

GENERAL NOTES AND EQUIPMENT SCHEDULE

⊙ 720

⊙ Com

⊙ ZV2 (O.K.)

⊙ ZV3 (SPACE)


⊙ ZV4 (ADD)

⊙ ZV5 (Q/O)

⊙ Y

⊙ Z/IV1

⊙ OF1

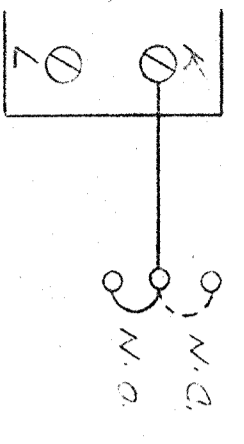

R1	Q	NO	⊙
	N2	NO	⊙
R2	Q	NO	⊙
	N2	NO	⊙
R3	Q	NO	⊙
	N2	NO	⊙
R4	Q	NO	⊙
	N2	NO	⊙
R5	Q	NO	⊙
	N2	NO	⊙
R6	Q	NO	⊙
	N2	NO	⊙
R7	Q	NO	⊙
	N2	NO	⊙
R8	Q	NO	⊙
	N2	NO	⊙
R9	Q	NO	⊙
	N2	NO	⊙
R10	Q	NO	⊙
	N2	NO	⊙
R11	Q	NO	⊙
	N2	NO	⊙
R12	Q	NO	⊙
	N2	NO	⊙
R13	Q	NO	⊙
	N2	NO	⊙
R14	Q	NO	⊙
	N2	NO	⊙
R15	Q	NO	⊙
	N2	NO	⊙
R16	Q	NO	⊙
	N2	NO	⊙

0310 } START VAN INTERLOCK  
0320 } (SEE SHEET #1)

0310 } START HOTEL CORRIDOR  
0320 } MAKE-UP SYSTEM  
(SEE SHEET #3)

0310 } START SWIMMING POOL  
0320 } STAIRWELL SF-4 SOUTH/NORTH  
(SEE SHEET #5)

0310 } START KITCHEN SYS, HOOD MAKE-UP AHU-3g  
0320 } HOOD EX EF-3 (SEE SHEET #7)

0460 } START B-1 (BALL ROOM ZONE 1)  
0470 } (SEE SHEET #1)


0460 } START B-2 (BALL ROOM ZONE 2)  
0480 } (SEE SHEET #1)

0450 } START B-3 (BALL ROOM ZONE 3)  
0490 } (SEE SHEET #1)

0460 } START B-4 (BALL ROOM ZONE 4)  
0500 } (SEE SHEET #1)

0460 } START RESTAURANT ZONE  
0510 } (SEE SHEET #1)

0460 } START HOTEL 1ST FLOOR ZONE  
0520 } (SEE SHEET #1)

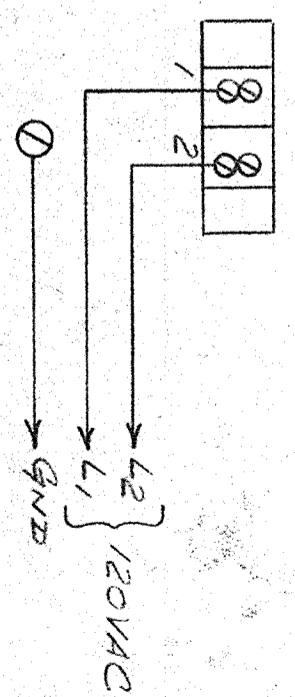

REVISIONS	
DATE	CHANGES
3-21-84	WAS BUILT

JOB NAME: CAPITOL PLAZA HOTEL  
 LOCATION: FRANKFORT, KY.  
 ARCHITECT: N/A  
 ENGINEER: CARRIER & FOSTER & ASSOCIATES  
 CONTRACTOR: STEWARD MECHANICAL

DRAWN BY: J.G.  
 CHECKED: L.G.  
 DATE: 11-7-83

MICRO/8000-  
 WIRING & ZONE  
 LAYOUT

RECEIVED MAY 11 1984