

INSTITUTION Capital Plaza Authority

DRAWING NO CPA

PAGE NO CPA-7

OFFICE DWG NO	ARCH DWG NO	BLD'G SECTOR	NAME OF BUILDING	TITLE OF DRAWING	BRANCH OF WORK	DRAWN BY	DATE	REMARKS
CPA-247	E-30	E-3	Capital Plaza Office Bldg Frankfort Ky	Plaza Level Plan	Electrical	Trahan	5/15/67	Lee Potter Smith & Assoc
" 248	E-31			Ramp Snow Melting Cable		"		
" 249	E-32			" " " " & Diagrams		"		
CPA 250	E-33	C-2	<i>CPA 250</i>	Ground Level - Lighting		"		
" 251	E-34	C-2		" " " " Power		"		
" 252	E-35	C-2		Mezzanine & Level Lighting		"		
" 253	E-36	C-2		Mezzanine & Level Power		"		
" 254	E-37	C-2		Lobby Level - Lighting		"		
" 255	E-38	C-2		Lobby Level - Power		"		
" 256	E-39	C-2		Lighting Typical Floors 1 thru 12 & 15 thru 23		"		
" 257	E-40	C-2		Lighting Fourteenth Floor		"		
" 258	E-41	C-2		Lighting - Twenty-Fourth Floor		"		
" 259	E-42	C-2		Lighting Core Areas		"		
" 260	E-43			Lighting Fixture Details		"		
" 261	E-44			" " "		"		
" 262	E-45	C-2		" " "		"		
" 263	E-46			Power Typical Floors 1 thru 12 & 15 thru 24		"		
" 264	E-47	C-2		Power 14th Floor		"		
" 265	E-48			Penthouse & Roof		"		
" 266	E-49	C-2		Power - Core Area		"		
" 267	E-50			Underfloor Dust Details		"		
" 268	E-51	C-2		13th Floor Fan Room		"		
" 269	E-52	C-1		Mechanical Room		"		
" 270	E-53	C-1		" "		"		
" 271	E-54			Substation & Motor Control Center Details		"		
" 272	E-55			Power Riser Diagrams		"		
" 273	E-56			" " "		"		
" 274	E-57			System Feeder Diagrams		"		
" 275	E-58			Building Exterior Lighting Control System Diagram		"		
" 276	E-59			Auditorium - Lobby Lighting Control System Details & Diagrams		"		
" 277	E-60			Fire Alarm & Telephone Riser Diagrams		"		
" 278	E-61			Panel & Circuit Schedules		"		
" 279	E-62			Legend - Schedules & Details		"		
" 280			Capital Plaza Development	Cover Sheet	Topo			Lee Potter Smith
" 280A			Phase II	Schedule or Index Sheet				Pritchett, Hugo F. Carter
" 281	G-1		Frankfort, Kentucky	Site Survey		E H W		
" 282	G-2		(CPA-4)	" "		"		
" 283	G-3			" "		"		L. E. Gregg & Assoc
" 284	G-4			Log of Berings		"		
" 285	G-1			Mezzanine Level	Landscape	C W		

INSTITUTION CAPITAL PLAZA OFFICE BUILDING

DRAWING NO CPA

PAGE NO 8

OFFICE DWG NO	ARCH DWG NO	BLD'G	NAME OF BUILDING	TITLE OF DRAWING	BRANCH OF WORK	DRAWN BY	DATE	REMARKS
CPA-279	1 9		Addendum No 2	Section 114-114				
	2 26		Capital Plaza Office Building	Utility - Tunnel Section				
	3 31		Frankfort, Kentucky	Plan				
	4 35			Section R6-R6 and Section R7-R7				
	5 36			Section R8-R8				
	6 37			Section R9-R9				
	7 38			Detail 14				
	8 39			Utilities - Tunnel under Main Street				
	9 53			Section 115-115				
	10 72			Sidewalk Plan				
	11 79			Plan				
	12 104			Partial Plan of Walkway				
	13 113			Sidewalk Plan				
	14 125			Sidewalk Plan				
	15 127			Plan				
	16 128			Plan				
	17 135			Plan				
	17A-135			Plan				
	18 168			Section 8-8				
	19 178			Sidewalk Plan				
	20 178			Sidewalk Plan				
	21 182			Section 42-42				
	22 183			Section 43-43				
	23 183			Section 43-43				
	24 184			Section 41-41				
	25 185			Sidewalk Plan				
	26 185			Sidewalk Plan				
	27 190			Section 57-57				
	28 190			Section 57-57				
	29 190			Section 57-57				
	30 192			Center Line Expansion Joint for Continuation See Drawing No S-36				
	31 213			Building Foundation				
	32 248			Concrete Curb				
	33 259			Building Foundation				
	34 259			Building Foundation				
35	35 270			Building Foundation				
	35A 270			Building Foundation				
	36 272			Section G-G				
	37 272			Section G1-G1				
	38 272			Section G1-G1				
	39 277							

OFFICE DWG NO	ARCH DWG NO	BLD'G	NAME OF BUILDING	TITLE OF DRAWING	BRANCH OF WORK	DRAWN BY	DATE	REMARKS
CPA-279	40 283		Addendum No 2	Building Foundation				
	41 288		Capital Plaza Office Building	Building Foundation				
	42 290		Frankfort, Kentucky	Building Foundation				
	43 294			Section Q-Q				
	44 295			Building Foundation				
	45 317			Additional Reinforcement at Cable Anchorage				
	46 320			Detail 15				
	47 327			Section Type Y6				
	48 329			Typical Truss Setting Detail				
	49 335			Section 29-29 Stairs				
	50 336			Section 60-60 Stairs				
	51 337			Section 75-75 Stairs				
	52 338			Section 30-30 Stairs				
	53 340			Section 76-76 Stairs				
	54 341			Section 58-58 Stairs				
	55 344			Mezzanine Level Plan-Stair				
	56 345			Plaza Level Plan-Stair				
	57 350			Section				
	58 351			Section				
	59 352			Section of Trench Drain				
	60 358			Section of Trench Drain				
	61 359			Section of Trench Drain				
	62 362			Section 19-19				
	63 363			Section 20-20				
	64 364			Section 21-21				
	65 366			Section 31-31				
	66 367			Section 22 32-32				
	67 367			Section 32-32				
	68 383			Screen Wall Plan				
	69 390			Section 45-45				
	70 5		Addendum No 3	Section 47-47				
	71 37			Stairs Section				
	72 38			Section				

OFFICE DWG NO	ARCH DWG NO	BLD'G SECTOR	NAME OF BUILDING	TITLE OF DRAWING	BRANCH OF WORK	DRAWN BY	DATE	REMARKS
CPA-287	A-1	Master	Capital Plaza Development	Ground Level	Architectural	C W		
" -288	A-2	"	Phase II	Mezzonine Level	"	"		
" -289	A-3	"	Frankfort, Kentucky	Plaza Level	"	"		
" -290	A-4	B-4		Ground Level Plan	Architectural	JB/WH	10/16/67	Lee Potter Smith
" -291	A-5	B-5		" " "		"		
" -292	A-6	B-6		" " "		"		
" -293	A-7	B-7		" " "		"		
" -294	A-8	C-4		" " "		H/WH/JB		
" -295	A-9	C-5		" " "		"		
" -296	A-10	C-6		" " "		J B		
" -297	A-11	C-7		" " "		"		
" -298	A-12	D-4		" " "		J B /WH		
" -299	A-13	D-5		" " "		J B		
" -300	A-14	D-6		" " "		"		
" -301	A-15	B-4	Commercial Area-Fountain Place	Plaza Level Plan		"		
" -302	A-16	E-5	" " "	" " "		JB/WH		
" -303	A-17	D-6		" " "		JB		
" -304	A-18	B-7		" " "		WD/WH		
" -305	A-19	B-8		" " "		J B		
" -306	A-20	C-4	Commercial Area-Fountain Place	" " "		WD/LH/WH		
" -307	A-21	C-5	" " "	" " "		"		
" -308	A-22	C-6		" " "		JB/WH		
" -309	A-23	C-7		" " "		JB/WH		
" -310	A-24	C-8		" " "		JB/WH		
" -311	A-25	D-4	Comm. Area-Fountain Place	" Cafeteria "		FD/WH		
" -312	A-26	D-5	" " "	" " "		JB/WH		
" -313	A-27	D-6		" " "		JB		
" -314	A-28			Elevations		WD/LH		
" -315	A-29			"		WD		
" -316	A-30			"		"		
" -317	A-31			"		"		
" -318	A-32			"		"		
" -319	A-33			"		WD/DJ/HB		
" -320	A-34			Building Sections		WD/WT		
" -321	A-35			" "		WD/DJ		
" -322	A-36			" "		WD		
" -323	A-37			Stair Plans and Sections		"		
" -324	A-38			" " " "		"		
" -325	A-39	D-4		Enlarged Kitchen Plan		F D		
" -326	A-40	B-4		Schedules		"		
" -327	A-41			"		"		

COMMONWEALTH OF KENTUCKY
EDWARD T. BREATHITT, GOVERNOR

DEPARTMENT OF FINANCE
DIVISION OF ENGINEERING

CAPITAL PLAZA DEVELOPMENT PHASE I
FRANKFORT KENTUCKY

LEE POTTER SMITH, PRITCHETT, HUGG AND CARTER ARCHITECTS AND ENGINEERS

PRAEGER · KAVANAGH · WATERBURY



STRUCTURAL ENGINEERS

ARCHITECTURAL
STRUCTURAL

CAPITAL PLAZA DEVELOPMENT PHASE I SCHEDULE OF DRAWINGS

ELECTRICAL			MECHANICAL			STRUCTURAL			ARCHITECTURAL		
SHEET NO.	TITLE OF DRAWING	SECTOR NO.	SHEET NO.	TITLE OF DRAWING	SECTOR NO.	SHEET NO.	TITLE OF DRAWING	SECTOR NO.	SHEET NO.	TITLE OF DRAWING	SECTOR NO.
E-1	ELECTRICAL PLAN—GROUND LEVEL	SECTOR B-4	PJ-1	SITE UTILITIES PLAN	SECTOR MASTER	S-1	PARTIAL GROUND LEVEL PLAN	SECTOR B-4	G-1	SITE SURVEY	
E-2	ELECTRICAL PLAN—GROUND LEVEL	SECTOR B-5	PH-1	PLUMBING AND VENTILATING PLAN—GROUND LEVEL	SECTOR B-4	S-2	PARTIAL GROUND LEVEL PLAN	SECTOR B-5	G-2	SITE SURVEY	
E-3	ELECTRICAL PLAN—GROUND LEVEL	SECTOR B-6	PH-2	PLUMBING AND VENTILATING PLAN—GROUND LEVEL	SECTOR B-5	S-3	PARTIAL GROUND LEVEL PLAN	SECTOR B-6	G-3	SITE SURVEY	
E-4	ELECTRICAL PLAN—GROUND LEVEL	SECTOR B-7	PH-3	PLUMBING AND VENTILATING PLAN—GROUND LEVEL	SECTOR B-6	S-4	PARTIAL GROUND LEVEL PLAN	SECTOR B-7	G-4	LOG OF BORINGS	
E-5	ELECTRICAL PLAN—GROUND LEVEL	SECTOR C-4	PH-4	PLUMBING AND VENTILATING PLAN—GROUND LEVEL	SECTOR B-7	S-5	PARTIAL GROUND LEVEL PLAN	SECTOR C-4	L-1	LANDSCAPE—MEZZANINE LEVEL	
E-6	ELECTRICAL PLAN—GROUND LEVEL	SECTOR C-5	PH-5	PLUMBING AND VENTILATING PLAN—GROUND LEVEL	SECTOR C-4	S-6	PARTIAL GROUND LEVEL PLAN	SECTOR C-5	L-2	LANDSCAPE—PLAZA LEVEL	
E-7	ELECTRICAL PLAN—GROUND LEVEL	SECTOR C-6	PH-6	PLUMBING AND VENTILATING PLAN—GROUND LEVEL	SECTOR C-5	S-7	PARTIAL GROUND LEVEL PLAN	SECTOR C-6	A-1	GROUND LEVEL	SECTOR MASTER
E-8	ELECTRICAL PLAN—GROUND LEVEL	SECTOR C-7	PH-7	PLUMBING AND VENTILATING PLAN—GROUND LEVEL	SECTOR C-6	S-8	PARTIAL GROUND LEVEL PLAN	SECTOR C-7	A-2	MEZZANINE LEVEL	SECTOR MASTER
E-9	ELECTRICAL PLAN—GROUND LEVEL	SECTOR D-4	PH-8	PLUMBING AND VENTILATING PLAN—GROUND LEVEL	SECTOR C-7	S-9	PARTIAL GROUND LEVEL PLAN	SECTOR D-4	A-3	PLAZA LEVEL	SECTOR MASTER
E-10	ELECTRICAL PLAN—GROUND LEVEL	SECTOR D-5	PH-9	PLUMBING AND VENTILATING PLAN—GROUND LEVEL	SECTOR D-4	S-10	PARTIAL GROUND LEVEL PLAN	SECTOR D-5	A-4	GROUND LEVEL PLAN	SECTOR B-4
E-11	ELECTRICAL PLAN—GROUND LEVEL	SECTOR D-6	PH-10	PLUMBING AND VENTILATING PLAN—GROUND LEVEL	SECTOR D-5	S-11	PARTIAL GROUND LEVEL PLAN	SECTOR D-6	A-5	GROUND LEVEL PLAN	SECTOR B-5
E-12	ELECTRICAL PLAN—MEZZANINE LEVEL	SECTOR B-4	PH-11	PLUMBING AND VENTILATING PLAN—GROUND LEVEL	SECTOR D-6	S-12	PARTIAL MEZZANINE FRAMING PLAN	SECTOR B-4	A-6	GROUND LEVEL PLAN	SECTOR B-6
E-13	ELECTRICAL PLAN—MEZZANINE LEVEL	SECTOR B-5	PH-12	PLUMBING, HEATING AND AIR CONDITIONING PLAN—MEZZANINE LEVEL	SECTOR B-4	S-13	PARTIAL MEZZANINE FRAMING PLAN	SECTOR B-5	A-7	GROUND LEVEL PLAN	SECTOR B-7
E-14	ELECTRICAL PLAN—MEZZANINE LEVEL	SECTOR B-6	PH-13	PLUMBING, HEATING AND AIR CONDITIONING PLAN—MEZZANINE LEVEL	SECTOR B-5	S-14	PARTIAL MEZZANINE FRAMING PLAN	SECTOR B-6	A-8	GROUND LEVEL PLAN	SECTOR C-4
E-15	ELECTRICAL PLAN—MEZZANINE LEVEL	SECTOR B-7	PH-14	PLUMBING AND VENTILATING PLAN—MEZZANINE LEVEL	SECTOR B-6	S-15	PARTIAL MEZZANINE FRAMING PLAN	SECTOR B-7	A-9	GROUND LEVEL PLAN	SECTOR C-5
E-16	ELECTRICAL PLAN—LIGHTING — MEZZANINE LEVEL	SECTOR C-4	PH-15	PLUMBING AND VENTILATING PLAN—MEZZANINE LEVEL	SECTOR B-7	S-16	PARTIAL MEZZANINE FRAMING PLAN	SECTOR C-4	A-10	GROUND LEVEL PLAN	SECTOR C-6
E-17	ELECTRICAL PLAN—POWER—MEZZANINE LEVEL	SECTOR C-4	PH-16	PLUMBING PLAN—MEZZANINE LEVEL	SECTOR C-4	S-17	PARTIAL MEZZANINE FRAMING PLAN	SECTOR C-5	A-11	GROUND LEVEL PLAN	SECTOR C-7
E-18	ELECTRICAL PLAN—LIGHTING—MEZZANINE LEVEL	SECTOR C-5	PH-17	HEATING AND AIR CONDITIONING PLAN—MEZZANINE LEVEL	SECTOR C-4	S-18	PARTIAL MEZZANINE FRAMING PLAN	SECTOR C-6	A-12	GROUND LEVEL PLAN	SECTOR D-4
E-19	ELECTRICAL PLAN—POWER—MEZZANINE LEVEL	SECTOR C-5	PH-18	PLUMBING PLAN—MEZZANINE LEVEL	SECTOR C-4	S-19	PARTIAL MEZZANINE FRAMING PLAN	SECTOR C-7	A-13	GROUND LEVEL PLAN	SECTOR D-5
E-20	ELECTRICAL PLAN—MEZZANINE LEVEL	SECTOR C-6	PH-19	HEATING AND AIR CONDITIONING PLAN—MEZZANINE LEVEL	SECTOR C-5	S-20	PARTIAL MEZZANINE FRAMING PLAN	SECTOR D-4	A-14	GROUND LEVEL PLAN	SECTOR D-6
E-21	ELECTRICAL PLAN—MEZZANINE LEVEL	SECTOR C-7	PH-20	PLUMBING AND VENTILATING PLAN—MEZZANINE LEVEL	SECTOR C-6	S-21	PARTIAL MEZZANINE FRAMING PLAN	SECTOR D-5	A-15	MEZZANINE LEVEL PLAN	SECTOR B-4
E-22	ELECTRICAL PLAN—LIGHTING—MEZZANINE LEVEL	SECTOR D-4	PH-21	PLUMBING AND VENTILATING PLAN—MEZZANINE LEVEL	SECTOR C-7	S-22	PARTIAL MEZZANINE FRAMING PLAN	SECTOR D-6	A-16	MEZZANINE LEVEL PLAN	SECTOR B-5
E-23	ELECTRICAL PLAN—POWER—MEZZANINE LEVEL	SECTOR D-4	PH-22	PLUMBING PLAN—MEZZANINE LEVEL	SECTOR D-4	S-23	PARTIAL PLAZA FRAMING PLAN	SECTOR B-4	A-17	MEZZANINE LEVEL PLAN	SECTOR B-6
E-24	ELECTRICAL PLAN—LIGHTING—MEZZANINE LEVEL	SECTOR D-5	PH-23	HEATING AND AIR CONDITIONING PLAN—MEZZANINE LEVEL	SECTOR D-4	S-24	PARTIAL PLAZA FRAMING PLAN	SECTOR B-5	A-18	MEZZANINE LEVEL PLAN	SECTOR B-7
E-25	ELECTRICAL PLAN—POWER—MEZZANINE LEVEL	SECTOR D-5	PH-24	PLUMBING PLAN—MEZZANINE LEVEL	SECTOR D-5	S-25	PARTIAL PLAZA FRAMING PLAN	SECTOR B-6	A-19	MEZZANINE LEVEL PLAN	SECTOR B-8
E-26	ELECTRICAL PLAN—MEZZANINE LEVEL	SECTOR D-6	PH-25	HEATING AND AIR CONDITIONING PLAN—MEZZANINE LEVEL	SECTOR D-5	S-26	PARTIAL PLAZA FRAMING PLAN	SECTOR B-7	A-20	MEZZANINE LEVEL PLAN	SECTOR C-4
E-27	ELECTRICAL PLAN—PLAZA LEVEL	SECTOR B-4	PH-26	PLUMBING AND VENTILATING PLAN—MEZZANINE LEVEL	SECTOR D-6	S-27	PARTIAL PLAZA FRAMING PLAN	SECTOR C-4	A-21	MEZZANINE LEVEL PLAN	SECTOR C-5
E-28	ELECTRICAL PLAN—PLAZA LEVEL	SECTOR B-5	PH-27	PLUMBING PLAN—PLAZA LEVEL	SECTOR D-6	S-28	PARTIAL PLAZA FRAMING PLAN	SECTOR C-5	A-22	MEZZANINE LEVEL PLAN	SECTOR C-6
E-29	ELECTRICAL PLAN—PLAZA LEVEL	SECTOR B-6	PH-28	PLUMBING PLAN—PLAZA LEVEL	SECTOR B-3	S-29	PARTIAL PLAZA FRAMING PLAN	SECTOR C-6	A-23	MEZZANINE LEVEL PLAN	SECTOR C-7
E-30	ELECTRICAL PLAN—PLAZA LEVEL	SECTOR B-7	PH-29	PLUMBING PLAN—PLAZA LEVEL	SECTOR B-6	S-30	PARTIAL PLAZA FRAMING PLAN	SECTOR C-7	A-24	MEZZANINE LEVEL PLAN	SECTOR C-8
E-31	ELECTRICAL PLAN—PLAZA LEVEL	SECTOR B-8	PH-30	PLUMBING PLAN—PLAZA LEVEL	SECTOR B-7	S-31	PARTIAL PLAZA FRAMING PLAN	SECTOR D-4	A-25	MEZZANINE LEVEL PLAN	SECTOR D-4
E-32	ELECTRICAL PLAN—PLAZA LEVEL	SECTOR C-4	PH-31	PLUMBING PLAN—PLAZA LEVEL	SECTOR B-8	S-32	PARTIAL PLAZA FRAMING PLAN	SECTOR D-5	A-26	MEZZANINE LEVEL PLAN	SECTOR D-5
E-33	ELECTRICAL PLAN—PLAZA LEVEL	SECTOR C-5	PH-32	PLUMBING PLAN—PLAZA LEVEL	SECTOR C-4	S-33	PARTIAL PLAZA FRAMING PLAN	SECTOR D-6	A-27	MEZZANINE LEVEL PLAN	SECTOR D-6
E-34	ELECTRICAL PLAN—PLAZA LEVEL	SECTOR C-6	PH-33	PLUMBING PLAN—PLAZA LEVEL	SECTOR C-5	S-34	PARTIAL PLAZA LEVEL PLAN	SECTOR B-4	A-28	ELEVATIONS	
E-35	ELECTRICAL PLAN—PLAZA LEVEL	SECTOR C-7	PH-34	PLUMBING PLAN—PLAZA LEVEL	SECTOR C-6	S-35	PARTIAL PLAZA LEVEL PLAN	SECTOR B-5	A-29	ELEVATIONS	
E-36	ELECTRICAL PLAN—PLAZA LEVEL	SECTOR C-8	PH-35	PLUMBING PLAN—PLAZA LEVEL	SECTOR C-7	S-36	PARTIAL PLAZA LEVEL PLAN	SECTOR B-6	A-30	ELEVATIONS	
E-37	ELECTRICAL PLAN—PLAZA LEVEL	SECTOR D-4	PH-36	PLUMBING PLAN—PLAZA LEVEL	SECTOR C-8	S-37	PARTIAL PLAZA LEVEL PLAN	SECTOR B-7	A-31	ELEVATIONS	
E-38	ELECTRICAL PLAN—PLAZA LEVEL	SECTOR D-5	PH-37	PLUMBING PLAN—PLAZA LEVEL	SECTOR D-4	S-38	PARTIAL PLAZA LEVEL PLAN	SECTOR B-8	A-32	ELEVATIONS	
E-39	ELECTRICAL PLAN—PLAZA LEVEL	SECTOR D-6	PH-38	PLUMBING PLAN—PLAZA LEVEL	SECTOR D-5	S-39	PARTIAL PLAZA LEVEL PLAN	SECTOR C-4	A-33	ELEVATIONS	
E-40	ELECTRICAL PLAN—KITCHEN	SECTOR D-4	PH-39	PLUMBING PLAN—PLAZA LEVEL	SECTOR D-6	S-40	PARTIAL PLAZA LEVEL PLAN	SECTOR C-5	A-34	BUILDING SECTIONS	
E-41	ELECTRICAL PLAN—MECHANICAL ROOM	SECTOR D-4	PH-40	PLUMBING PLAN—KITCHEN	SECTOR D-4	S-41	PARTIAL PLAZA LEVEL PLAN	SECTOR C-6	A-35	BUILDING SECTIONS	
E-42	SWITCHBOARD AND MOTOR CONTROL CENTER DETAILS	SECTOR D-4	PH-41	HEATING AND AIR CONDITIONING PLAN—KITCHEN	SECTOR D-4	S-42	PARTIAL PLAZA LEVEL PLAN	SECTOR C-7	A-36	BUILDING SECTIONS	
E-43	FEEDER DIAGRAM		PH-42	WASTE AND VENT PIPING DIAGRAM—KITCHEN	SECTOR D-4	S-43	PARTIAL PLAZA LEVEL PLAN	SECTOR C-8	A-37	STAIR PLANS AND SECTIONS	
E-44	LIGHTING CONTROL SYSTEM DIAGRAM		PH-43	WASTE AND VENT PIPING DIAGRAM—MECHANICAL ROOM	SECTOR D-4	S-44	PARTIAL PLAZA LEVEL PLAN	SECTOR D-4	A-38	STAIR PLANS AND SECTIONS	
E-45	COMPOSITE ELECTRICAL PLAN—MEZZANINE LEVEL		PH-44	WATER PIPING DIAGRAM—KITCHEN	SECTOR D-4	S-45	PARTIAL PLAZA LEVEL PLAN	SECTOR D-5	A-39	ENLARGED KITCHEN PLAN	SECTOR D-4
			PH-45	PLUMBING PLAN—MECHANICAL ROOM	SECTOR D-4	S-46	PARTIAL PLAZA LEVEL PLAN	SECTOR D-6	A-40	KITCHEN EQUIPMENT SCHEDULE	SECTOR D-4
			PH-46	ENLARGED MECHANICAL ROOM PLAN—HEATING AND AIR CONDITIONING PIPING	SECTOR D-4	S-47	JOIST, BEAM AND SLAB SCHEDULES	SECTOR ALL	A-41	SCHEDULES	
			PH-47	ENLARGED MECHANICAL ROOM PLAN—DUCTWORK LAYOUT	SECTOR D-4	S-48	GENERAL NOTES AND TYPICAL DETAILS	SECTOR ALL	A-42	SCHEDULES	
			PH-48	MECHANICAL ROOM PIPING DIAGRAM	SECTOR D-4	S-49	TYPICAL AND MISCELLANEOUS DETAILS	SECTOR ALL			
			PH-49	SCHEDULES	SECTOR D-4	S-50	FOUNDATION DETAILS	SECTOR ALL			
						S-51	PRECAST CONCRETE I	SECTOR ALL			

AS BUILT REVISIONS - 8-24-72

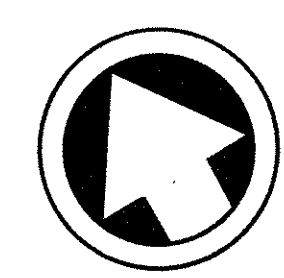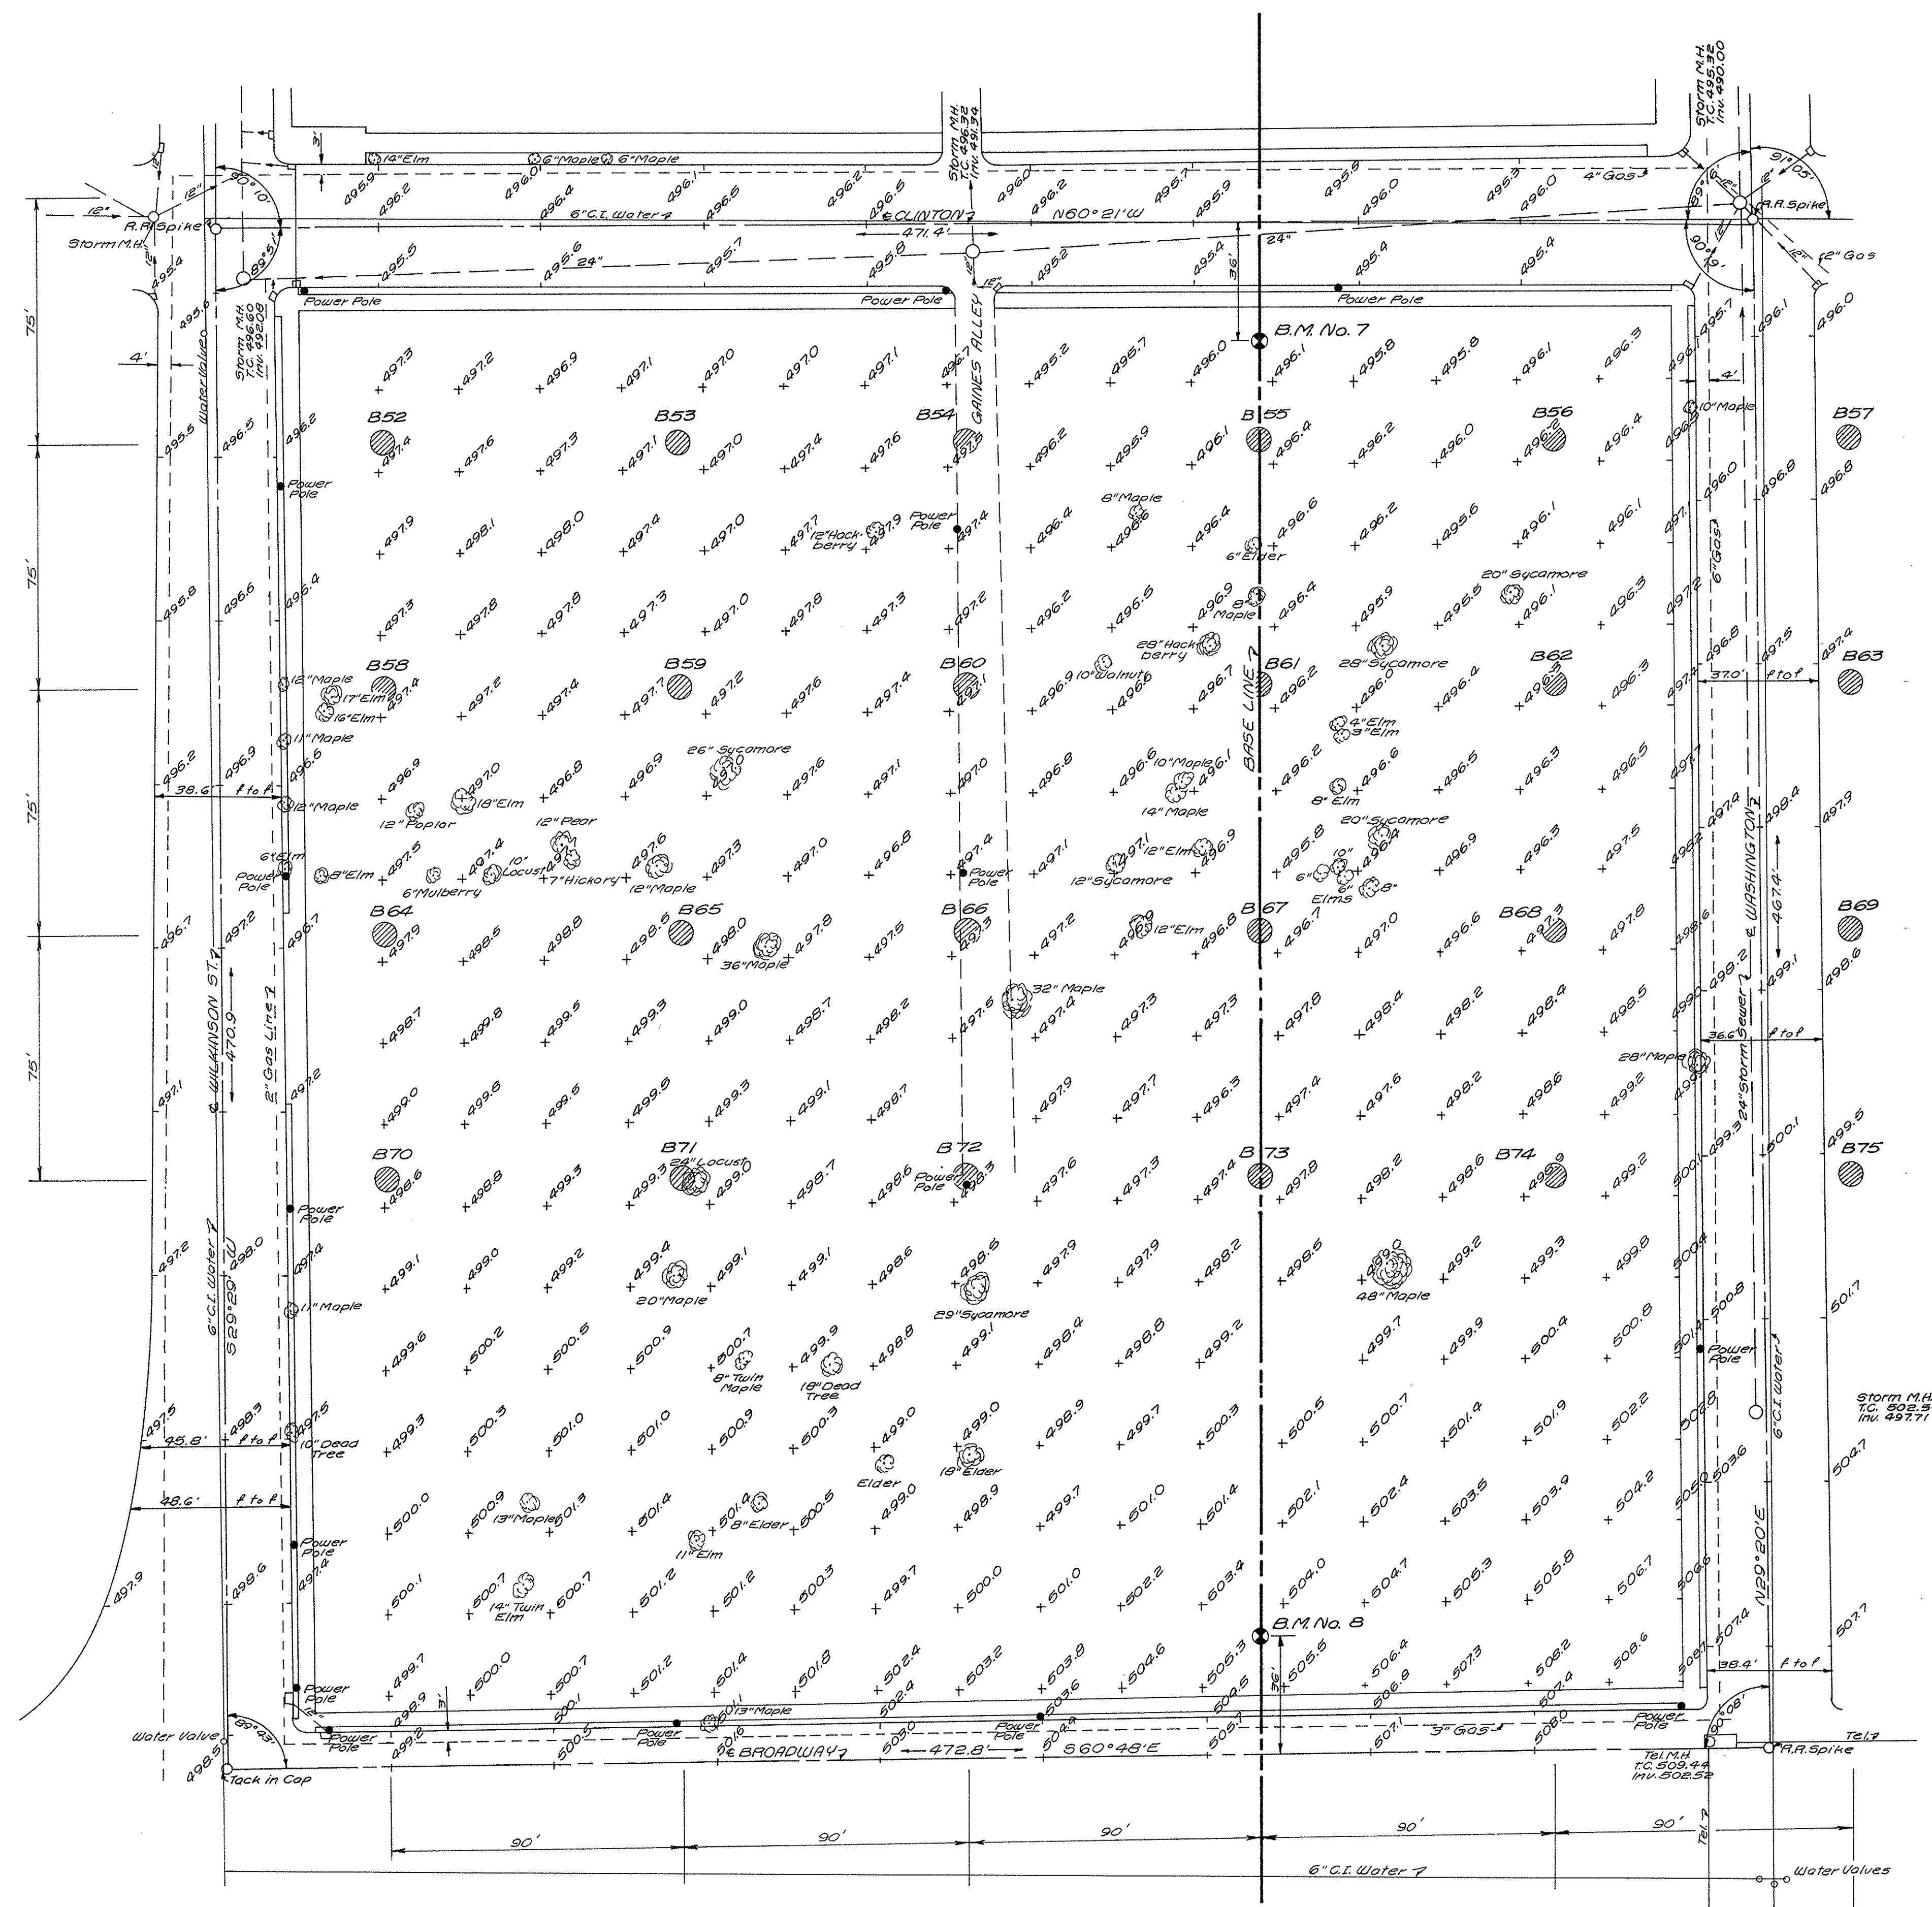


B.M. Datum Obtained From U.S.G.S
 B.M. No. W-146-1949 in Wall of Railway
 Express Office Behind L & N Depot
 Elev. 510.390

Scale: 1"=30'

BENCH MARK DATA



- *7 Commonwealth Survey Marker Set in Concrete
 On @ 36' S.W. of @ Clinton Elev. 495.61
- *8 Commonwealth Survey Marker Set in Concrete
 On @ 36' N.E. of @ Broadway Elev. 504.77

AS BUILT REVISIONS - 8-24-72

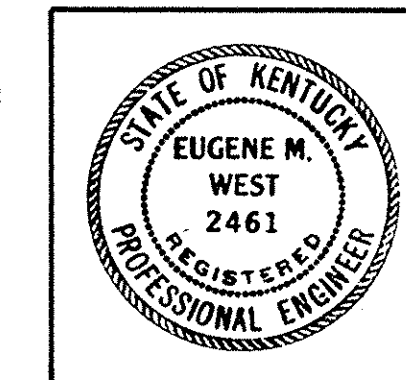

SITE SURVEY & BORING LOCATIONS
 L.E. GREGG & ASSOCIATES
 CONSULTING ENGINEERS
 LEXINGTON, KENTUCKY
 DRAWN HR SEPT 1967

CAPITAL PLAZA DEVELOPMENT PHASE II FRANKFORT, KENTUCKY		
DRAWN BY	SITE SURVEY	DATE
CHECKED BY		10/2/67
SECTOR NO.	LEE POTTER SMITH, PRITCHETT, HUGG & CARTER ARCHITECTS 314 WILKINSON STREET FRANKFORT, KENTUCKY	COMPL. NO. S0367
	COMMONWEALTH OF KENTUCKY DEPARTMENT OF FINANCE - DIVISION OF ENGINEERING FRANKFORT, KENTUCKY	DRAWING NO. 61
APPROVED BY	AGENCY HEAD	DATE
APPROVED BY	OWNER	DATE

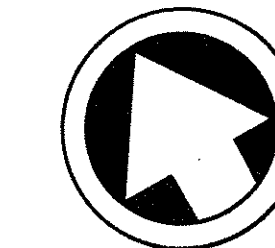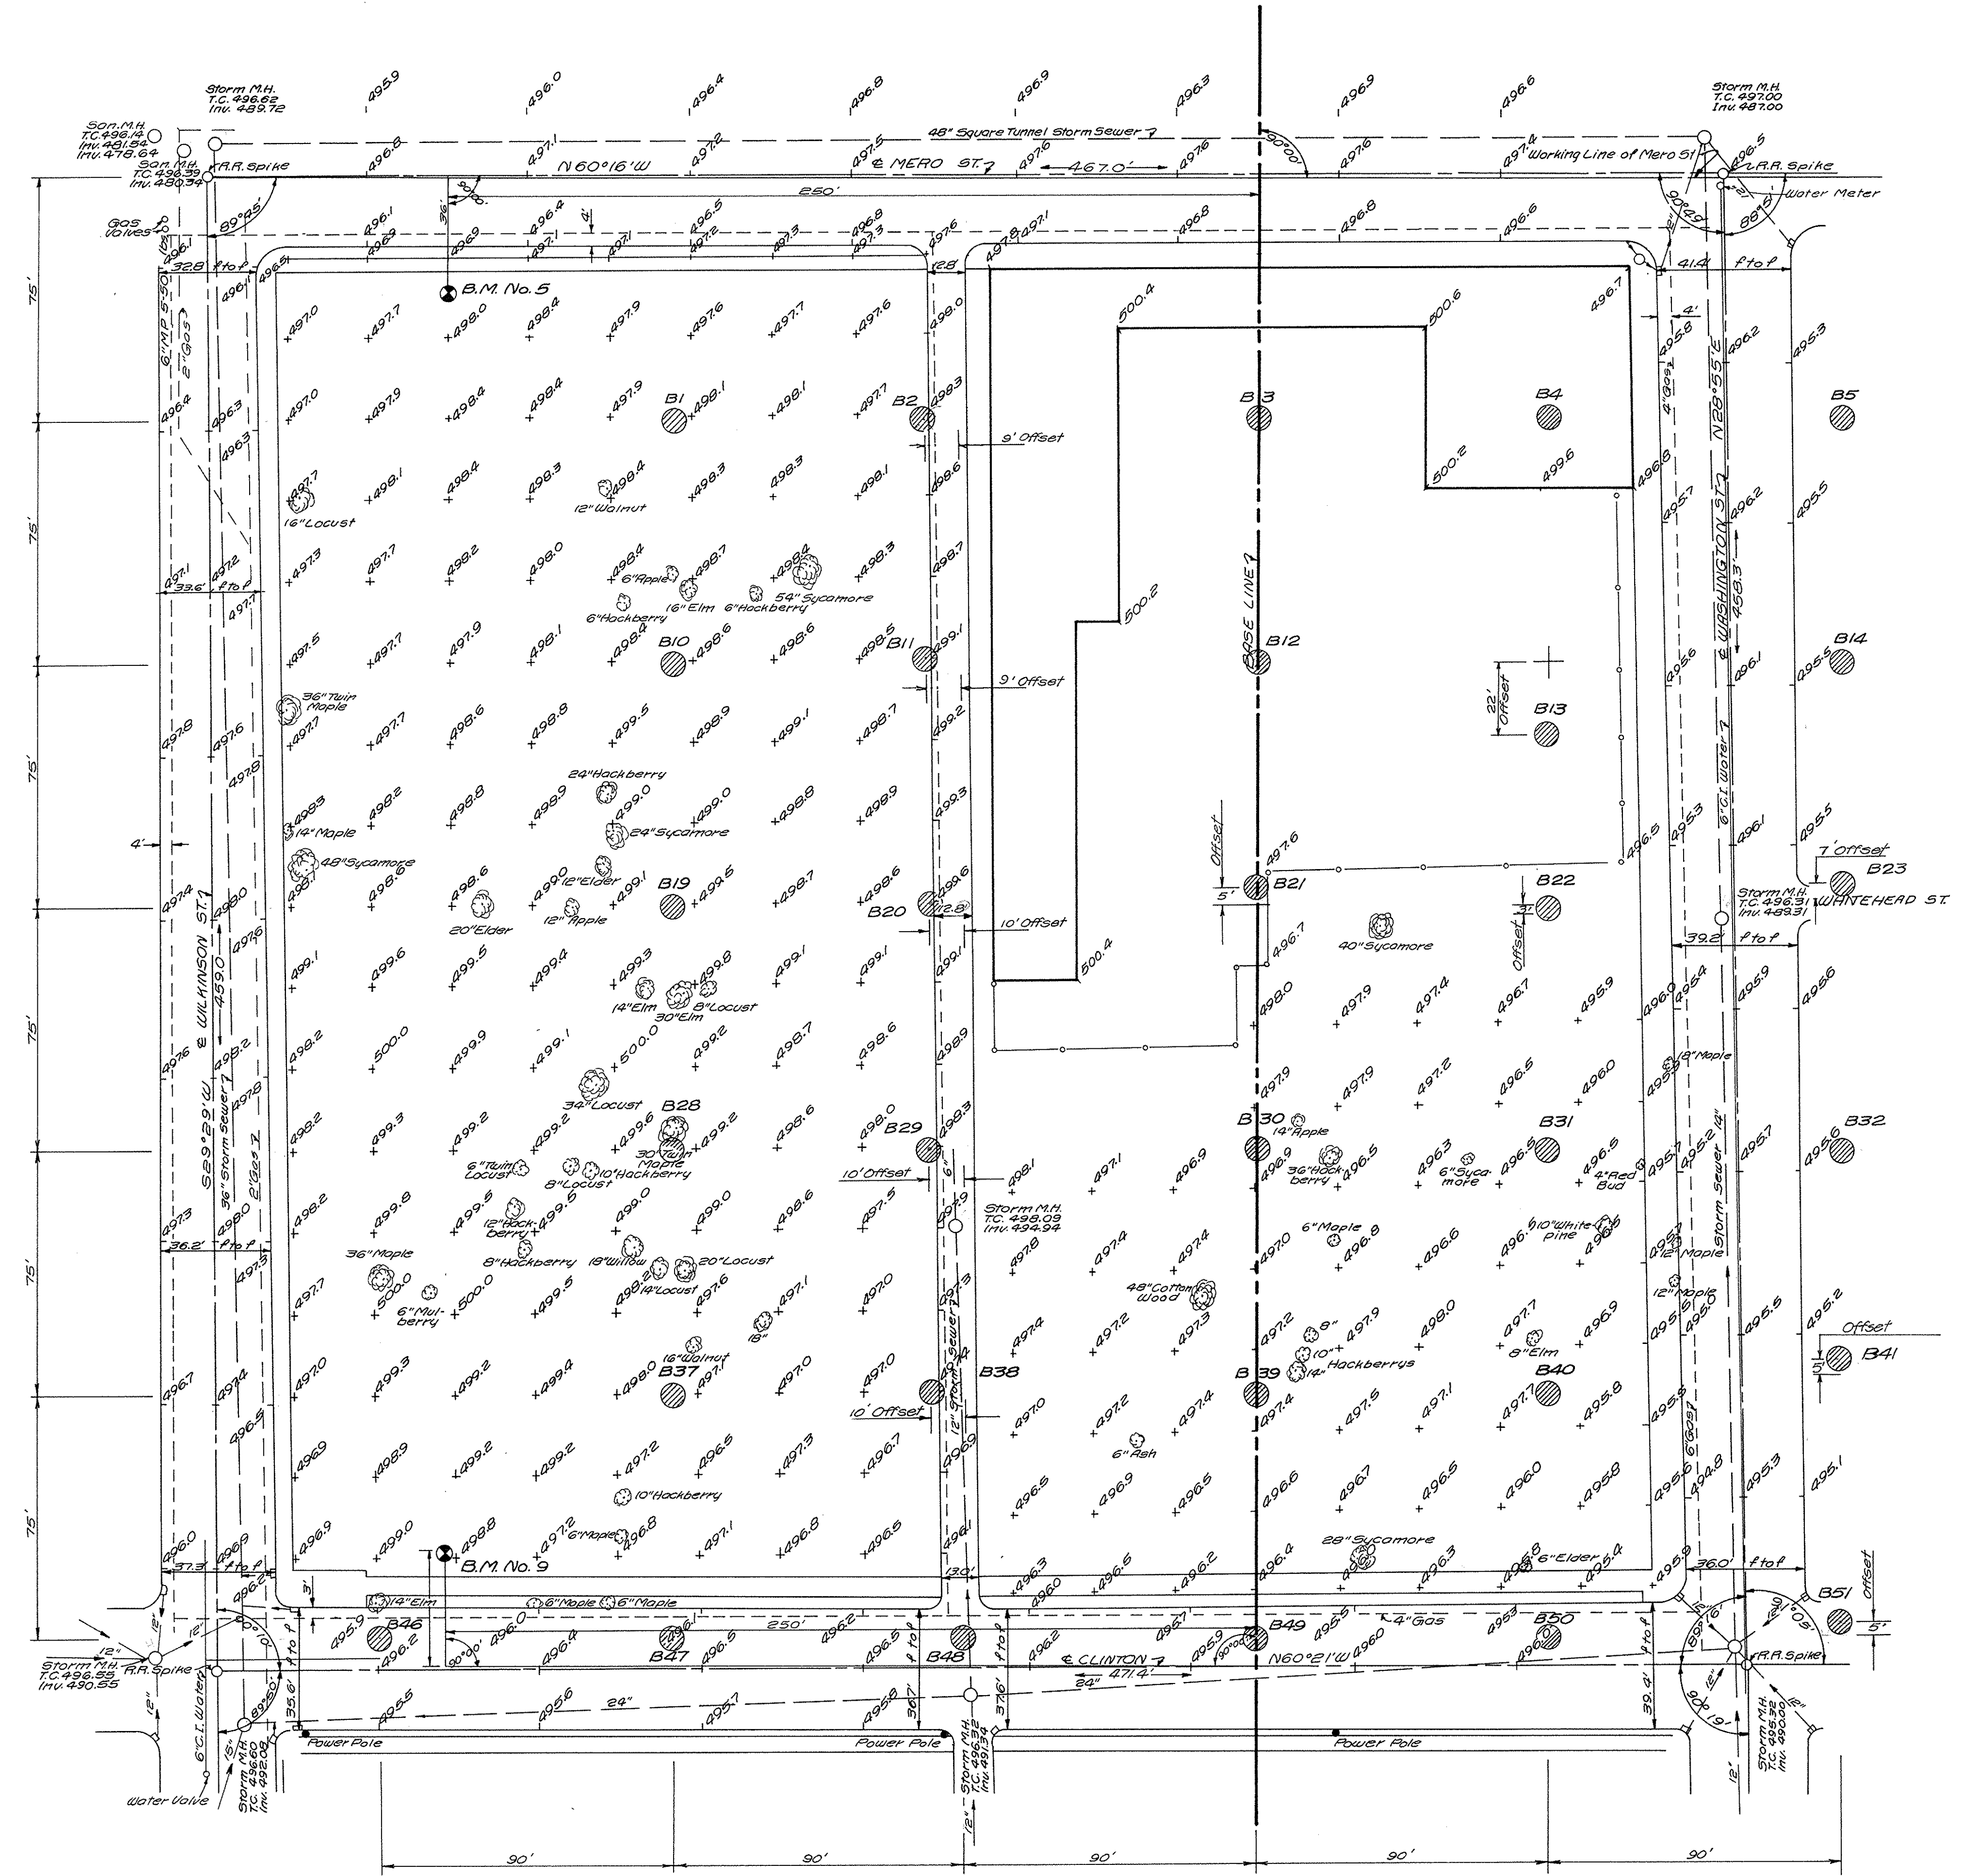

Scale: 1"=30'

B.M. Datum Obtained From U.S.G.S.
 B.M. No. W-146-1949 in Wall of Railway
 Express Office Behind L & N Depot
 Elev. 510.390



BENCH MARK DATA

- *5 Commonwealth Survey Marker Set in Concrete
 250' N.W. of B on E. of Mero & 36' S.W. at 90°00'
 Elev. 497.54
- *9 Commonwealth Survey Marker Set in Concrete
 30'00" N.W. of B, 250' & 30'00" N.E. 36'
 Elev.


AS BUILT REVISIONS - 6-24-72

CAPITAL PLAZA DEVELOPMENT PHASE II
 FRANKFORT, KENTUCKY

DRAWN BY	SITE SURVEY	DATE	12 OCT 67
CHECKED BY		COMM. NO.	50367
SECTOR NO.	LEE POTTER SMITH, PRITCHETT, HUGG & CARTER ARCHITECTS 314 WILKINSON STREET FRANKFORT, KENTUCKY	DRAWING NO.	62
	COMMONWEALTH OF KENTUCKY DEPARTMENT OF FINANCE - DIVISION OF ENGINEERING FRANKFORT, KENTUCKY	OF	41
APPROVED BY	AGENCY HEAD	DATE	
APPROVED BY	OWNER	DATE	10-22-67

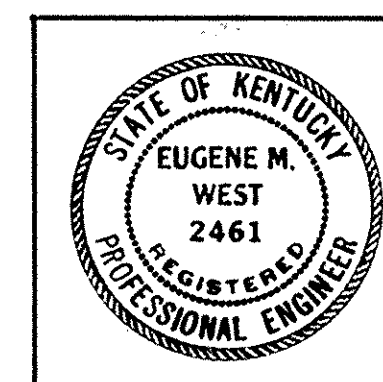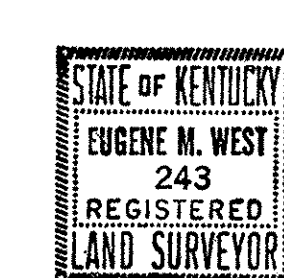

SITE SURVEY & BORING LOCATIONS
 L.E. GREGG & ASSOCIATES
 CONSULTING ENGINEERS
 LEXINGTON, KENTUCKY
 DRAWN HR SEPT 1967

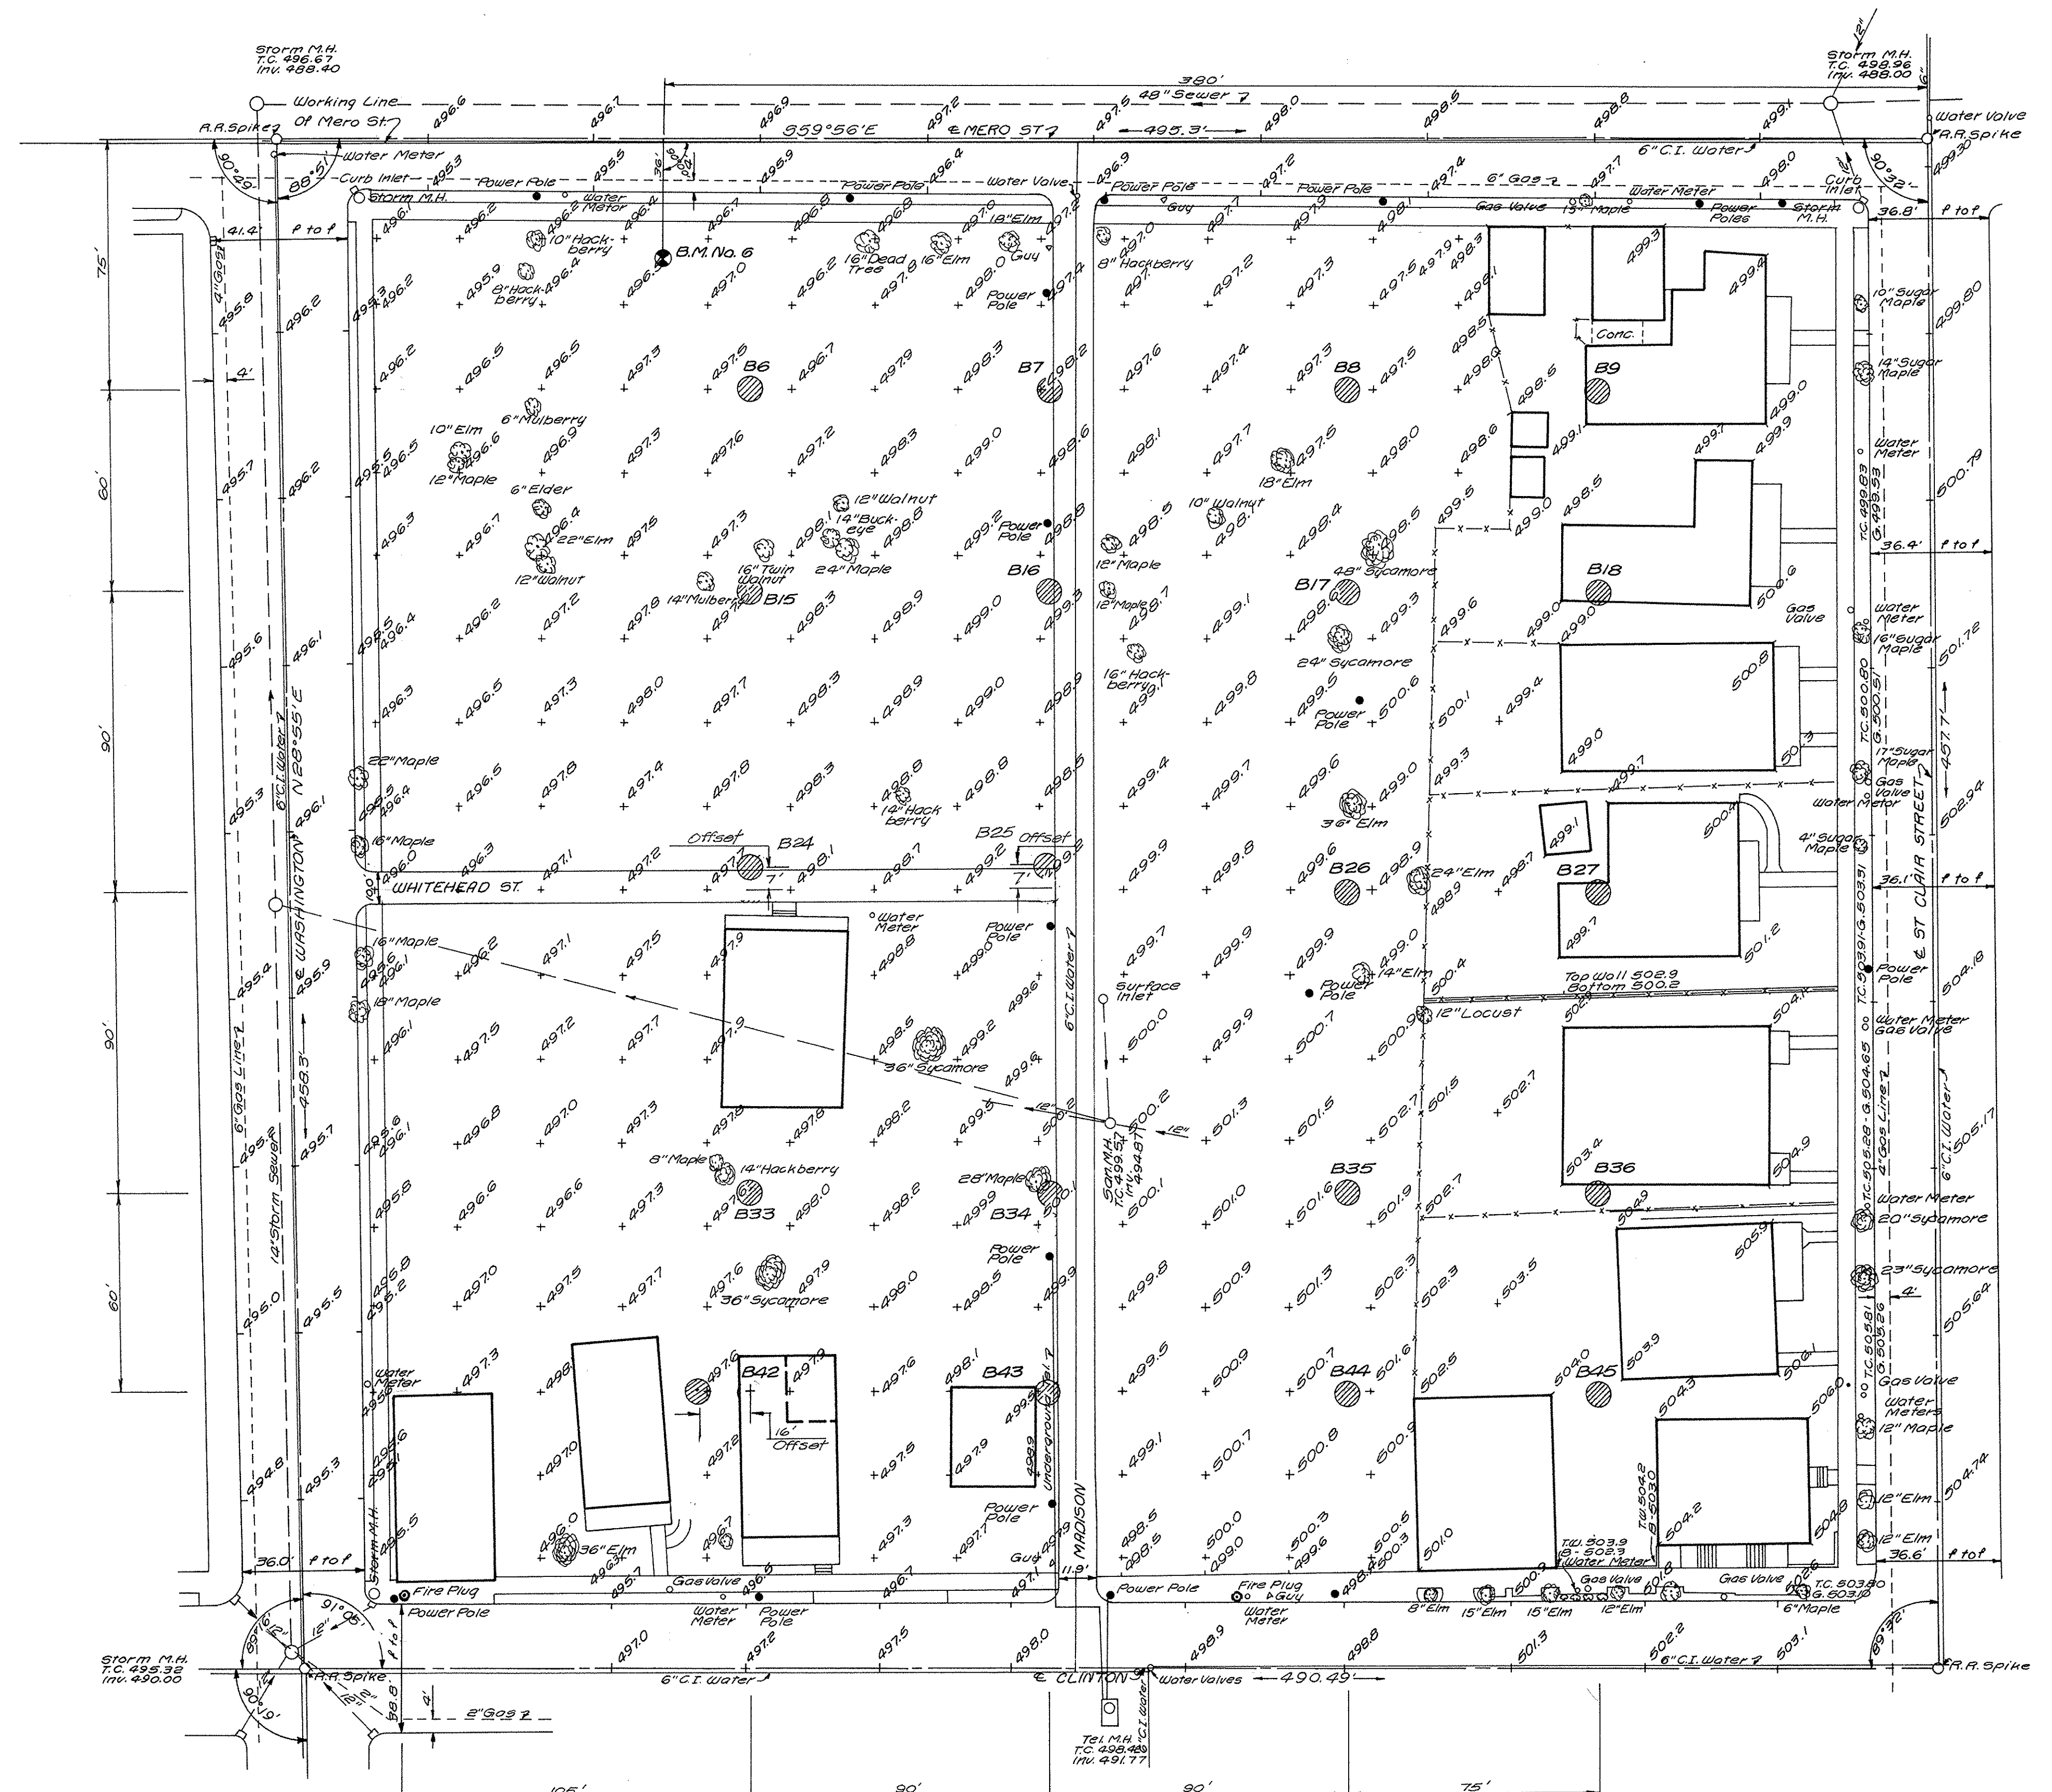

B.M. Datum Obtained From U.S.G.S.
 B.M. No. W-146-1949 in Wall of Railway
 Express Office Behind L & N Depot
 Elev. 510.380

Scale: 1" = 30'

BENCH MARK DATA
 *6 Commonwealth Survey Marker Set in Concrete
 380' N.W. of R.R. Spike at E. of St. Clair & Mero
 & 36' S.W. at 90°00' Elev. 496.37

AS BUILT REVISIONS - 5-24-72

STATE OF KENTUCKY
 EUGENE M. WEST
 243
 REGISTERED
 LAND SURVEYOR



STATE OF KENTUCKY
 EUGENE M. WEST
 2461
 REGISTERED
 PROFESSIONAL ENGINEER

**SITE SURVEY &
BORING LOCATIONS**

L.E. GREGG & ASSOCIATES
 CONSULTING ENGINEERS
 LEXINGTON, KENTUCKY
 DRAWN HR SEPT 1967

CAPITAL PLAZA DEVELOPMENT PHASE II			
FRANKFORT, KENTUCKY			
DRAWN BY	SITE SURVEY		DATE 10 OCT 67
CHECKED BY			COMM. NO. 50367
SECTOR NO.	LEE POTTER SMITH, PRITCHETT, HUGG & CARTER ARCHITECTS 314 WILKINSON STREET FRANKFORT, KENTUCKY		DRAWING NO. 33
	COMMONWEALTH OF KENTUCKY DEPARTMENT OF FINANCE - DIVISION OF ENGINEERING FRANKFORT		OF 4
APPROVED BY	AGENCY HEAD	DATE	
APPROVED BY	OWNER	DATE	10-24-67

LOGS OF BORINGS

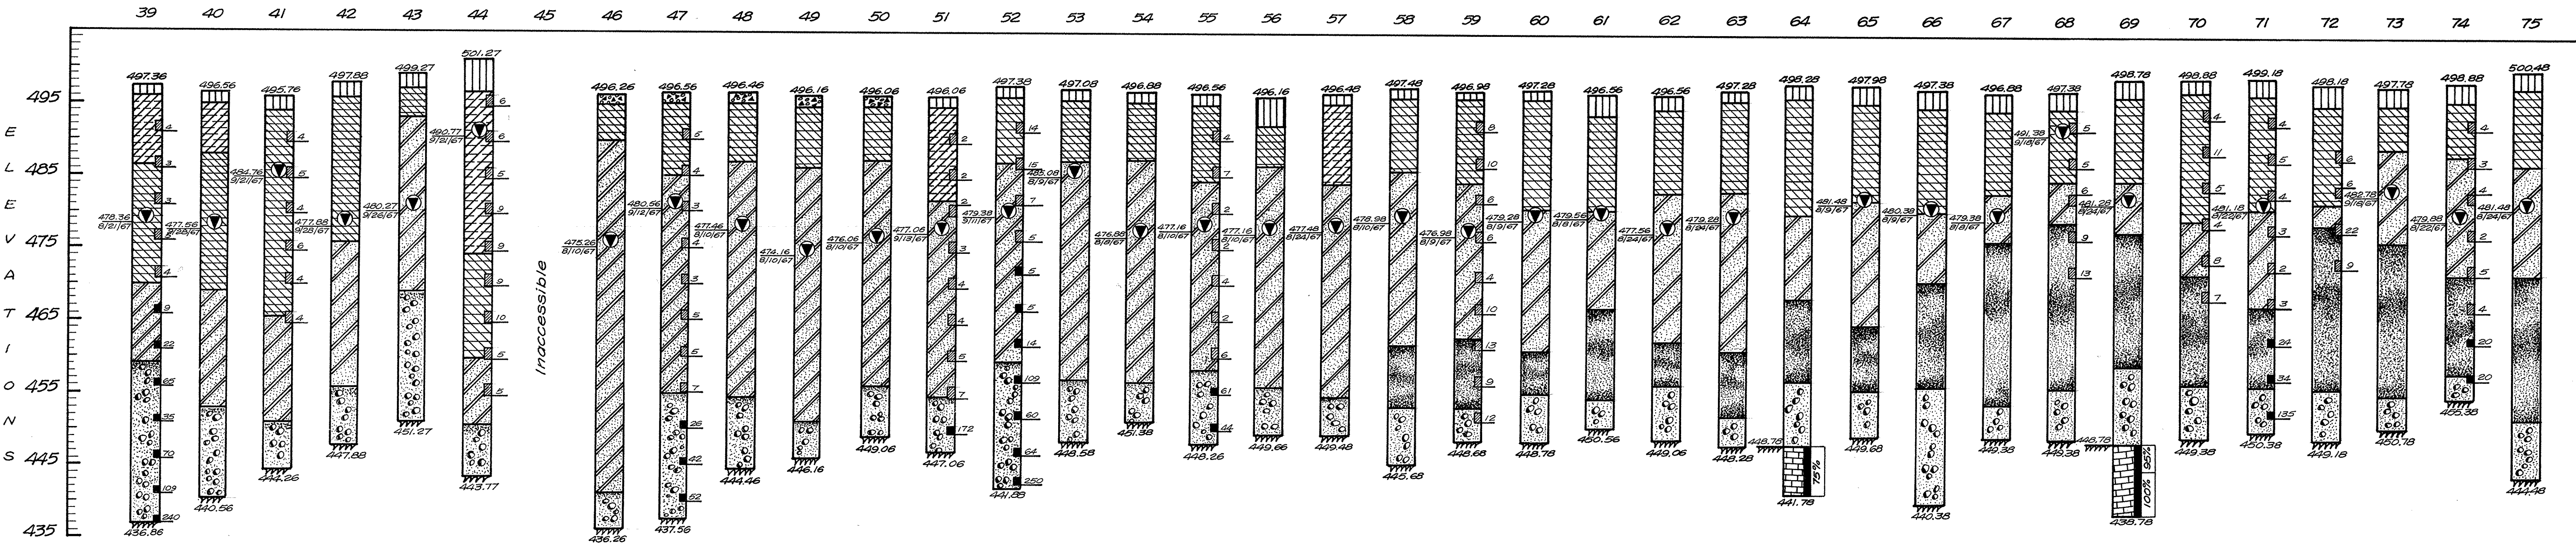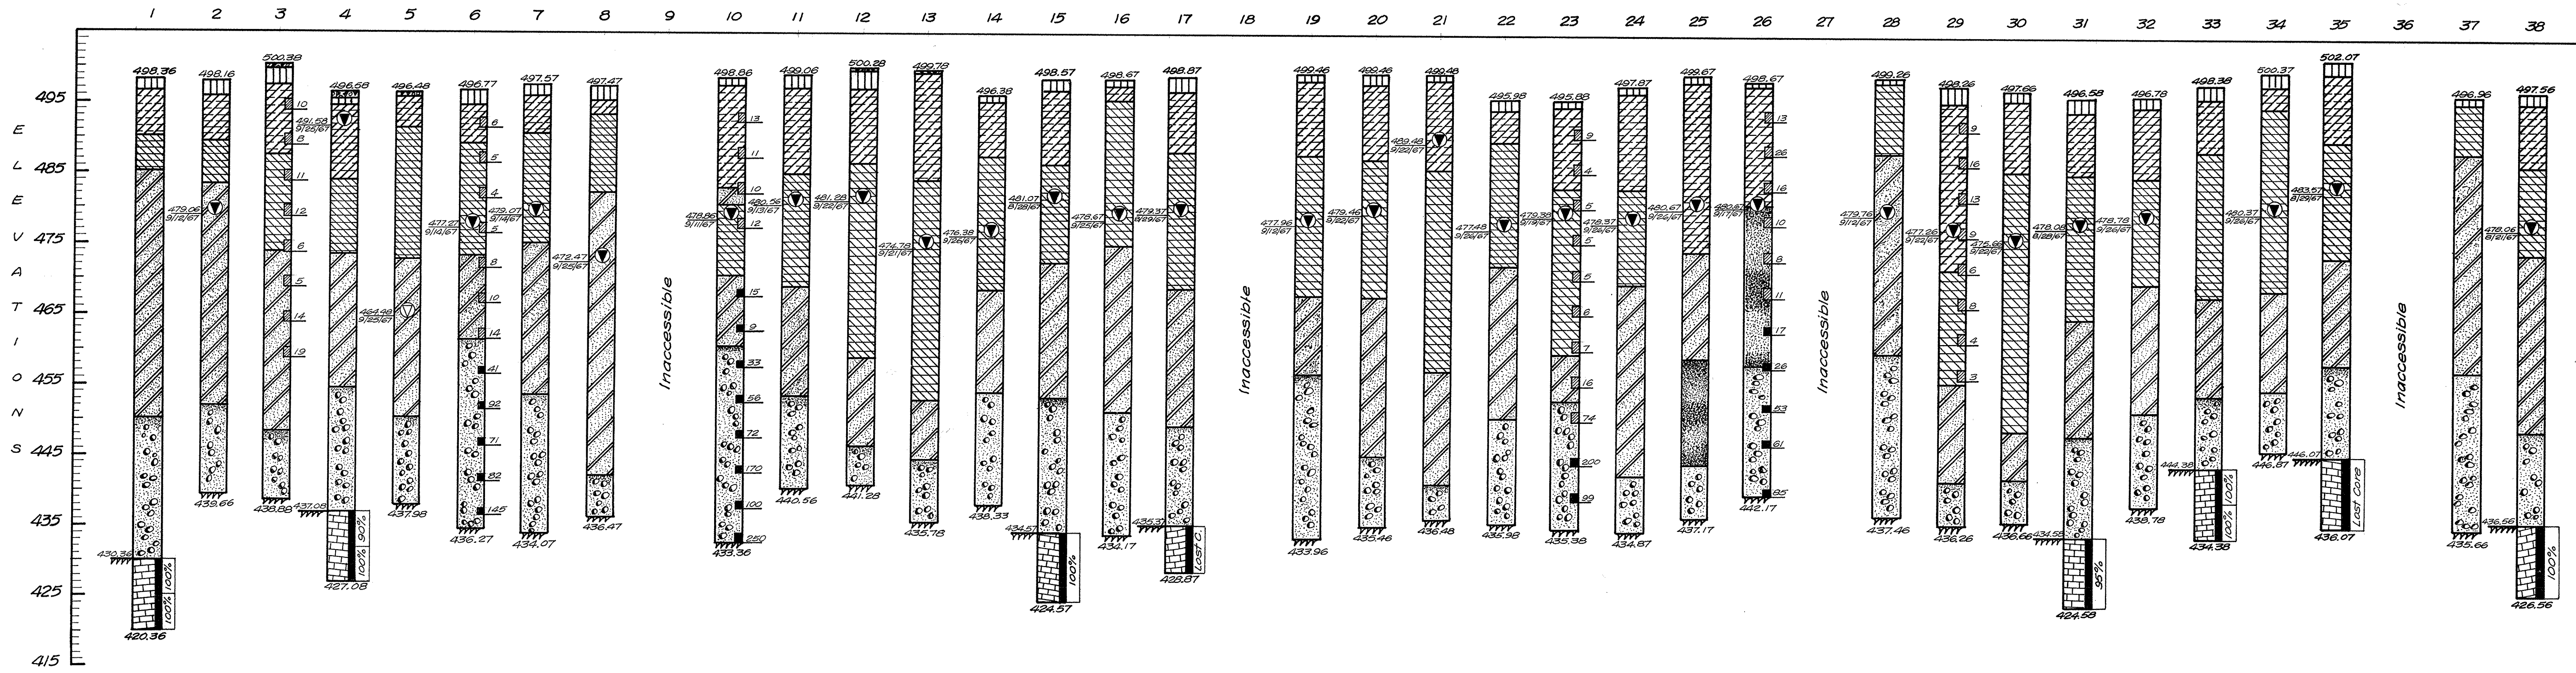

LEGEND OF SYMBOLS


- Elevation and Date on Which Ground Water Found.
- Auger Refusal at Indicated Elevation.
- Core Recovery in Per Cent.
- Tube Penetration Resistance, Blows Per Ft.
- Cone Penetration Resistance, Blows Per Ft.
- Silt
- Clayey Silt
- Fine Sandy Silt
- Silt with Clay
- Fine Sand
- Sand and Gravel
- Sandy Clay with Gravel
- Pavement and Base Material
- Limestone
- Fill

AS BUILT REVISIONS - 6-24-72




LOGS OF BORINGS
SUBSURFACE INVESTIGATION
 L.E. GREGG & ASSOCIATES
 CONSULTING ENGINEERS
 LEXINGTON, KENTUCKY
 DRAWN JCS SEPT 1967


CAPITAL PLAZA DEVELOPMENT PHASE II FRANKFORT, KENTUCKY		
DRAWN BY	LOG OF BORINGS	DATE 10-24-67
CHECKED BY		COMM. NO. 50367
SECTOR NO.	LEE POTTER SMITH, PRITCHETT, HUGG & CARTER ARCHITECTS 314 WILKINSON STREET FRANKFORT, KENTUCKY	ENGINEERS FRANKFORT, KENTUCKY
	COMMONWEALTH OF KENTUCKY DEPARTMENT OF FINANCE - DIVISION OF ENGINEERING FRANKFORT, KENTUCKY	
APPROVED BY	AGENCY HEAD <i>L. J. M. ...</i>	DATE 10-24-67
APPROVED BY	OWNER	DATE
		DRAWING NO. 64 OF 4

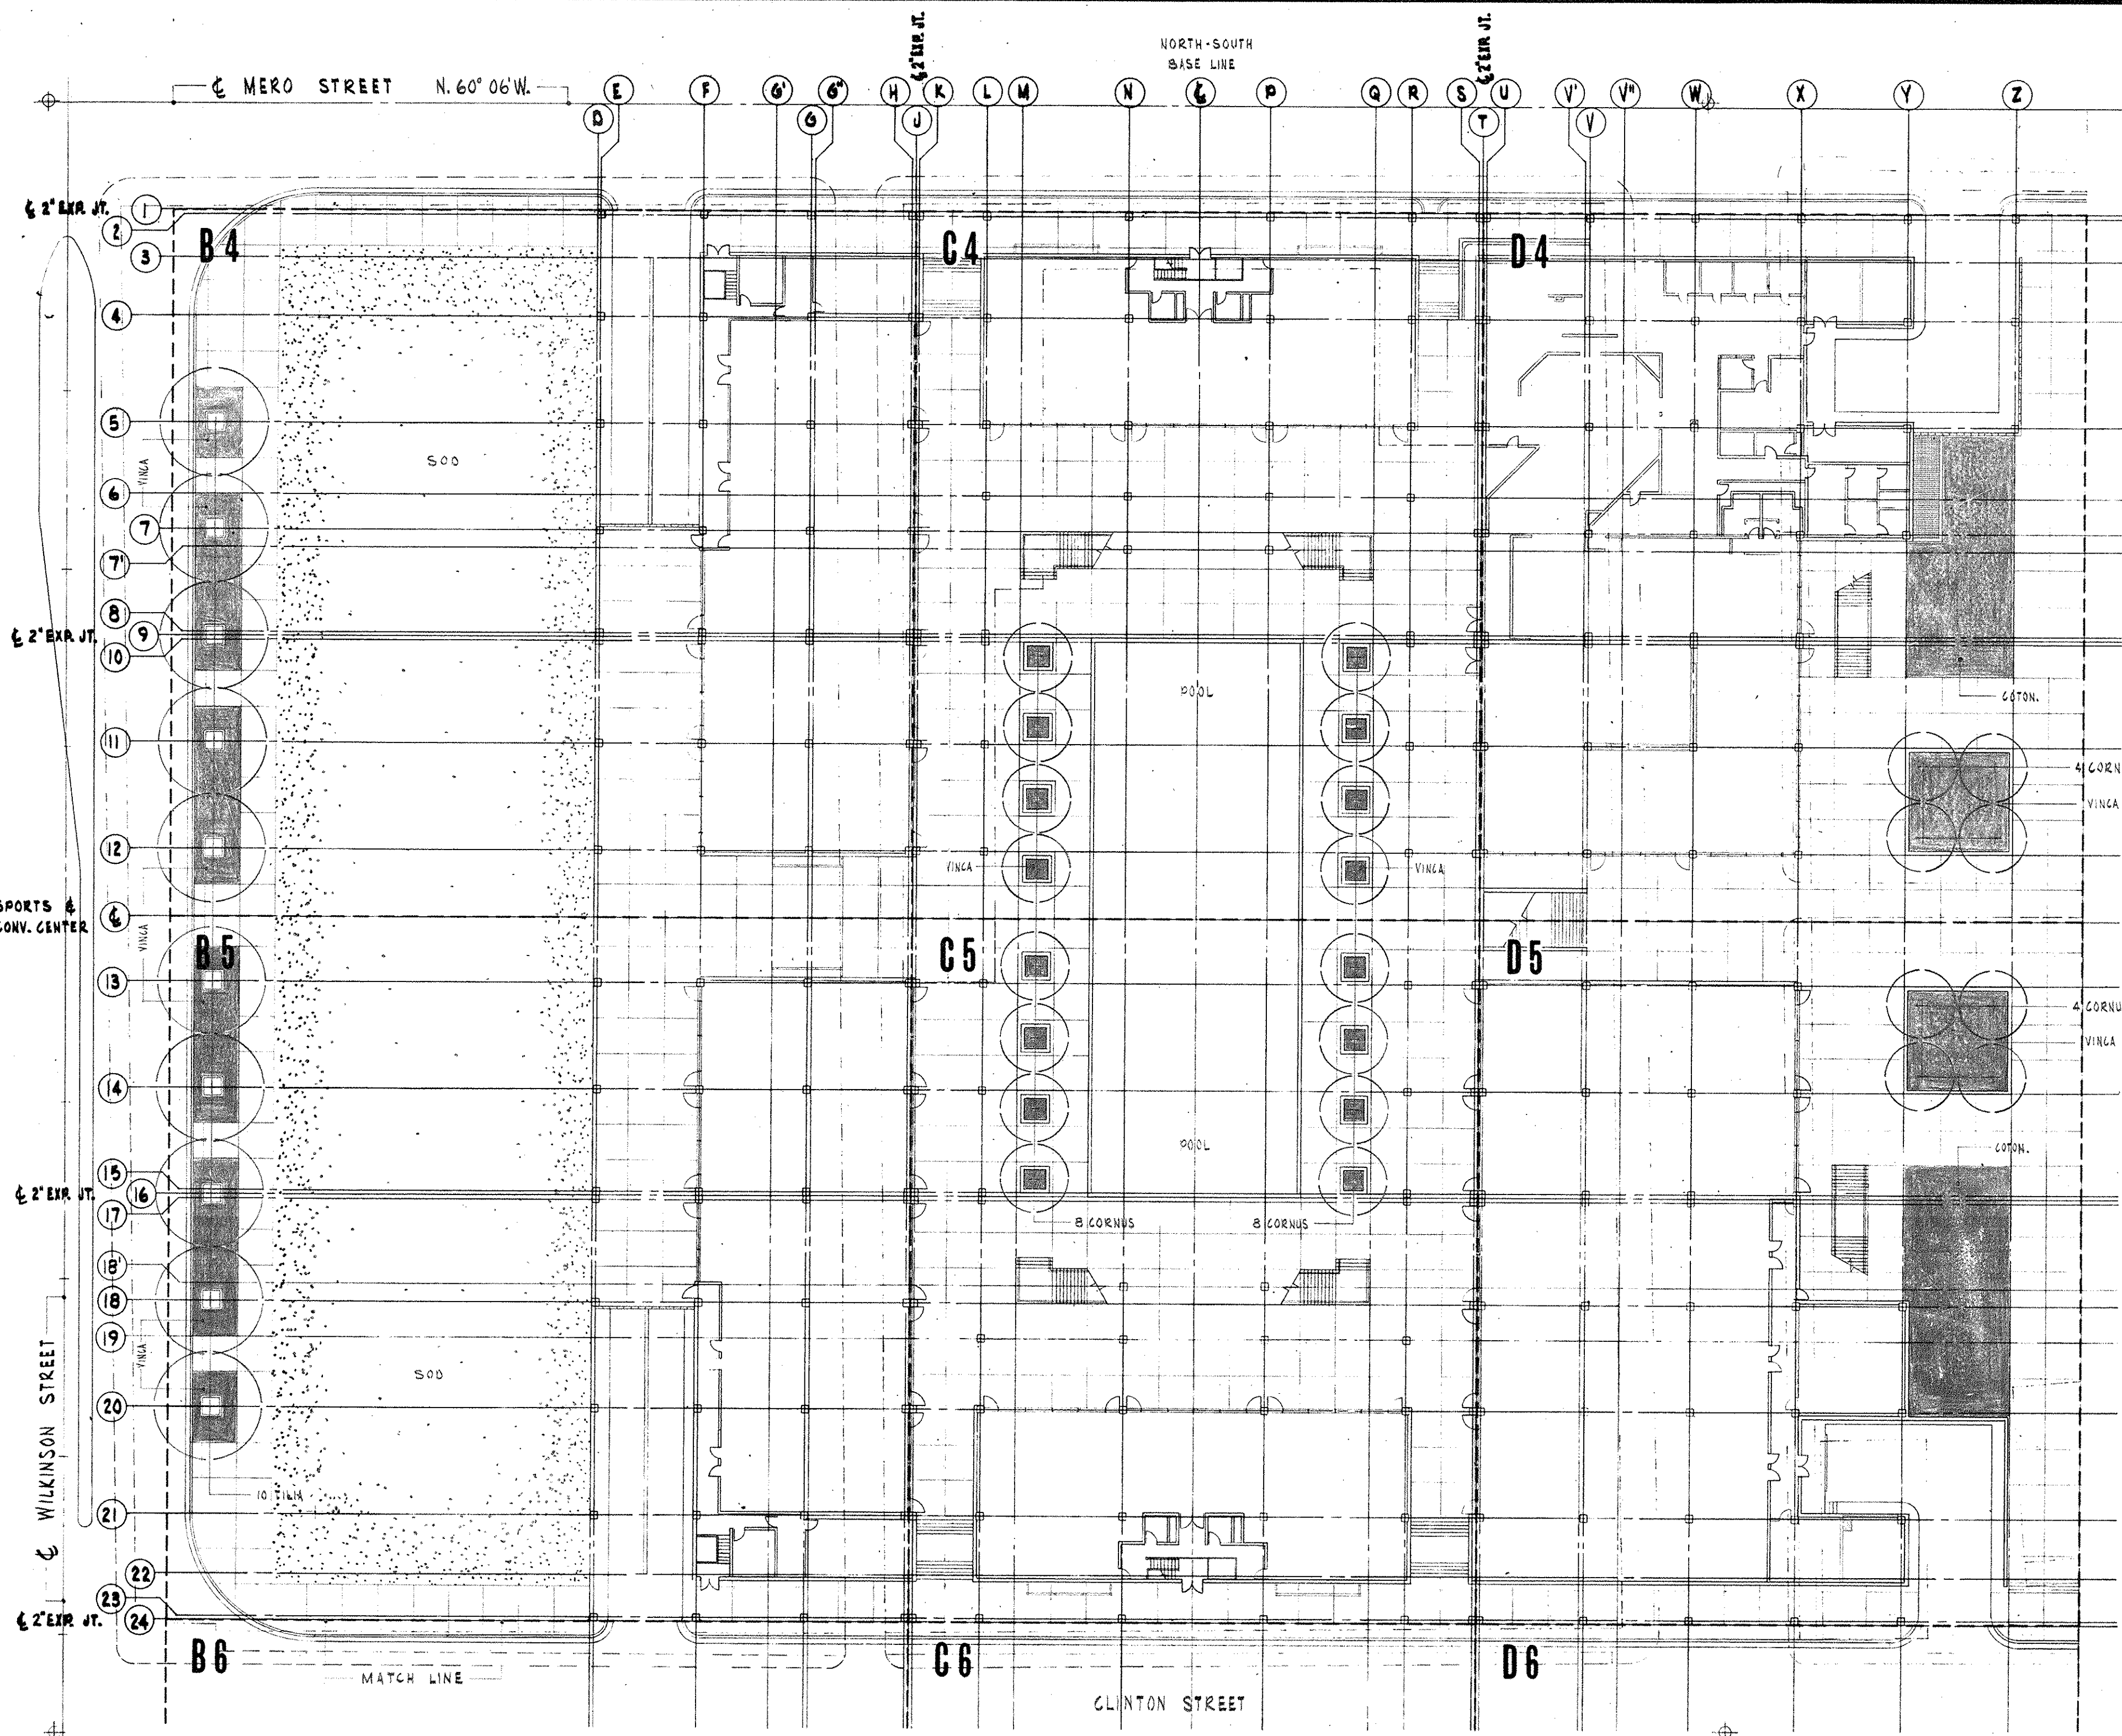


MEZZANINE LEVEL PLANTING PLAN - MERO ST. TO CLINTON ST.
SCALE 1" = 30'-0"

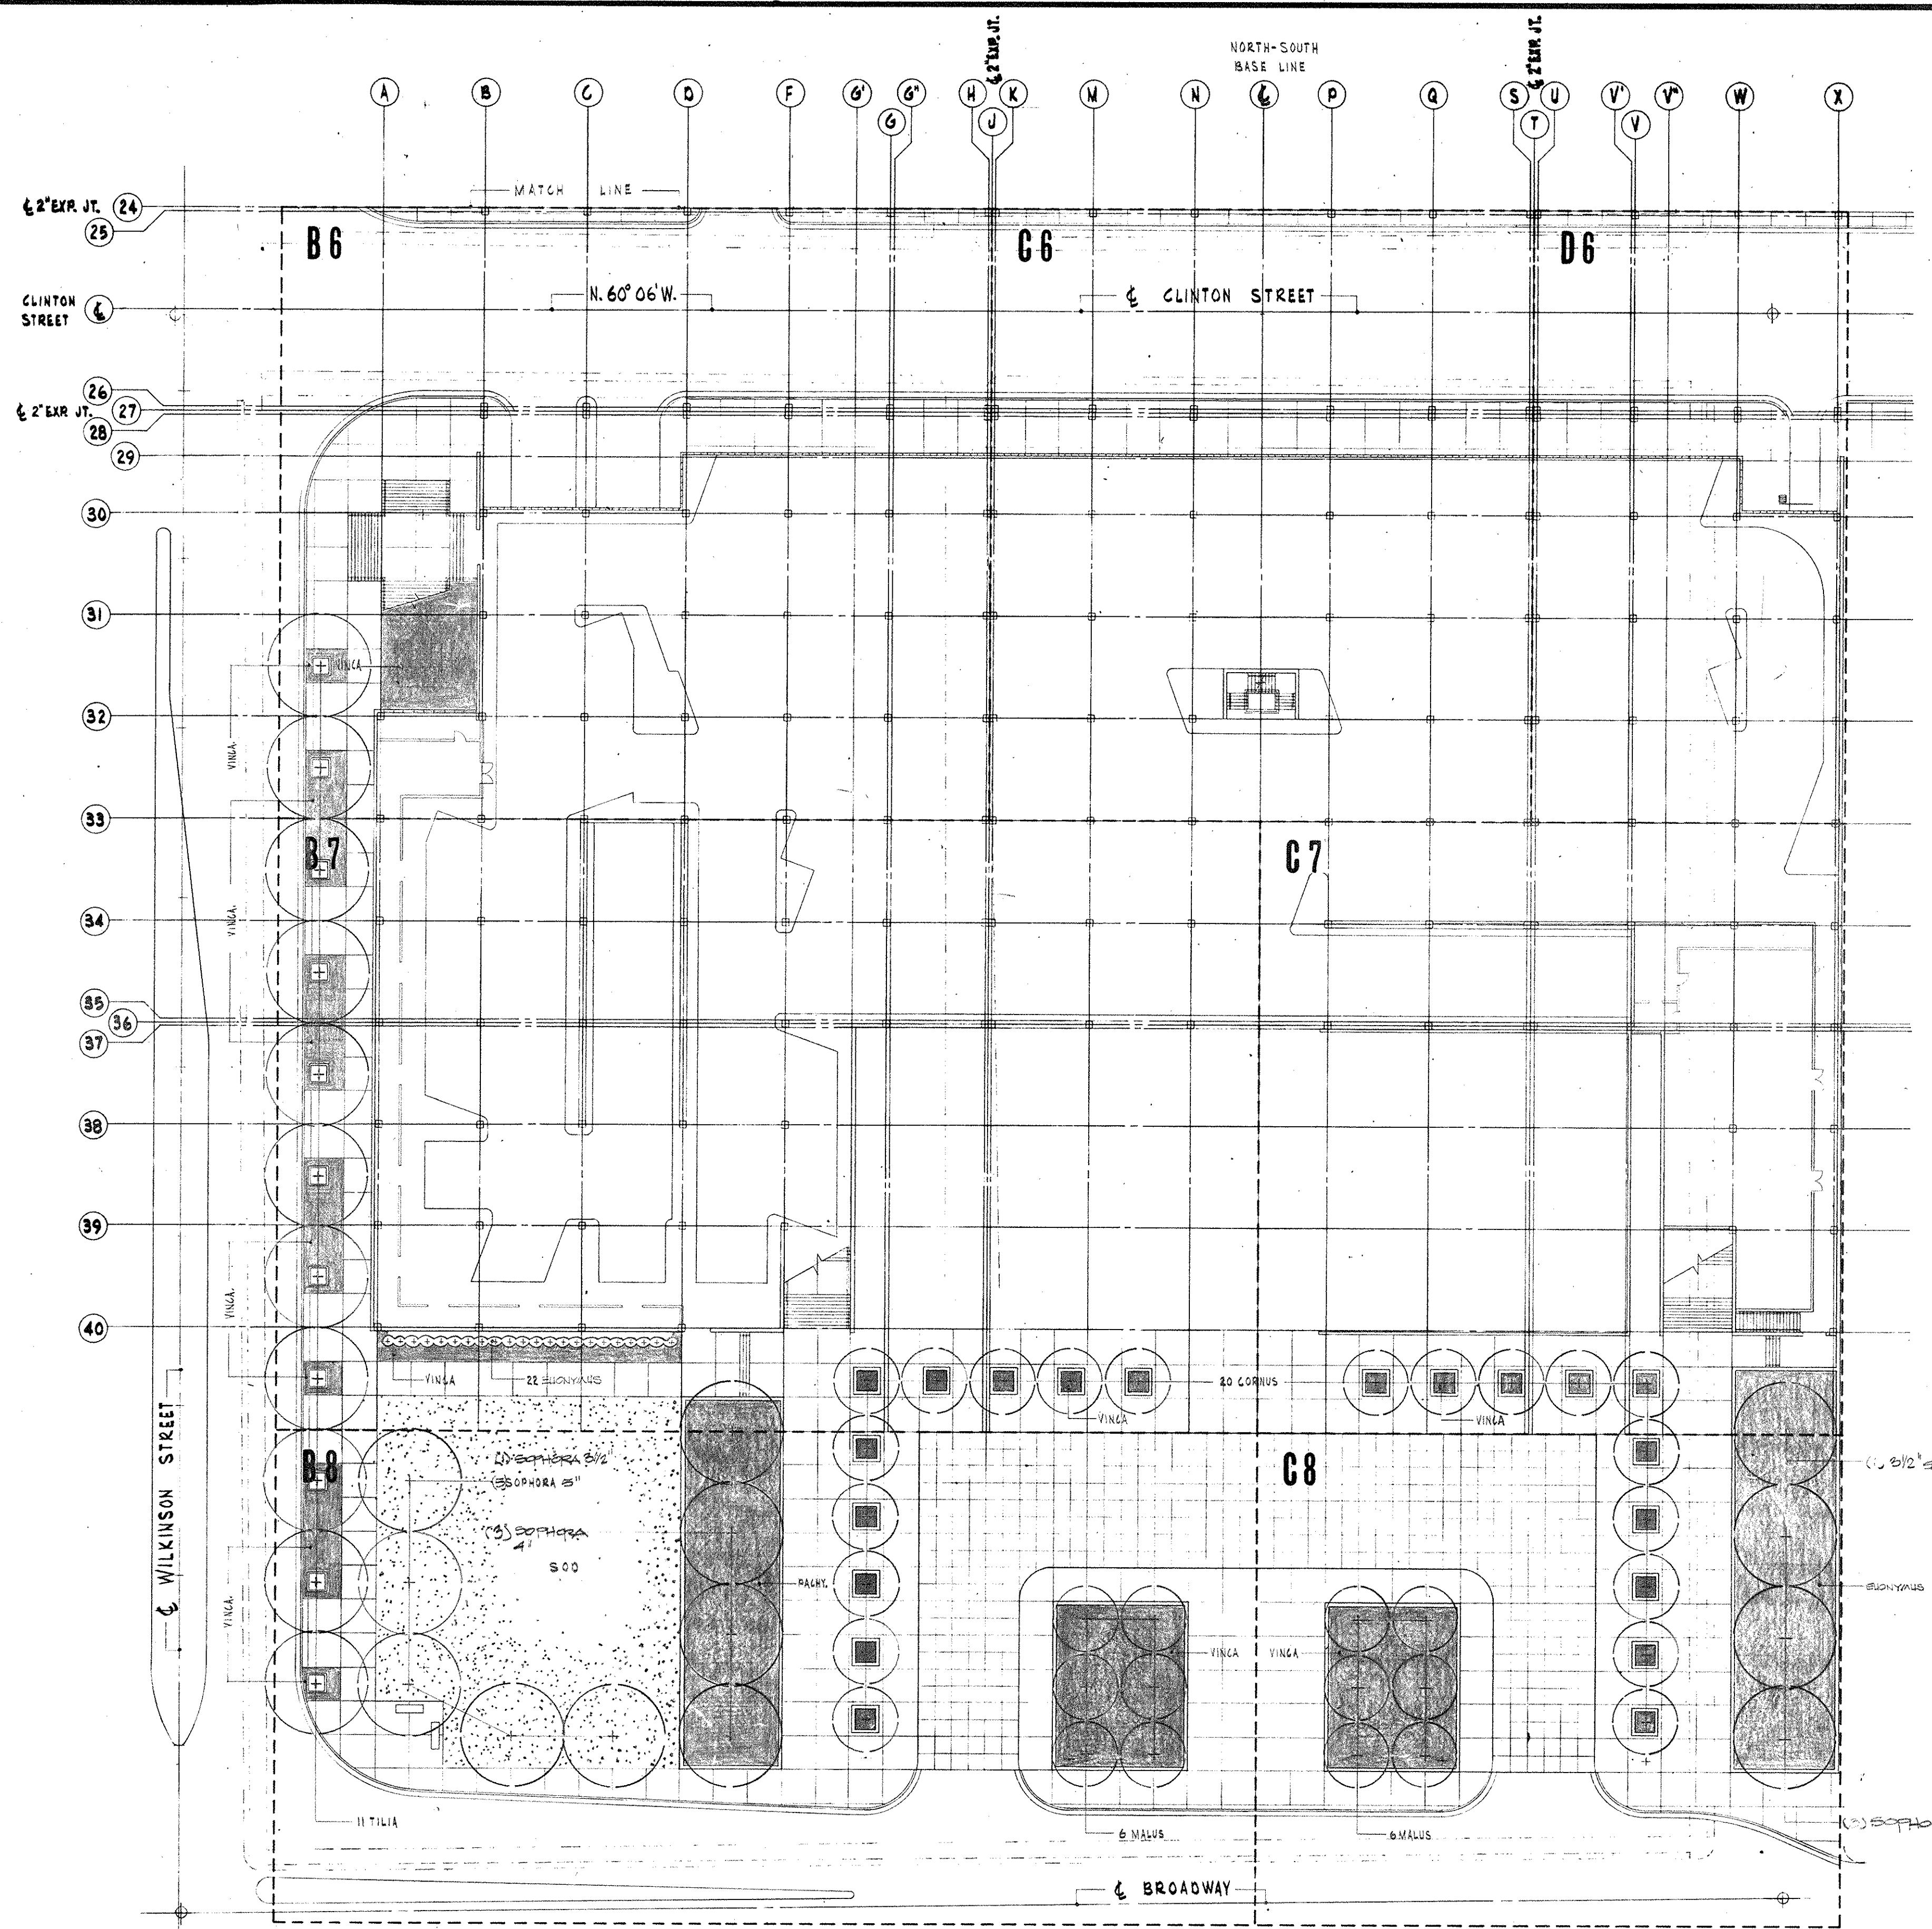


MEZZANINE LEVEL PLANTING PLAN - CLINTON ST. TO BROADWAY
SCALE 1" = 30'-0"

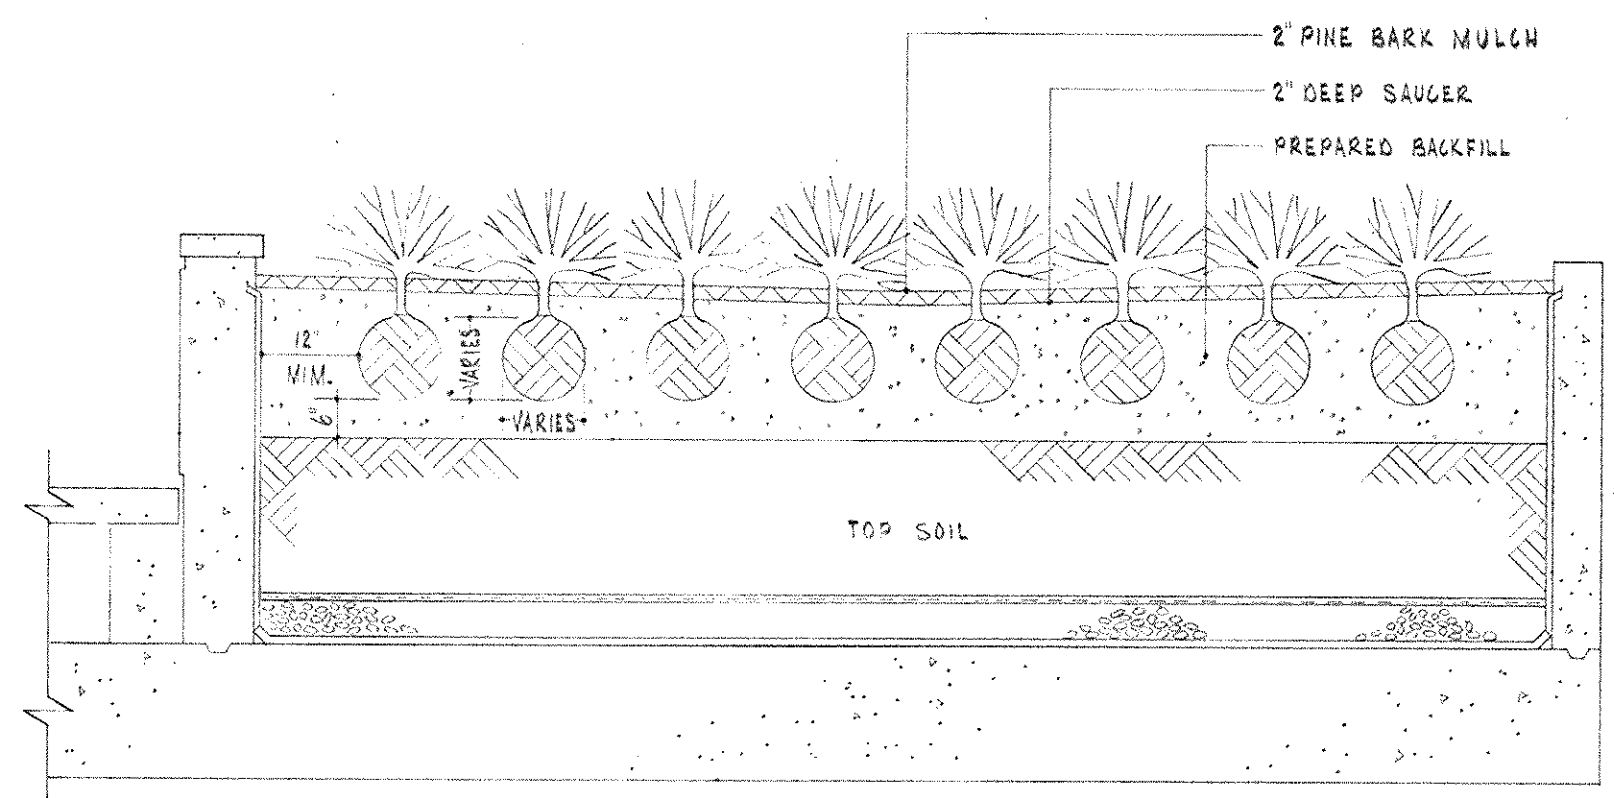



SHRUB PLANTING DETAIL
NOT TO SCALE

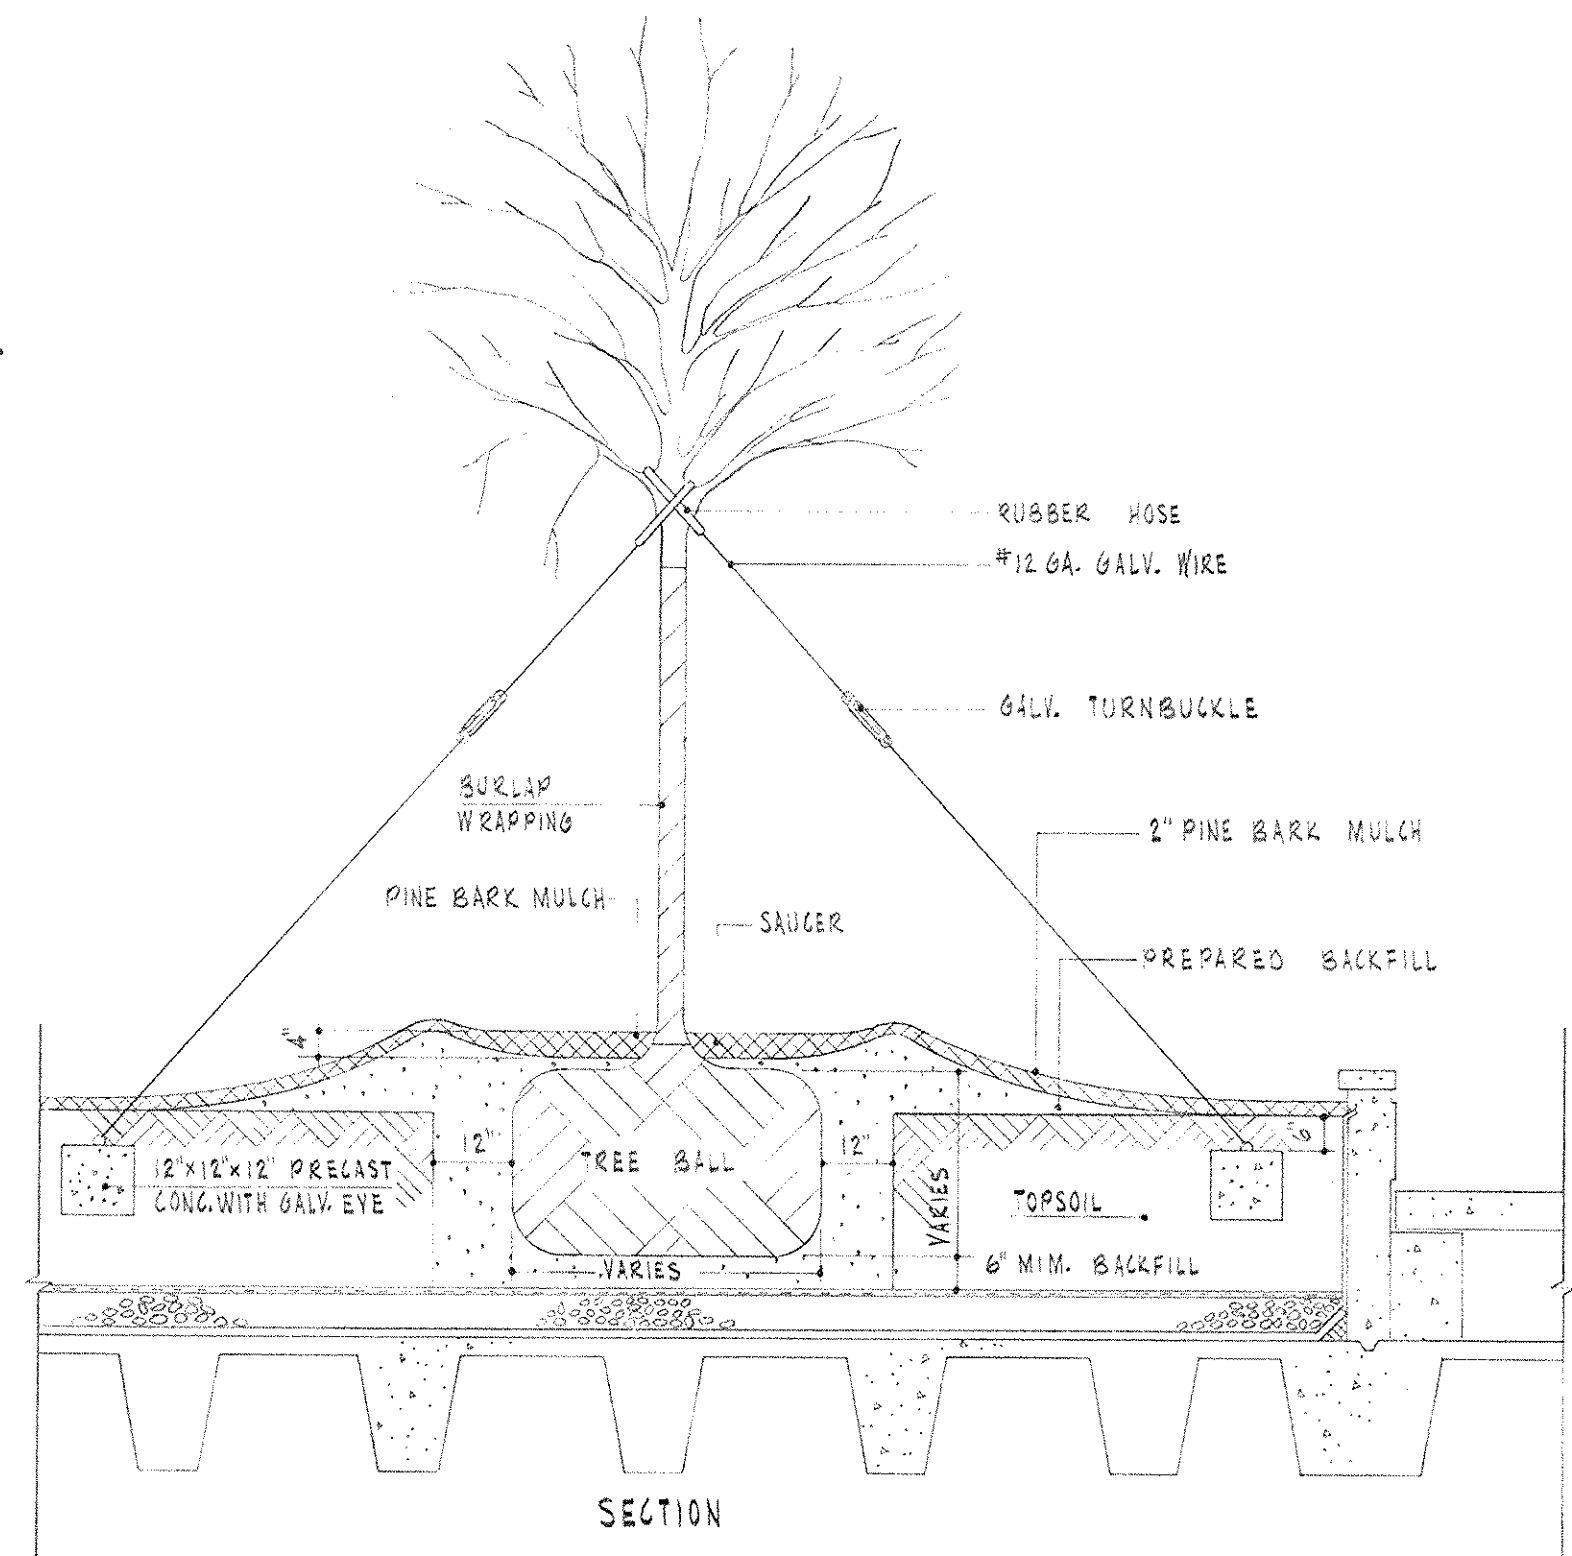

TREE PLANTING DETAILS
NOT TO SCALE

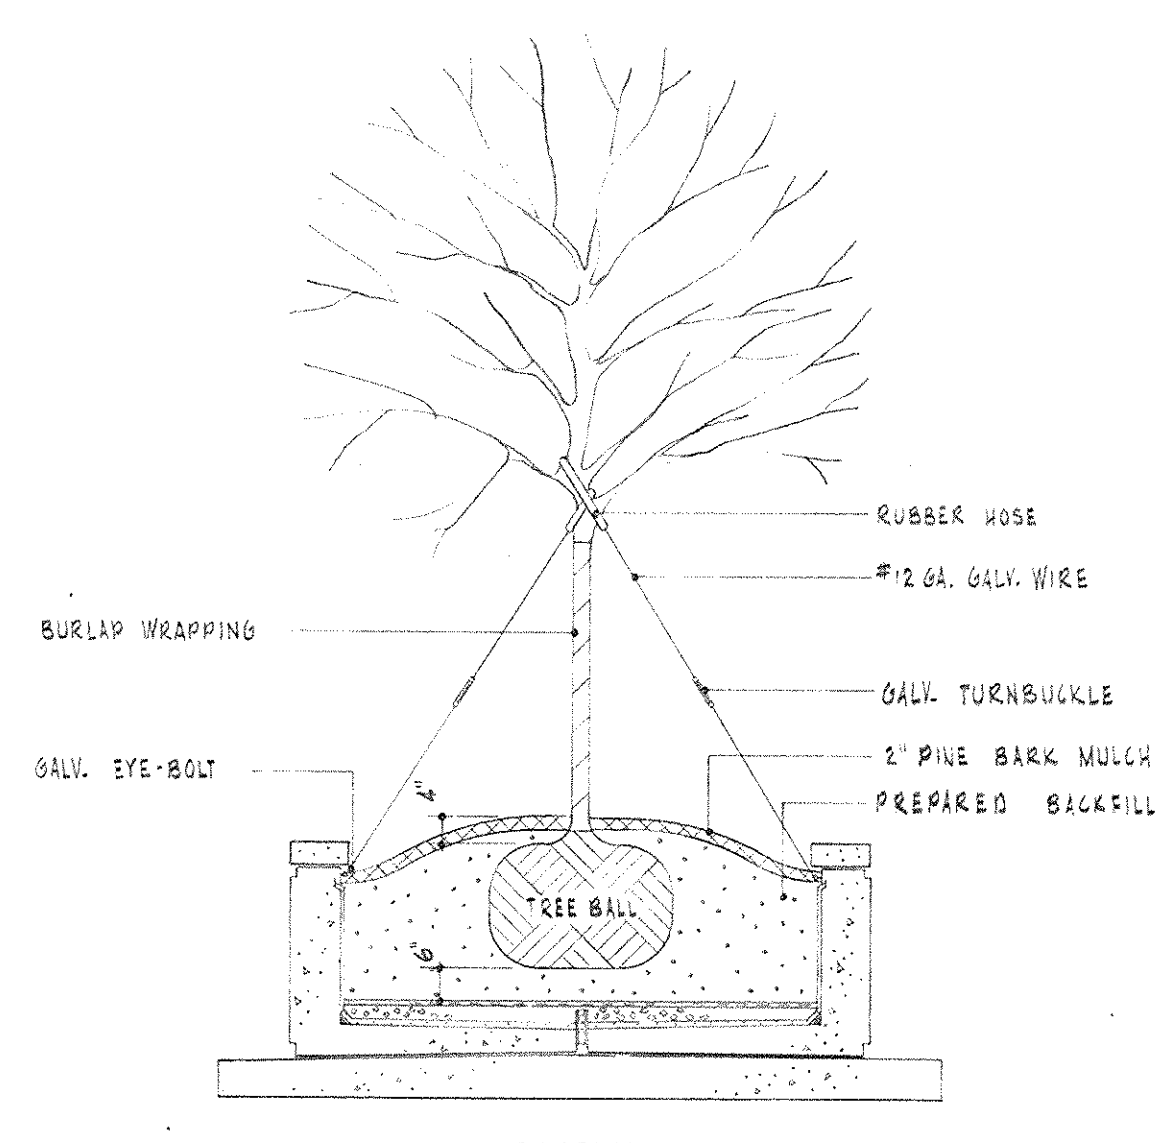



TREE PLANTING DETAILS FOR PRECAST UNIT
NOT TO SCALE

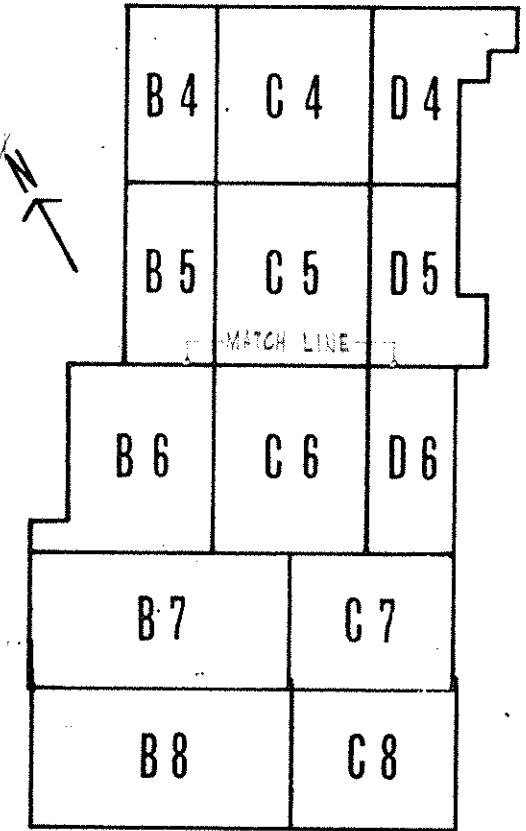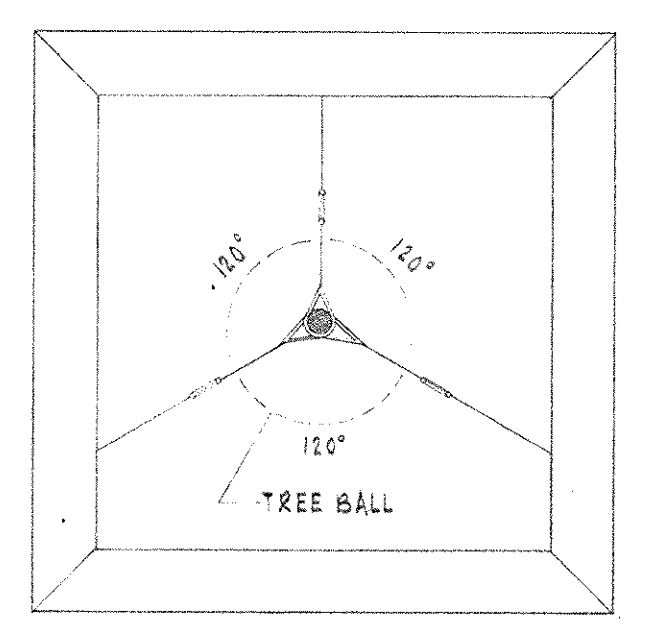

KEY PLAN

ASBULT REYNOLDS - S. 20-72
NOTE: SEE LEGEND & SCHEDULE, SHEET 1-1

CAPITAL PLAZA DEVELOPMENT PHASE II		
FRANKFORT, KENTUCKY		
DRAWN BY CPT	REGISTERED 338 LANDSCAPE ARCHITECT	DATE 12 OCT. 1967
CHECKED BY LSC	LANDSCAPE - MEZZANINE LEVEL	COMM. NO. 50357
SECTOR NO.	LEE POTTER SMITH, PRITCHETT, HUGG & CARTER ARCHITECTS 314 WILKINSON STREET FRANKFORT, KENTUCKY	DRAWING NO. L 1
ALL	COMMONWEALTH OF KENTUCKY DEPARTMENT OF FINANCE - DIVISION OF ENGINEERING FRANKFORT	OF 1-2.
APPROVED BY CPT	AGENCY HEAD W. M. Connel	DATE 10-26-67
APPROVED BY	OWNER	

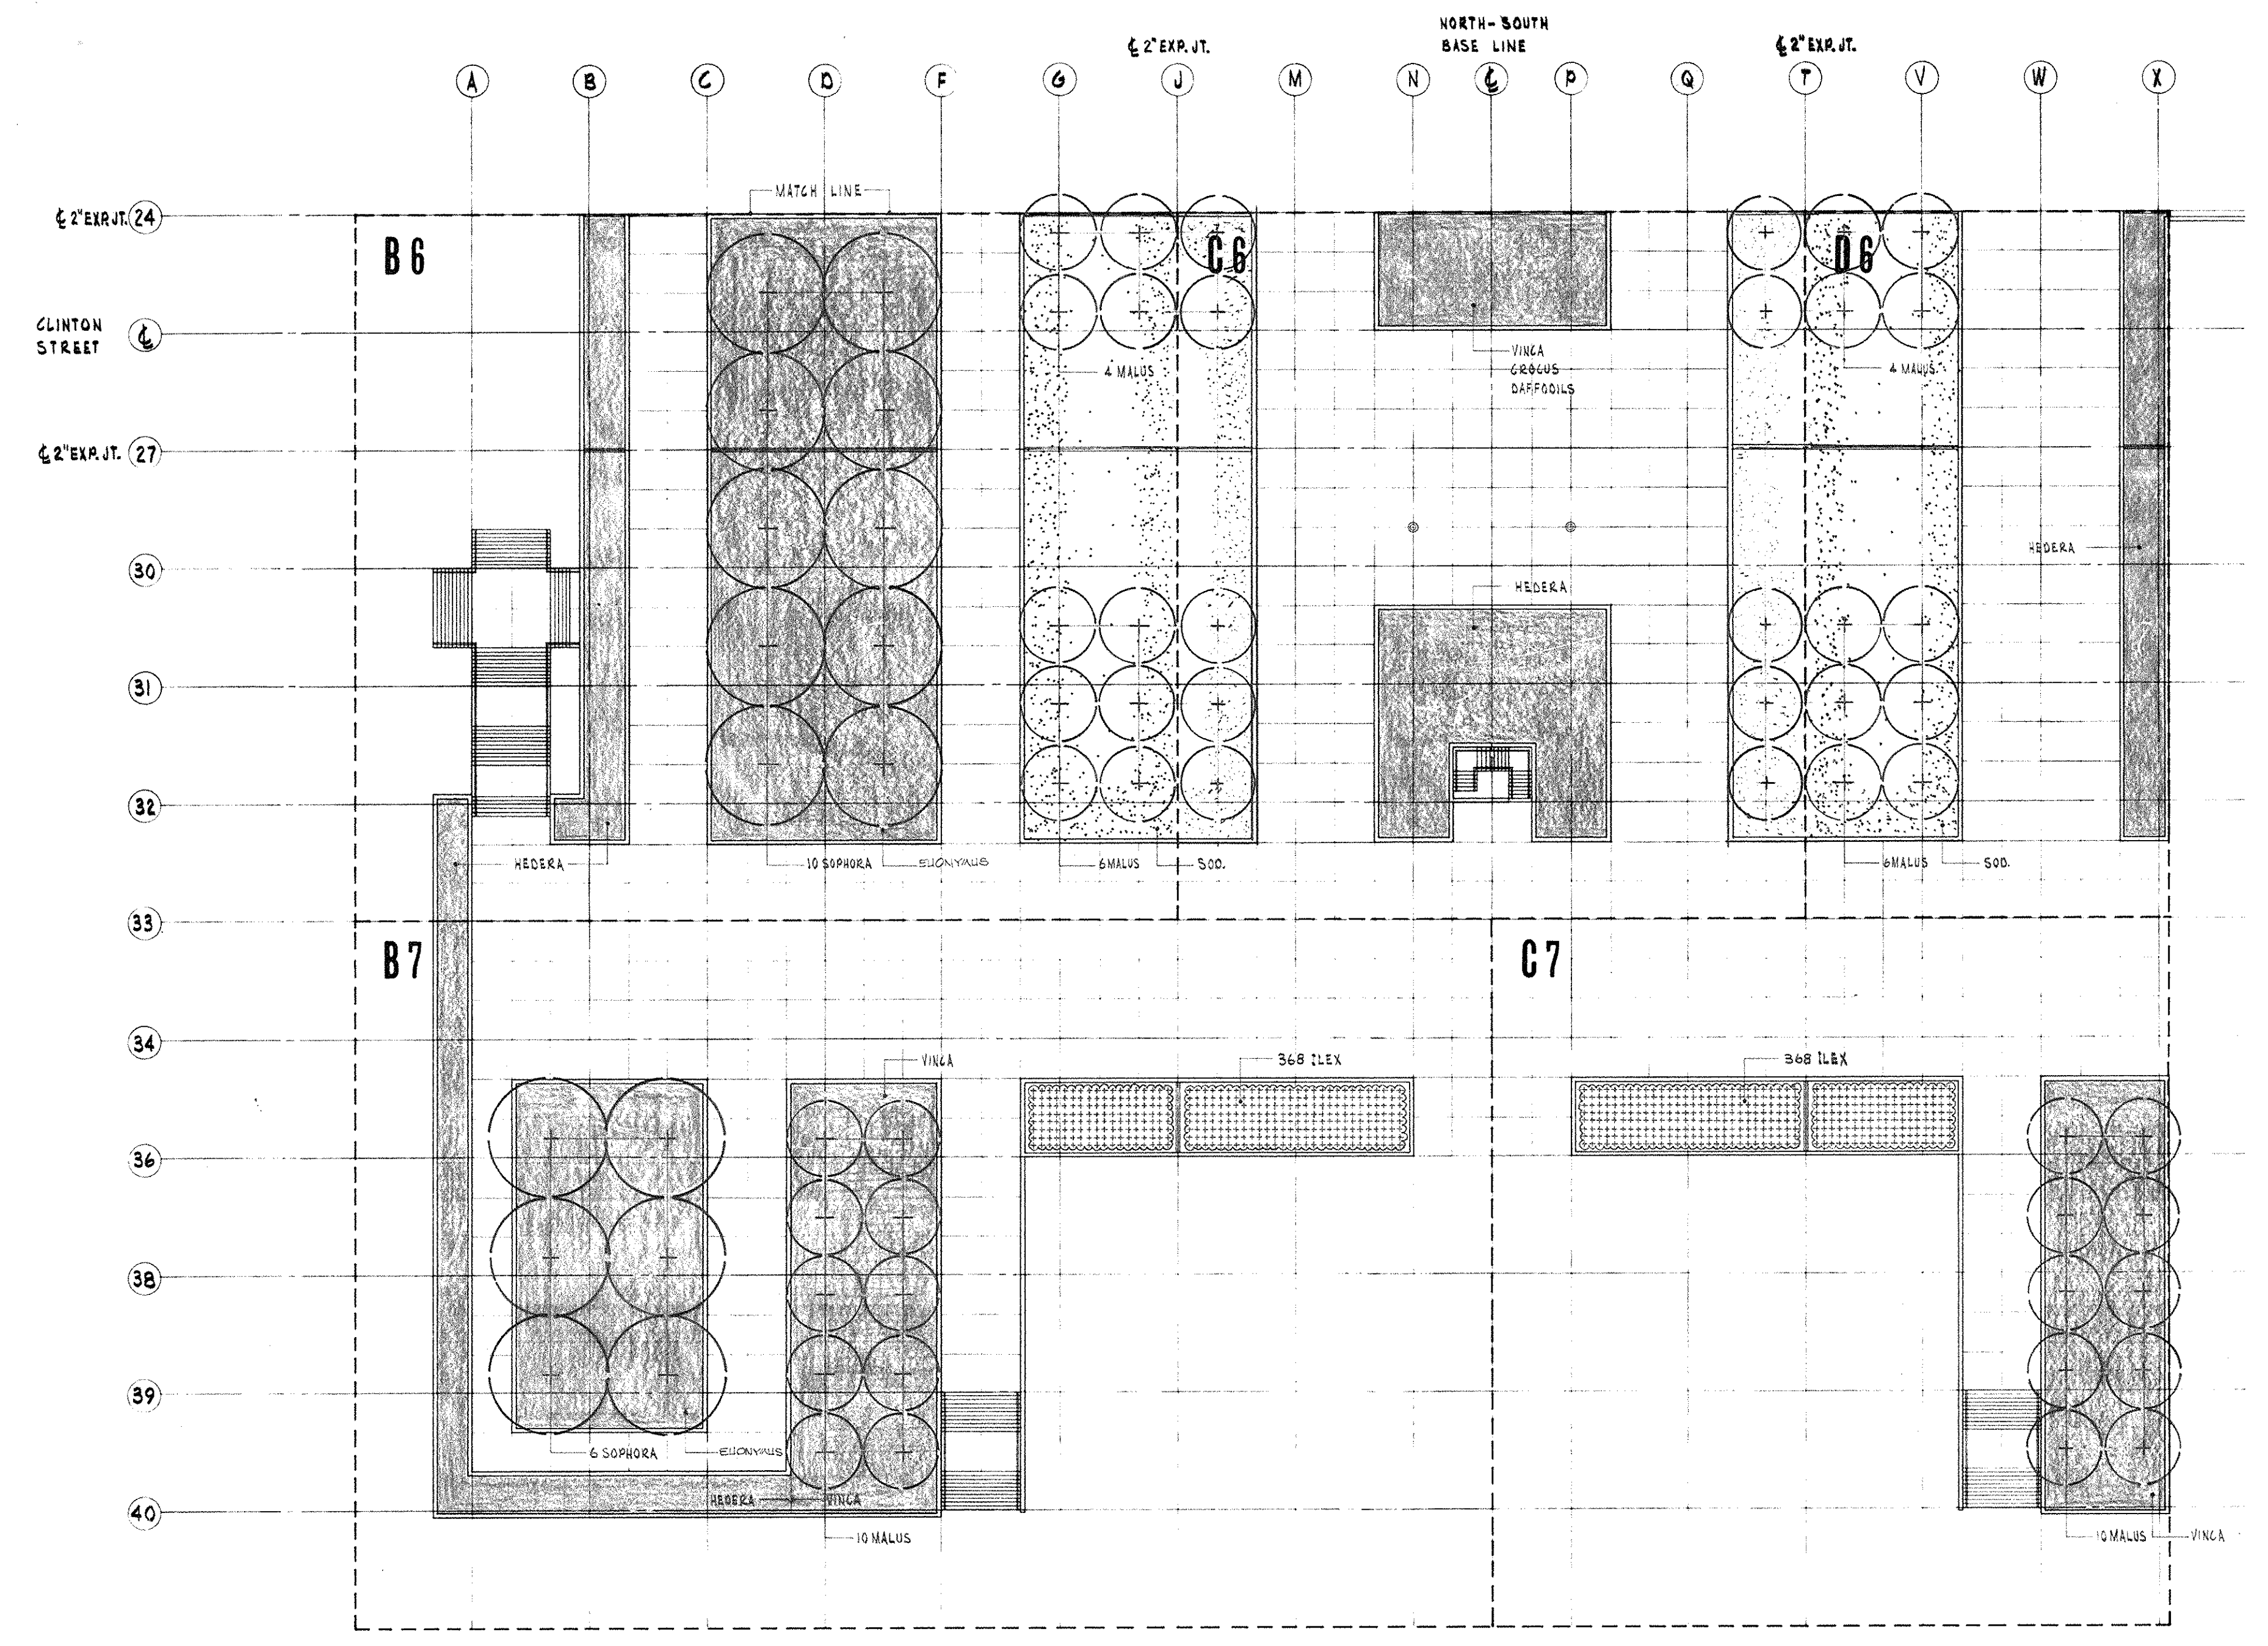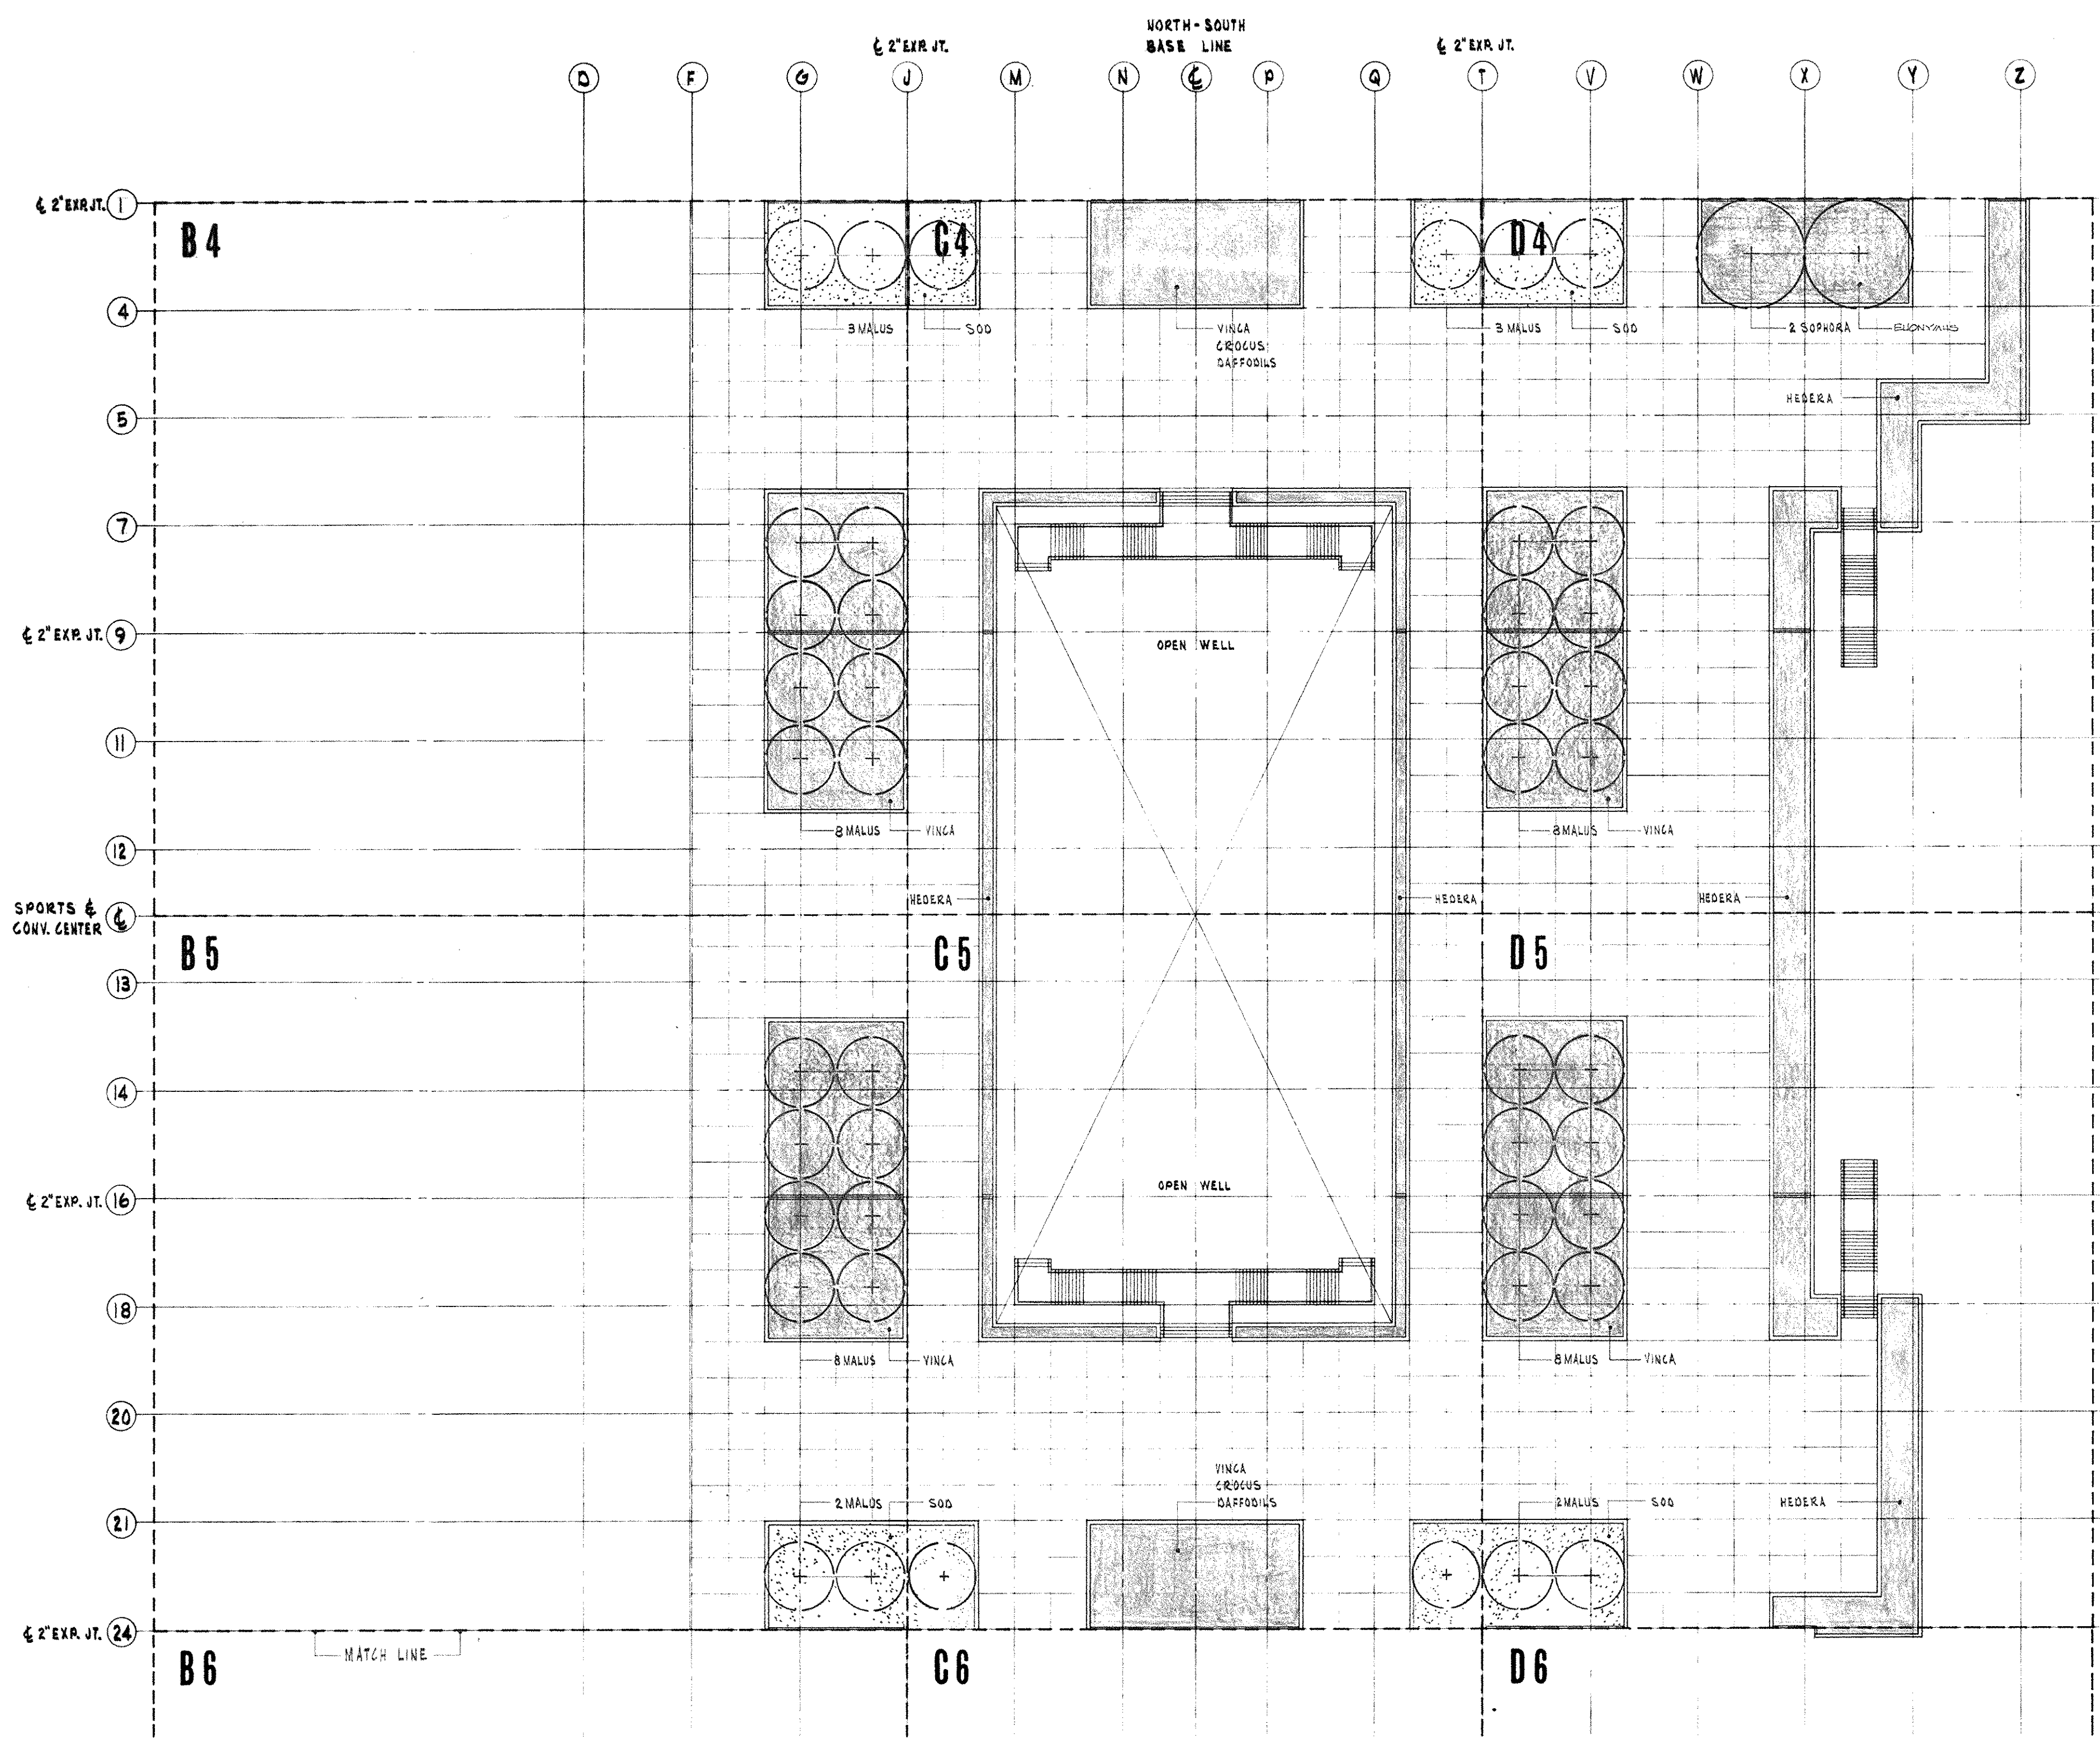



PLAZA LEVEL - PLANTING PLAN
SCALE 1"=30'-0"

PLAZA LEVEL - PLANTING PLAN
SCALE 1"=30'-0"

PLANTING LEGEND

- NEW TREES
- SHRUB BEDS
- GROUND COVER
- SODDING

PLANTING SCHEDULE					
QUANTITY	ABBREVIATION	BOTANICAL NAME	SIZE	BALL SIZE	SPACING
20	TILIA	TILIA CORDATA	6"-5 1/2" CAL.	55"W. x 37"D.	45 SHORN
10	SOPHORA	SOPHORA JAPONICA	5 1/2"-5 1/2" CAL.	55"W. x 37"D.	"
2	"	"	4" SOD	"	"
44	CORNUS	CORNUS FLORIDA RUBRA	2 1/4"-3" CAL.	30"W. x 20"D.	"
94	MALUS	MALUS FLORIBUNDA	2 1/4"-3" CAL.	28"W. x 16"D.	"
68043	HEDERA	HEDERA HELIX	2 YR. GROWTH	BARE SOOT	8" O.C.
26046	BUCHENAVIA	BUCHENAVIA COLONICATA	"	"	"
76498	VINCA	VINCA MINOR	"	"	"
8979	COTON	COTONEASTER HORIZONTALIS	12" HIGH	1 GAL. CAN	8" O.C.
786	ILEX	ILEX CORNATA COMENI	18"14" x 18"14"	1 1/2" x 1 1/2" J GAL. CAN	45 SHORN
32	HYDRANTHA	HYDRANTHA COCCINEA LALANDI	14" x 30" x 14"	1 GAL. CAN	"
492	CROCUS	CROCUS CHRYSANTHUS	TOP SIZE	9 CM. - UP	RANDOM
492	DAFFODILS	DAFFODILS - KING ALFRED	TOP SIZE	DOUBLE NOSE	"

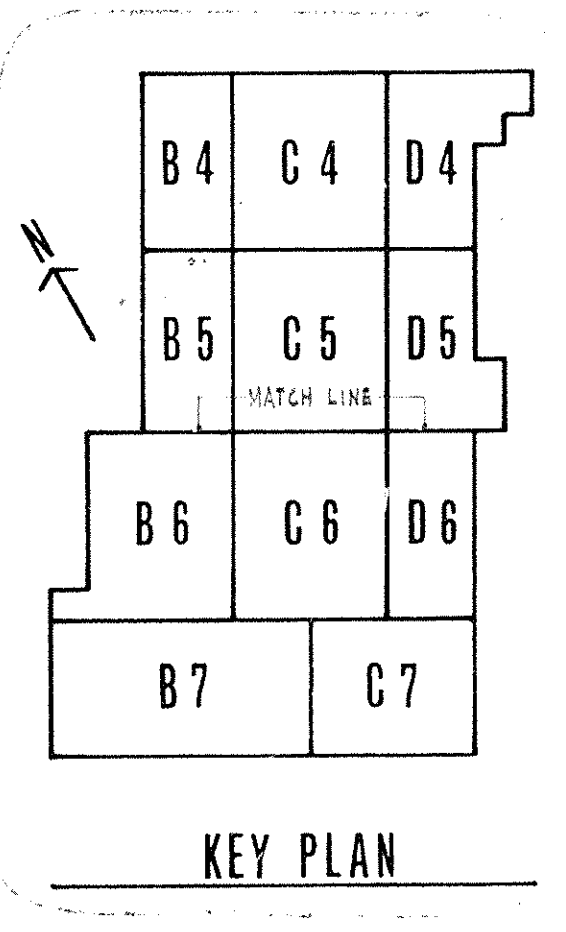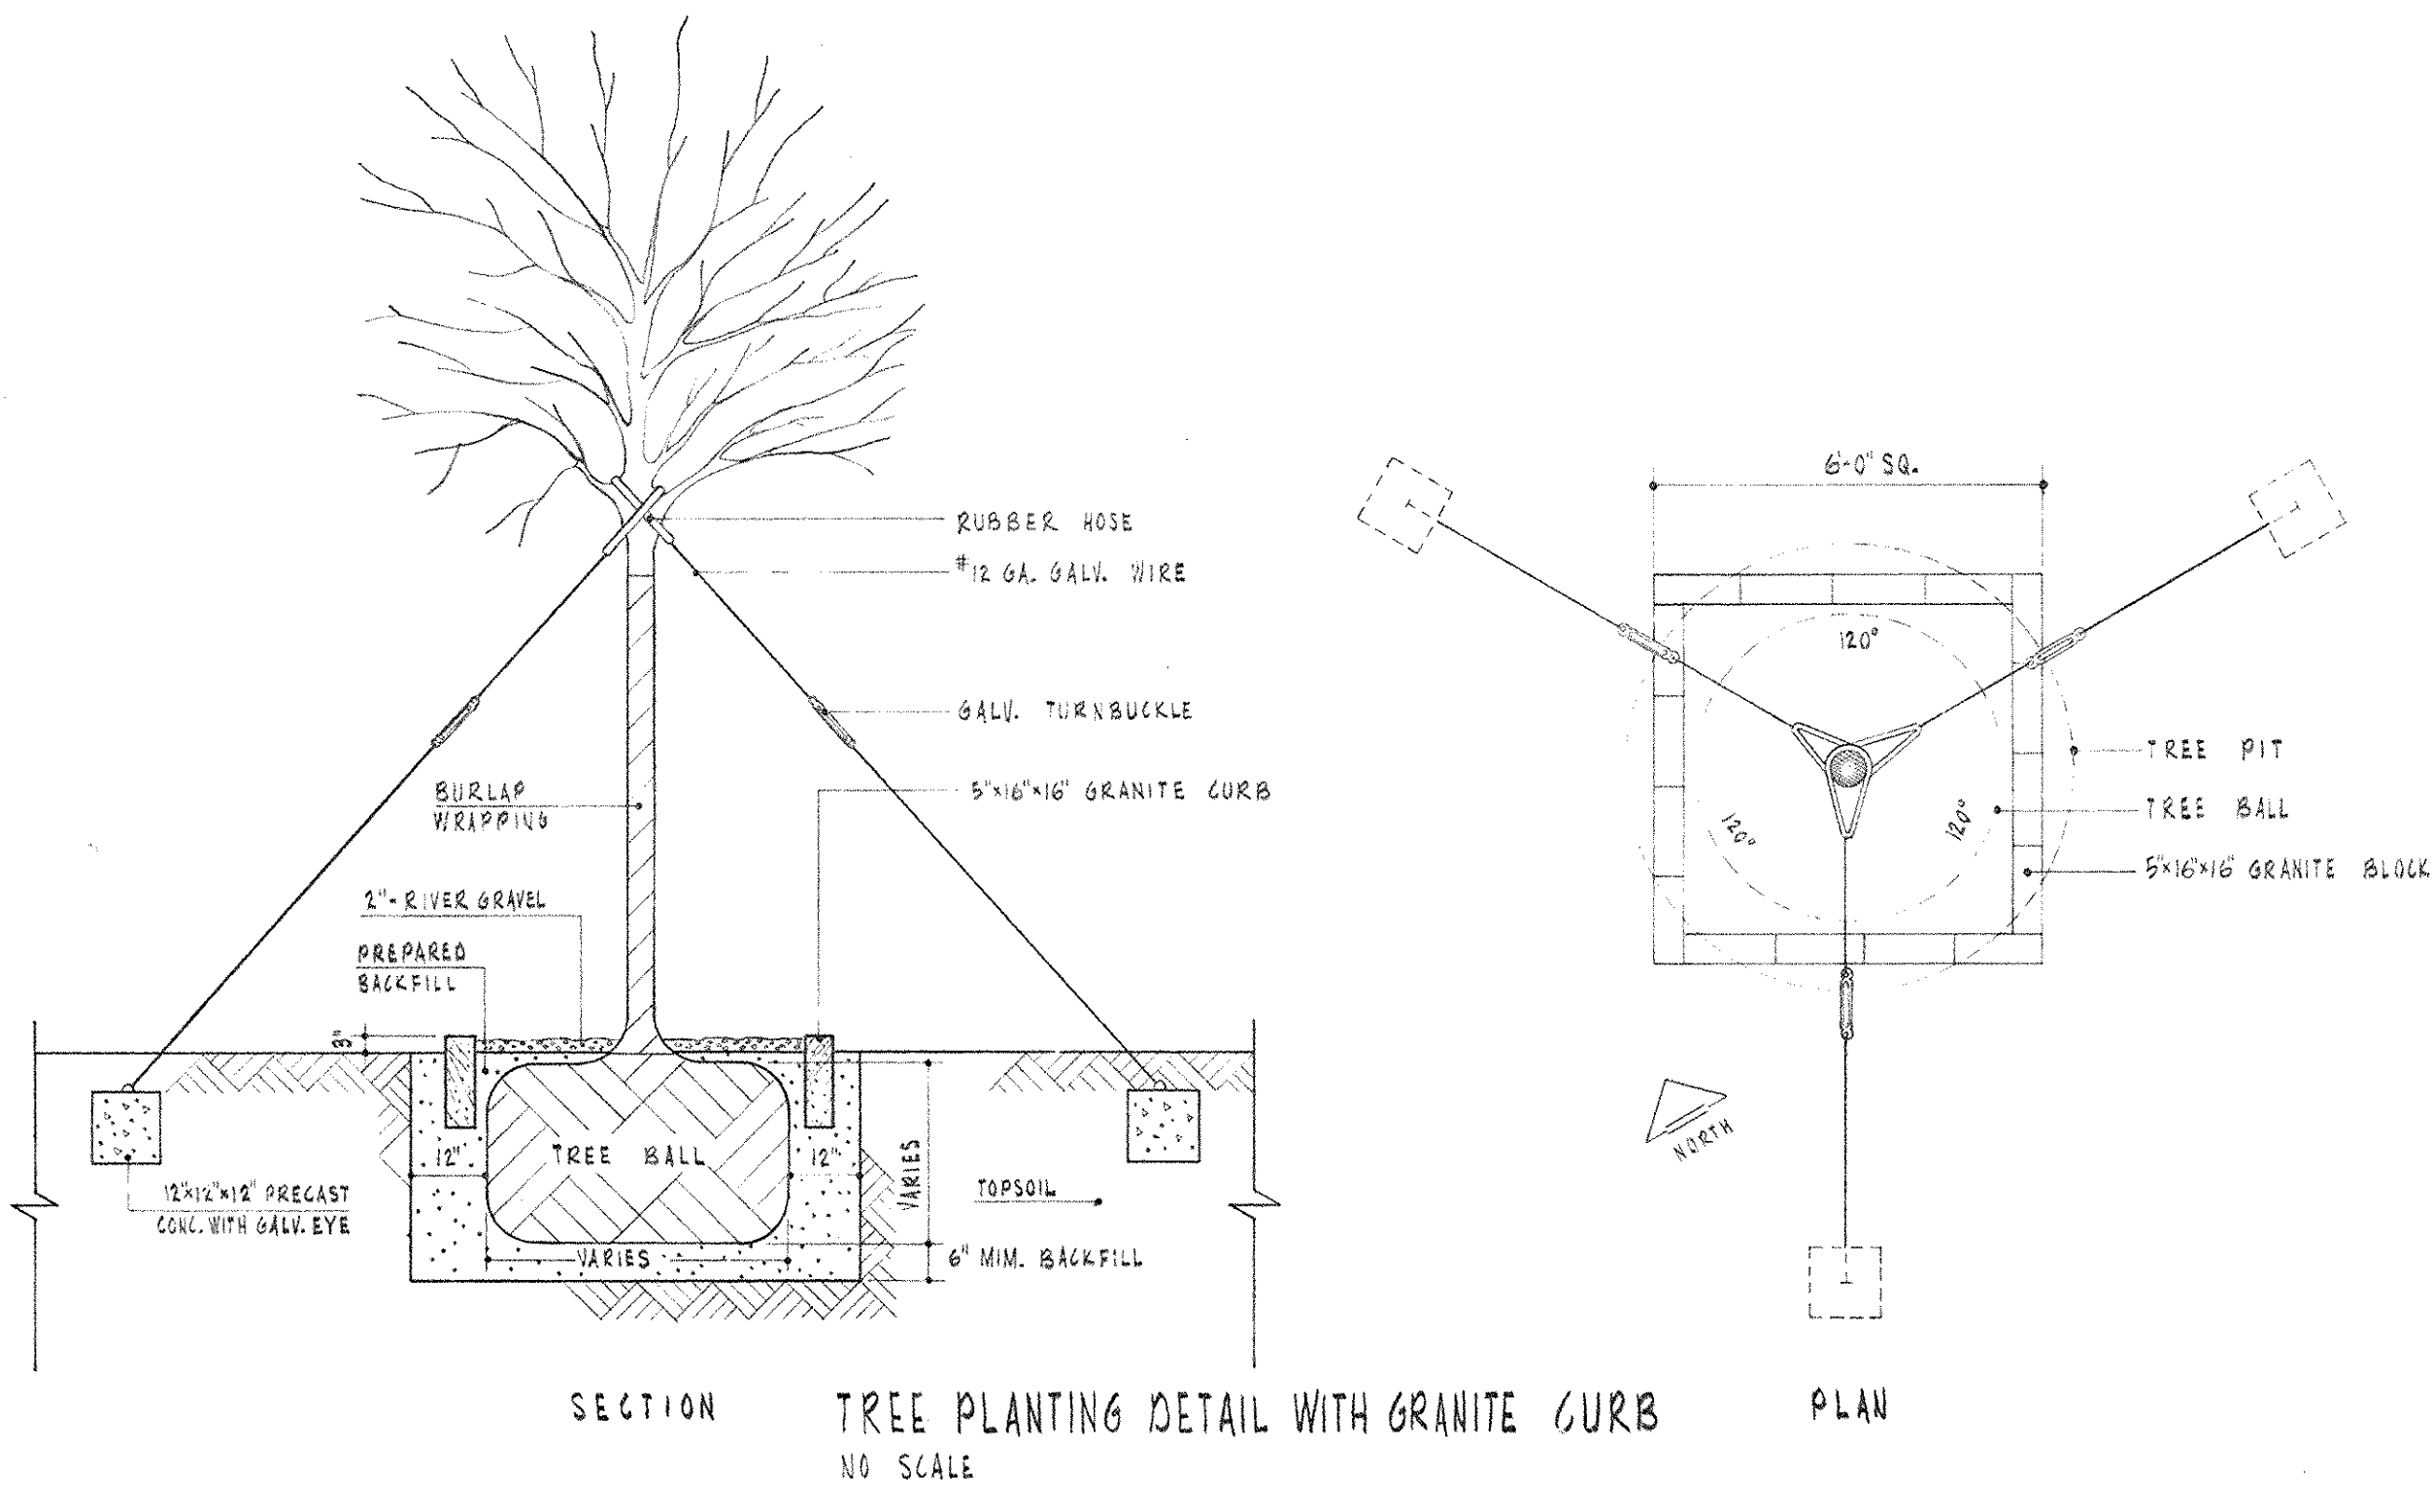


AS BUILT REVISIONS - 8-21-72


CAPITAL PLAZA DEVELOPMENT PHASE II
FRANKFORT, KENTUCKY

DRAWN BY C.W.	REGISTERED NO. 338	DATE 10 OCT. 1967
CHECKED BY L.P.H.	COMMONWEALTH OF KENTUCKY ARCHITECT	COMM. NO. 50367
SECTOR NO.	LEE POTTER SMITH, PRITCHETT, HUGG & CARTER ARCHITECTS 314 WILKINSON STREET FRANKFORT, KENTUCKY	DRAWING NO. L 2
APPROVED BY AGENCY HEAD <i>W. J. Mc Connell</i>	COMMONWEALTH OF KENTUCKY DEPARTMENT OF FINANCE - DIVISION OF ENGINEERING FRANKFORT	DATE 10-26-67
APPROVED BY OWNER		OF L. 2.




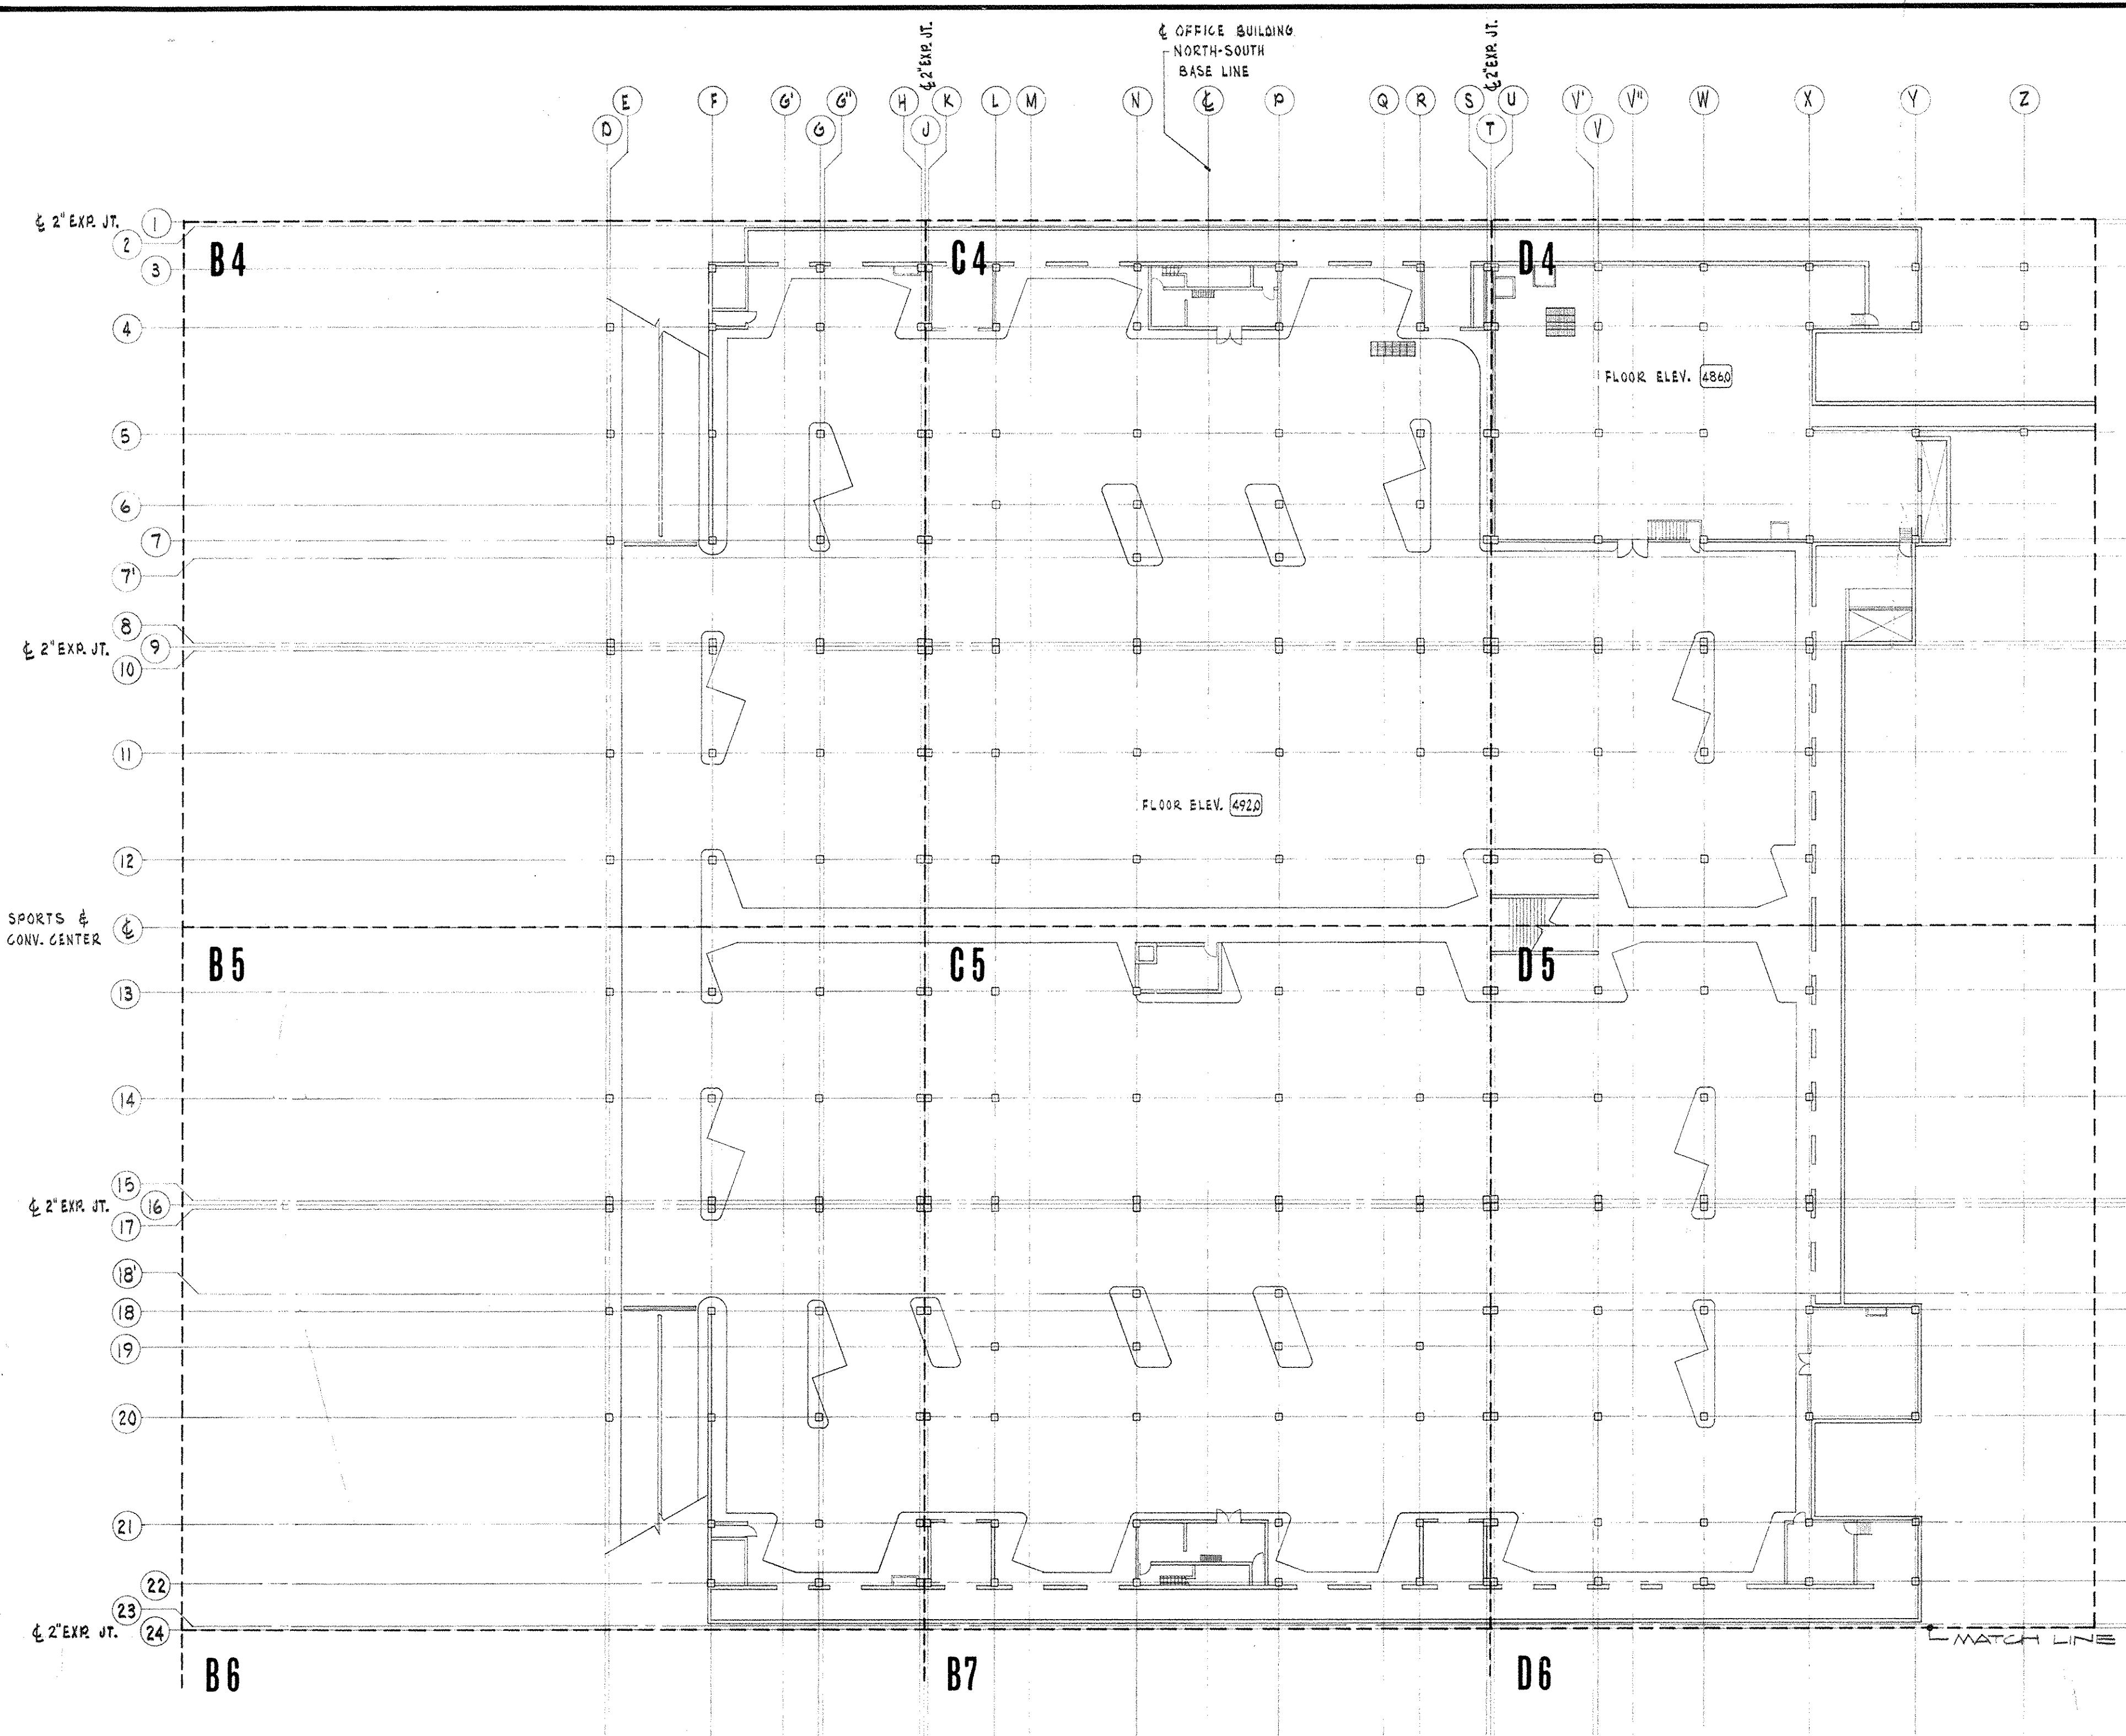

SECTOR MASTER - GROUND LEVEL - MERO ST. TO CLINTON ST.
SCALE 1/8" = 30'-0"

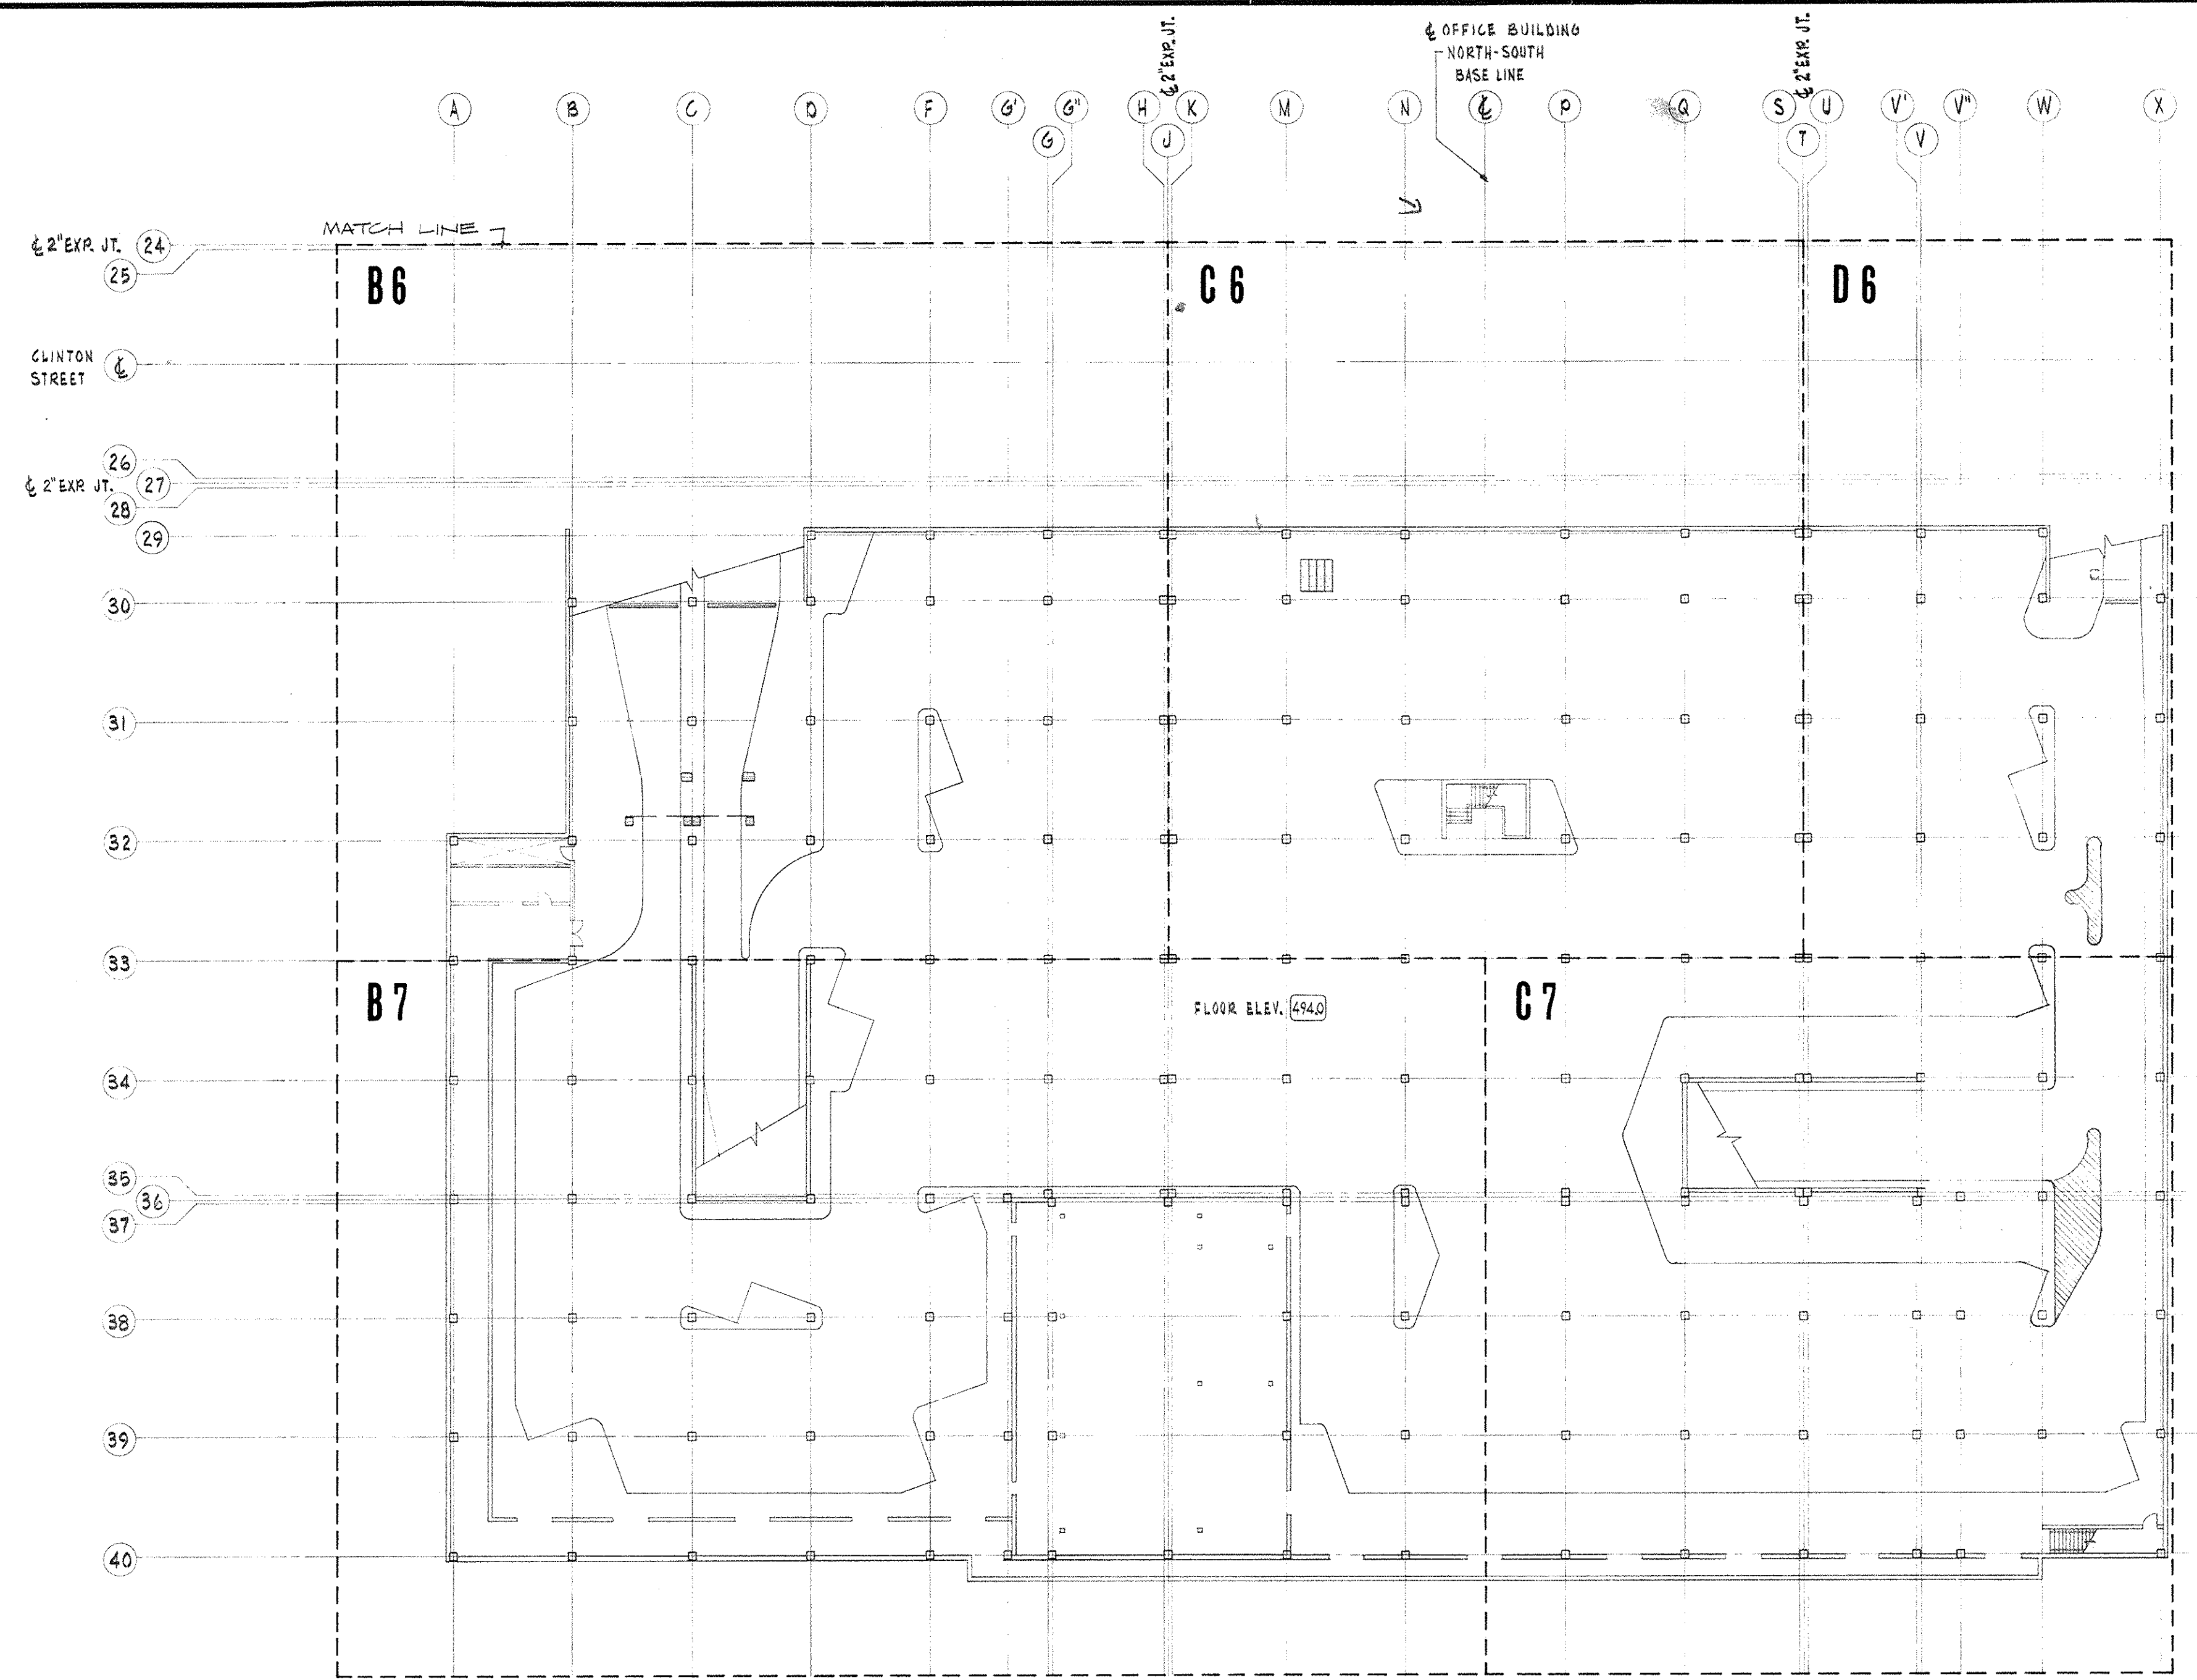


SECTOR MASTER - GROUND LEVEL - CLINTON ST. TO BROADWAY
SCALE 1/8" = 30'-0"

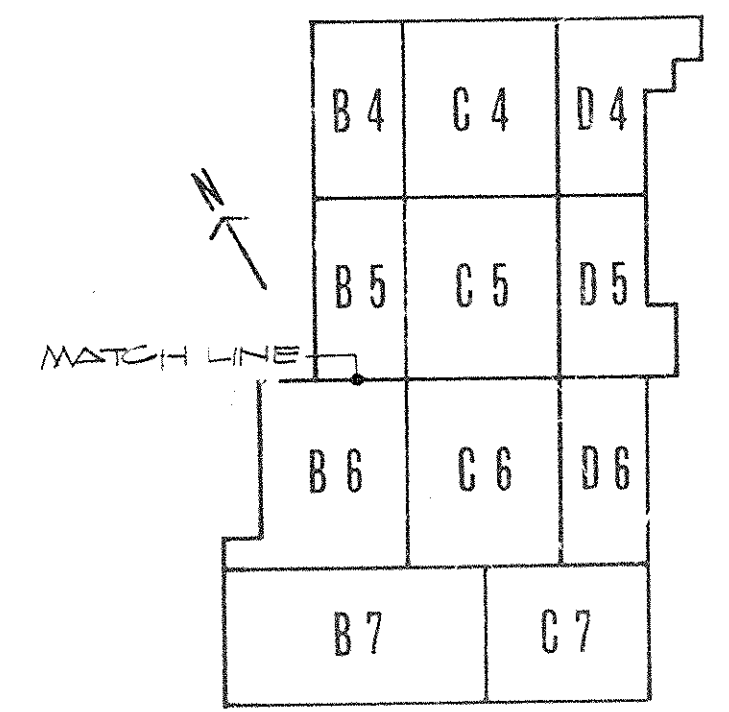


KEY PLAN


AS BUILT REVISIONS - 8-24-72

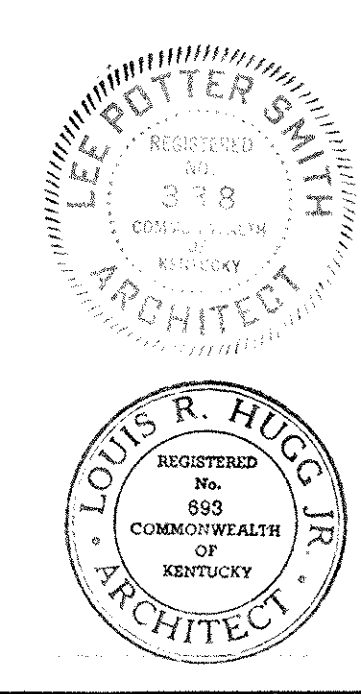


CAPITAL PLAZA DEVELOPMENT PHASE II FRANKFORT, KENTUCKY		
DRAWN BY C.W.	GROUND LEVEL	DATE 10-22-67
CHECKED BY J.F.H.	SECTOR NO. MASTER	COMM. NO. 50367
LEE POTTER SMITH, PRITCHETT, HUGG & CARTER ARCHITECTS 314 WILKINSON STREET FRANKFORT, KENTUCKY		DRAWING NO. A 1
COMMONWEALTH OF KENTUCKY DEPARTMENT OF FINANCE - DIVISION OF ENGINEERING FRANKFORT		OF A-42
APPROVED BY AGENCY HEAD	<i>W. J. McConnel</i>	DATE 10-22-67
APPROVED BY OWNER		DATE

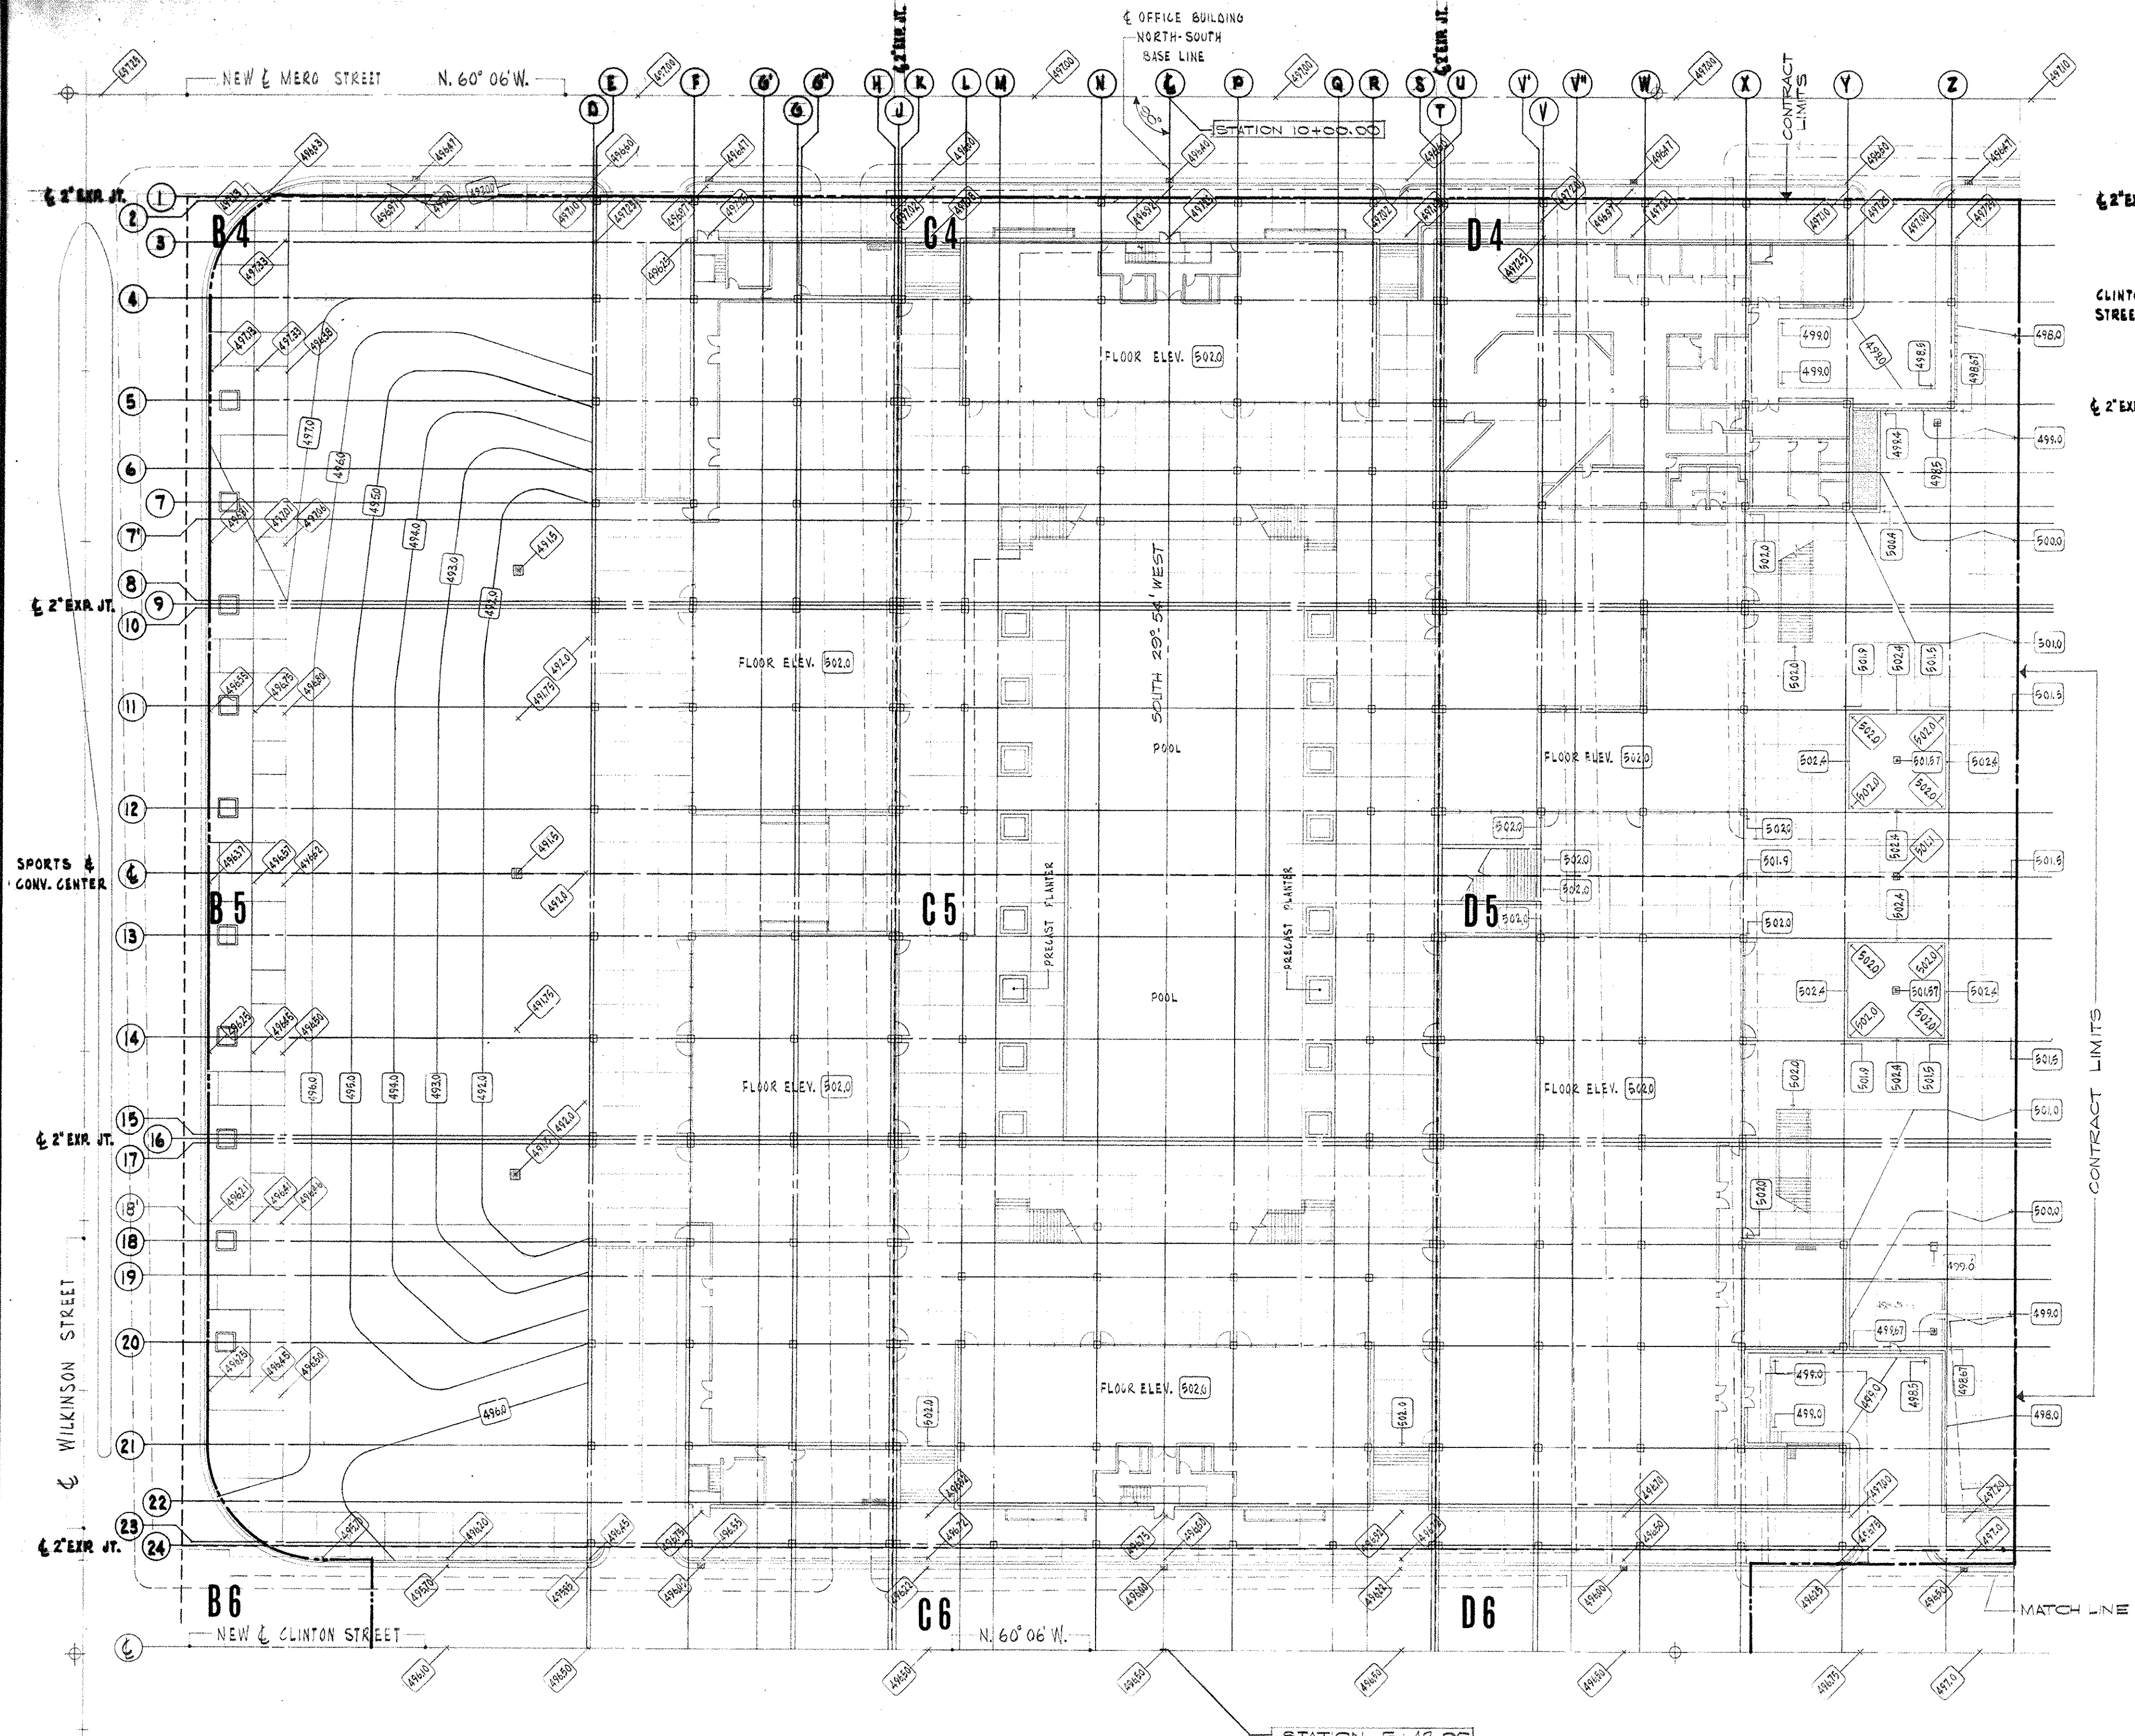


SECTOR MASTER - MEZZANINE LEVEL MERO ST. TO CLINTON ST.
SCALE: 1" = 30'-0"

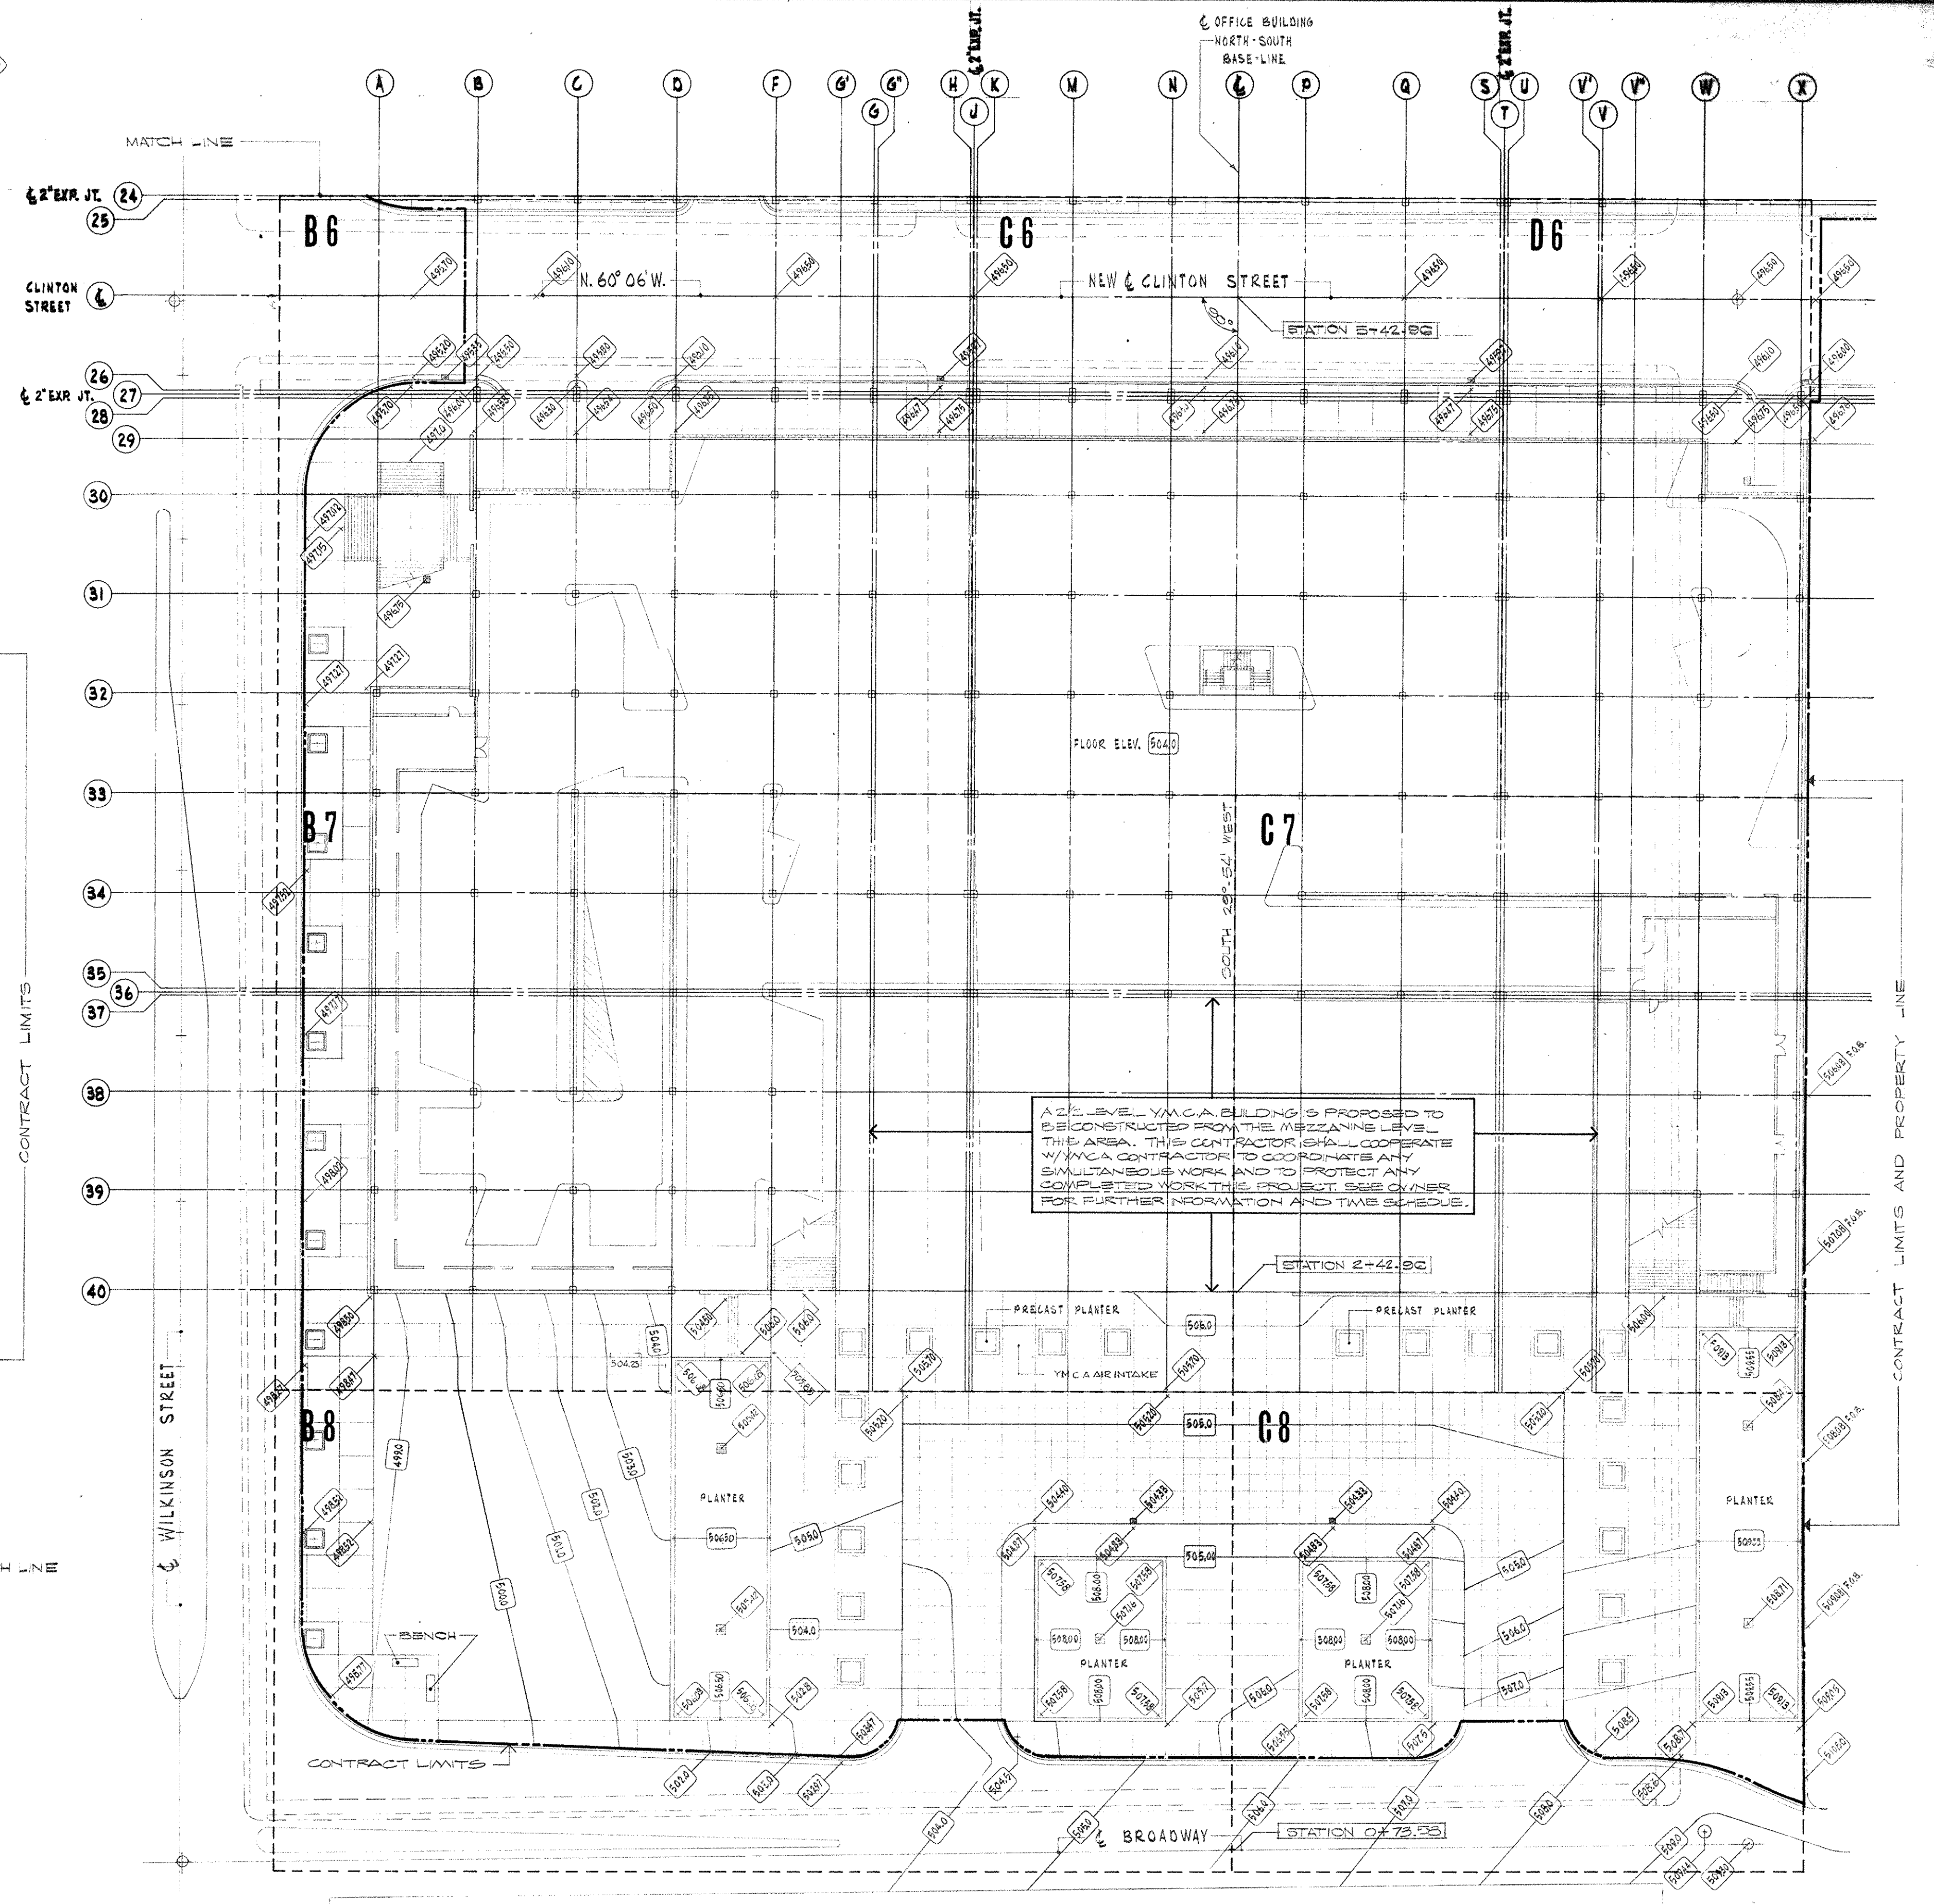


SECTOR MASTER - MEZZANINE LEVEL CLINTON ST. TO BROADWAY
SCALE: 1" = 30'-0"

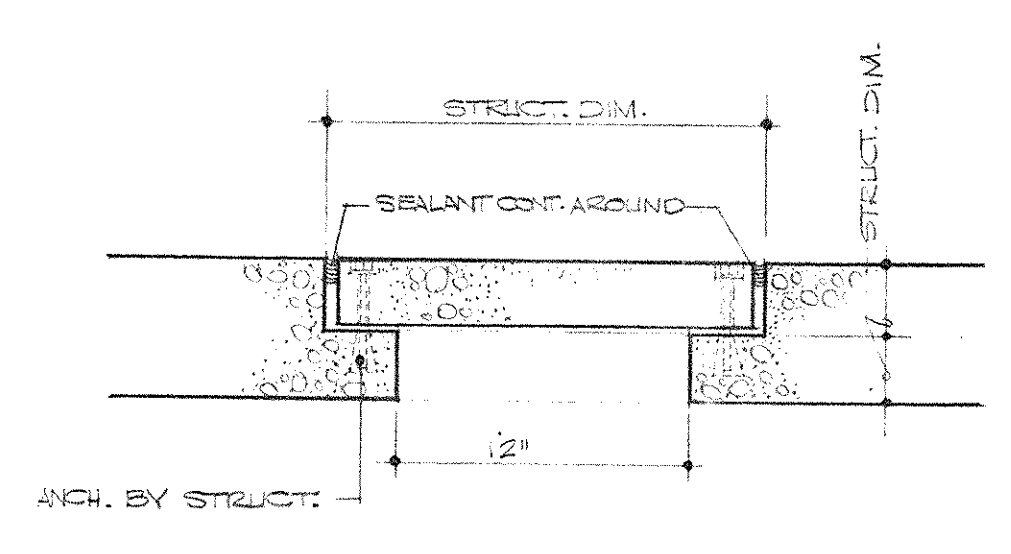

A
TYPICAL ACCESS TO PLAZA DRAIN
SCALE: 1/2" = 1'-0"


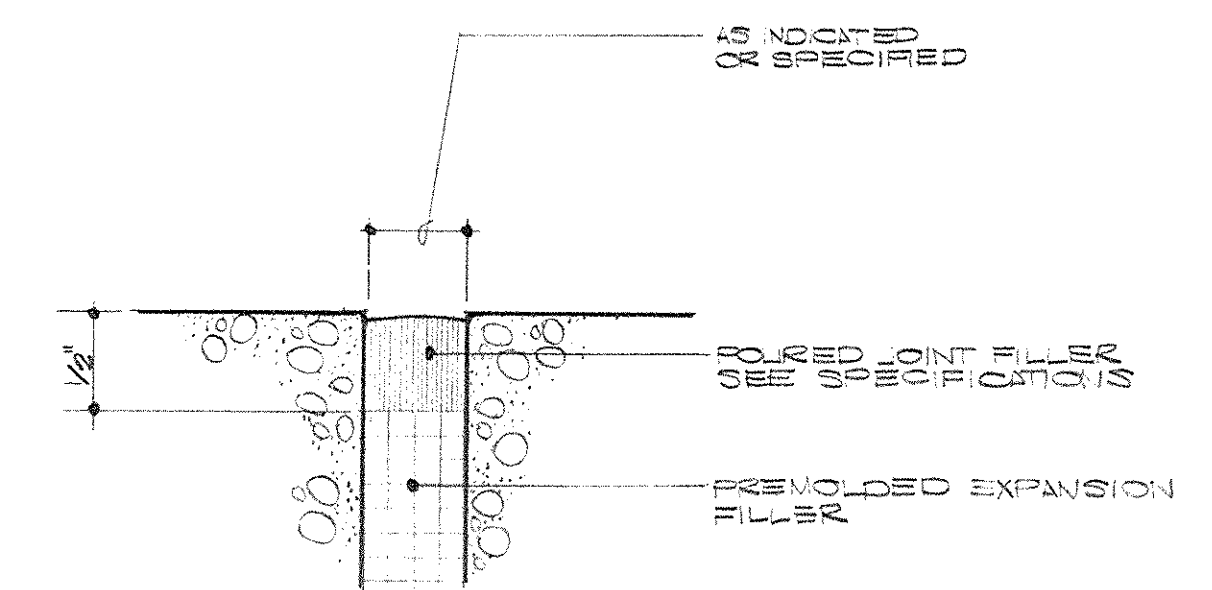


B
JOINT FILLER
NOTE: COMPLETELY FILL WITH JOINT FILLER ALL EXPANSION JOINTS IN CONCRETE SLABS ON GRADE, GARAGE SLABS RAISED OR REINFORCED AND CONCRETE SLABS ON PAVEMENT.

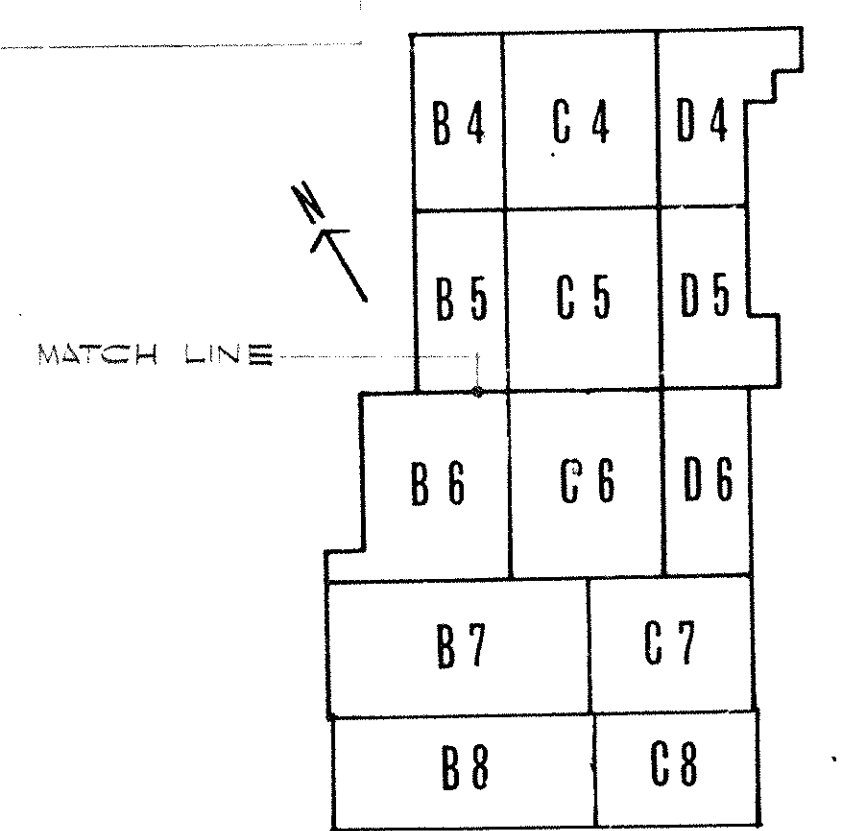


KEY PLAN

AS BUILT REVISIONS - 5-23-72

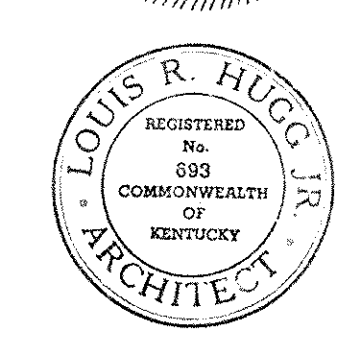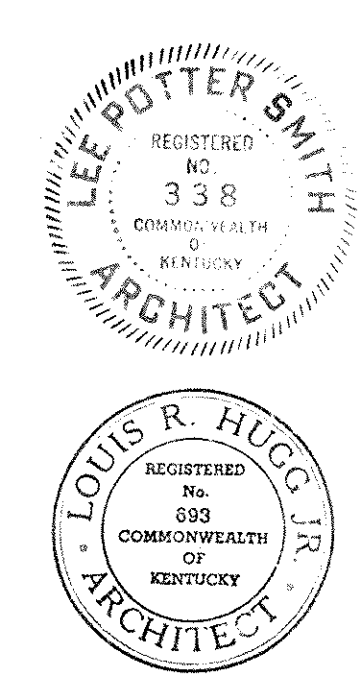


CAPITAL PLAZA DEVELOPMENT PHASE II		
FRANKFORT, KENTUCKY		
DRAWN BY C.V.	MEZZANINE LEVEL	DATE 10-26-67
CHECKED BY L.P.S.		COMM. NO. 50367
SECTOR NO. MASTER	LEE POTTER SMITH, PRITCHETT, HUGG & CARTER ARCHITECTS 814 WILKINSON STREET FRANKFORT, KENTUCKY	DRAWING NO. A 2
APPROVED BY AGENCY HEAD	COMMONWEALTH OF KENTUCKY DEPARTMENT OF FINANCE - DIVISION OF ENGINEERING FRANKFORT, KENTUCKY	DATE 10-26-67
APPROVED BY OWNER		DATE


C.P.A.-288

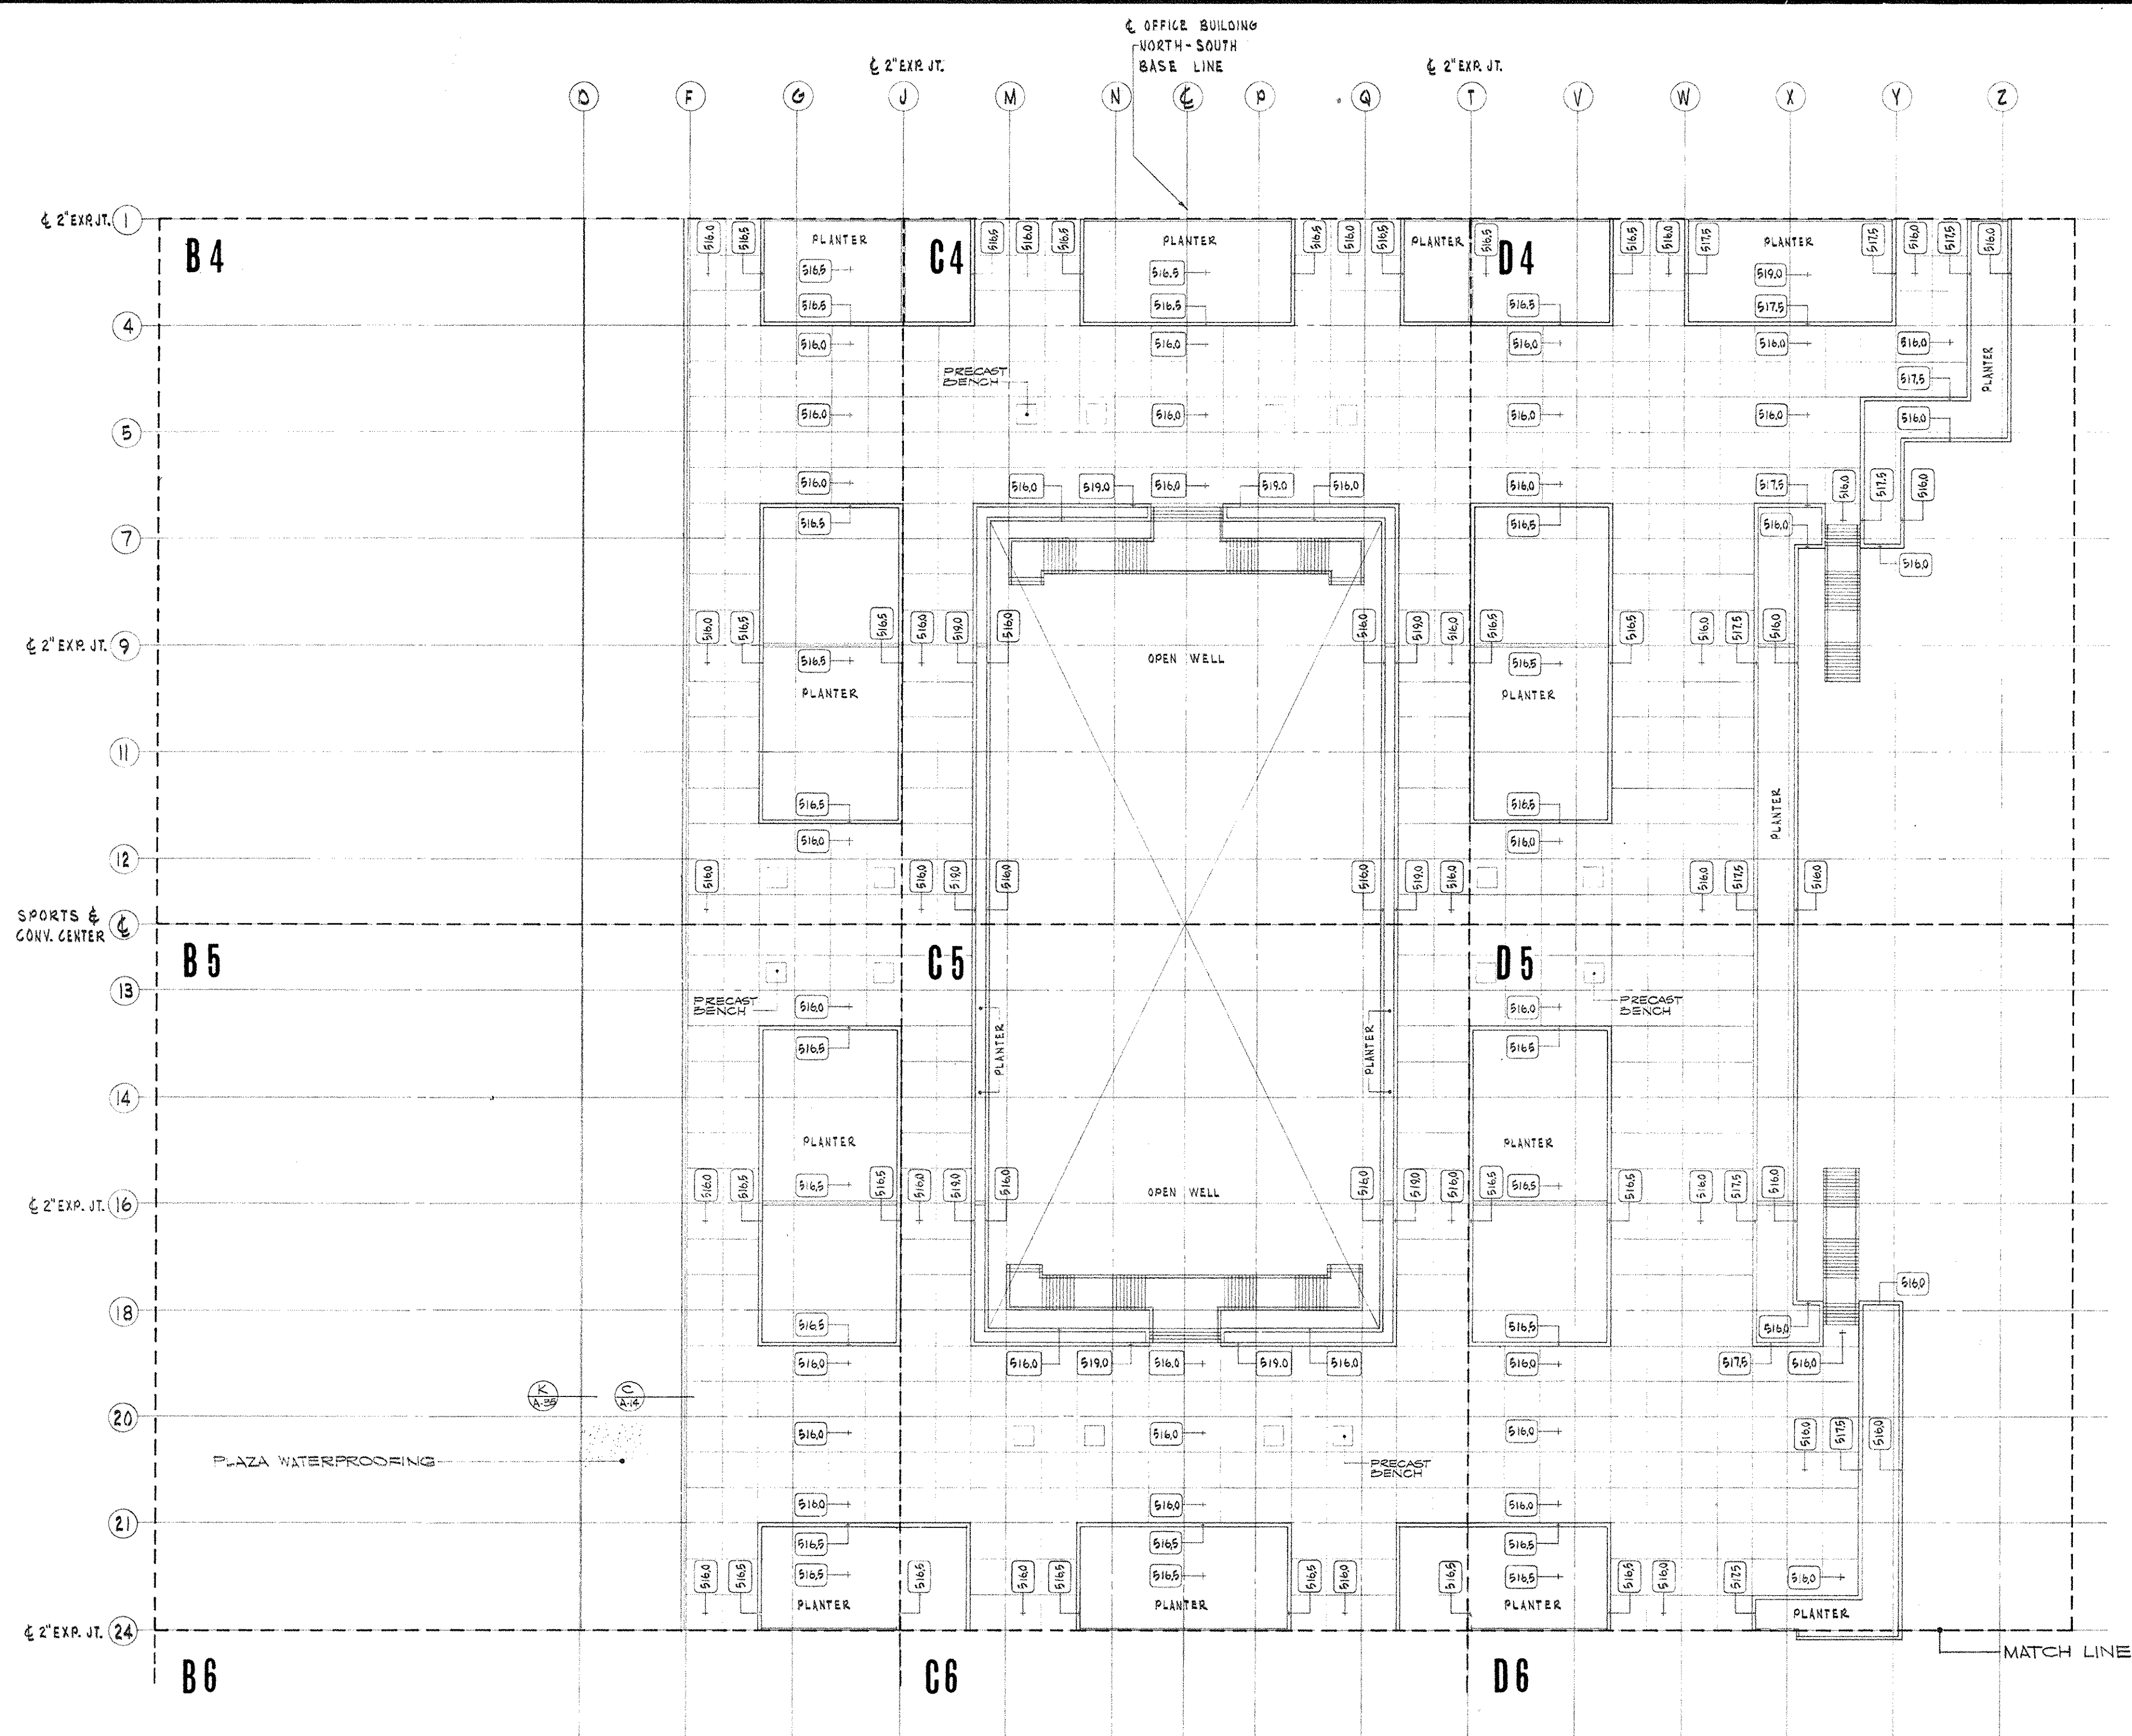


SECTOR MASTER - PLAZA LEVEL MERO ST. TO CLINTON ST.
SCALE: 1" = 30'-0"

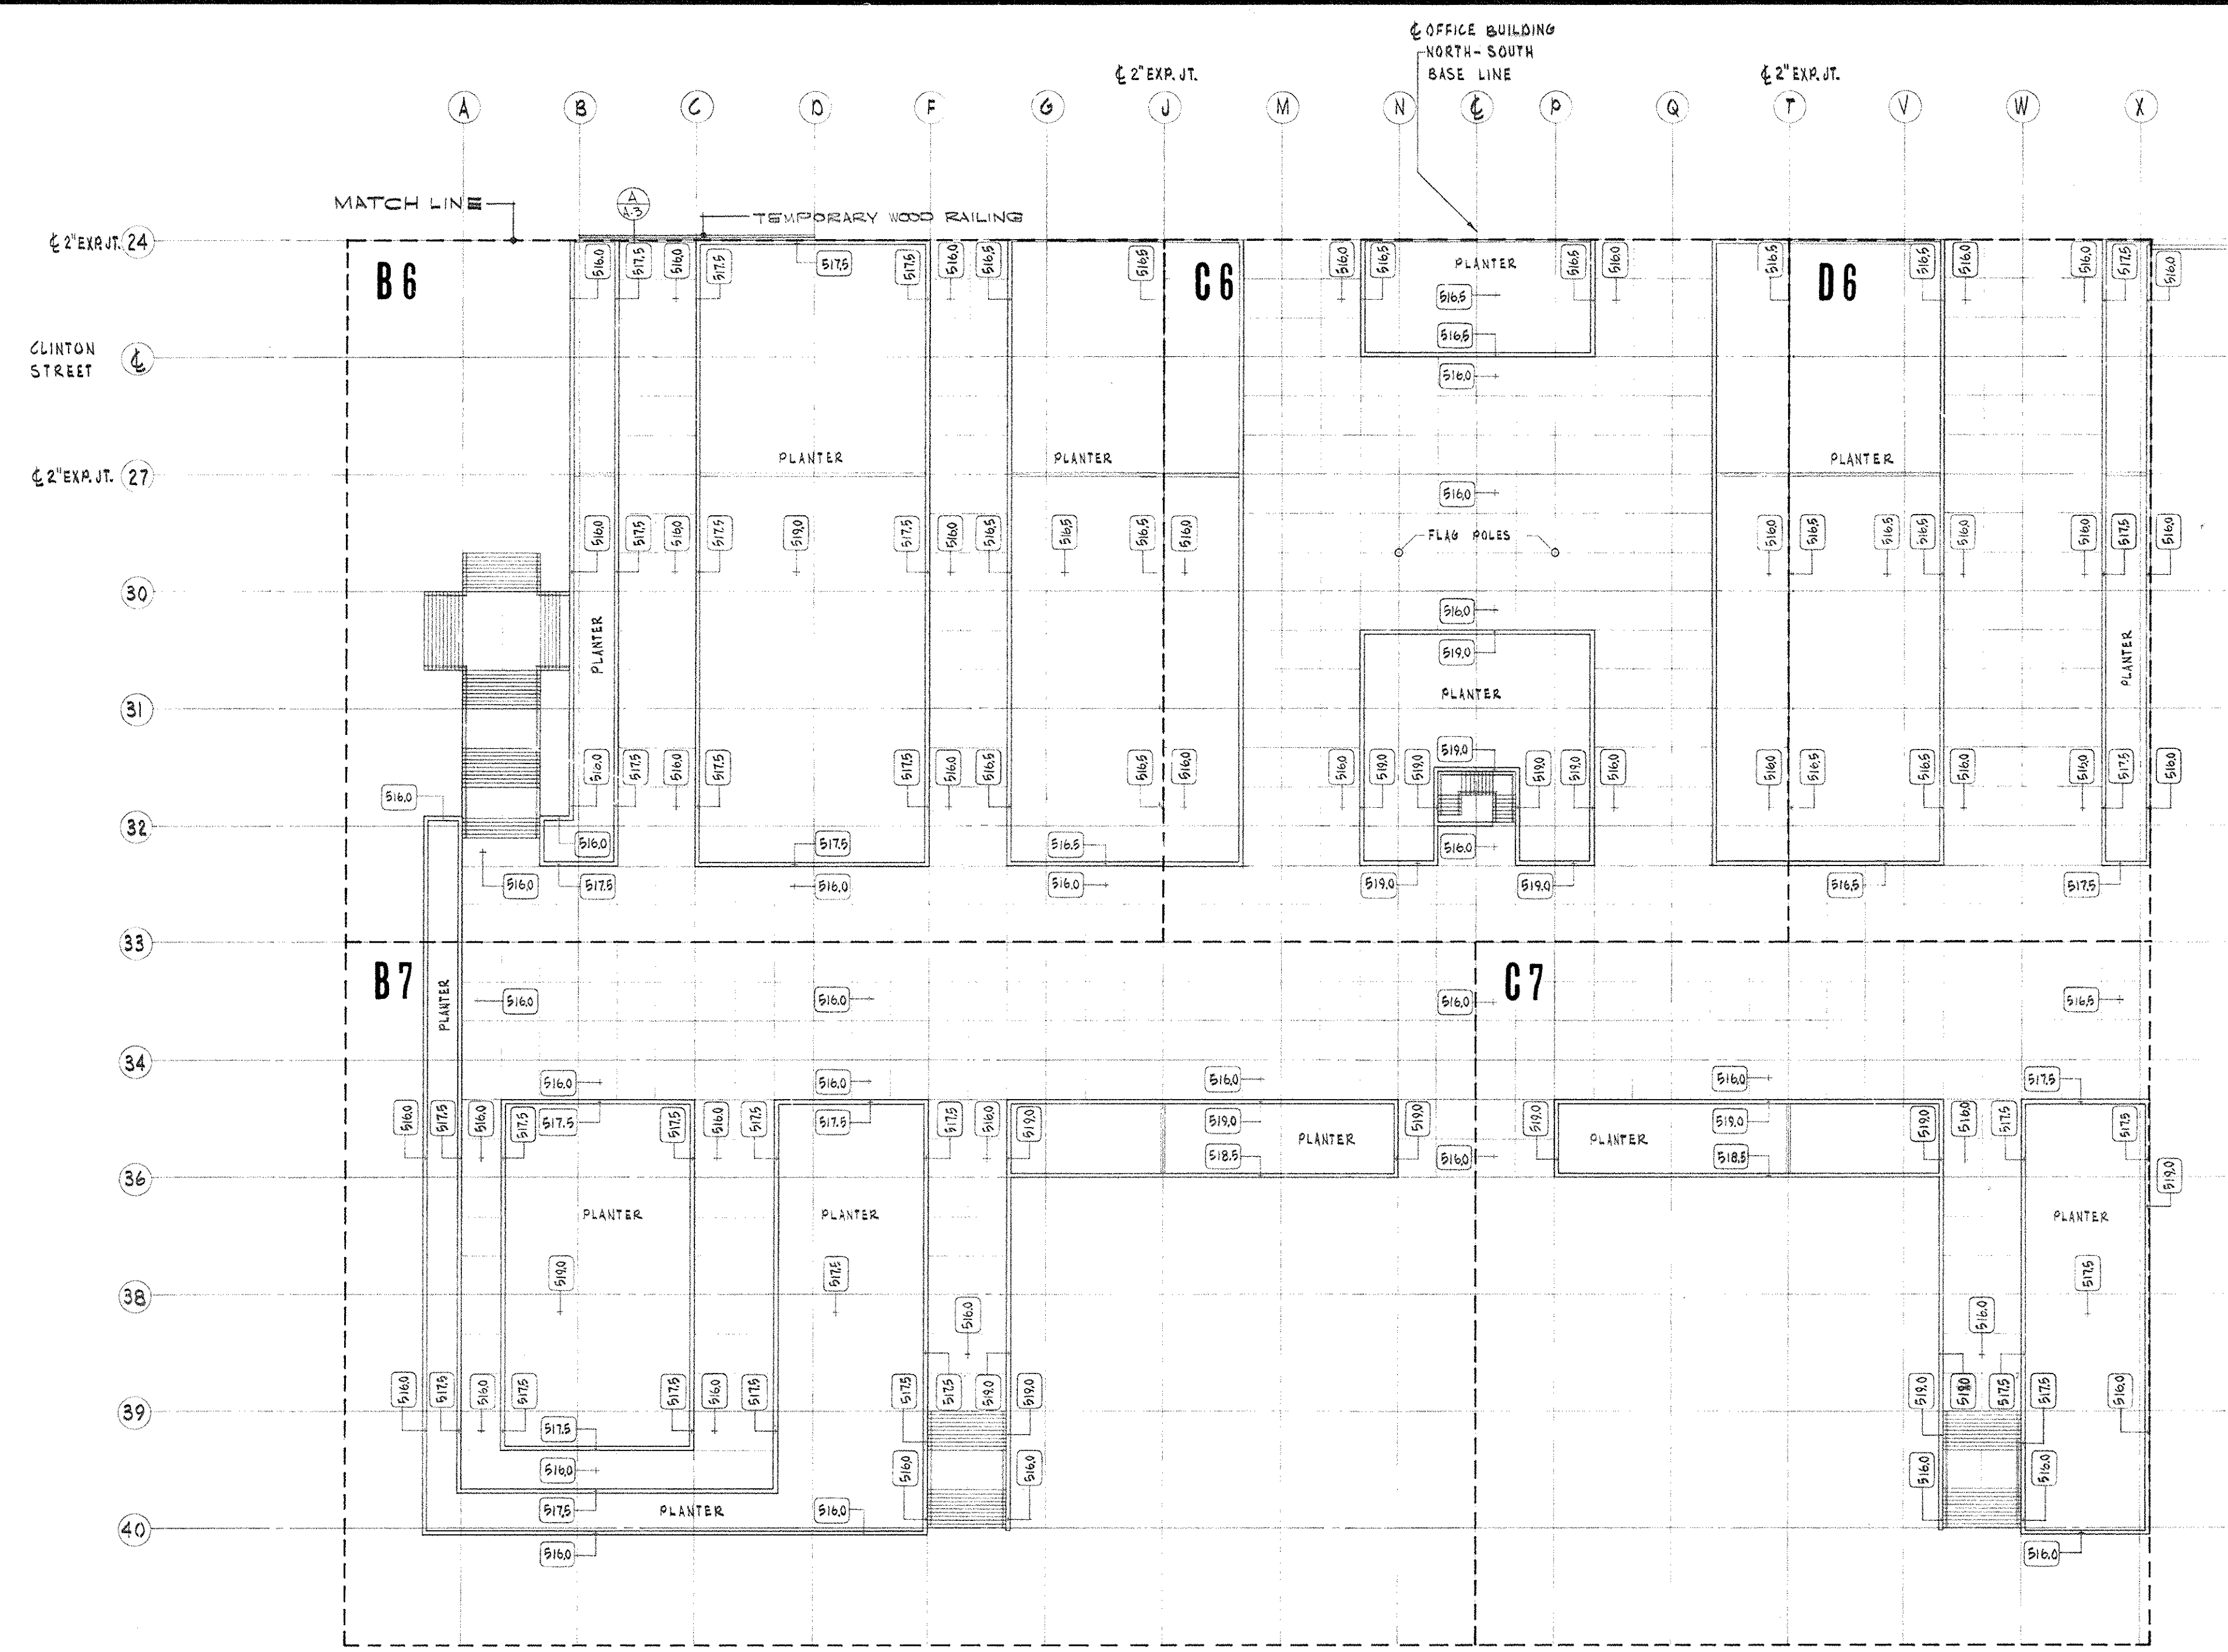

SECTOR MASTER - PLAZA LEVEL - CLINTON TO BROADWAY
SCALE: 1" = 30'-0"

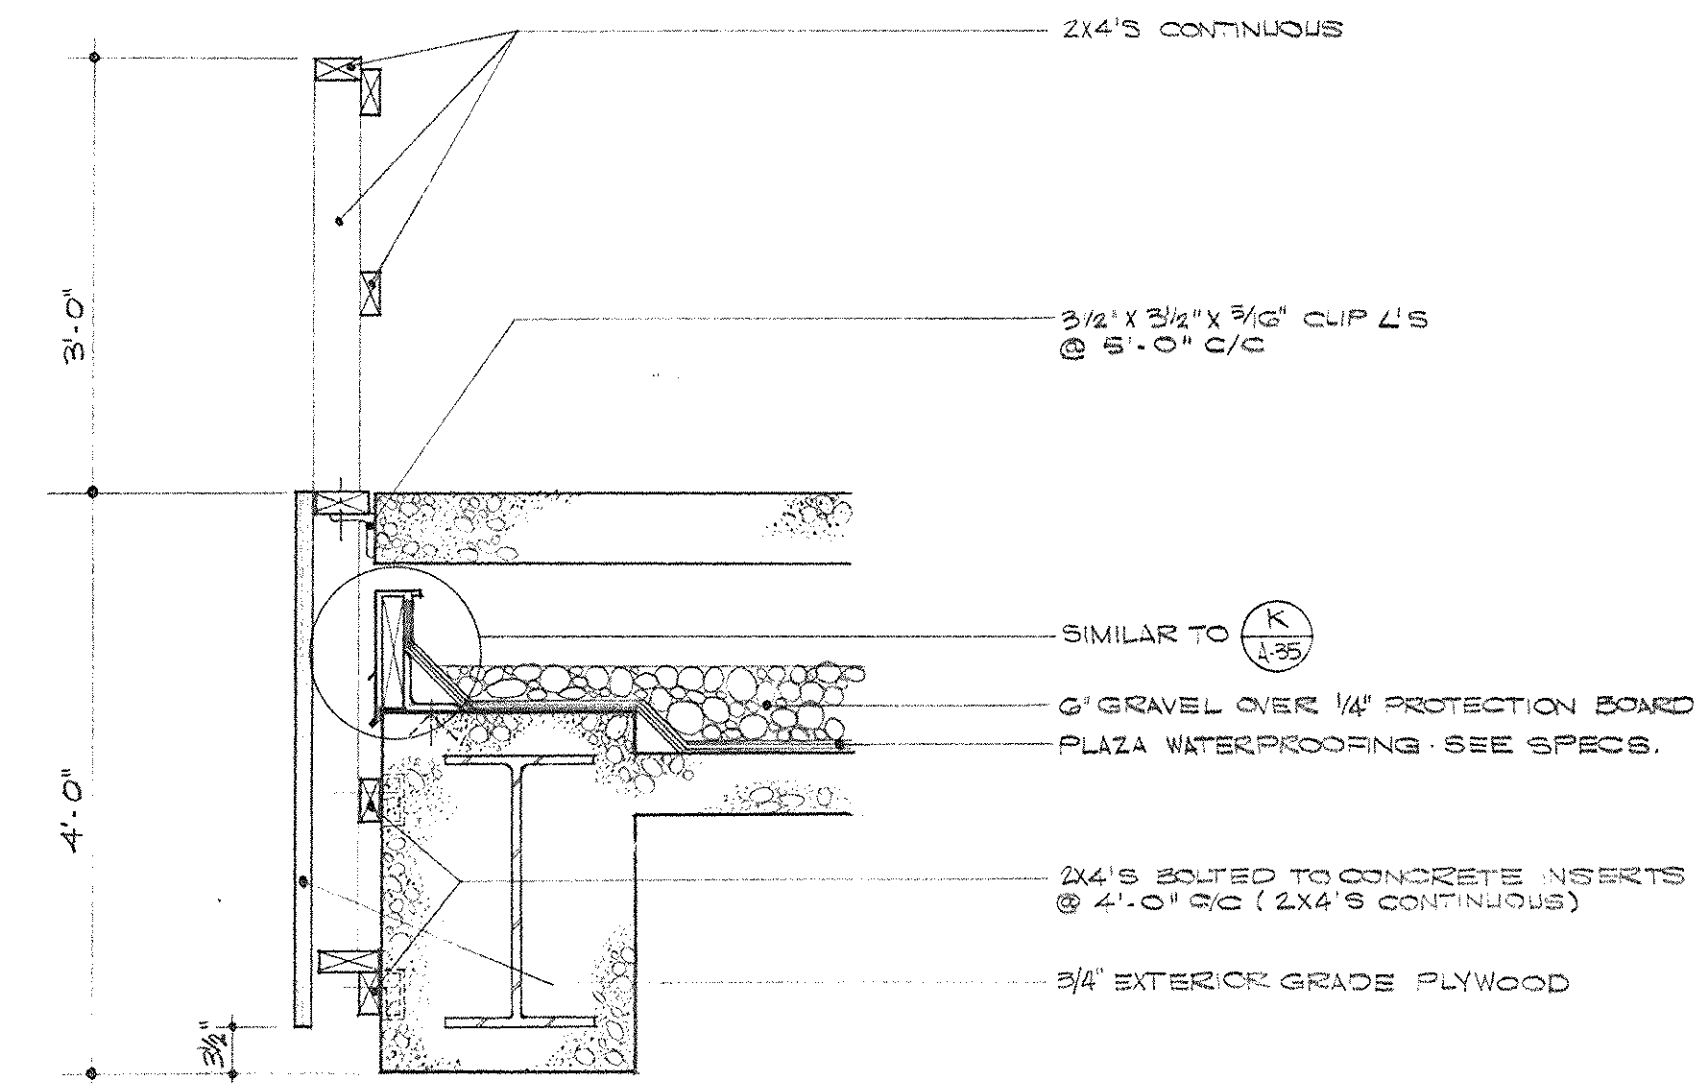


SECTION - TEMPORARY RAILING
SCALE: 3/4" = 1'-0"

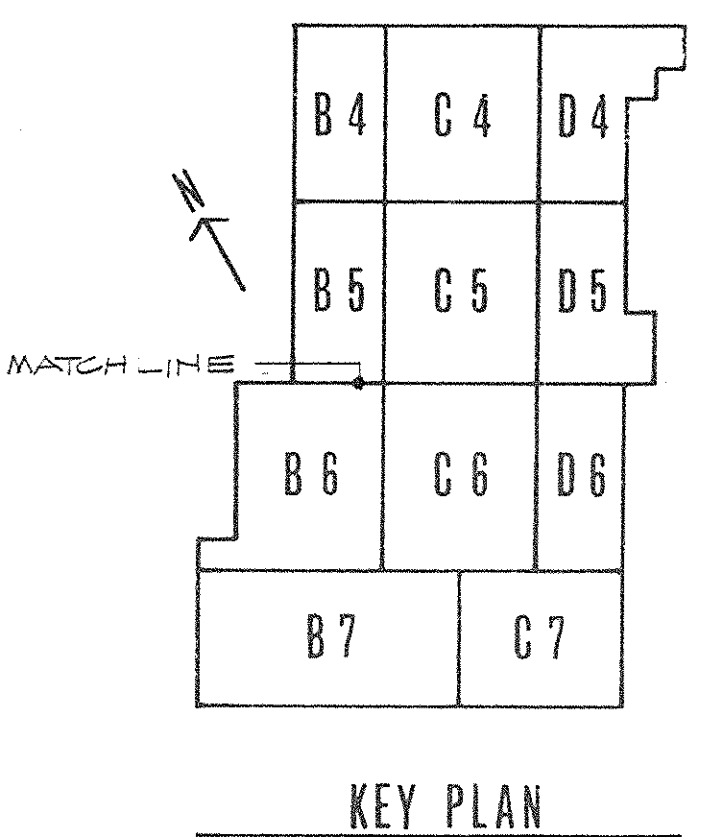


KEY PLAN

GENERAL NOTE:
WALKS, CURBS, GUTTERS AND PAVING AT SURFACE LEVEL WITHIN THE 60'-0" RIGHT-OF-WAY AT MERO AND CLINTON STREETS ARE N.I.C.


AS BUILT REVISIONS - 8-21-72

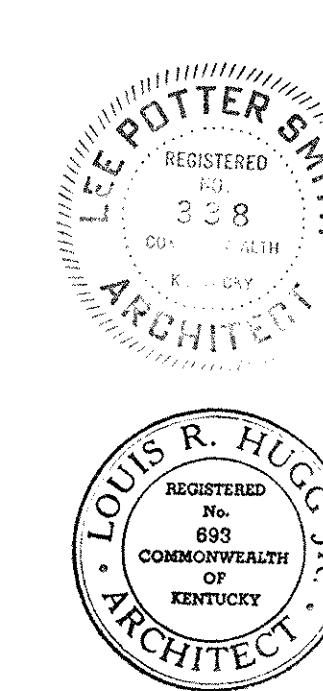


CAPITAL PLAZA DEVELOPMENT PHASE II FRANKFORT, KENTUCKY		
DRAWN BY G.W.	DATE 10-20-72	REGISTERED PROFESSIONAL ENGINEER COMMONWEALTH OF KENTUCKY 50367
CHECKED BY L.H.	SECTOR NO. PLAZA LEVEL	DRAWING NO. A 3
ENGINEER LEE POTTER SMITH, PRITCHETT, HUGG & CARTER ARCHITECTS 314 WILKINSON STREET FRANKFORT, KENTUCKY	COMMONWEALTH OF KENTUCKY DEPARTMENT OF FINANCE - DIVISION OF ENGINEERING FRANKFORT	OF A. 42
APPROVED BY AGENCY HEAD	DATE	
APPROVED BY OWNER	DATE 10-20-72	

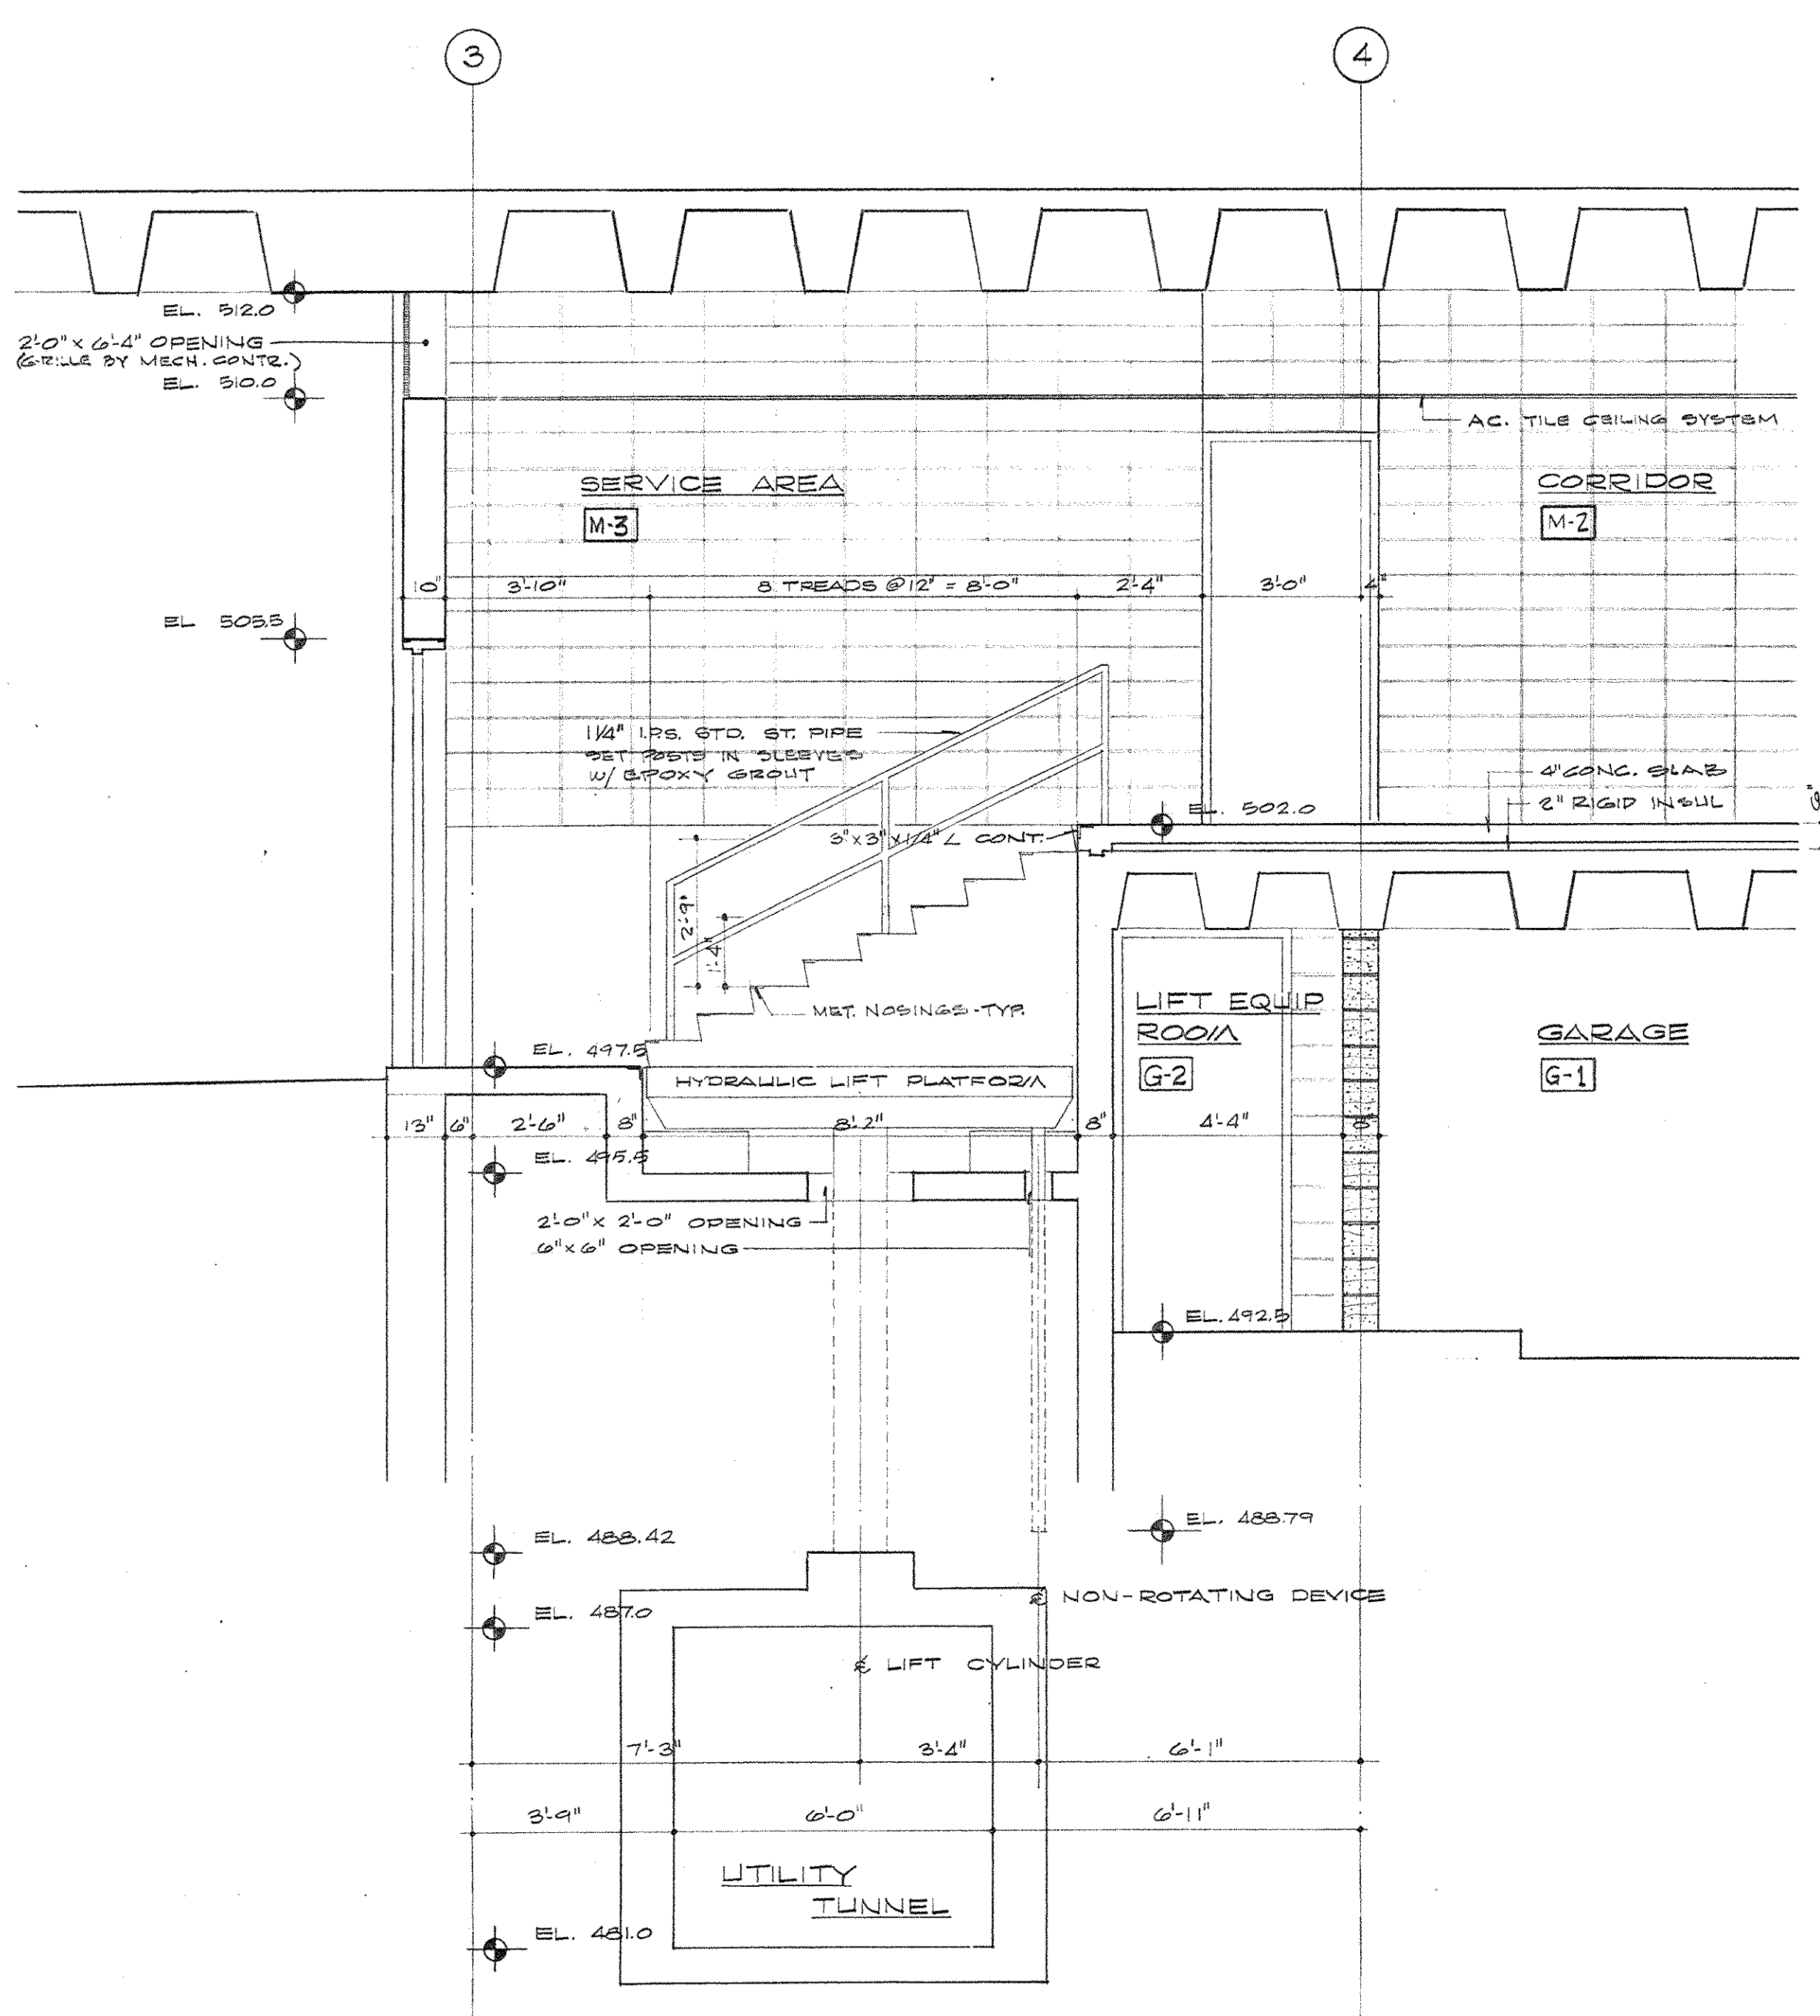


SECTION A-A SERVICE AREA
SCALE 3/8" = 1'-0"

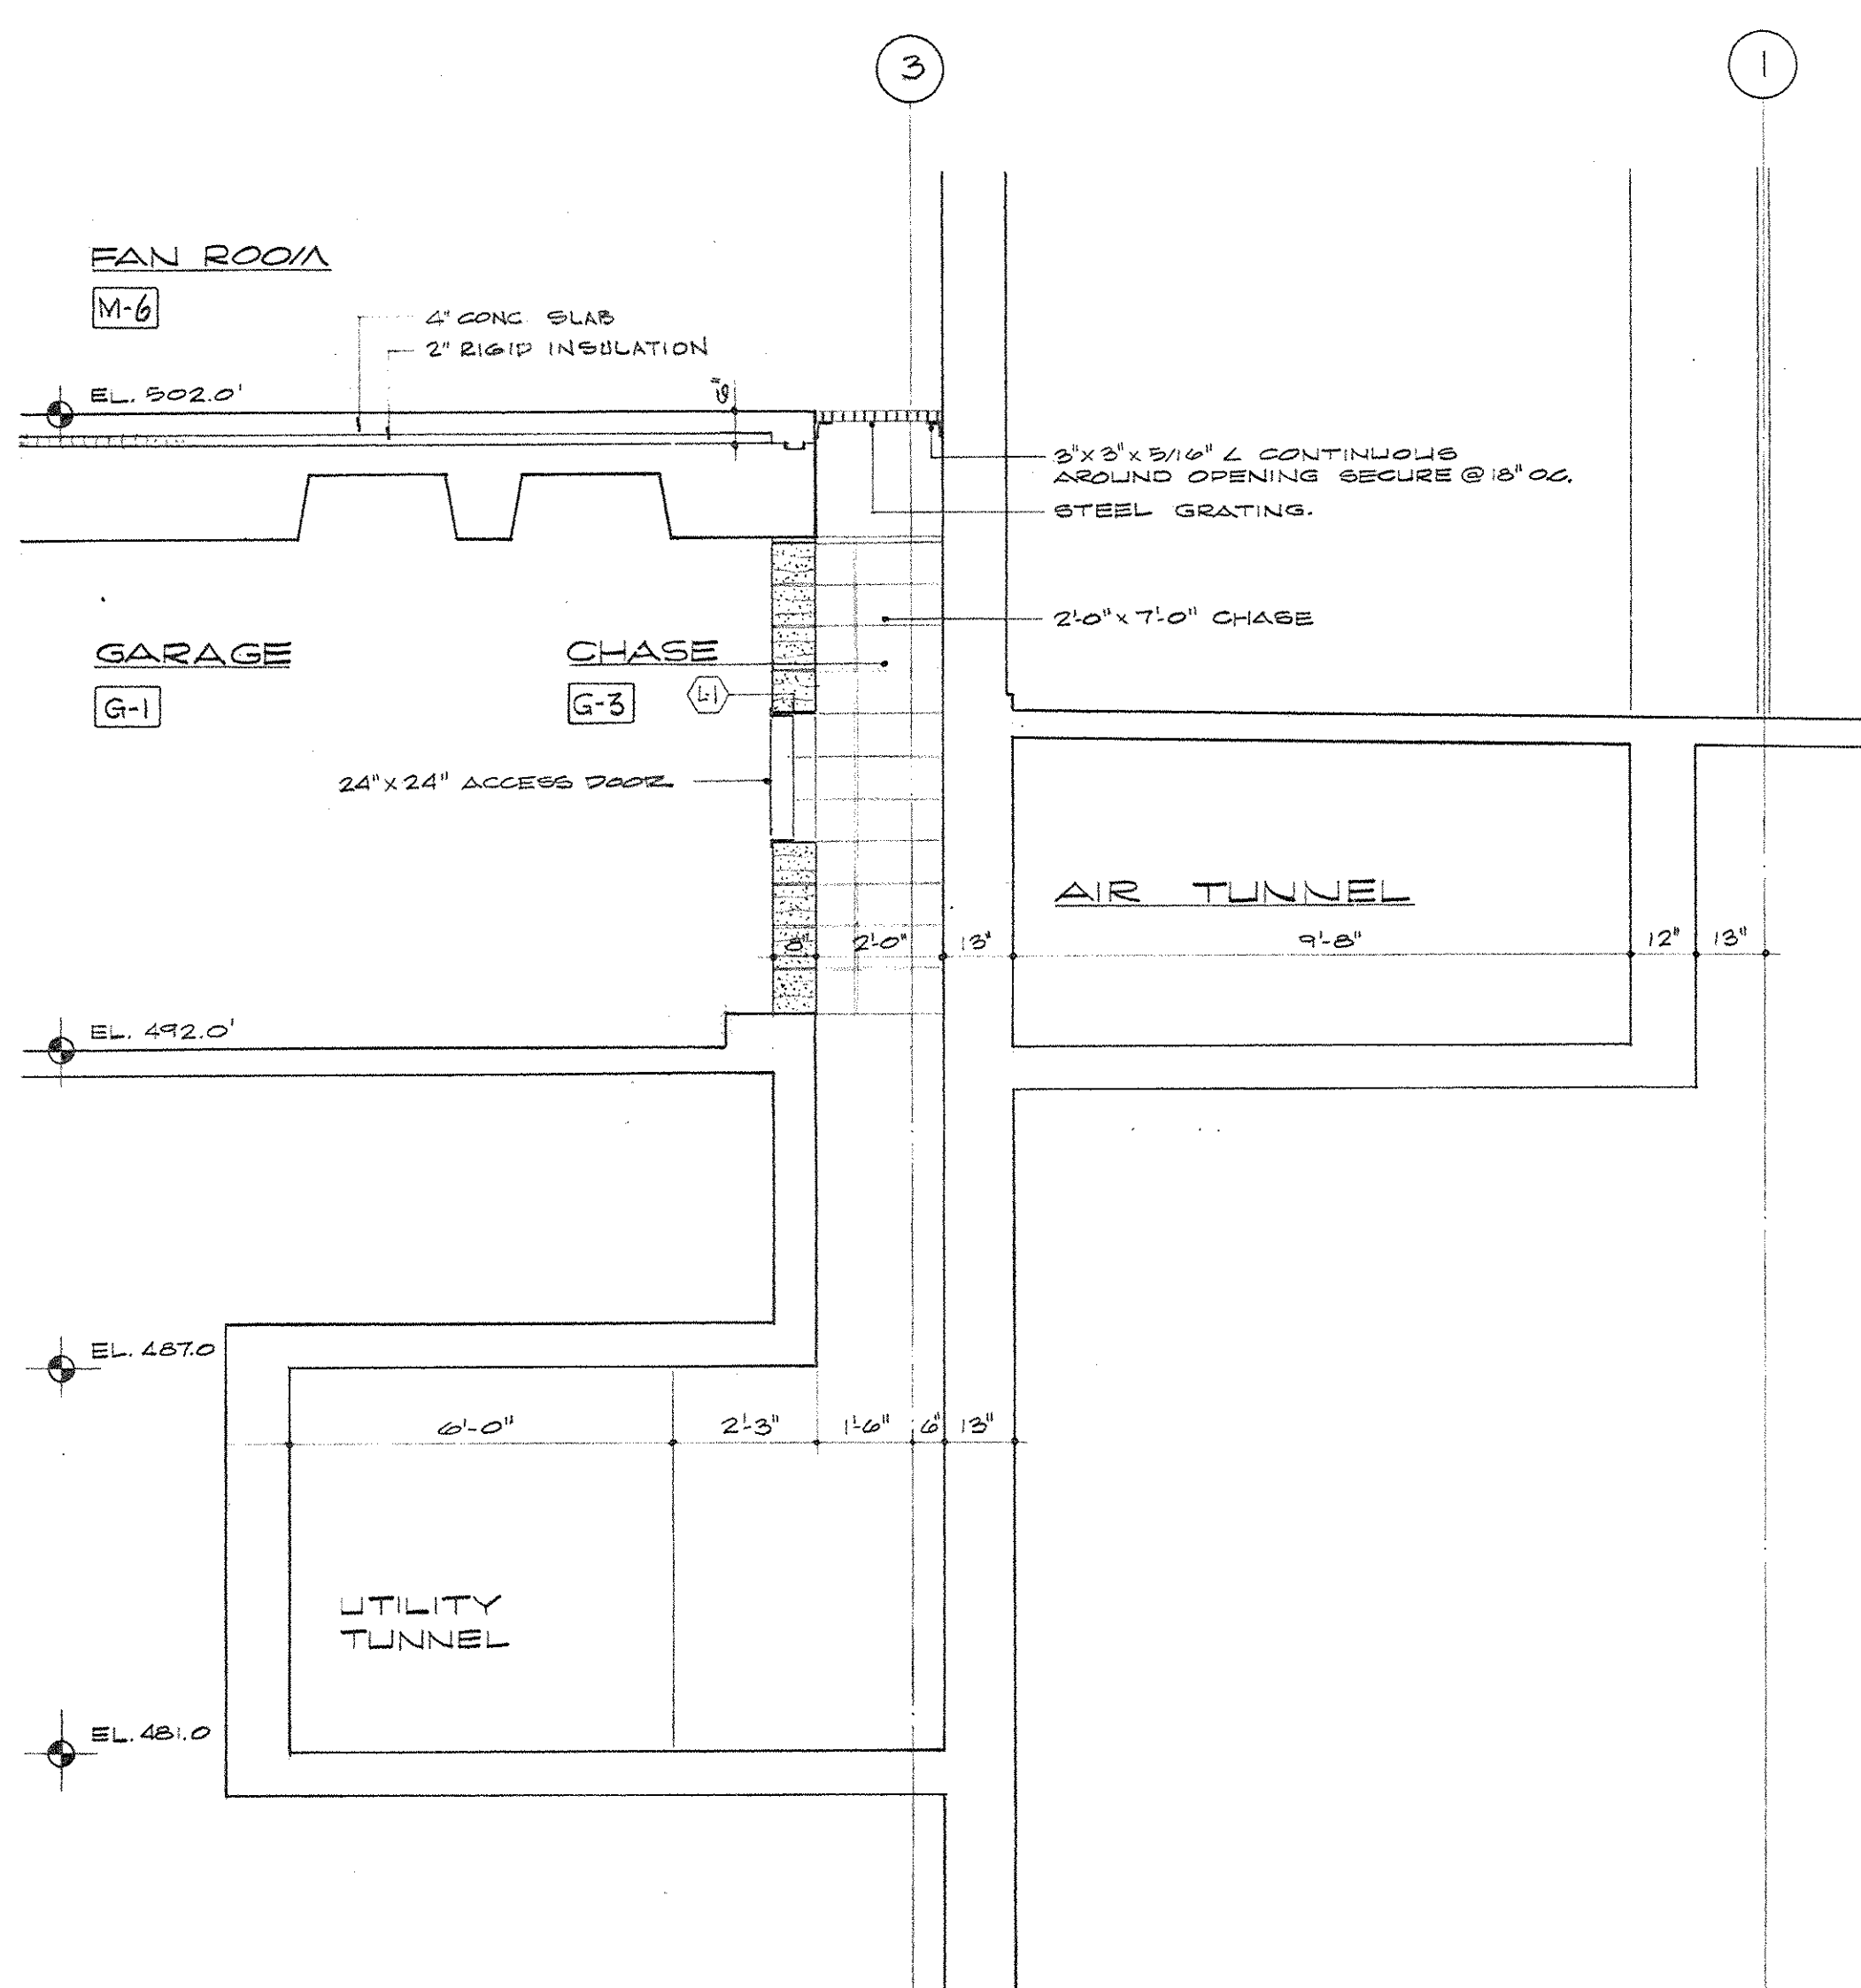


SECTION C-C CHASE
SCALE 3/8" = 1'-0"

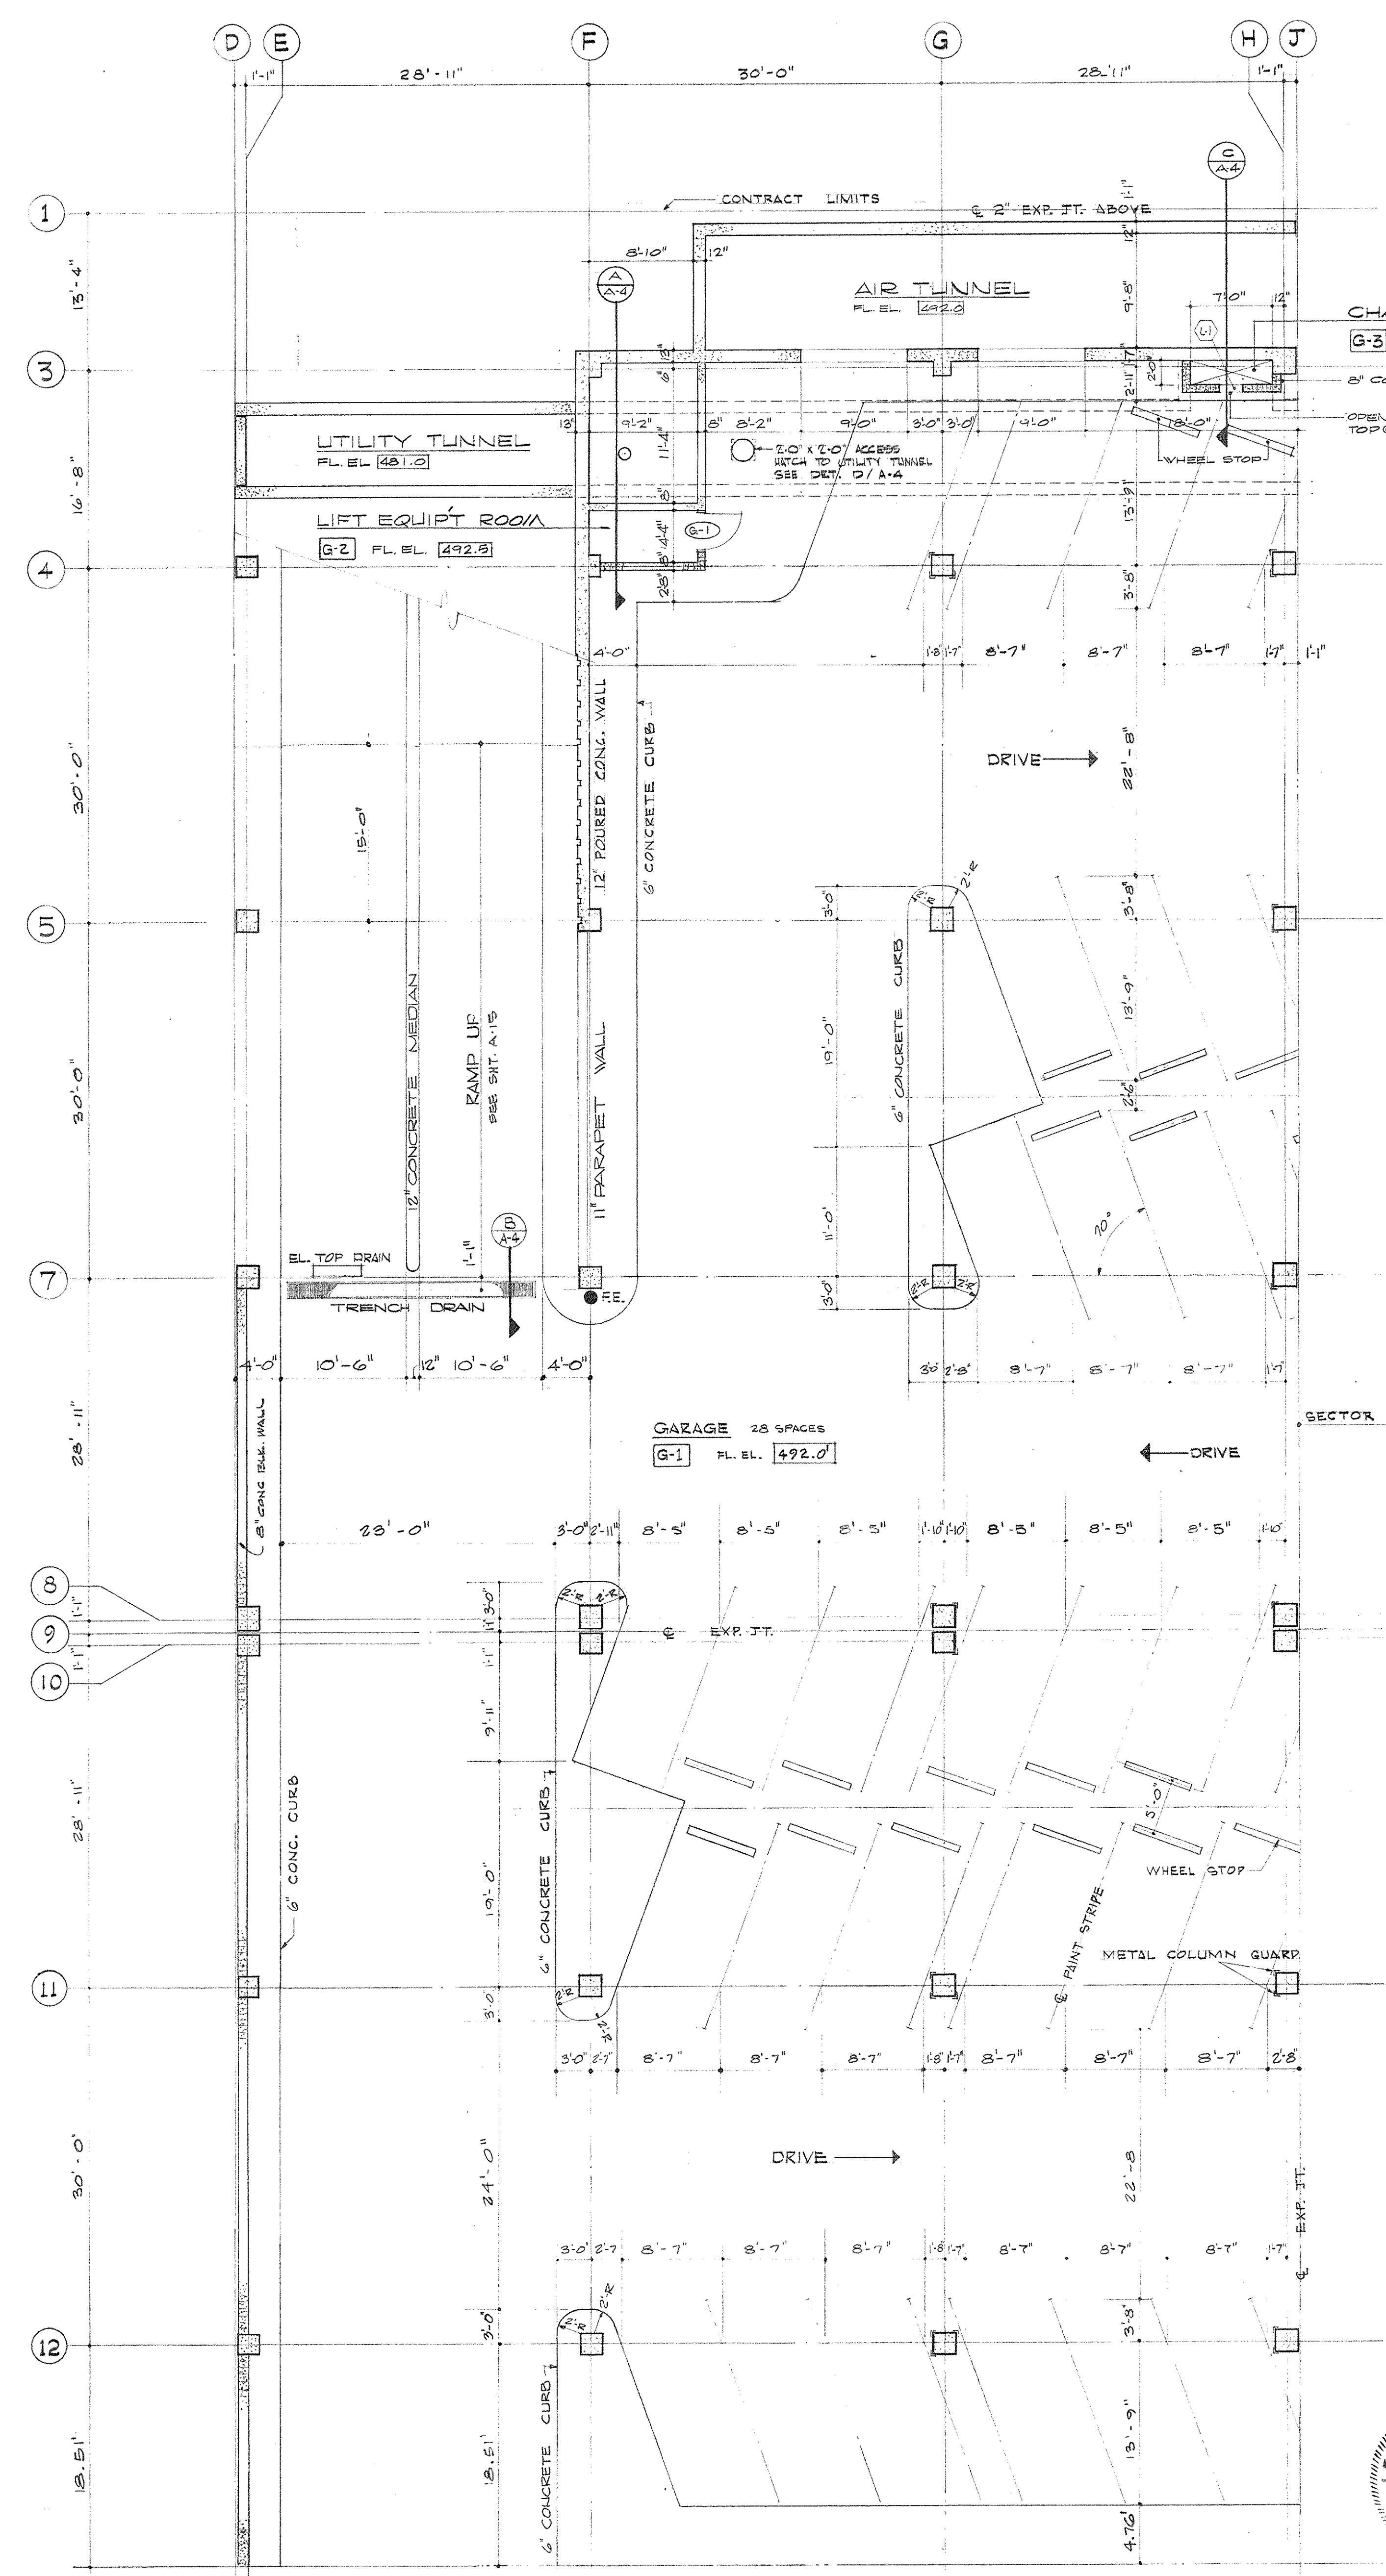


GROUND LEVEL PLAN SECTOR B-4
SCALE 1/8" = 1'-0"
NOTE: SYMBOL "RE" INDICATES LOCATION OF CO2 FIRE EXTINGUISHERS

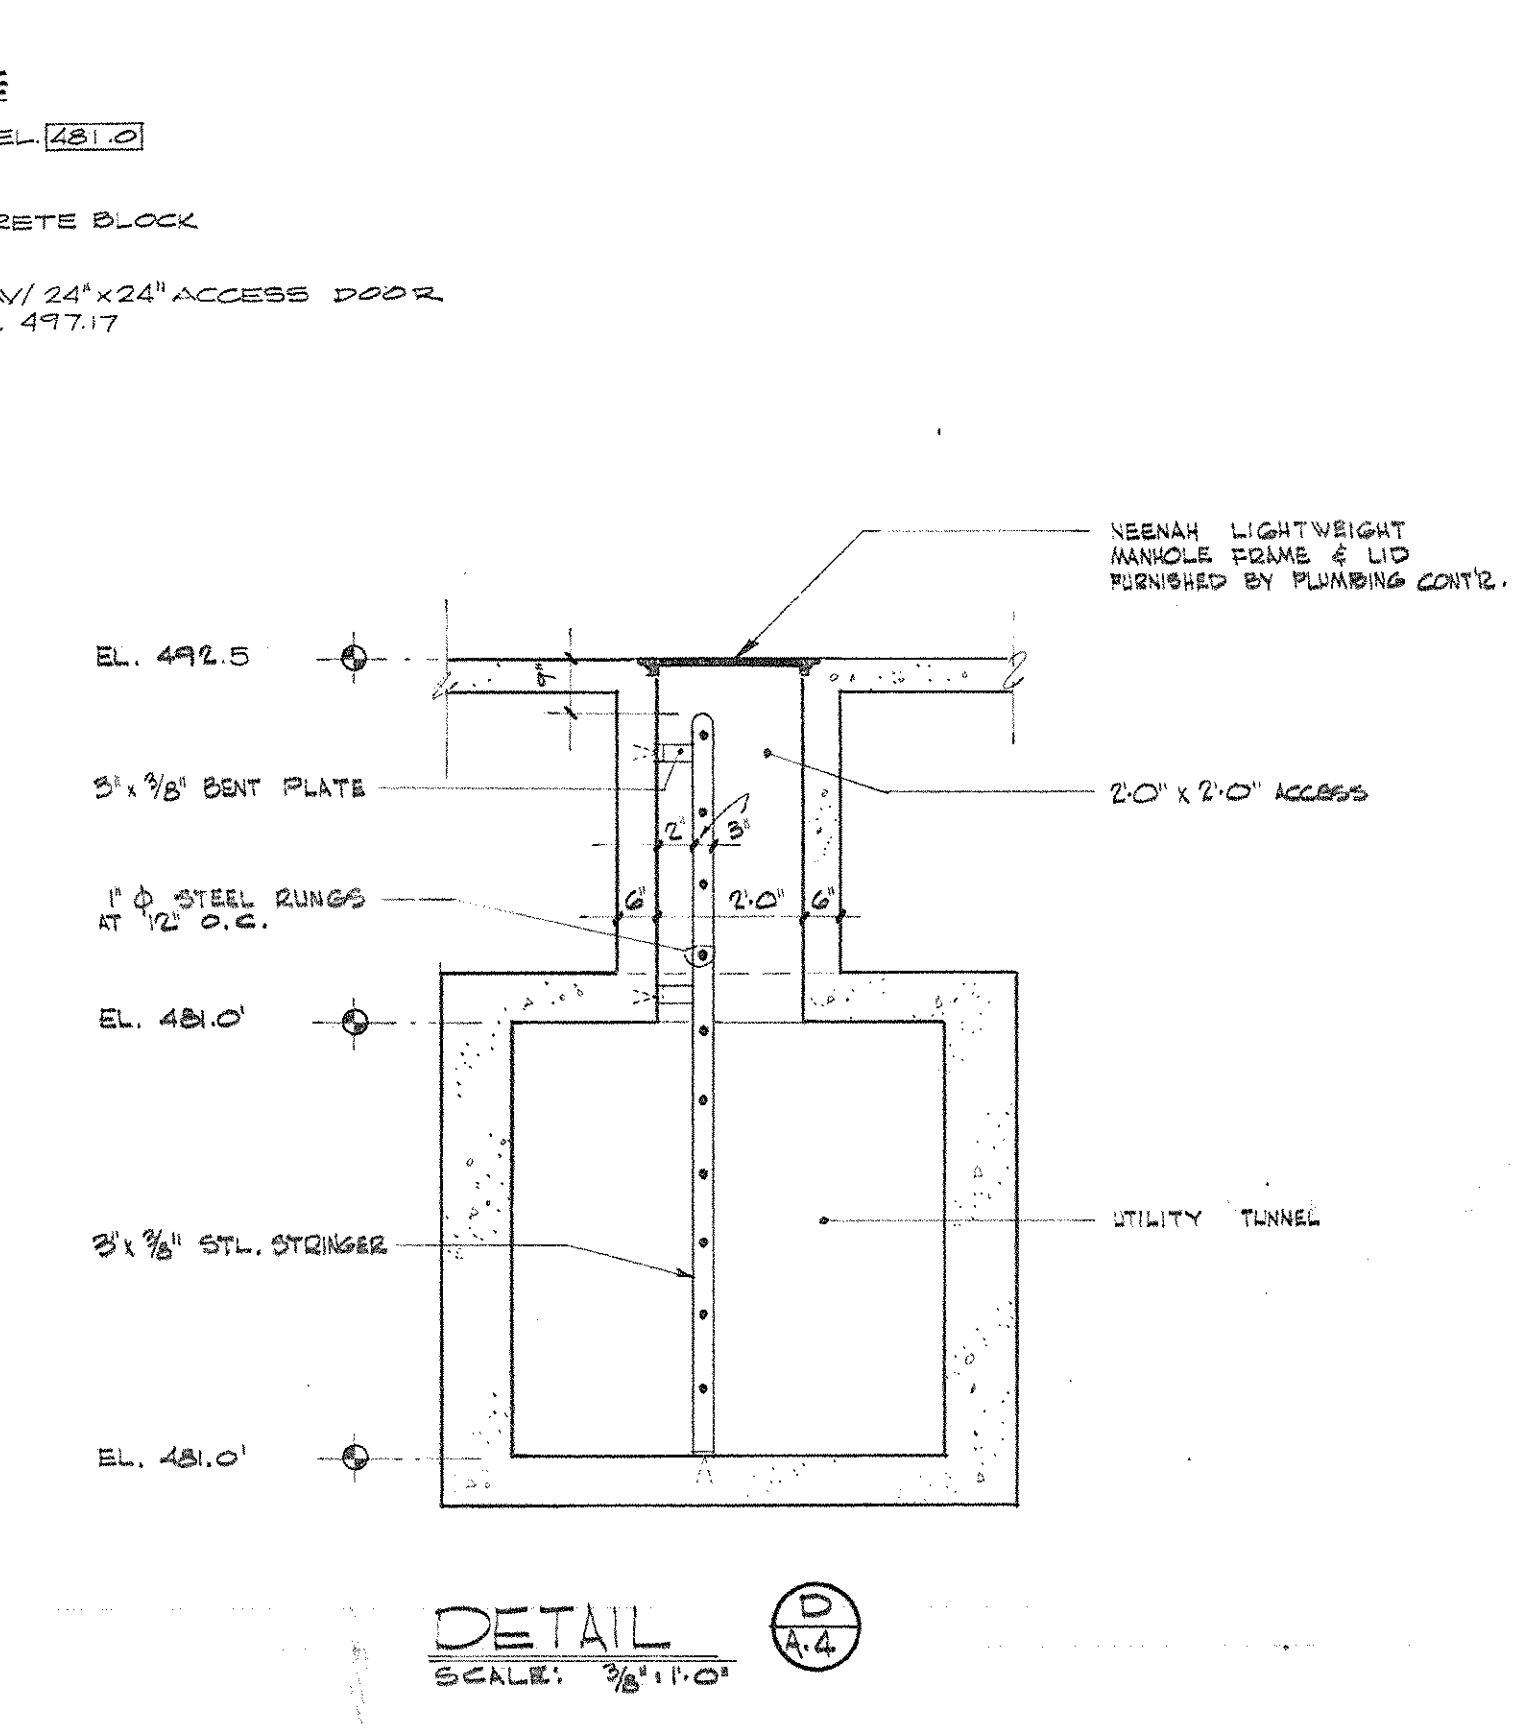


DETAIL D-4
SCALE 1/8" = 1'-0"

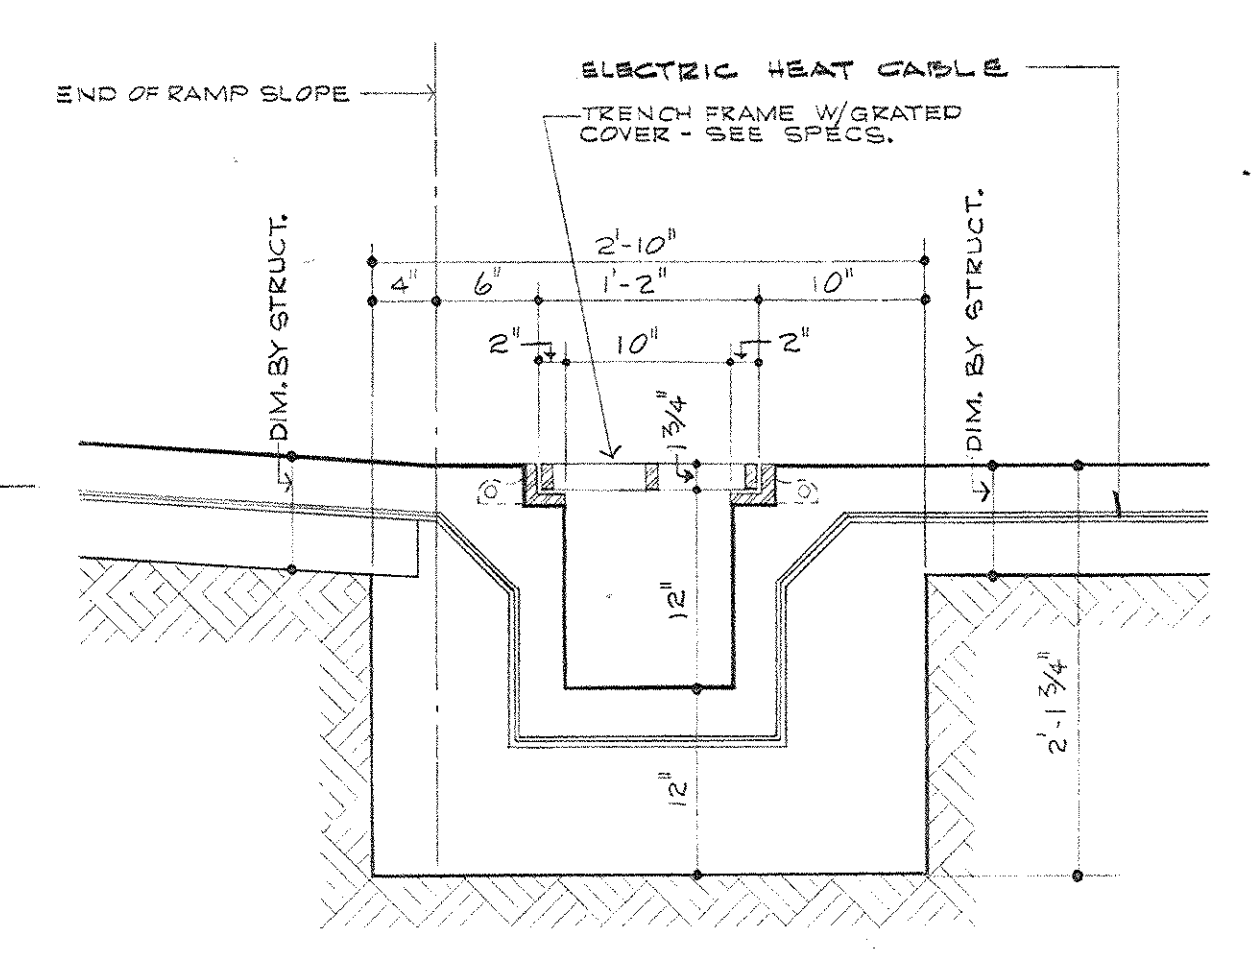


DETAIL B-4 TYPICAL SECTION THRU TRENCH DRAIN
SCALE 1/2" = 1'-0"

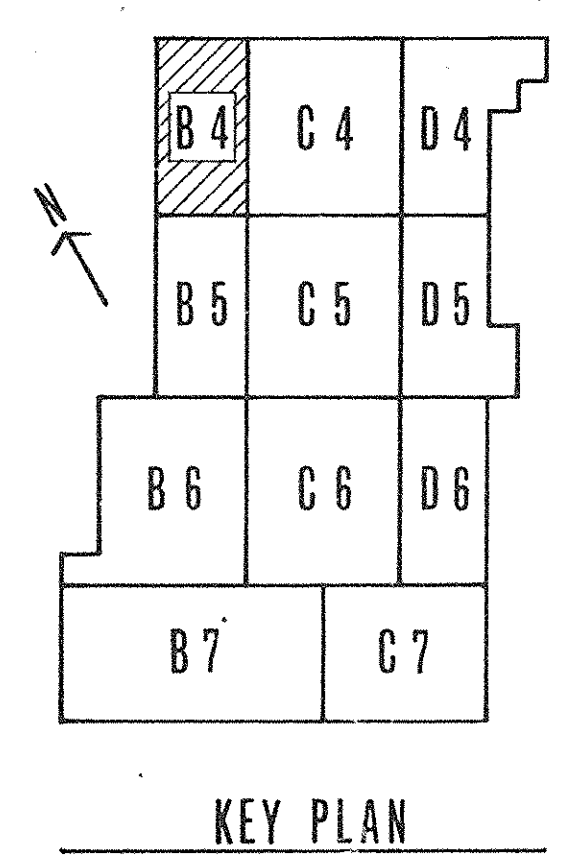


KEY PLAN

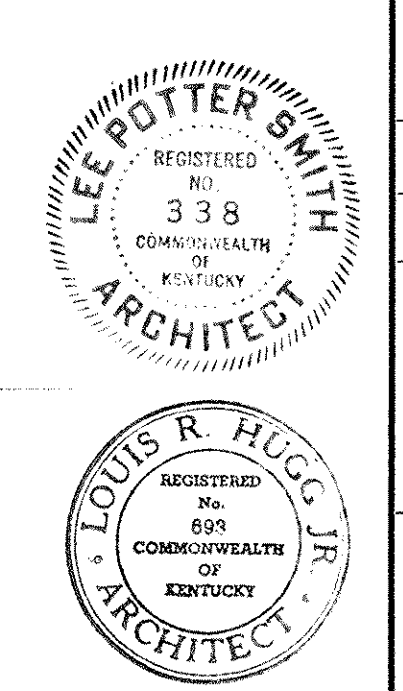


CAPITAL PLAZA DEVELOPMENT PHASE II			FRANKFORT, KENTUCKY	
DRAWN BY J.B. & W.H.	CHECKED BY 338	DATE OCT. 1967	COMM. NO. 50367	
SECTOR NO. B 4		ARCHITECTS LEE POTTER SMITH, PRITCHETT, HUGG & CARTER 314 WILKINSON STREET FRANKFORT, KENTUCKY		DRAWING NO. A 4 OF A-42
APPROVED BY AGENCY HEAD		DATE 10-31		
APPROVED BY OWNER		DATE		

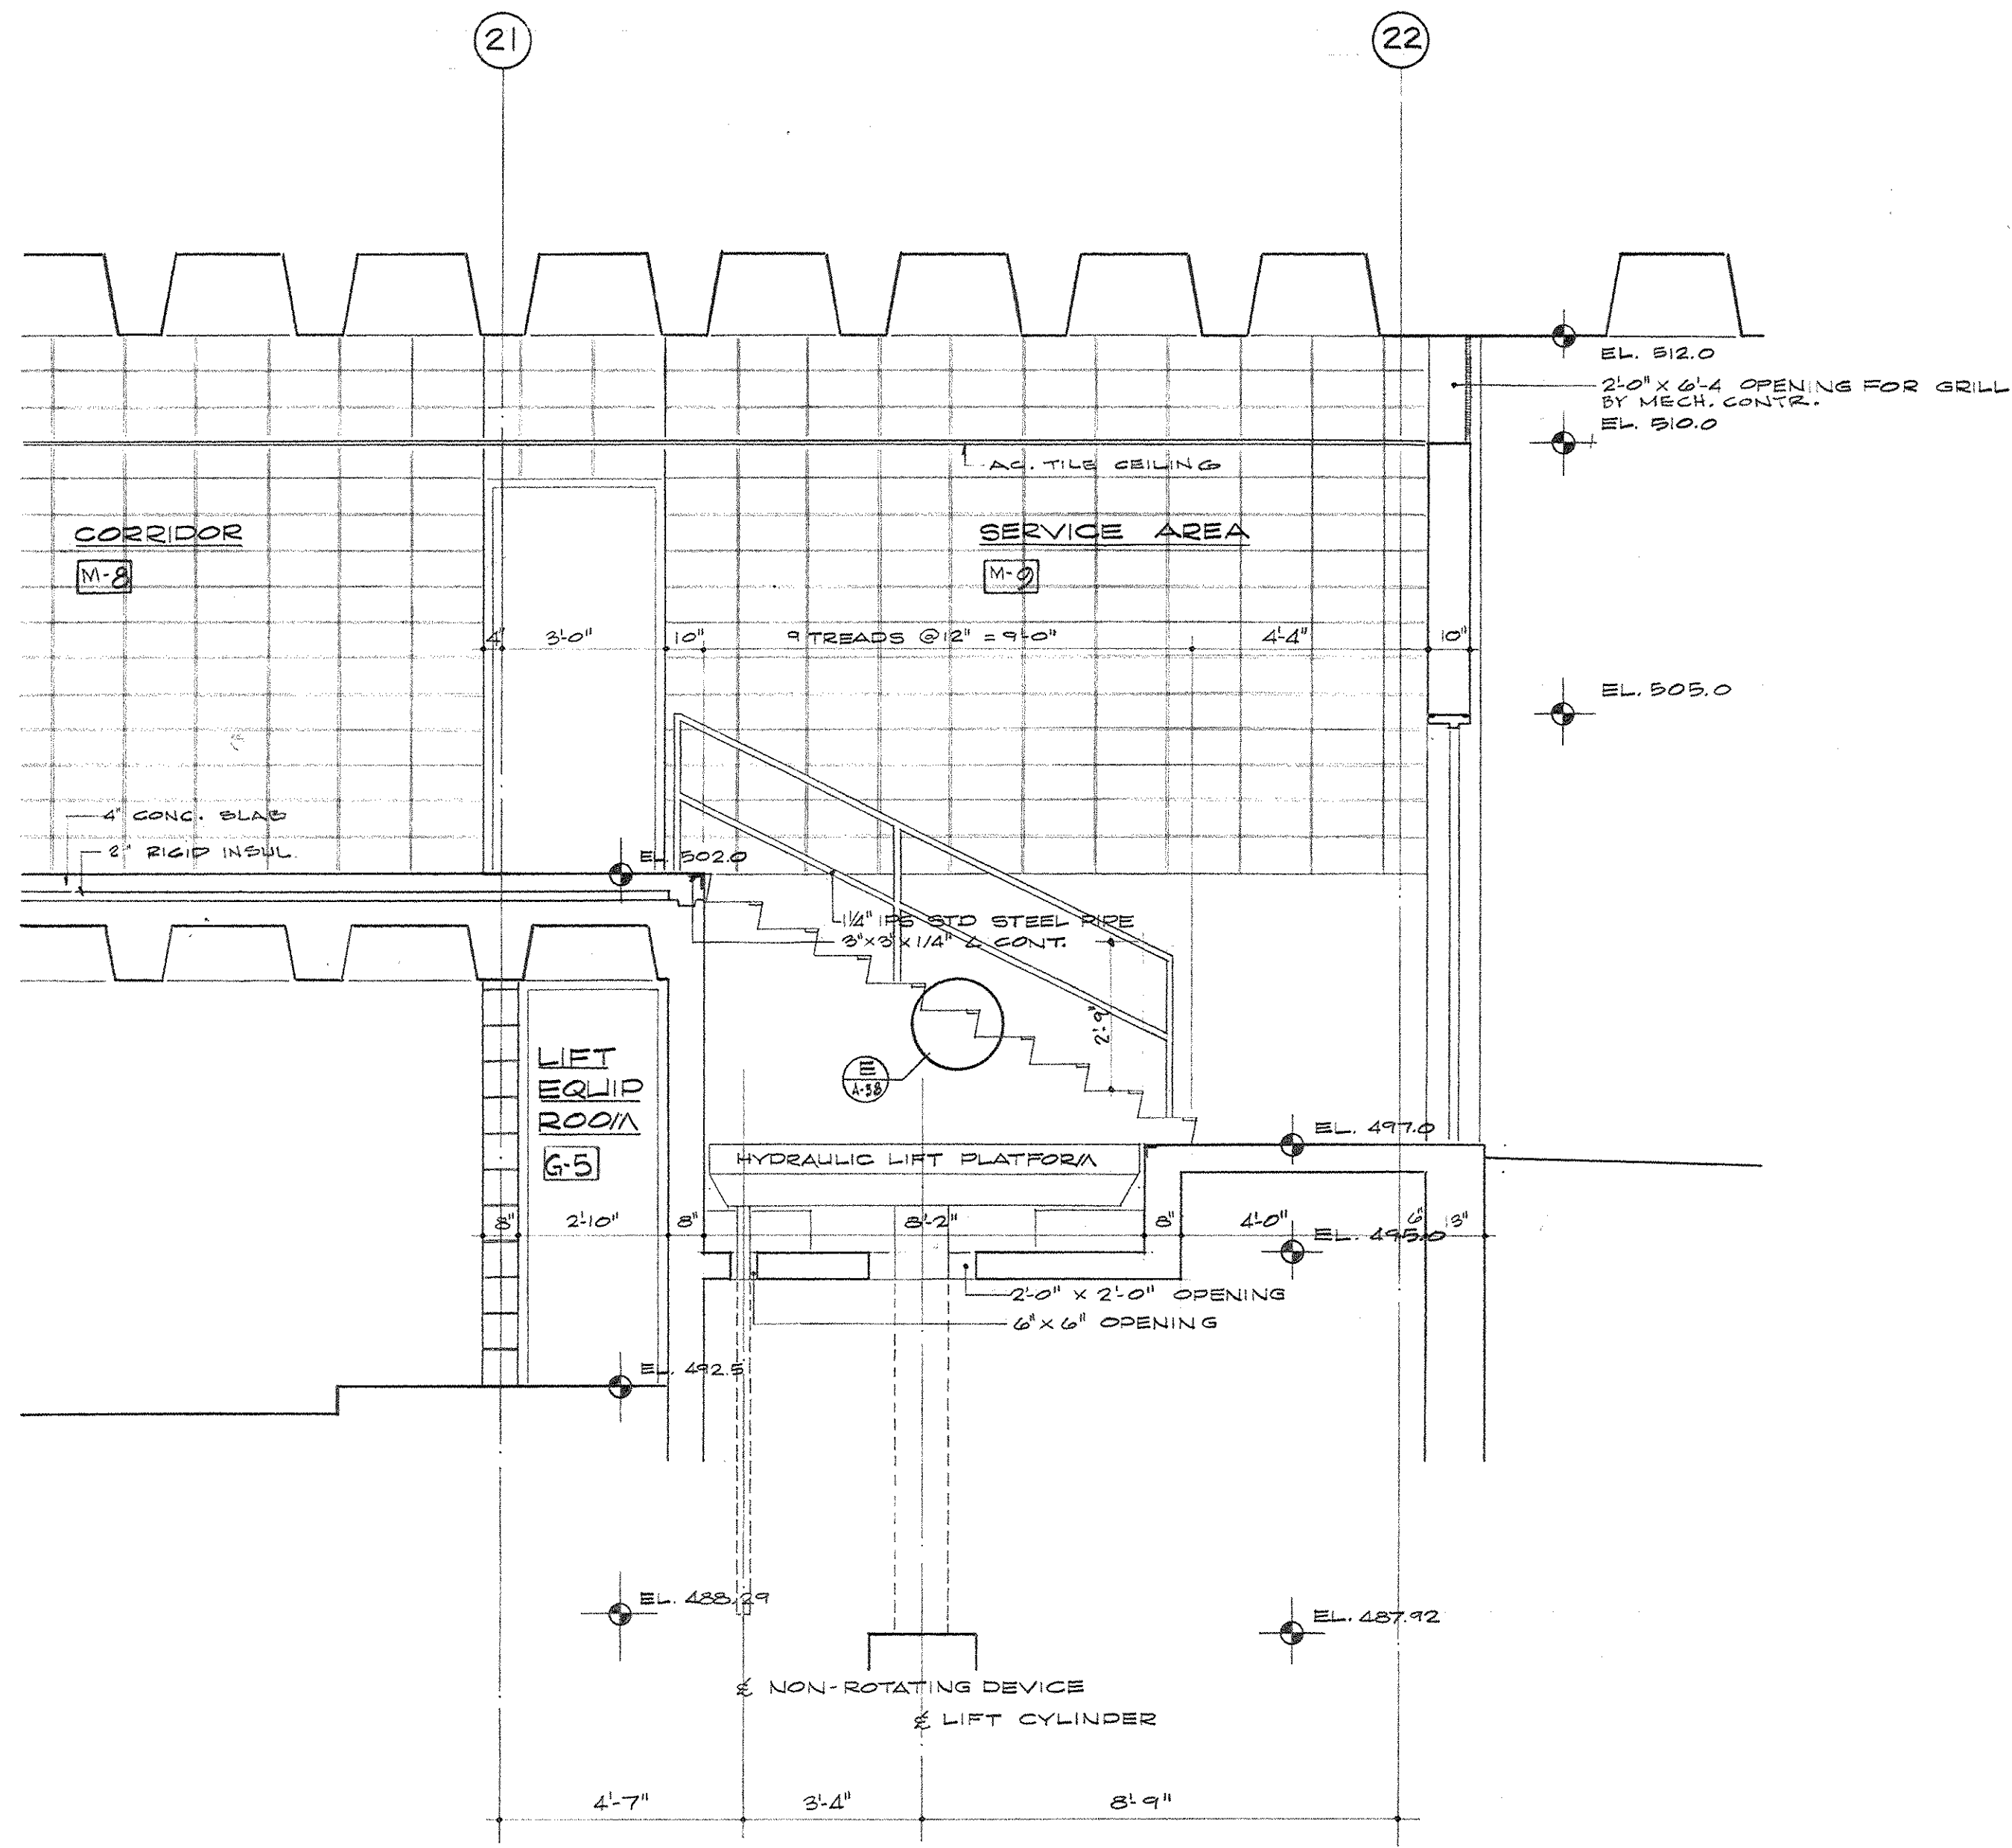


SECTION A-A SERVICE AREA
SCALE 3/8" = 1'-0"

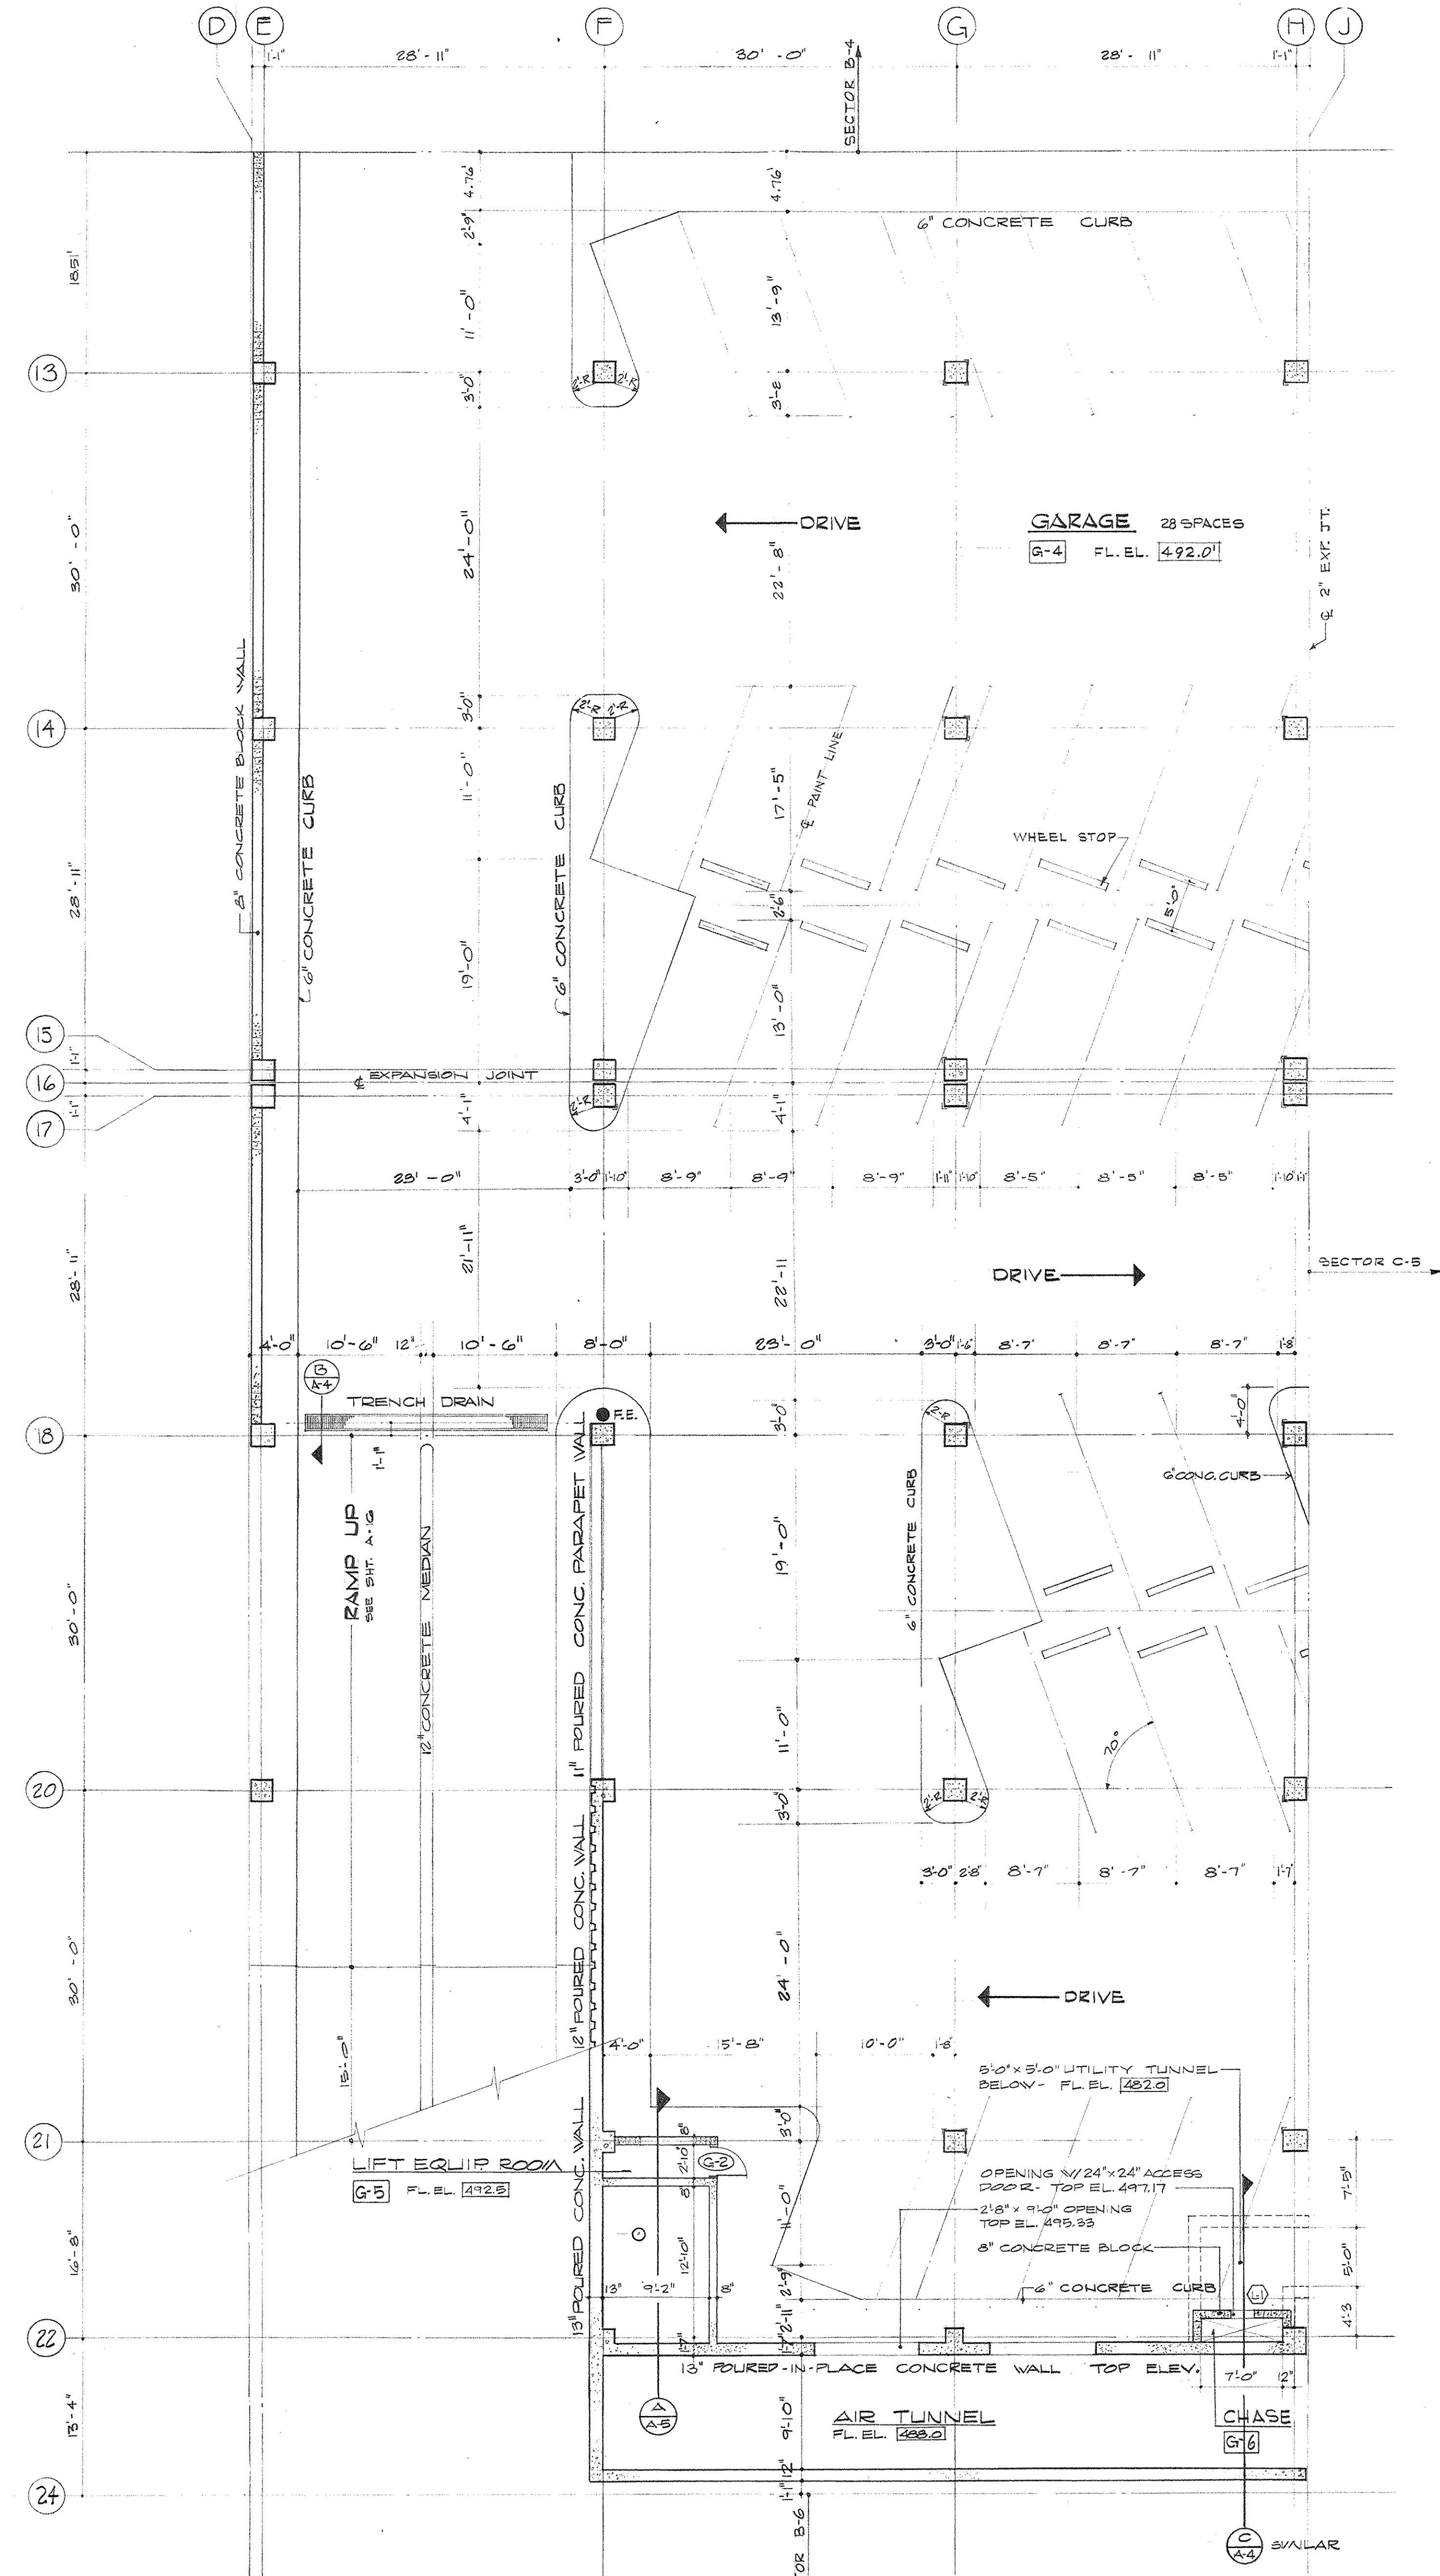

GROUND LEVEL PLAN SECTOR B-5
SCALE 1/8" = 1'-0"

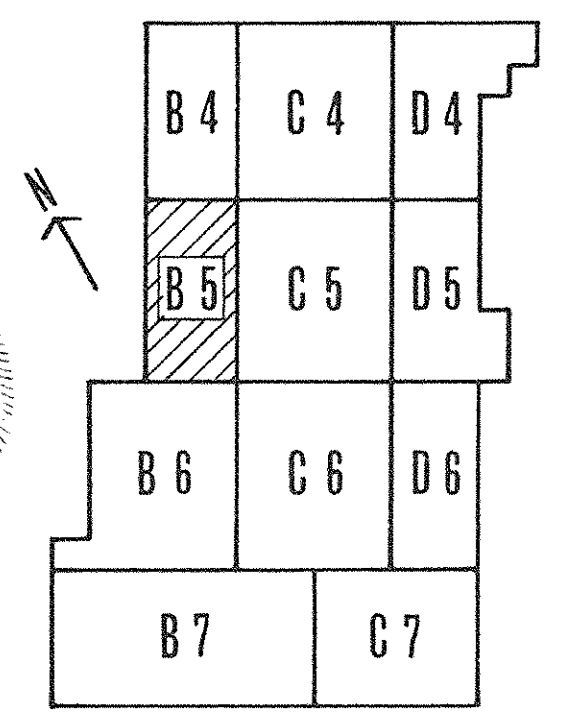


KEY PLAN

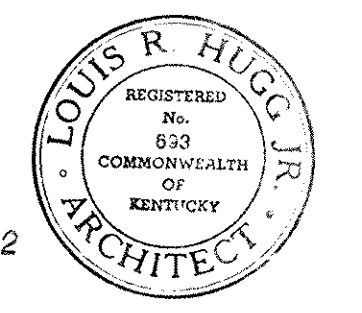


AS BUILT REVISIONS 8-24-72

CAPITAL PLAZA DEVELOPMENT PHASE II FRANKFORT, KENTUCKY		
DRAWN BY J. B. & W. H.	GROUND LEVEL PLAN	DATE 10 OCT. 1967
CHECKED BY KCH		COMM. NO. 50387
SECTOR NO. B 5	LEE POTTER SMITH, PRITCHETT, HUGG & CARTER ARCHITECTS 314 WILKINSON STREET FRANKFORT, KENTUCKY	DRAWING NO. A 5
	COMMONWEALTH OF KENTUCKY DEPARTMENT OF FINANCE - DIVISION OF ENGINEERING FRANKFORT	OF A. 42
APPROVED BY AGENCY HEAD	DATE	
APPROVED BY OWNER	DATE 10-21-67	

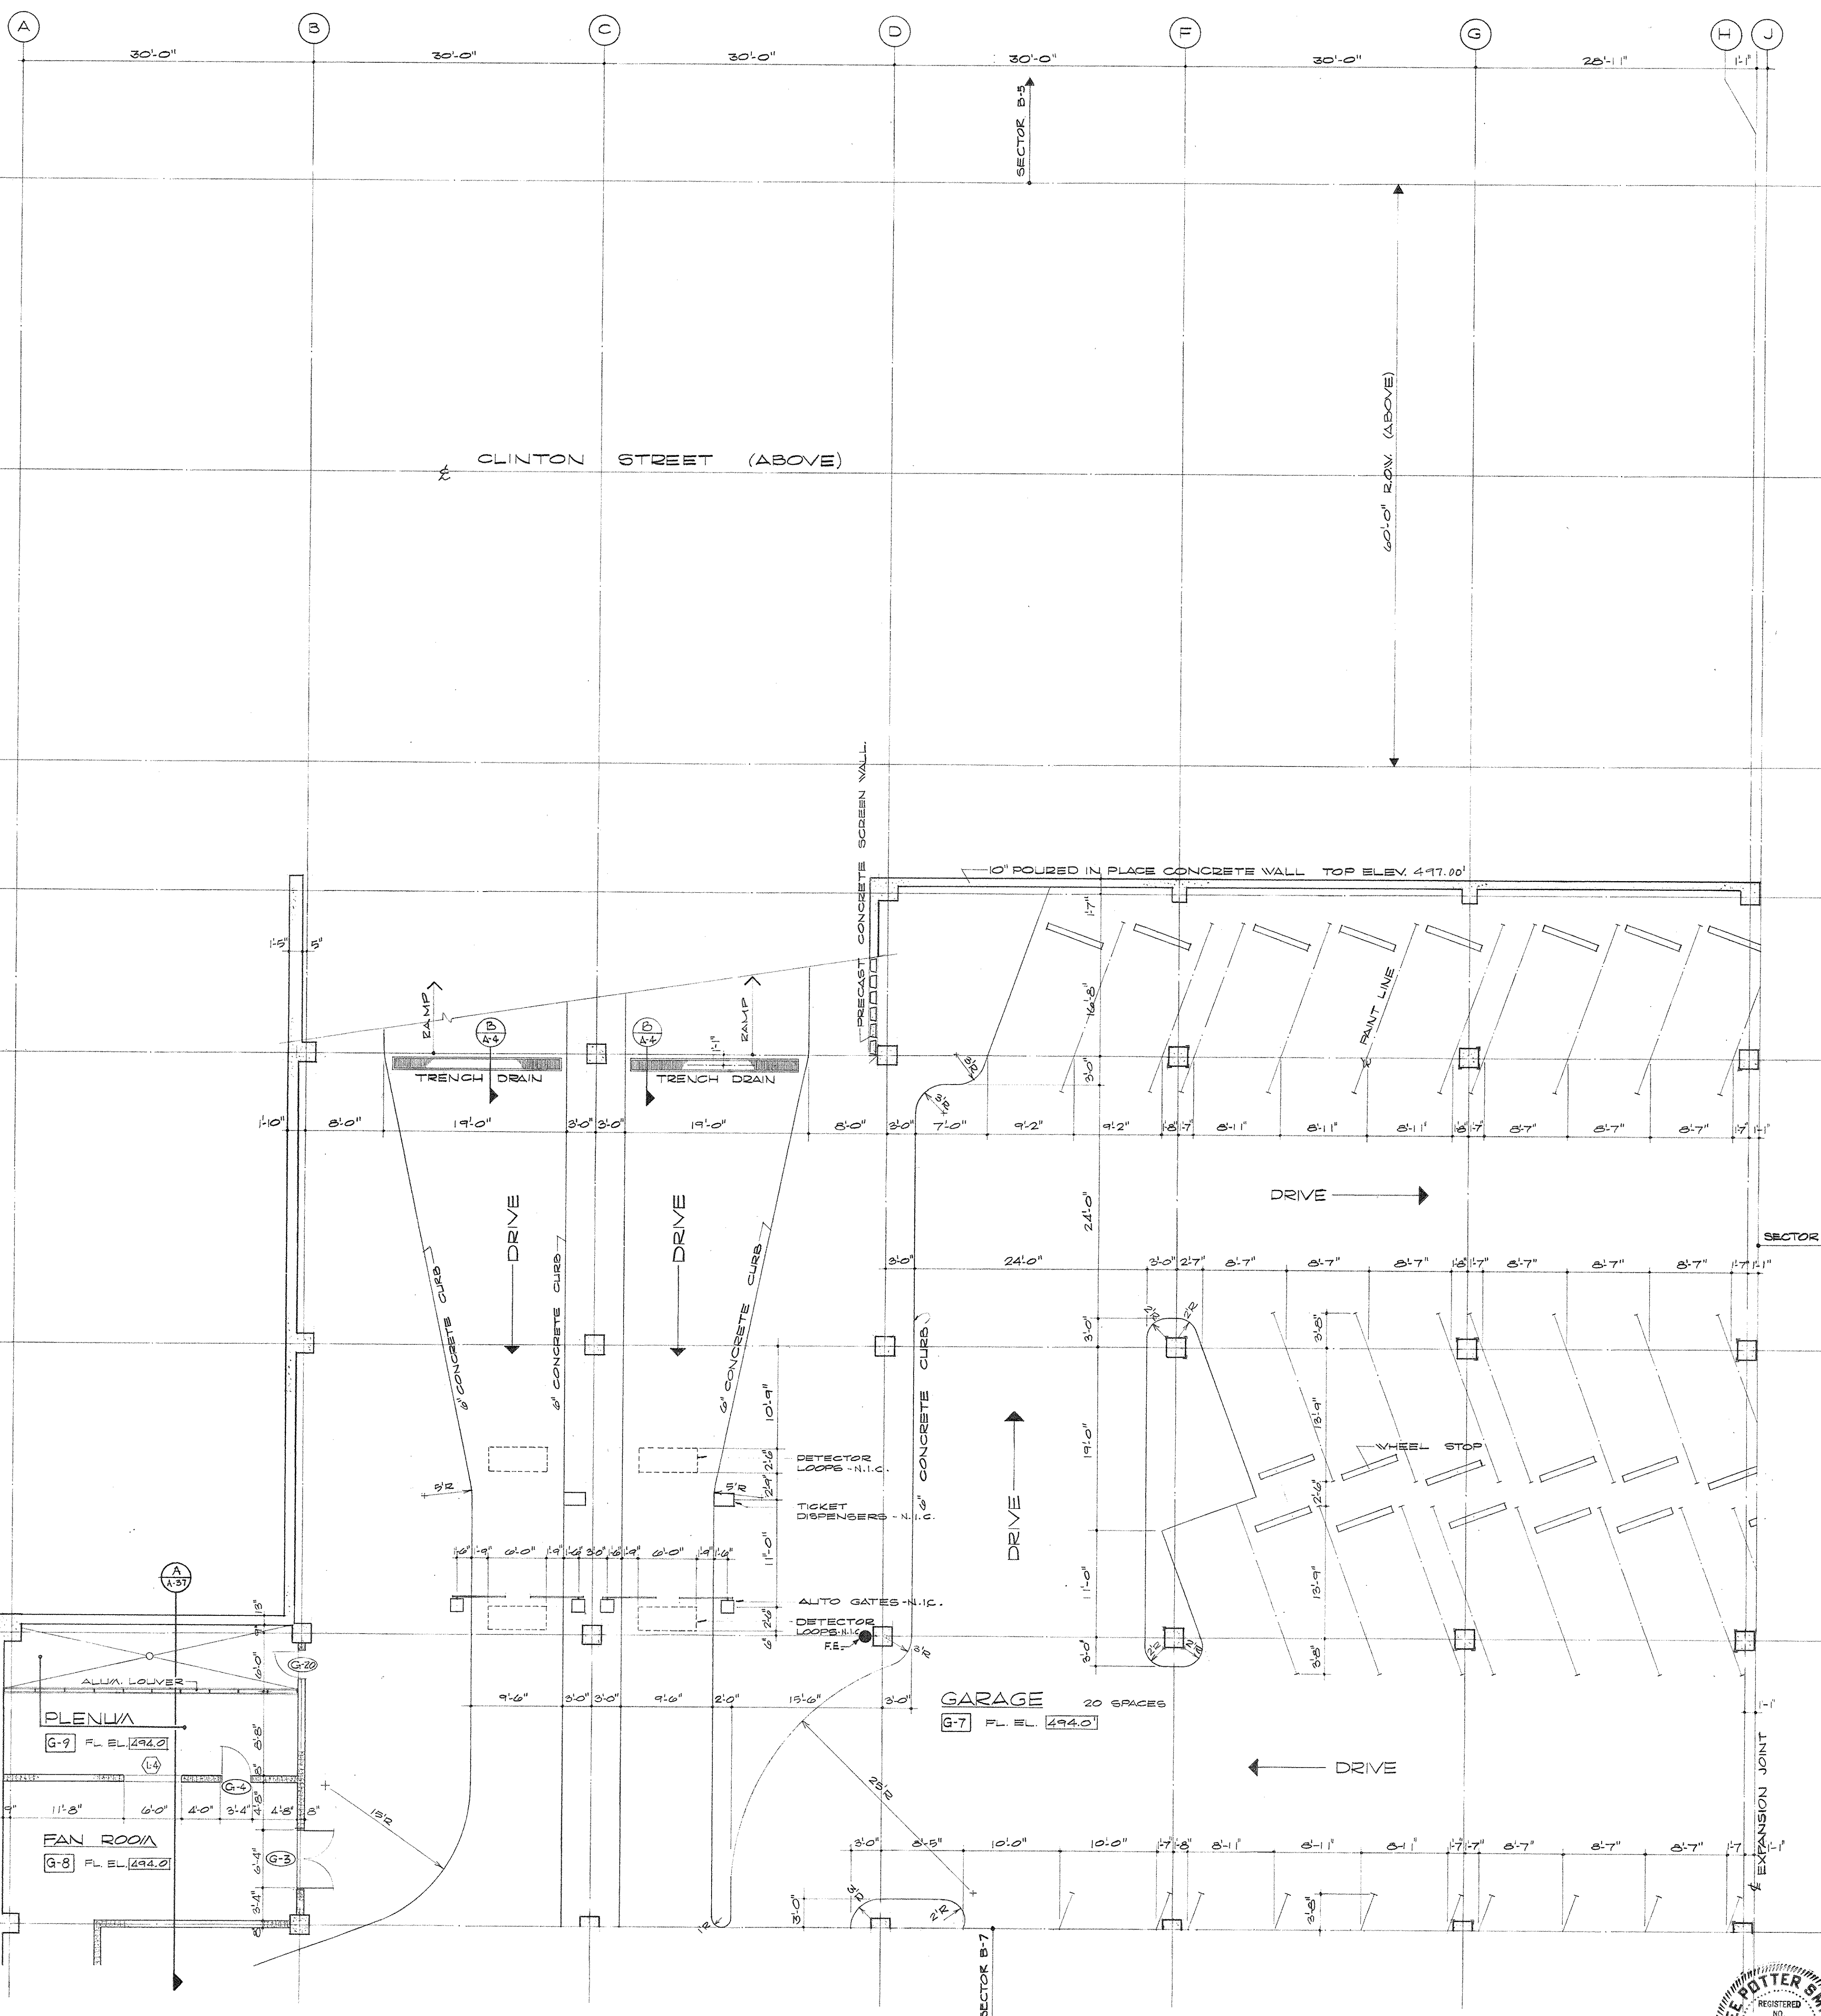

GROUND LEVEL PLAN SECTOR B-6
SCALE 1/8" = 1'-0"


AS BUILT REVISIONS - 8-24-72

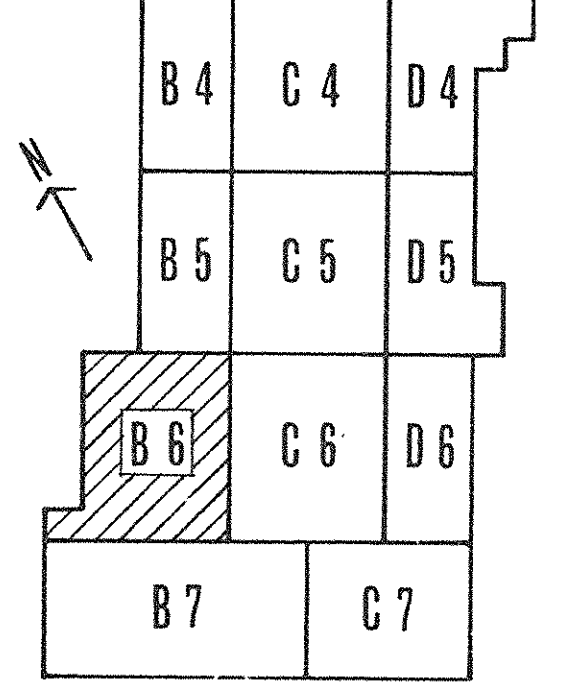


KEY PLAN








CAPITAL PLAZA DEVELOPMENT PHASE II FRANKFORT, KENTUCKY		
DRAWN BY L.S.	GROUND LEVEL PLAN	DATE 10 OCT 1967
CHECKED BY L.H.		COMM. NO. 50367
SECTOR NO. B 6	LEE POTTER SMITH, PRITCHETT, HUGG & CARTER ARCHITECTS 314 WILKINSON STREET FRANKFORT, KENTUCKY	DRAWING NO. A 6
APPROVED BY	COMMONWEALTH OF KENTUCKY DEPARTMENT OF FRANCE - DIVISION OF ENGINEERING FRANKFORT KENTUCKY	OF A-42
APPROVED BY	AGENCY HEAD <i>W. M. Campbell</i>	DATE 10-26-67
APPROVED BY	OWNER	

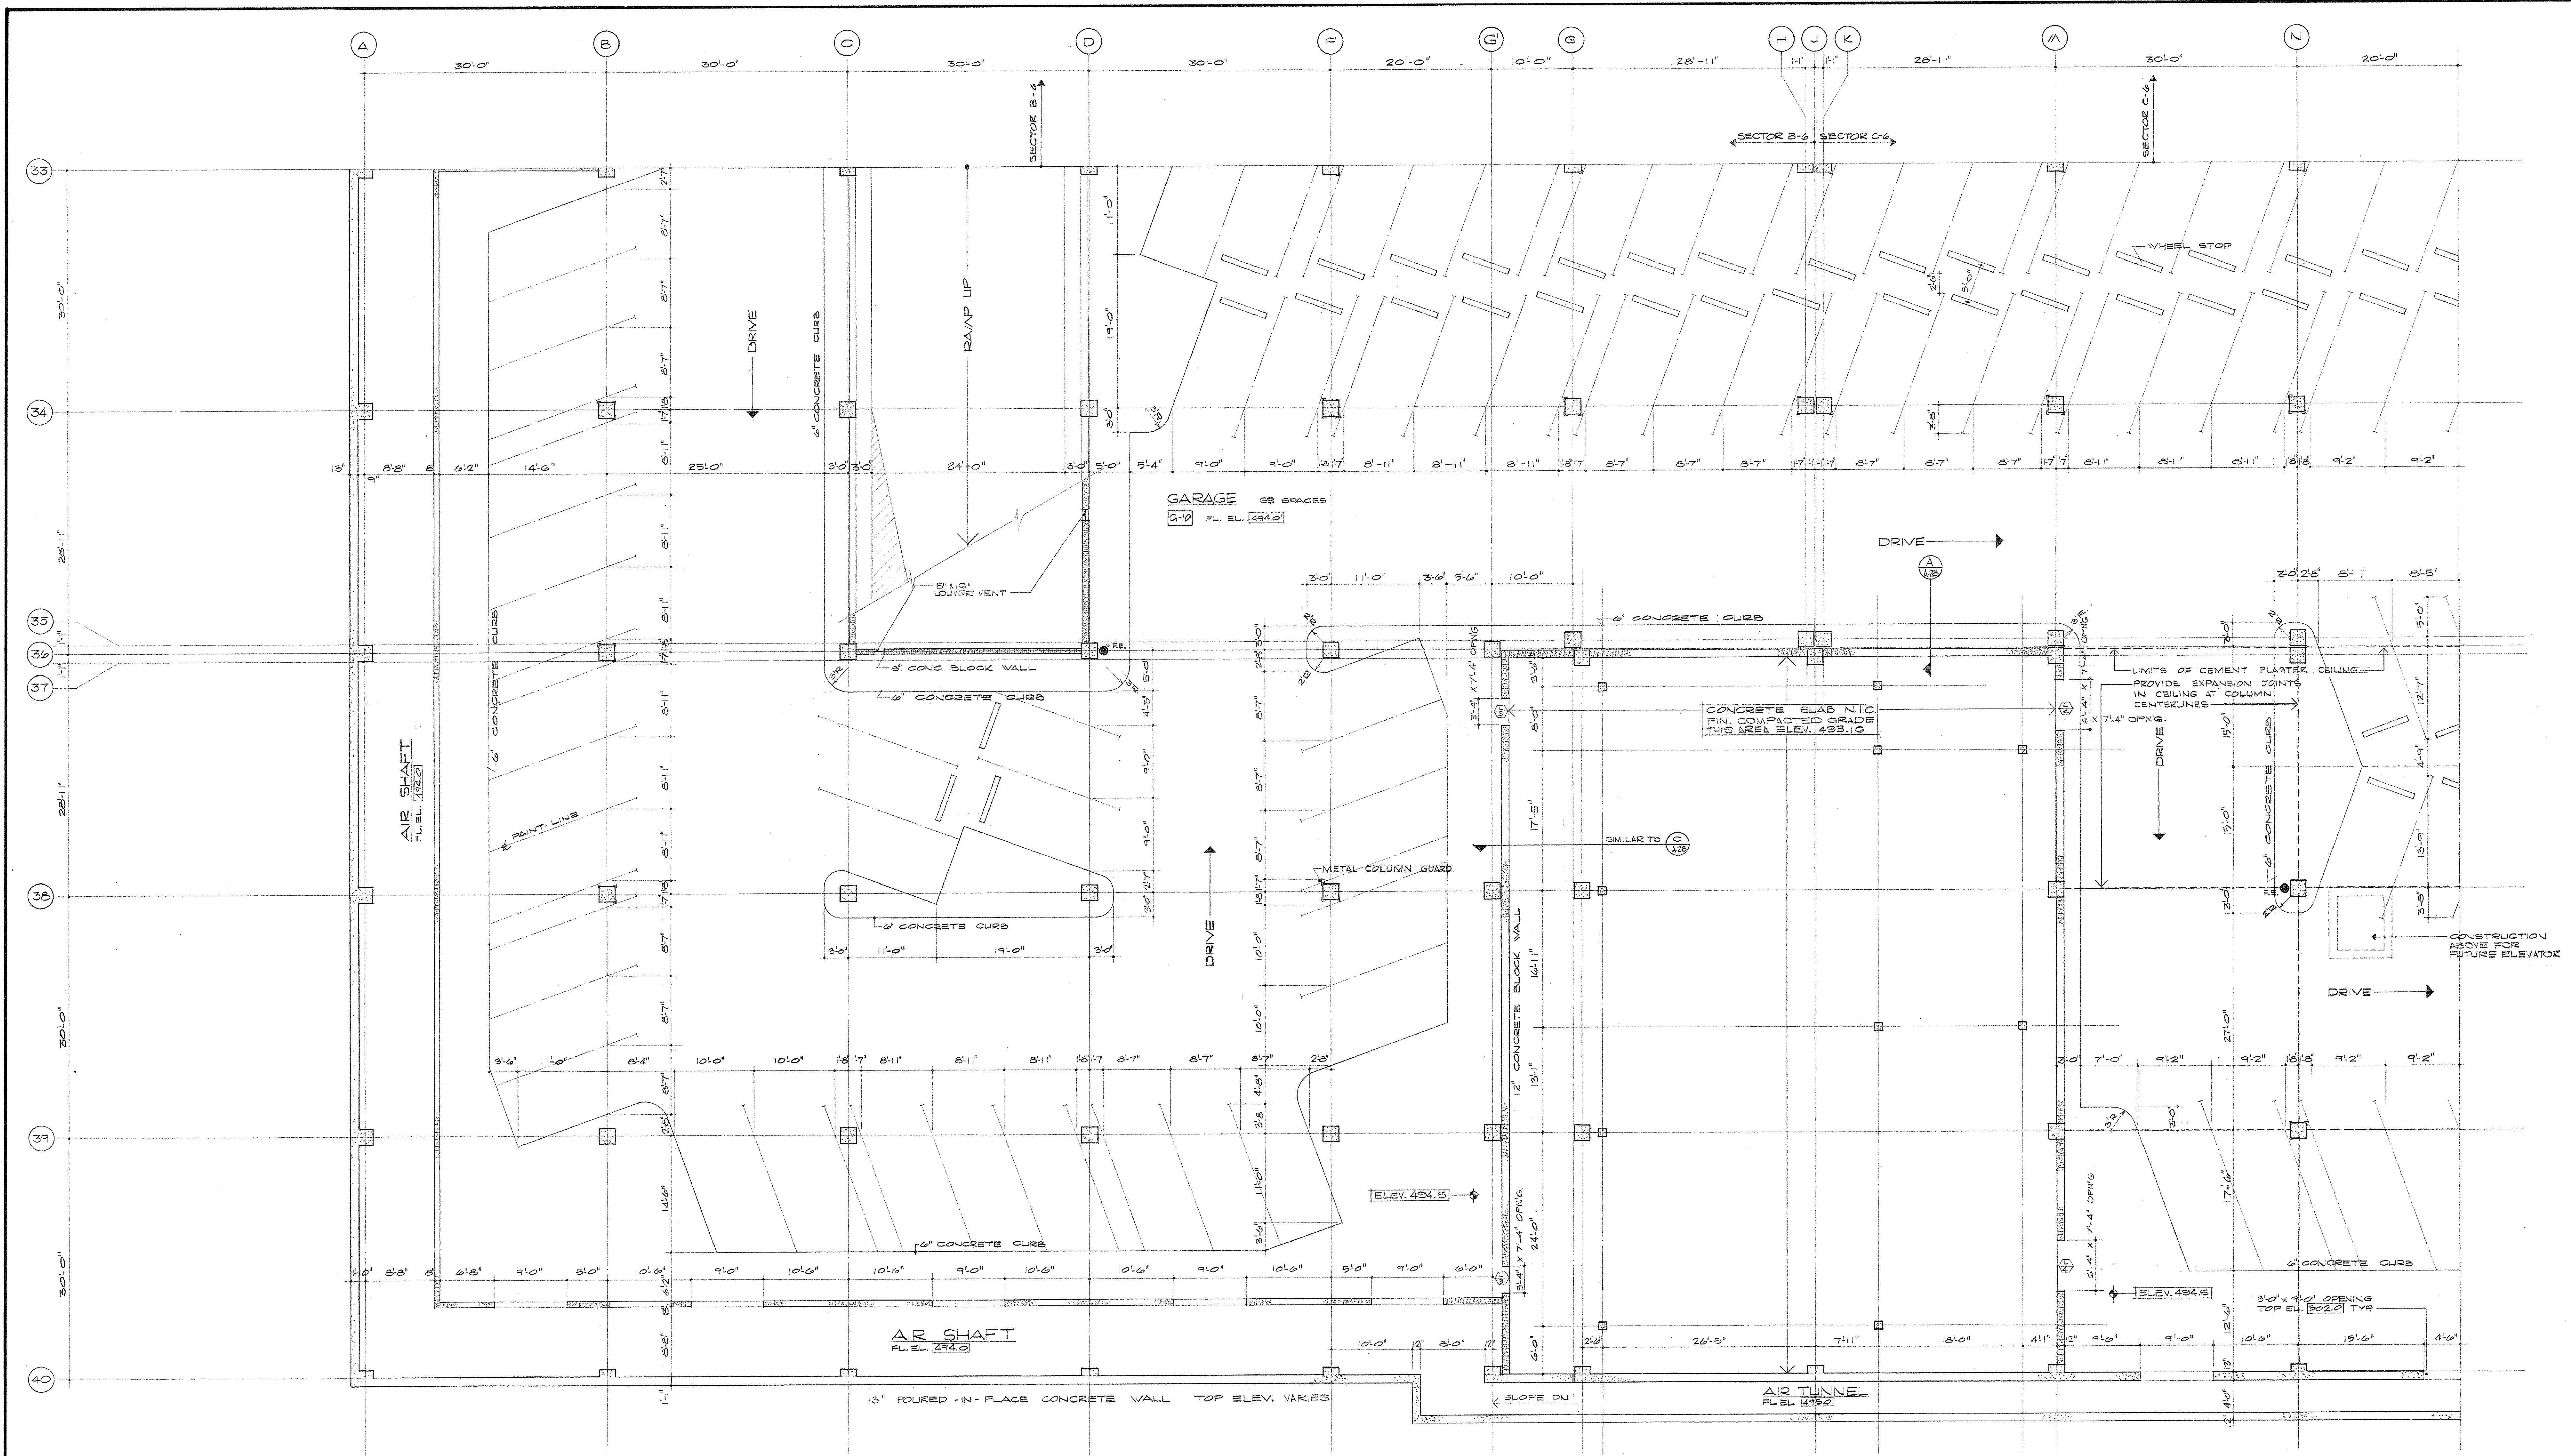


GROUND LEVEL PLAN SECTOR B-7
 SCALE 1/8"=1'-0"
 NOTE: SYMBOL "R.E." INDICATES LOCATION OF CO² FIRE EXTINGUISHERS. SEE SPECS

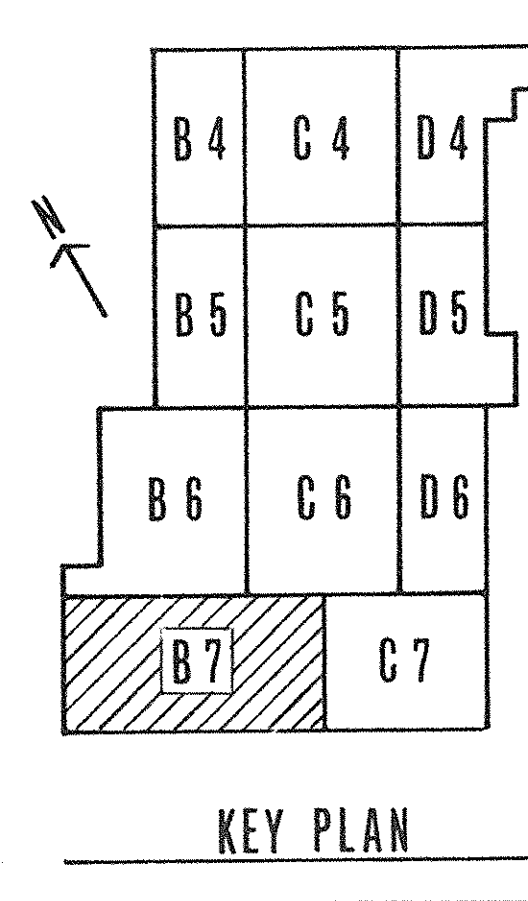


AS BUILT REVISIONS 8-23-72		
CAPITAL PLAZA DEVELOPMENT PHASE II FRANKFORT, KENTUCKY		
DRAWN BY U.B. & W.R.	DATE OCT. 1967	COM. NO. 50367
CHECKED BY E.L.C.	GROUND LEVEL PLAN	
SECTOR NO. B 7	LEE POTTER SMITH, PRITCHETT, HUGG & CARTER ARCHITECTS 314 WILKINSON STREET FRANKFORT, KENTUCKY	ENGINEERS FRANKFORT, KENTUCKY
APPROVED BY OWNER	COMMONWEALTH OF KENTUCKY DEPARTMENT OF FINANCE - DIVISION OF ENGINEERING FRANKFORT	DRAWING NO. A 7 OF 2-42
APPROVED BY AGENCY HEAD	DATE 10-26-67	

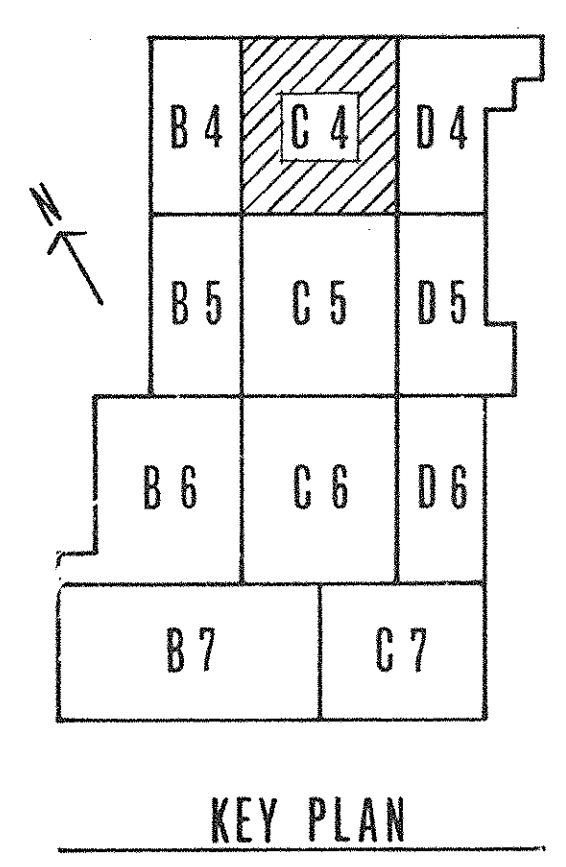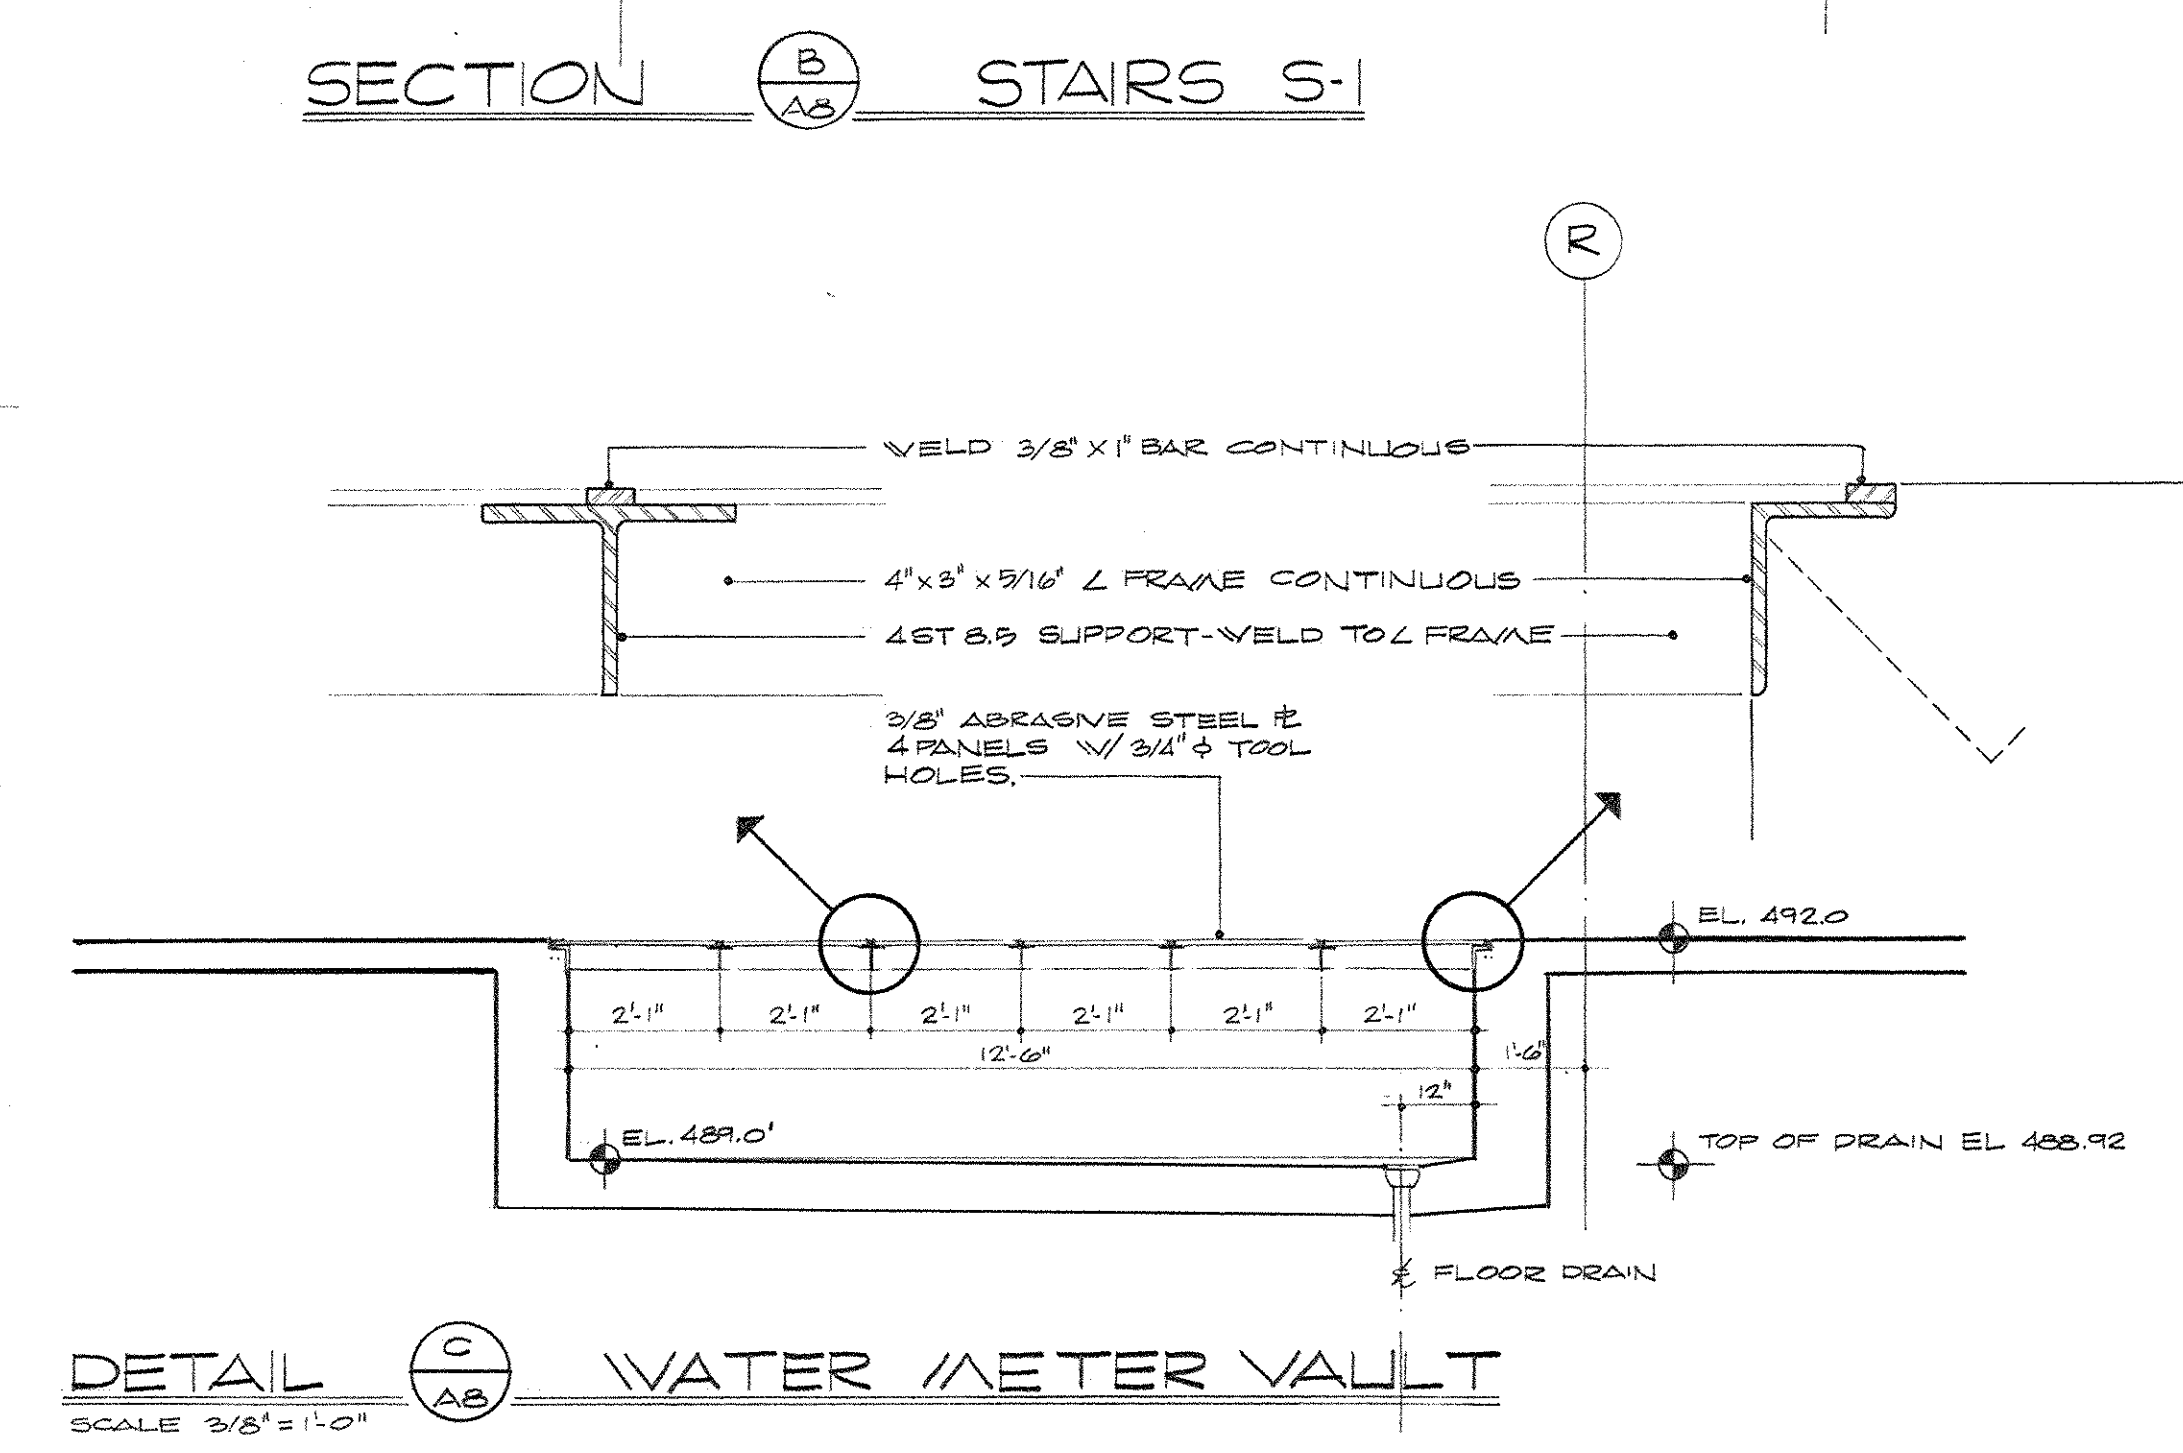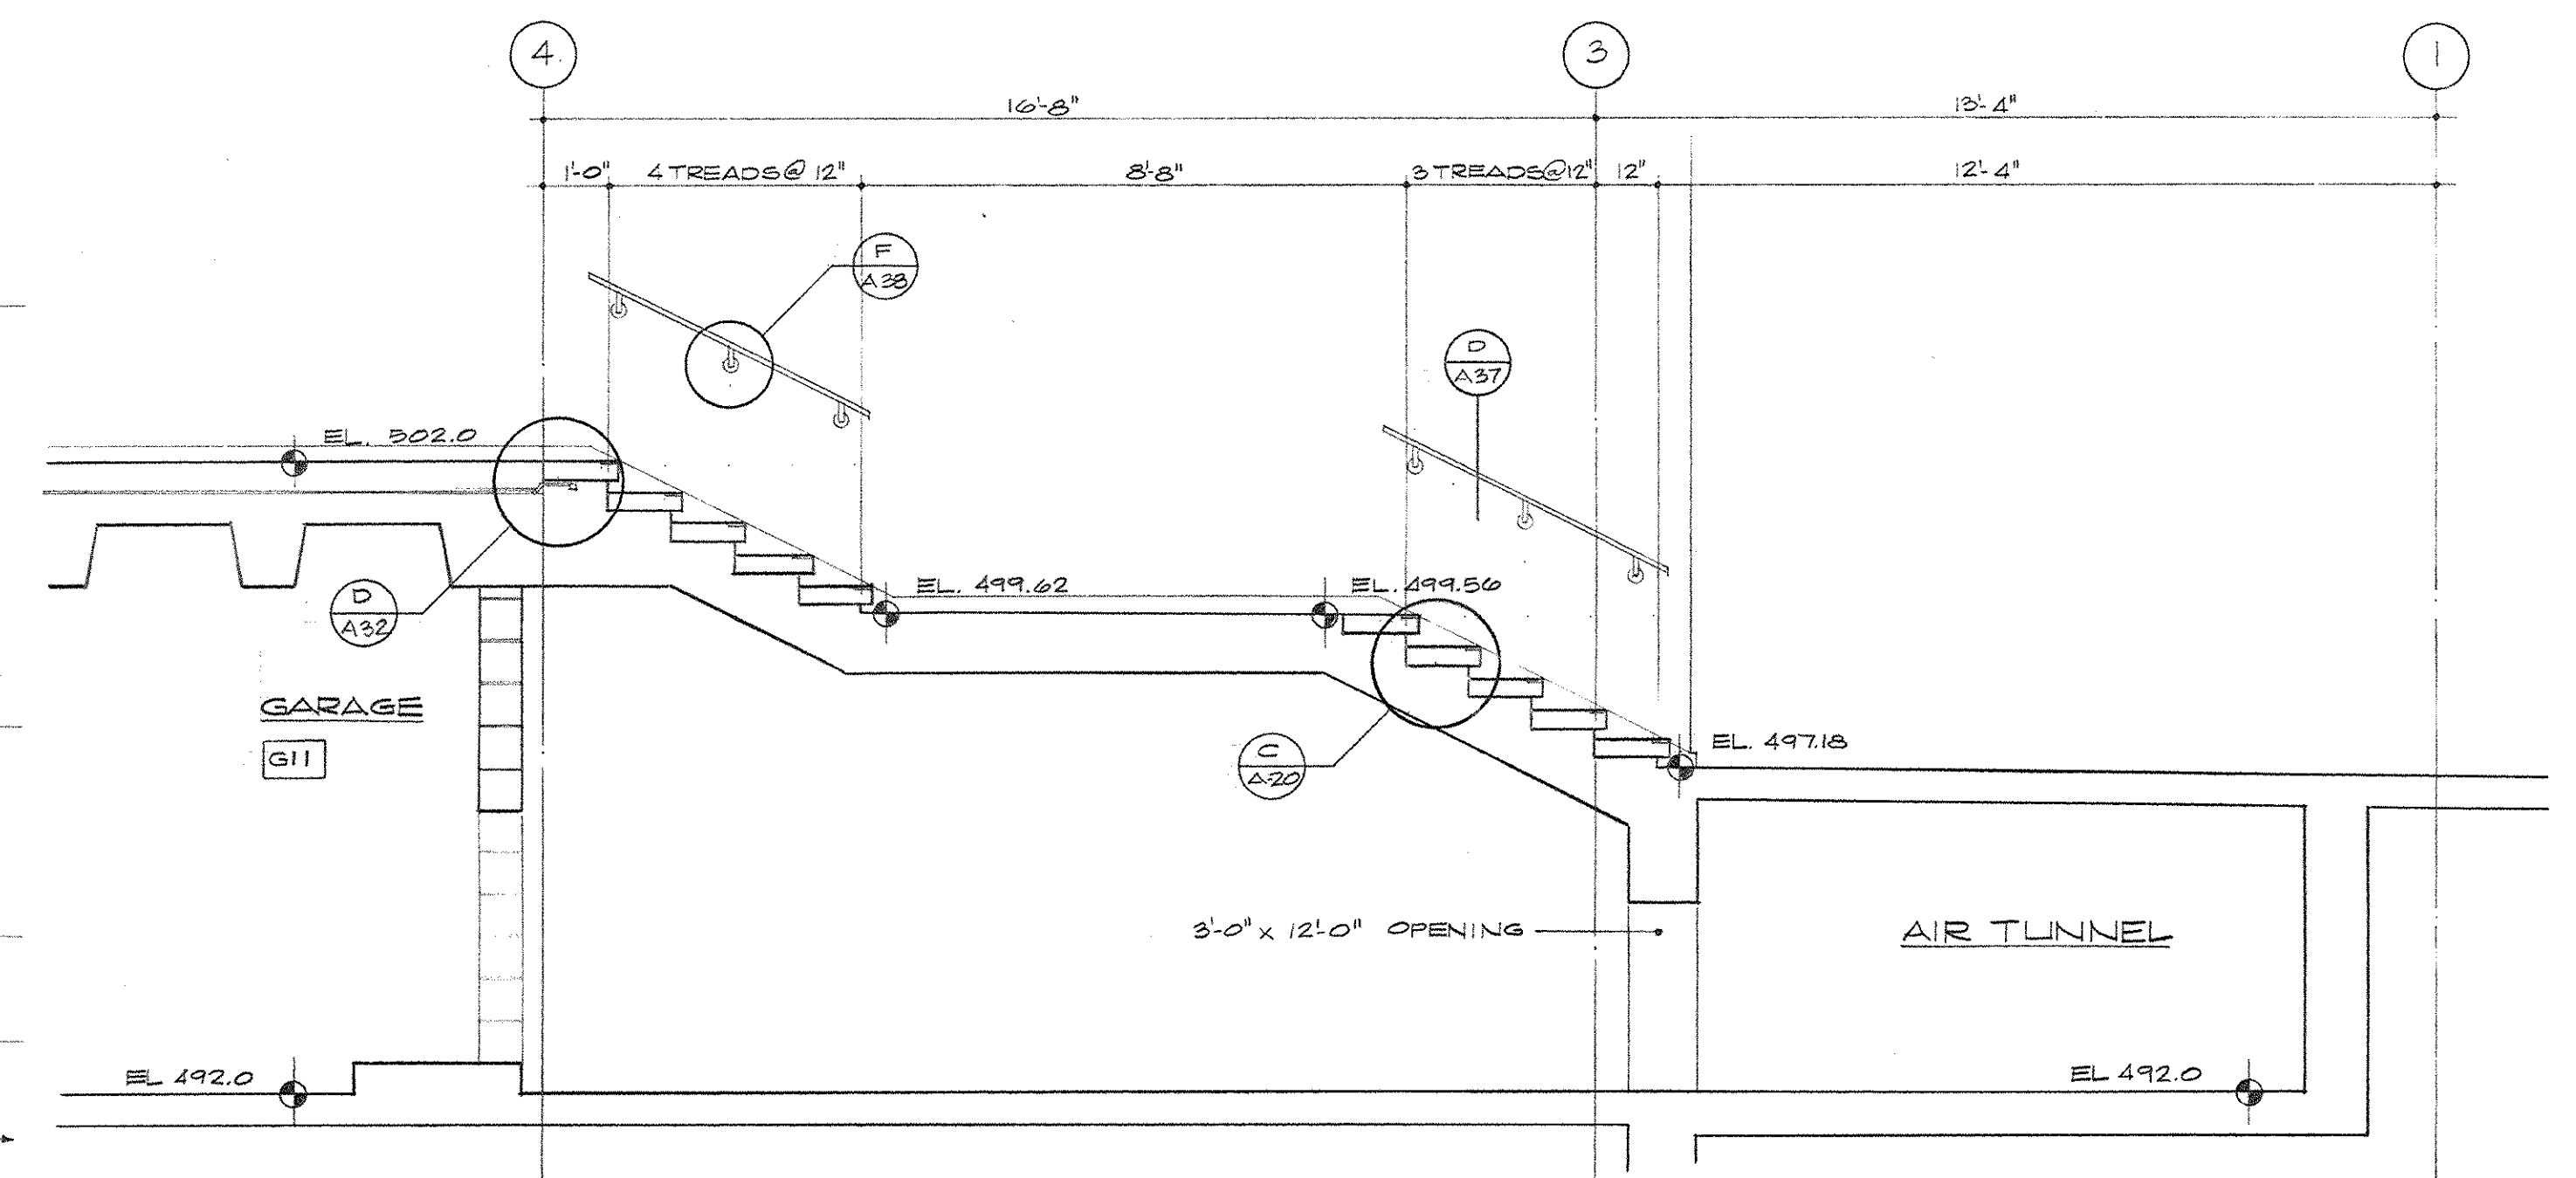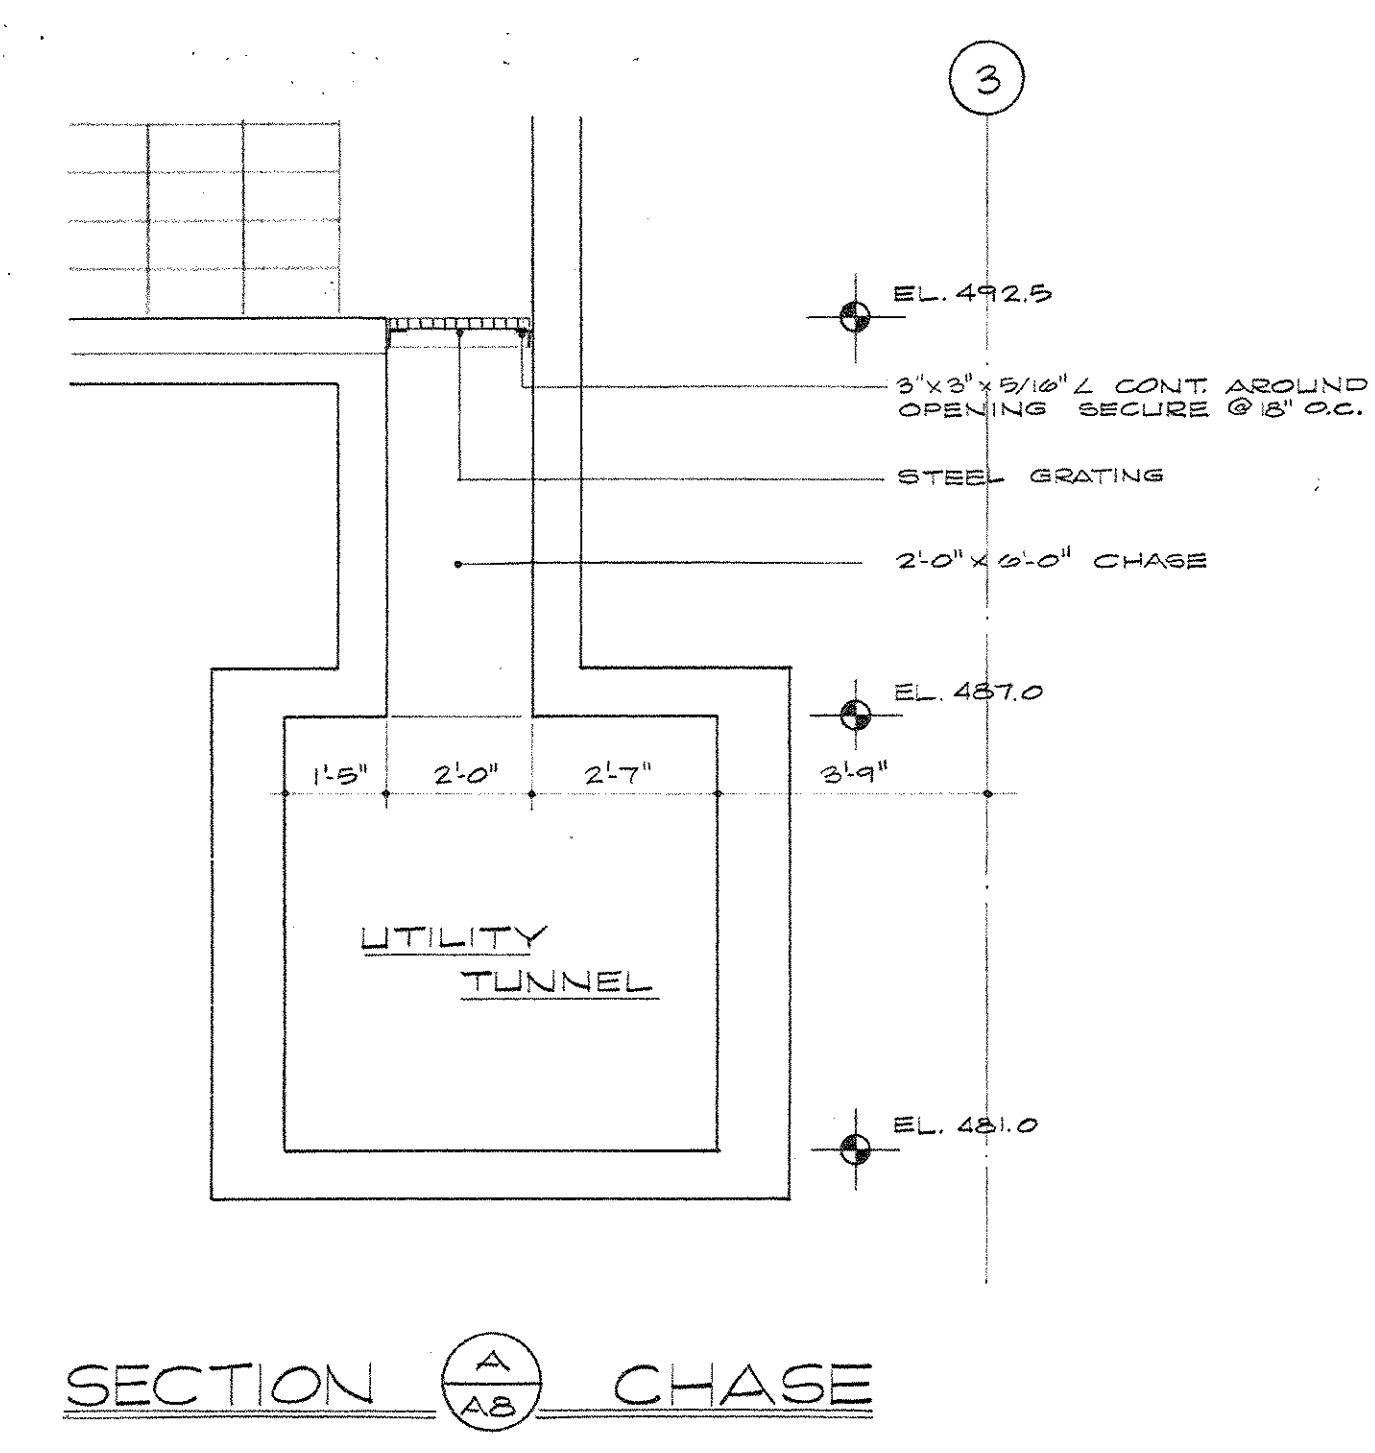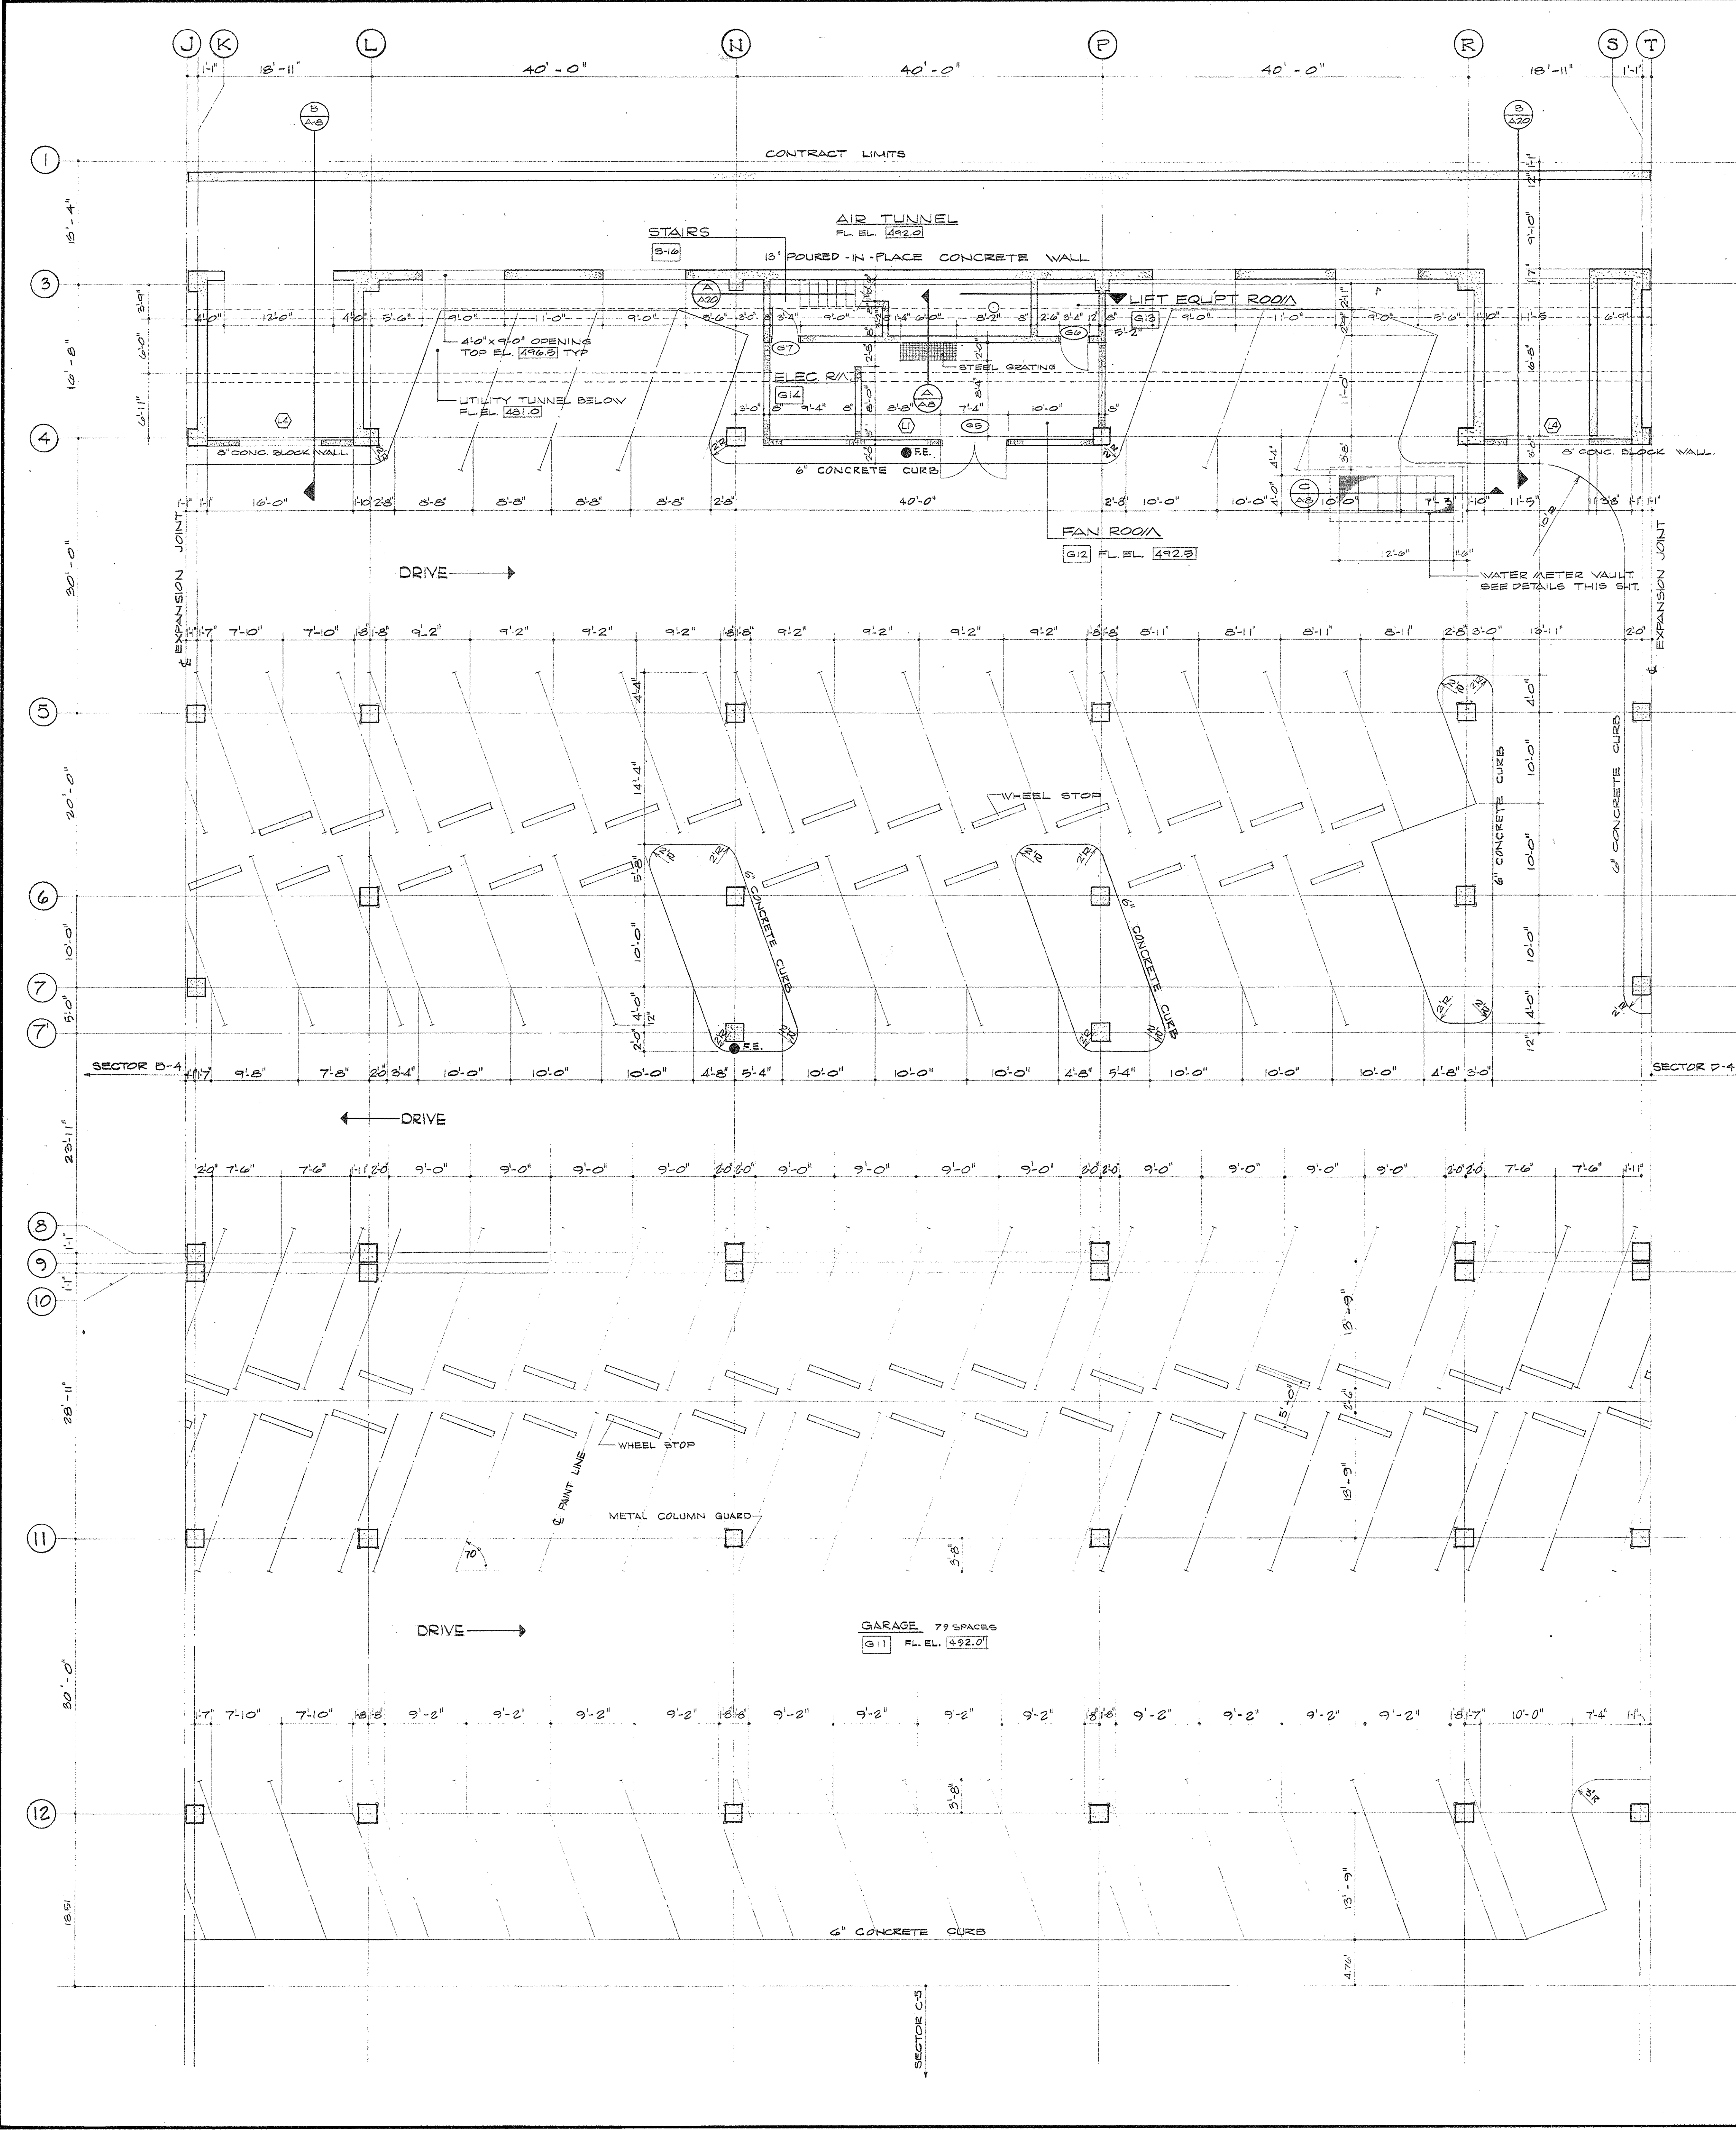


AS BUILT REVISIONS: 8-24-72

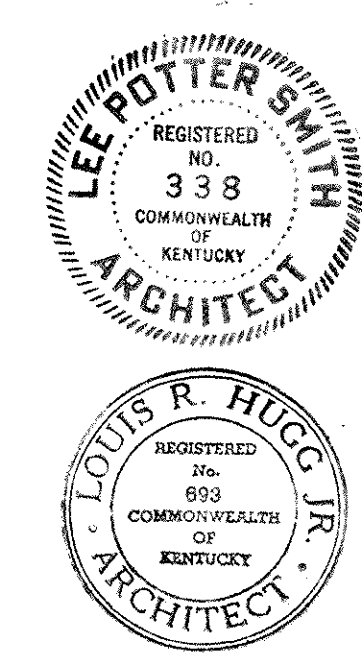


CAPITAL PLAZA DEVELOPMENT PHASE II		
FRANKFORT, KENTUCKY		
DRAWN BY W.H. & J.B.	GROUND LEVEL PLAN	DATE OCT 1967
CHECKED BY C.T.H.		COMM. NO. 50367
SECTOR NO. C 4	LEE POTTER SMITH, PRITCHETT, HUGG & CARTER ARCHITECTS 314 WILKINSON STREET FRANKFORT, KENTUCKY	DRAWING NO. A 8
	COMMONWEALTH OF KENTUCKY DEPARTMENT OF FINANCE - DIVISION OF ENGINEERING FRANKFORT, KENTUCKY	OF A 42
APPROVED BY AGENCY HEAD	DATE	
APPROVED BY OWNER	DATE	10-26-67

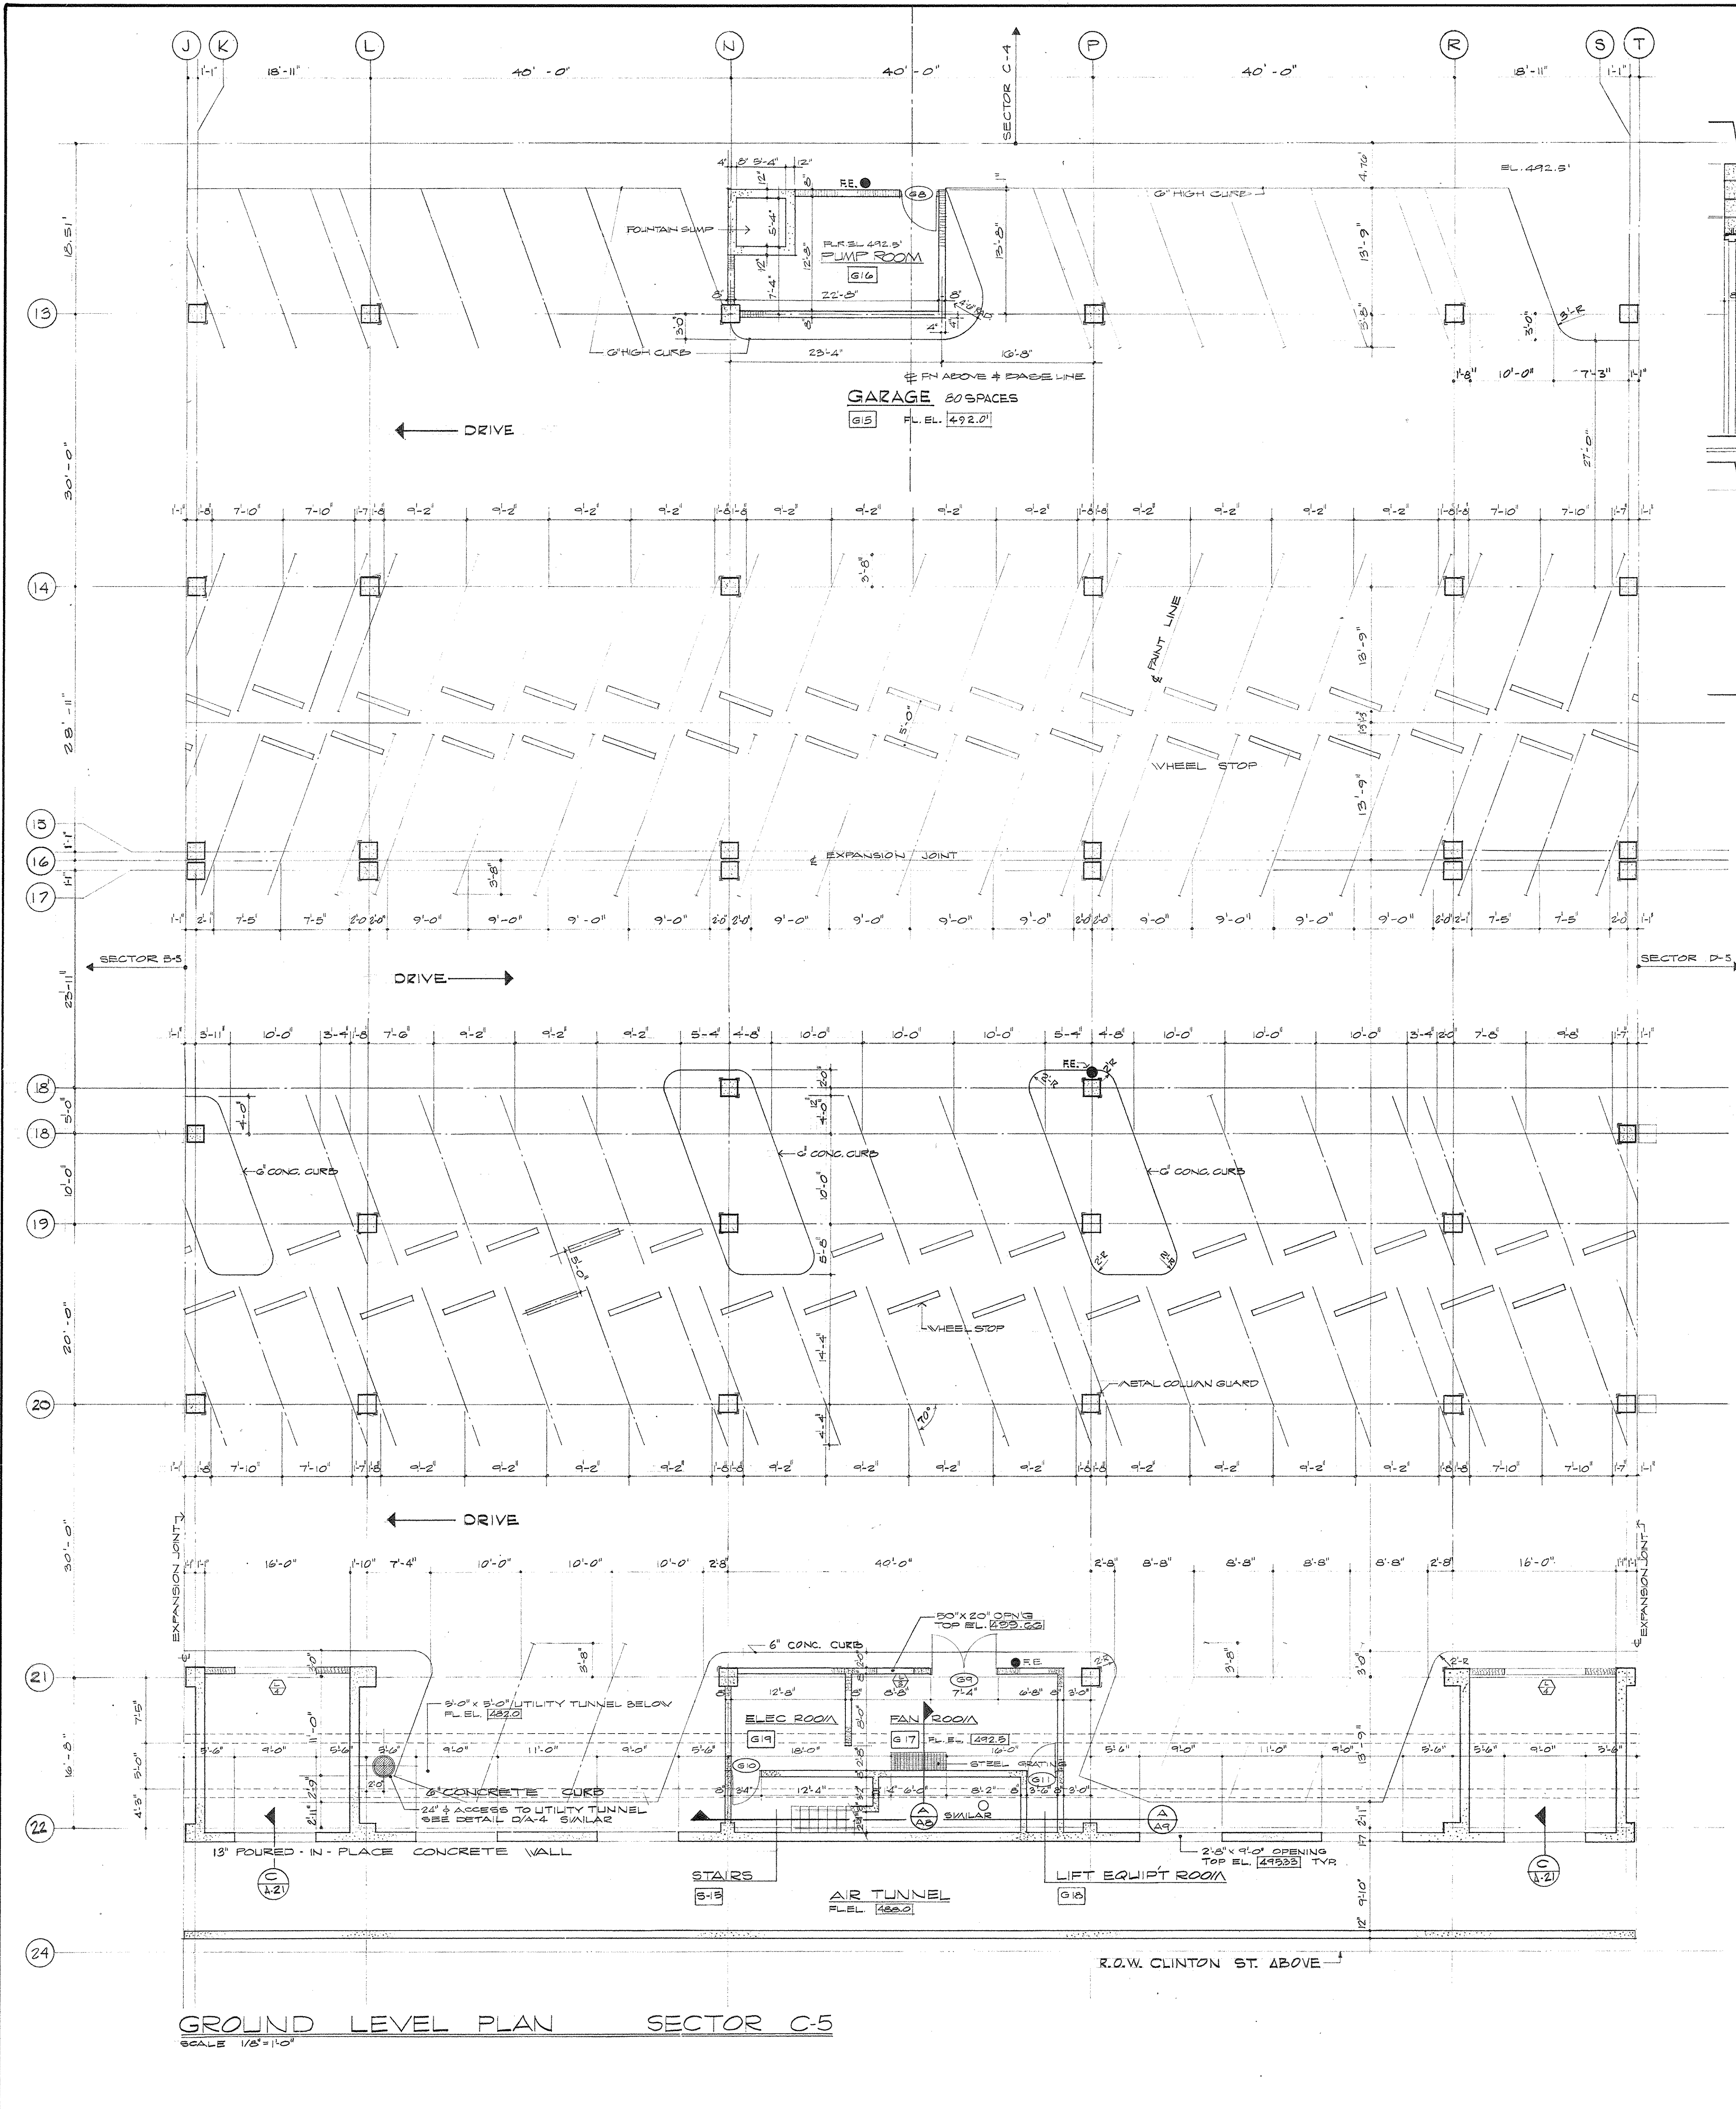

GROUND LEVEL PLAN SECTOR C-5
SCALE 1/8" = 1'-0"

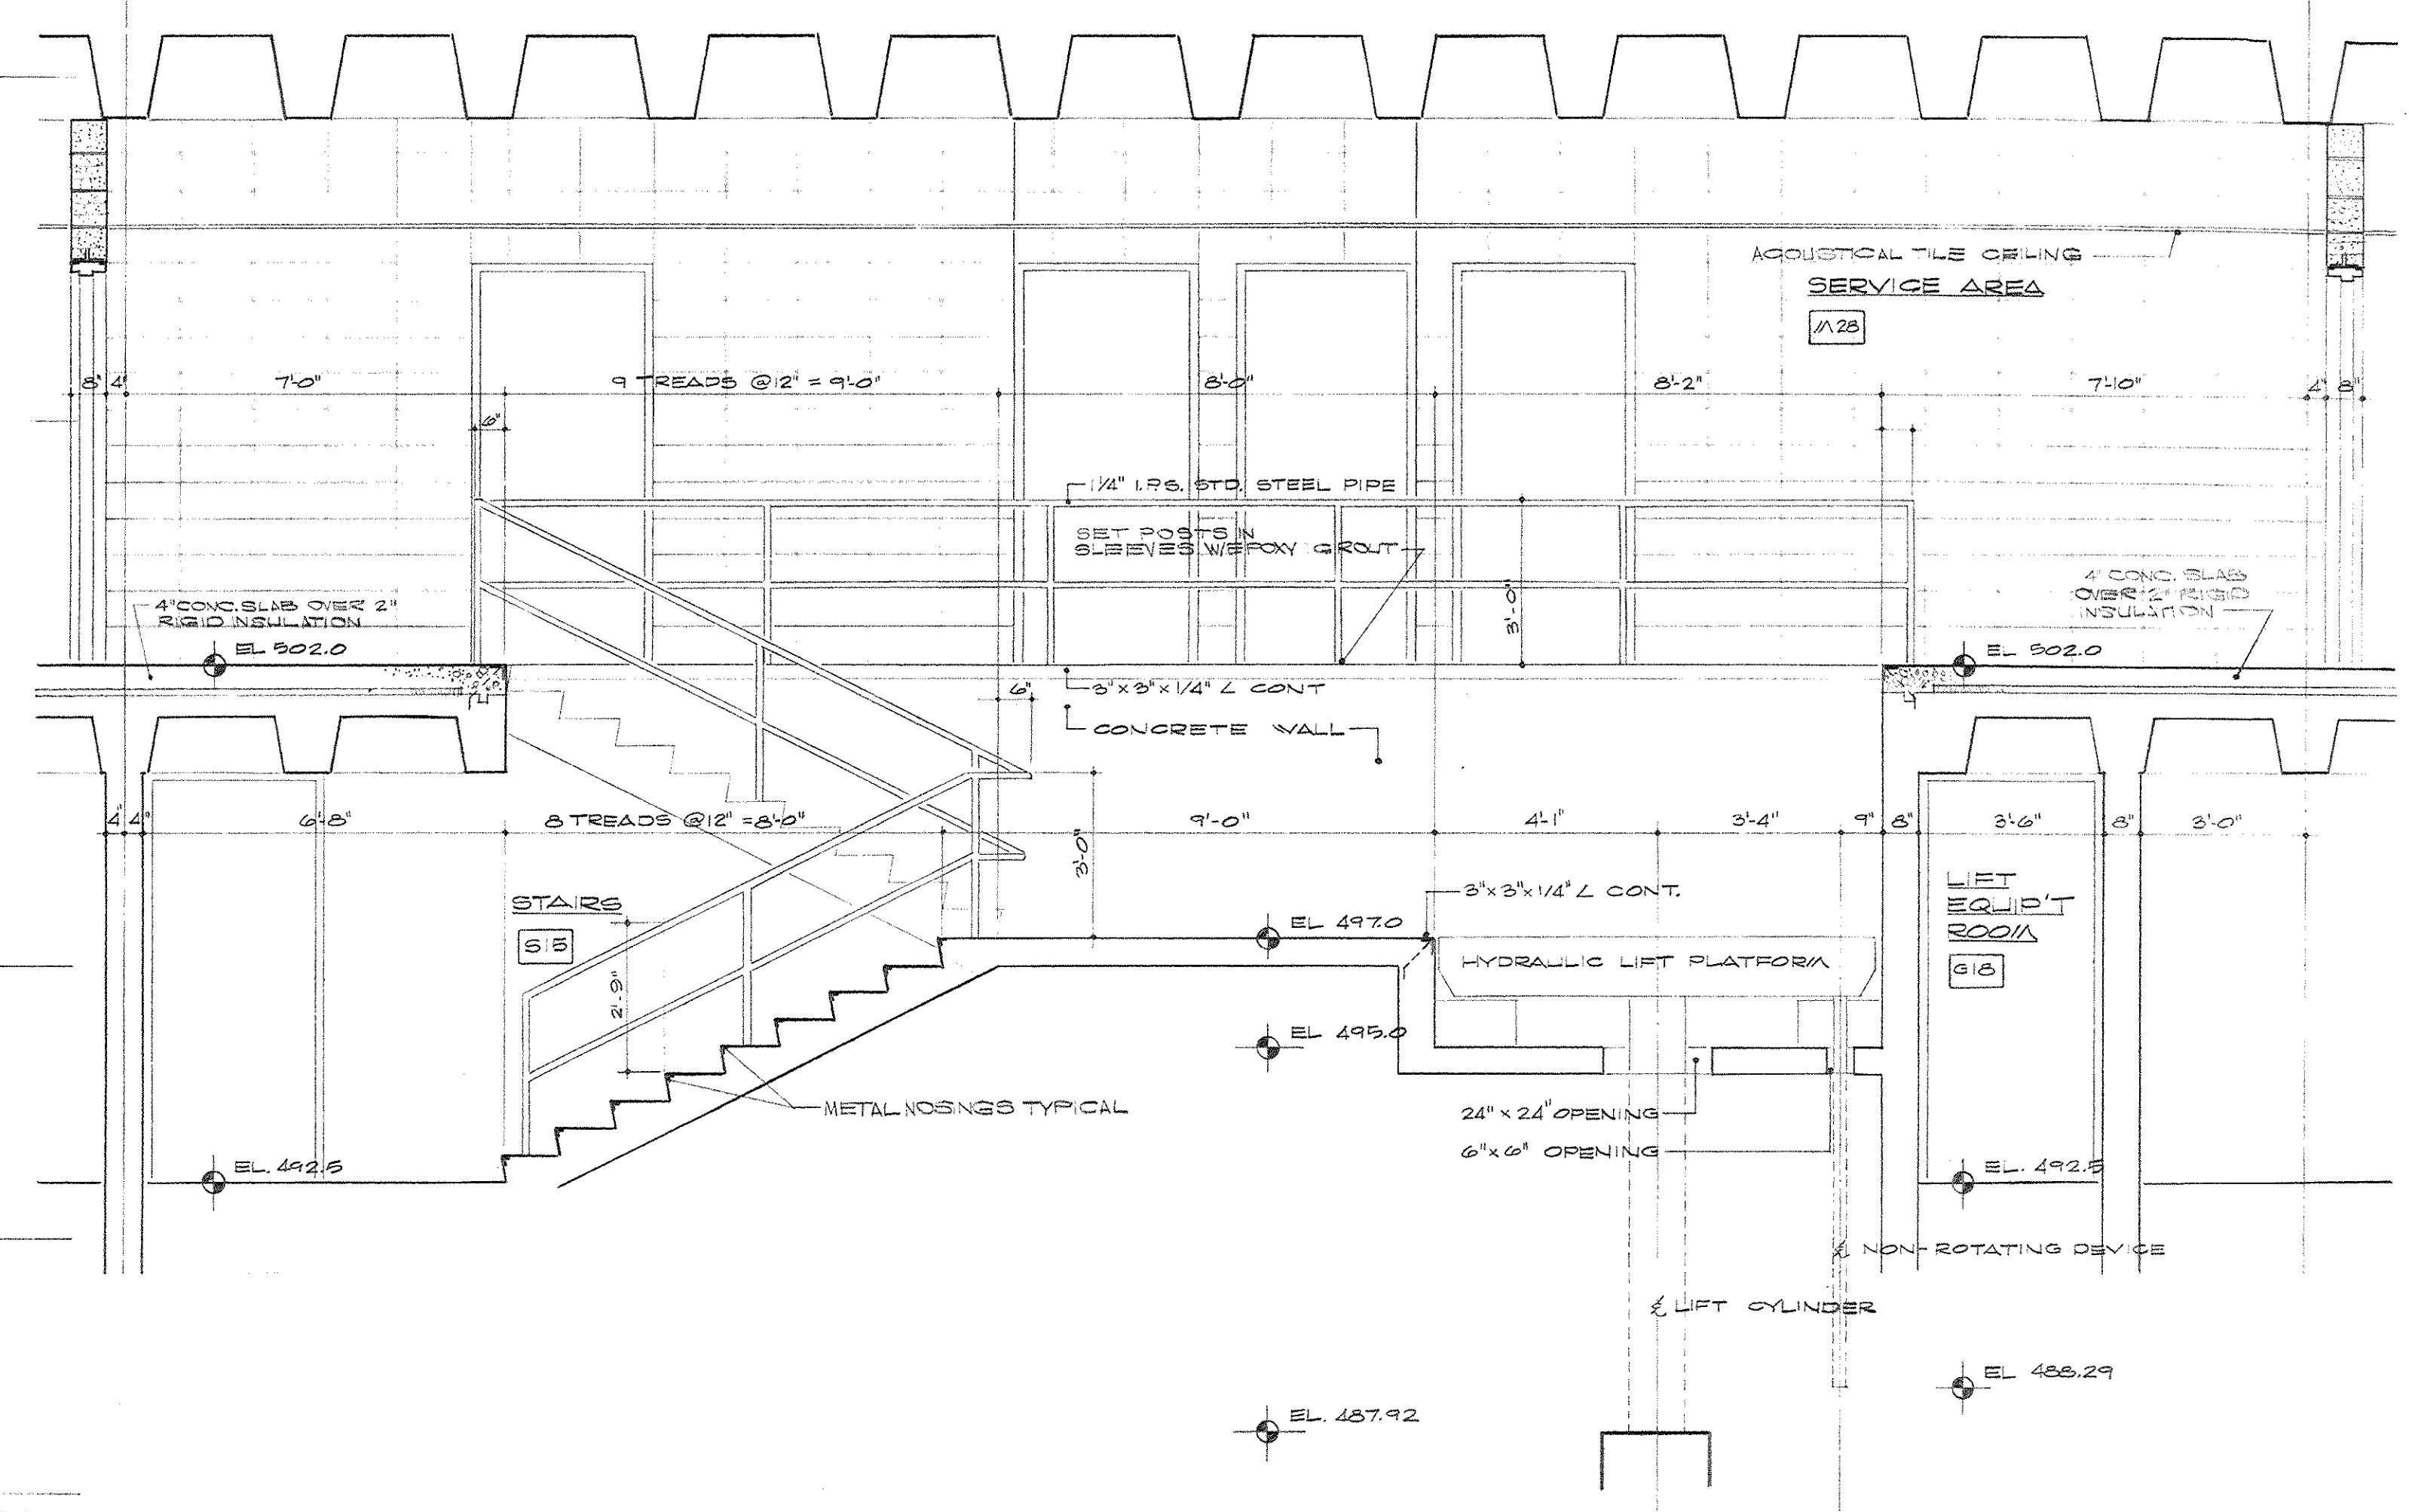


SECTION A SERVICE AREA & STAIRS S-15
SCALE 3/8" = 1'-0"

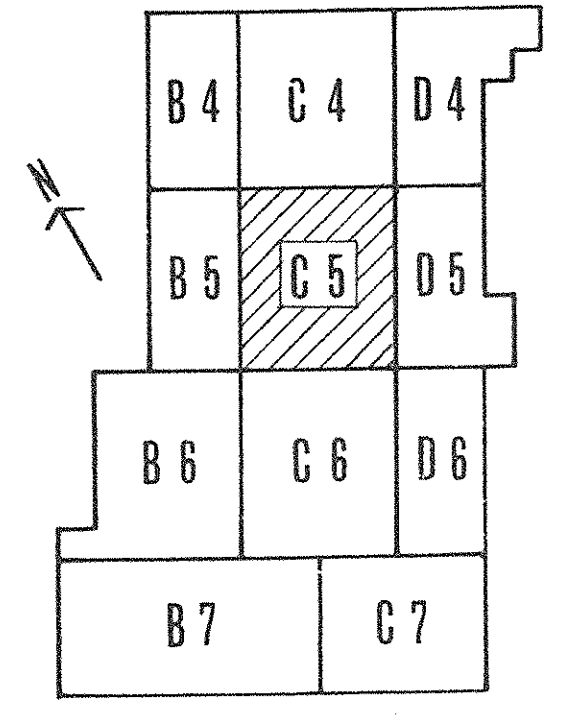


KEY PLAN


AS BUILT REVISIONS 3/24/72

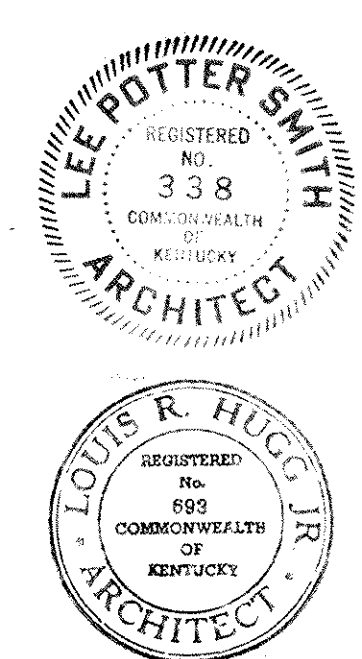

CAPITAL PLAZA DEVELOPMENT PHASE II			
FRANKFORT, KENTUCKY			
DRAWN BY L.W. W.H. J.S.B.	CHECKED BY LKH	DATE 10 OCT 1967	COMM. NO. 50367
SECTOR NO. C 5		ARCHITECTS LEE POTTER SMITH, PRITCHETT, HUGG & CARTER 314 WILKINSON STREET FRANKFORT, KENTUCKY	DRAWING NO. A 9
APPROVED BY OWNER		ENGINEERING COMMONWEALTH OF KENTUCKY DEPARTMENT OF FINANCE - DIVISION OF ENGINEERING FRANKFORT, KENTUCKY	DATE 10-3-67

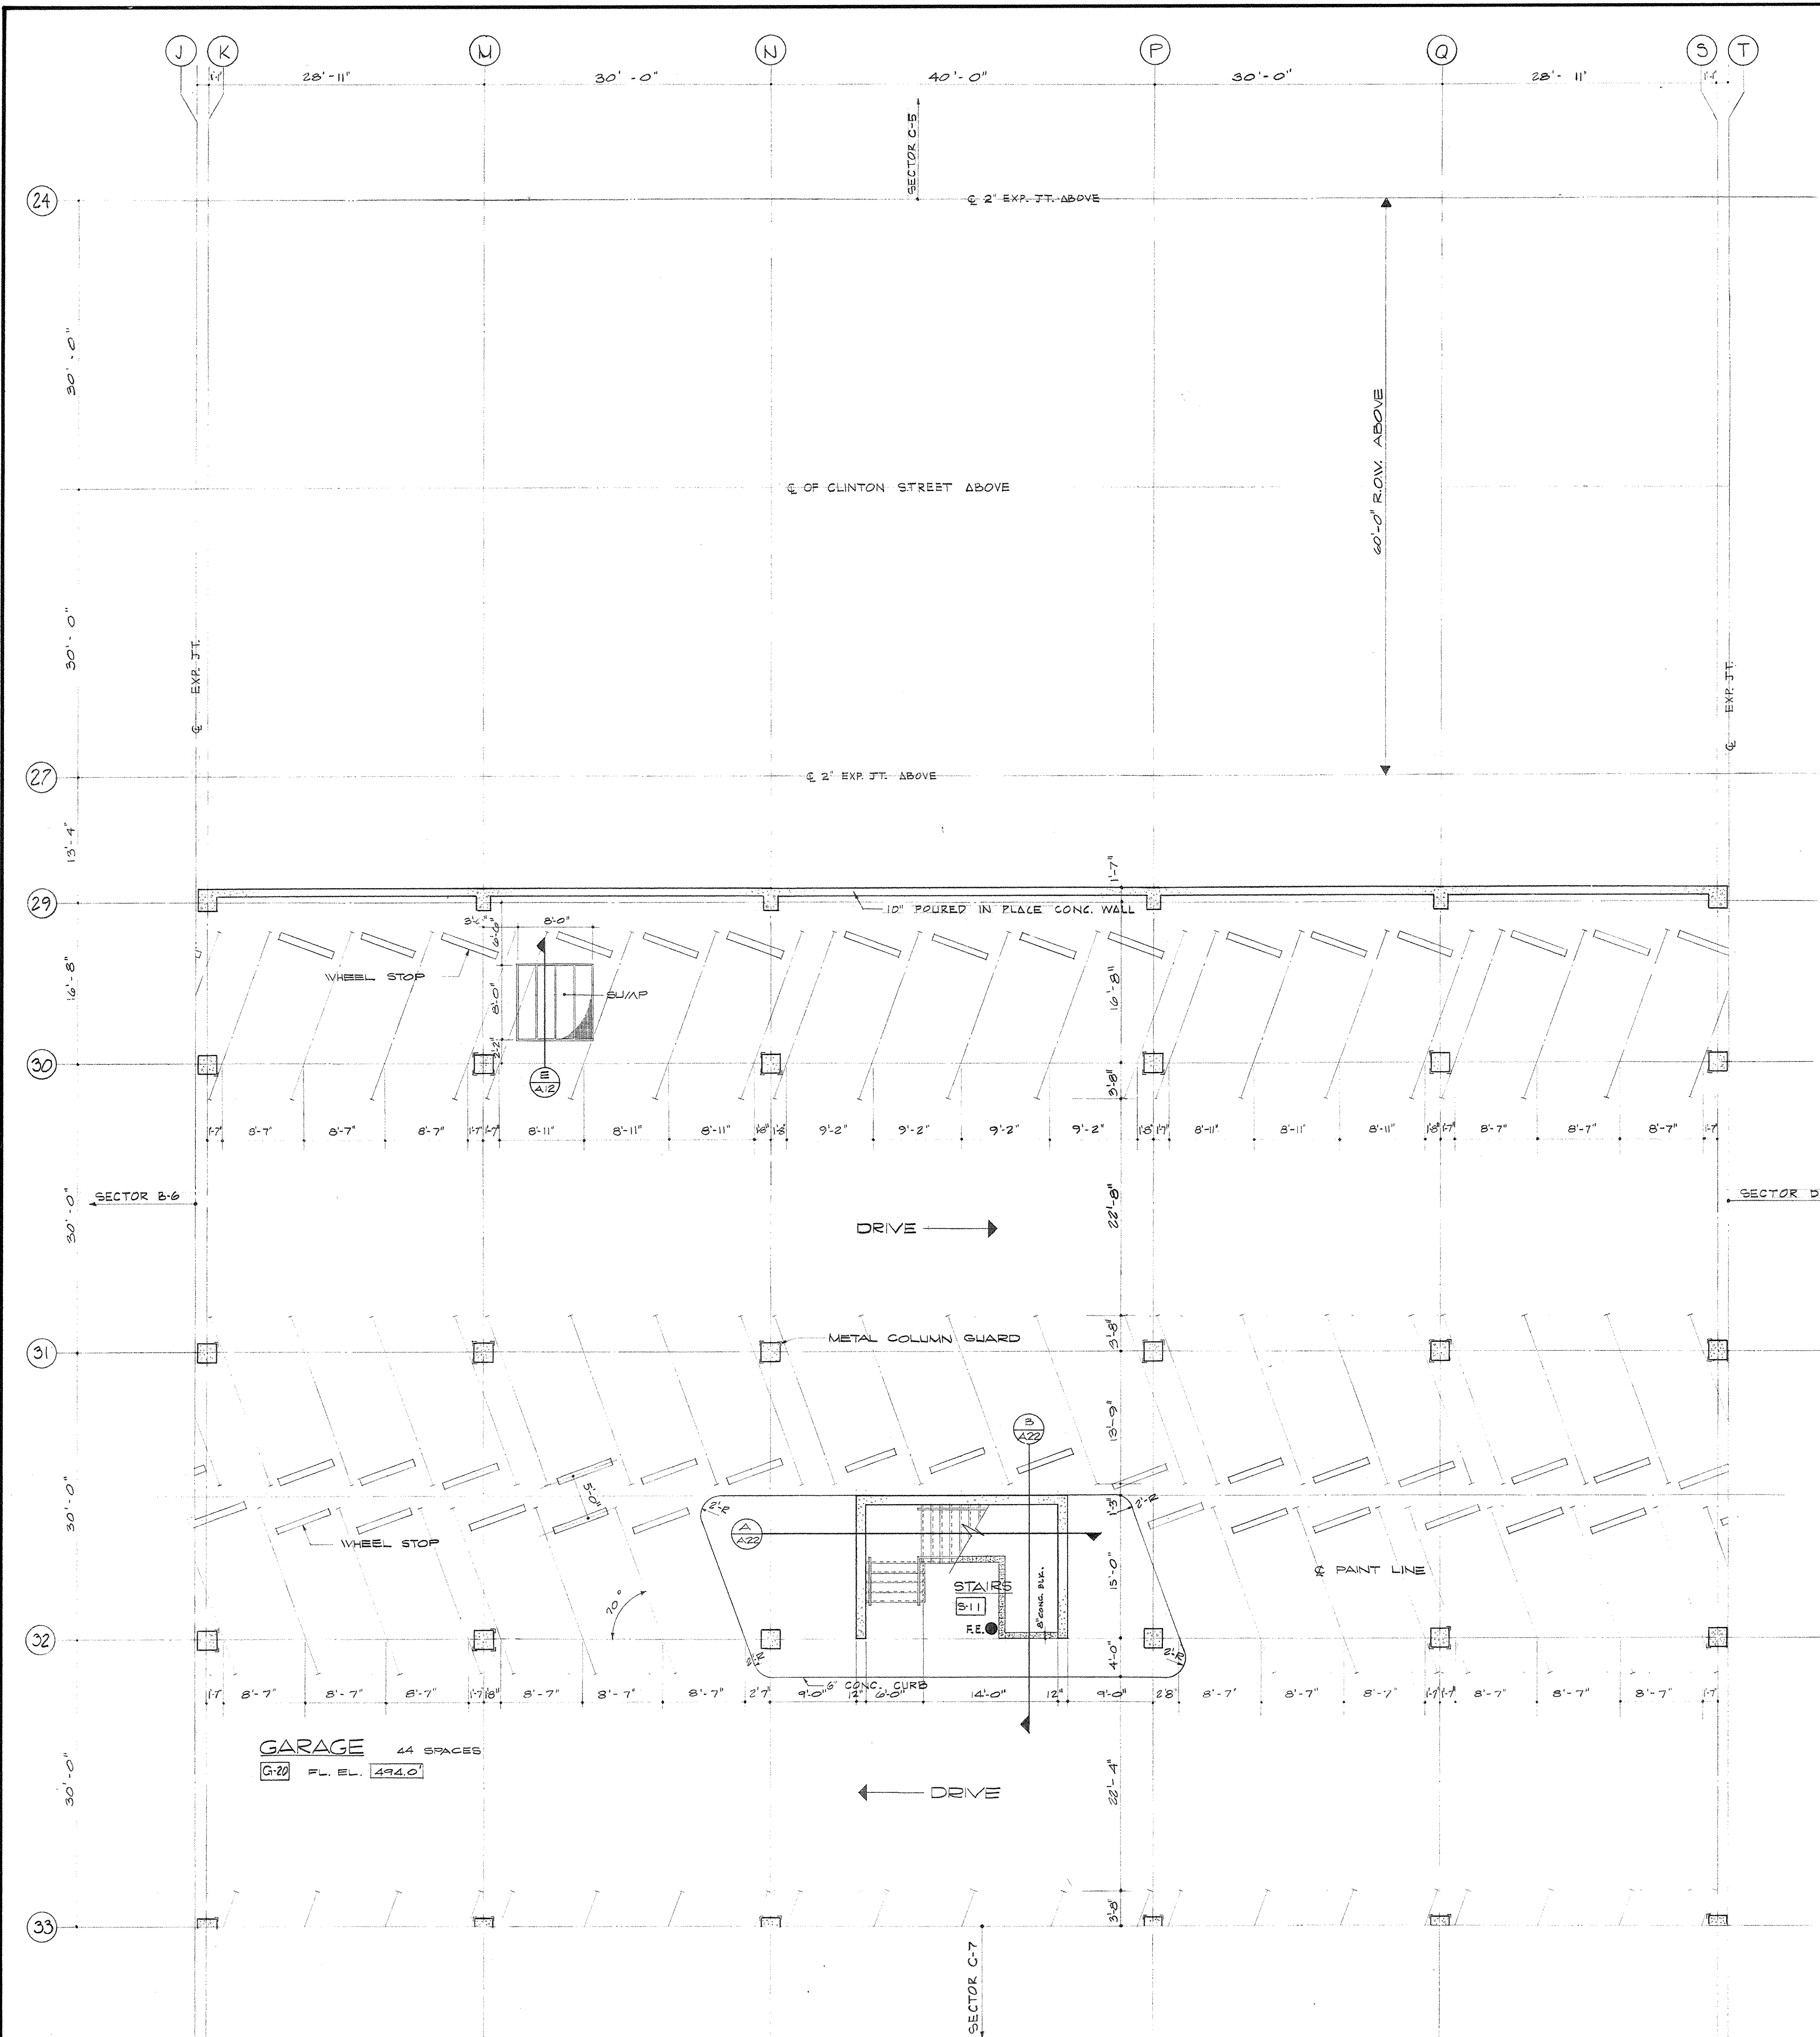


GROUND LEVEL PLAN SECTOR C-6
SCALE 1/8" = 1'-0"

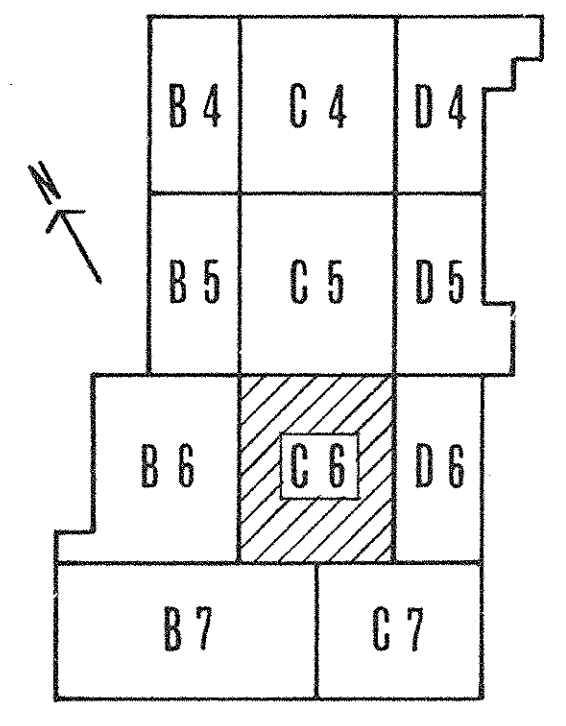


KEY PLAN


AS BUILT REVISIONS - 6-24-72

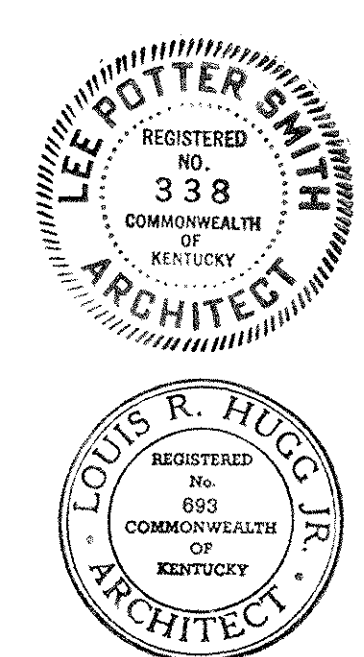


CAPITAL PLAZA DEVELOPMENT PHASE II FRANKFORT, KENTUCKY		
DRAWN BY J.B.	GROUND LEVEL PLAN	DATE OCT 1967
CHECKED BY L.R.H.		COMM. NO. 50367
SECTOR NO. C 6	LEE POTTER SMITH, PRITCHETT, HUGG & CARTER ARCHITECTS 314 WILKINSON STREET FRANKFORT, KENTUCKY	DRAWING NO. A 10
CFH-4	COMMONWEALTH OF KENTUCKY DEPARTMENT OF FINANCE - DIVISION OF ENGINEERING FRANKFORT	OF 42
APPROVED BY	AGENCY HEAD	DATE
APPROVED BY	OWNER	DATE 10-2-67

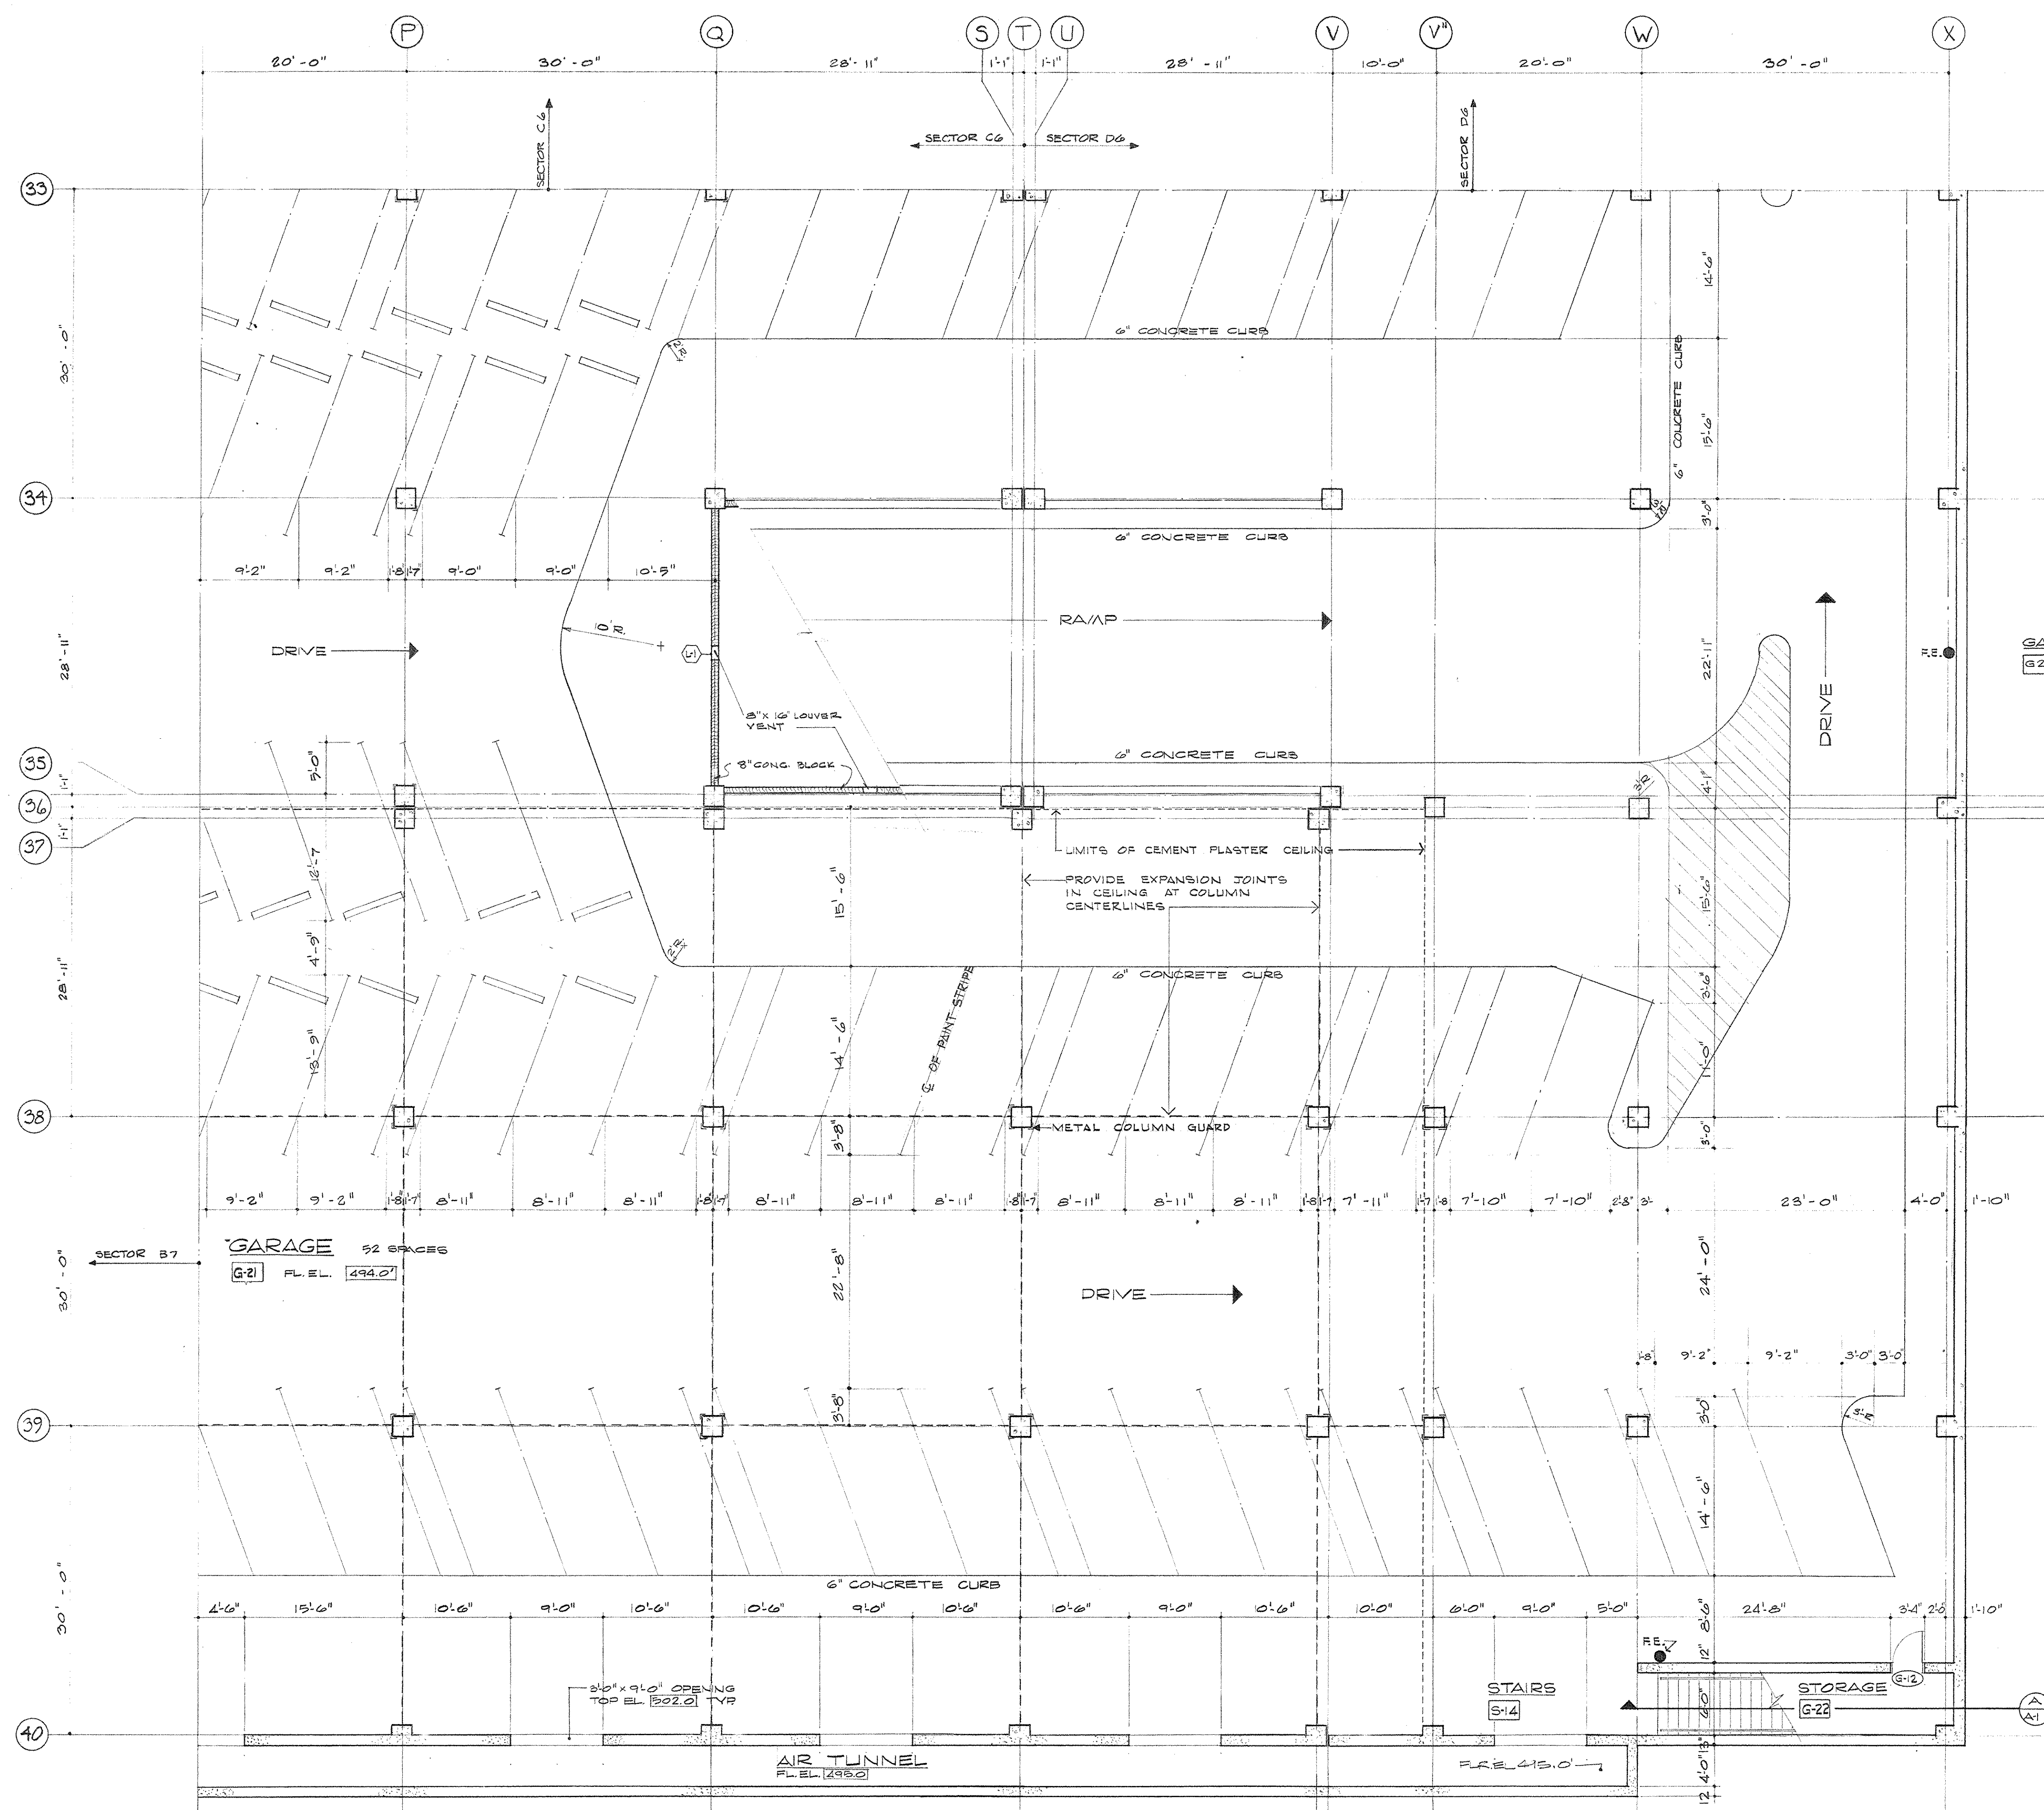


GROUND LEVEL PLAN SECTOR C-7
SCALE 1/8"=1'-0"

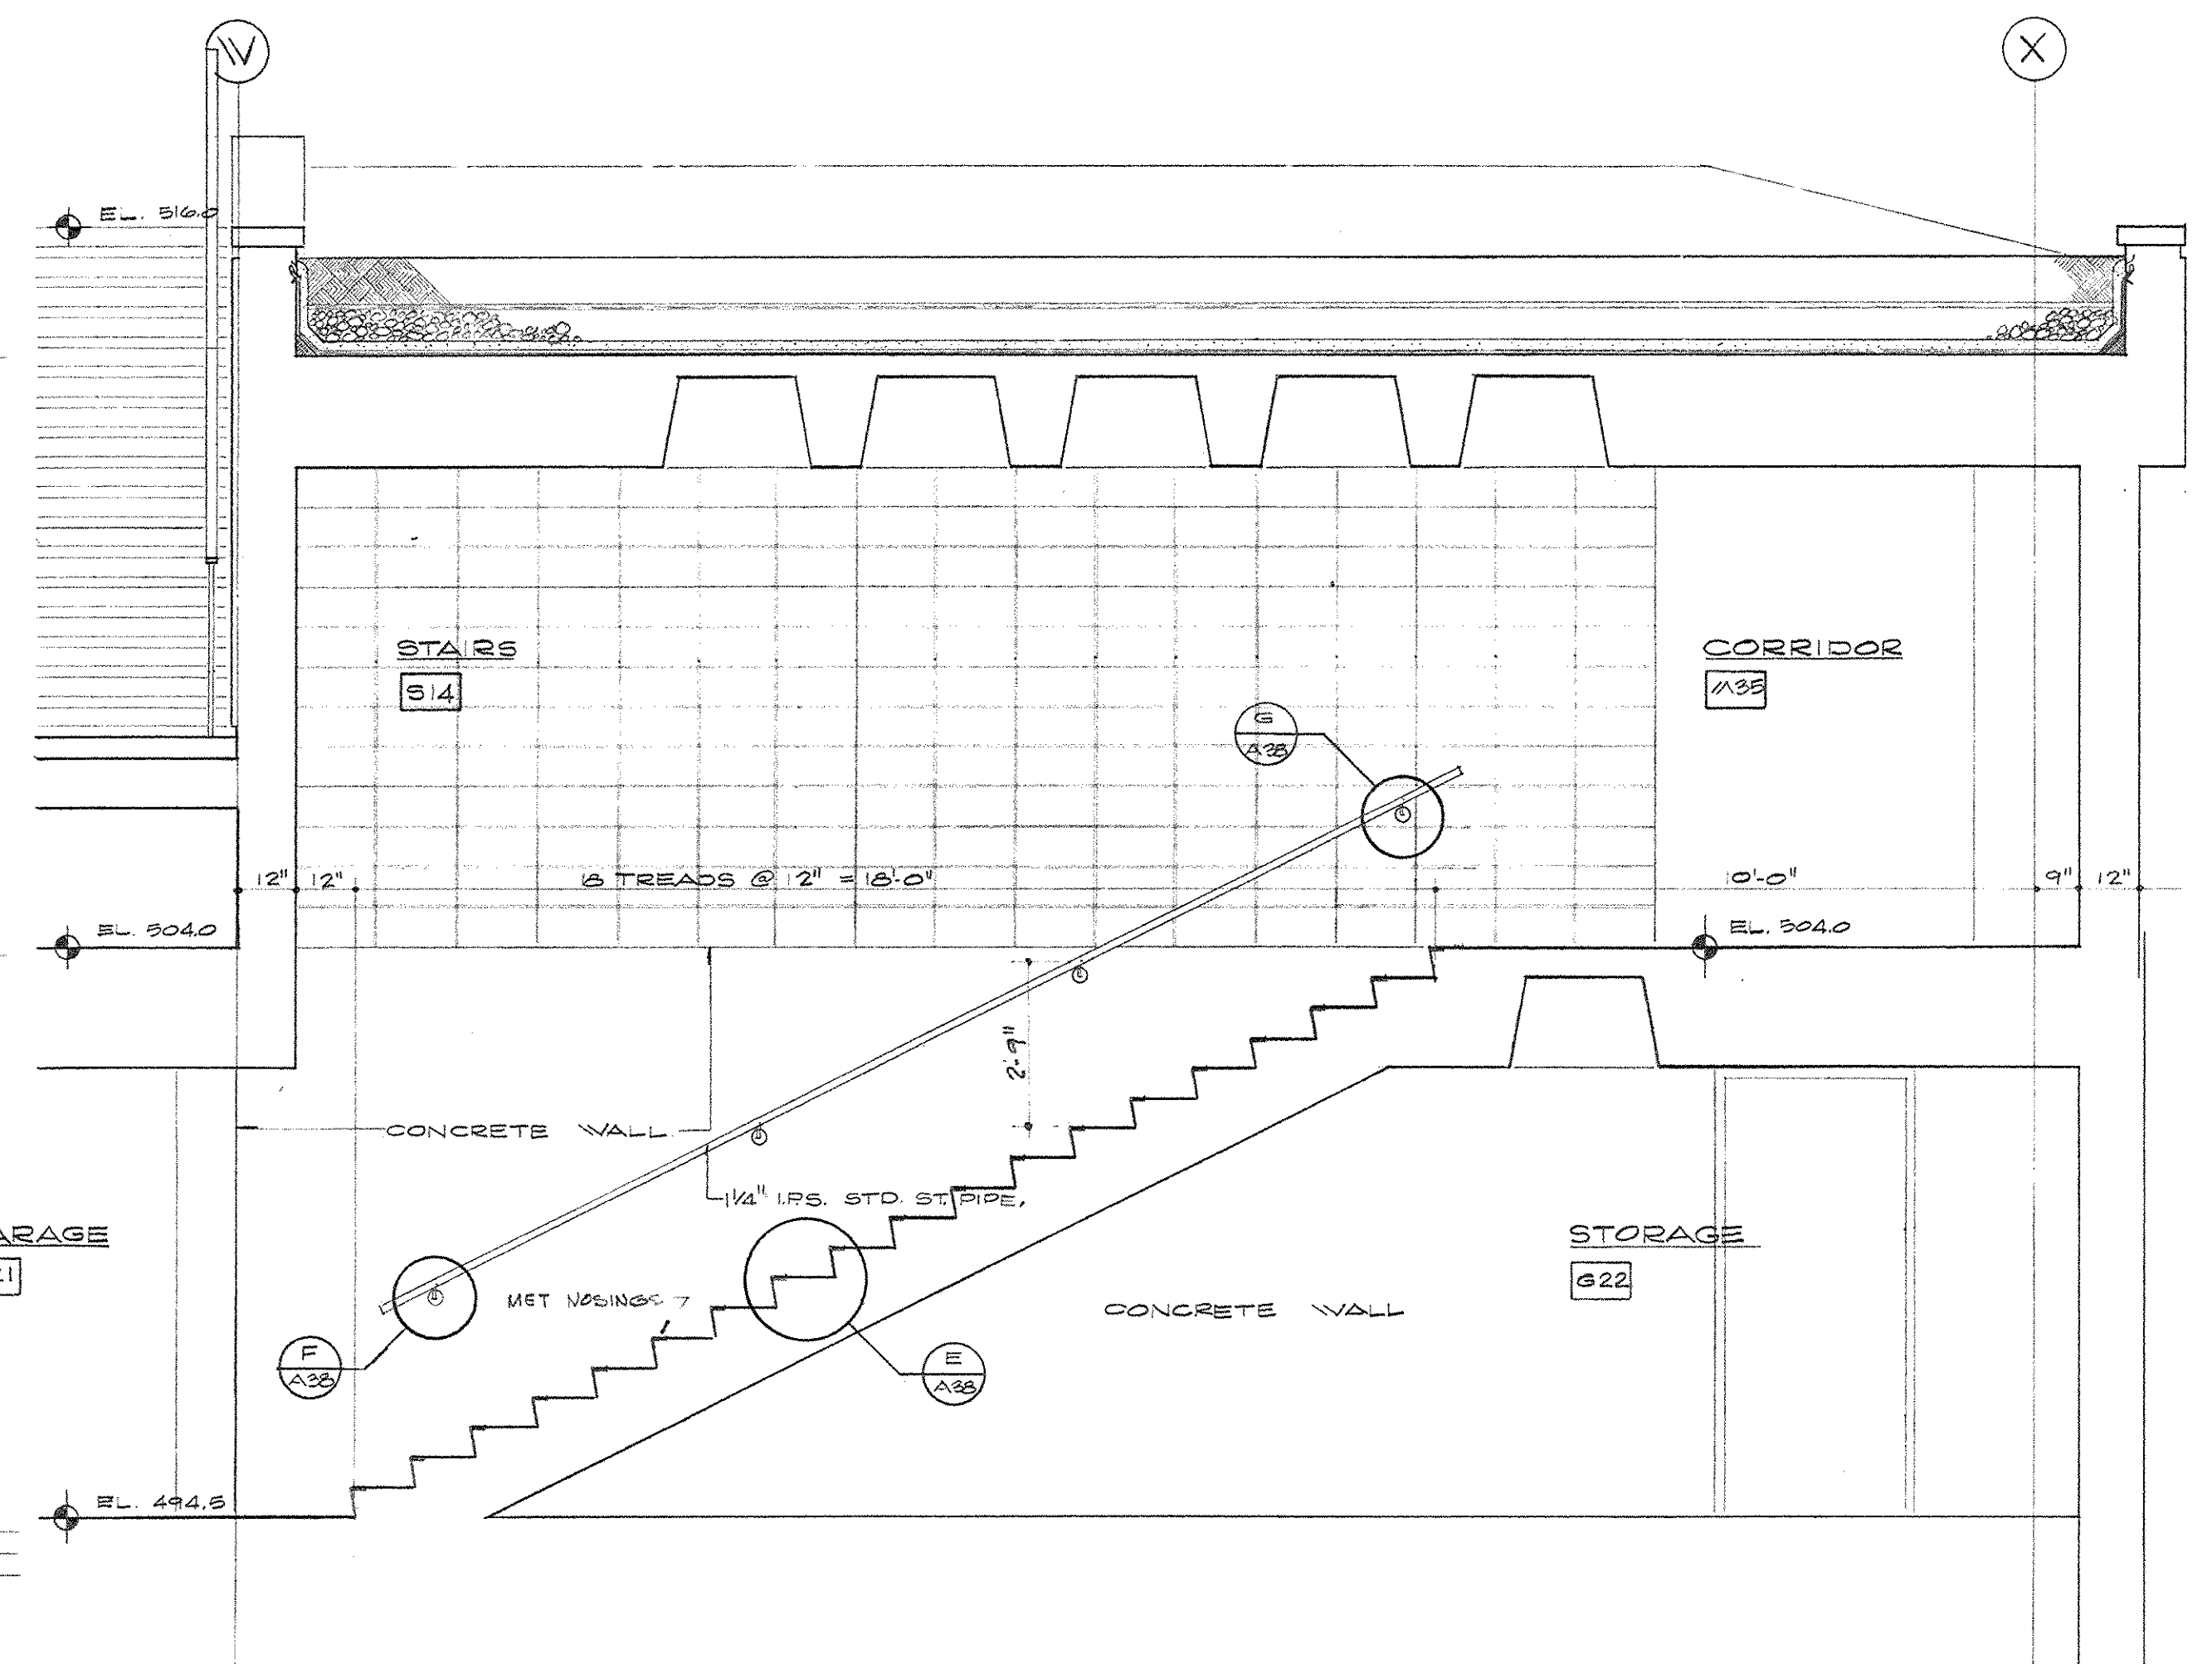

SECTION A-A11 STAIRS S14
SCALE 3/8"=1'-0"

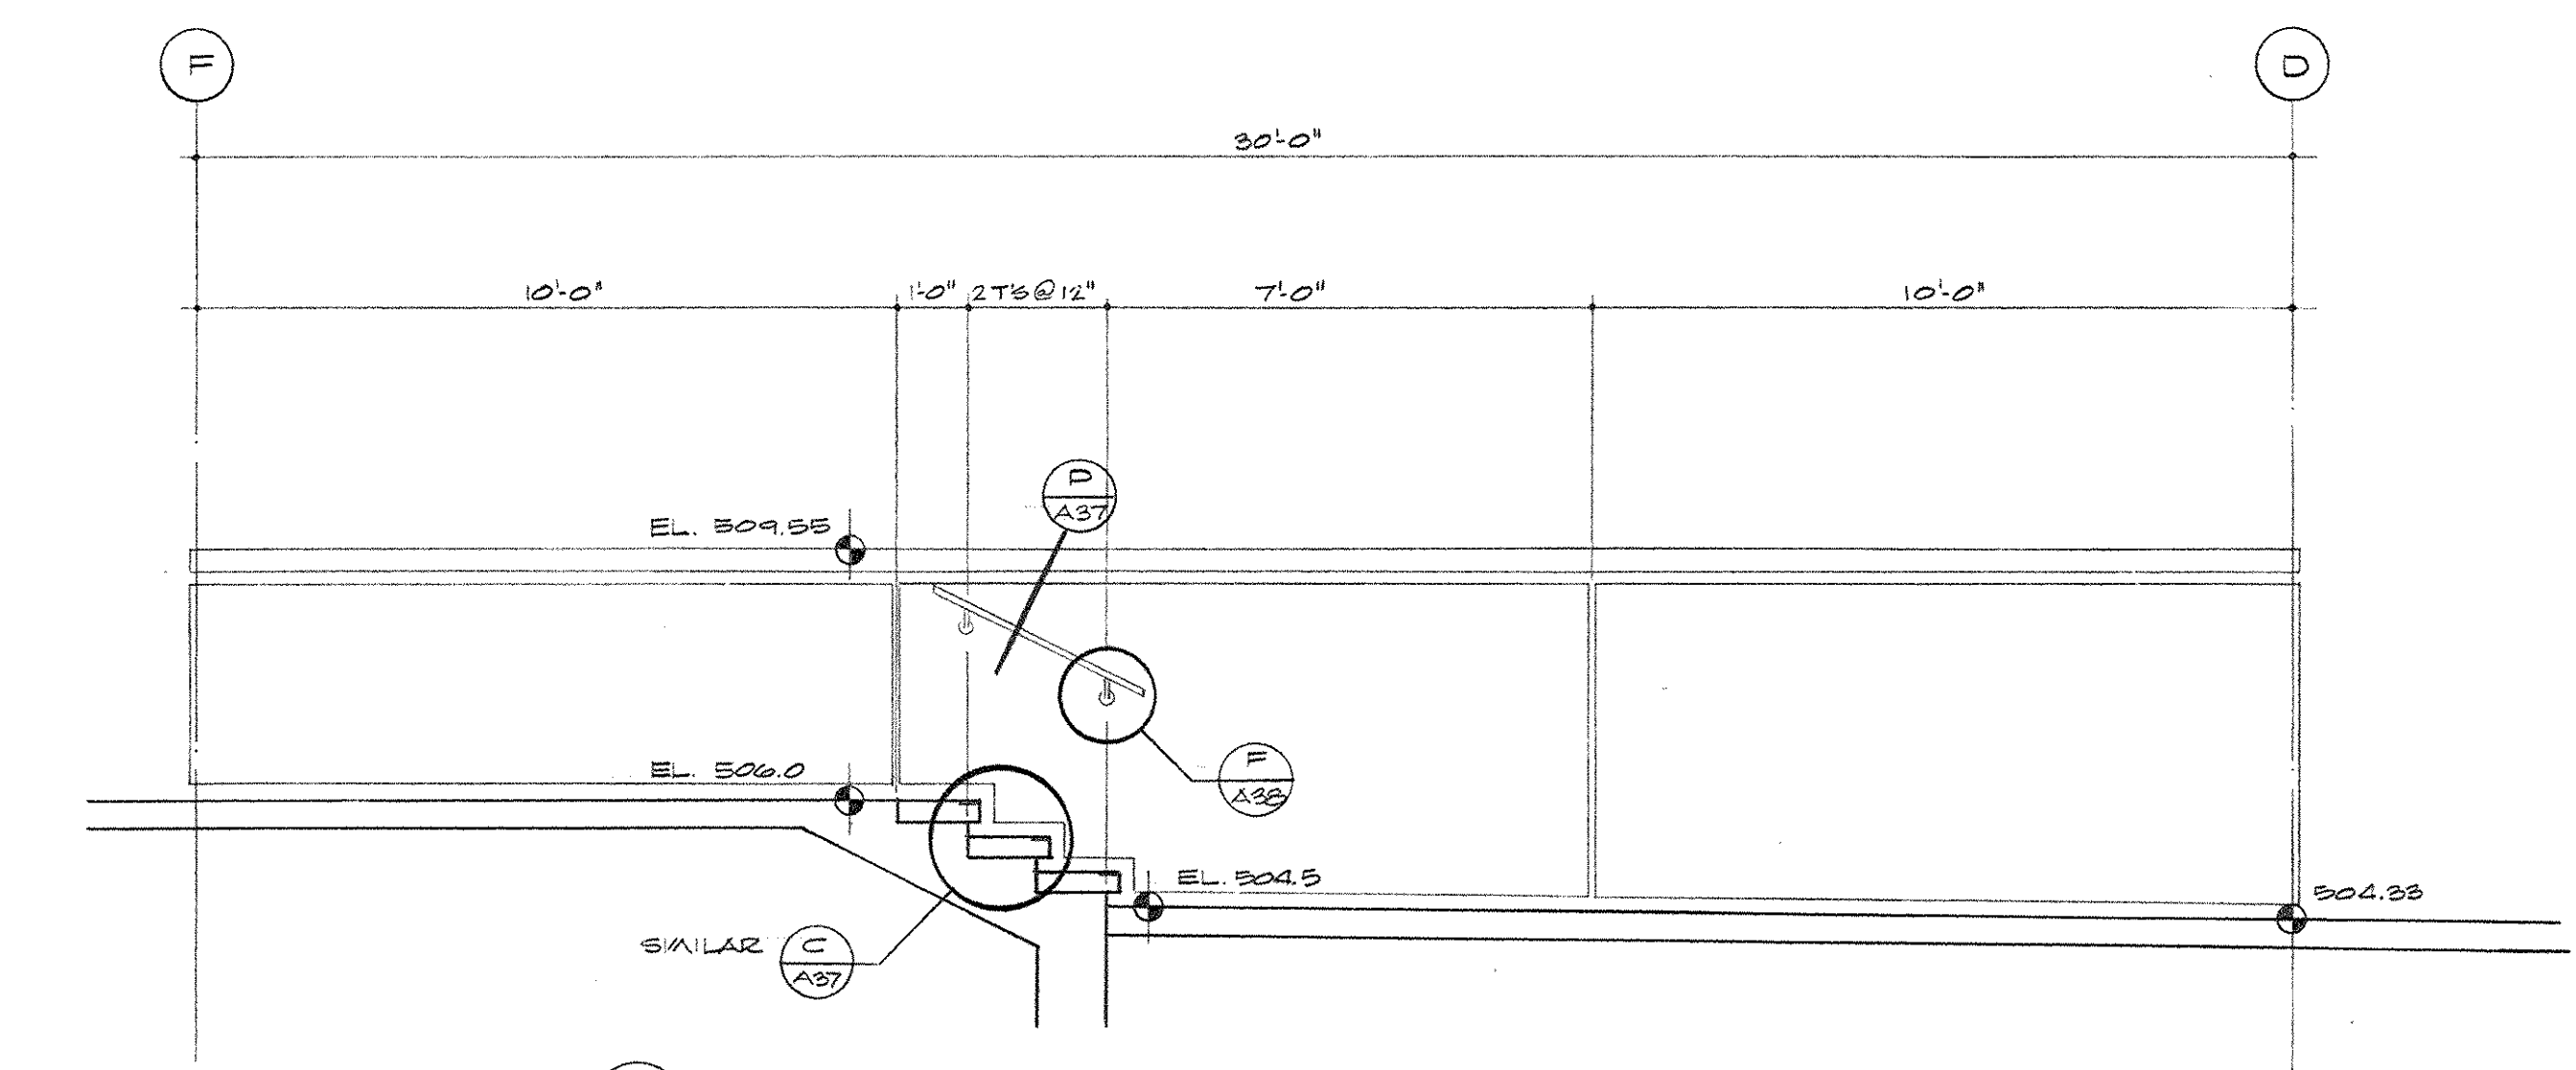


SECTION B-B11
SCALE 3/8"=1'-0"

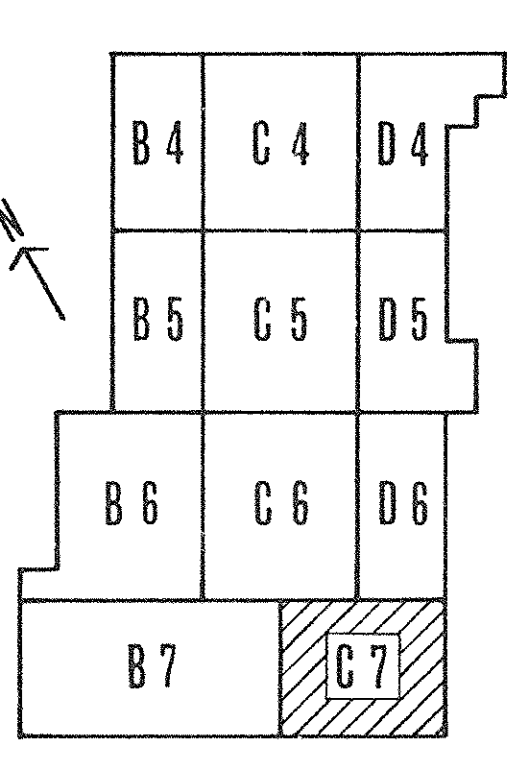


KEY PLAN

AS BUILT REVISIONS - 8-23-72

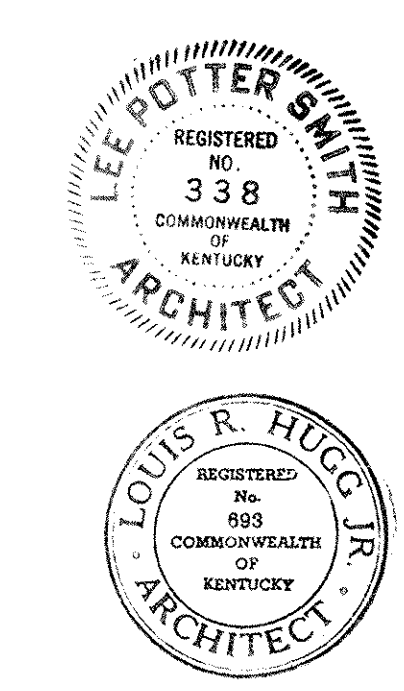


CAPITAL PLAZA DEVELOPMENT PHASE II FRANKFORT, KENTUCKY		
DRAWN BY J.B.	GROUND LEVEL PLAN	DATE 16 OCT 1967
CHECKED BY L.P.S.		CONTR. NO. 50387
SECTOR NO. G 7	LEE POTTER SMITH, PRITCHETT, HUGG & CARTER ARCHITECTS ENGINEERS 314 WILKINSON STREET FRANKFORT, KENTUCKY	DRAWING NO. A 11
COMMONWEALTH OF KENTUCKY DEPARTMENT OF FINANCE - DIVISION OF ENGINEERING FRANKFORT, KENTUCKY		
APPROVED BY AGENCY HEAD <i>W.J. Mc Connell</i>	DATE 10-26-67	DATE 10-26-67
APPROVED BY OWNER		

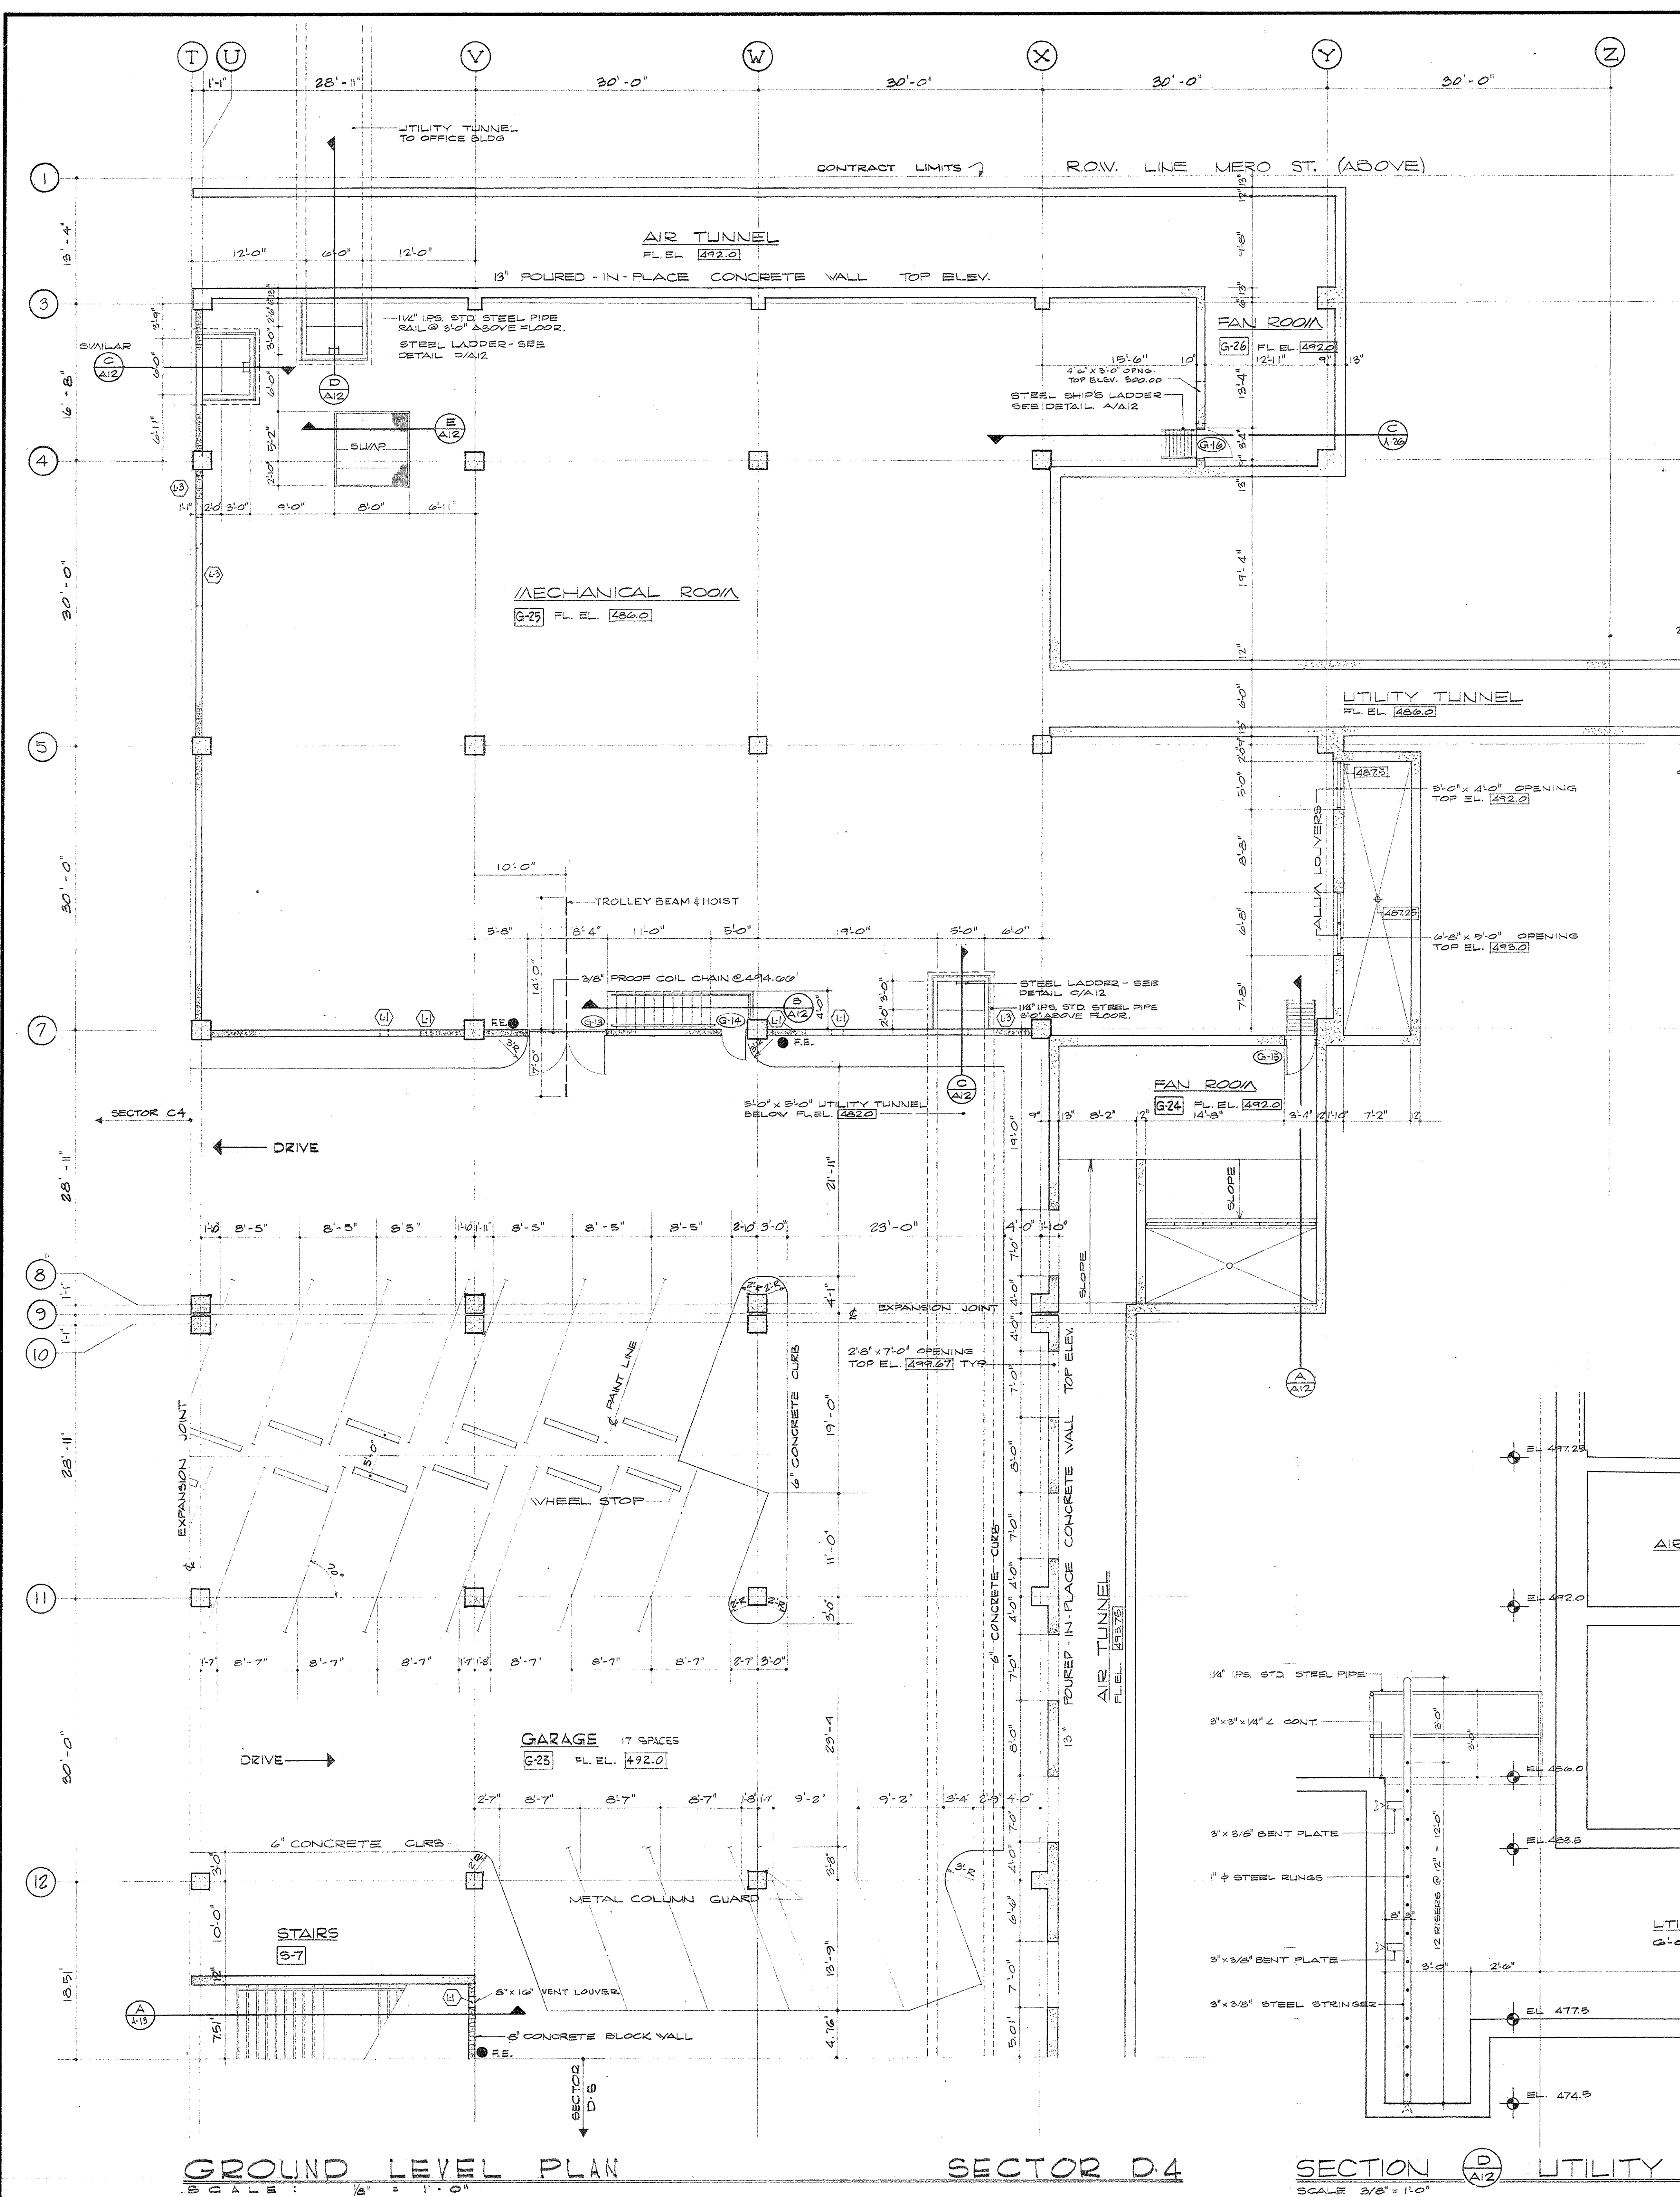


GROUND LEVEL PLAN
SCALE: 1/8" = 1'-0"


SECTOR D4

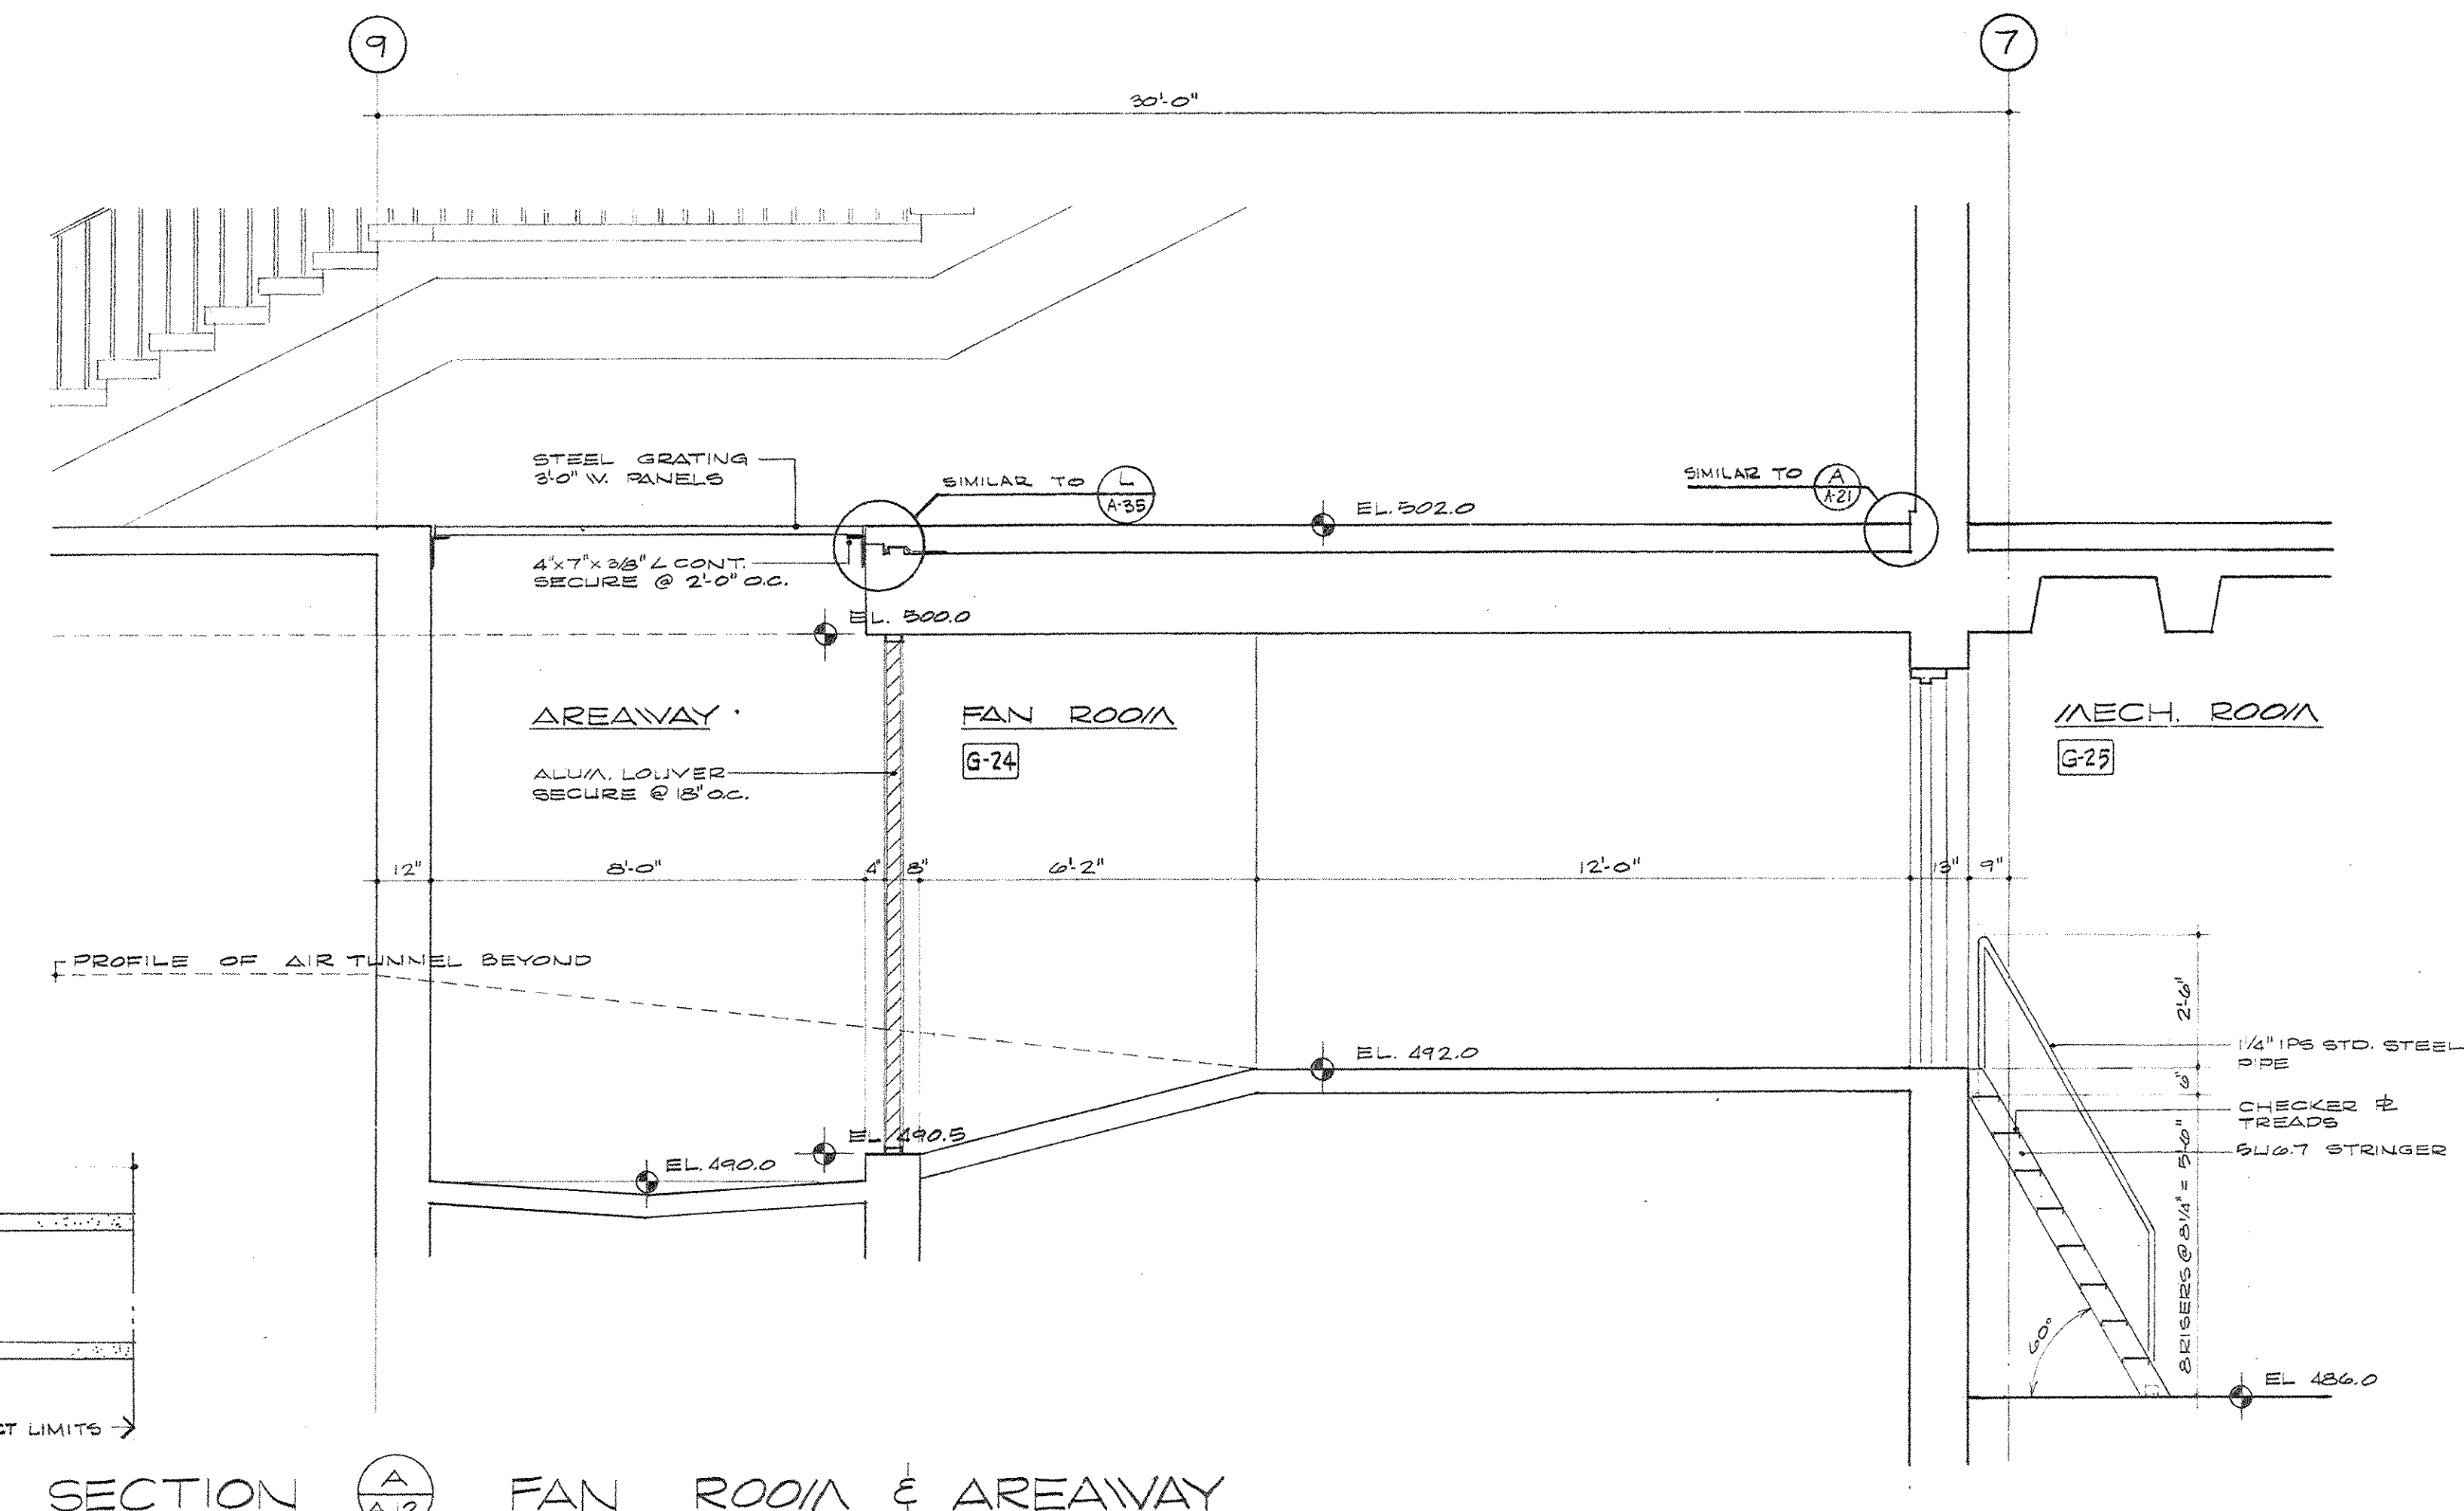


SECTION A-A FAN ROOM & AREAWAY

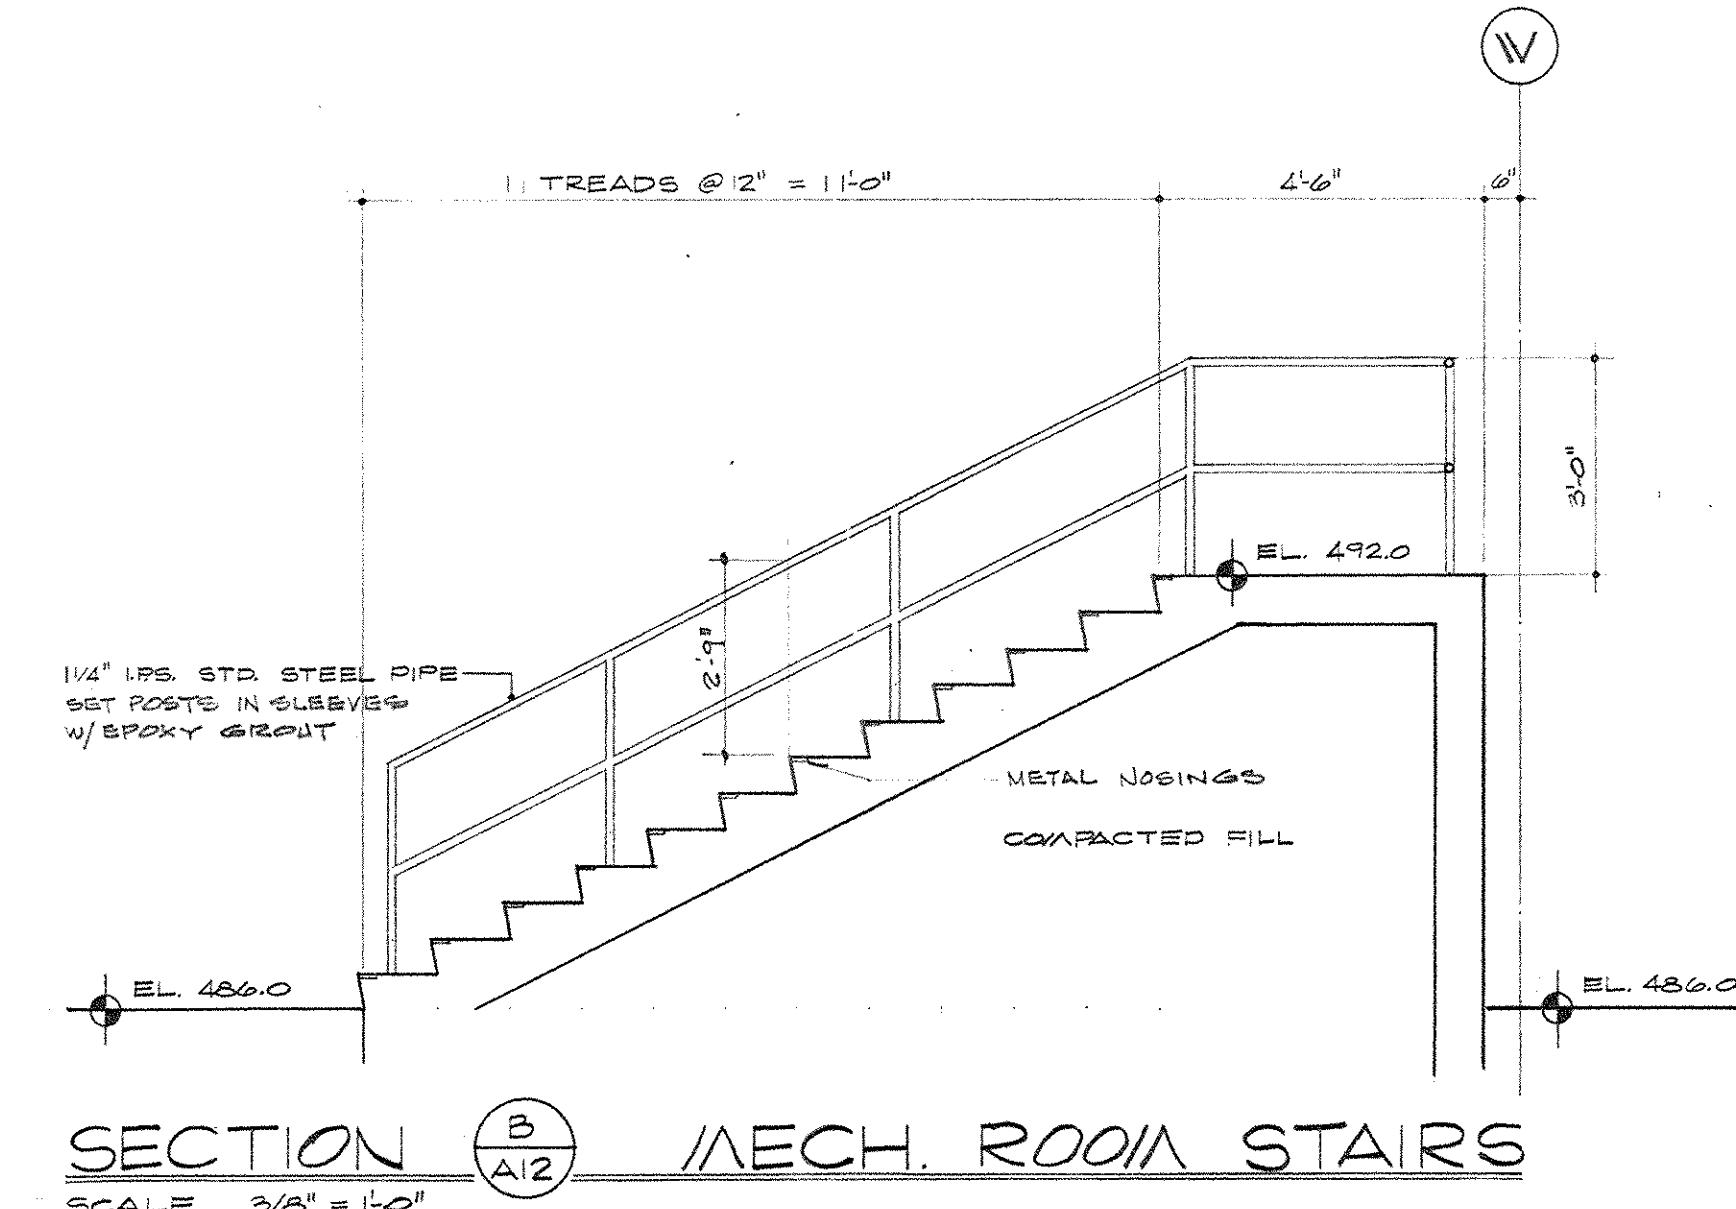


SECTION B-B MECH. ROOM STAIRS
SCALE: 3/8" = 1'-0"

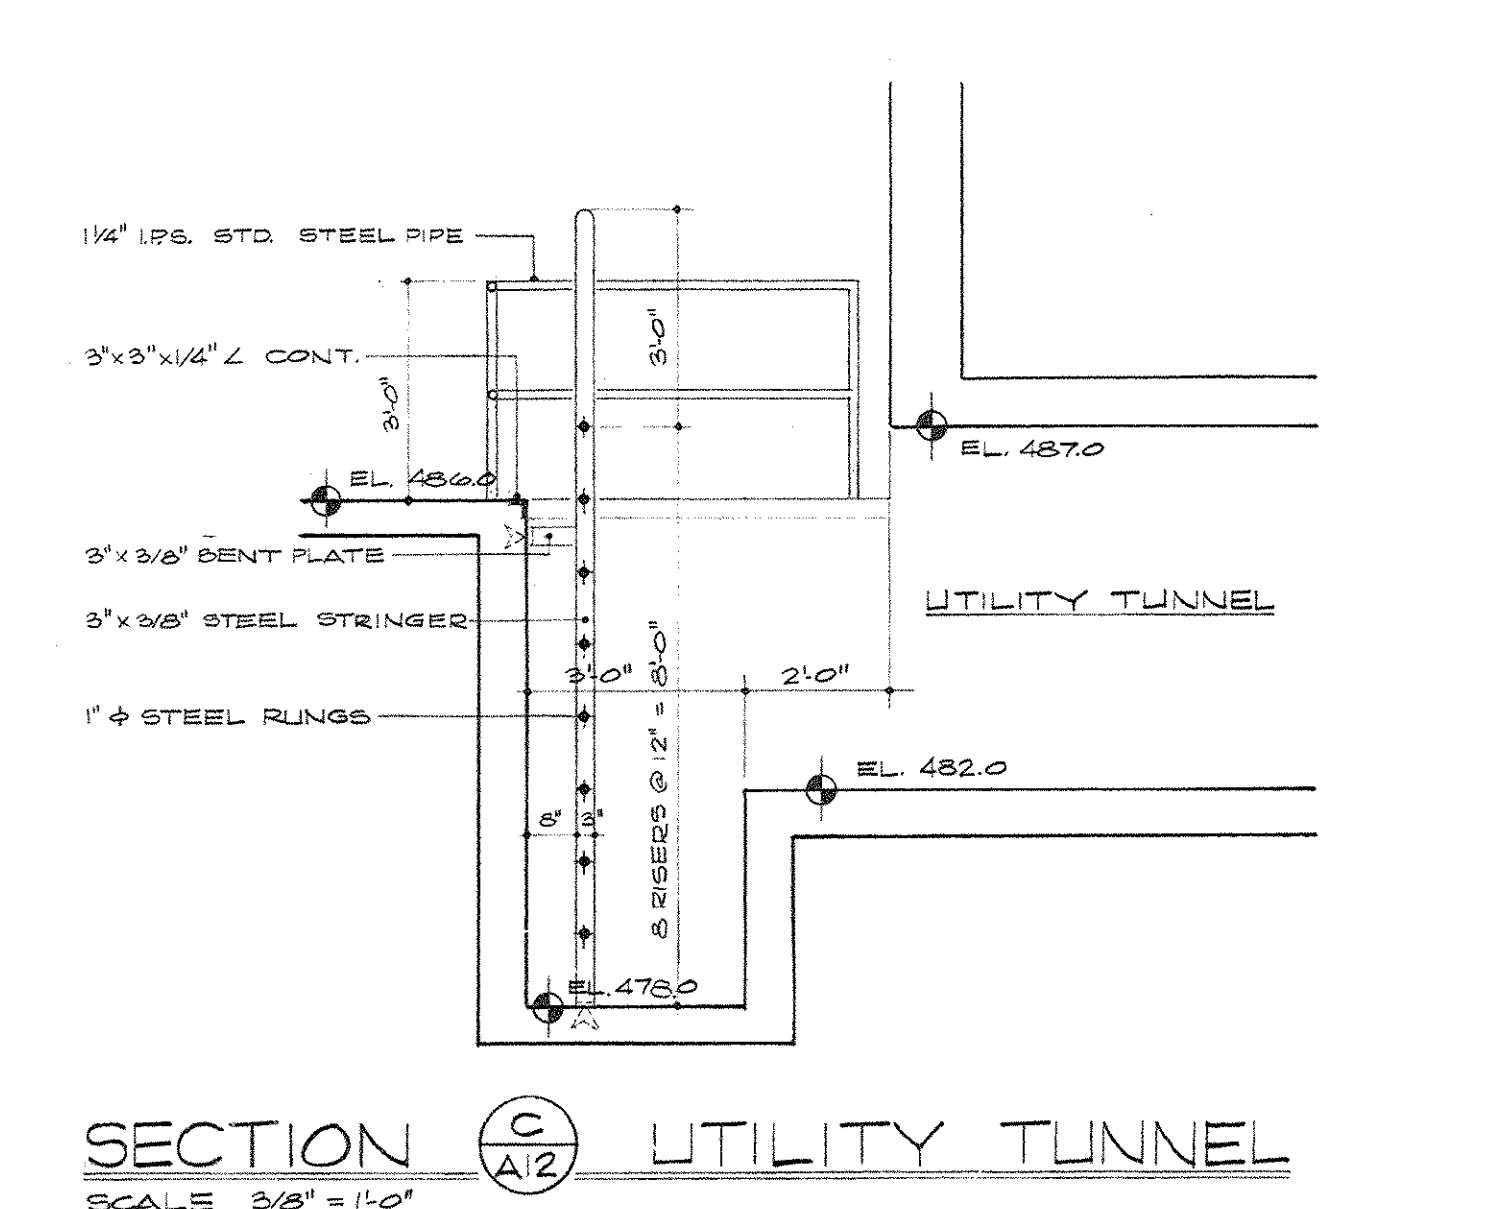


SECTION C-C UTILITY TUNNEL
SCALE: 3/8" = 1'-0"

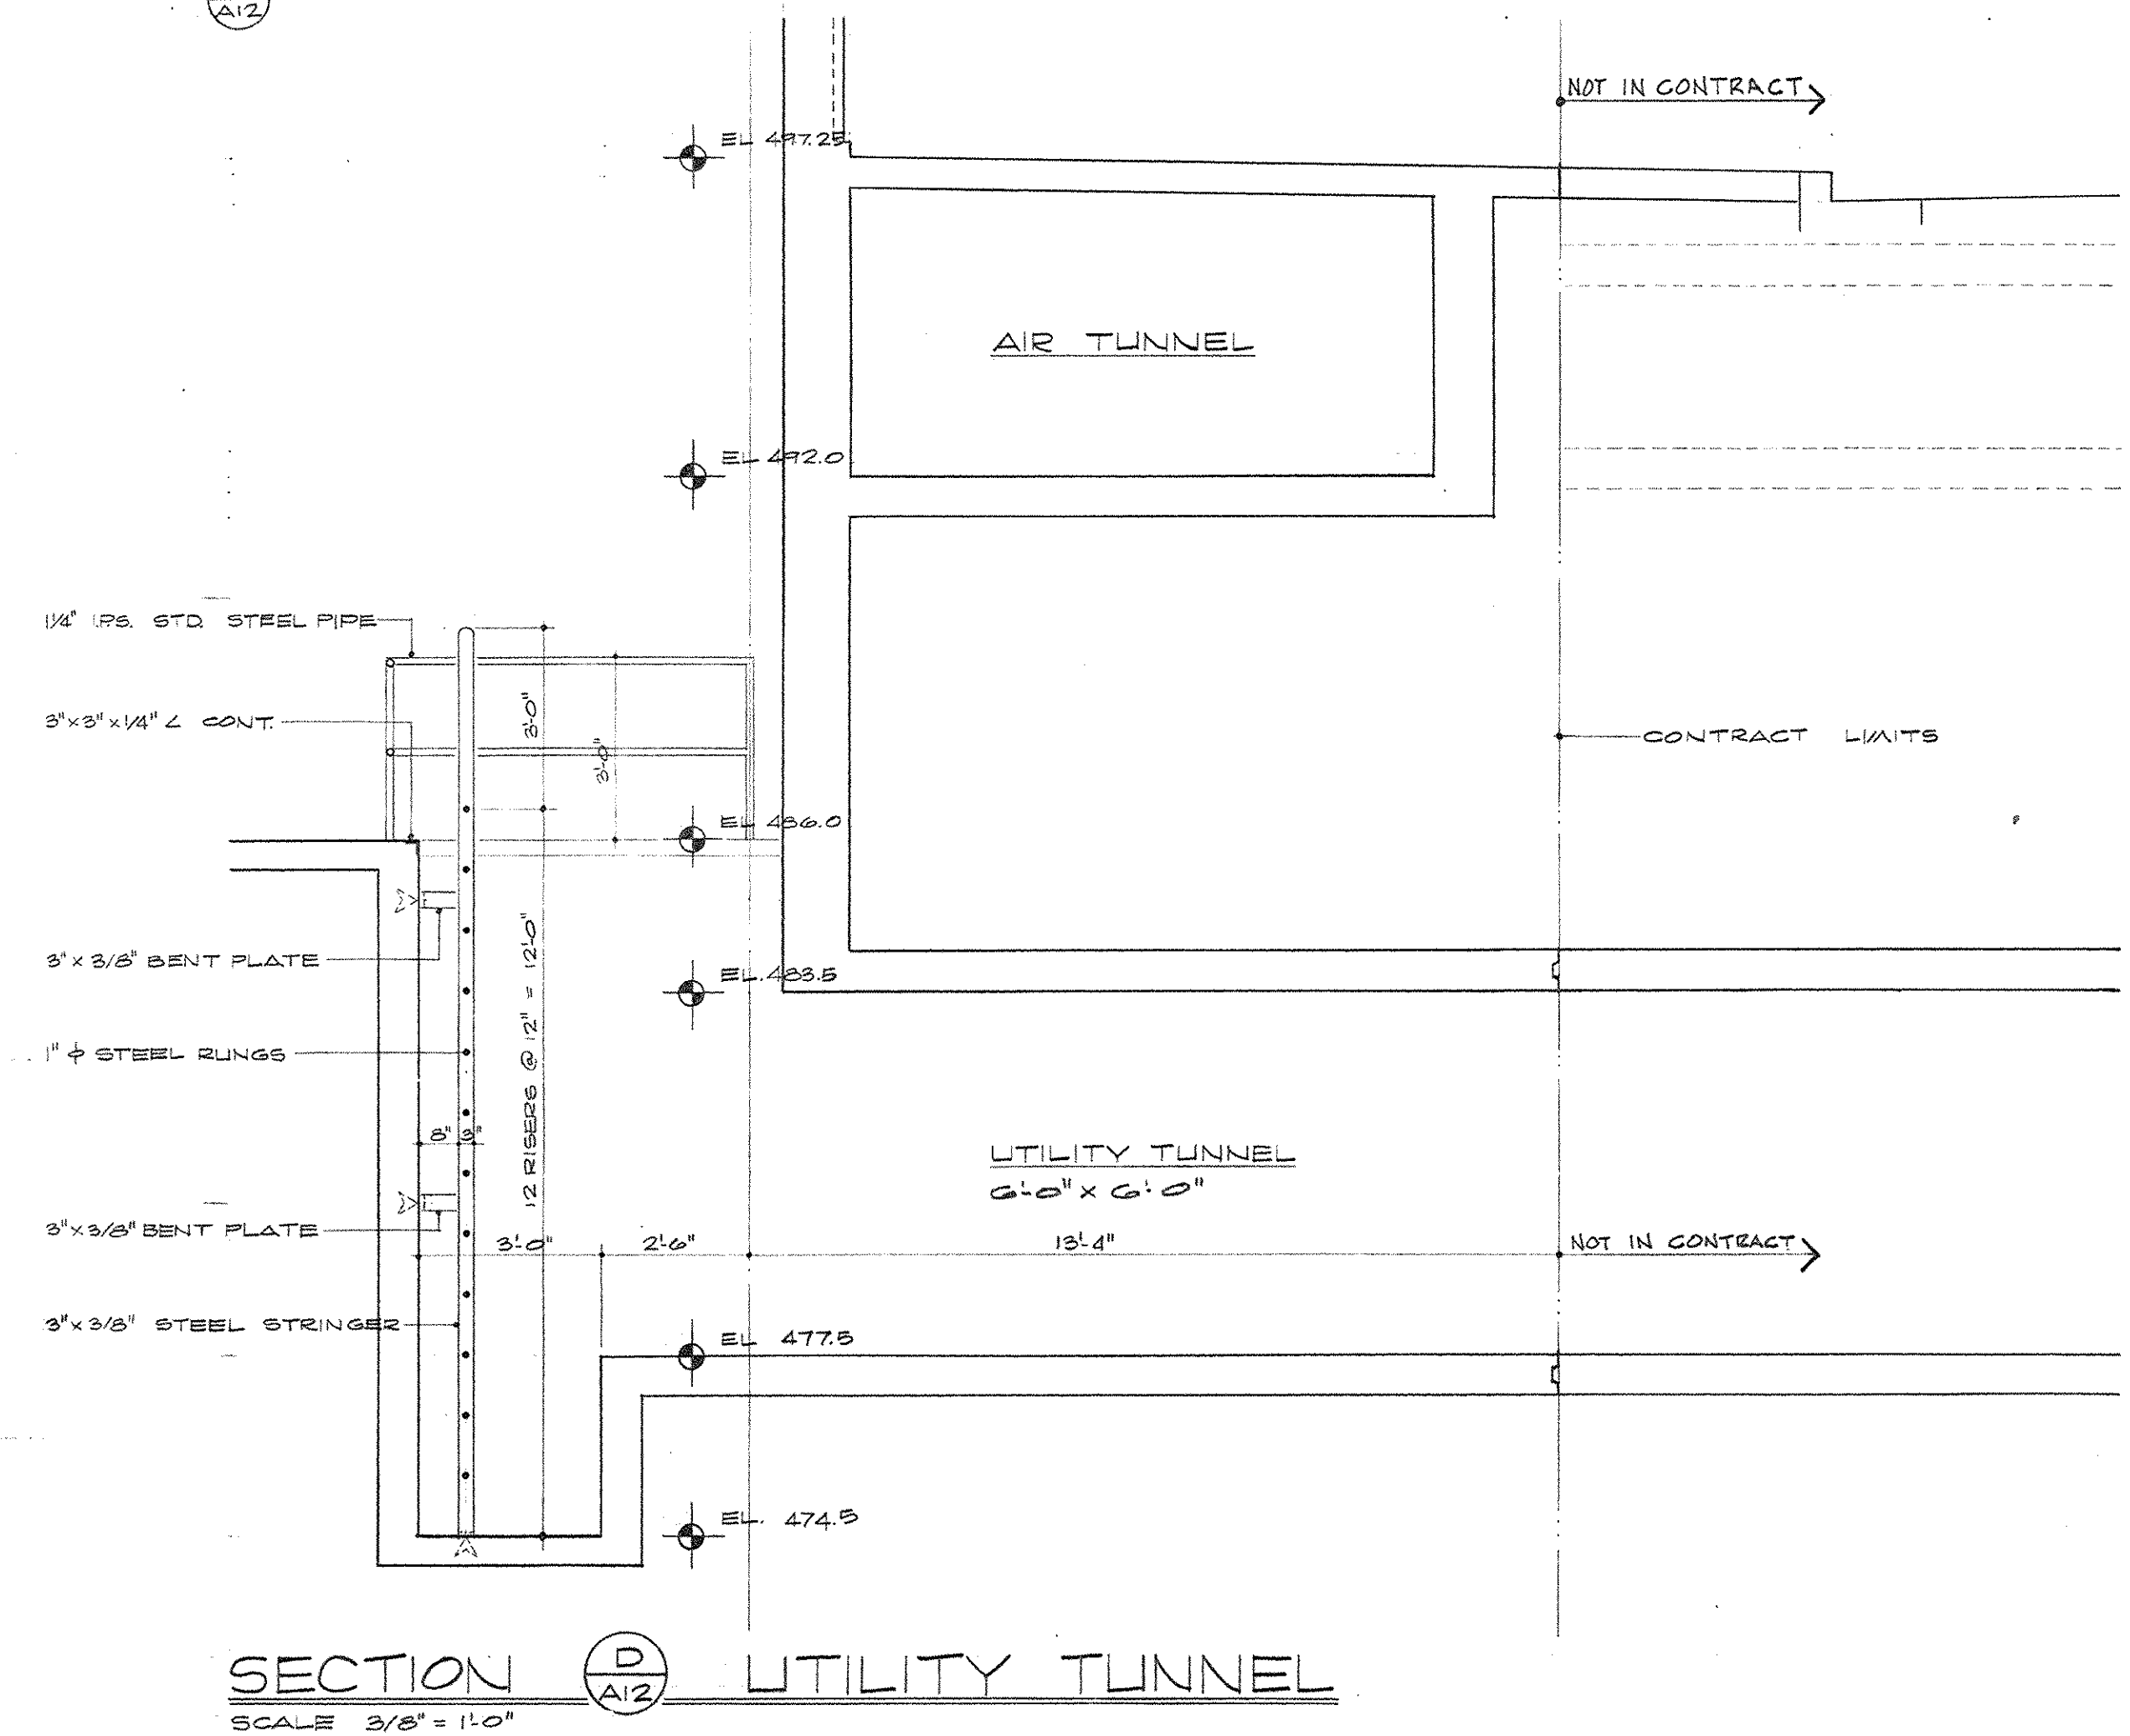

SECTION D-D UTILITY TUNNEL
SCALE: 3/8" = 1'-0"

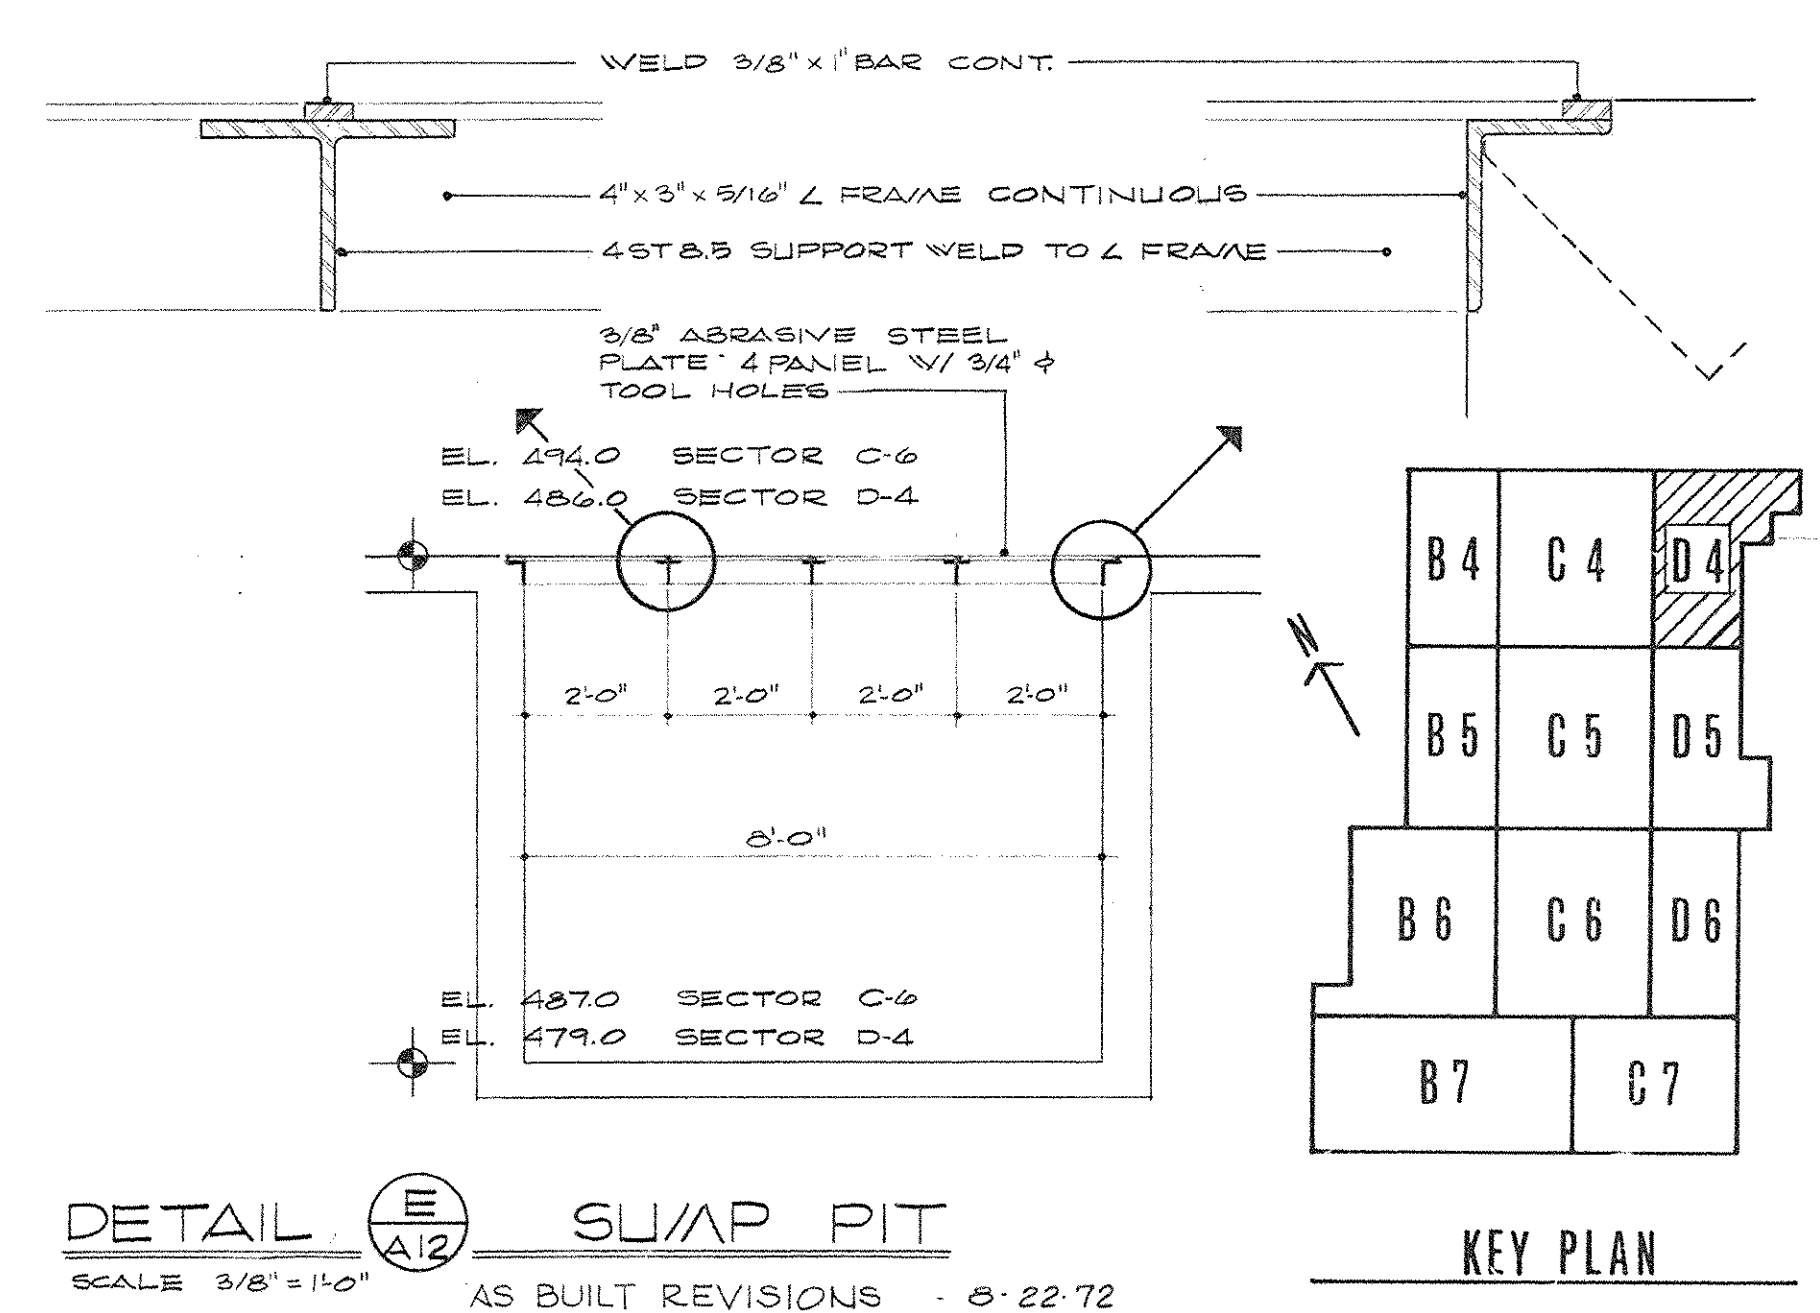



DETAIL E-E SLUMP PIT
SCALE: 3/8" = 1'-0"
AS BUILT REVISIONS - 8-22-72

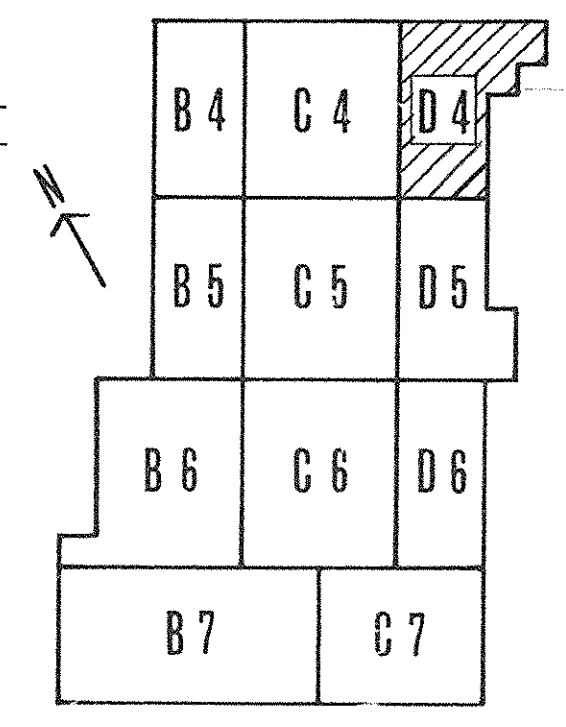


KEY PLAN

CAPITAL PLAZA DEVELOPMENT PHASE II FRANKFORT, KENTUCKY		
DRAWN BY L.P.S. & N.L.	CHECKED BY L.P.S.	DATE 10 OCT. 1967
REGISTERED NO. 338 CORPORATE ARCHITECTS	REGISTERED NO. 50367 ENGINEERS	COMMON. NO. 50367
SECTOR NO. D 4	LEE POTTER SMITH, PRITCHETT, HUGG & CARTER ARCHITECTS 314 WILKINSON STREET FRANKFORT, KENTUCKY	DRAWING NO. A 12
COMMONWEALTH OF KENTUCKY DEPARTMENT OF FINANCE - DIVISION OF ENGINEERING FRANKFORT, KENTUCKY		
APPROVED BY AGENCY HEAD	DATE	
APPROVED BY OWNER	DATE	10-24-67

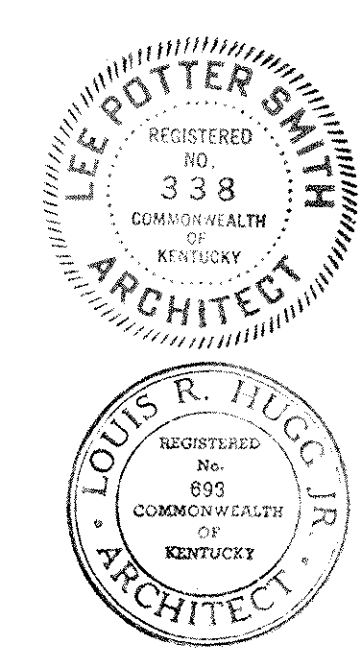


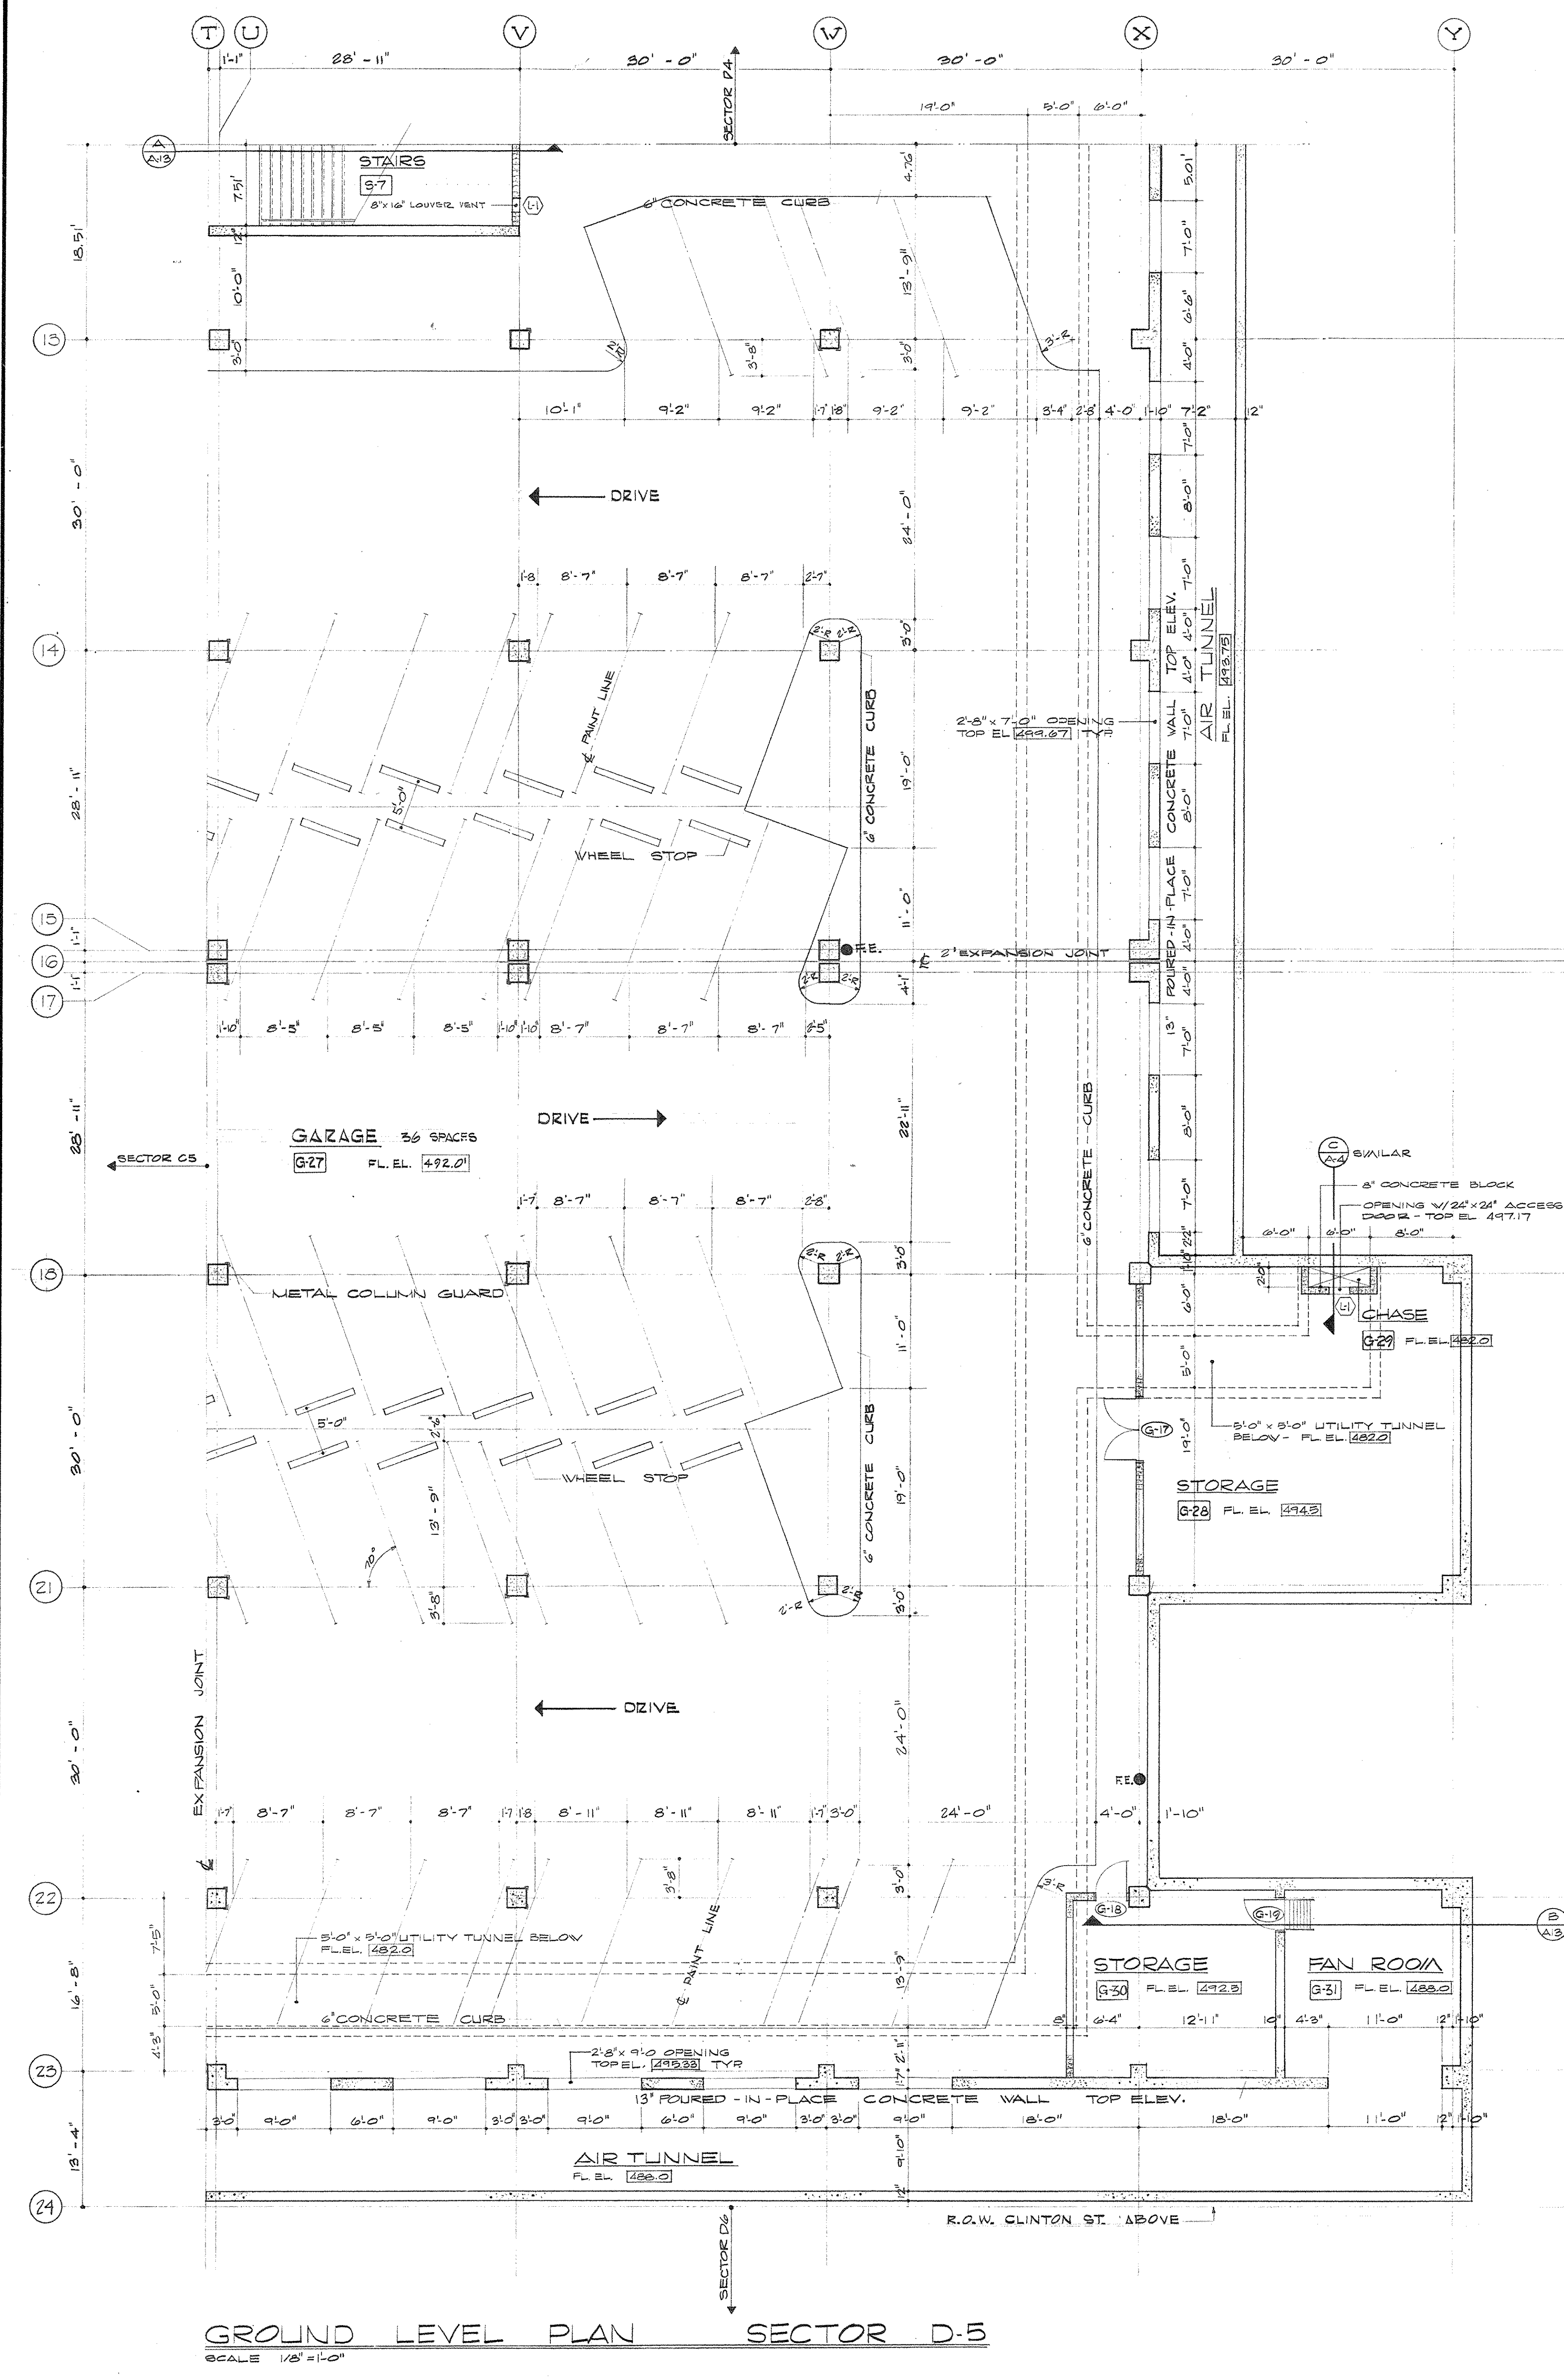


GROUND LEVEL PLAN SECTOR D-5
SCALE 1/8" = 1'-0"

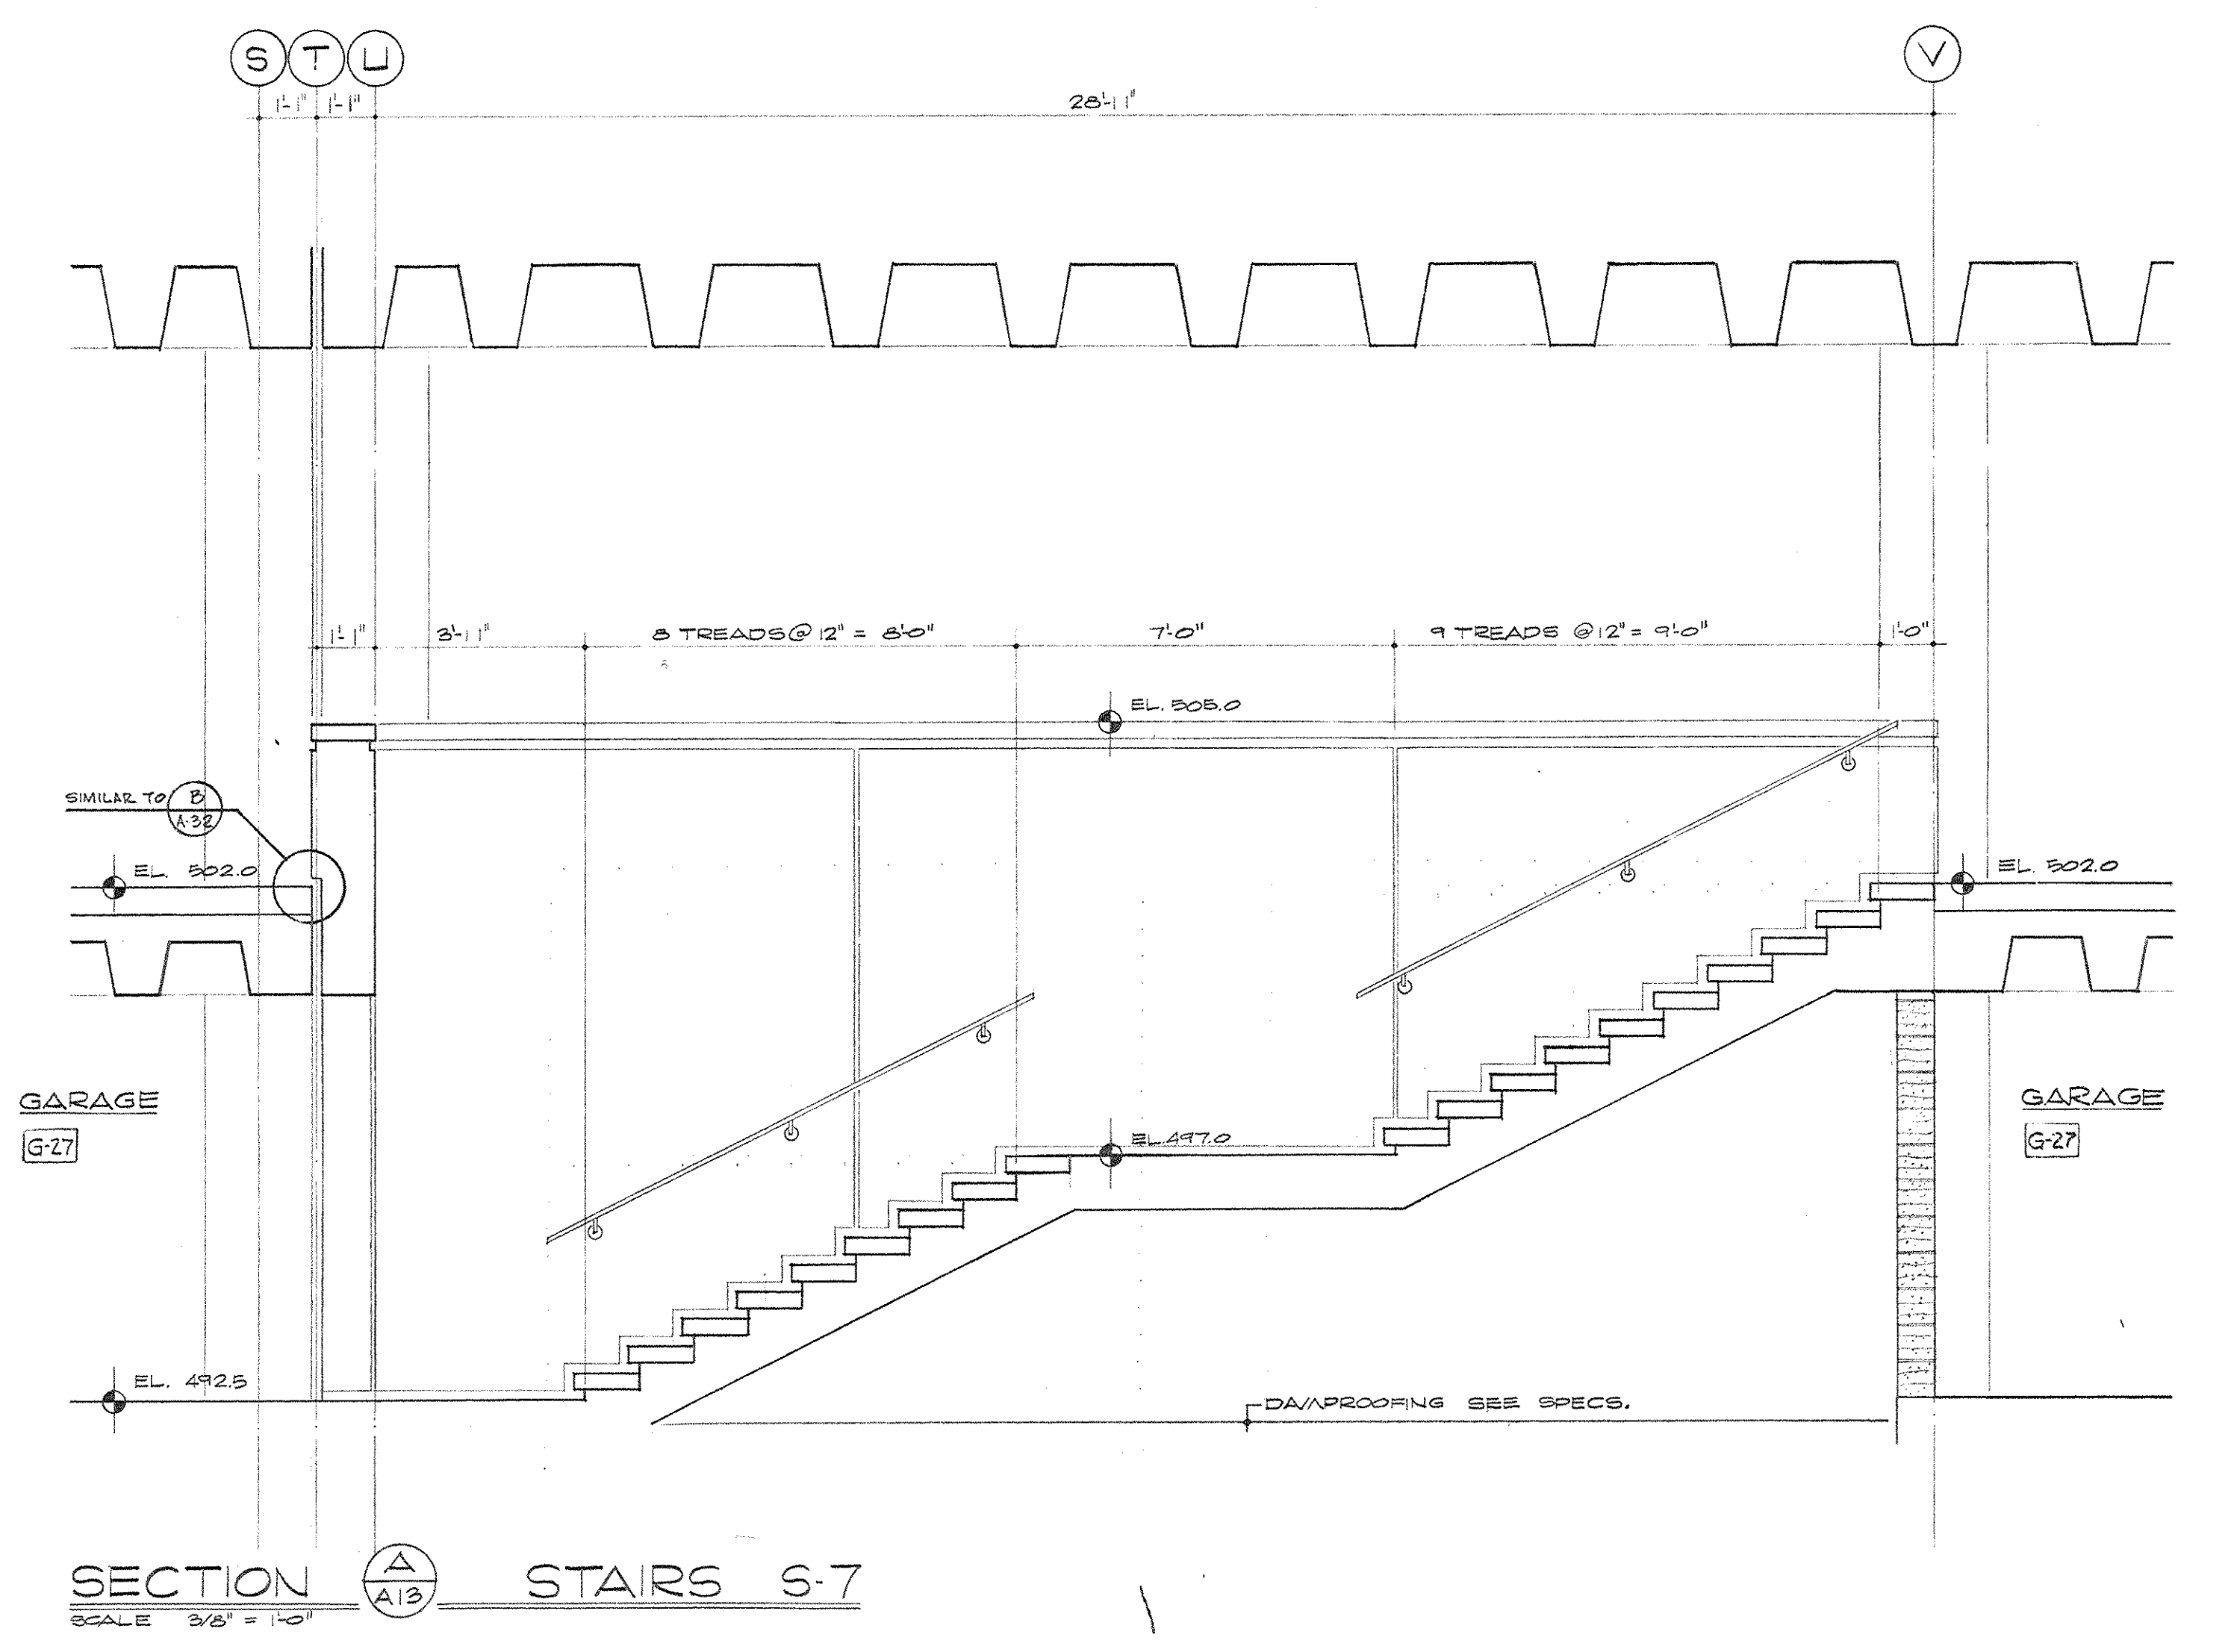

SECTION A-A STAIRS S-7
SCALE 3/8" = 1'-0"

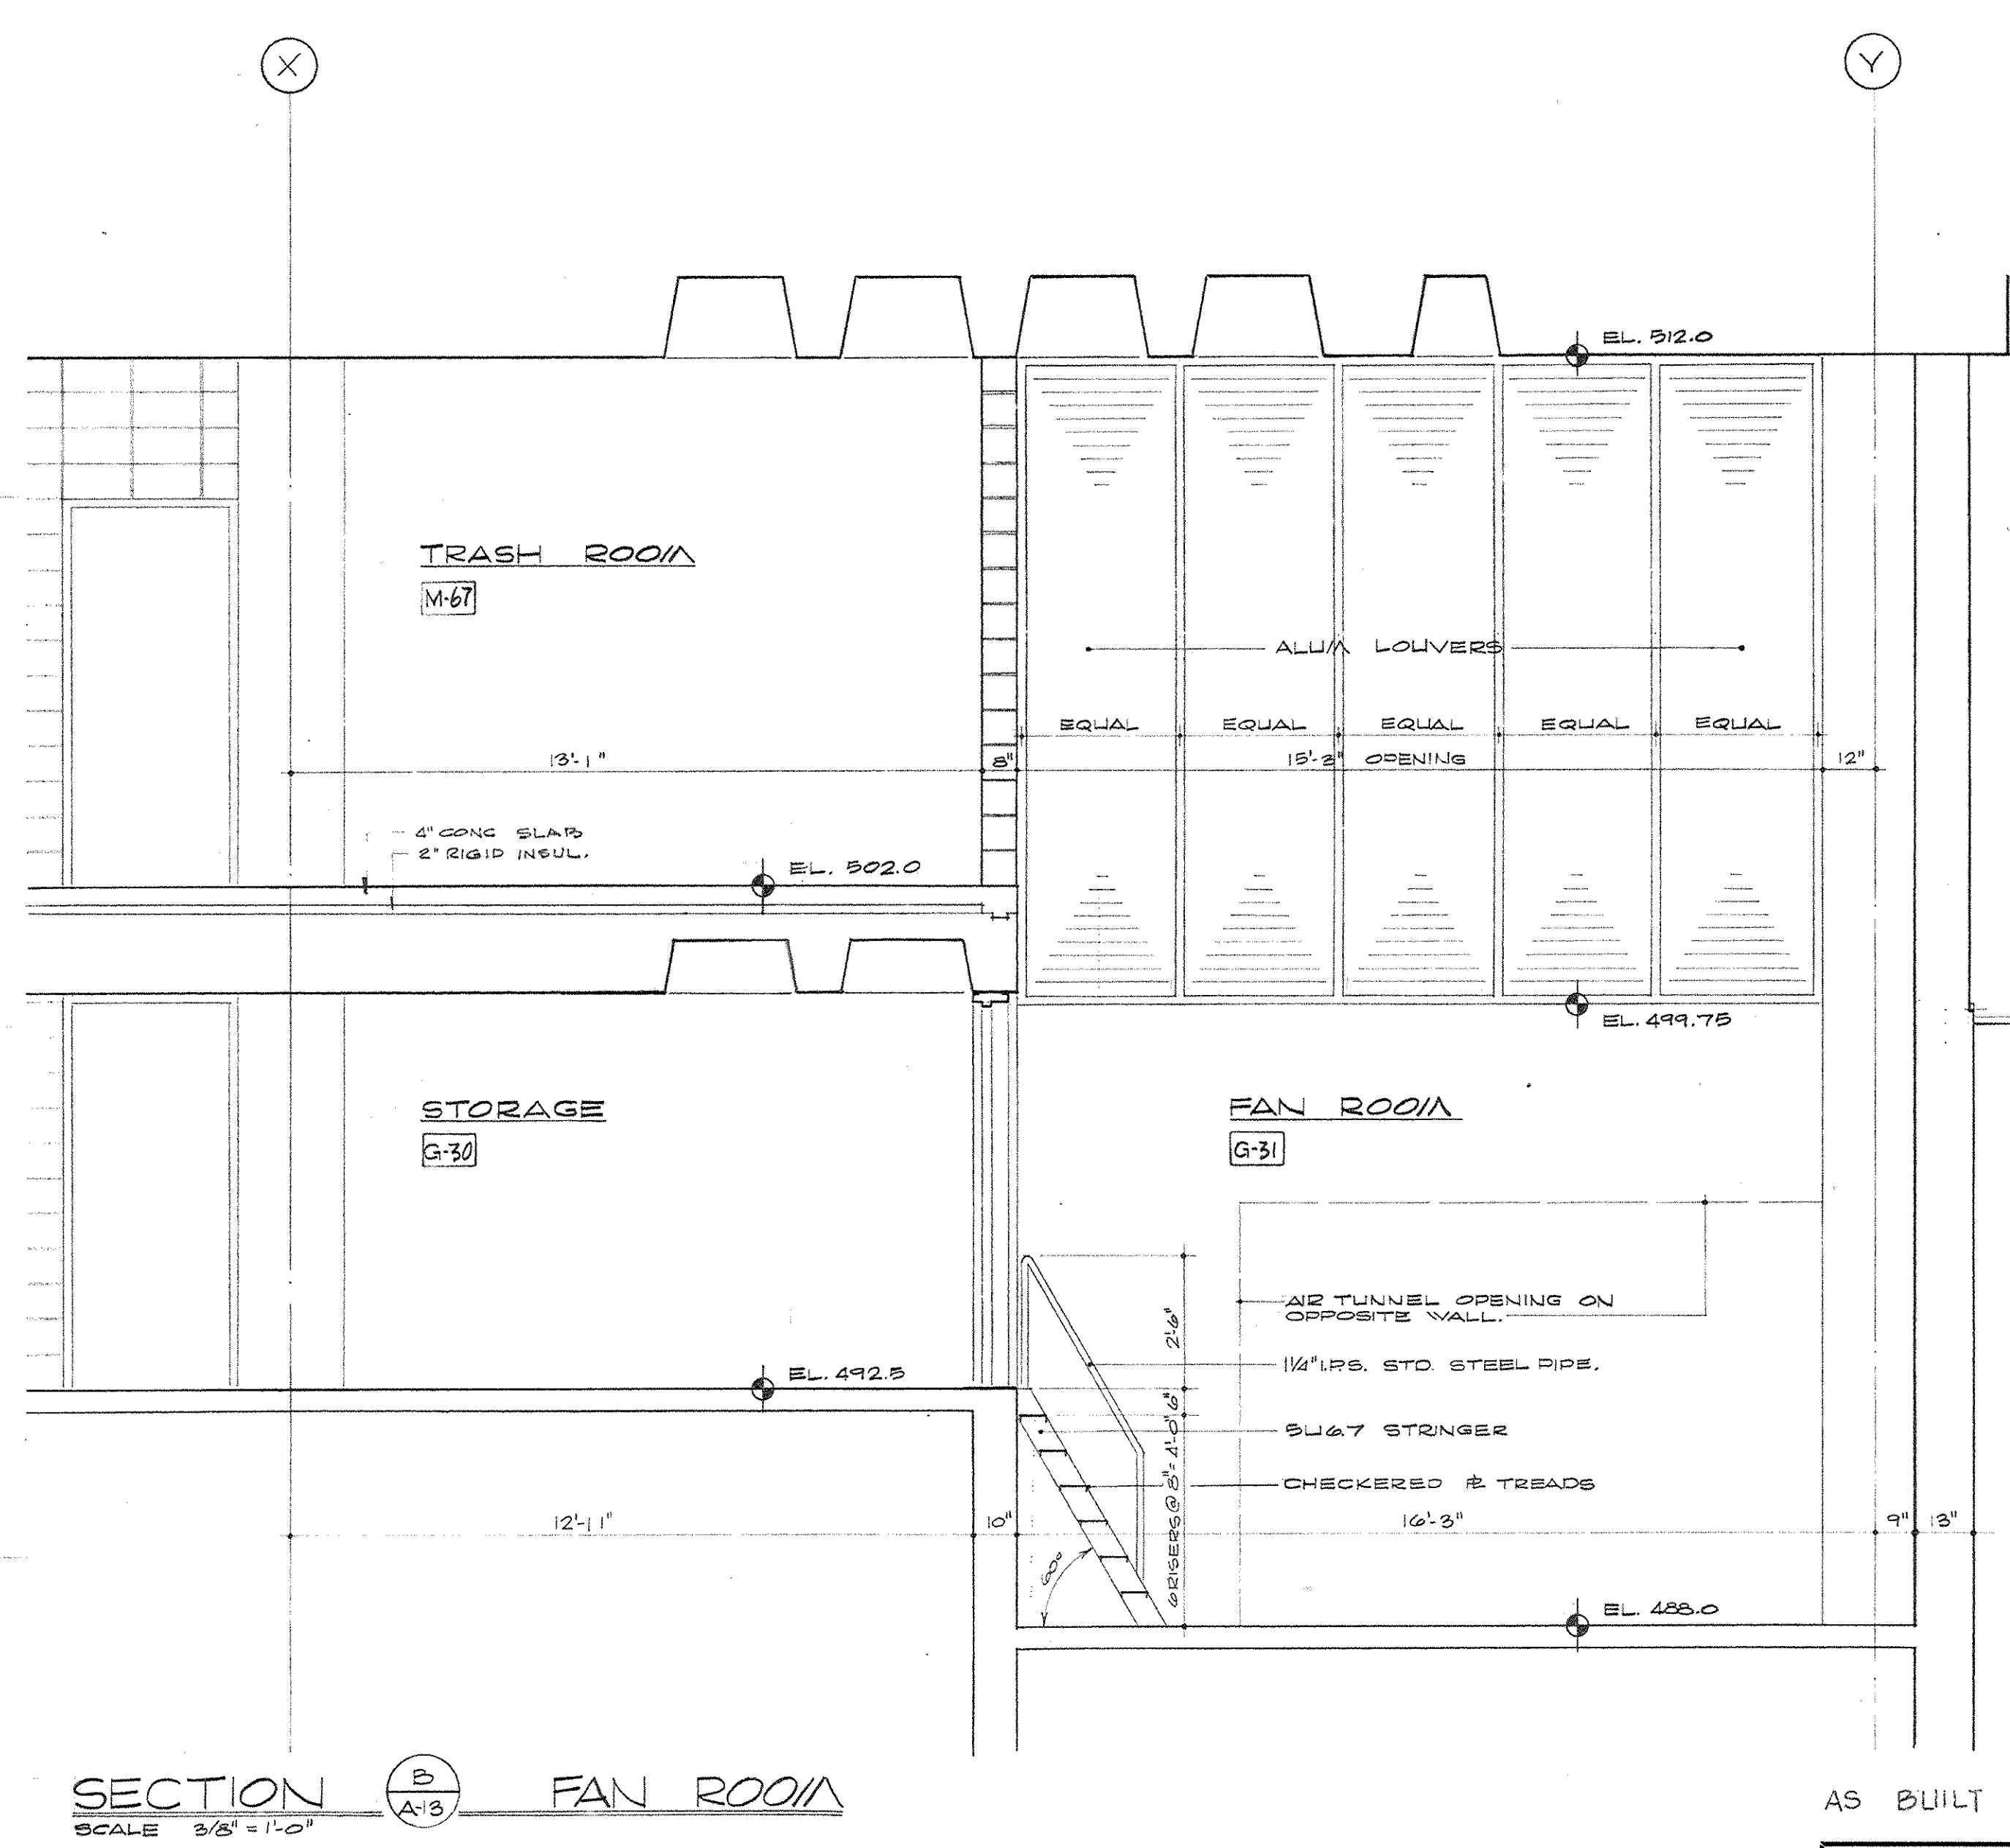


SECTION B-B FAN ROOM
SCALE 3/8" = 1'-0"

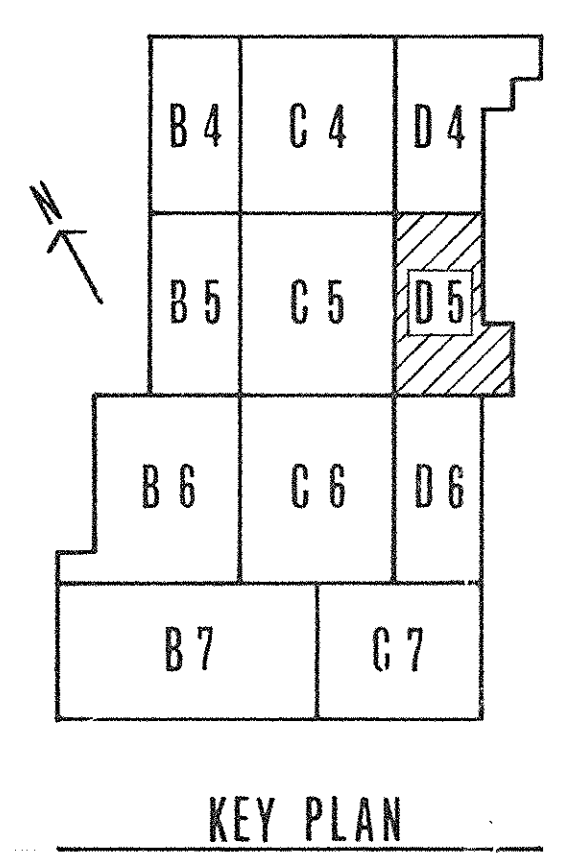


KEY PLAN


AS BUILT REVISIONS - 8-24-72

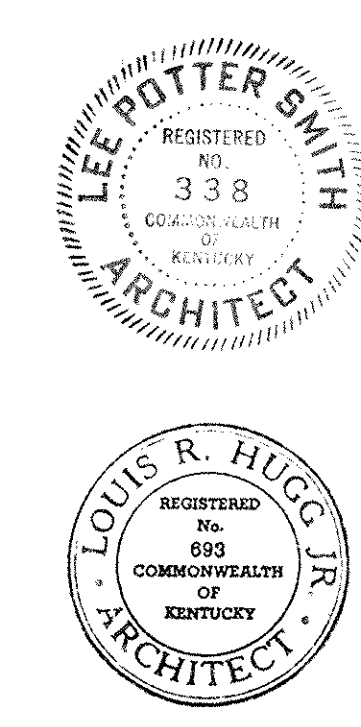


CAPITAL PLAZA DEVELOPMENT PHASE II			DATE
FRANKFORT, KENTUCKY			10-22-72
DRAWN BY J.B.	GROUND LEVEL PLAN	LEE POTTER SMITH, PRITCHETT, HUGG & CARTER ARCHITECTS 314 WILKINSON STREET FRANKFORT, KENTUCKY	DATE
CHECKED BY L.R.H.			10-22-72
SECTOR NO. D 5	COMMONWEALTH OF KENTUCKY DEPARTMENT OF FINANCE - DIVISION OF ENGINEERING FRANKFORT, KENTUCKY	DRAWING NO. A 13	DATE
APPROVED BY AGENCY HEAD <i>W. M. Combs</i>			10-26-72
APPROVED BY OWNER			DATE

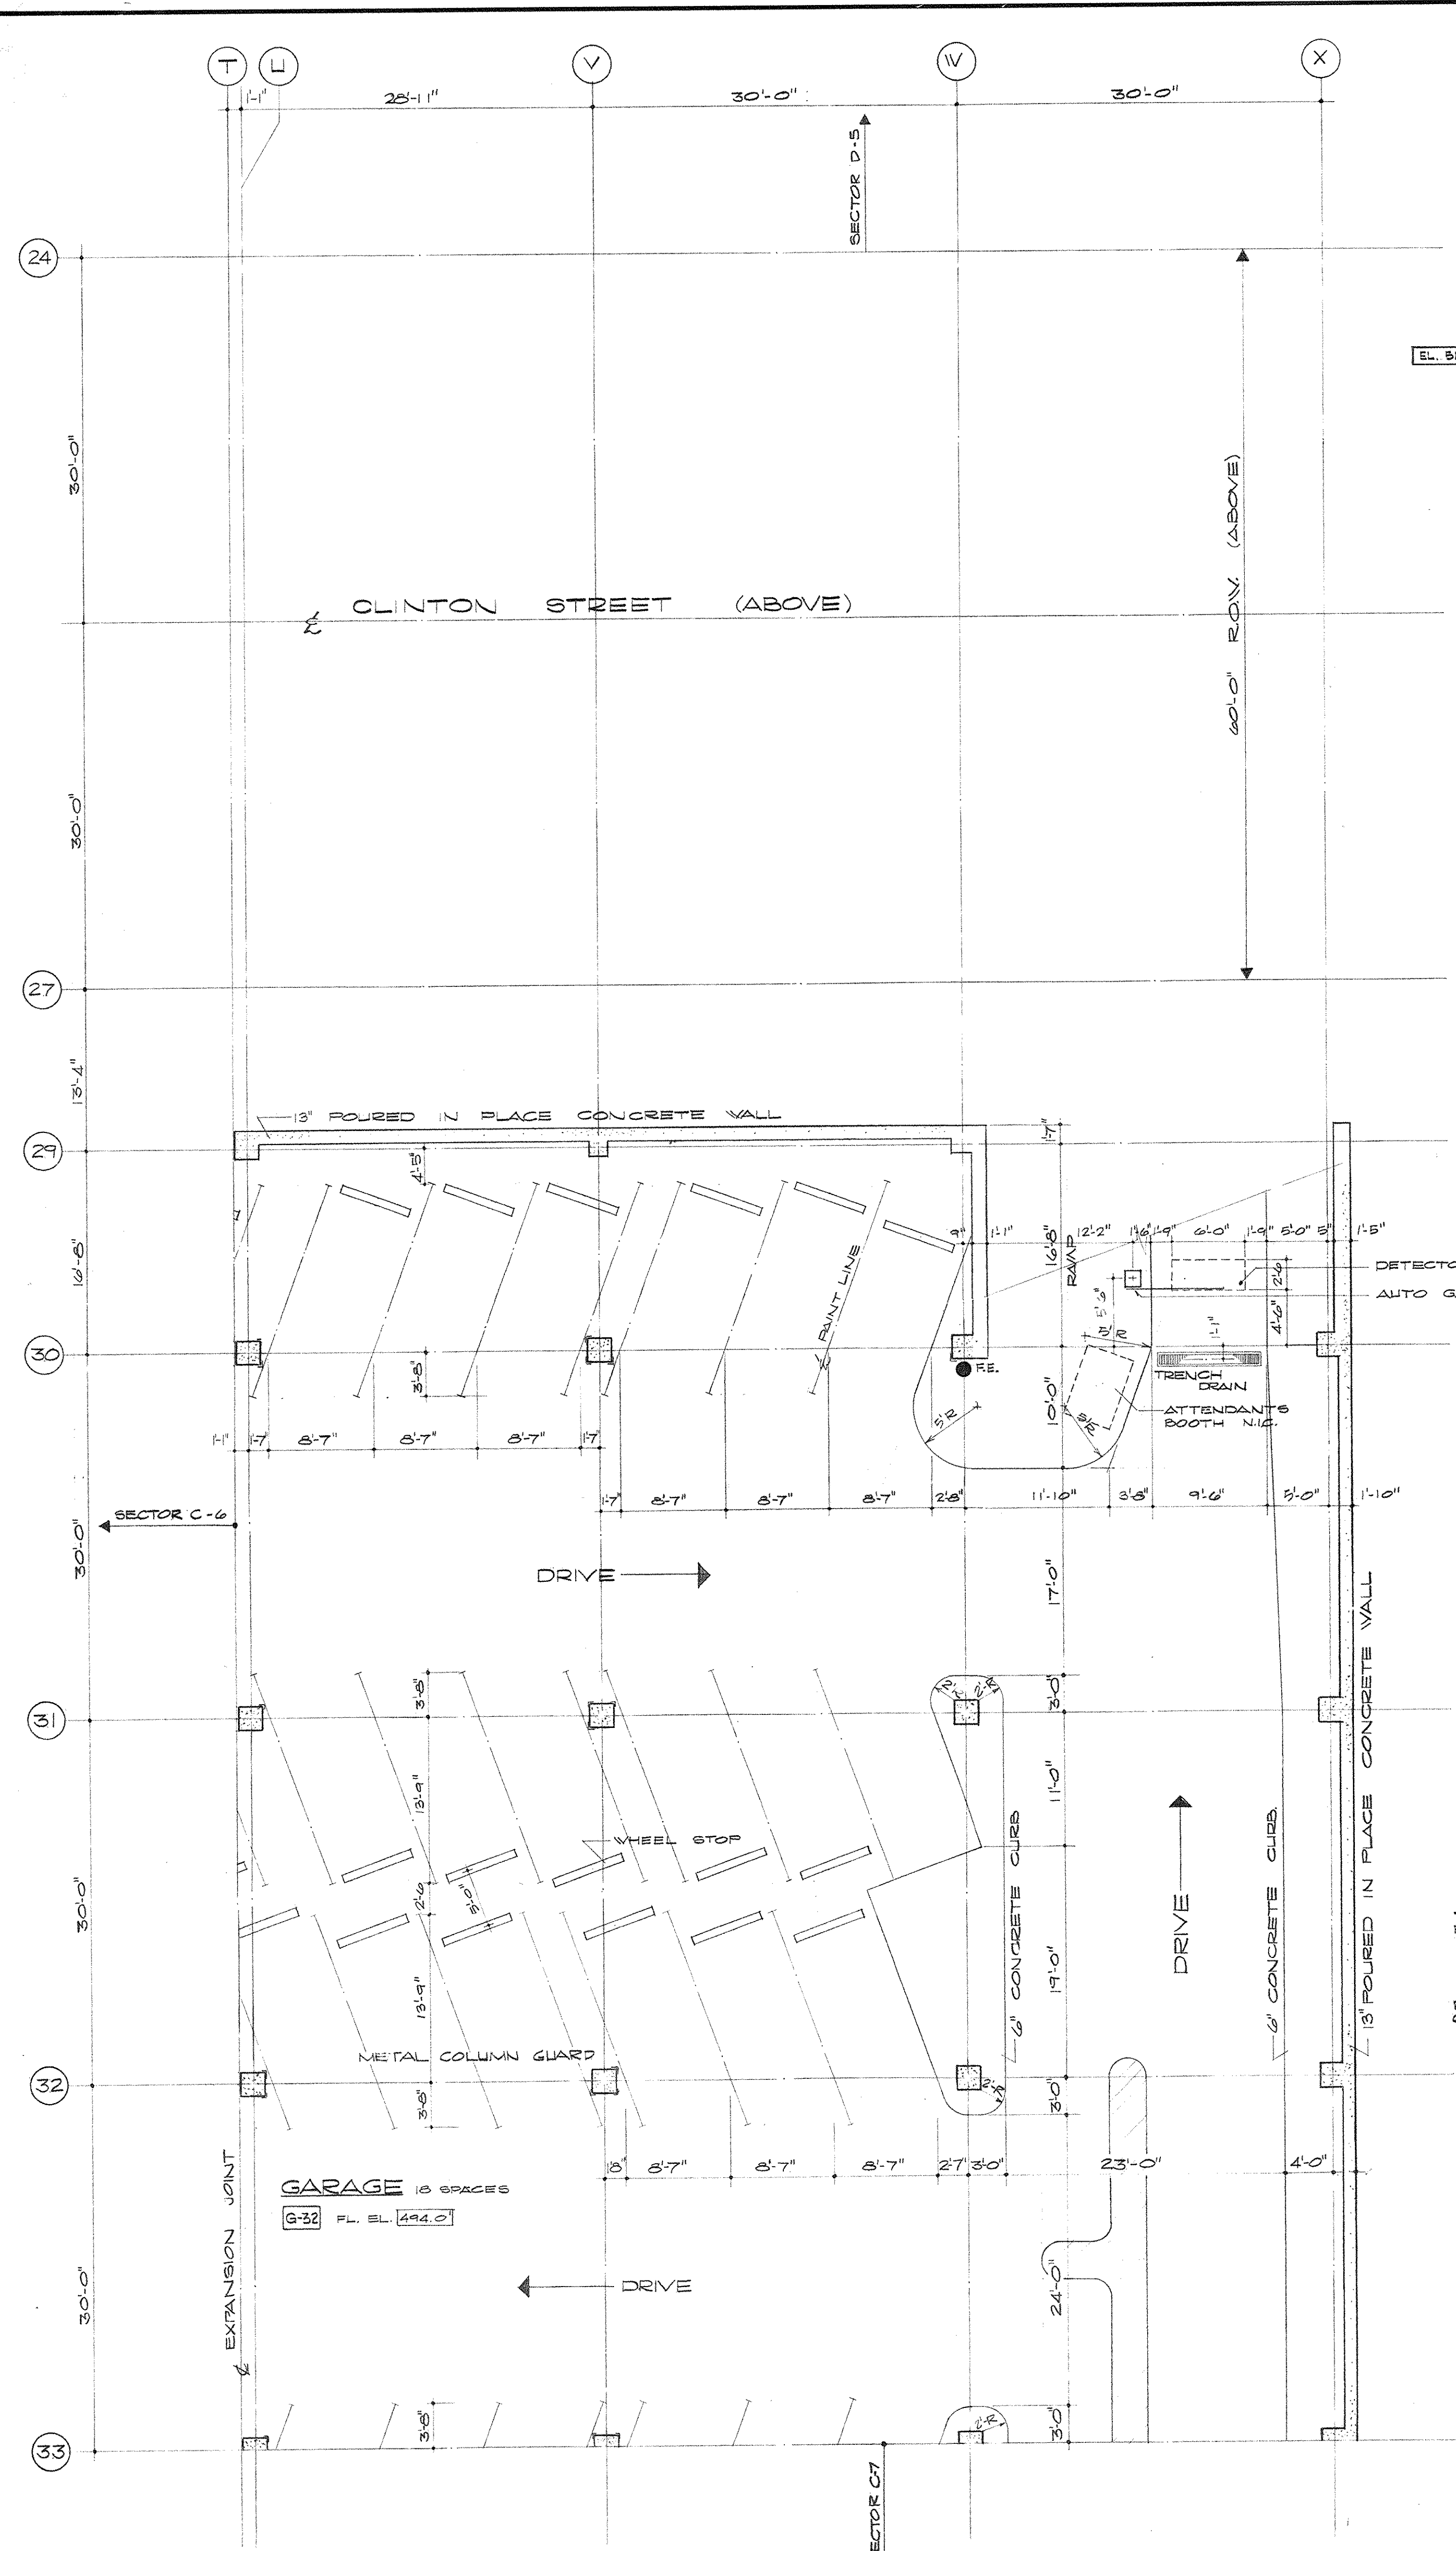


GROUND LEVEL PLAN SECTOR D-6
 SCALE: 1/8" = 1'-0"
 NOTE: SYMBOL "R.E." INDICATES LOCATION OF CO² FIRE EXTINGUISHERS. SEE SPECS.

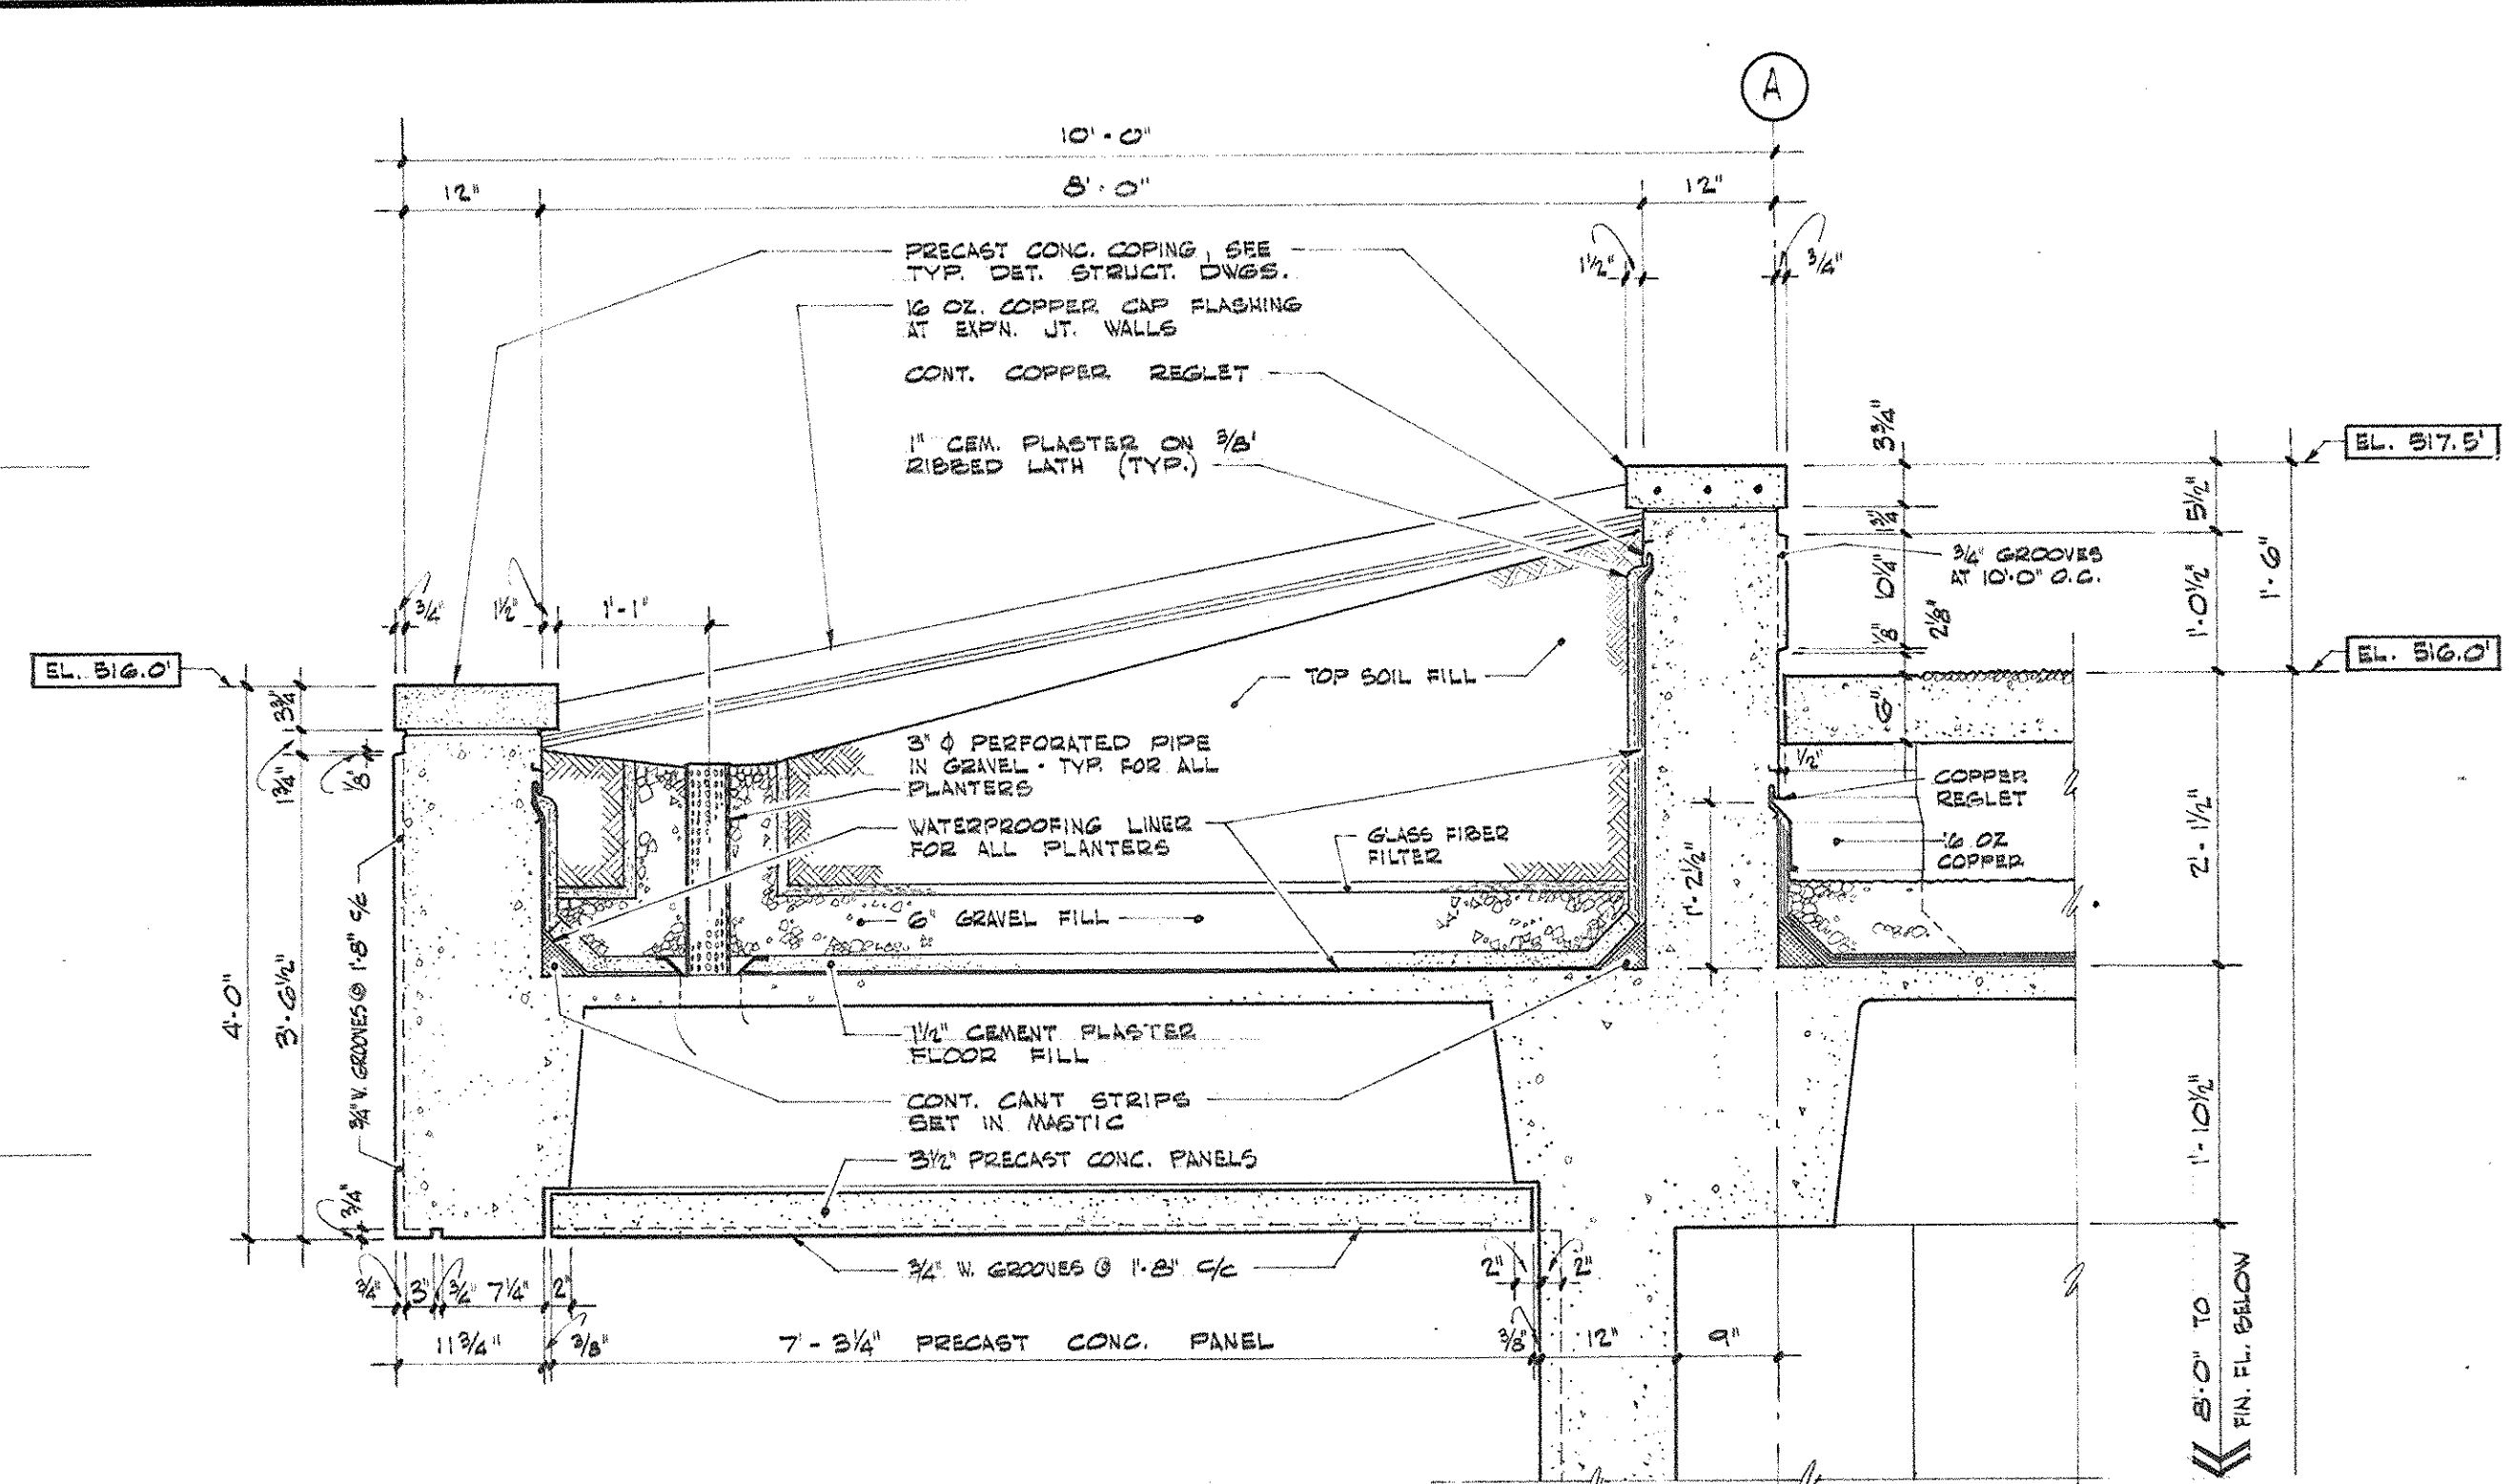


SECTION A-A
 SCALE: 3/4" = 1'-0"

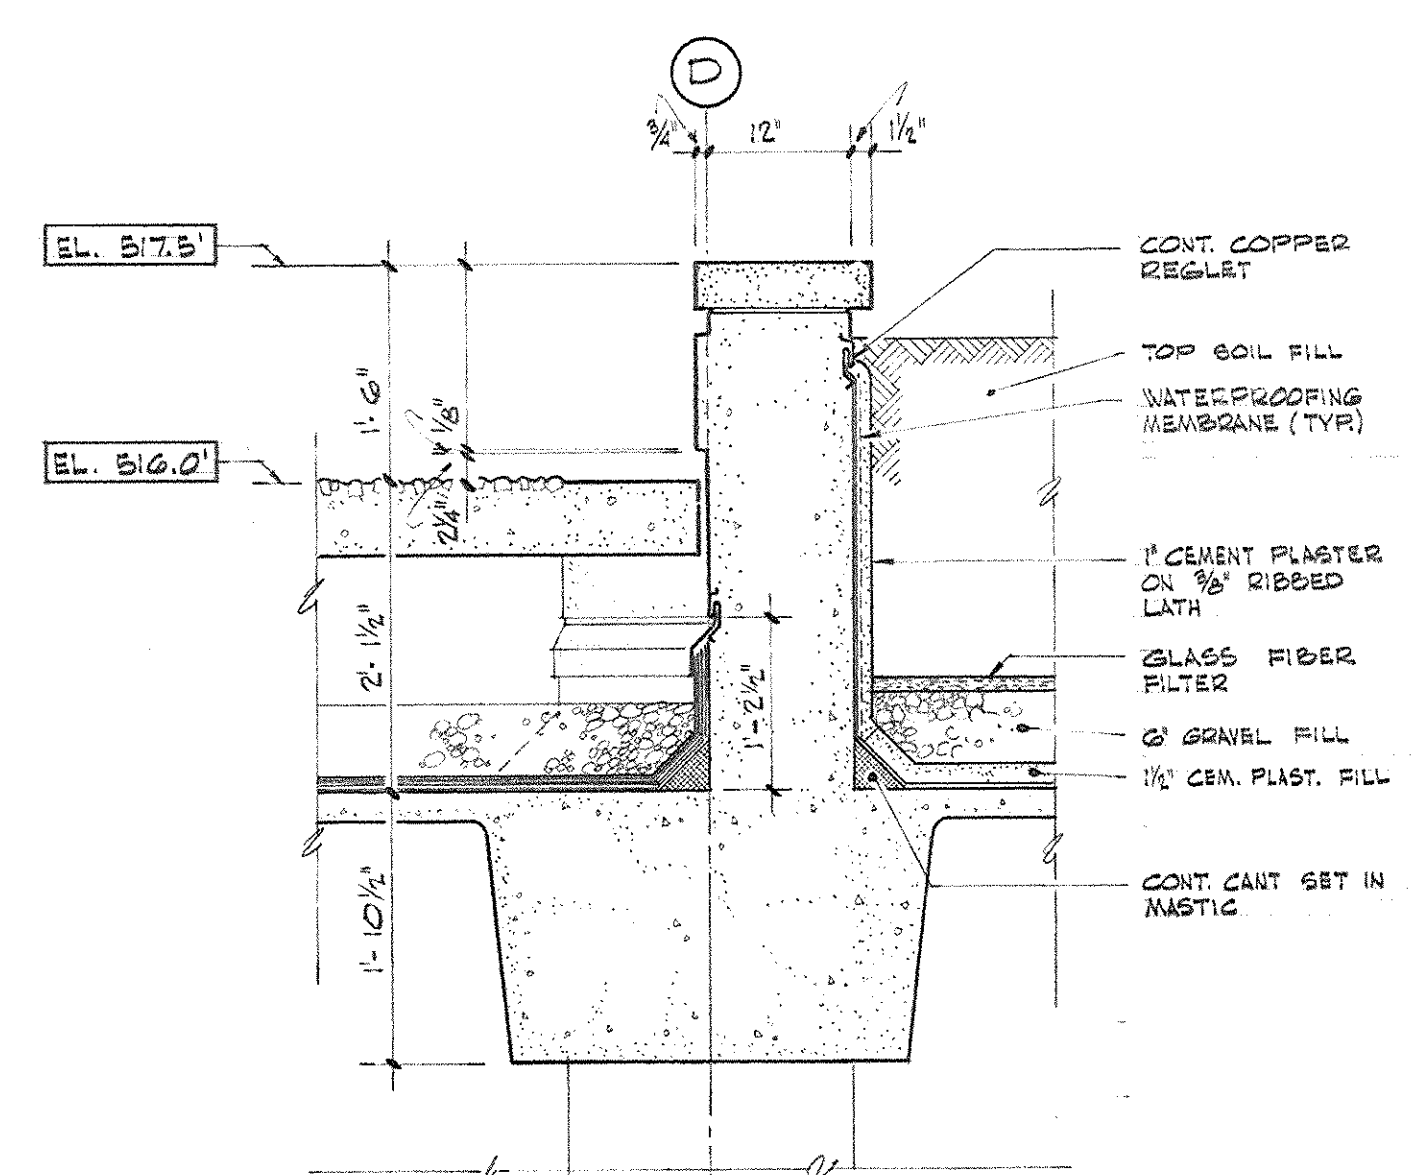

SECTION B-B
 SCALE: 3/4" = 1'-0"

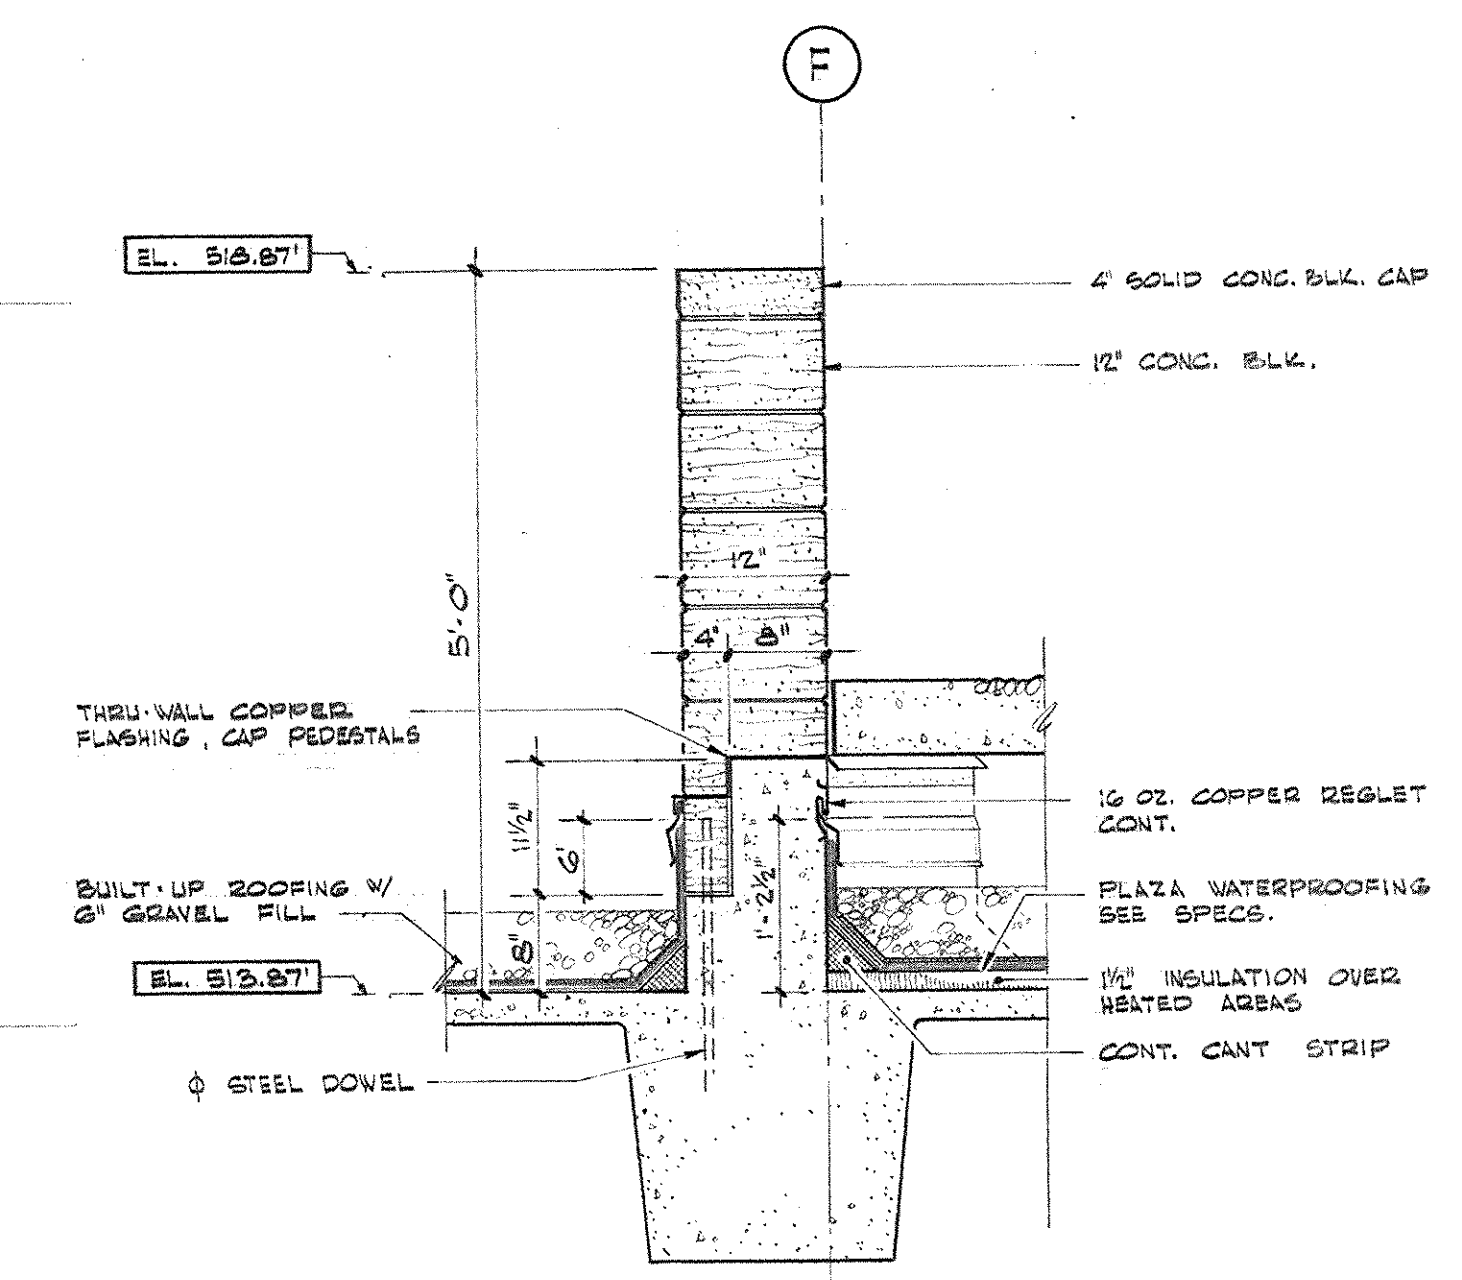


SECTION C-C
 SCALE: 3/4" = 1'-0"




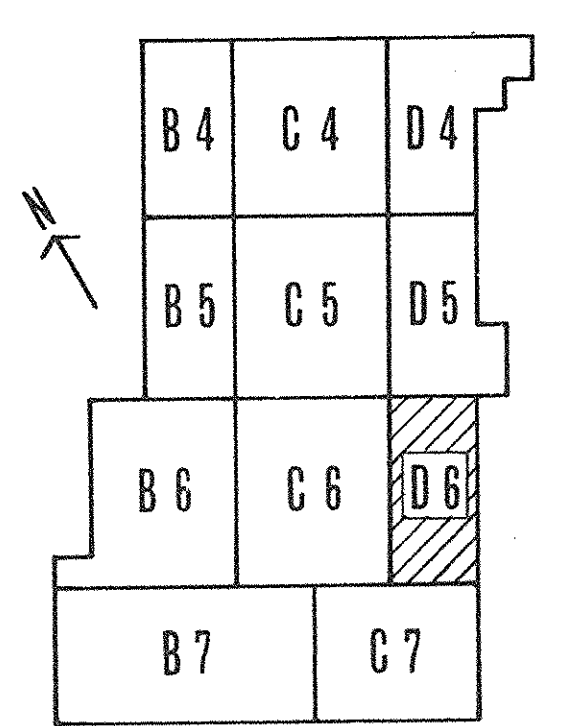


KEY PLAN


AS BUILT REVISIONS 8.28.72

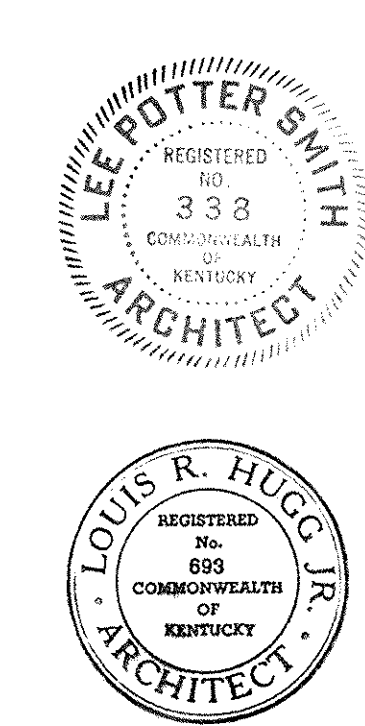

CAPITAL PLAZA DEVELOPMENT PHASE II FRANKFORT, KENTUCKY		
DRAWN BY J.B.	GROUND LEVEL PLAN	DATE 10 OCT 1967
CHECKED BY L.P.S.		CONTR. NO. 59387
SECTOR NO. D 6	LEE POTTER SMITH, PRITCHETT, HUGG & CARTER ARCHITECTS 314 WILKINSON STREET FRANKFORT, KENTUCKY	ENGINEERS FRANKFORT, KENTUCKY
	COMMONWEALTH OF KENTUCKY DEPARTMENT OF FINANCE - DIVISION OF ENGINEERING FRANKFORT	DRAWING NO. A 14 OF A-42
APPROVED BY AGENCY HEAD	<i>W. M. ...</i>	DATE 10-26-67
APPROVED BY OWNER		

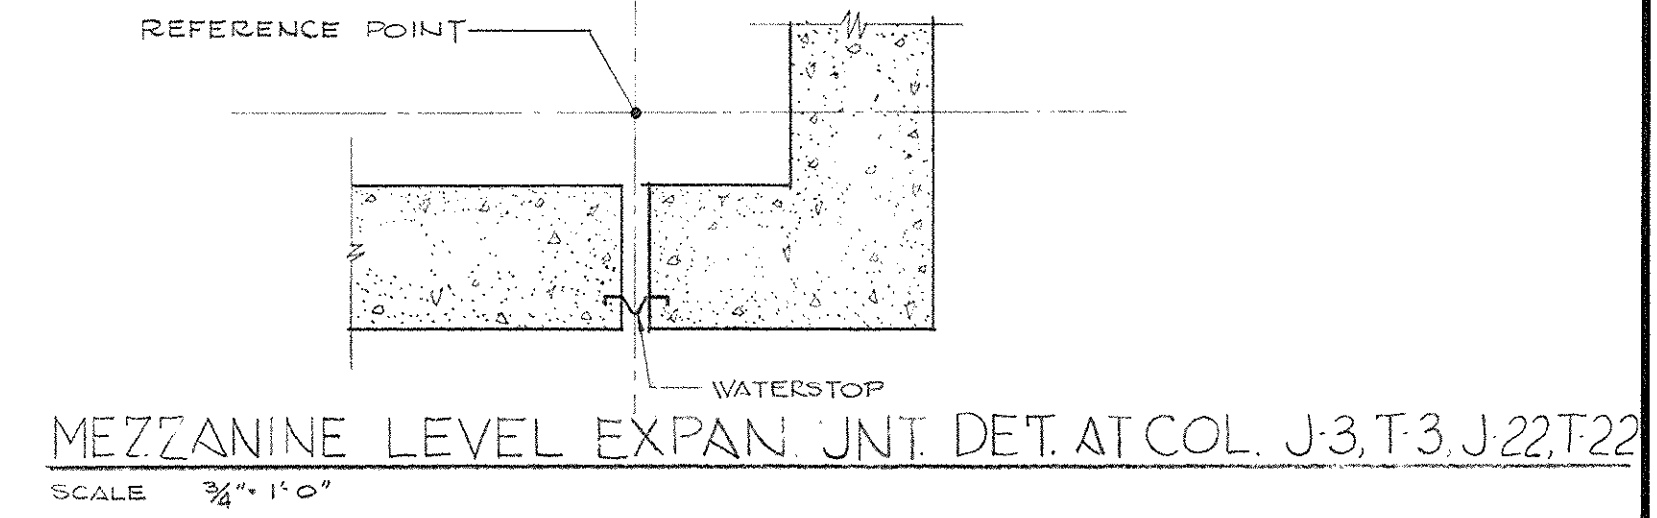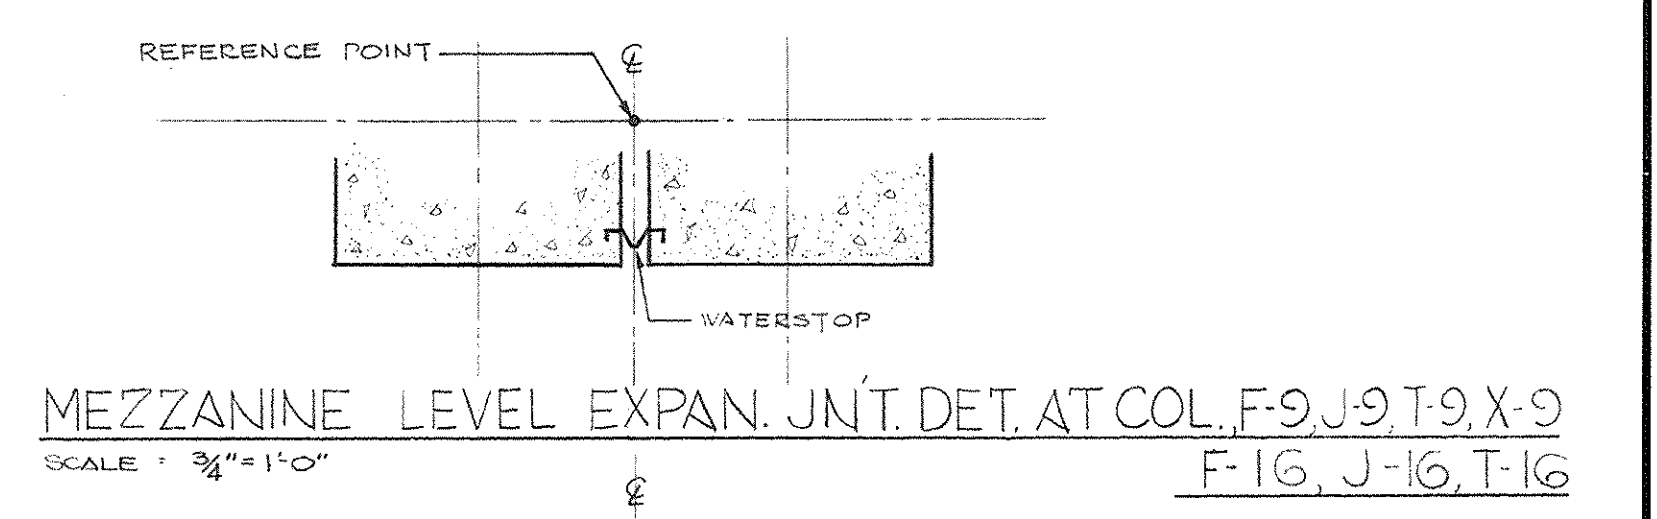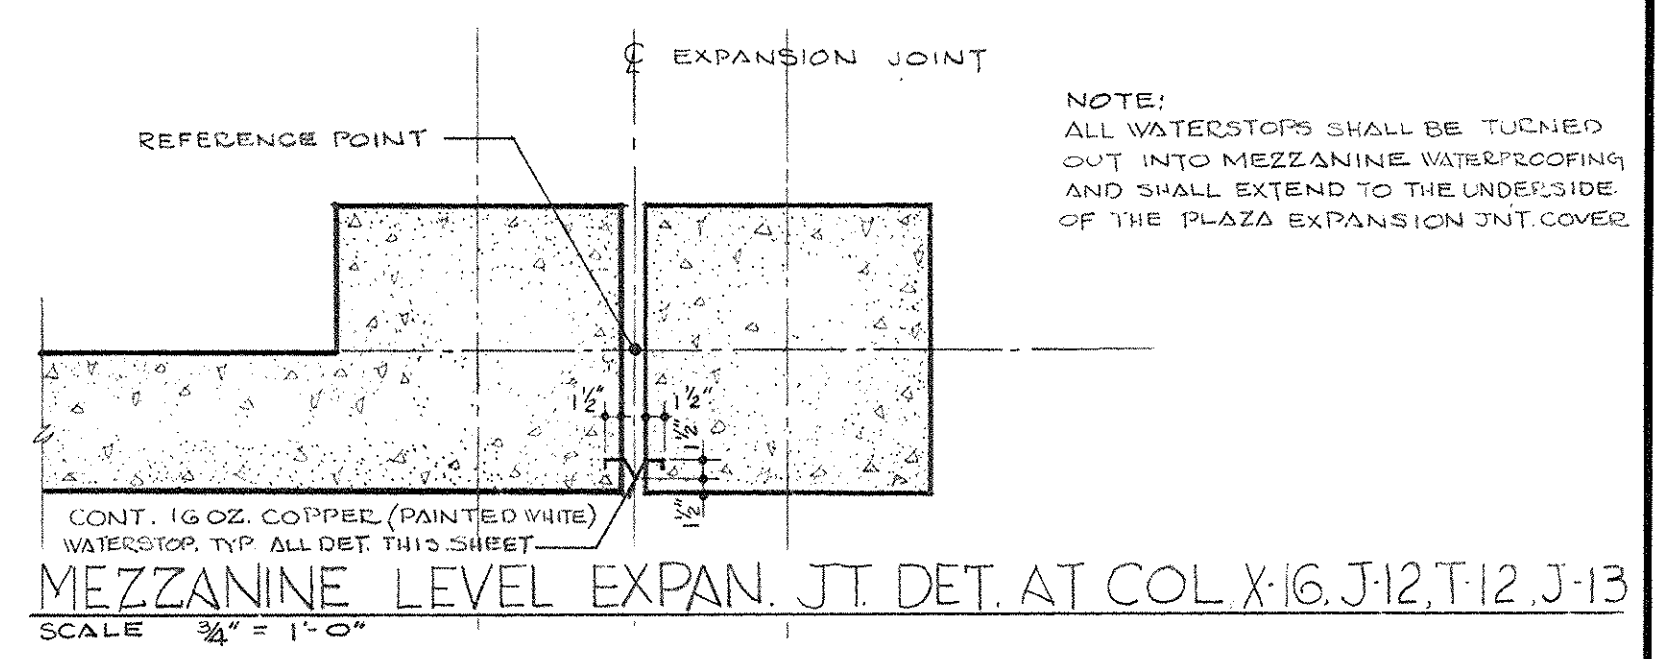
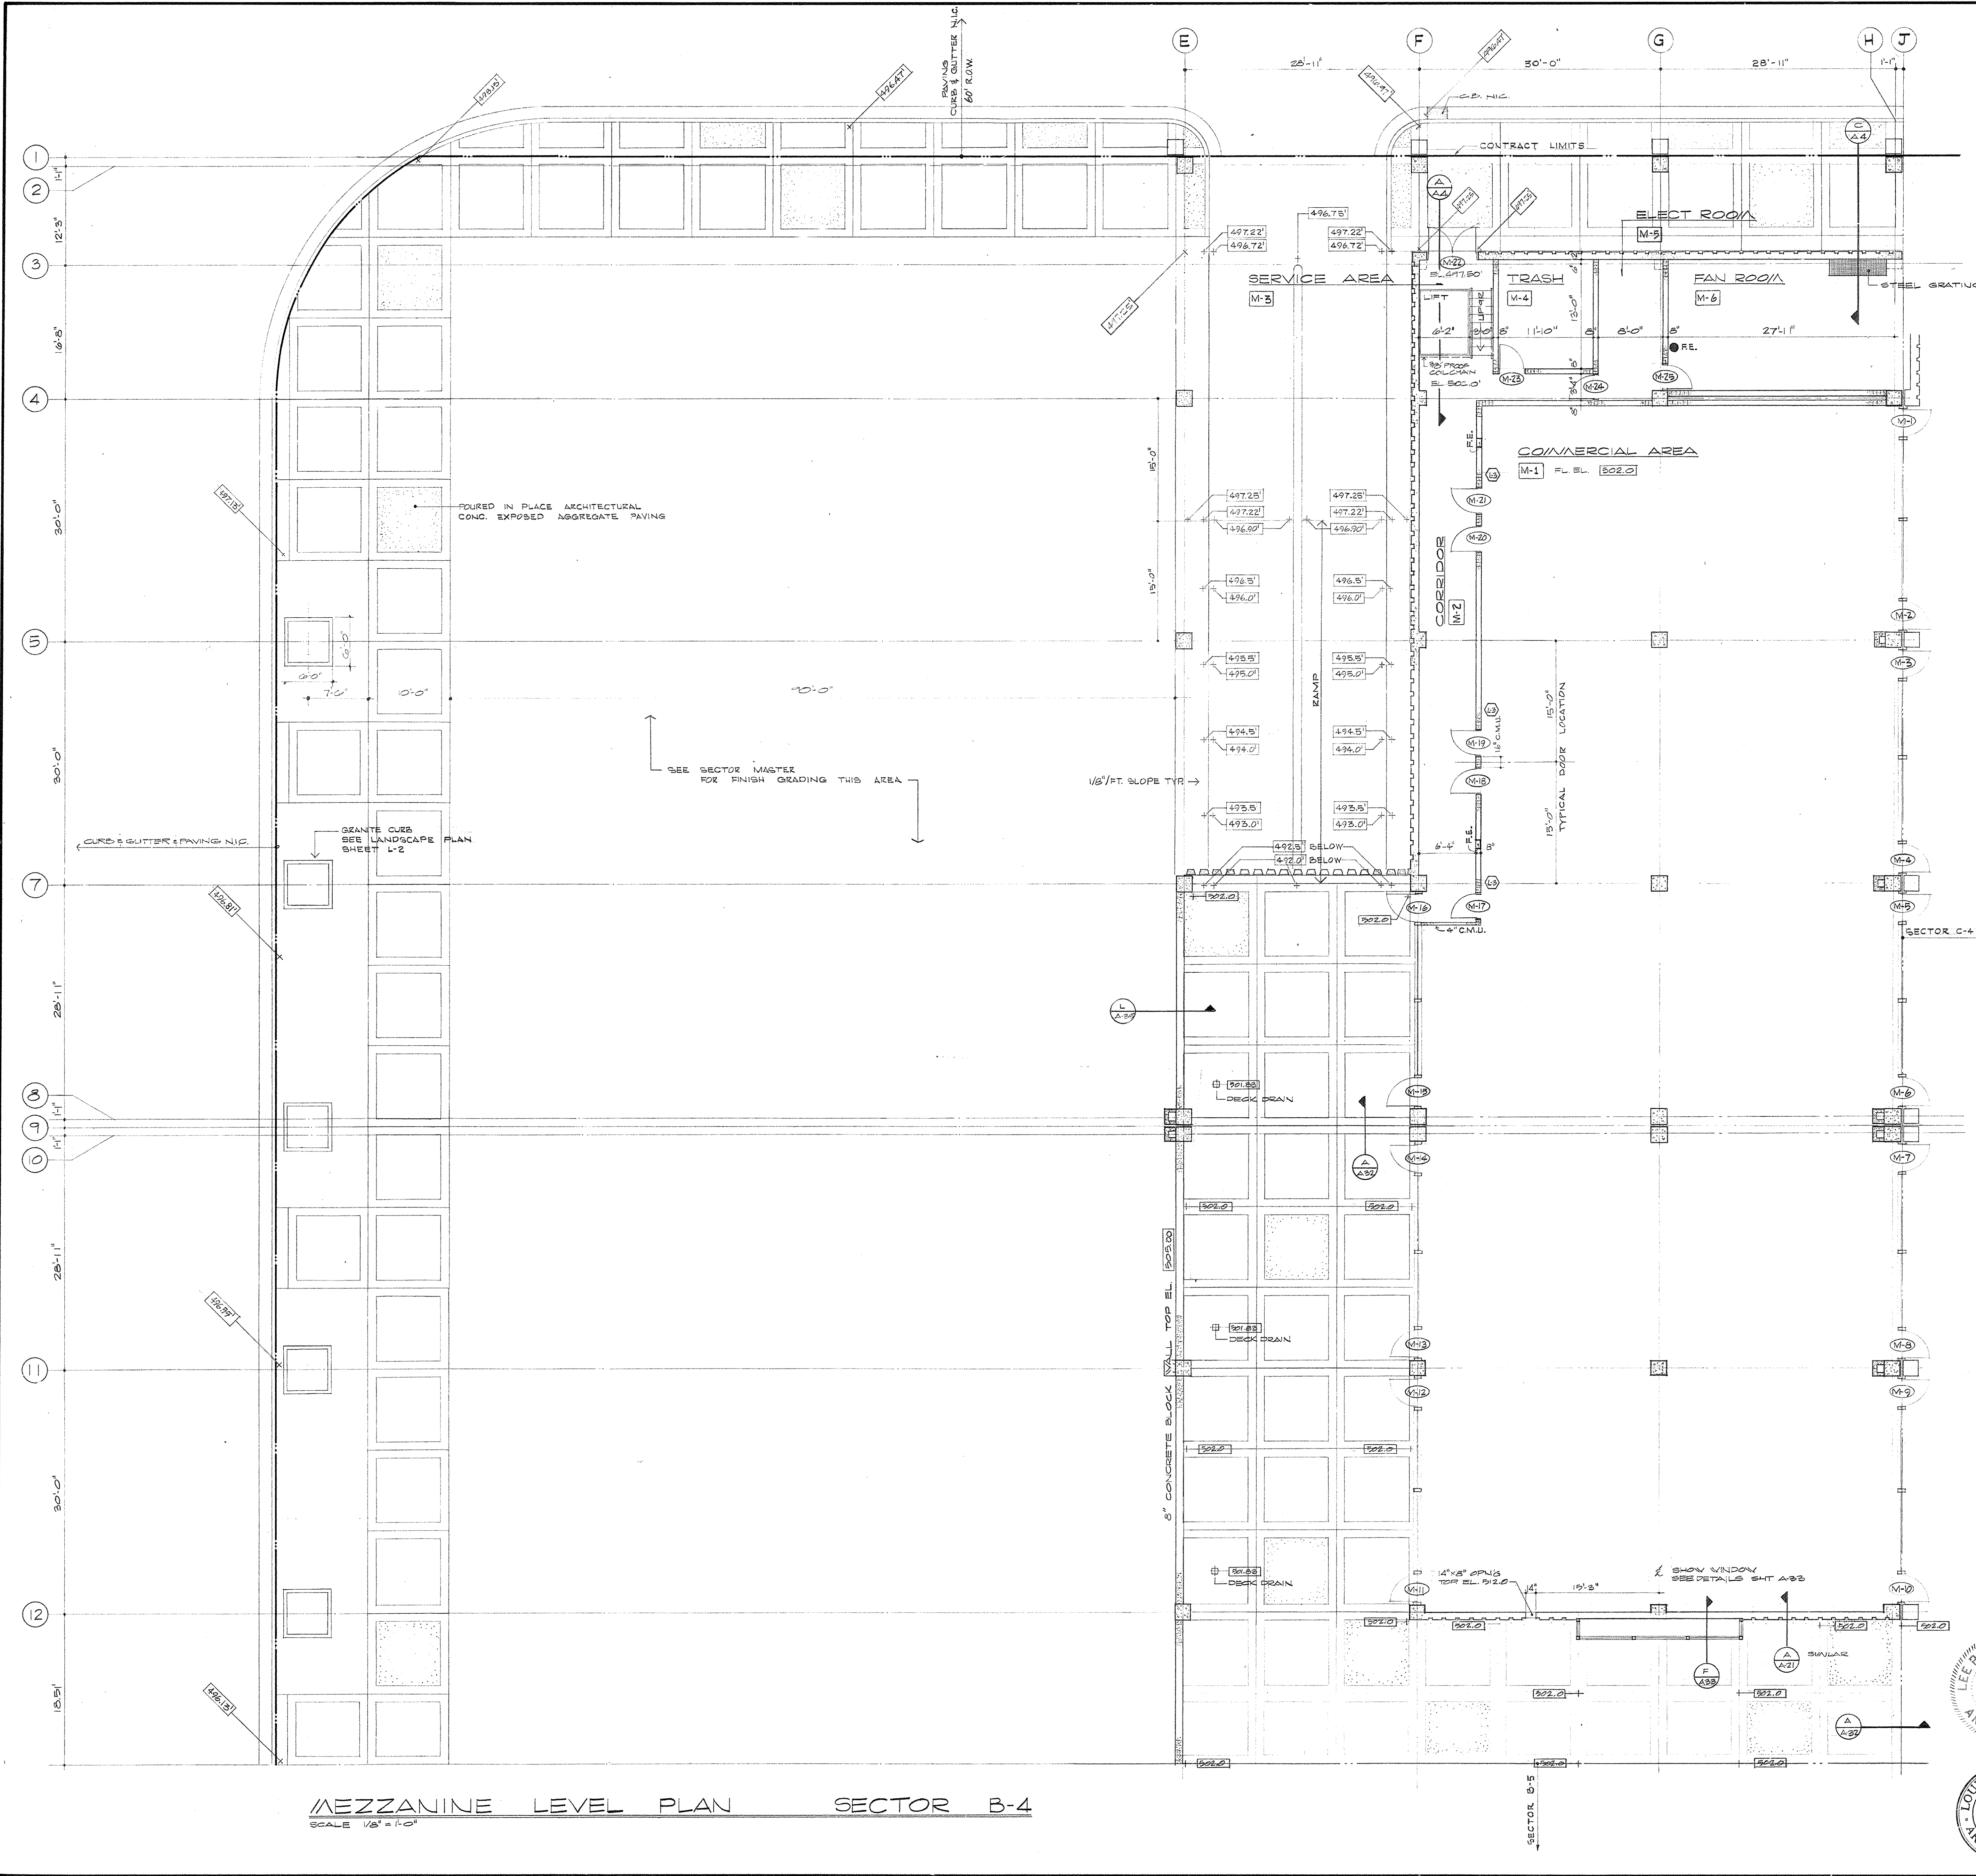



MEZZANINE LEVEL PLAN SECTOR B-4
SCALE 1/8" = 1'-0"

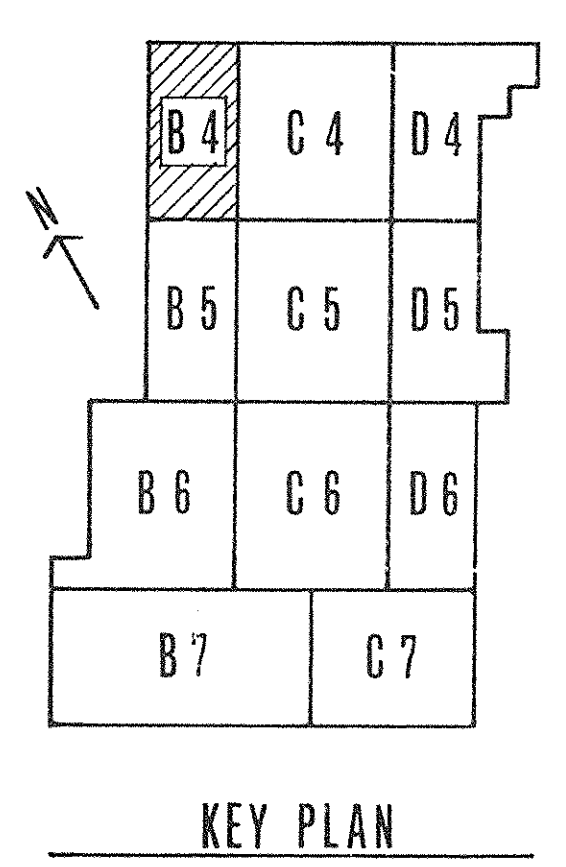

AS BUILT REVISIONS - 6-21-72


CAPITAL PLAZA DEVELOPMENT PHASE II		
FRANKFORT, KENTUCKY		
DRAWN BY J.S.	MEZZANINE LEVEL PLAN	DATE 10 OCT. 1967
CHECKED BY L.R.		COMM. NO. 50367
SECTOR NO. B 4	LEE POTTER SMITH, FRITCHETT, HUGG & CARTER ARCHITECTS 314 WILKINSON STREET FRANKFORT, KENTUCKY	DRAWING NO. A 15
	COMMONWEALTH OF KENTUCKY DEPARTMENT OF FINANCE - DIVISION OF ENGINEERING FRANKFORT	OF A. 42
APPROVED BY [Signature]	AGENCY HEAD	DATE 10-7-67
APPROVED BY [Signature]	OWNER	

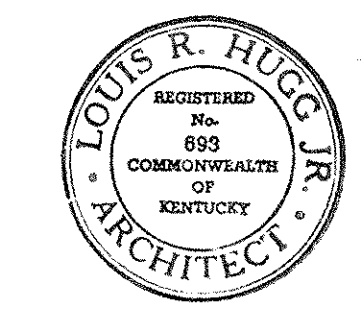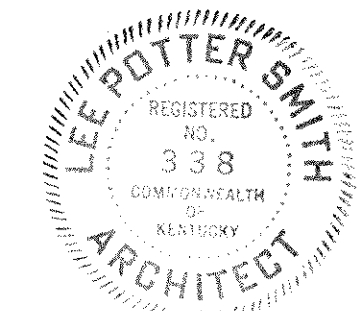

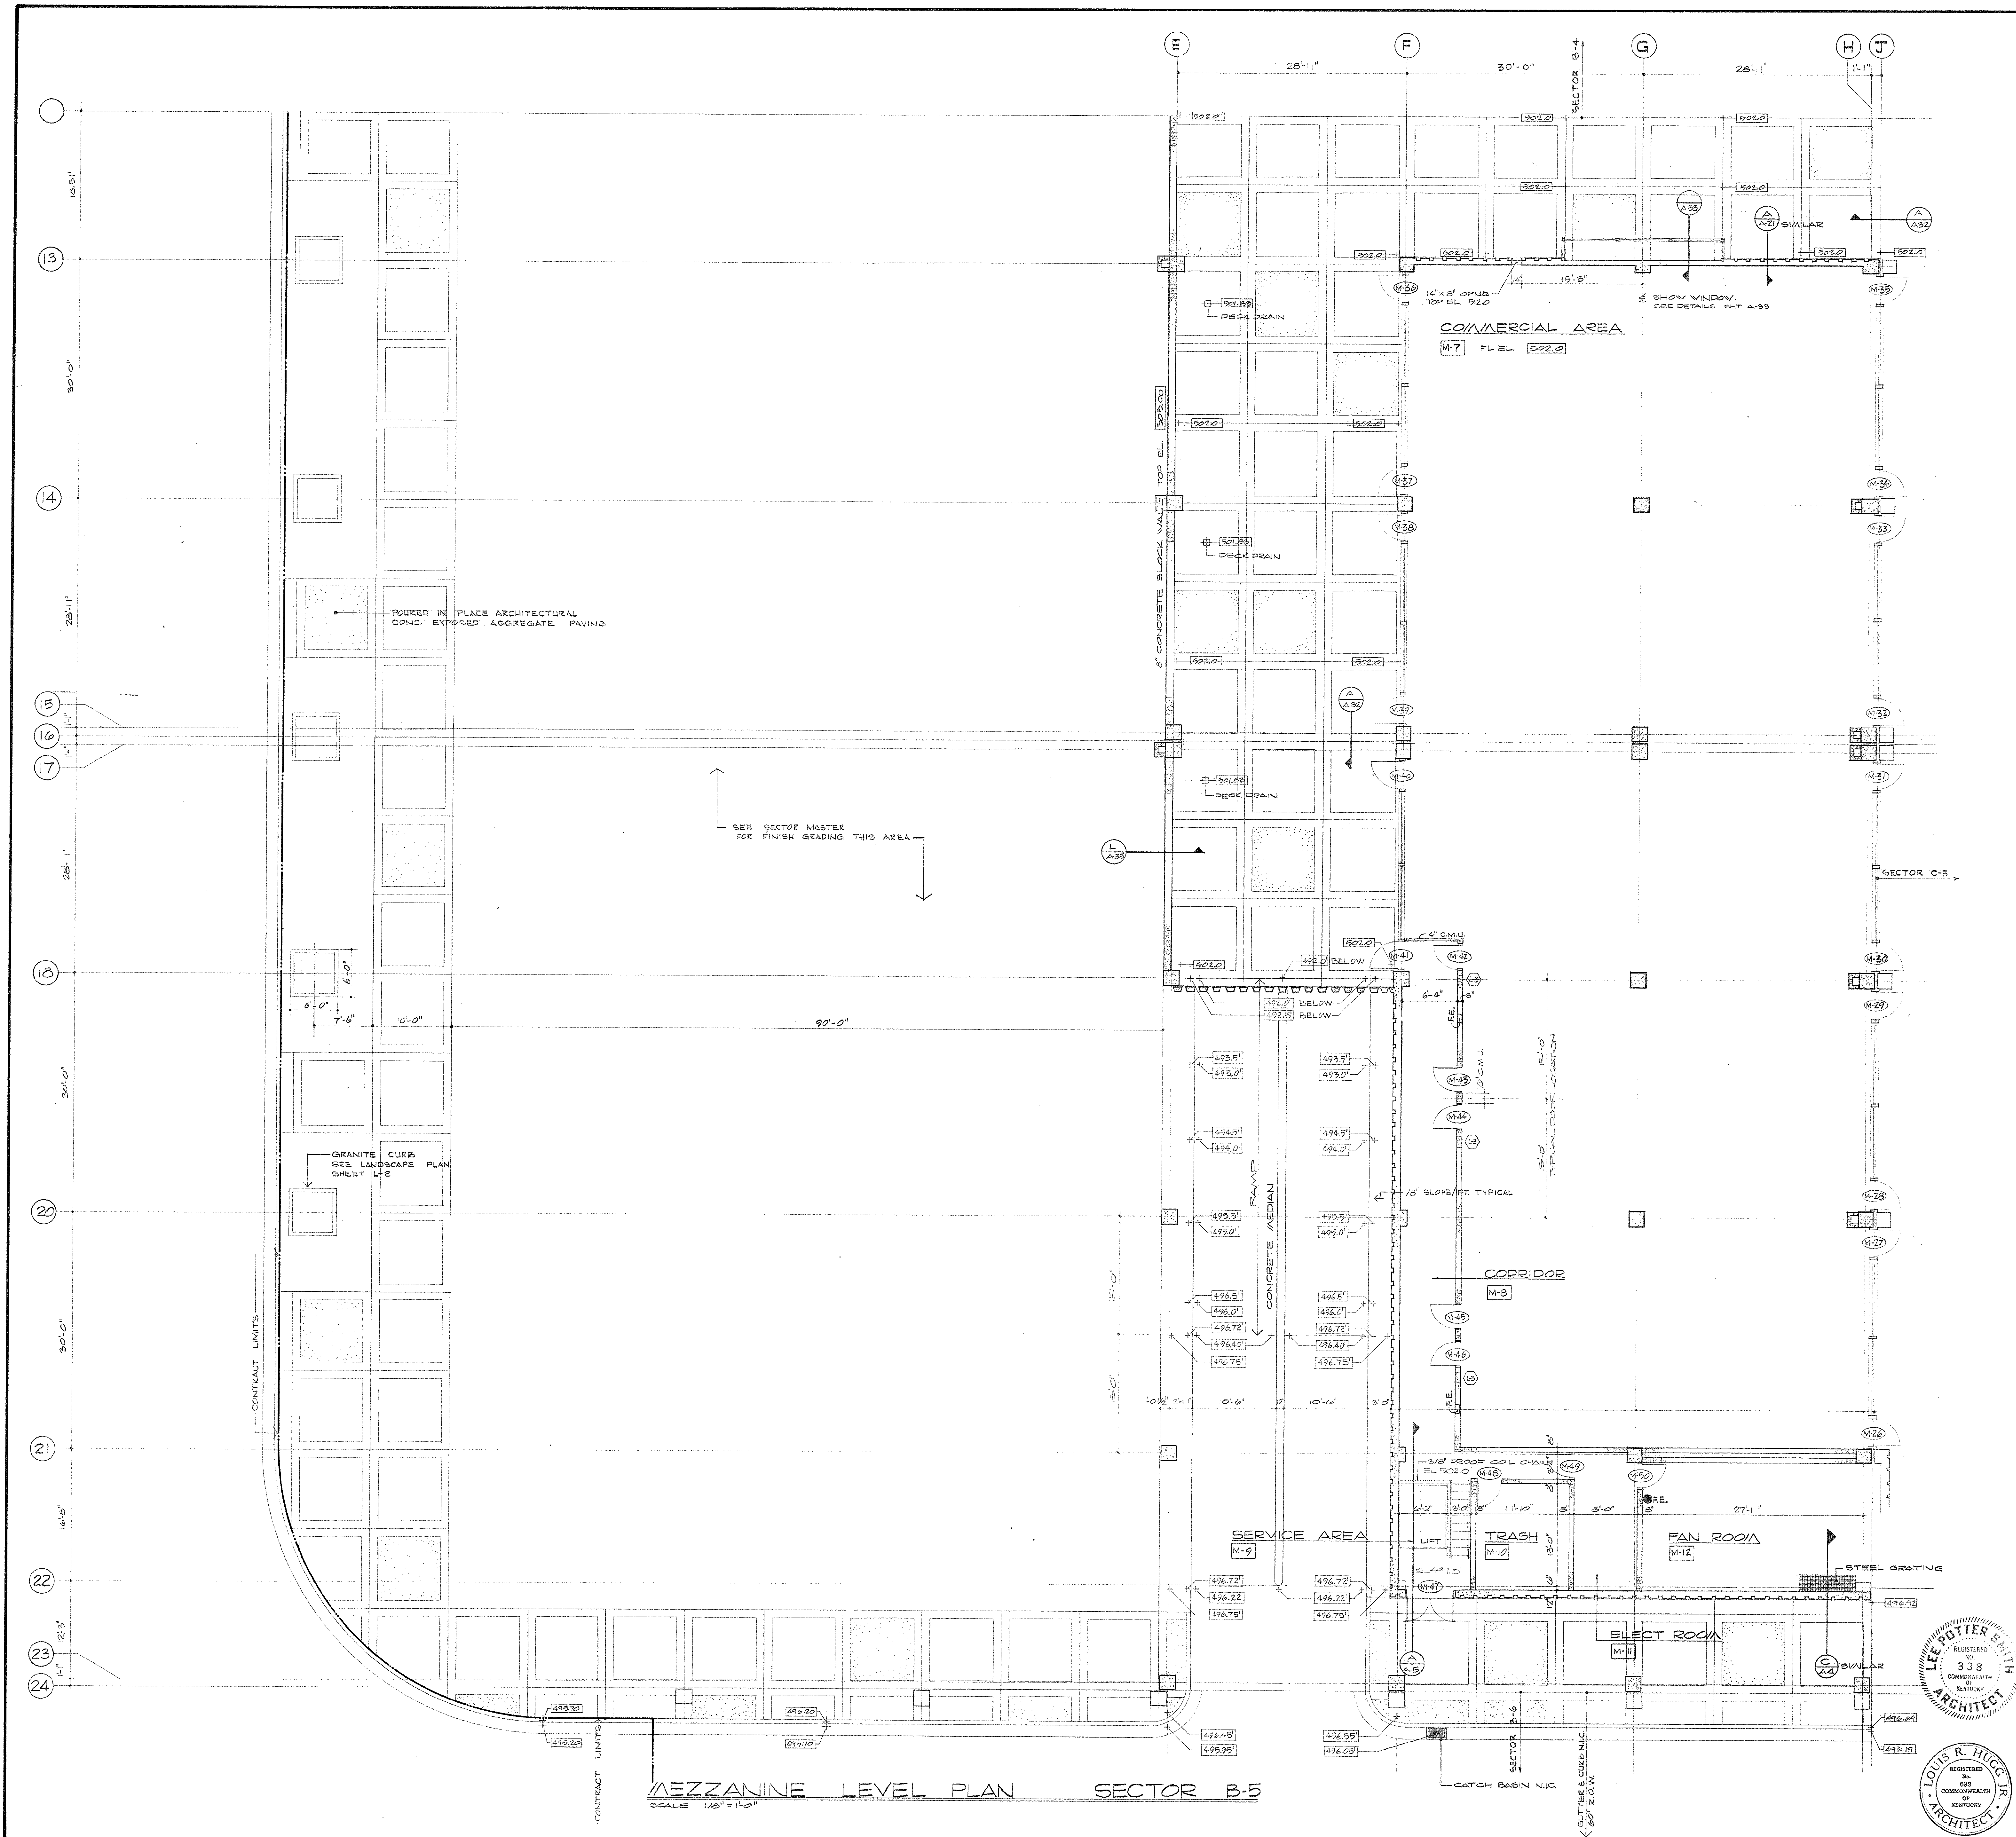



MEZZANINE LEVEL PLAN SECTOR B-5
SCALE 1/8" = 1'-0"

AS BUILT REVISIONS - 8-22-72

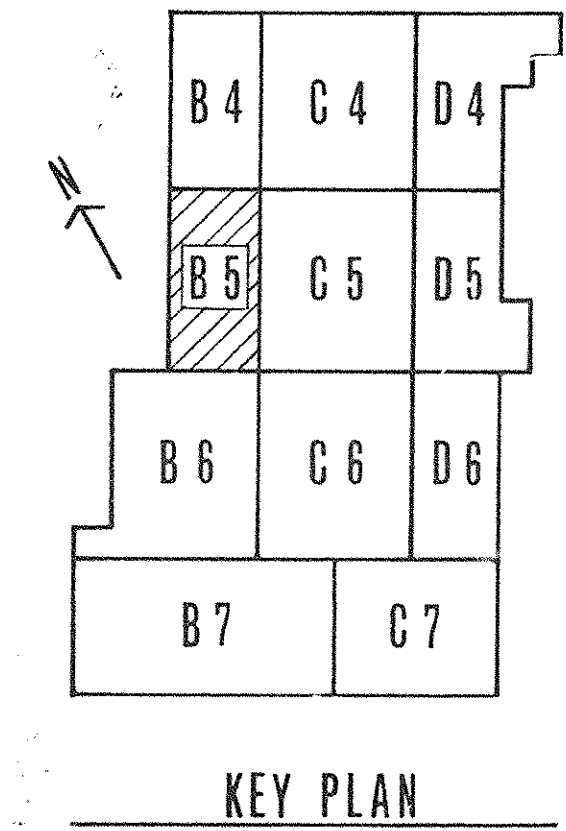


CAPITAL PLAZA DEVELOPMENT PHASE II			
FRANKFORT, KENTUCKY			
DRAWN BY J.P.	CHECKED BY L.R.H.	DATE 10 OCT. 1967	COMM. NO. 50367
SECTOR NO. B 5		ENGINEERS LEE POTTER SMITH, PRITCHETT, HUGG & CARTER 314 WILKINSON STREET FRANKFORT, KENTUCKY	DRAWING NO. A 16
APPROVED BY OWNER		APPROVED BY AGENCY HEAD <i>W. M. Connell</i>	DATE 10-26-67


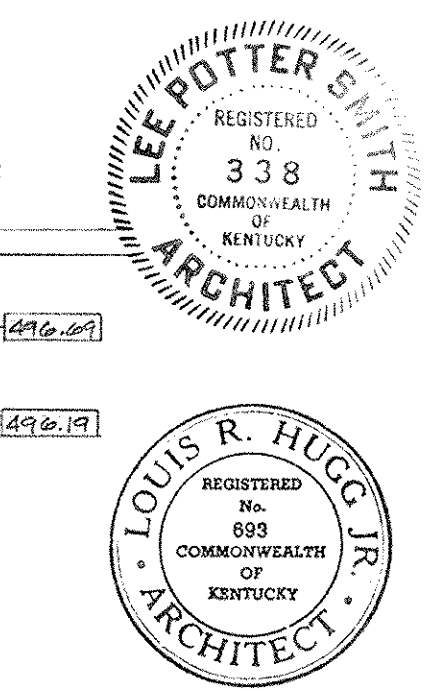


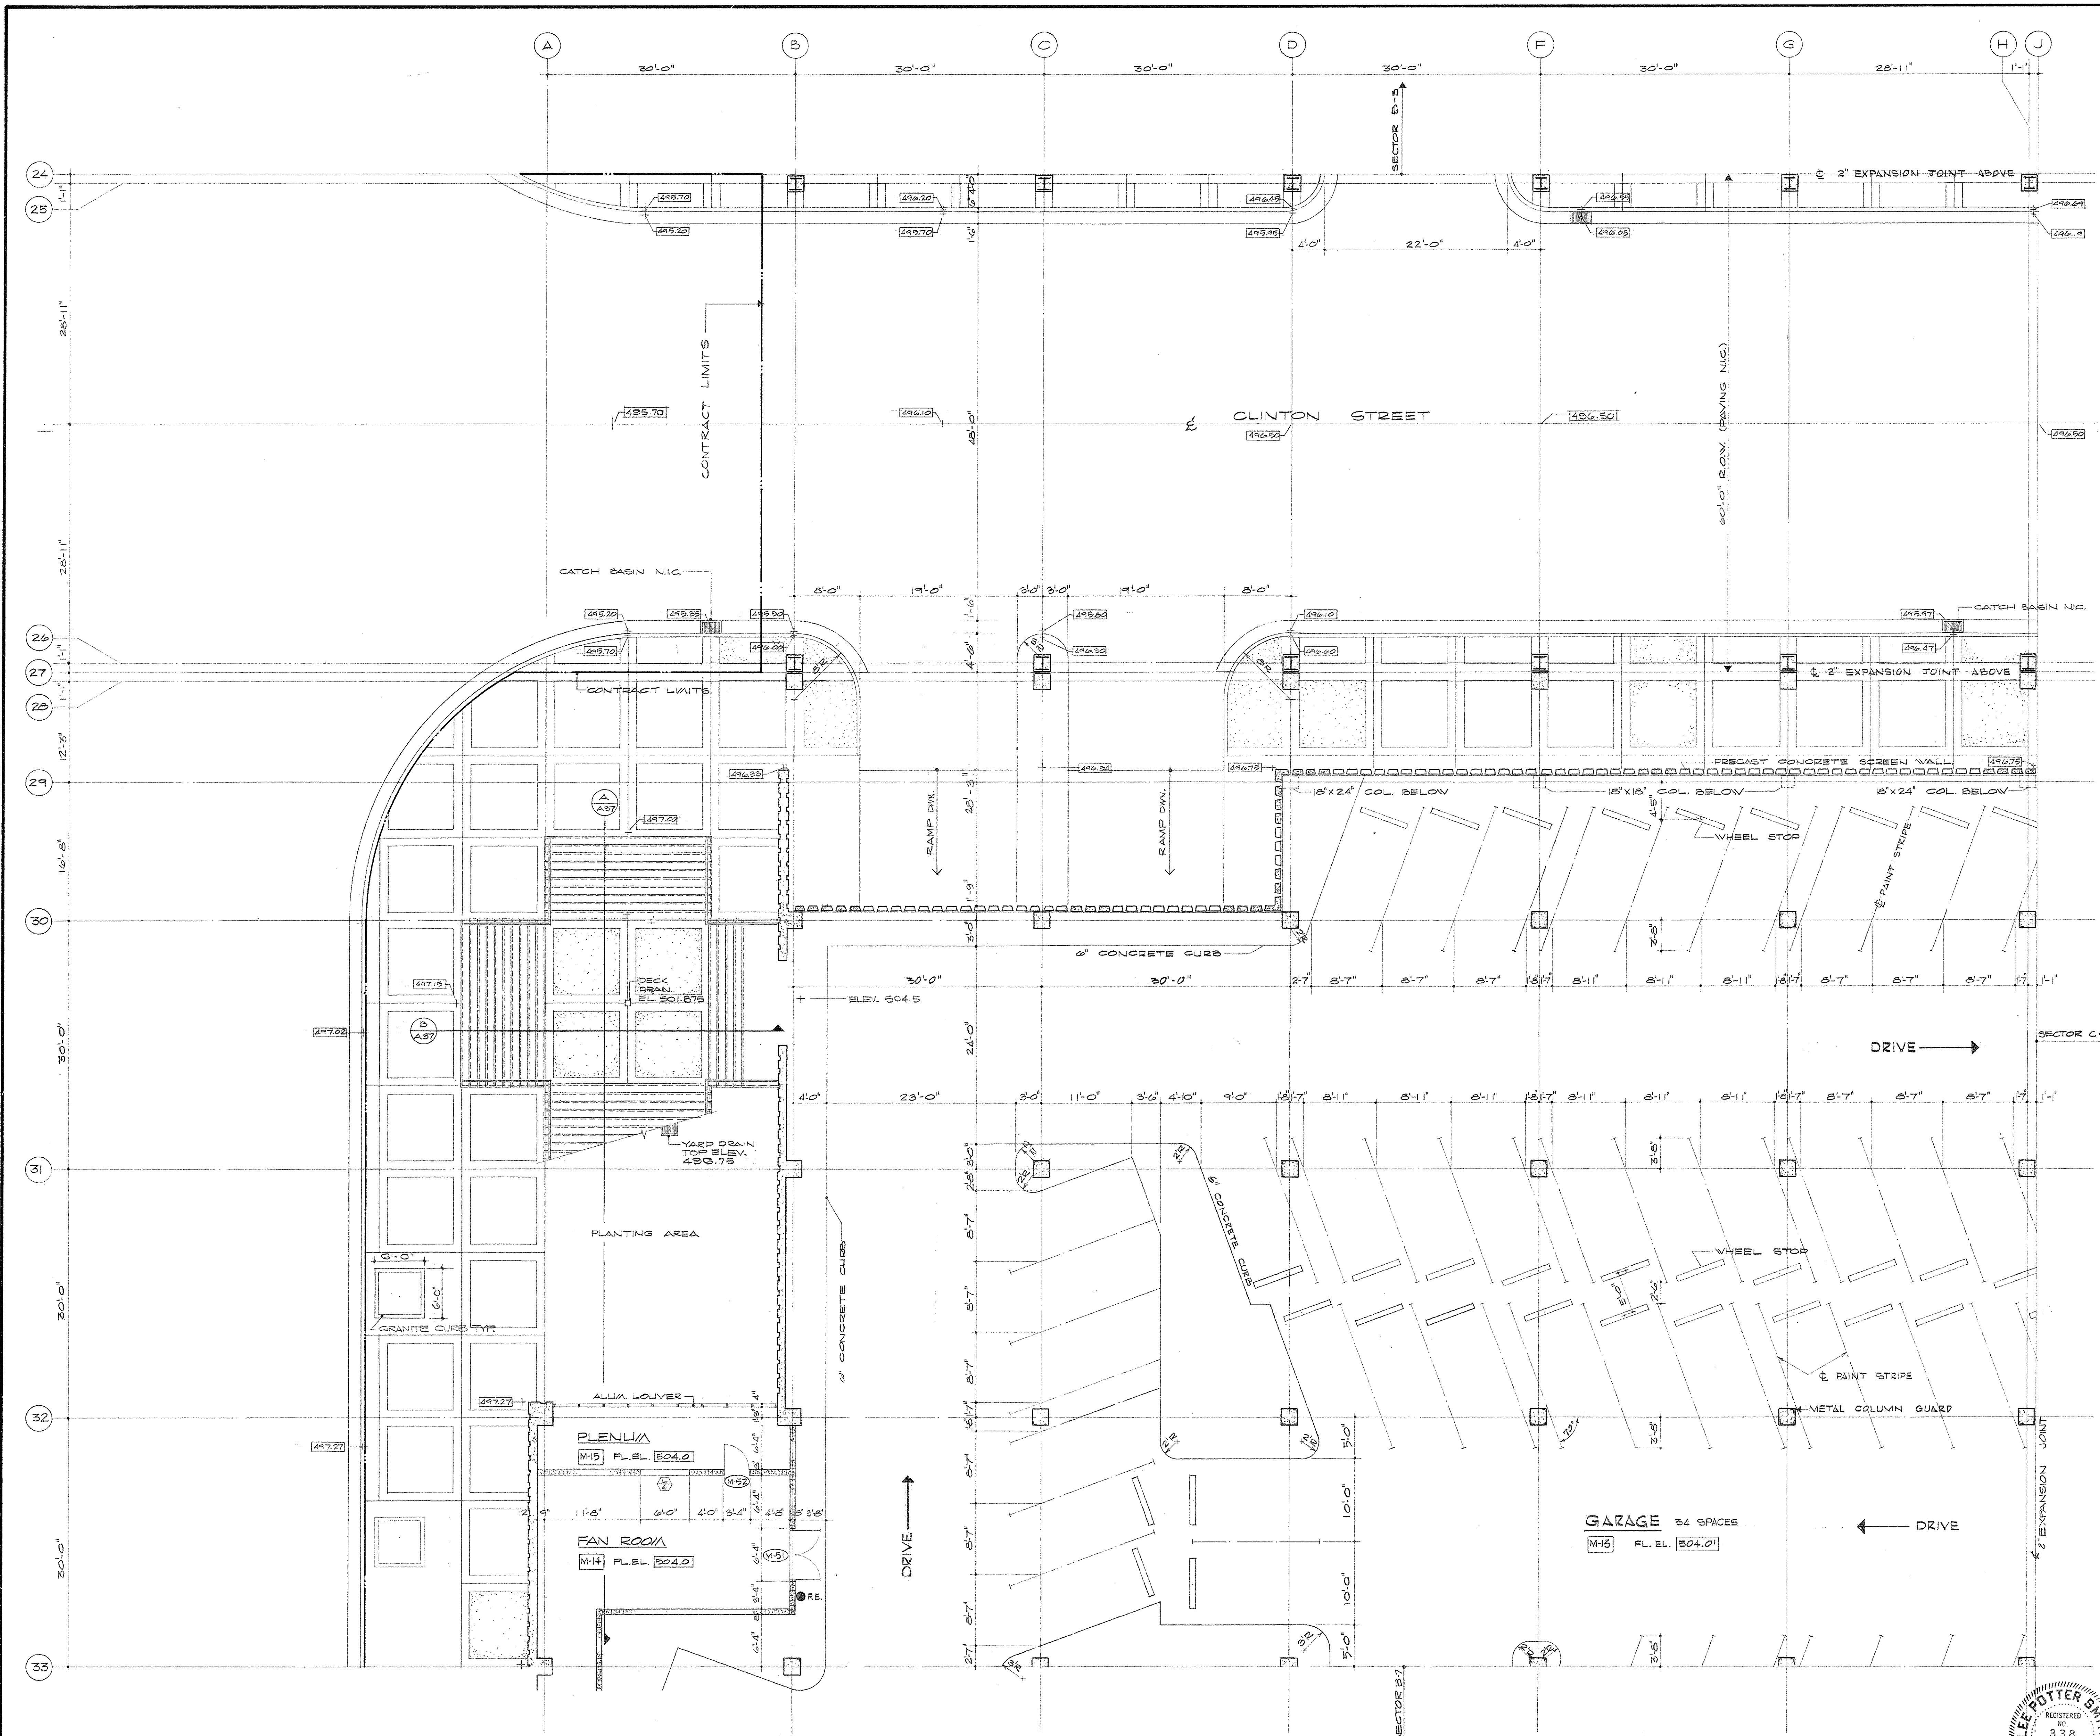


MEZZANINE LEVEL PLAN **SECTOR B-6**
 SCALE 1/8"=1'-0"
 NOTE *SYMBOL 'F.E.' INDICATES LOCATION OF CO² FIRE EXTINGUISHERS. SEE SPECS.

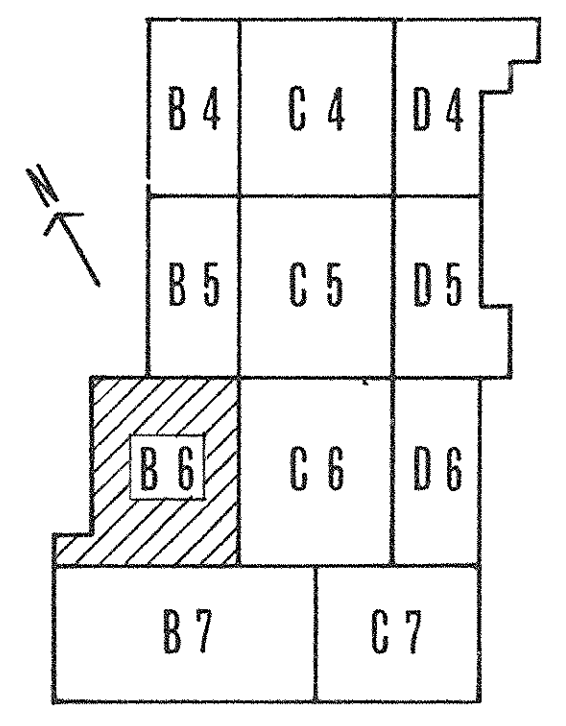


AS BUILT REVISIONS - 8-24-72

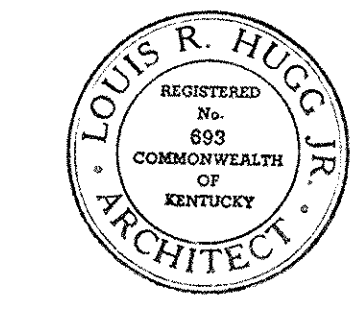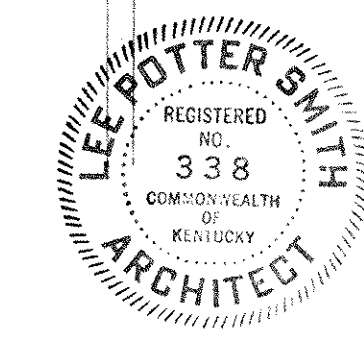


CAPITAL PLAZA DEVELOPMENT PHASE II			
FRANKFORT, KENTUCKY			
DRAWN BY J.B. & N.H.	MEZZANINE LEVEL PLAN	DATE OCT. 1967	COMM. NO. 50367
CHECKED BY L.P.H.	LEE POTTER SMITH, PRITCHETT, HUGG & CARTER ARCHITECTS 114 WILKINSON STREET FRANKFORT, KENTUCKY	ENGINEERS	DRAWING NO.
SECTOR NO. B 6	COMMONWEALTH OF KENTUCKY DEPARTMENT OF FINANCE - DIVISION OF ENGINEERING FRANKFORT	A 17	OF A. 42
APPROVED BY AGENCY HEAD	<i>W. M. Leonard</i>	DATE 10-2-67	
APPROVED BY OWNER		DATE	

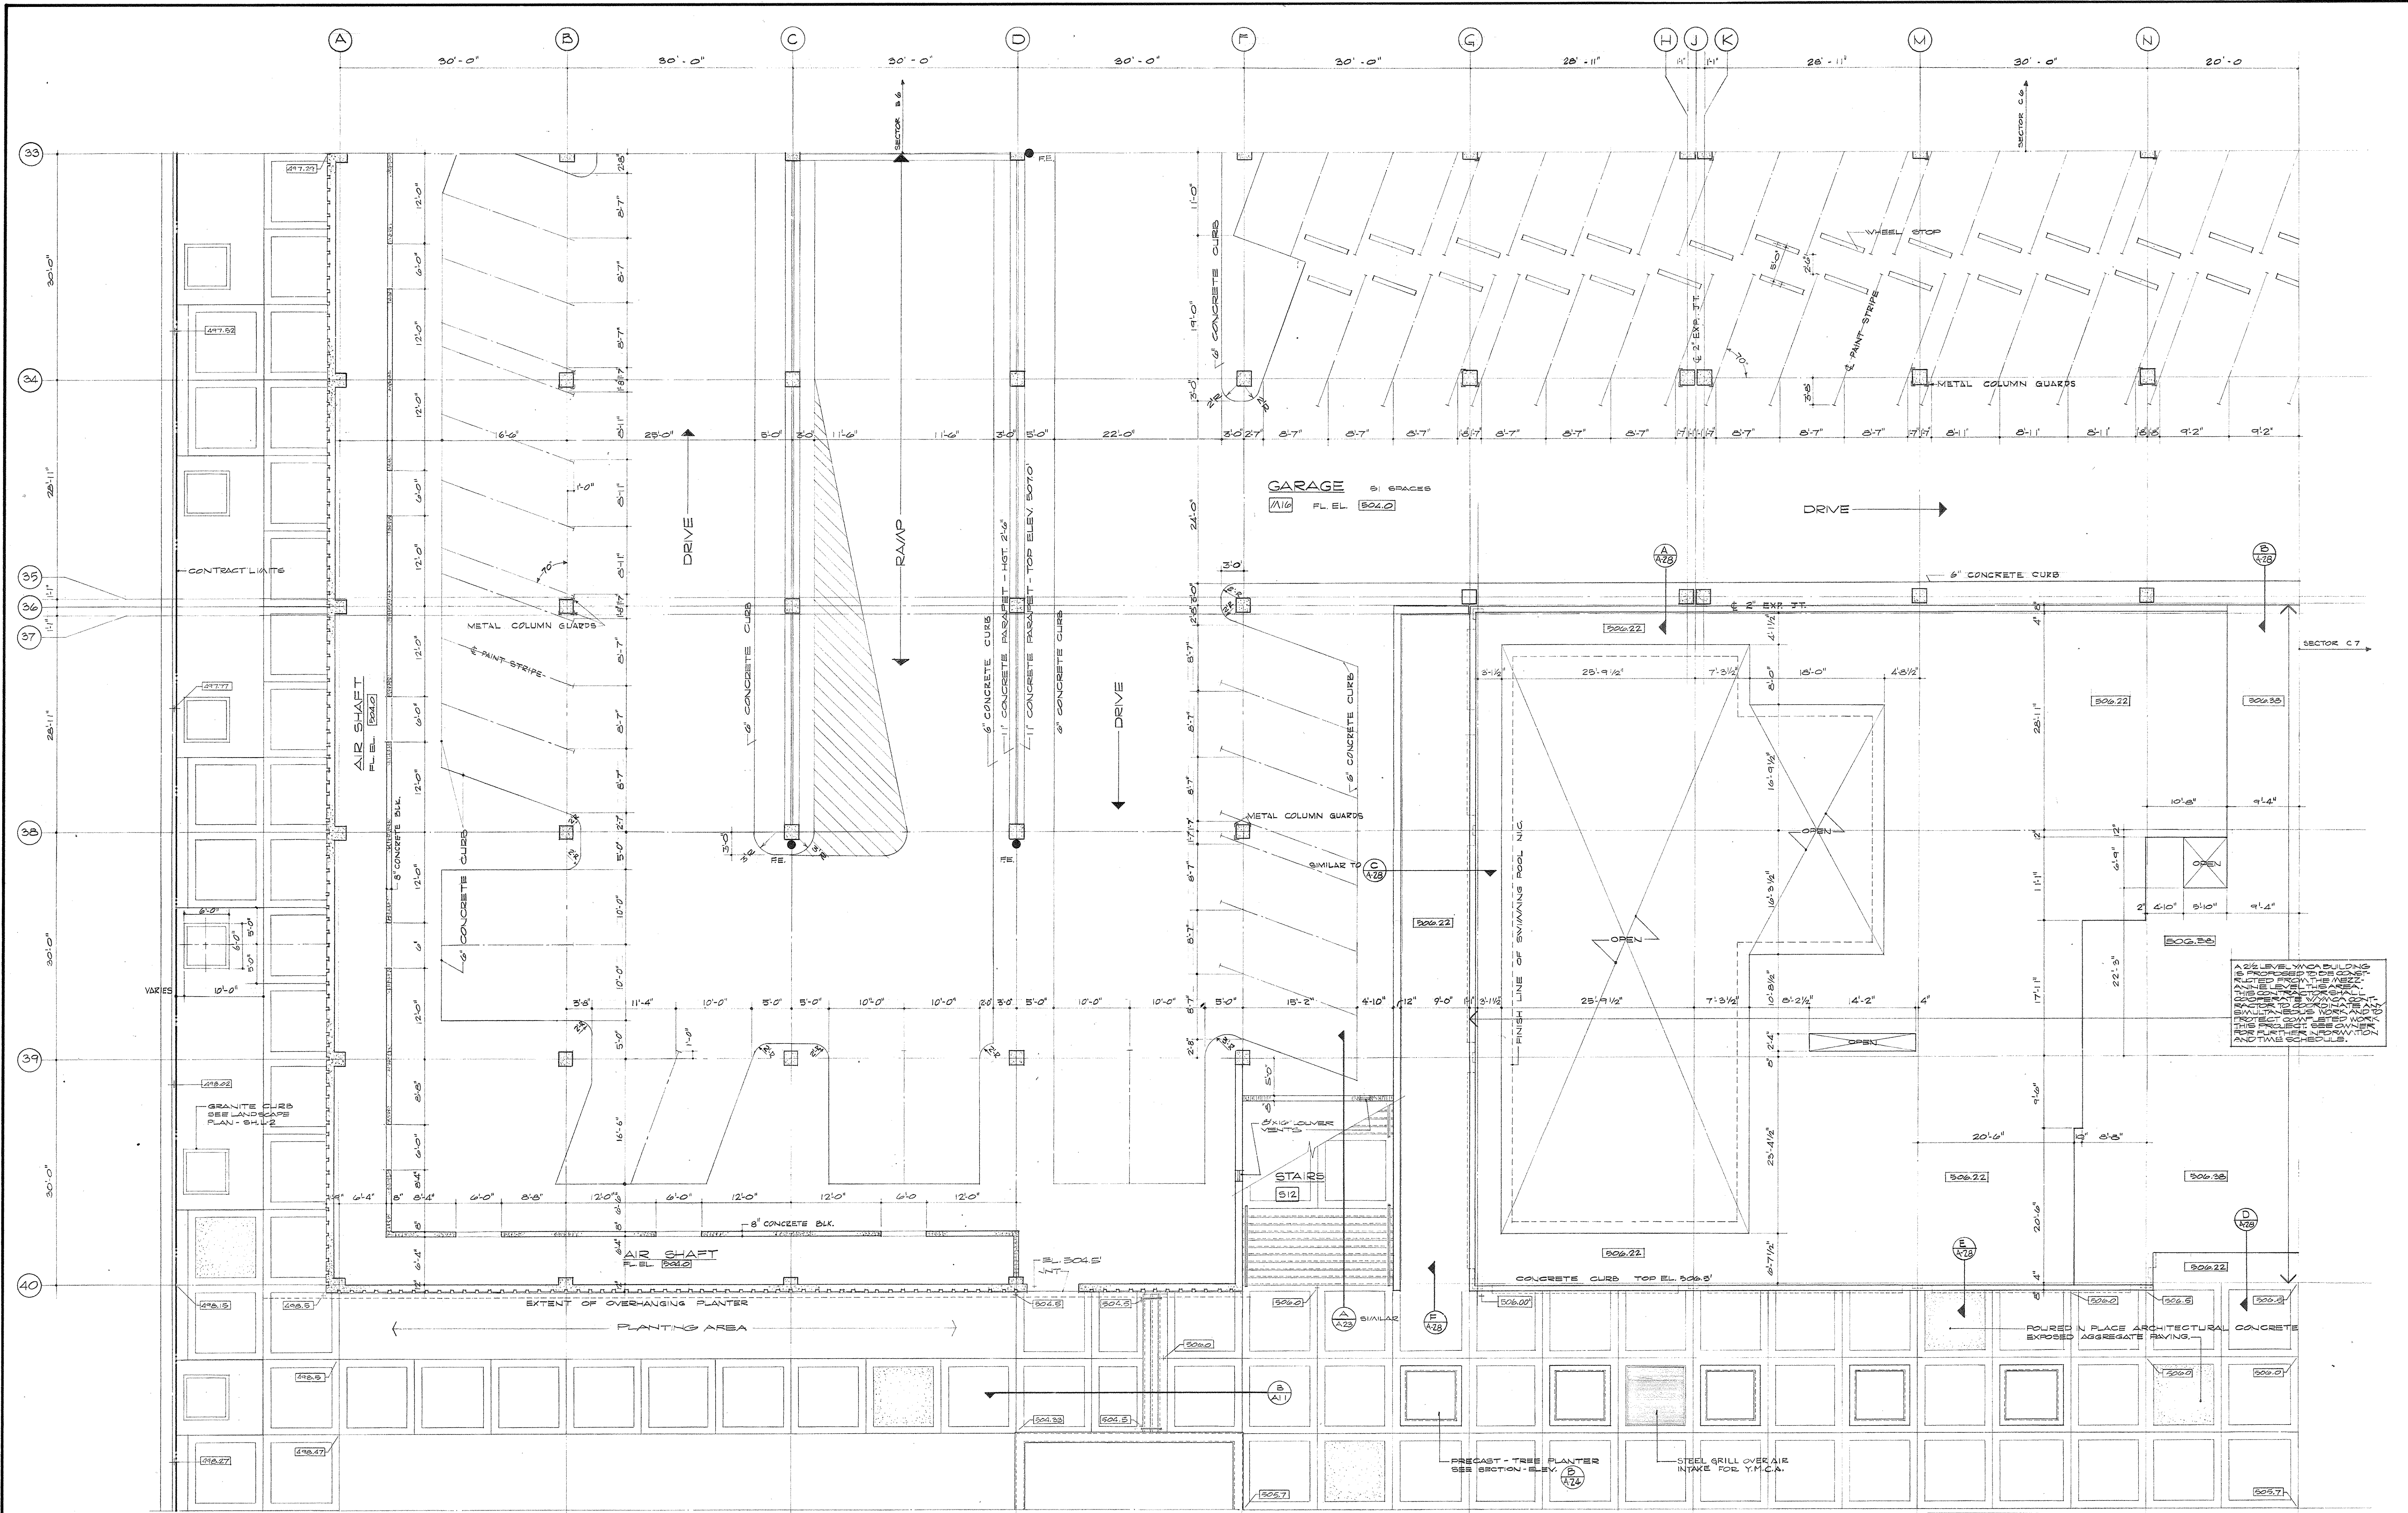


MEZZANINE LEVEL PLAN SECTOR B-7
SCALE 1/8" = 1'-0"

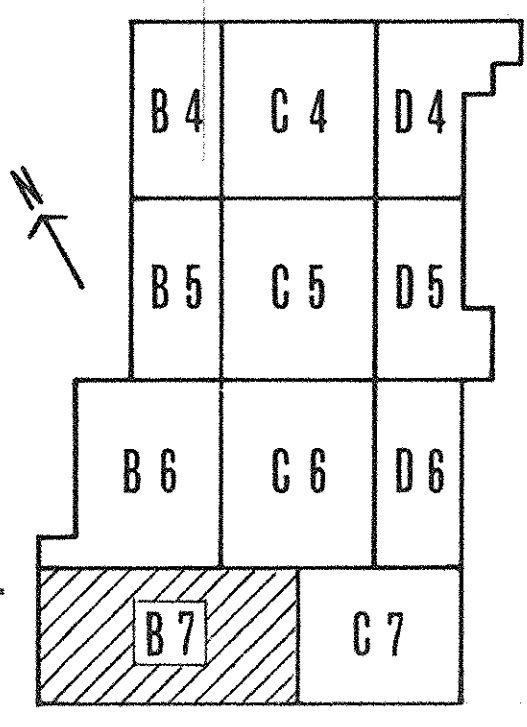


AS BUILT REVISIONS 8-23-72
KEY PLAN

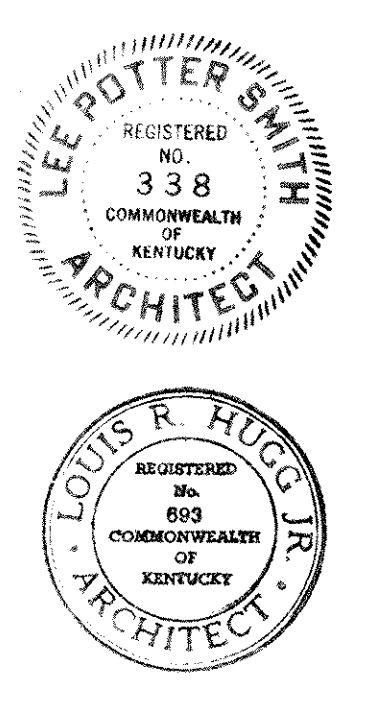


CAPITAL PLAZA DEVELOPMENT PHASE II FRANKFORT, KENTUCKY		
DRAWN BY J.P.	MEZZANINE LEVEL PLAN	DATE 18 OCT. 1967
CHECKED BY L.R.H.		COM. NO. 50367
SECTOR NO. B 7	LEE POTTER SMITH, PRITCHETT, HUGG & CARTER ARCHITECTS 314 WILKINSON STREET FRANKFORT, KENTUCKY	DRAWING NO. A 18
APPROVED BY OWNER <i>W. M. Connell</i>	COMMONWEALTH OF KENTUCKY DEPARTMENT OF FINANCE - DIVISION OF ENGINEERING FRANKFORT, KENTUCKY	DATE 10-26-67

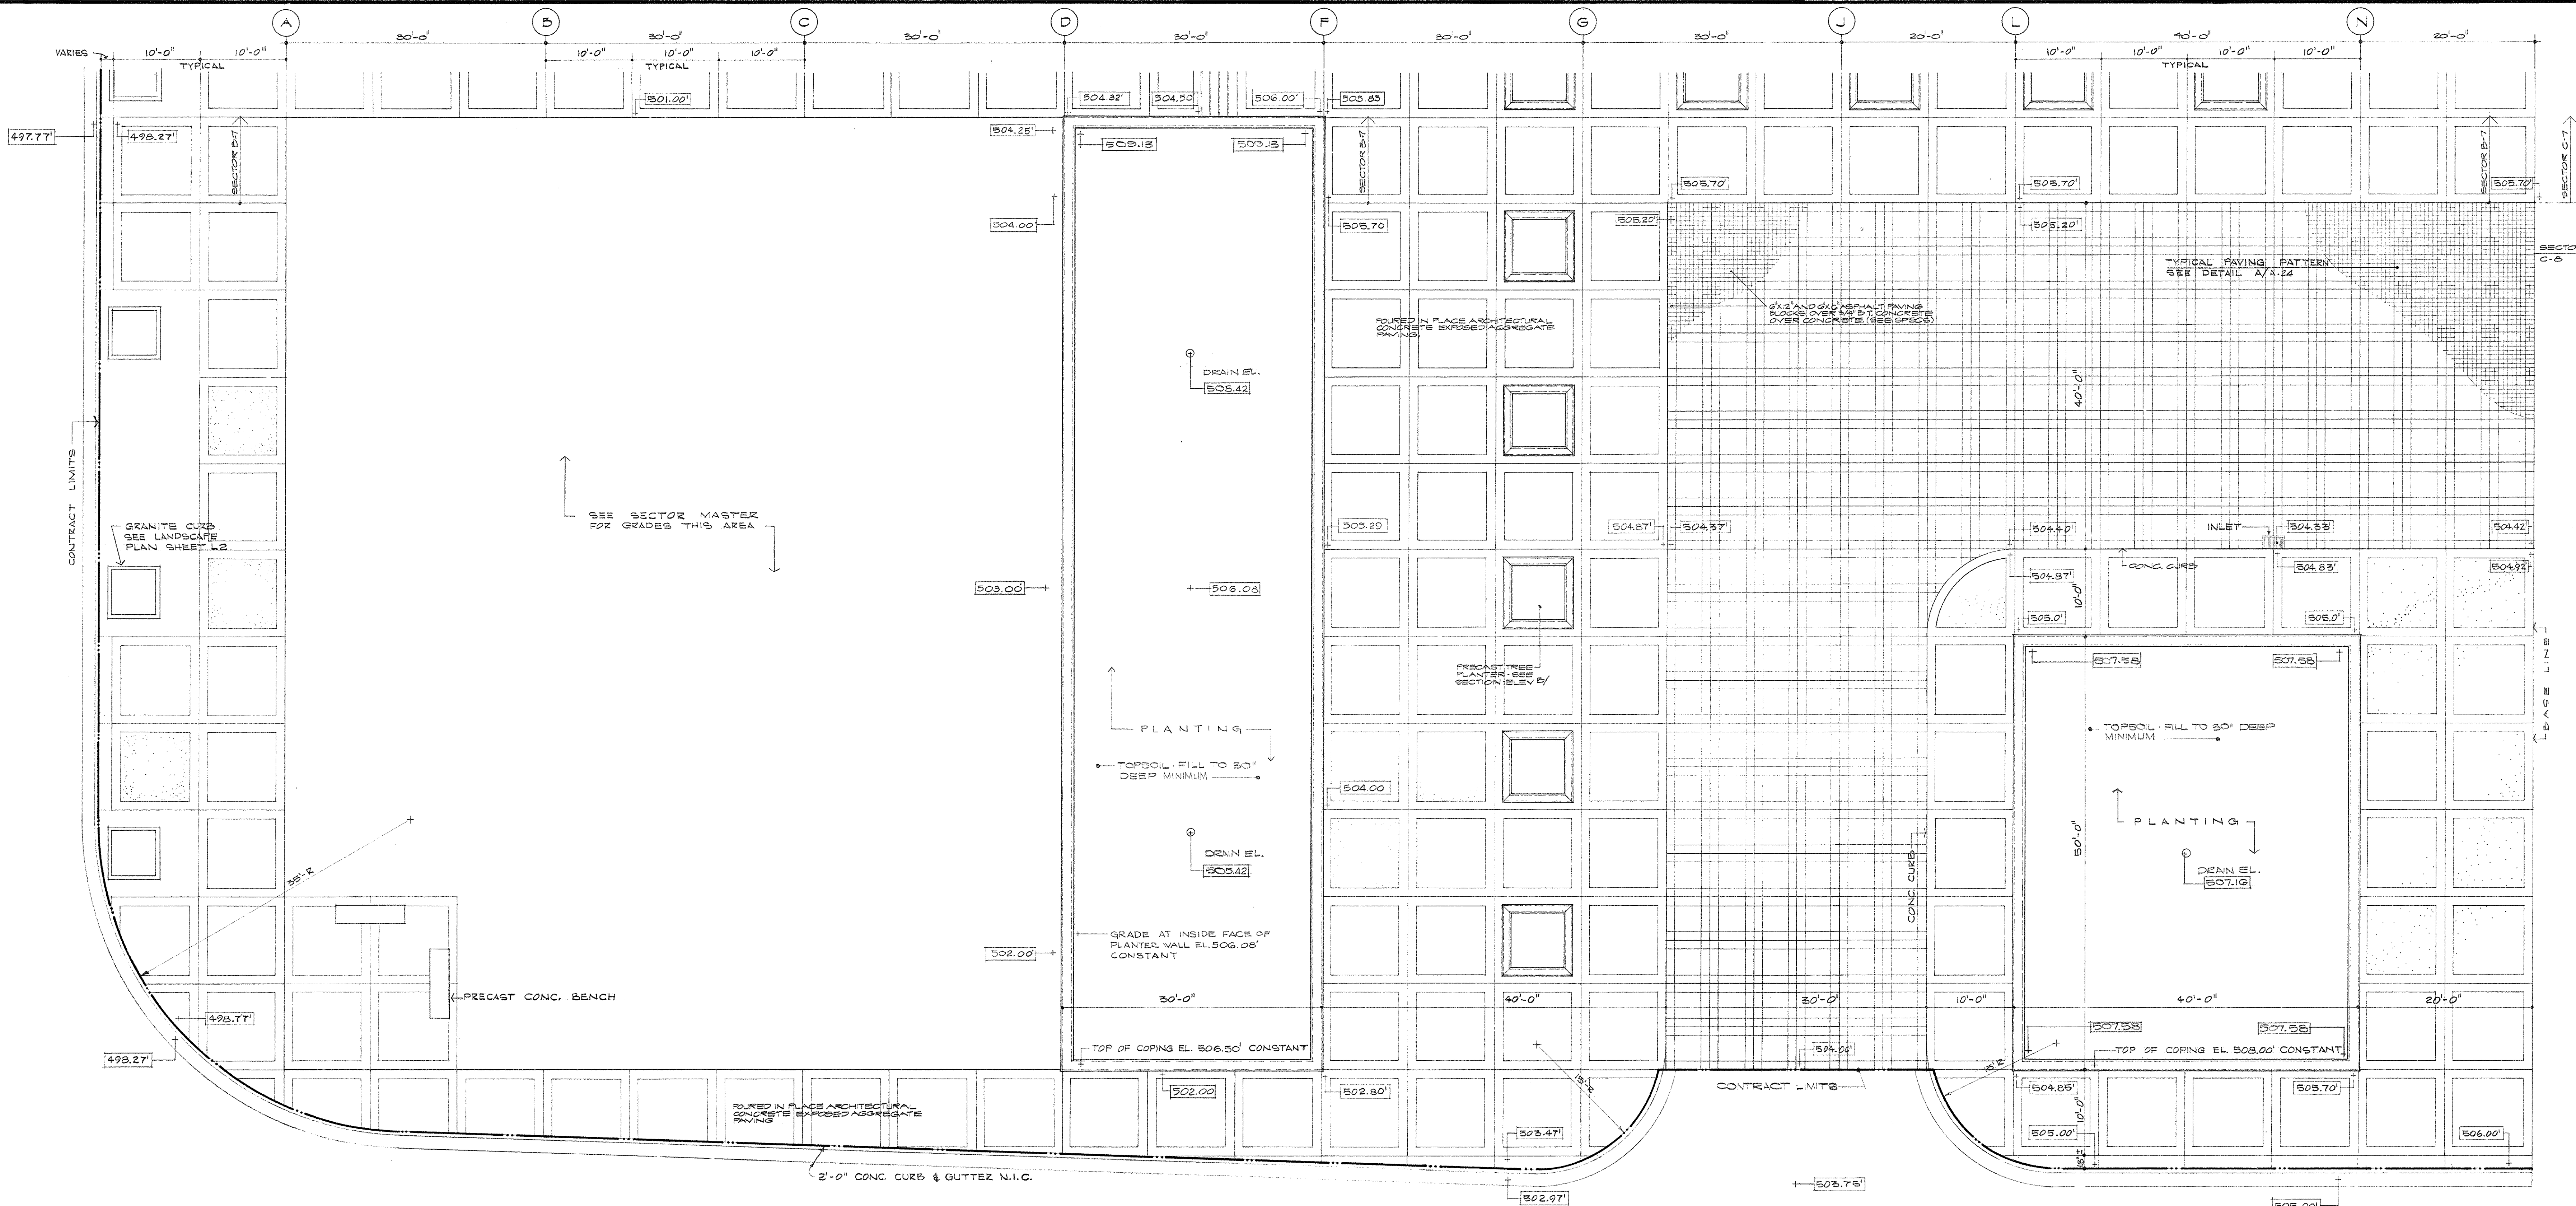


BROADWAY

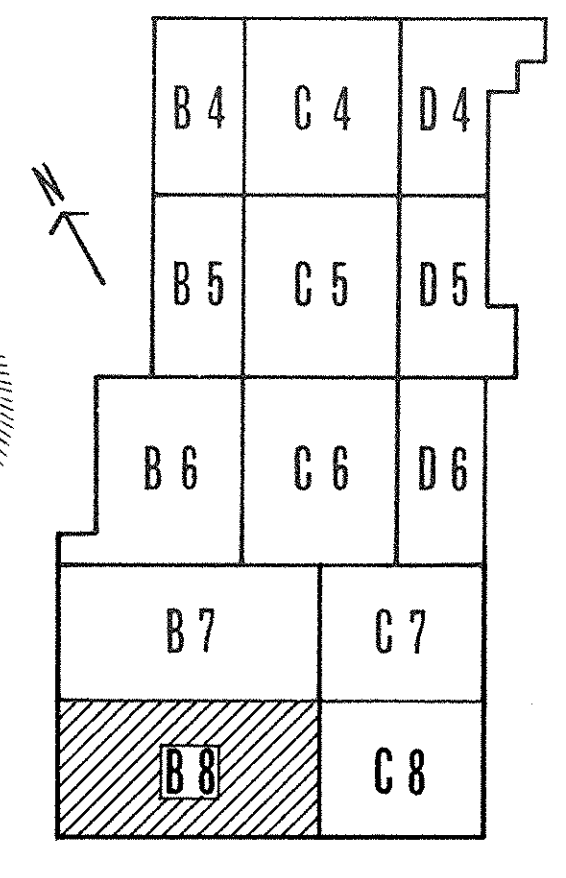


AS BUILT REVISIONS : 8-23-72

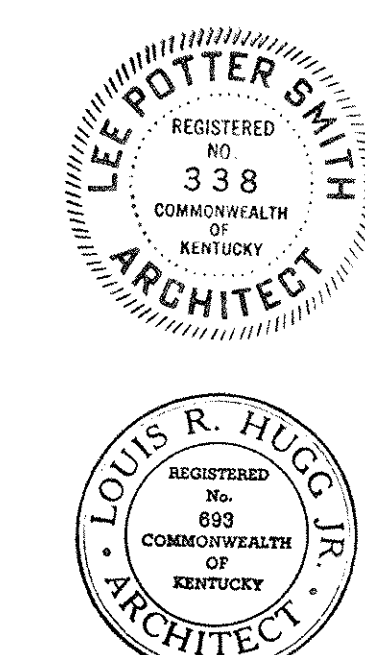


CAPITAL PLAZA DEVELOPMENT PHASE II		
FRANKFORT, KENTUCKY		
DRAWN BY LD/MLH	MEZZANINE LEVEL PLAN	DATE 10-25-72
CHECKED BY LRH		COMM. NO. 50367
SECTOR NO. B 8	LEE POTTER SMITH, PRITCHETT, HUGG & CARTER ARCHITECTS 314 WILKINSON STREET FRANKFORT, KENTUCKY	DRAWING NO. A 19 OF 1-42
APPROVED BY AGENCY HEAD	COMMONWEALTH OF KENTUCKY DEPARTMENT OF FINANCE - DIVISION OF ENGINEERING FRANKFORT, KENTUCKY	DATE 10-24-72
APPROVED BY OWNER	<i>W. M. Connell</i>	

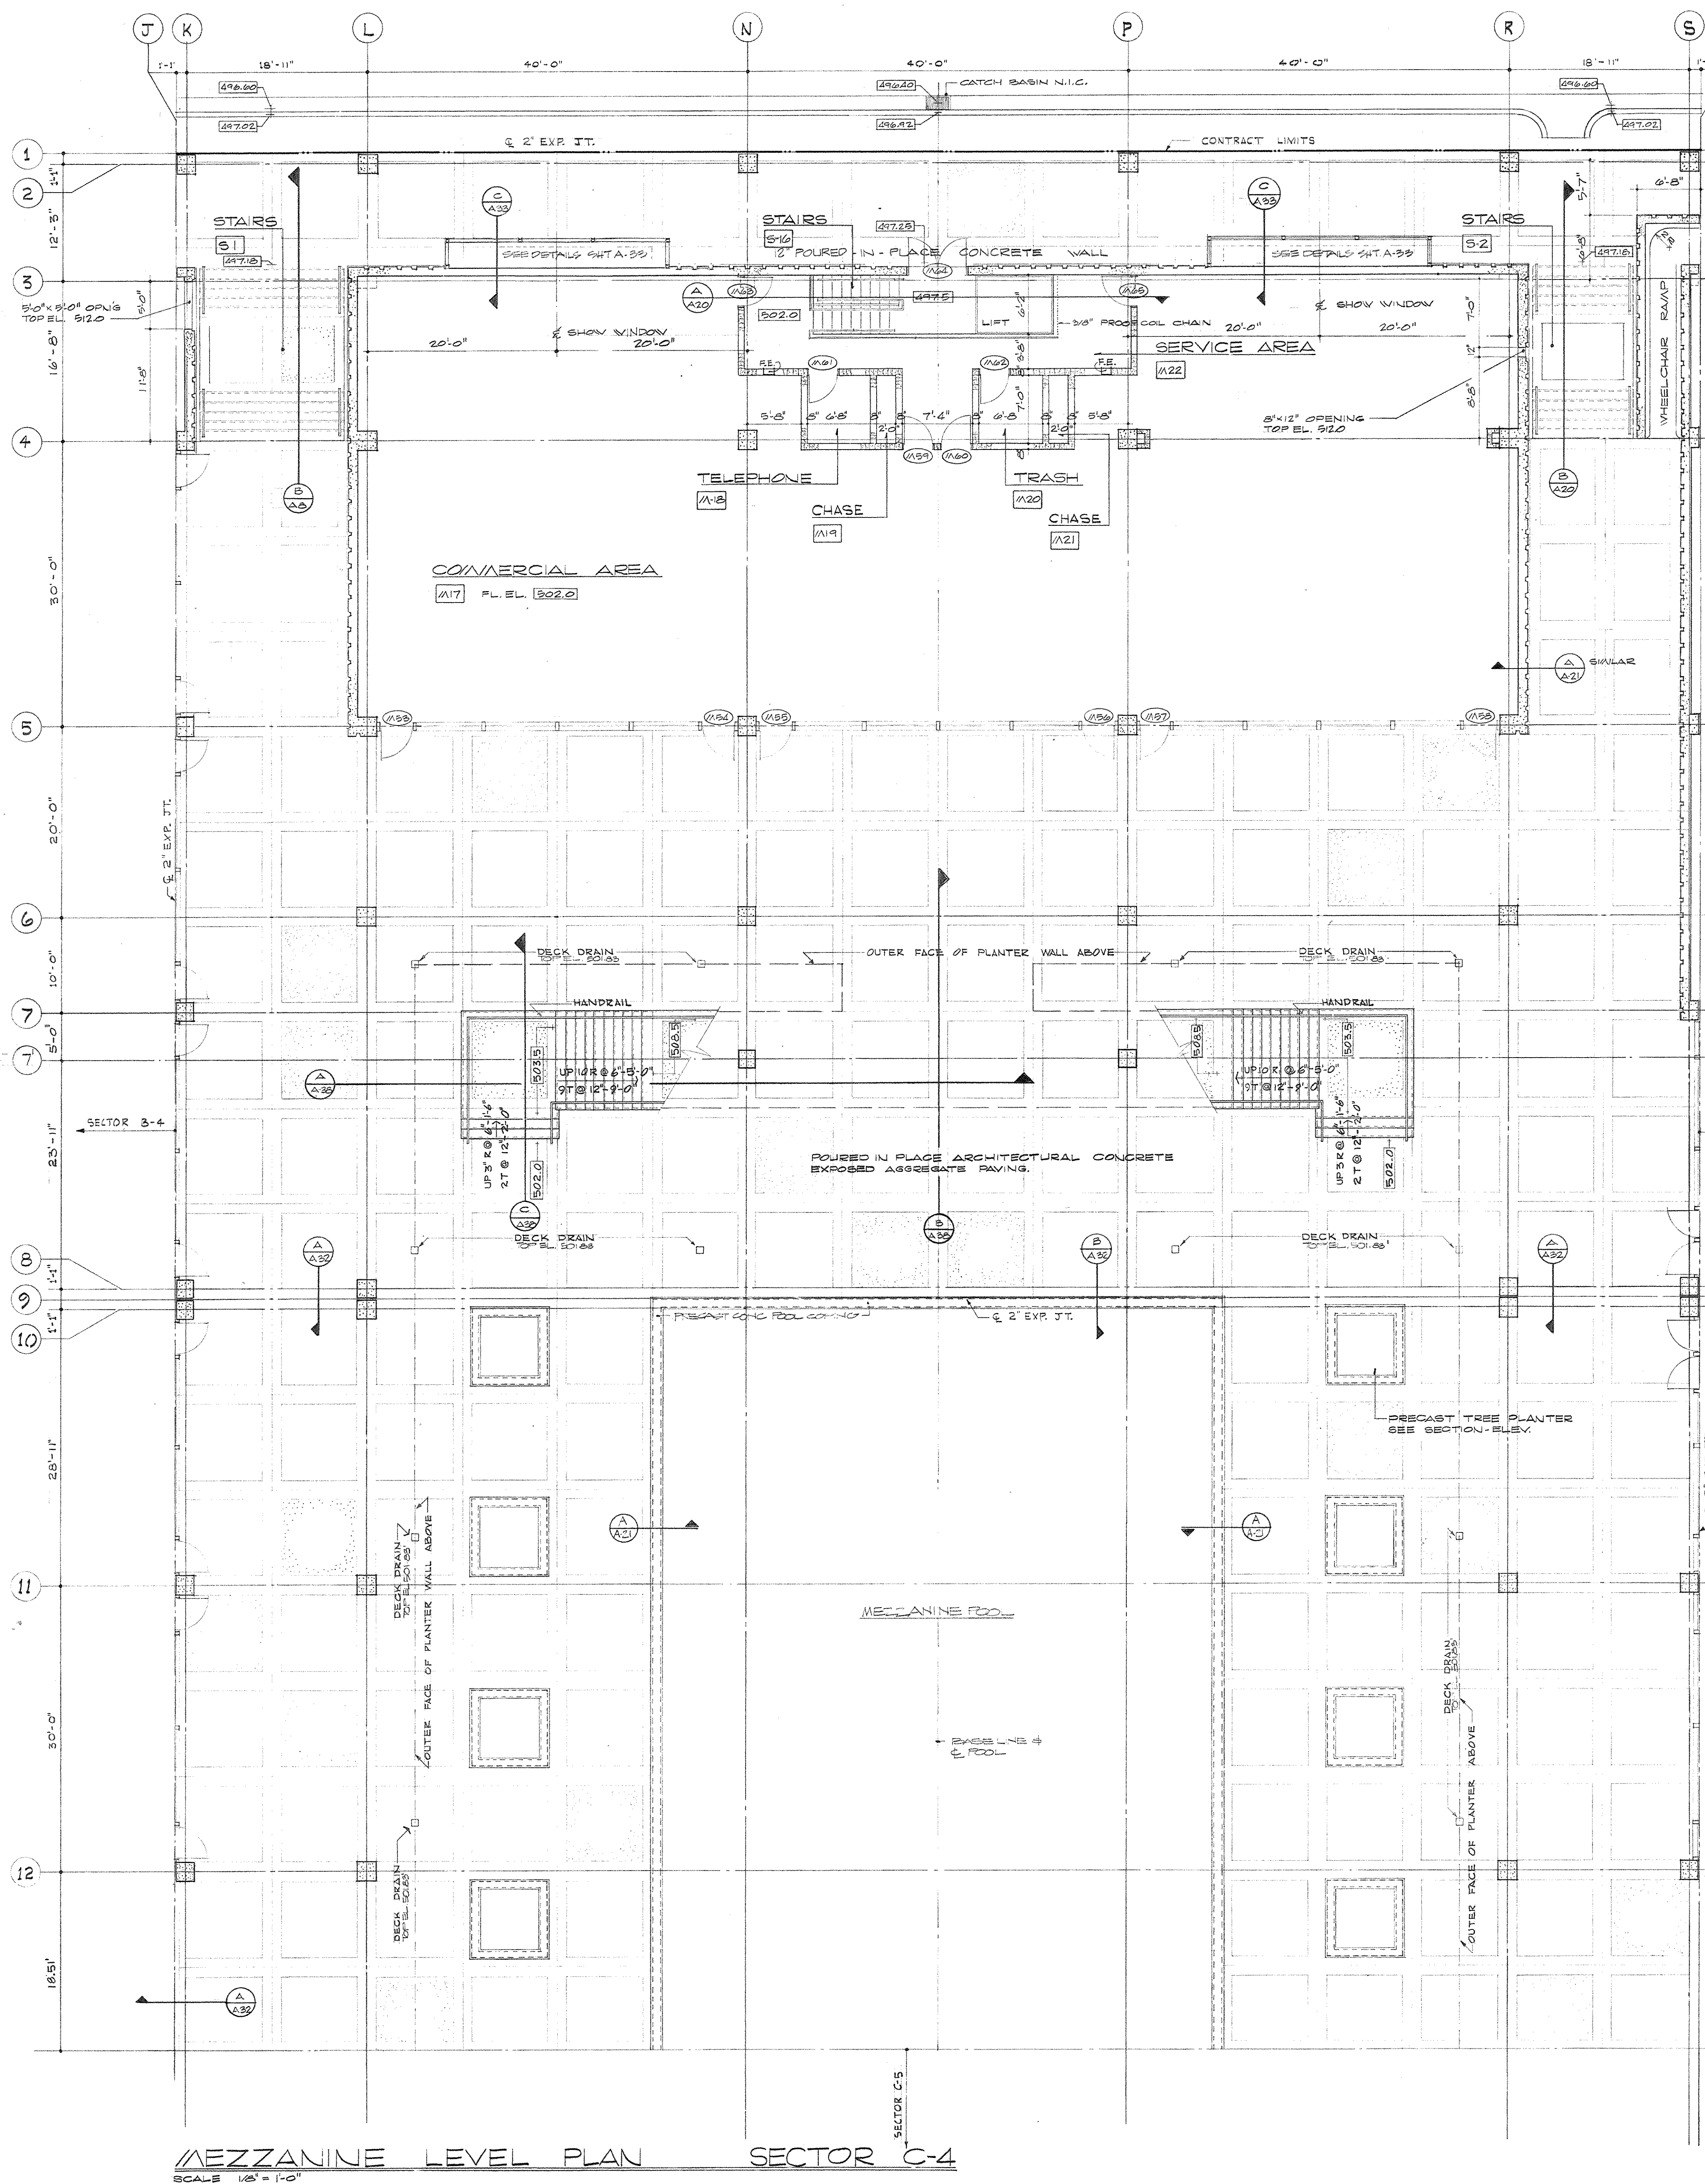


MEZZANINE LEVEL PLAN SECTOR C-4
SCALE 1/8" = 1'-0"

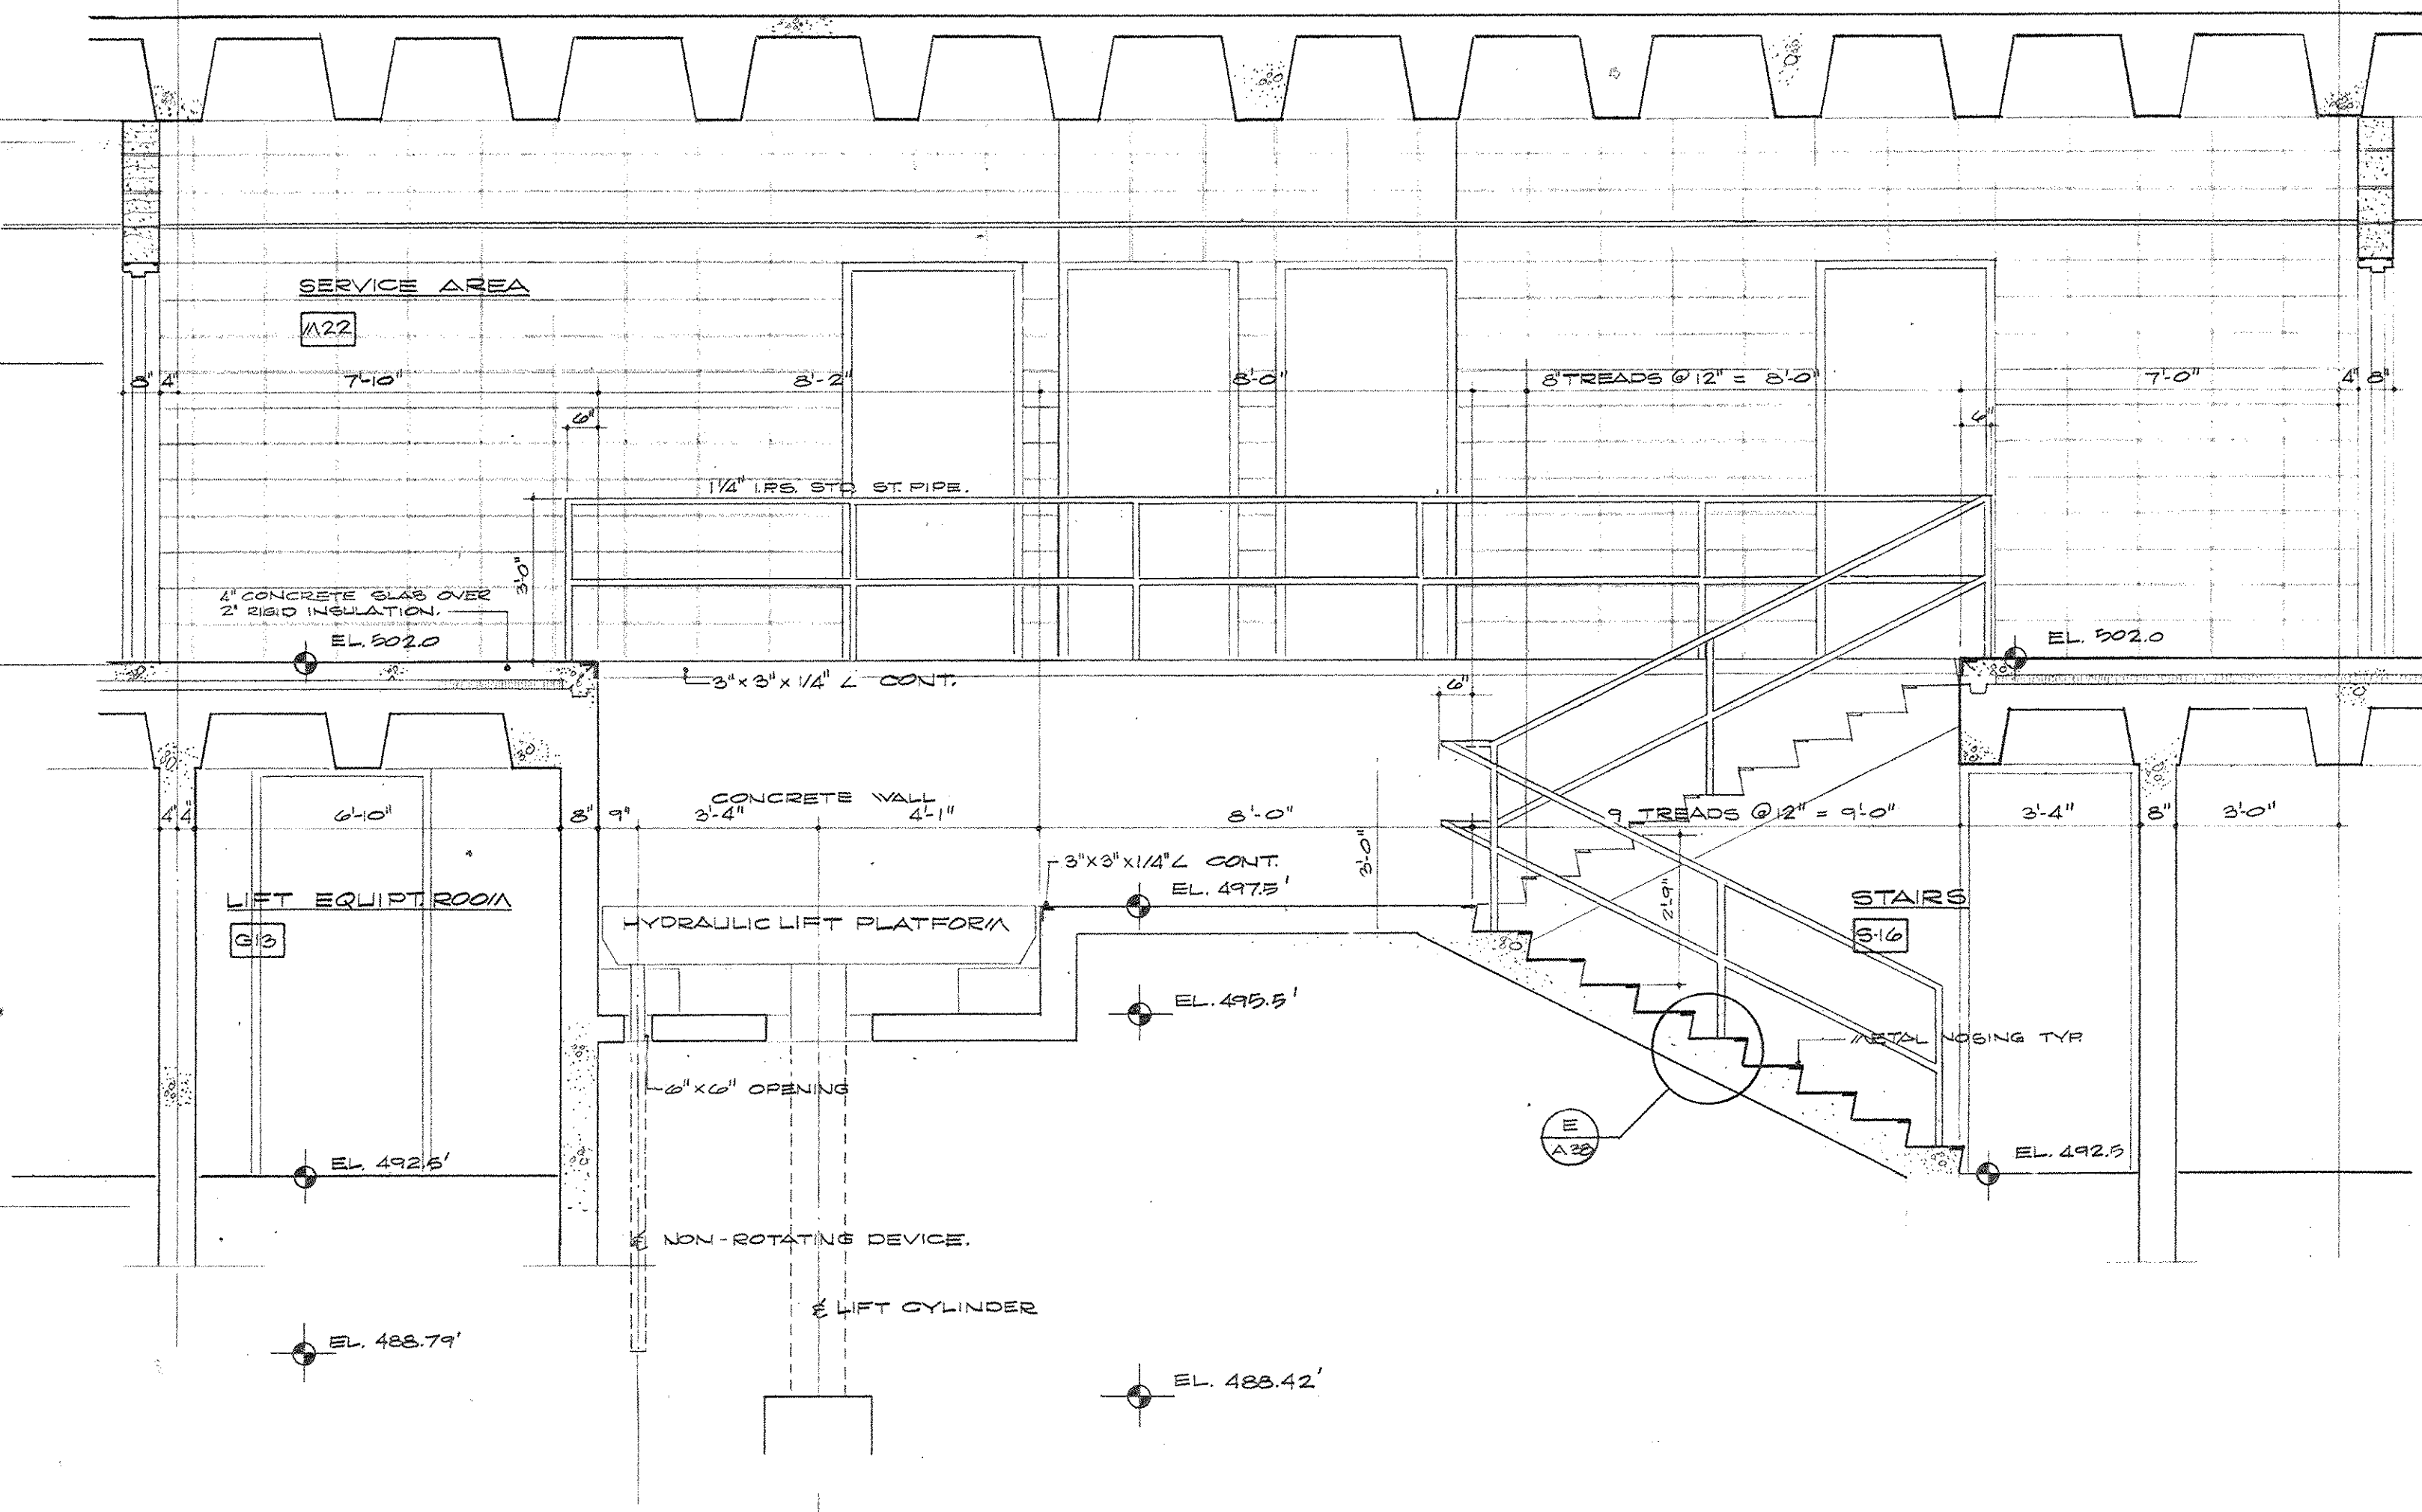


SECTION A (A20) SERVICE AREA & STAIRS S16
SCALE 3/8" = 1'-0"

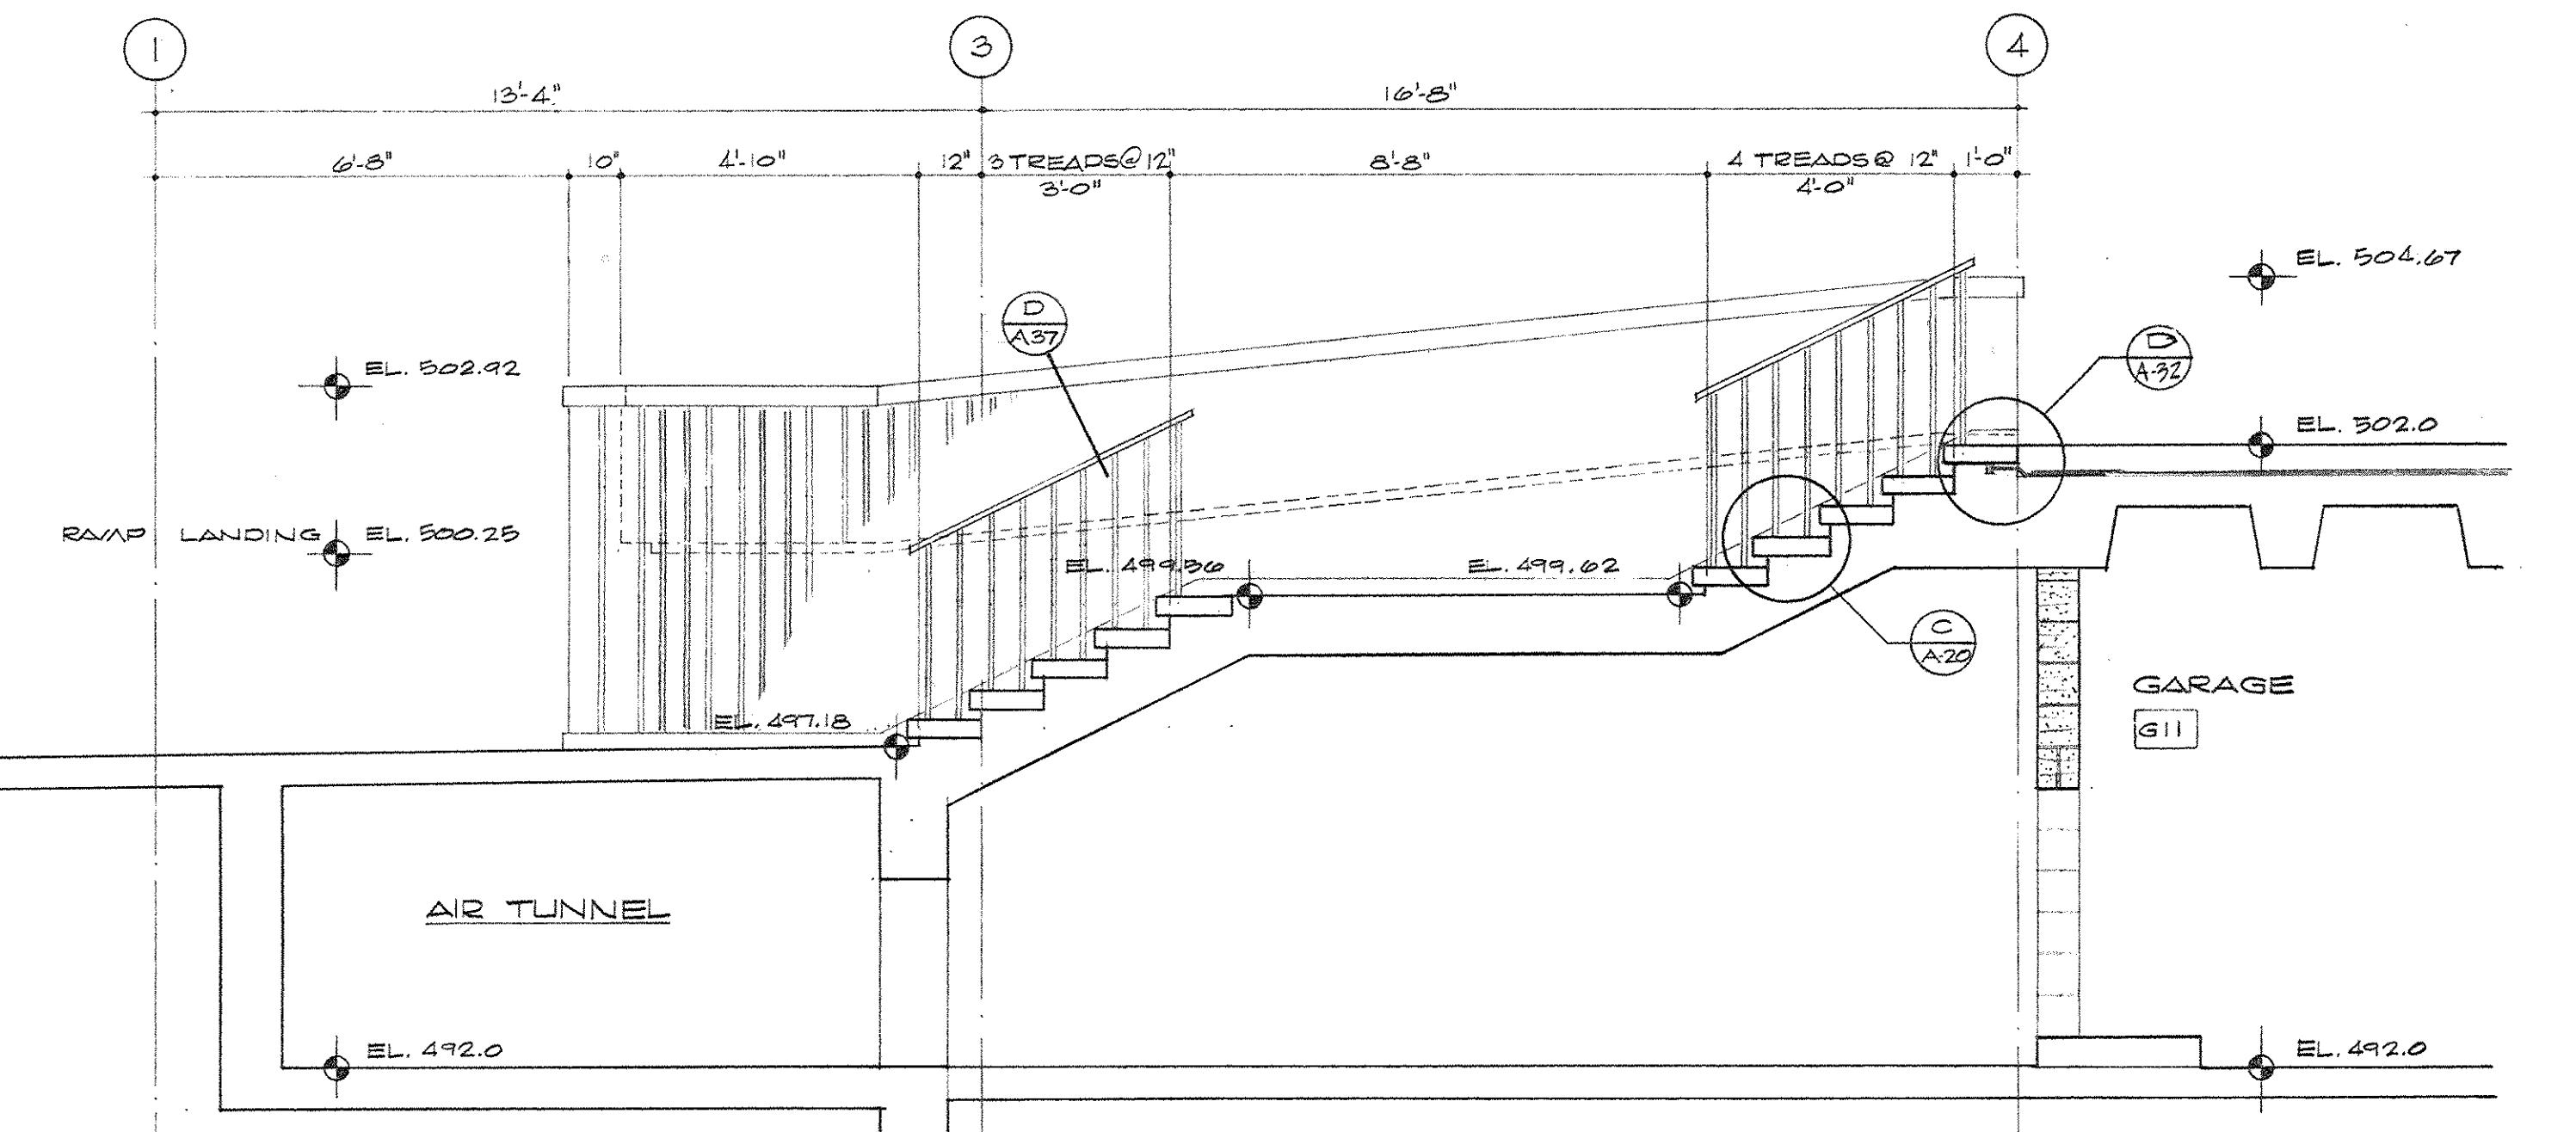

SECTION B (A20) STAIRS S2 & WHEEL CHAIR RAMP
SCALE 3/8" = 1'-0"

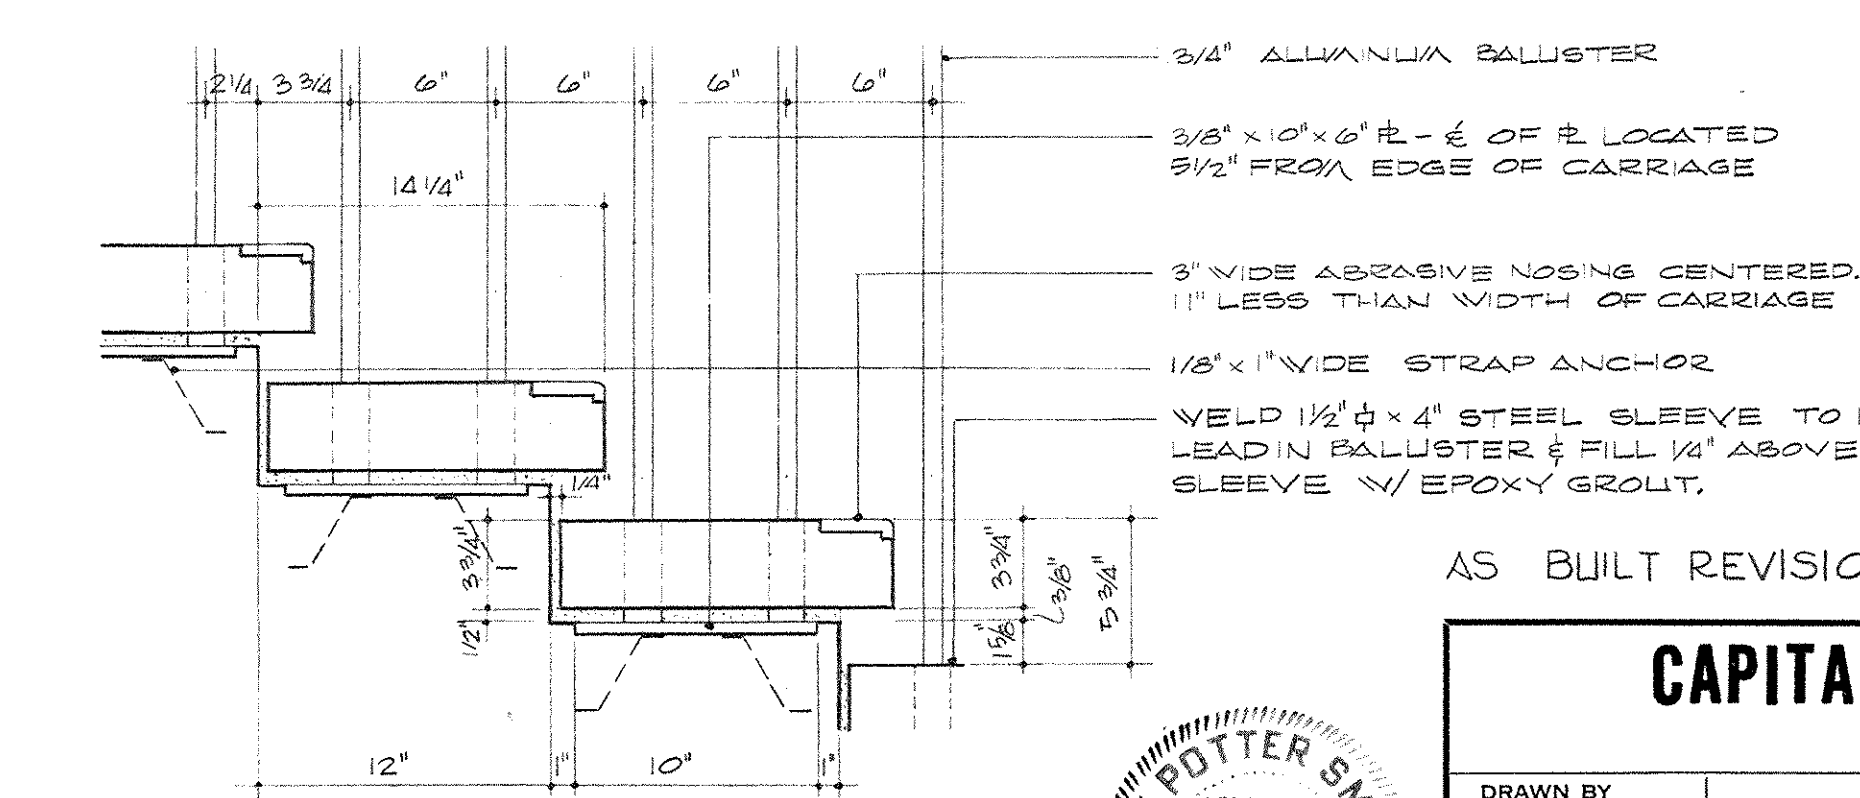





SECTION C (A20)
SCALE 1/2" = 1'-0"

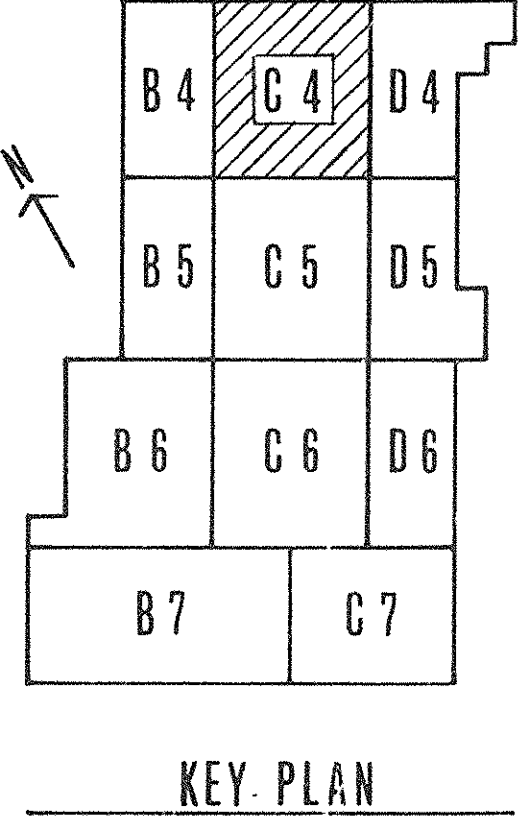

KEY PLAN


AS BUILT REVISIONS - 8-22-72


CAPITAL PLAZA DEVELOPMENT PHASE II			DATE
FRANKFORT, KENTUCKY			12 OCT. 1967
DRAWN BY	MEZZANINE LEVEL PLAN	CHECKED BY	COMM. NO.
U.D.		LEH	50387
SECTOR NO.	LEE POTTER SMITH, PRITCHETT, HUGG & CARTER ARCHITECTS ENGINEERS 314 WILKINSON STREET FRANKFORT, KENTUCKY	DATE	DRAWING NO.
C 4	COMMONWEALTH OF KENTUCKY DEPARTMENT OF FINANCE - DIVISION OF ENGINEERING FRANKFORT, KENTUCKY	10-26-67	A 20
APPROVED BY	AGENCY HEAD	DATE	OF A-42
	W. J. Mc Connell		
APPROVED BY	OWNER	DATE	

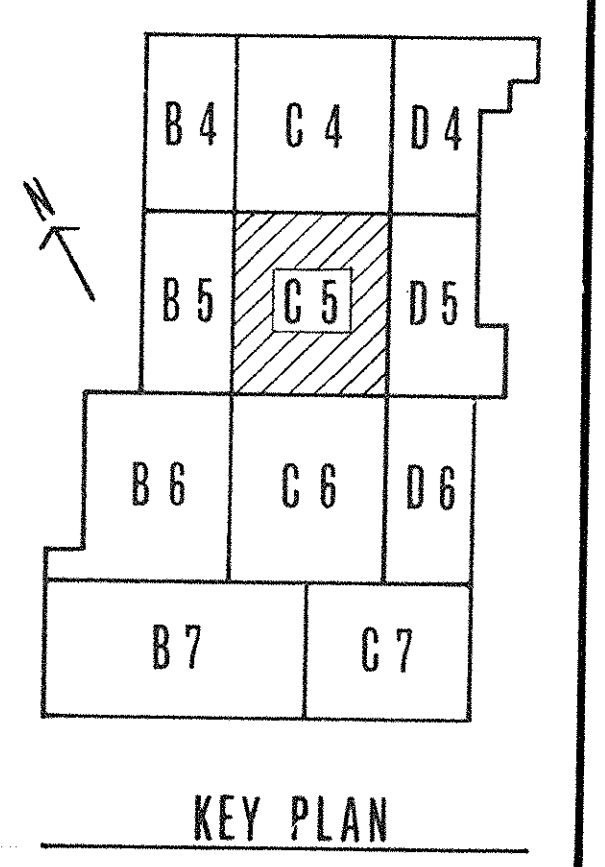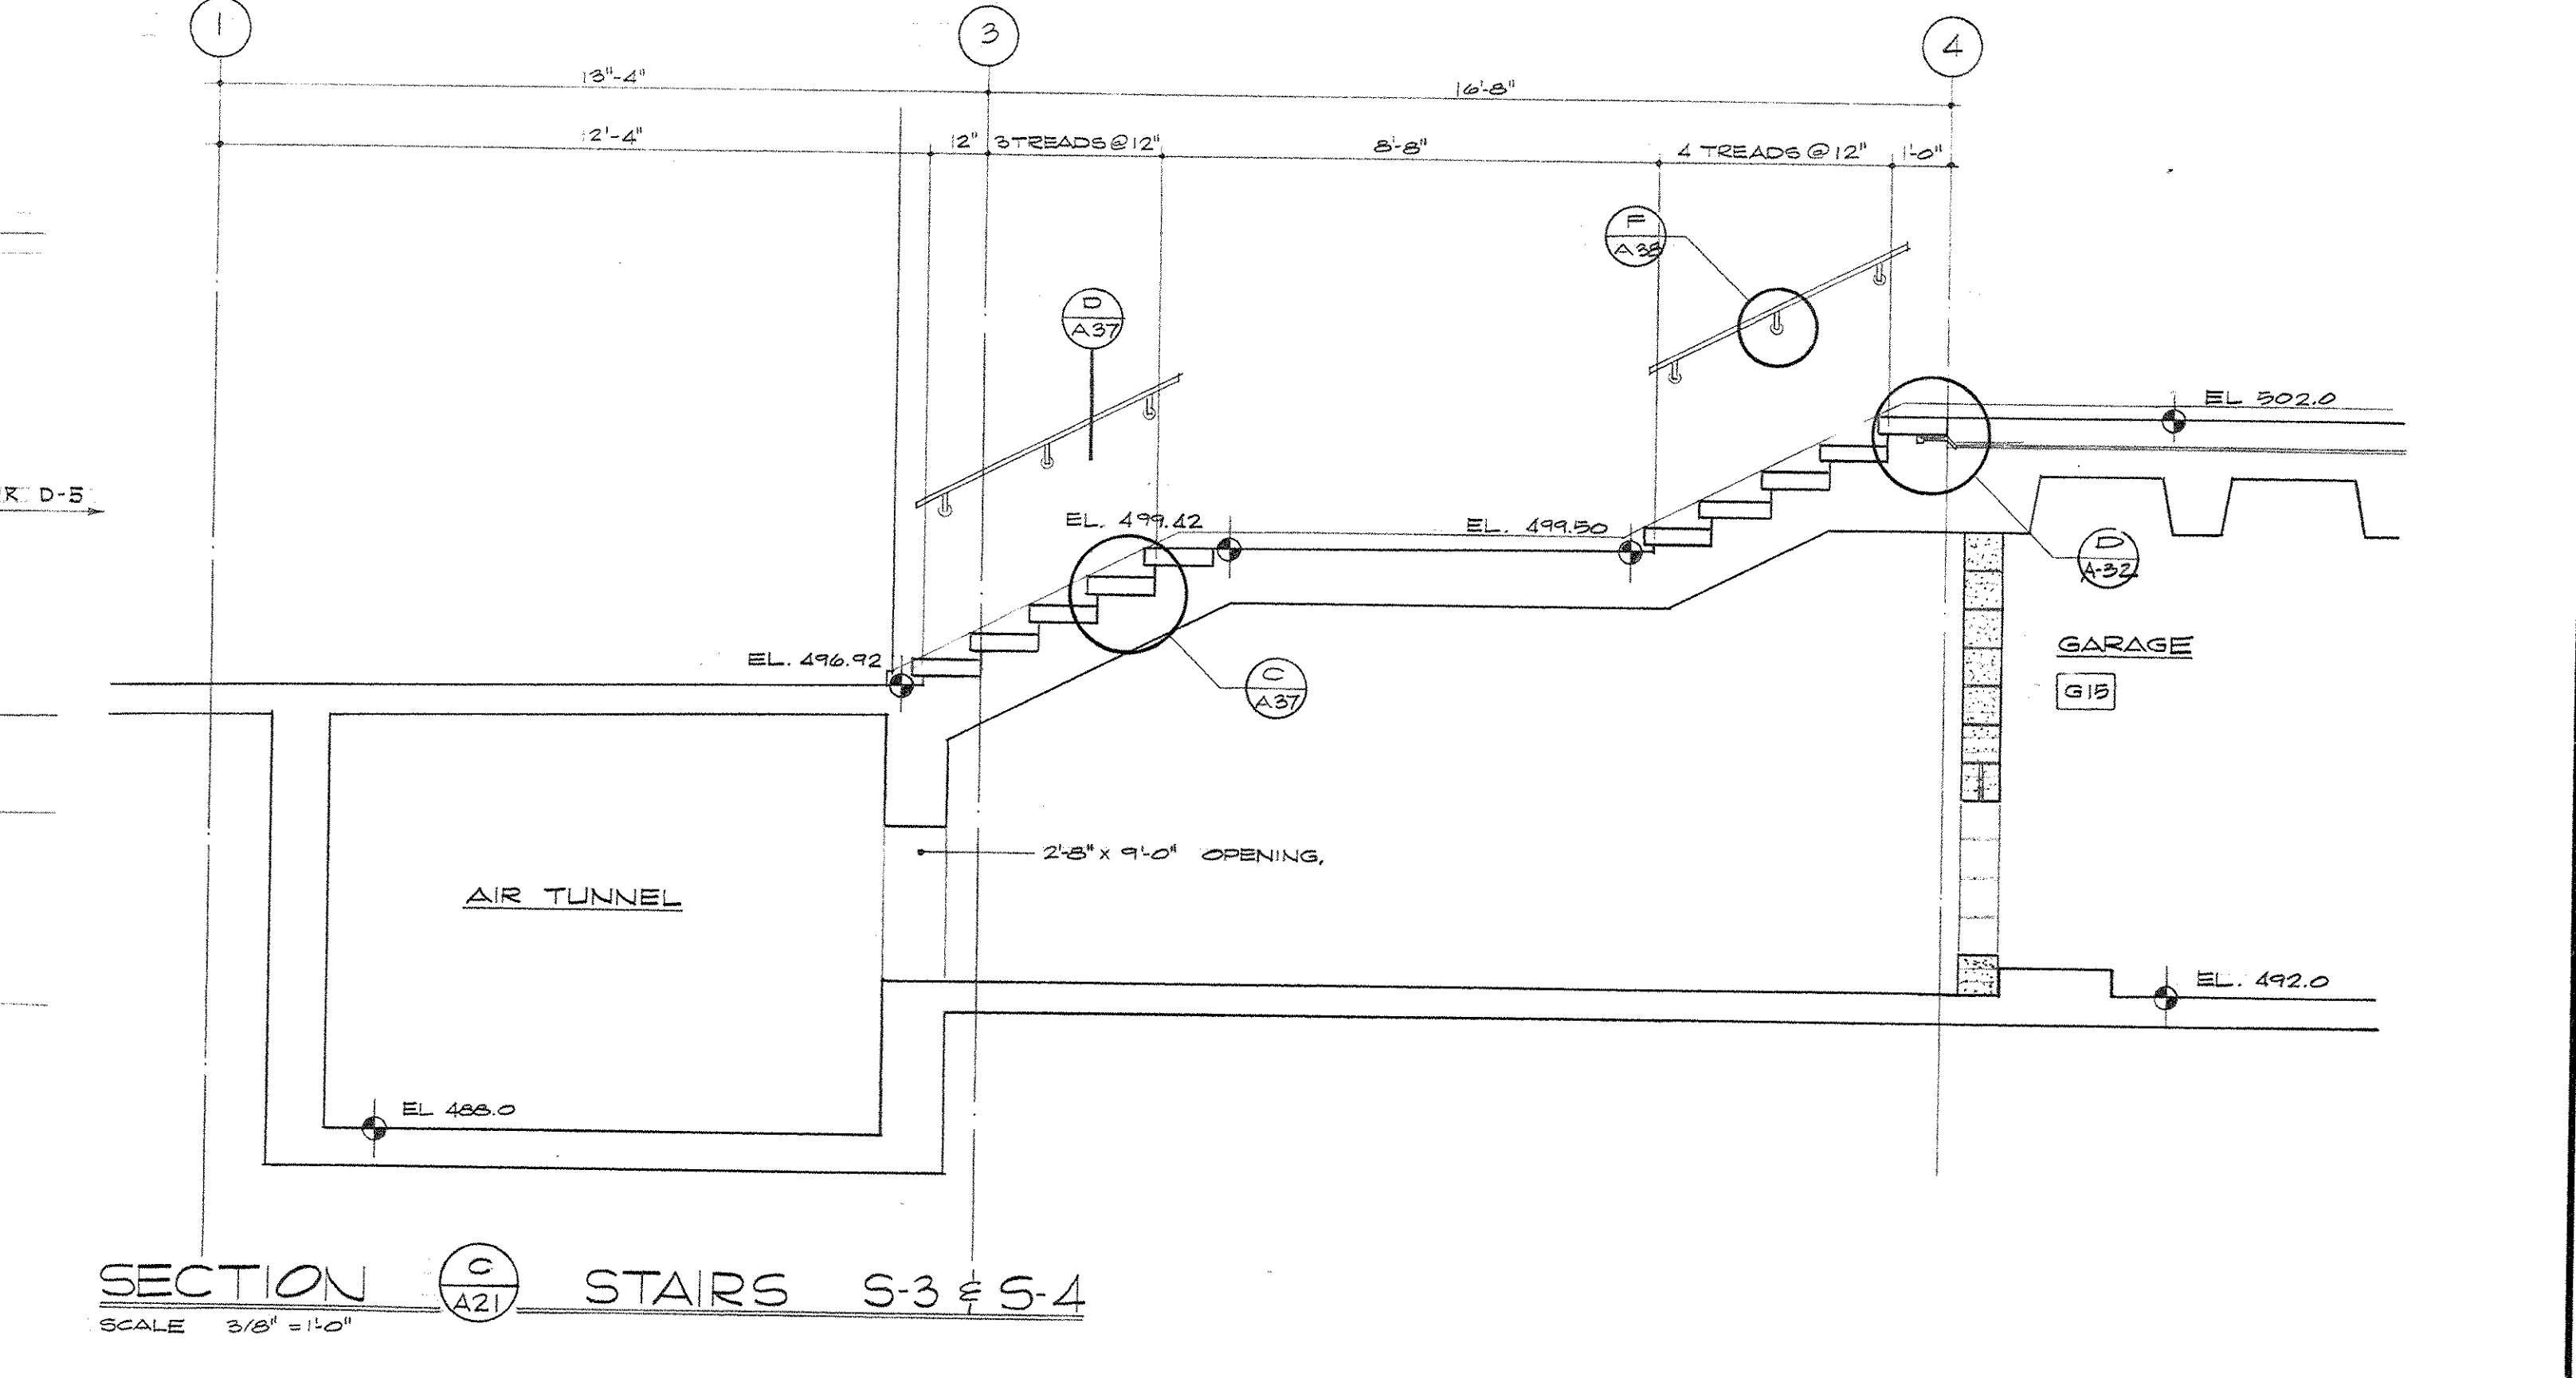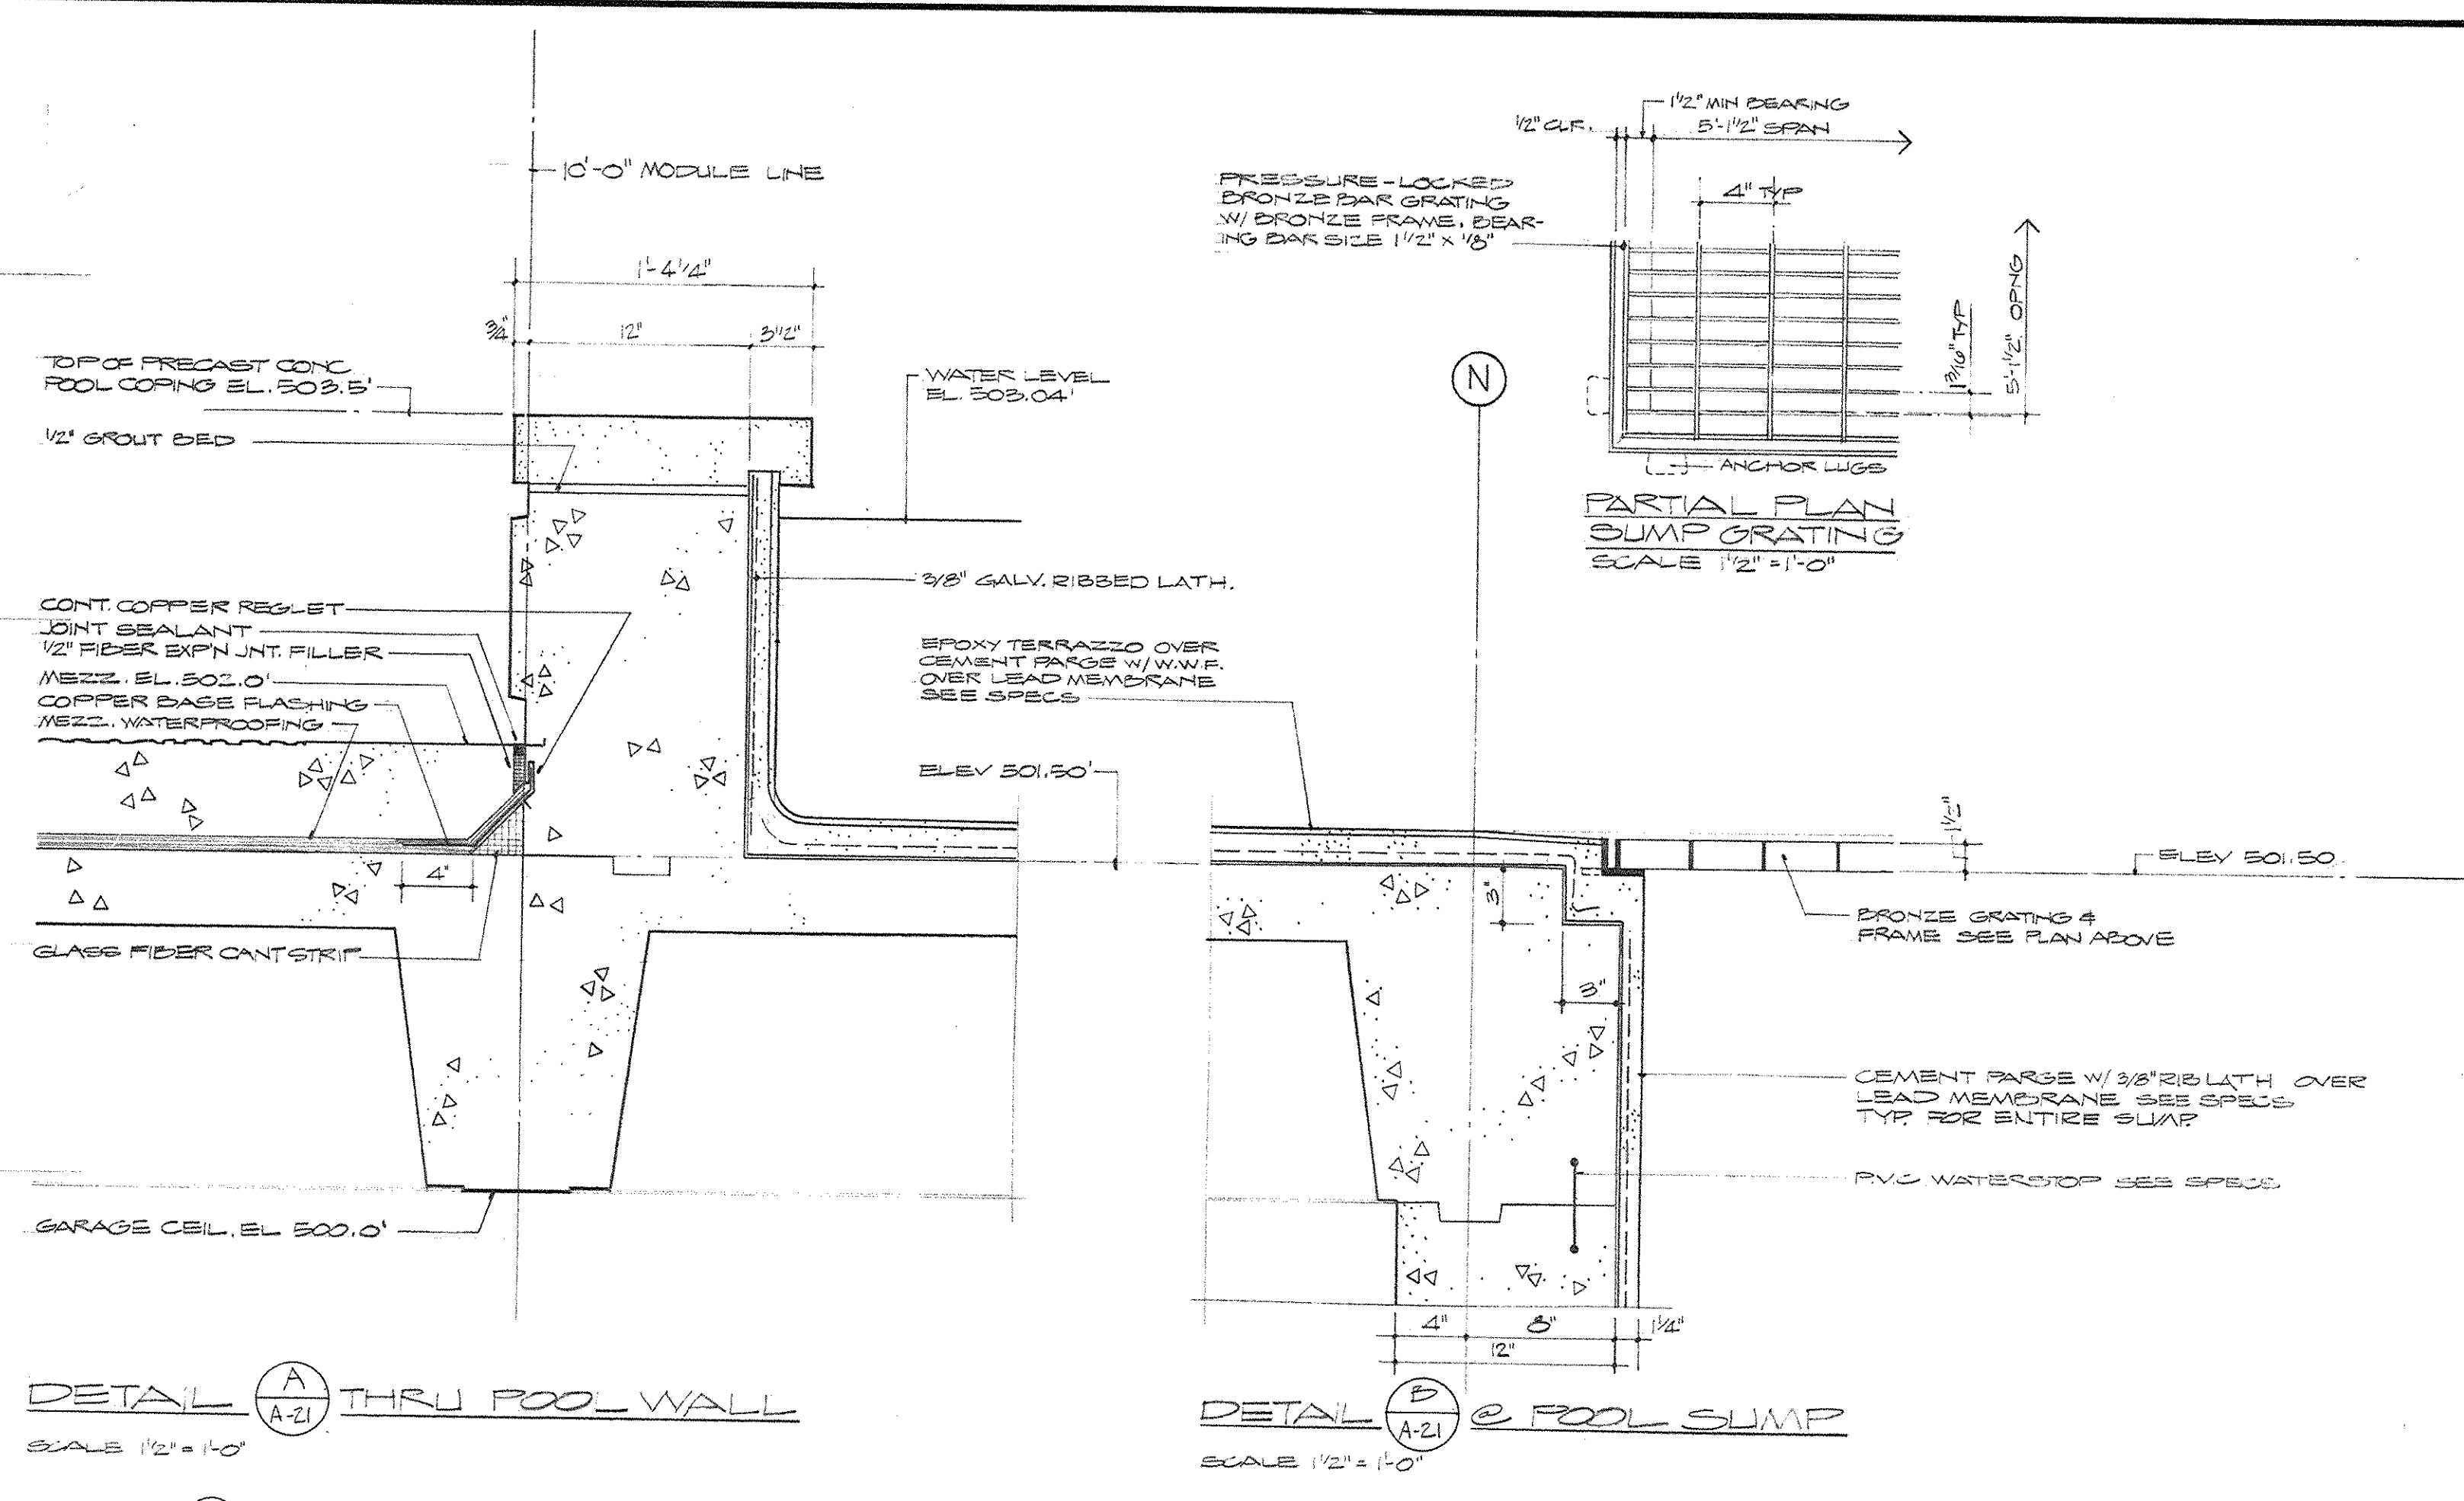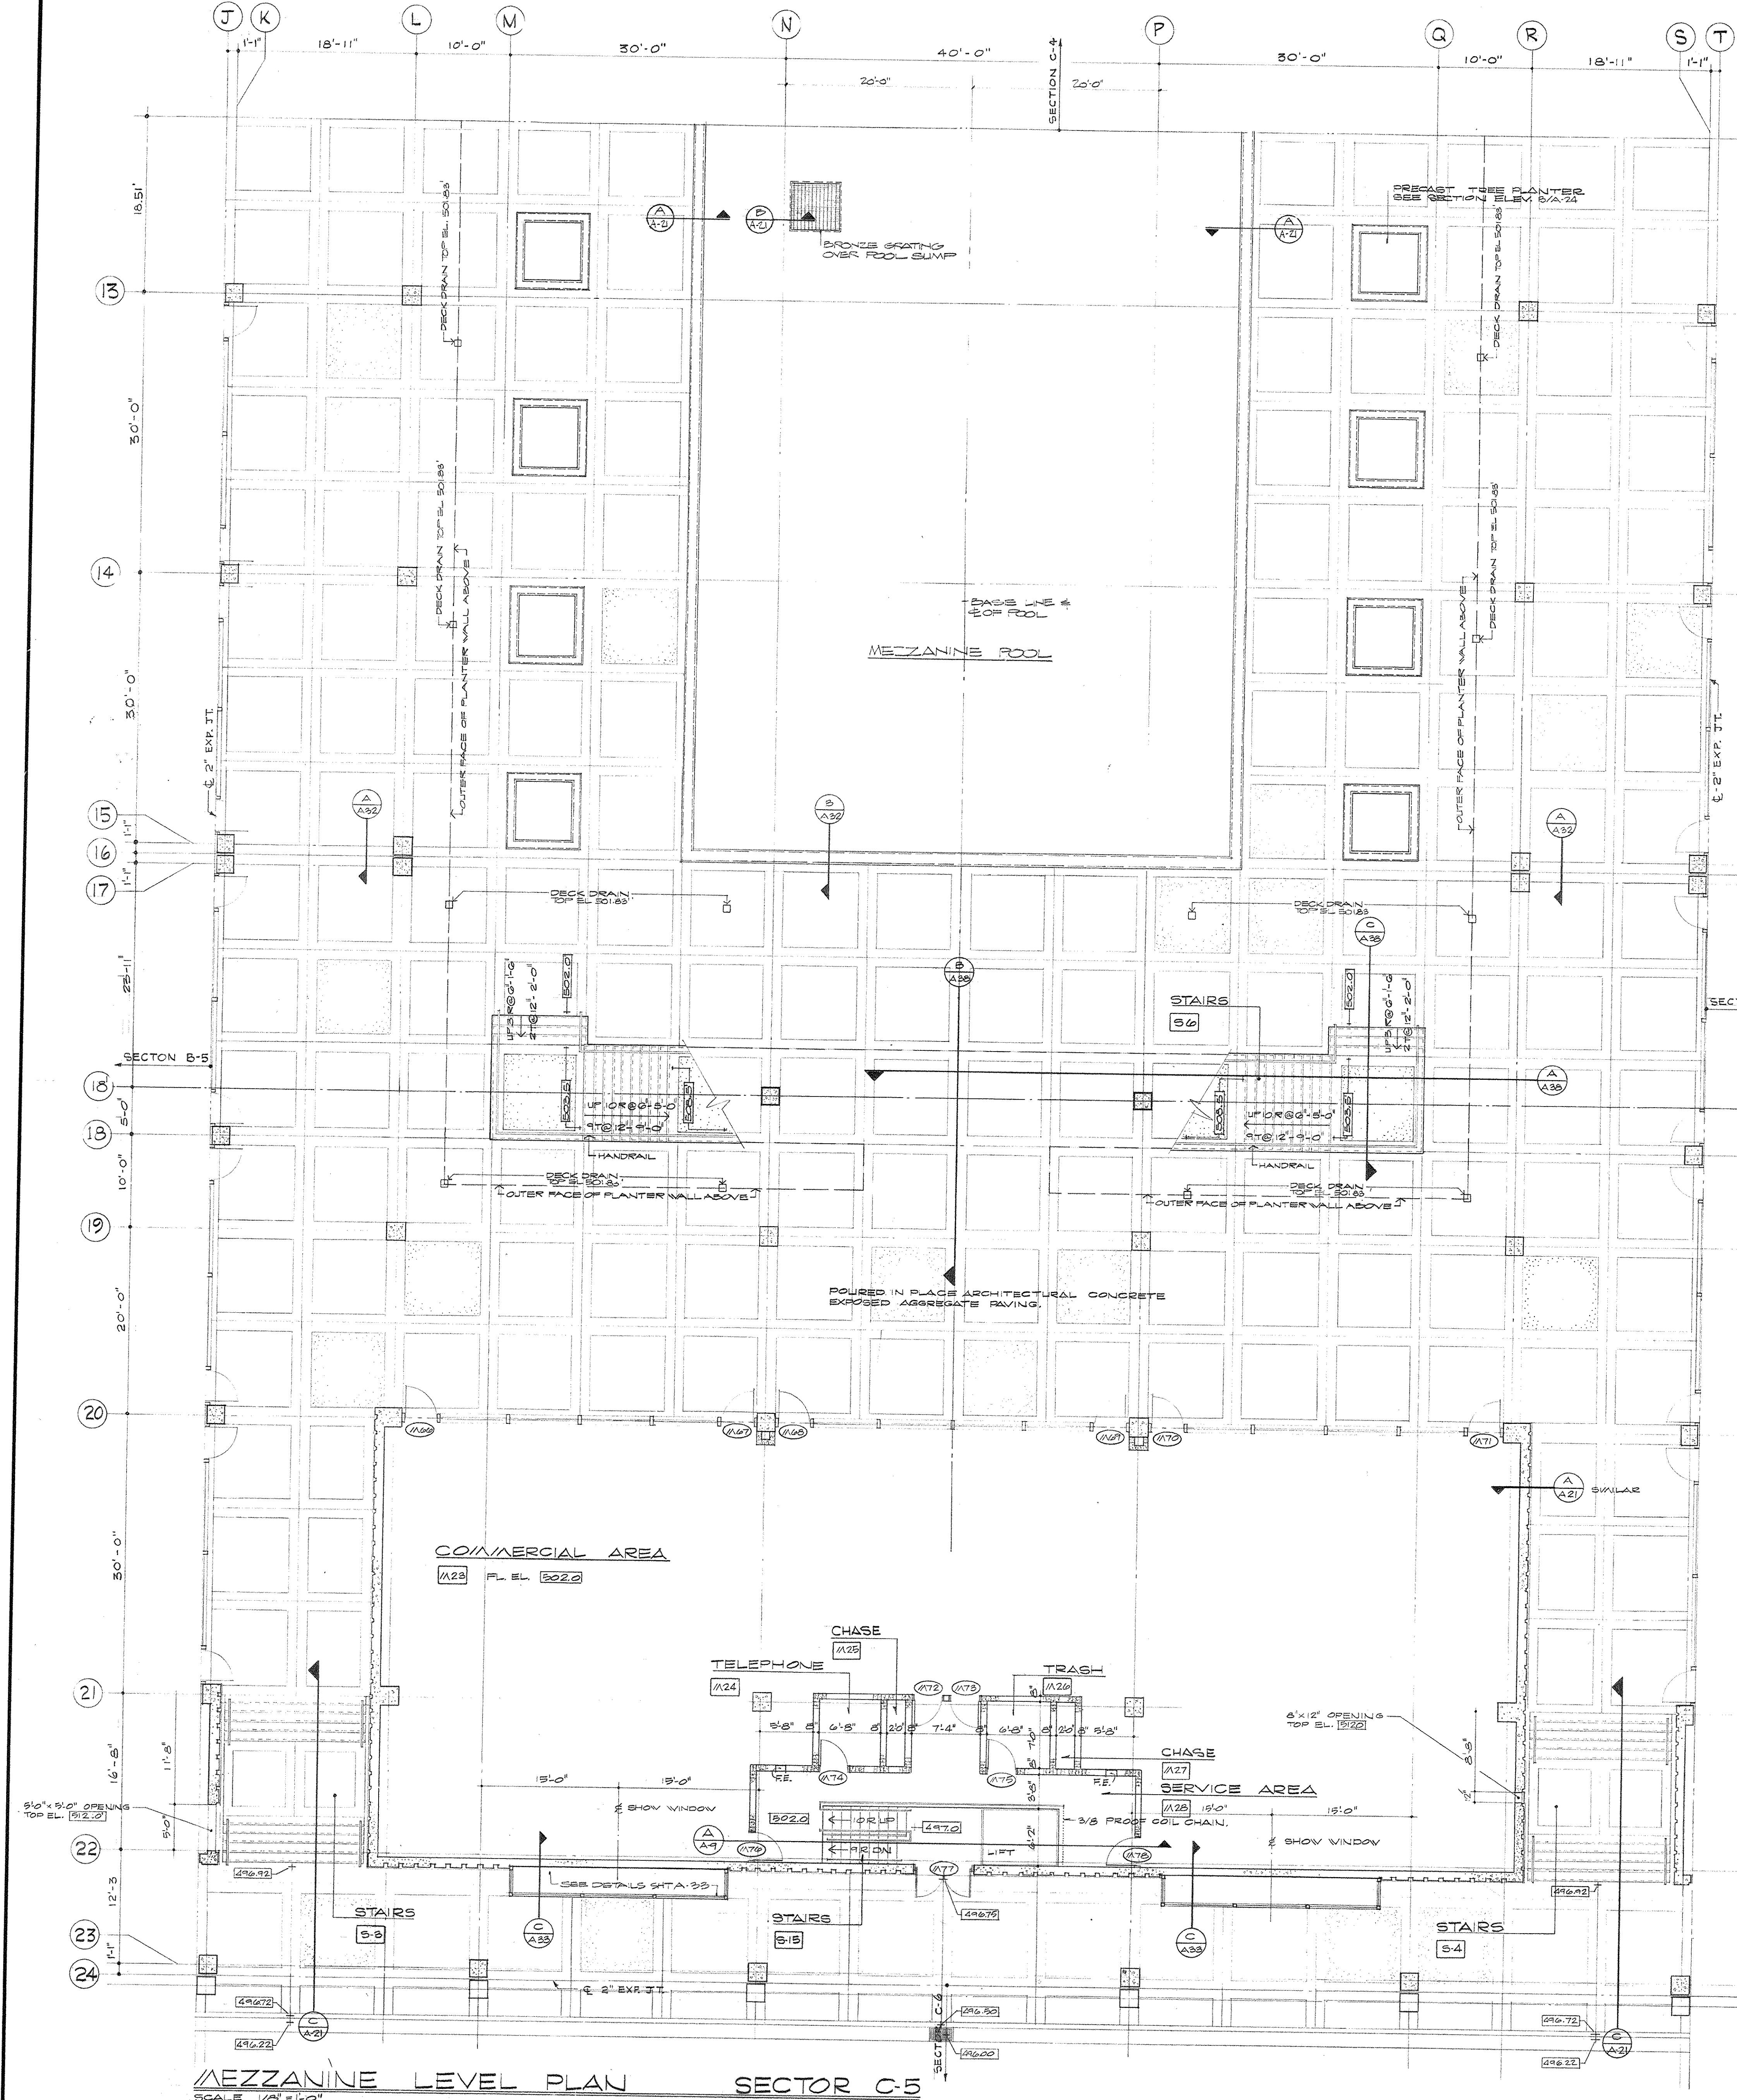


AS BUILT REVISIONS - 8-22-72

CAPITAL PLAZA DEVELOPMENT PHASE II		
FRANKFORT, KENTUCKY		
DRAWN BY N.C. L.H.W.R., U.S.	338	DATE OCT. 1967
CHECKED BY	ENGINEERS	COMM. NO. 50367
SECTOR NO.	LEE POTTER SMITH, PRITCHETT, HUGG & CARTER ARCHITECTS 314 WILKINSON STREET FRANKFORT, KENTUCKY	DRAWING NO. A 21
C 5	COMMONWEALTH OF KENTUCKY DEPARTMENT OF FINANCE - DIVISION OF ENGINEERING FRANKFORT	OF A 42
APPROVED BY	AGENCY HEAD	DATE
APPROVED BY	OWNER	DATE 10-26-67

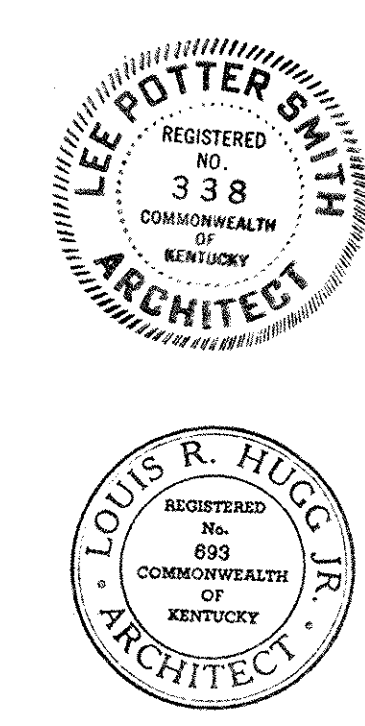


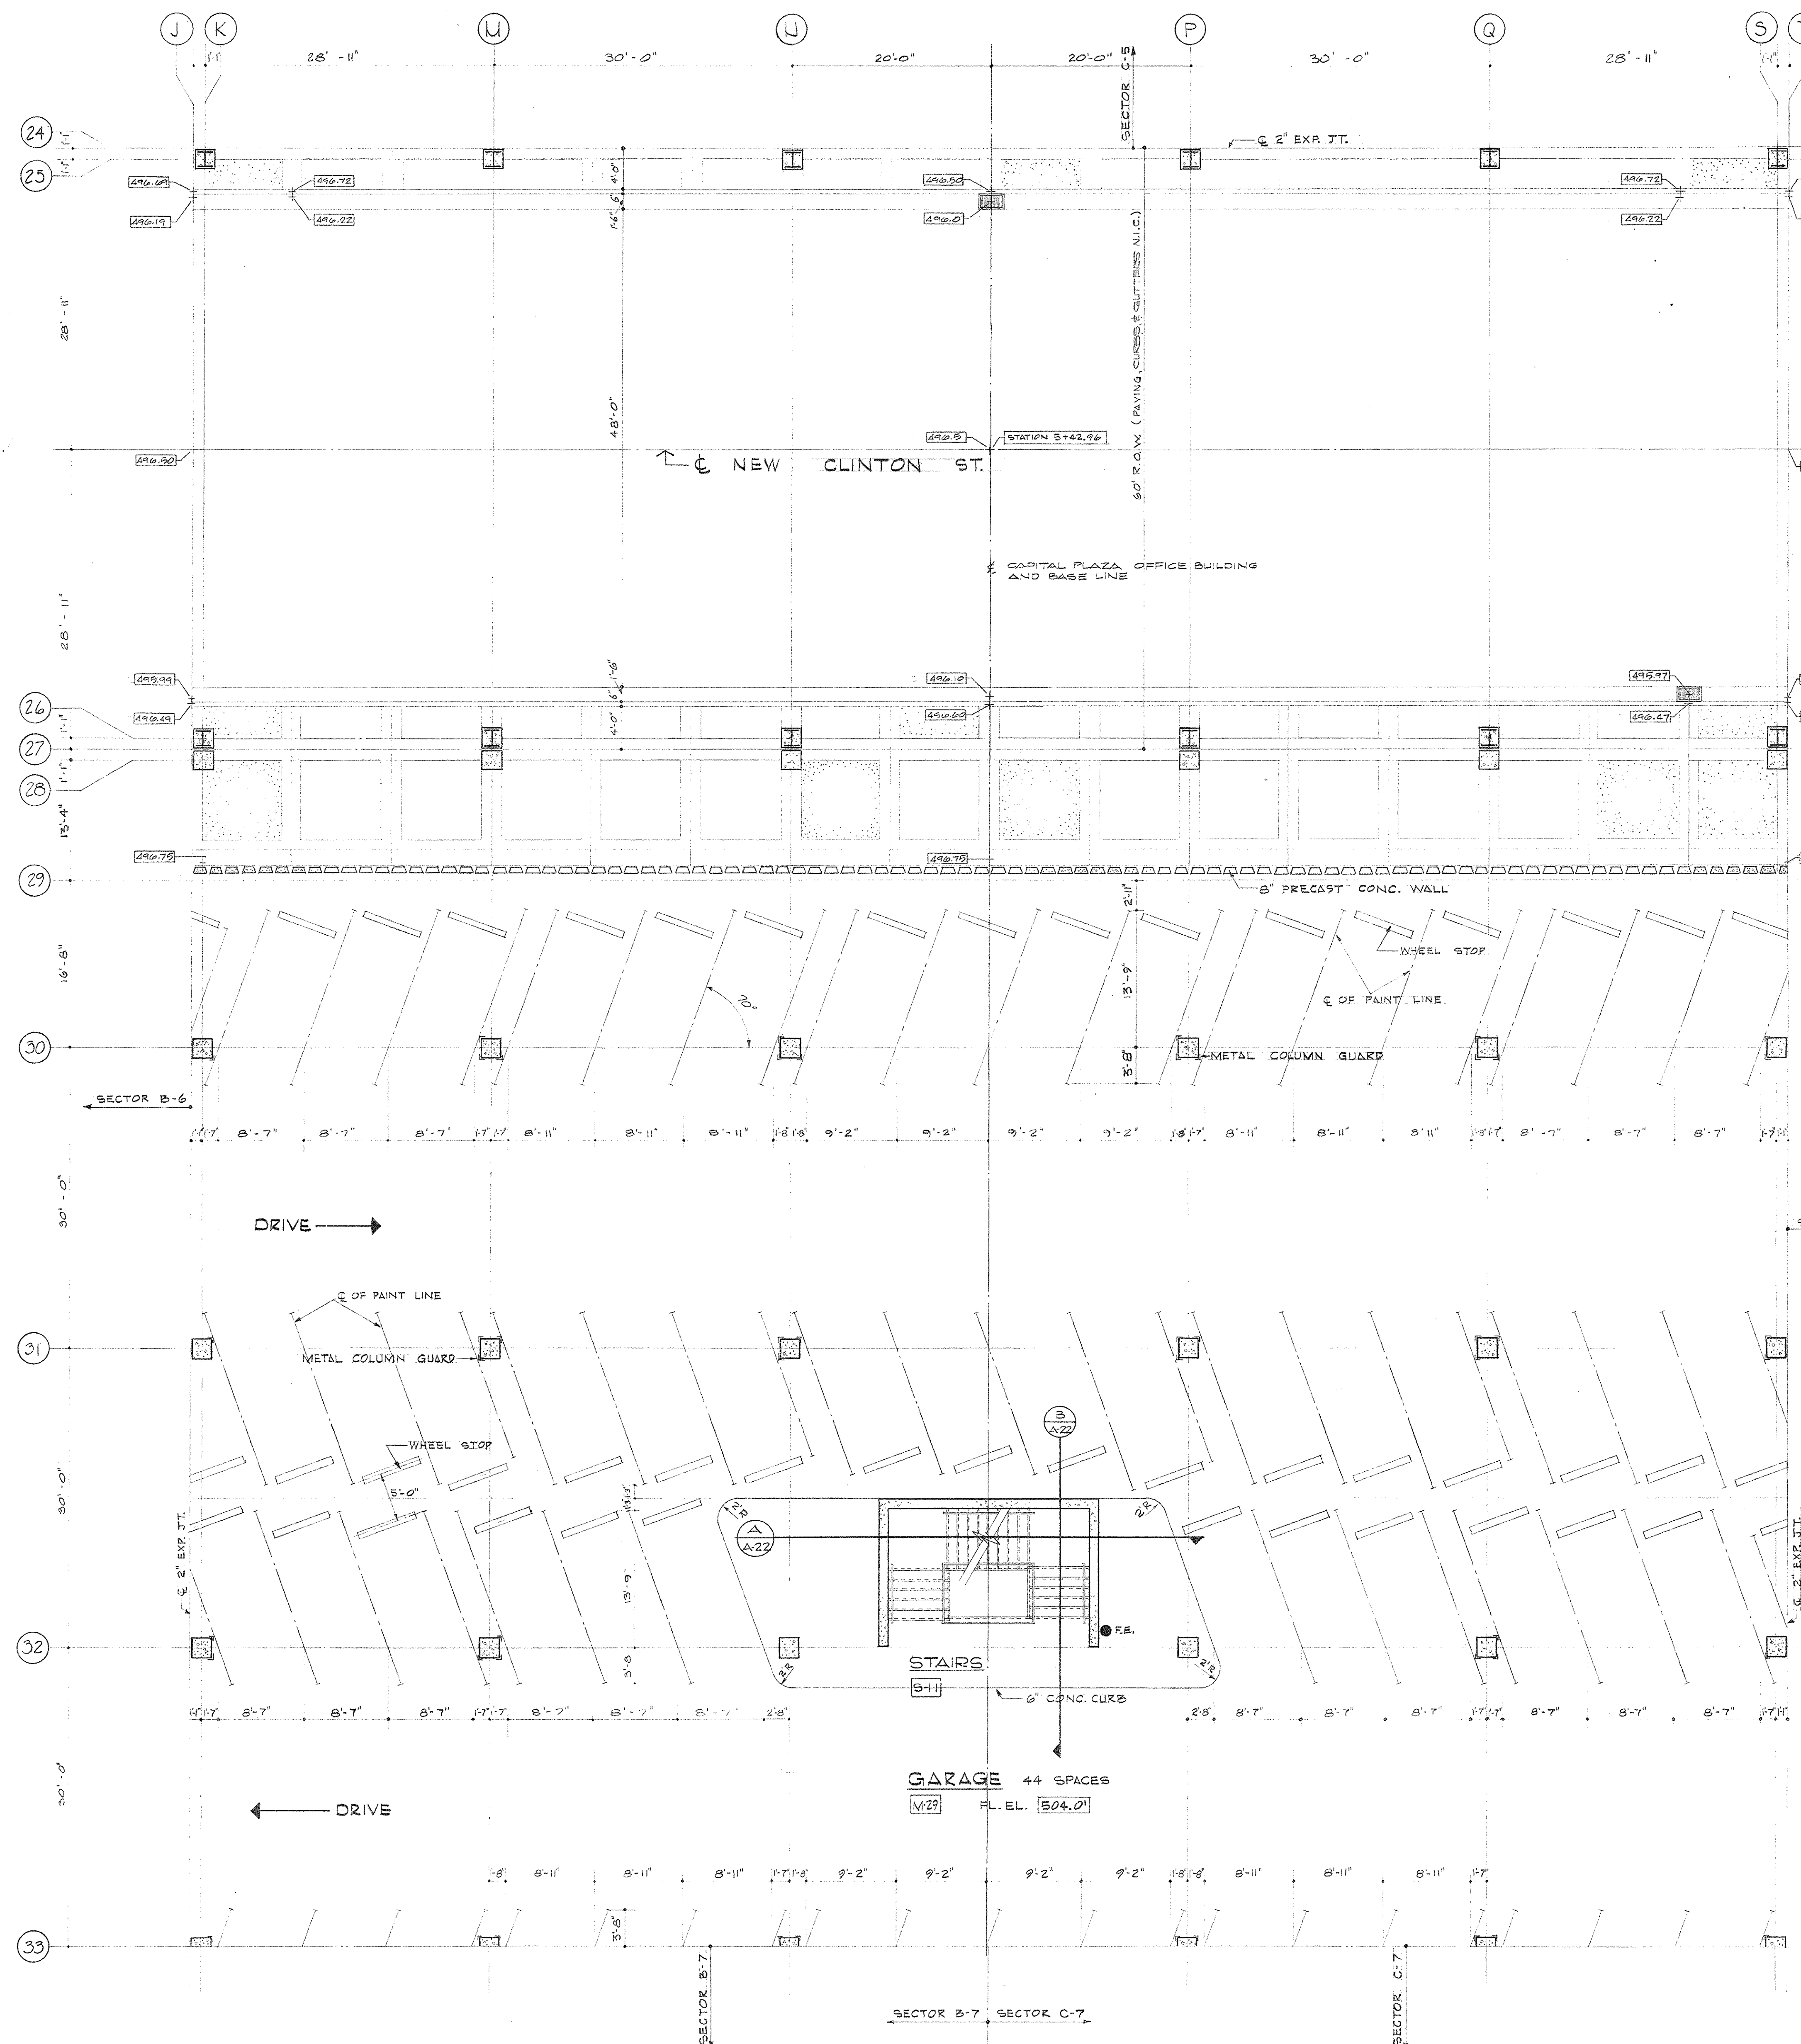


MEZZANINE LEVEL PLAN SECTOR C-6
SCALE 1/8" = 1'-0"

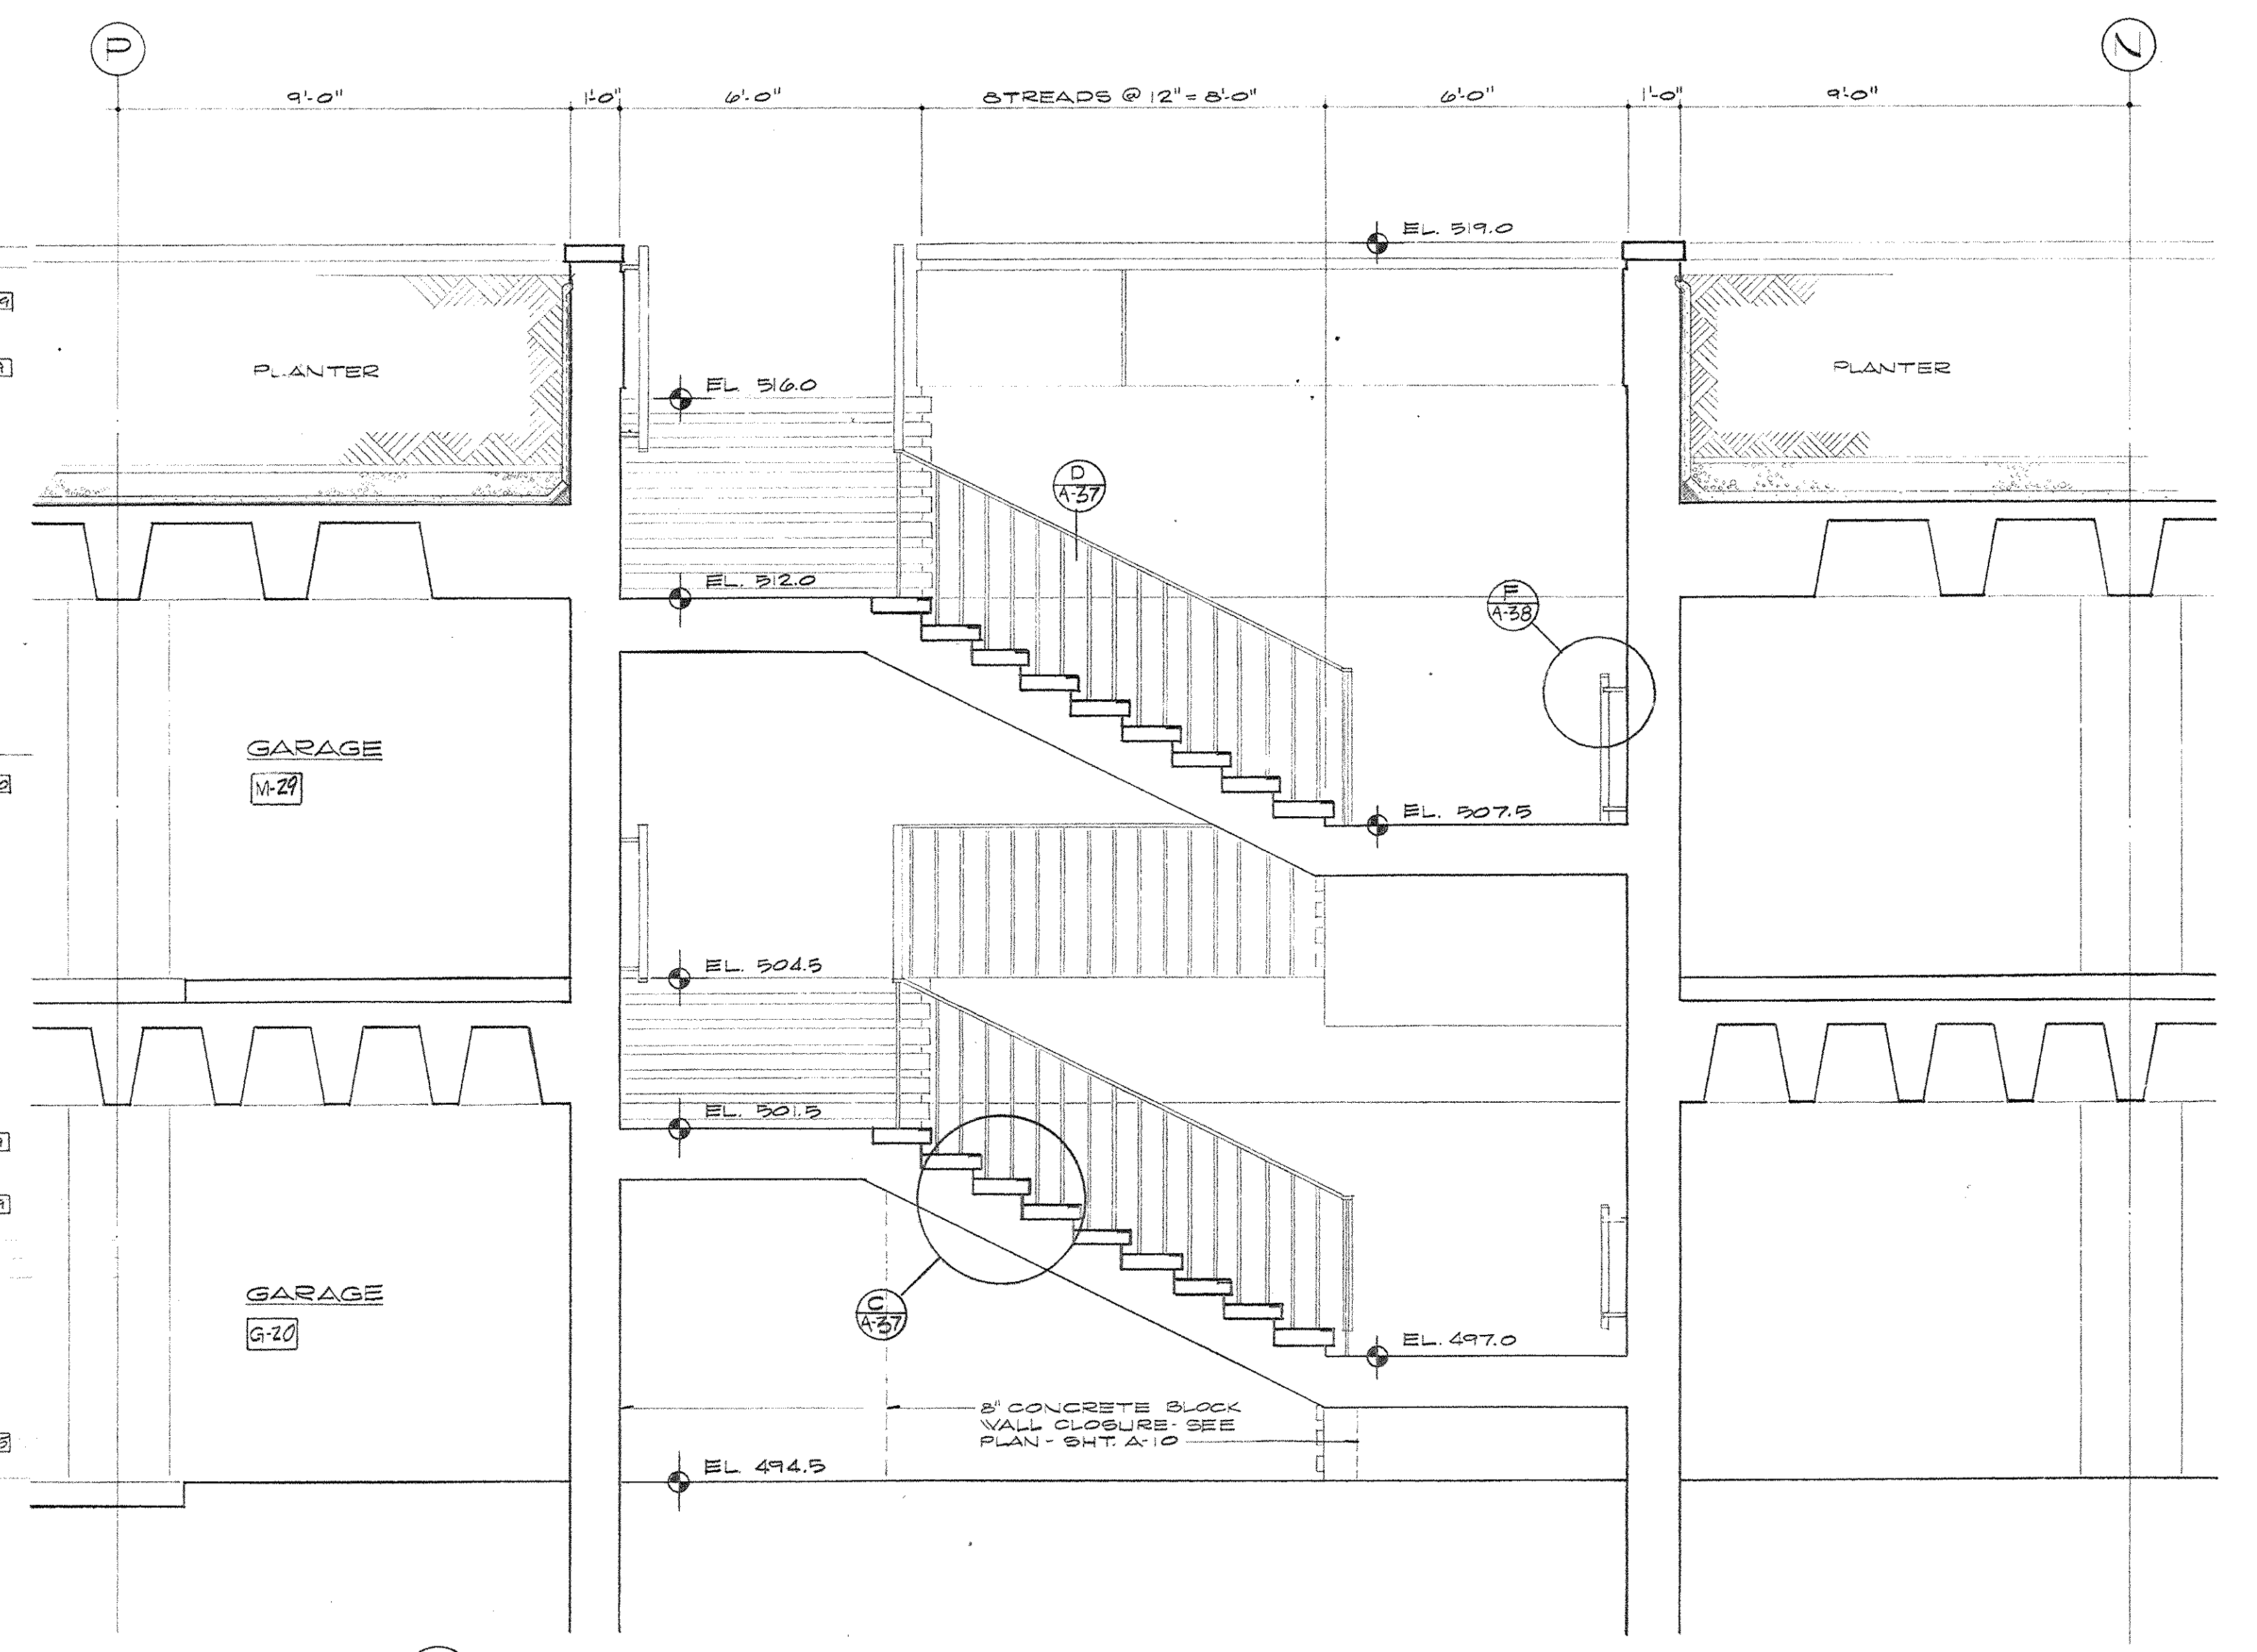


SECTION A-A STAIRS S-11
SCALE 3/8" = 1'-0"

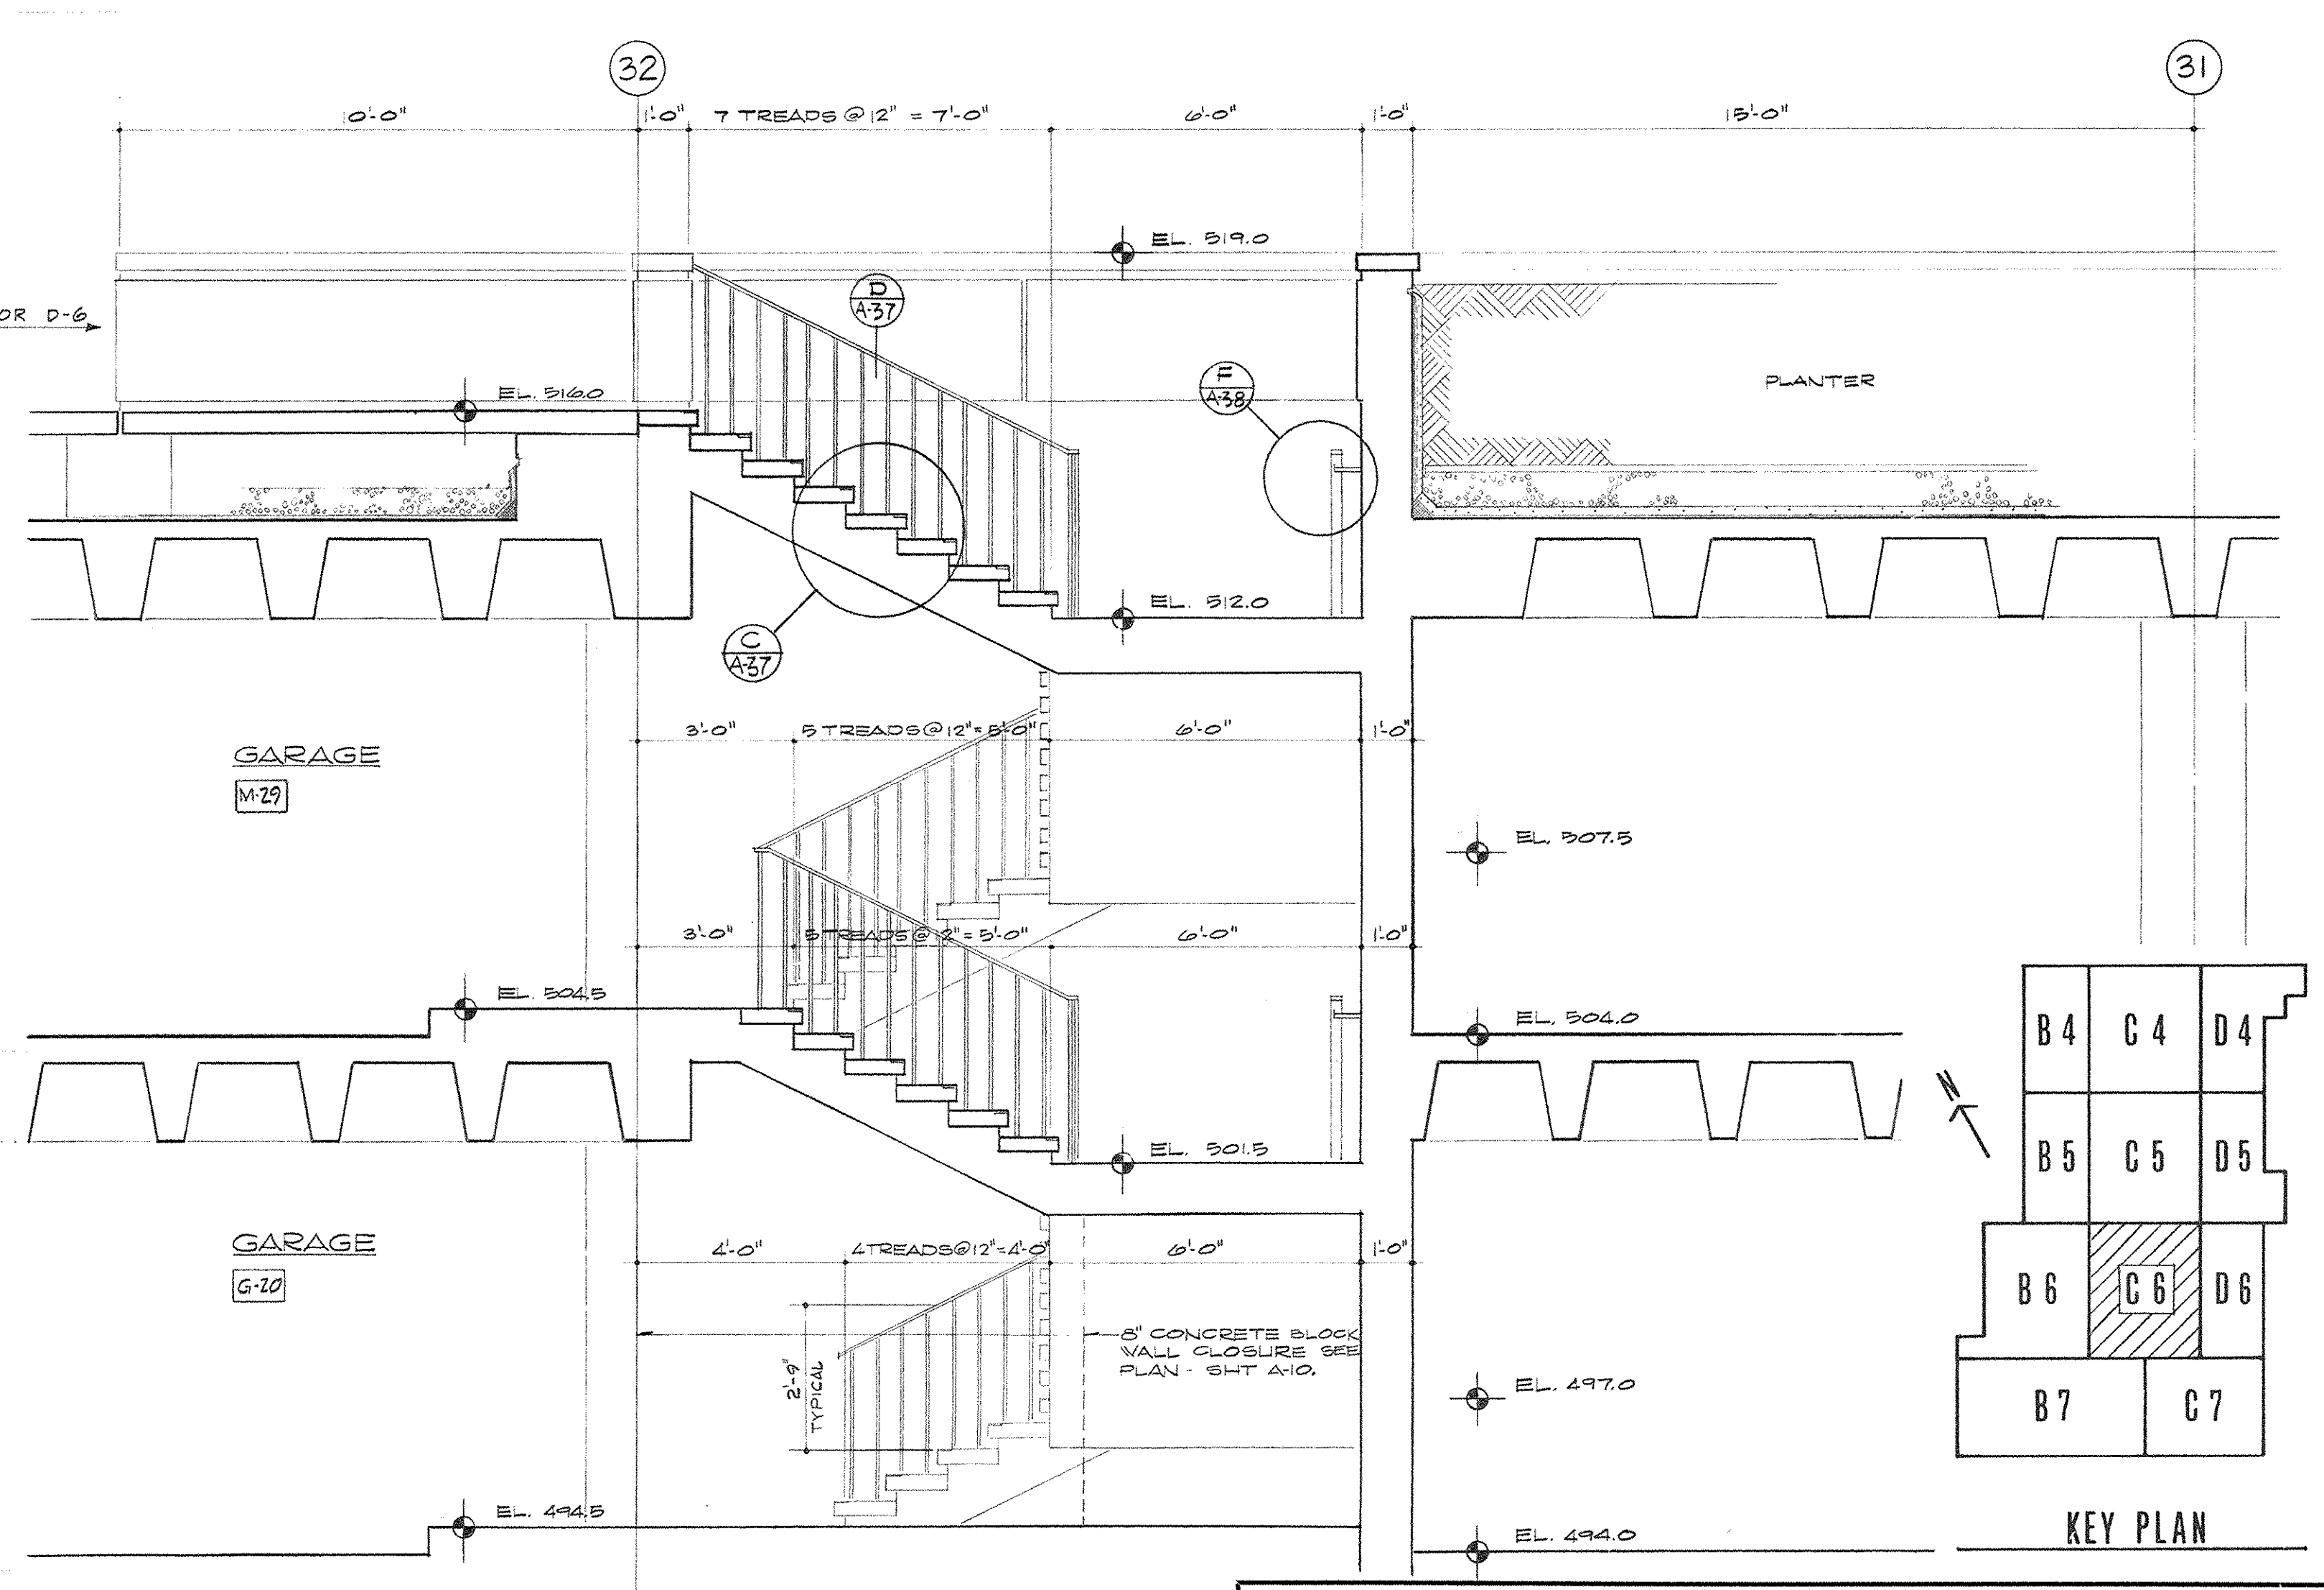

SECTION B-B STAIRS S-11
SCALE 3/8" = 1'-0"

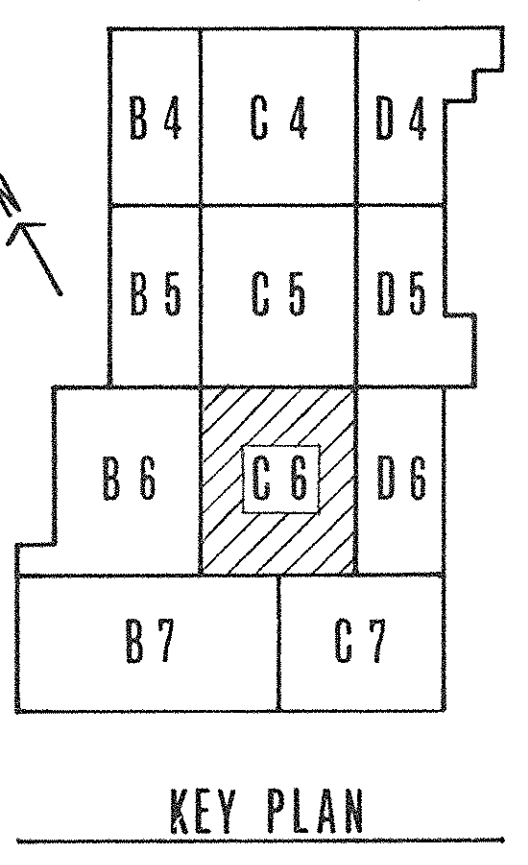


KEY PLAN

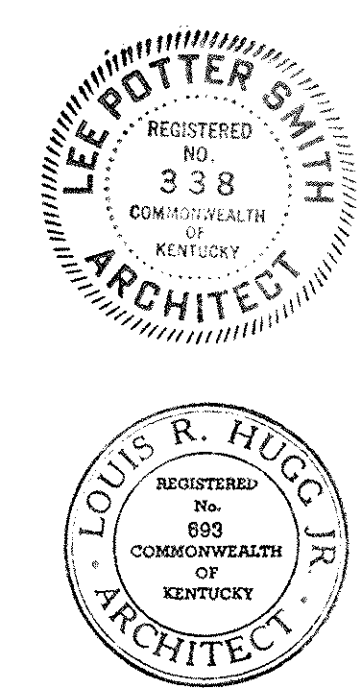


CAPITAL PLAZA DEVELOPMENT PHASE II
FRANKFORT, KENTUCKY

DRAWN BY L.S. & M.H.	DATE 10.09.1967
CHECKED BY L.R.H.	COMM. NO. 50367
SECTOR NO. C 6 CPA-4	DRAWING NO. A 22 OF A 42
LEE POTTER SMITH, PRITCHETT, HUGG & CARTER ARCHITECTS ENGINEERS 314 WILKINSON STREET FRANKFORT, KENTUCKY COMMONWEALTH OF KENTUCKY DEPARTMENT OF FINANCE - DIVISION OF ENGINEERING FRANKFORT KENTUCKY	
APPROVED BY AGENCY HEAD <i>Mr. Connally</i>	DATE 10.10.67
APPROVED BY OWNER	


AS BUILT REVISIONS - 3.24.72

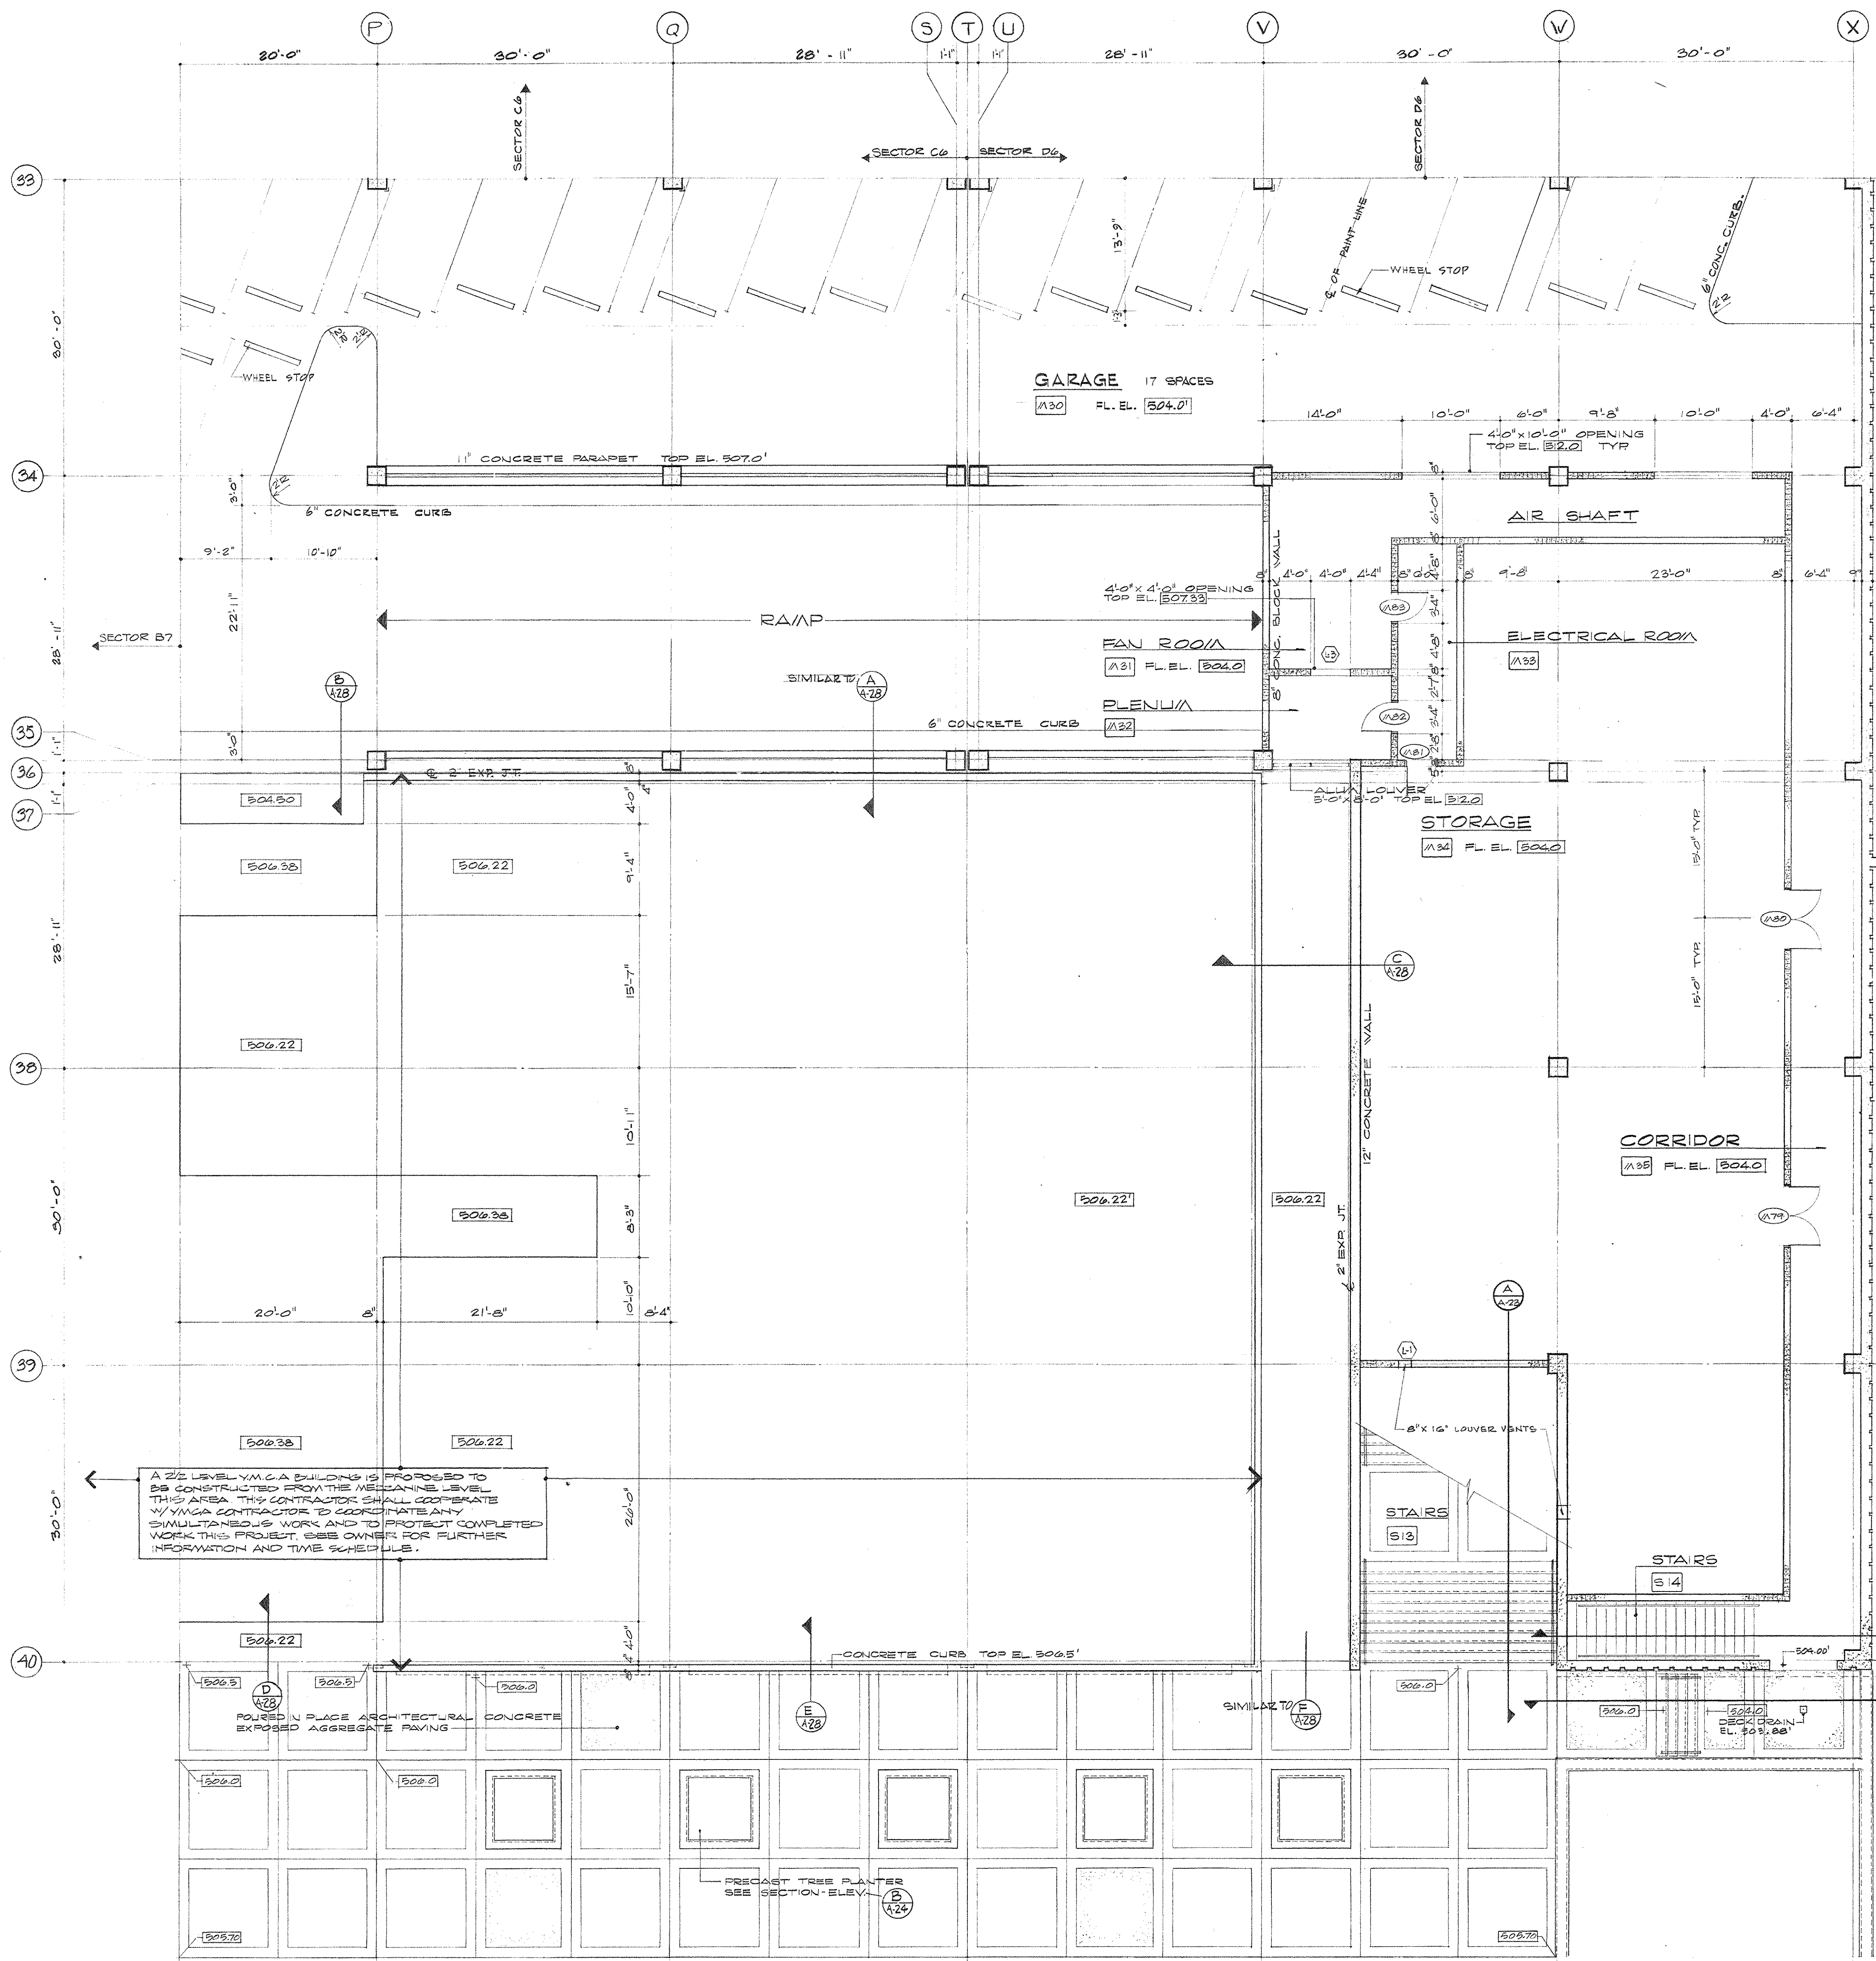


MEZZANINE LEVEL PLAN SECTOR C-7
SCALE 1/8" = 1'-0"

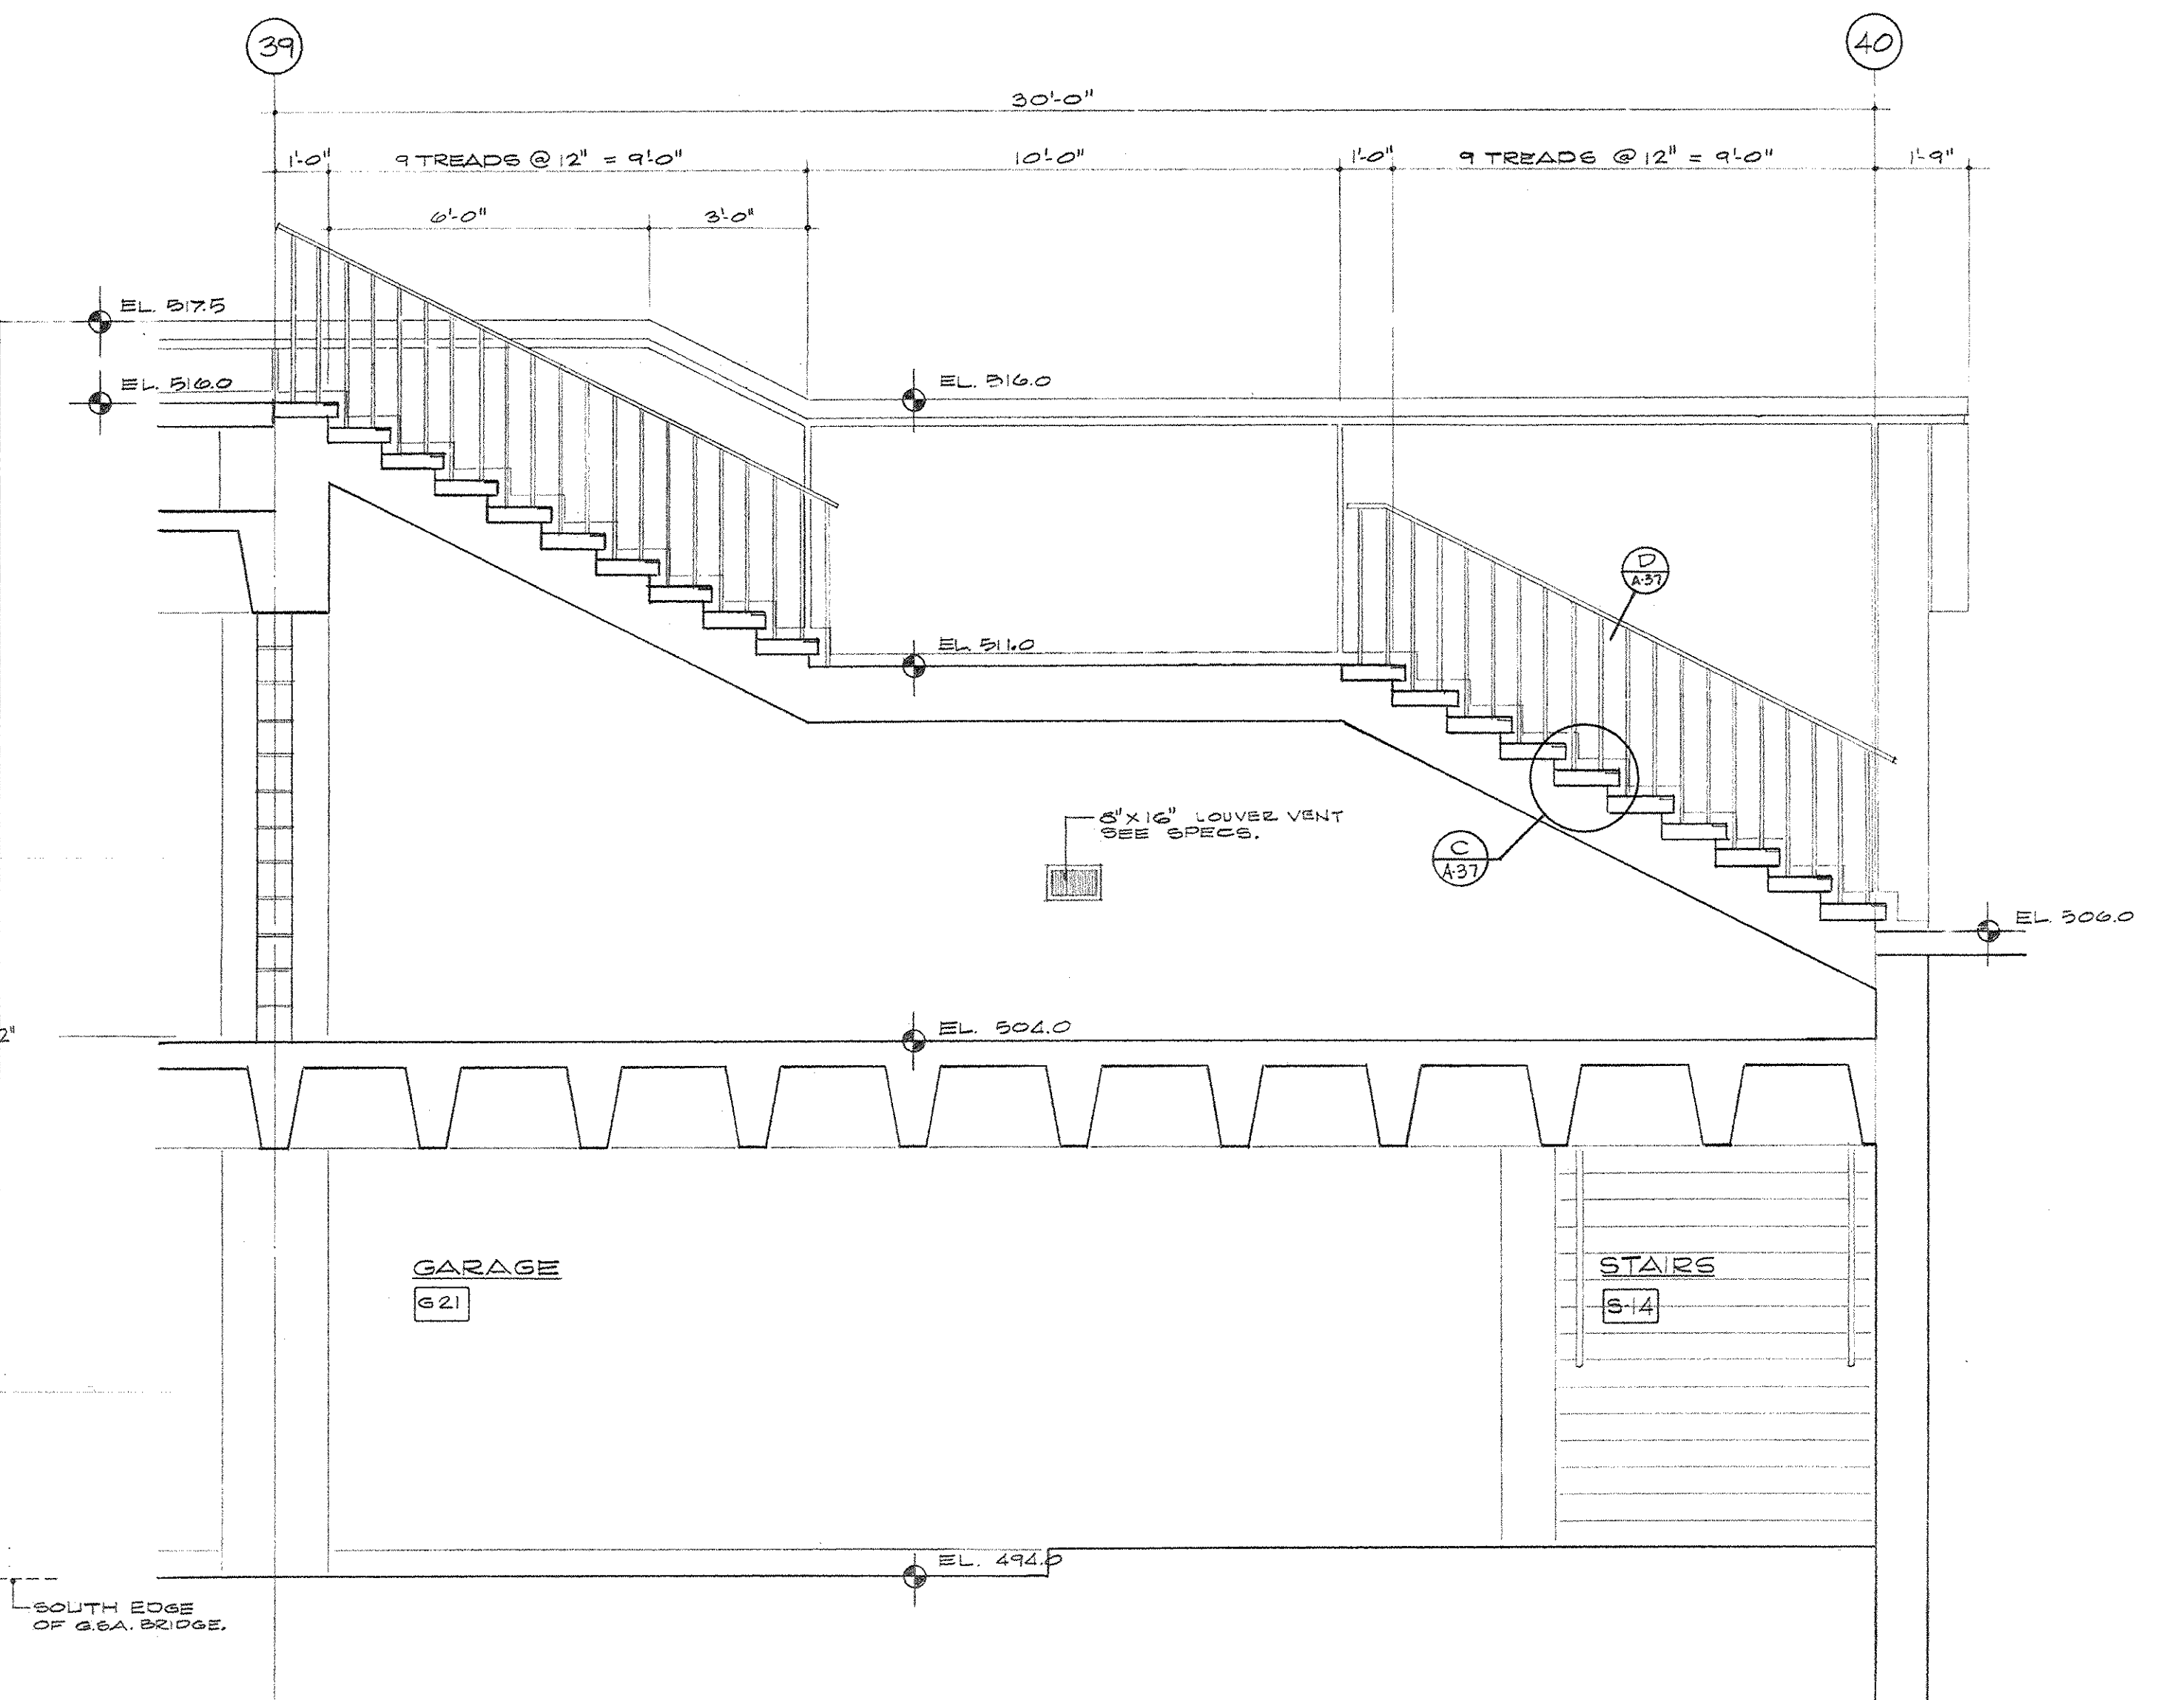

SECTION A-A STAIRS S-13
SCALE 3/8" = 1'-0"


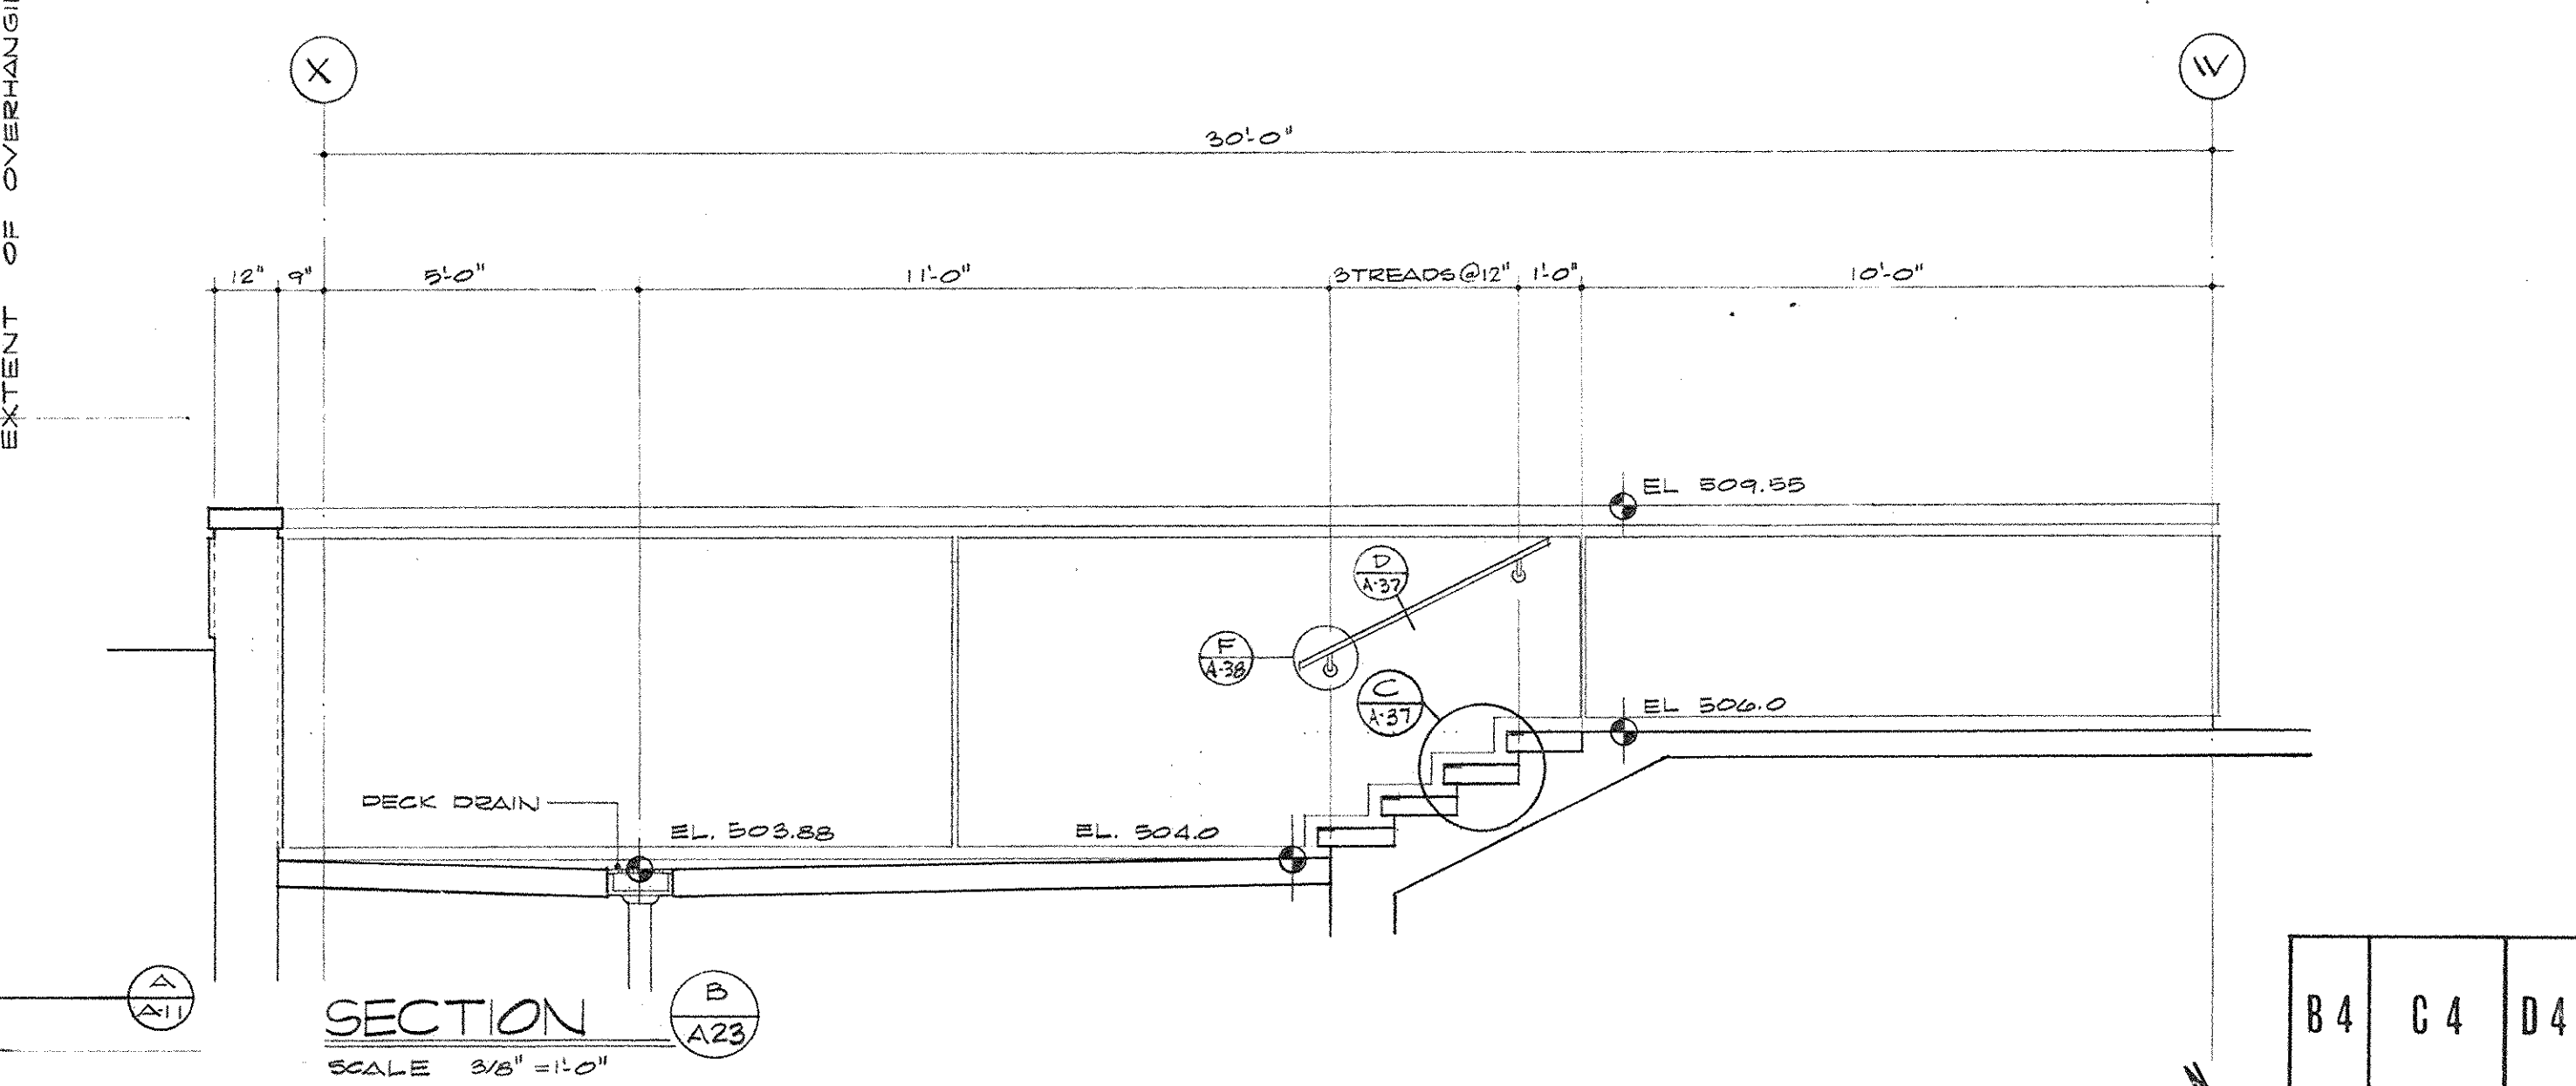


SECTION B-B
SCALE 3/8" = 1'-0"


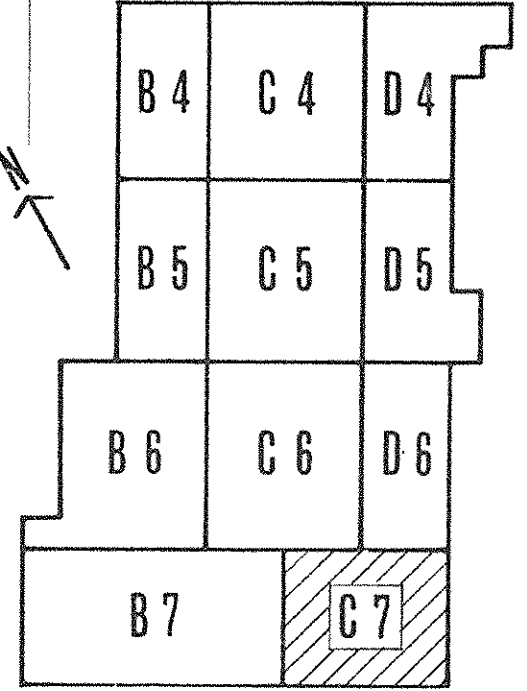


KEY PLAN


AS BUILT REVISIONS - 8-24-72

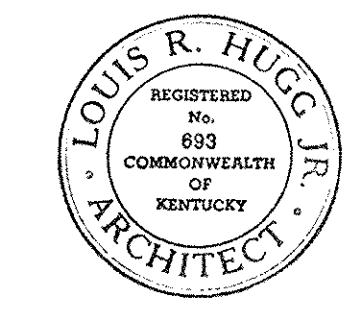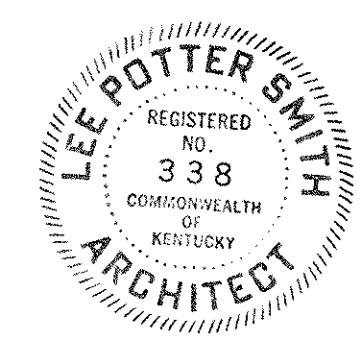


CAPITAL PLAZA DEVELOPMENT PHASE II FRANKFORT, KENTUCKY		
DRAWN BY L.P.S. N.T.	MEZZANINE LEVEL PLAN	DATE OCT. 1967
CHECKED BY L.P.S.		COMM. NO. 50387
SECTOR NO. C 7	LEE POTTER SMITH, PRITCHETT, HUGG & CARTER ARCHITECTS 214 WILKINSON STREET FRANKFORT, KENTUCKY	DRAWING NO. A 23 OF A-22
APPROVED BY AGENCY HEAD	COMMONWEALTH OF KENTUCKY DEPARTMENT OF FINANCE - DIVISION OF ENGINEERING FRANKFORT, KENTUCKY	DATE
APPROVED BY OWNER		DATE 10-26-67

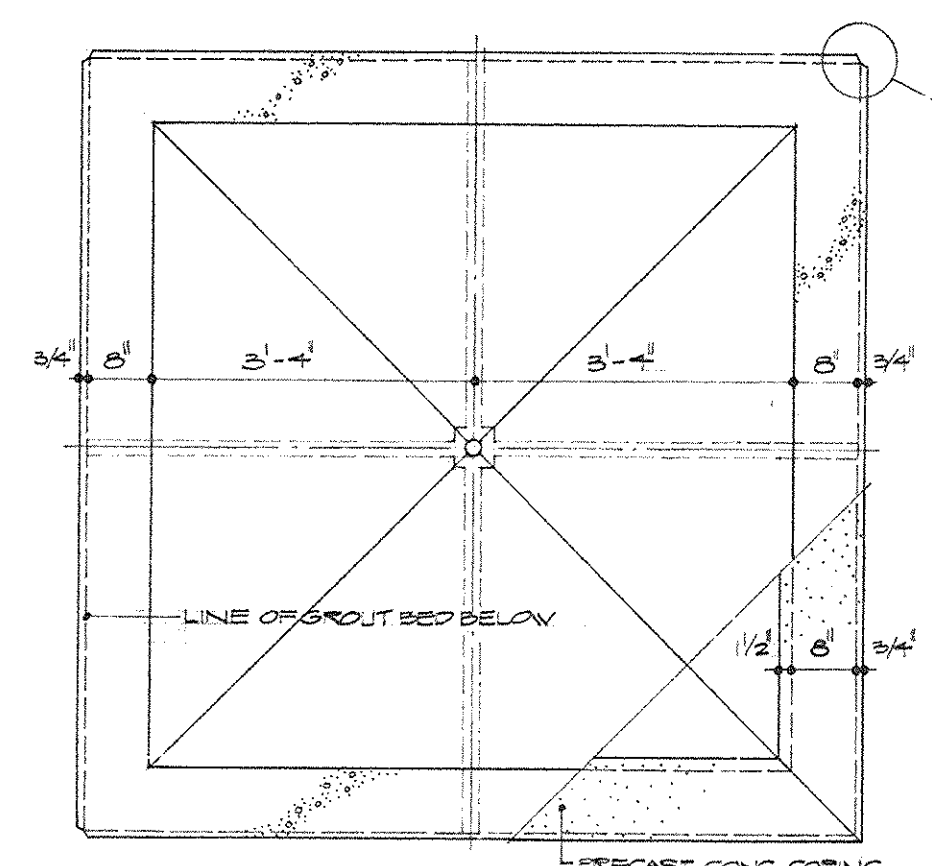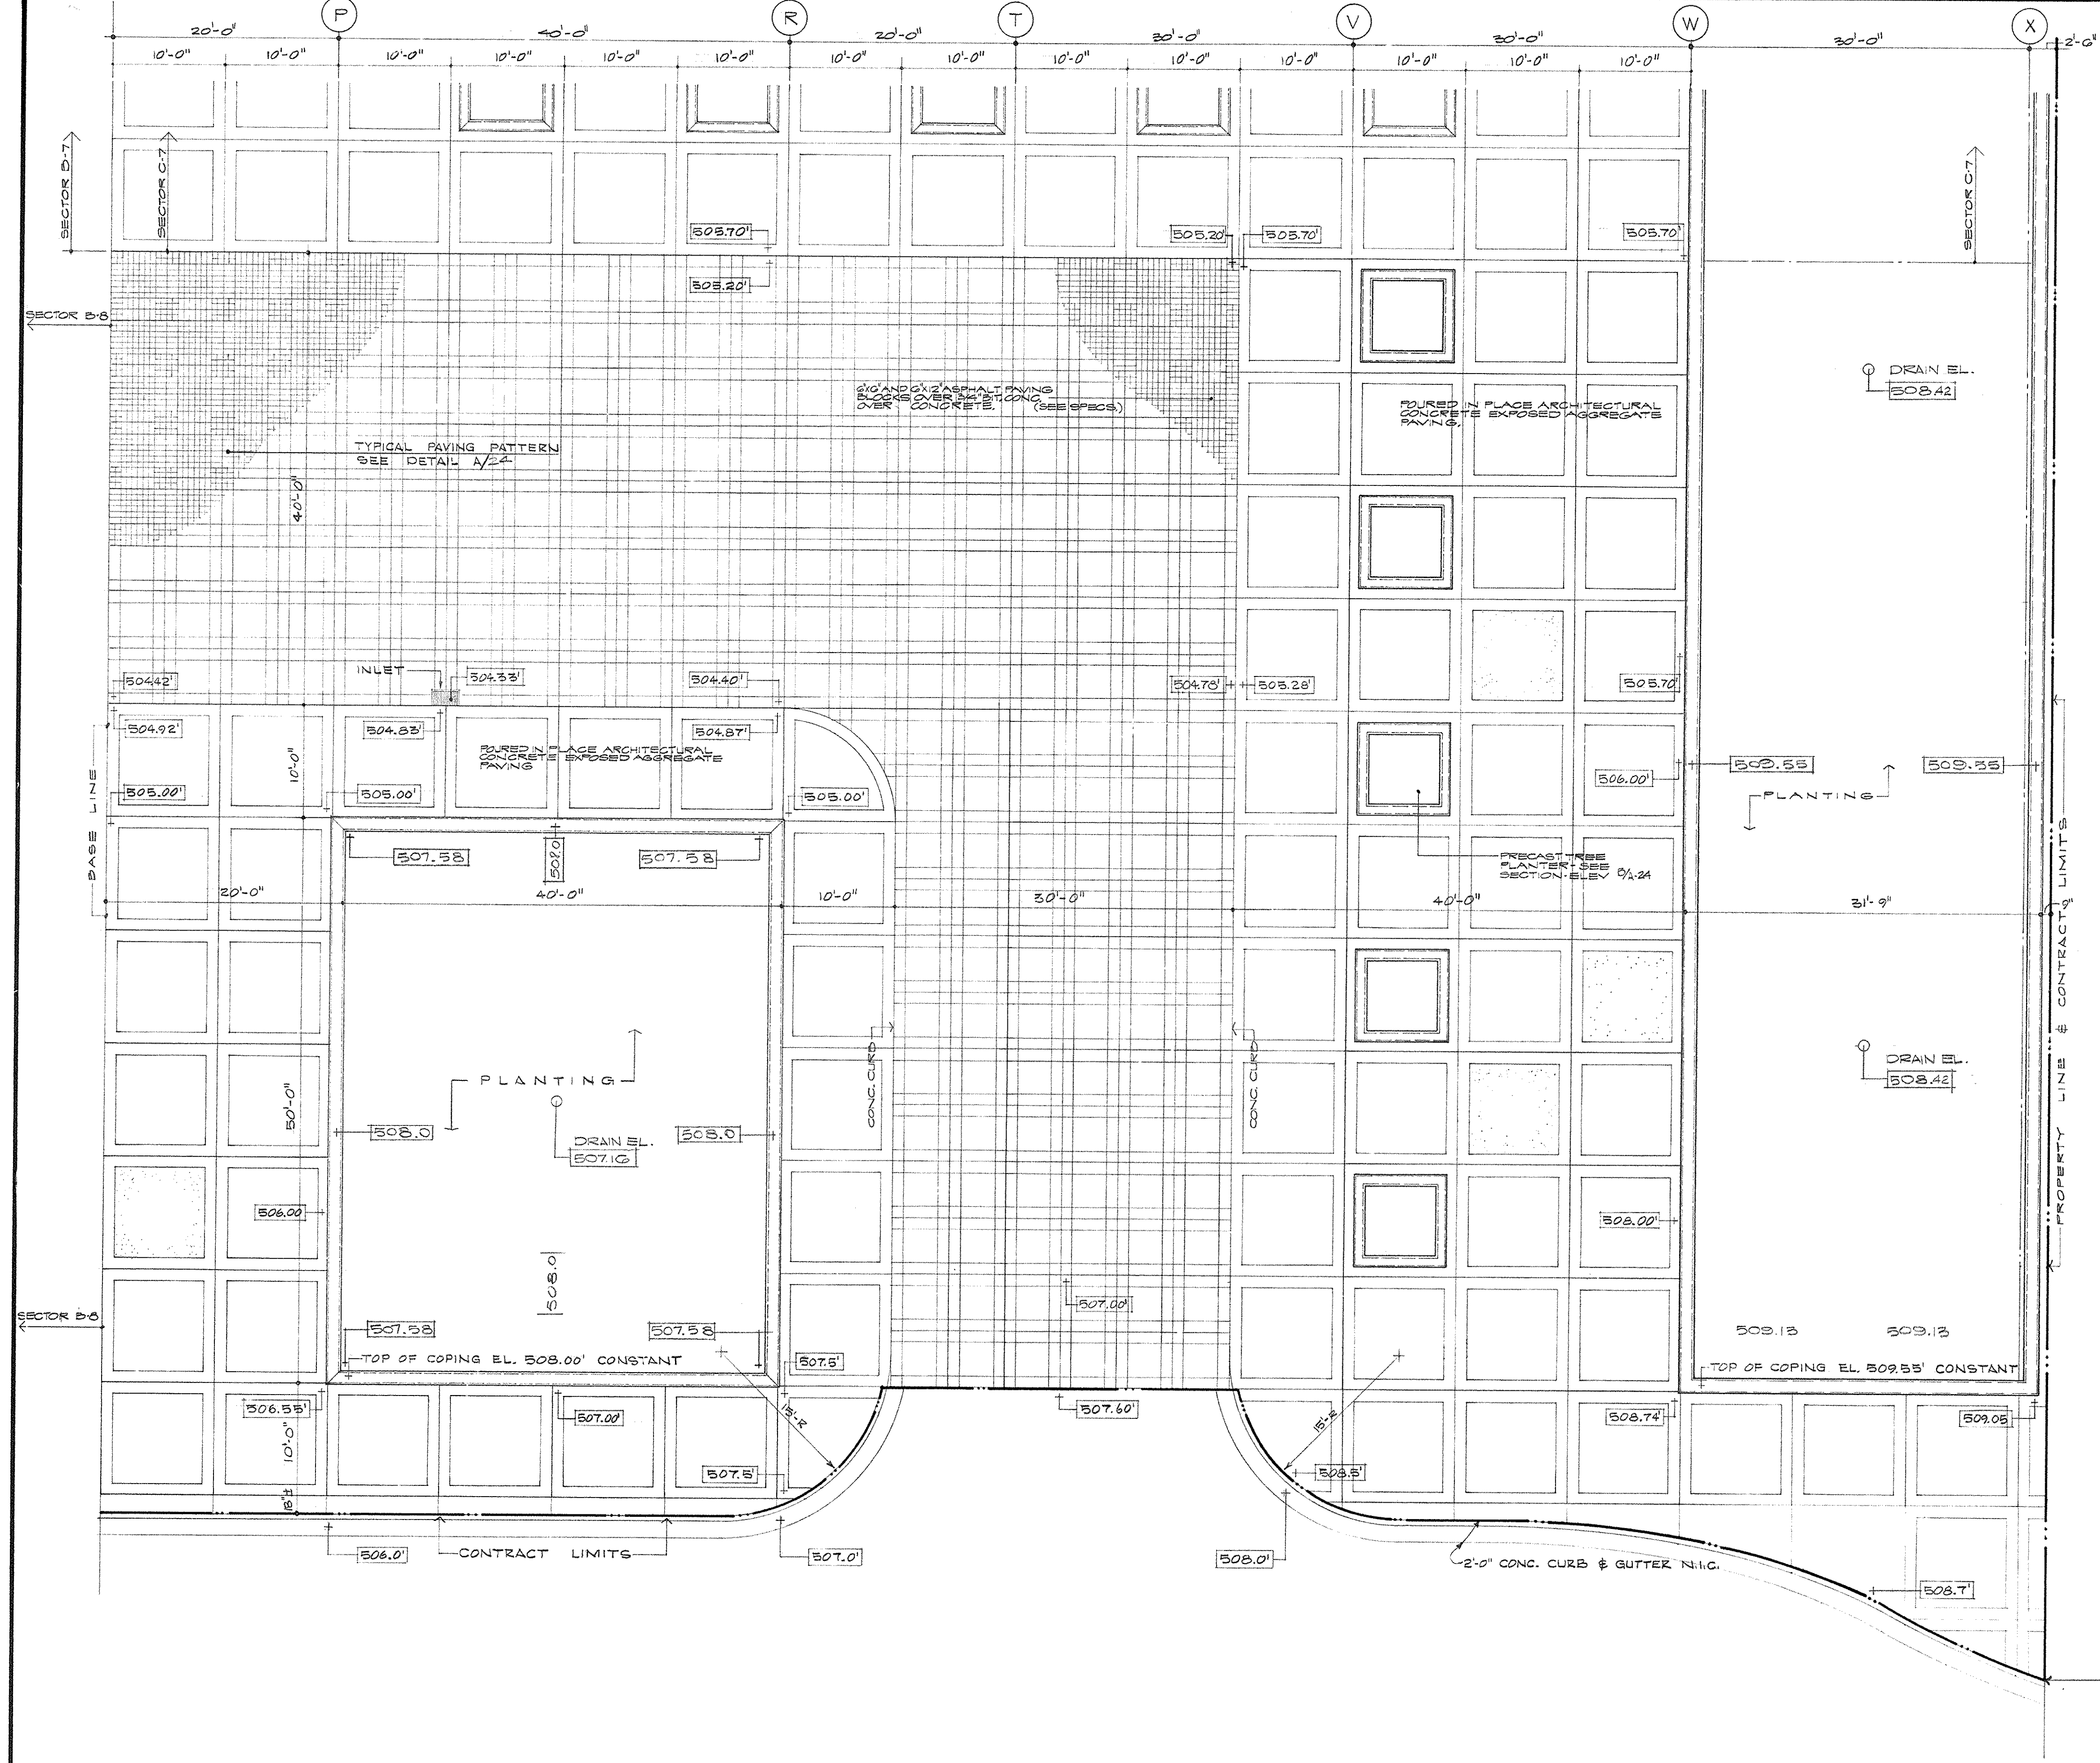

PLAN
SCALE 1/2" = 1'-0"

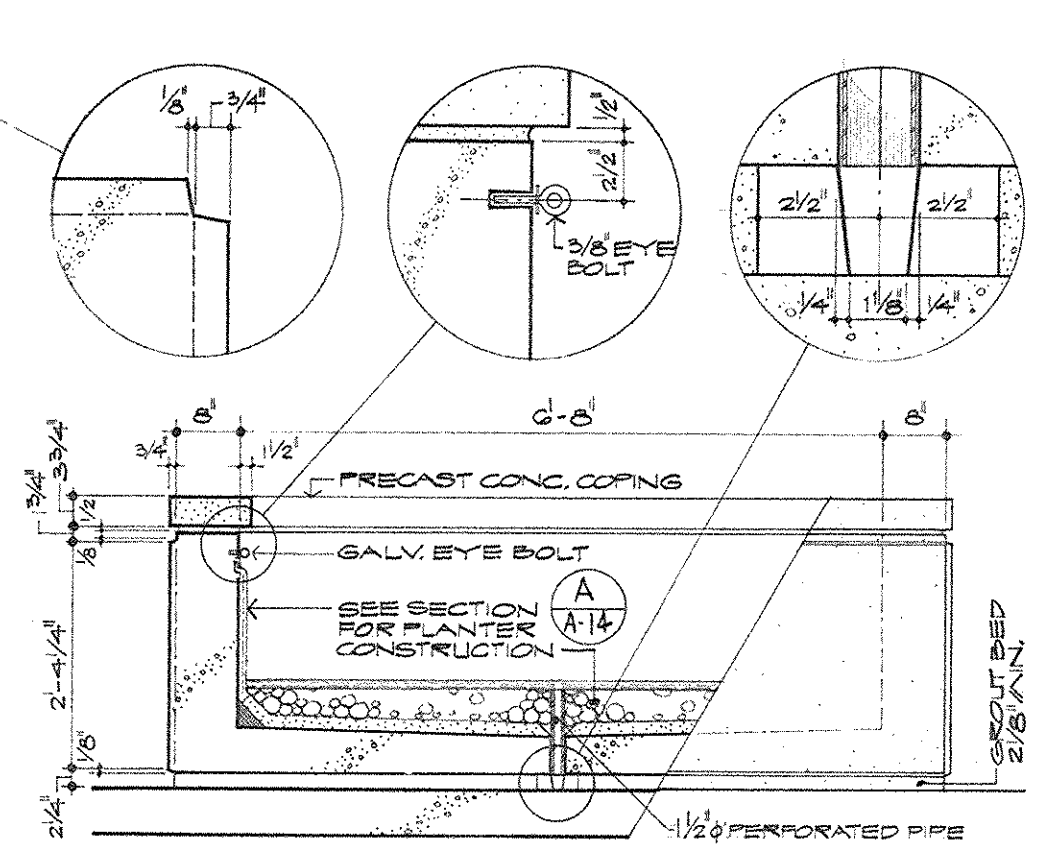


ELEV. SECTION
SCALE 1/2" = 1'-0"

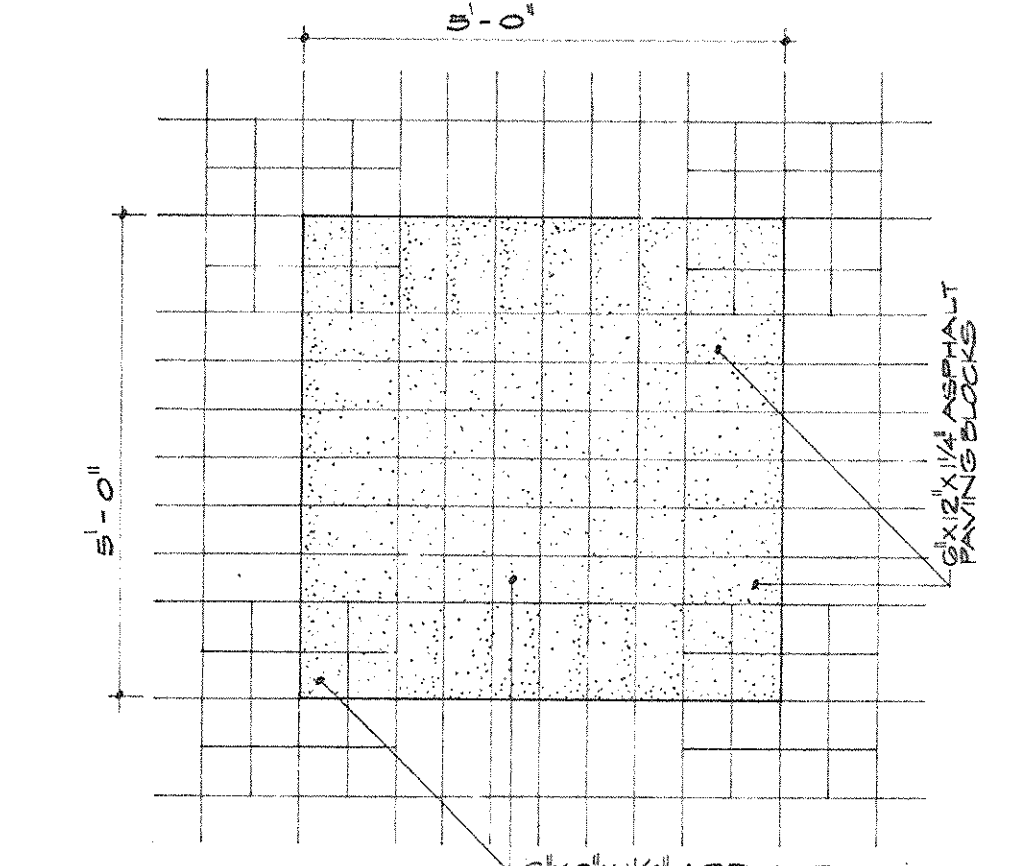


DETAIL
SCALE 1/2" = 1'-0"

BROADWAY



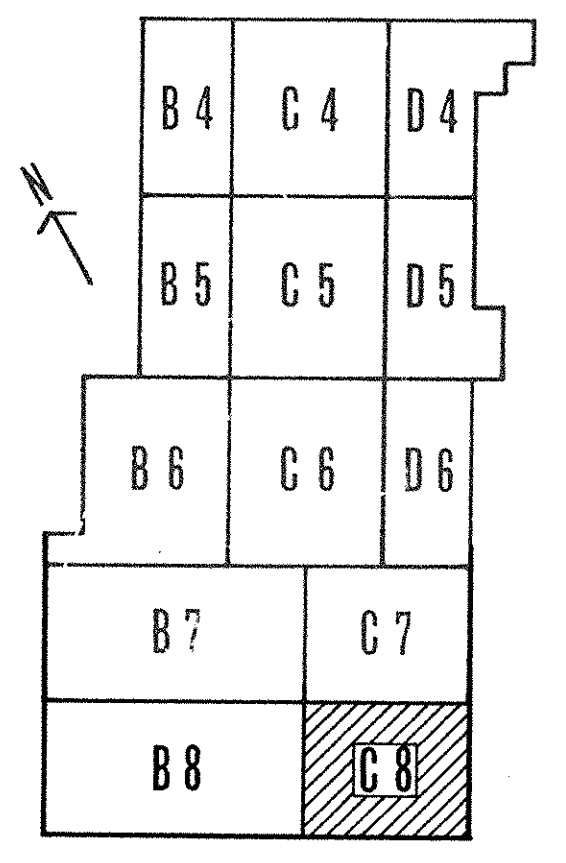


KEY PLAN

AS BUILT REVISIONS 8-23-72

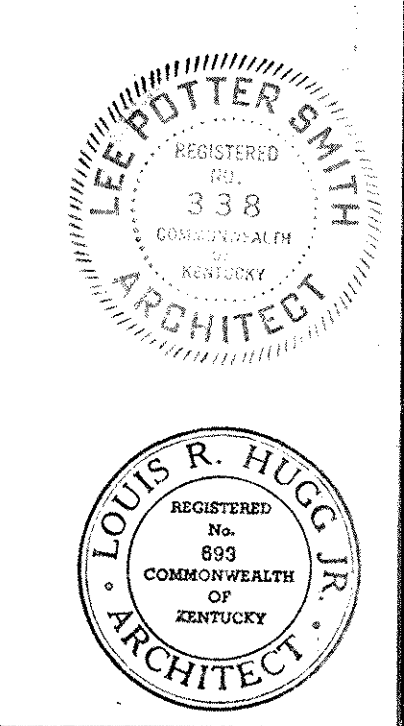






CAPITAL PLAZA DEVELOPMENT PHASE II		
FRANKFORT, KENTUCKY		
DRAWN BY J.B., M.D.	MEZZANINE LEVEL PLAN	DATE OCT. 1967
CHECKED BY L.S.H.		COMM. NO. 50387
SECTOR NO. C 8	LEE POTTER SMITH, PRITCHETT, HUGG & CARTER ARCHITECTS 314 WILKINSON STREET FRANKFORT, KENTUCKY	DRAWING NO. A 24
COMMONWEALTH OF KENTUCKY DEPARTMENT OF FINANCE - DIVISION OF ENGINEERING FRANKFORT, KENTUCKY		OF A-42
APPROVED BY AGENCY HEAD	<i>W. M. ...</i>	DATE 10-26-67
APPROVED BY OWNER		

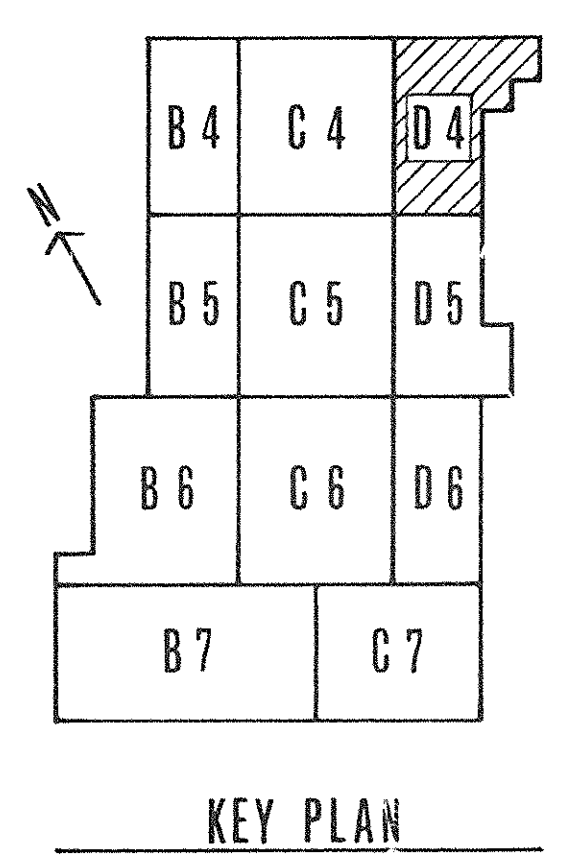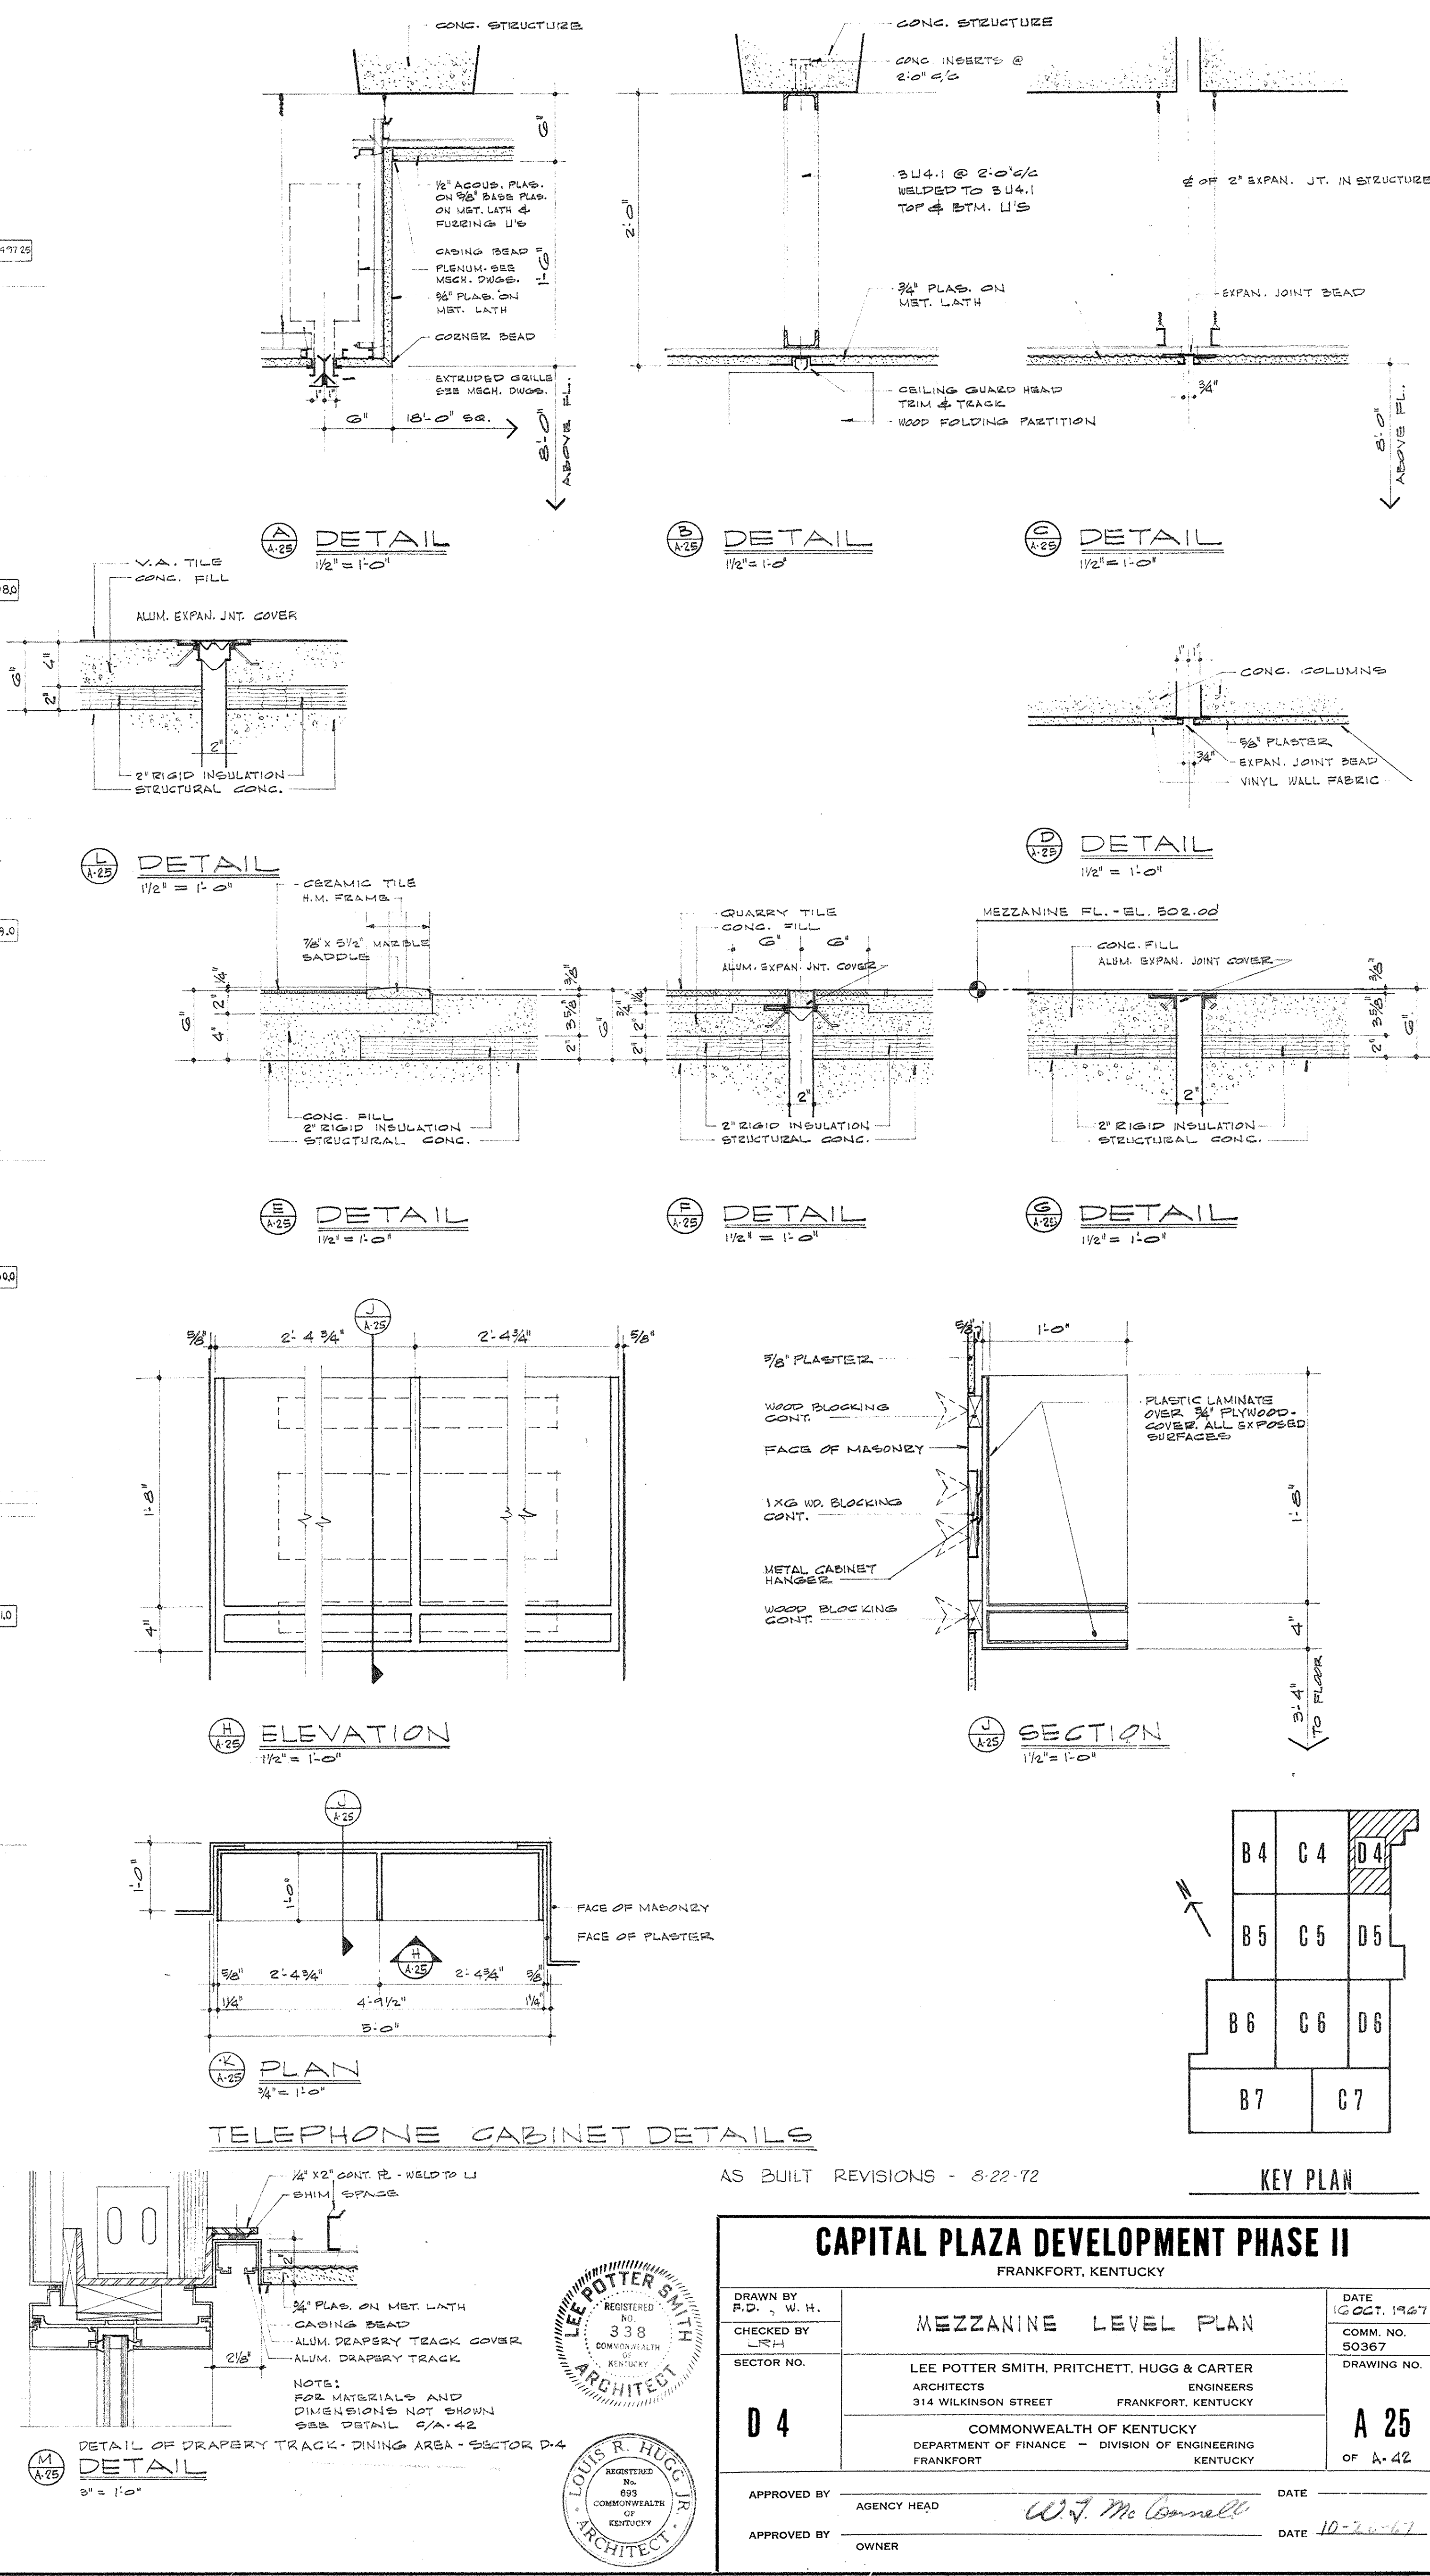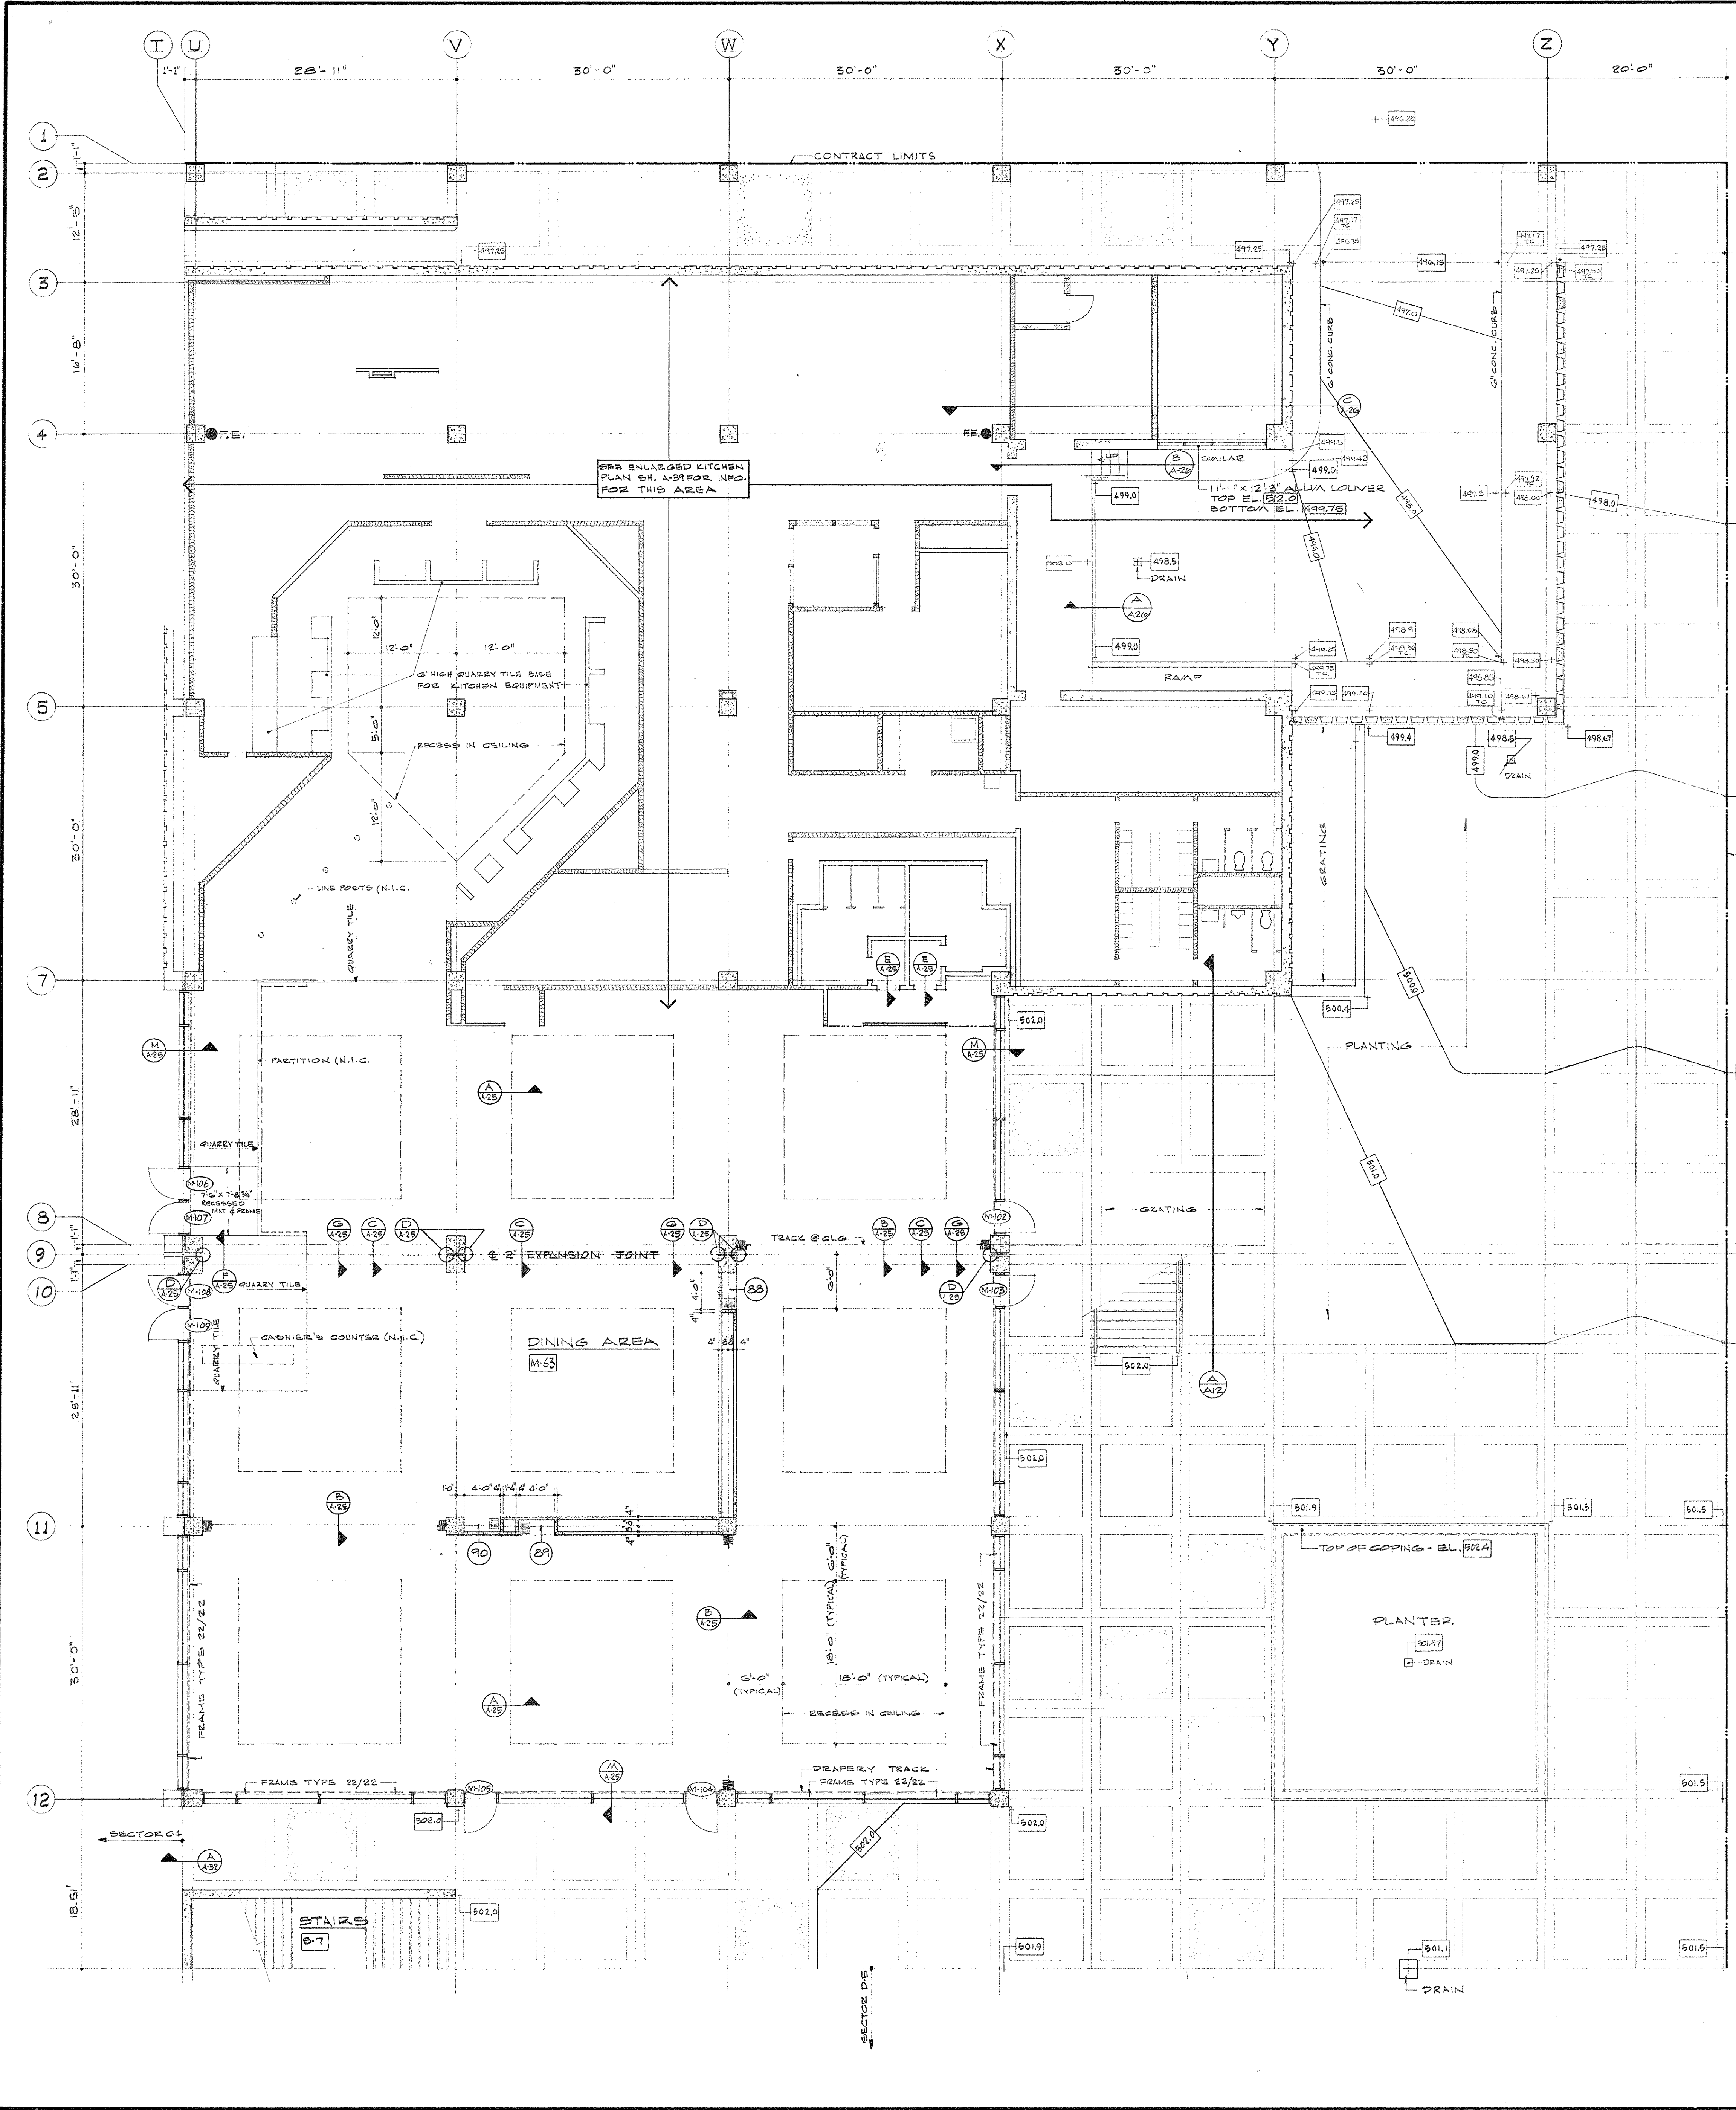


AS BUILT REVISIONS - 8-22-72

CAPITAL PLAZA DEVELOPMENT PHASE II FRANKFORT, KENTUCKY		
DRAWN BY P.D., W.H.	MEZZANINE LEVEL PLAN	DATE OCT. 1967
CHECKED BY L.S.A.	LEE POTTER SMITH, PRITCHETT, HUGG & CARTER ARCHITECTS 314 WILKINSON STREET FRANKFORT, KENTUCKY	COMM. NO. 50387
SECTOR NO. D 4	COMMONWEALTH OF KENTUCKY DEPARTMENT OF FINANCE - DIVISION OF ENGINEERING FRANKFORT, KENTUCKY	DRAWING NO. A 25 OF A-42
APPROVED BY AGENCY HEAD <i>W.J. Mc Connell</i>	DATE 10-20-67	

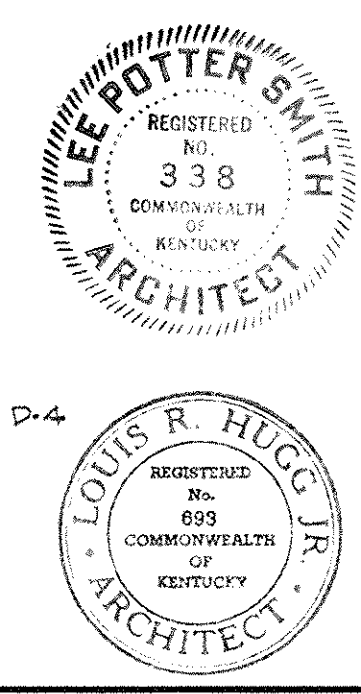

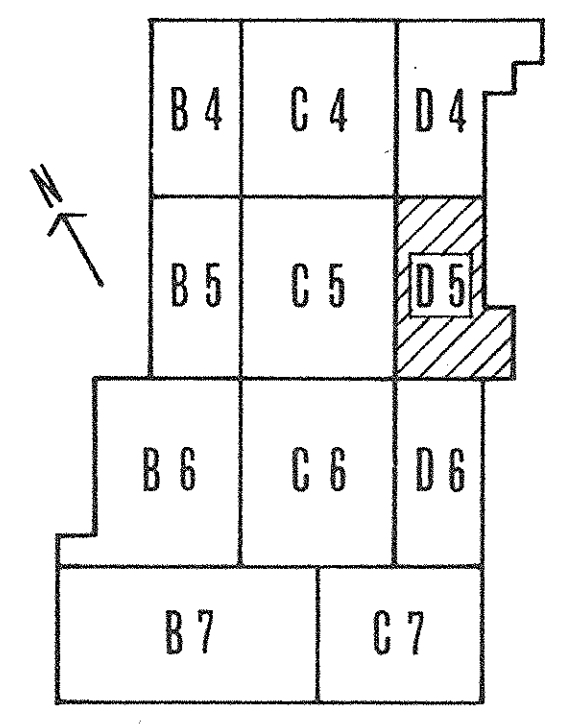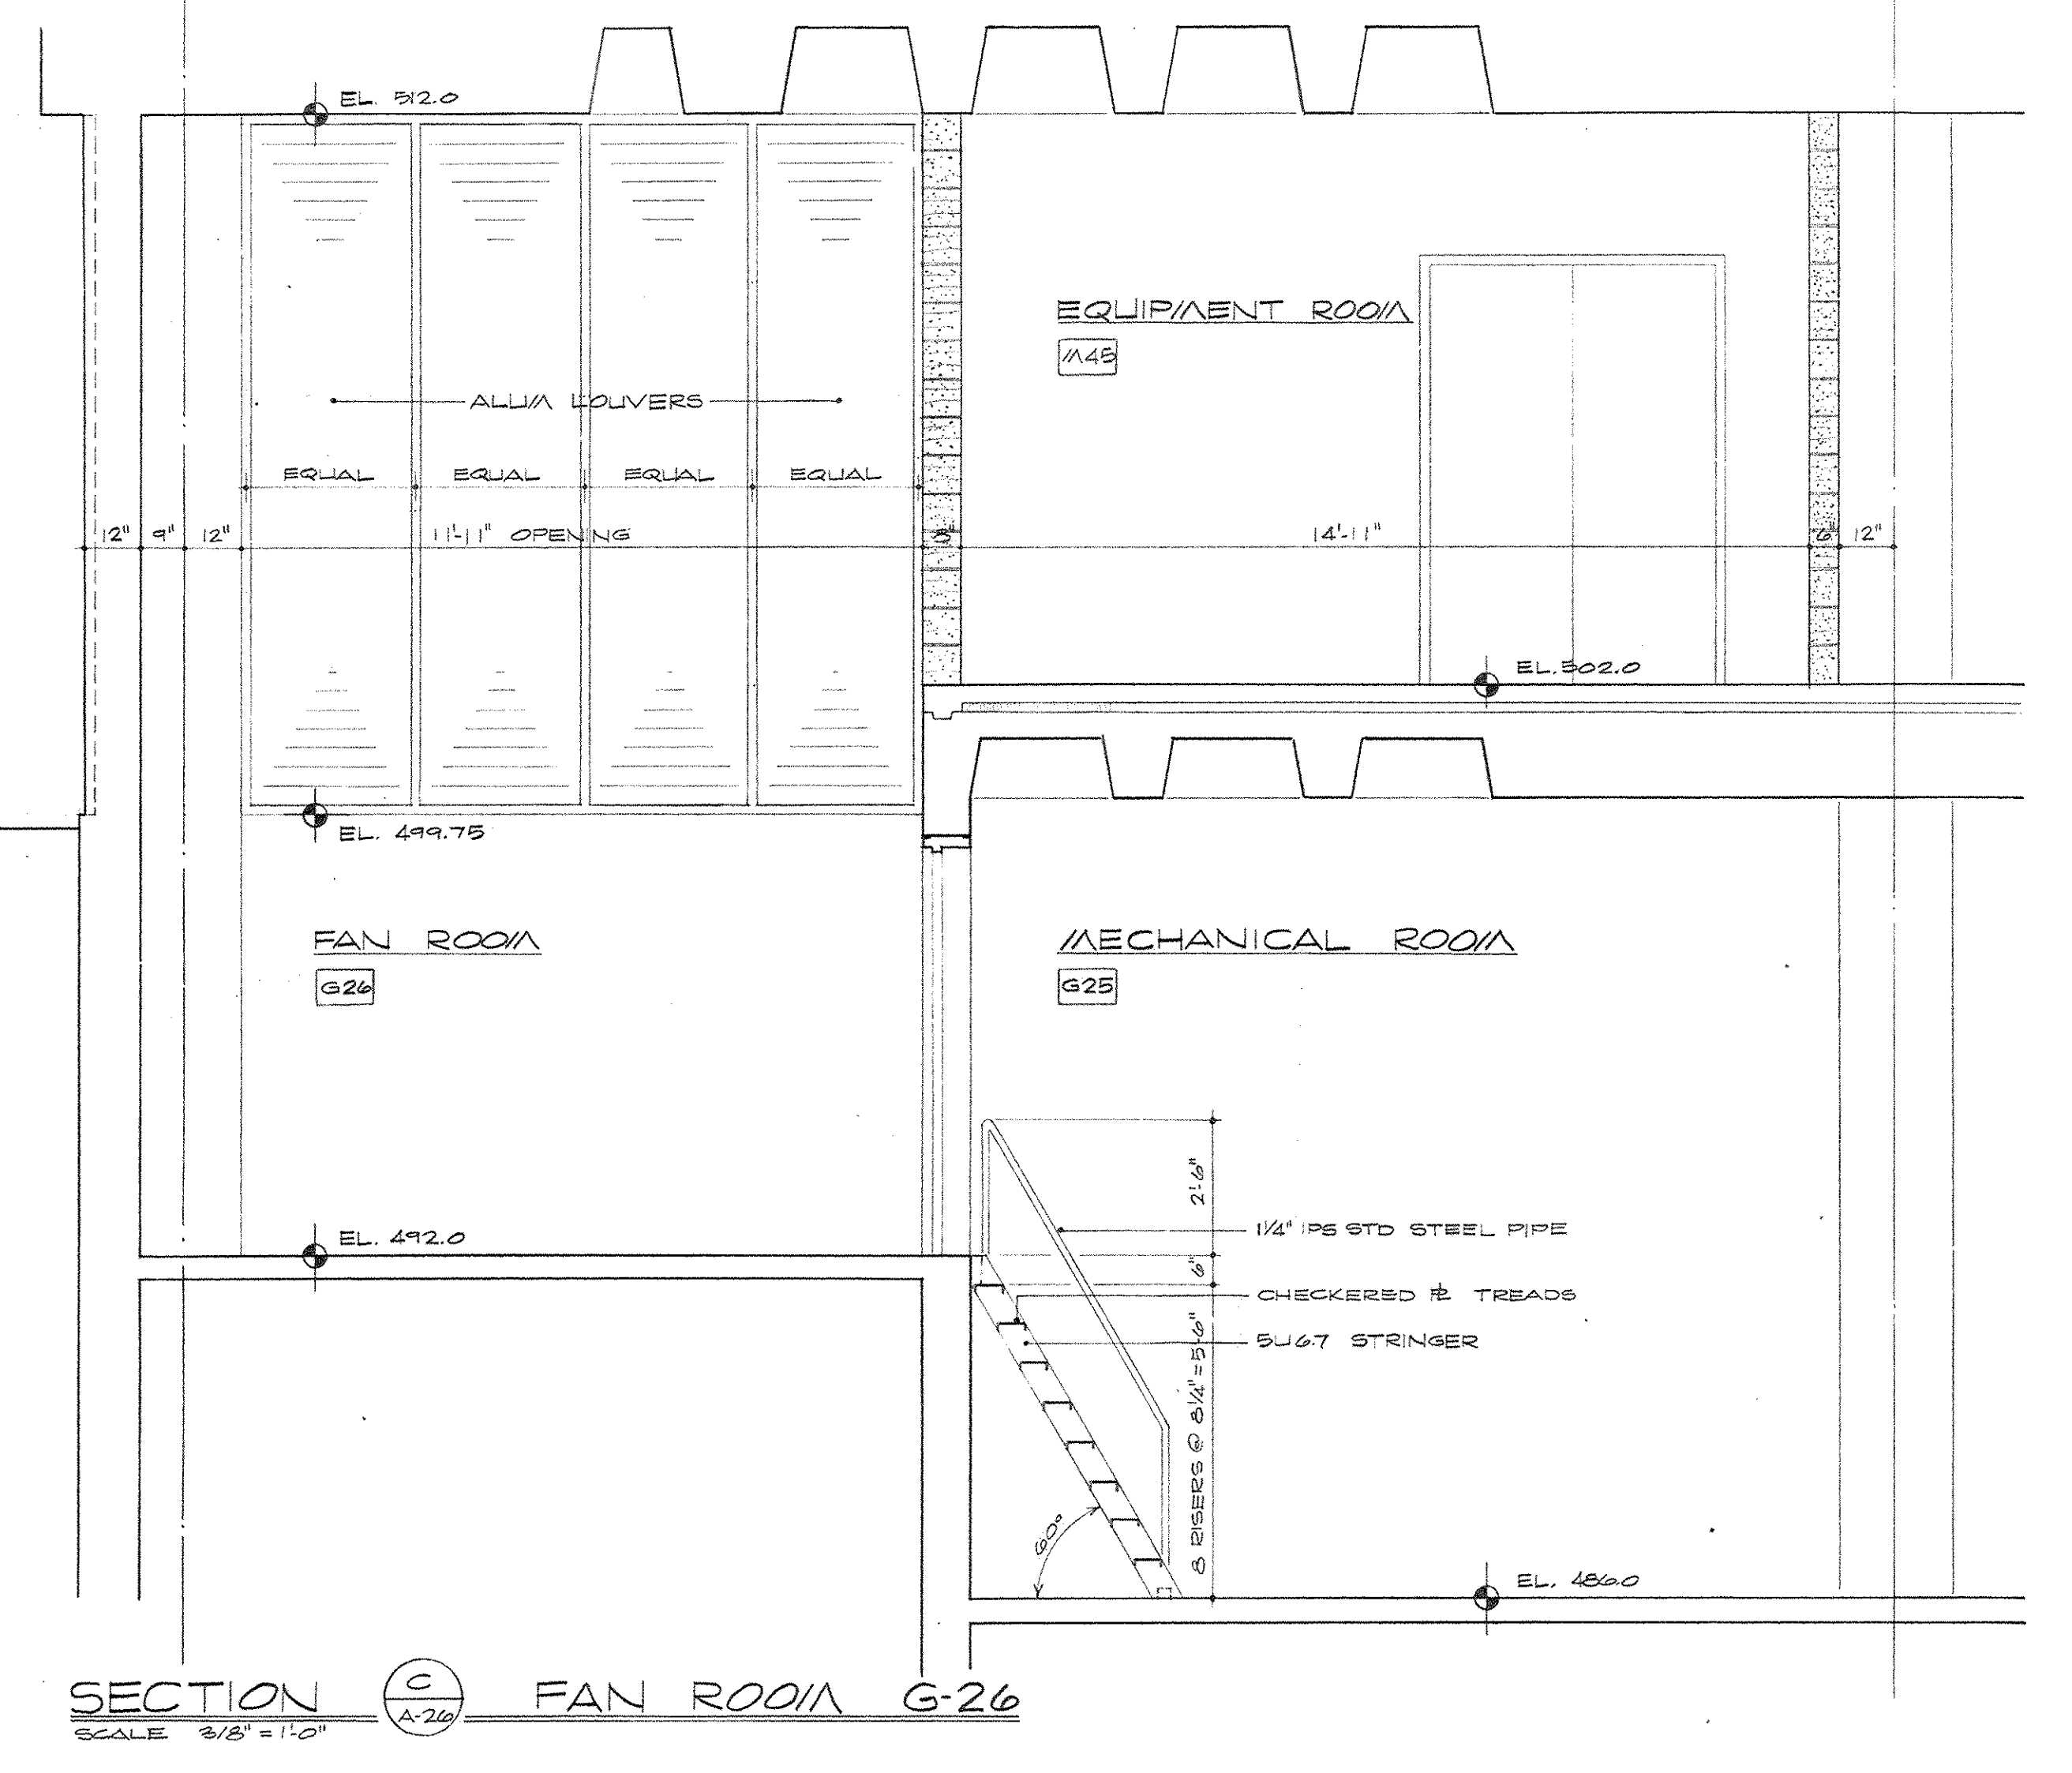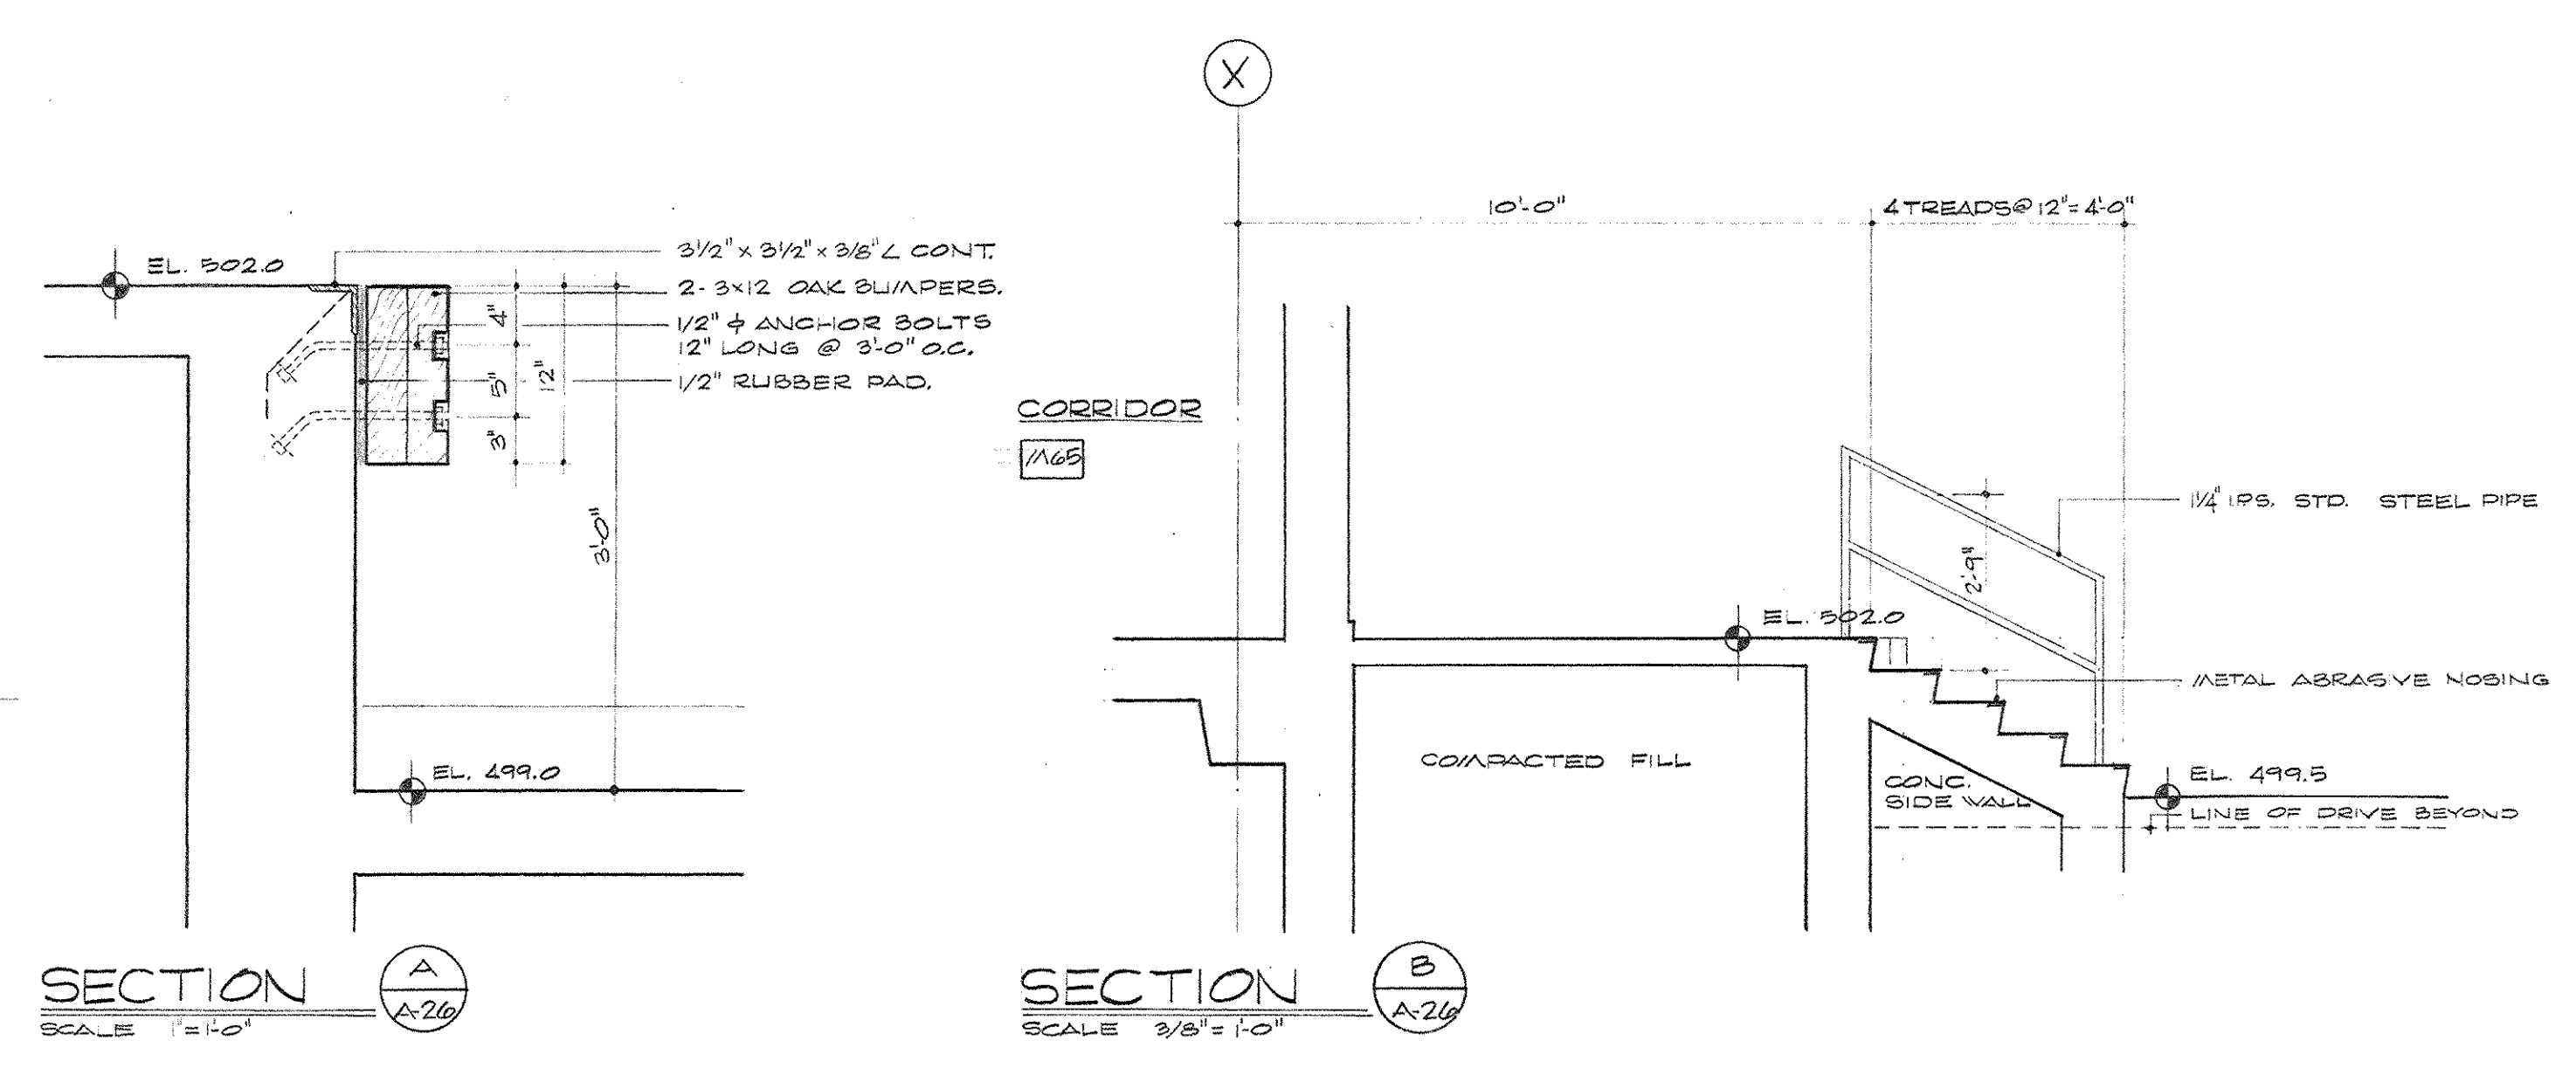
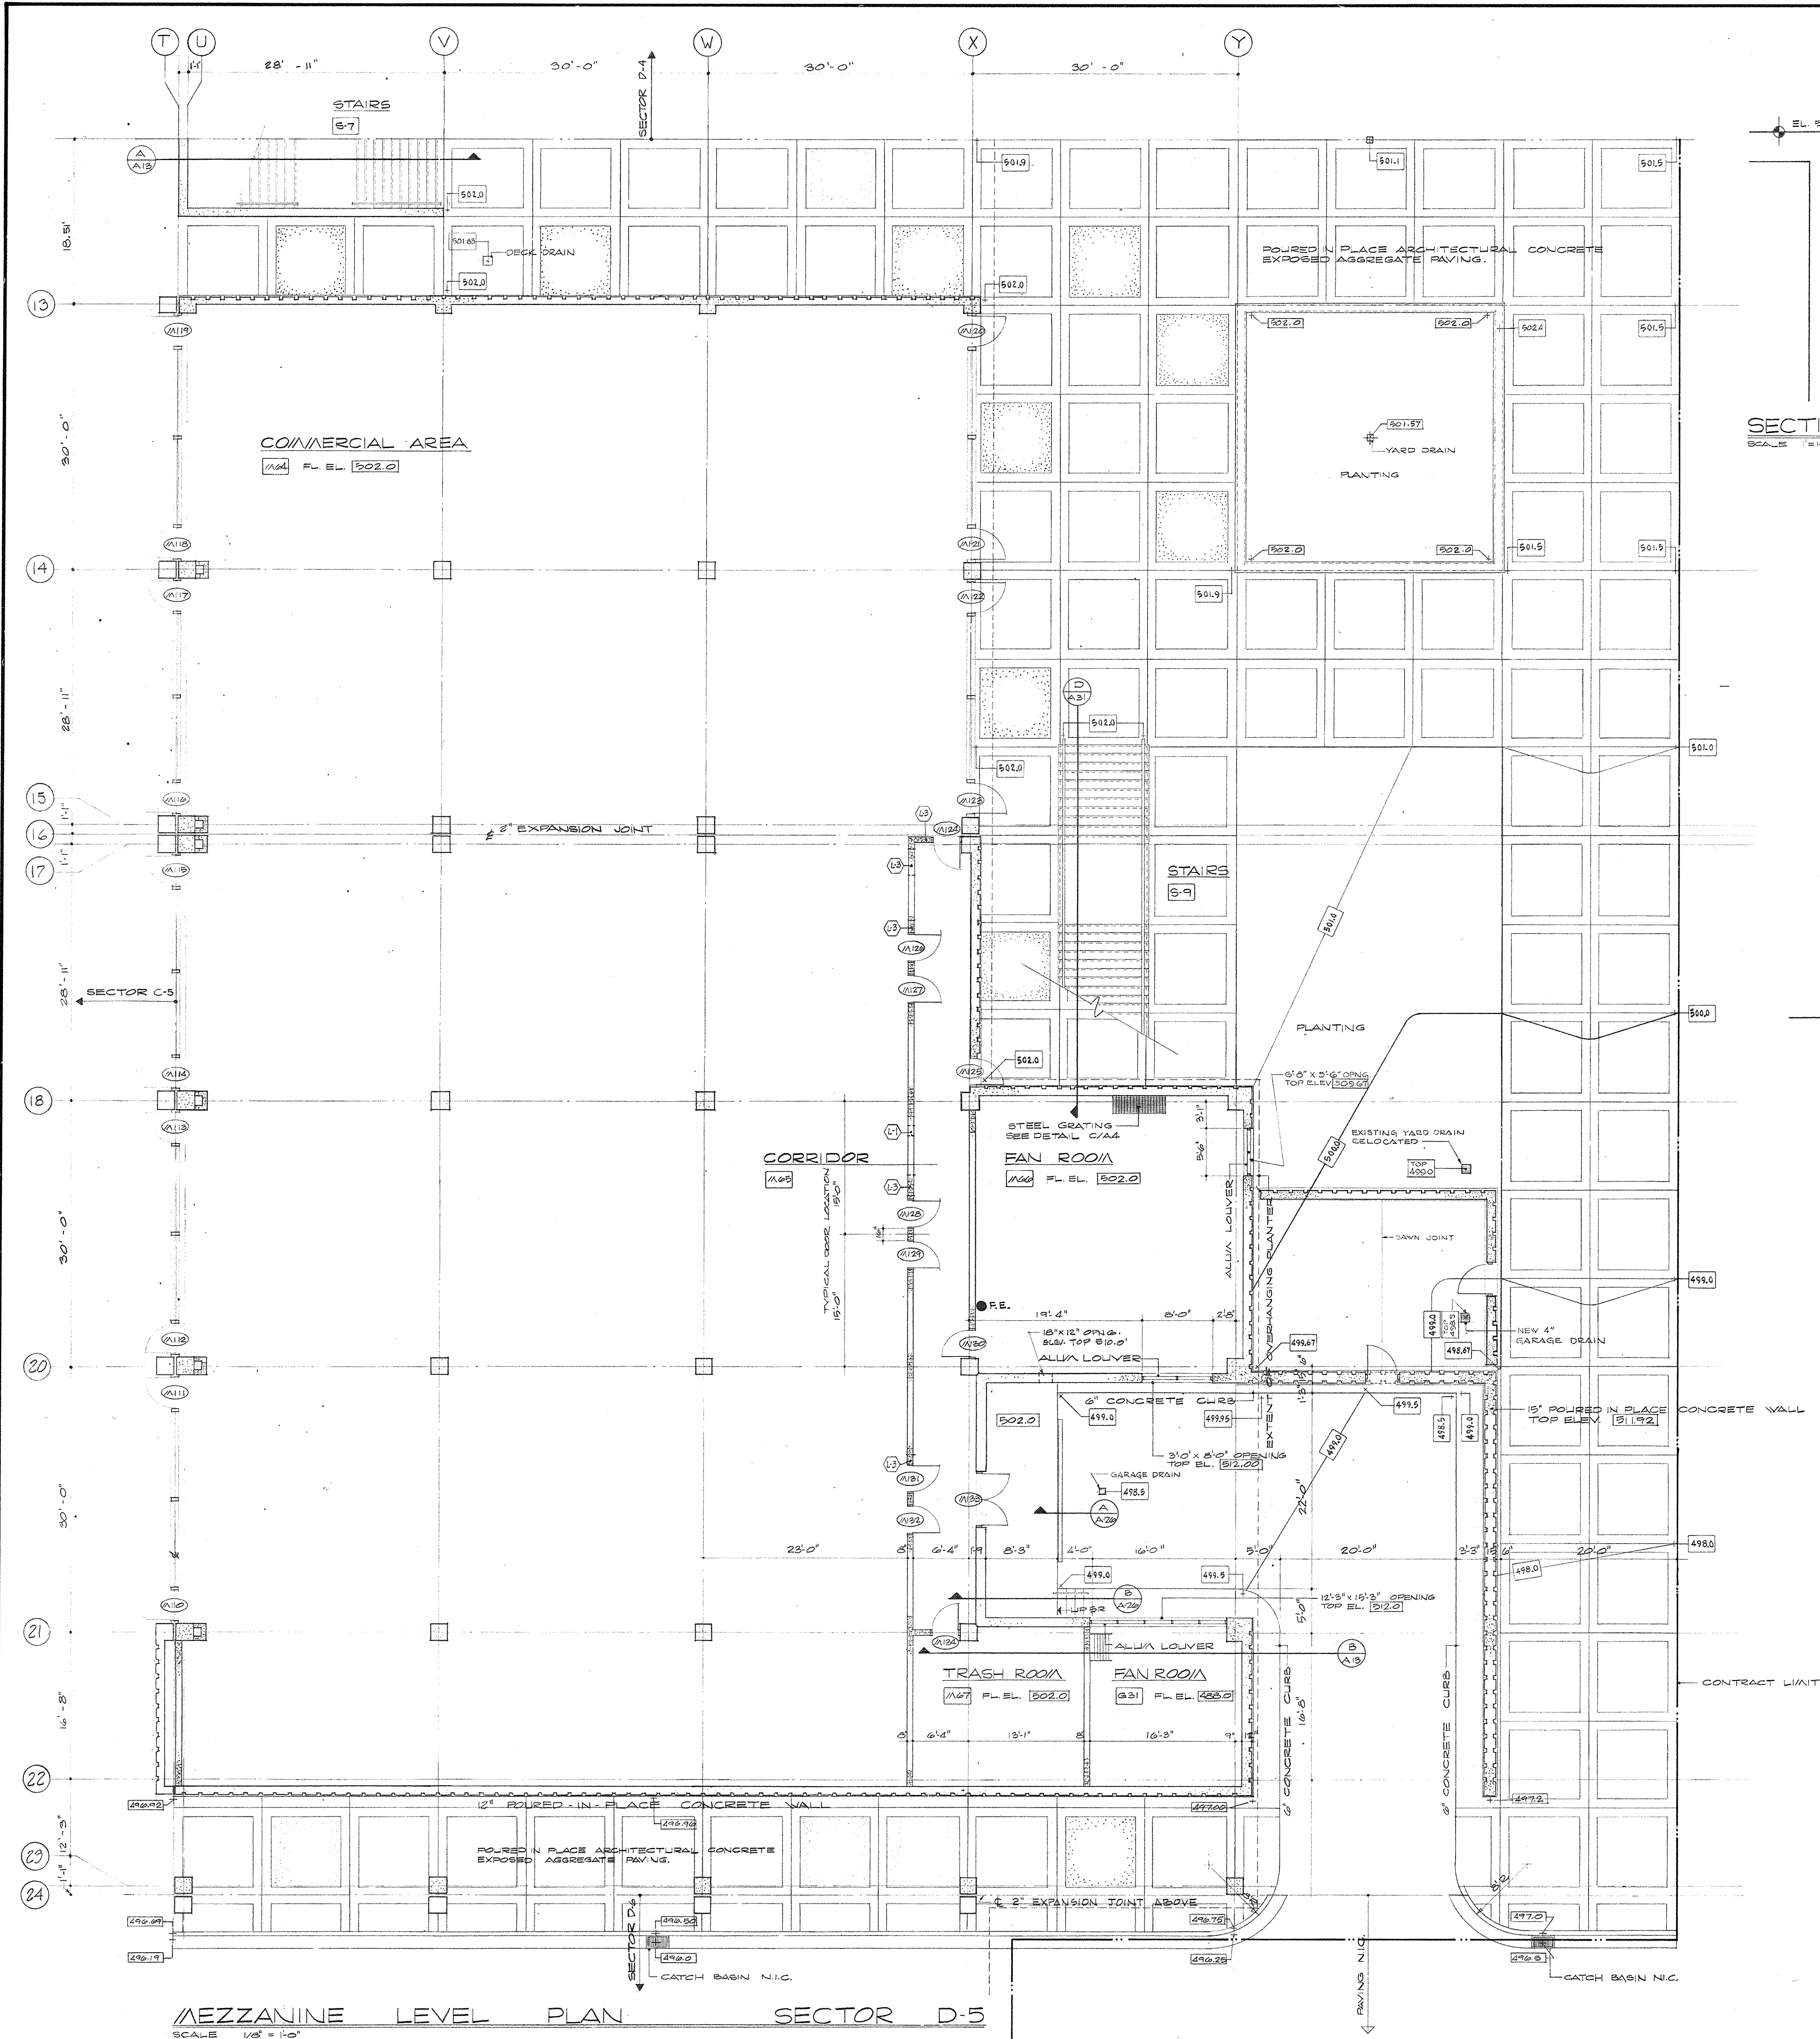


AS BUILT REVISIONS - 8-22-72

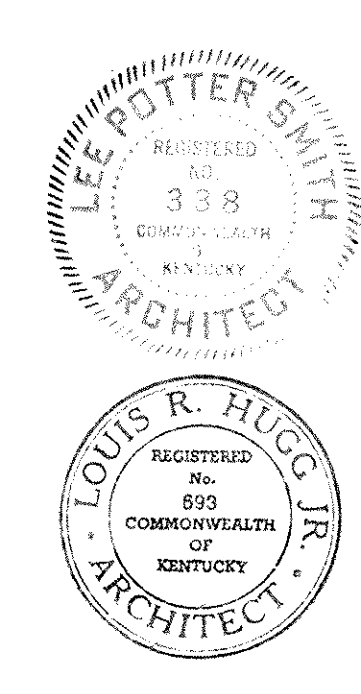


CAPITAL PLAZA DEVELOPMENT PHASE II FRANKFORT, KENTUCKY		
DRAWN BY J.B. & V.T.	MEZZANINE LEVEL PLAN	DATE 5 OCT. 1967
CHECKED BY L.S.H.	ARCHITECTS LEE POTTER SMITH, PRITCHETT, HUGG & CARTER 314 WILKINSON STREET FRANKFORT, KENTUCKY	CONS. NO. 50397
SECTOR NO. D 5	ENGINEERS COMMONWEALTH OF KENTUCKY DEPARTMENT OF FINANCE - DIVISION OF ENGINEERING FRANKFORT, KENTUCKY	DRAWING NO. A 26
APPROVED BY AGENCY HEAD	<i>W.J. McConnell</i>	DATE 10-26-67
APPROVED BY OWNER		OF 1-42


MEZZANINE LEVEL PLAN SECTOR D-5
SCALE 1/8" = 1'-0"

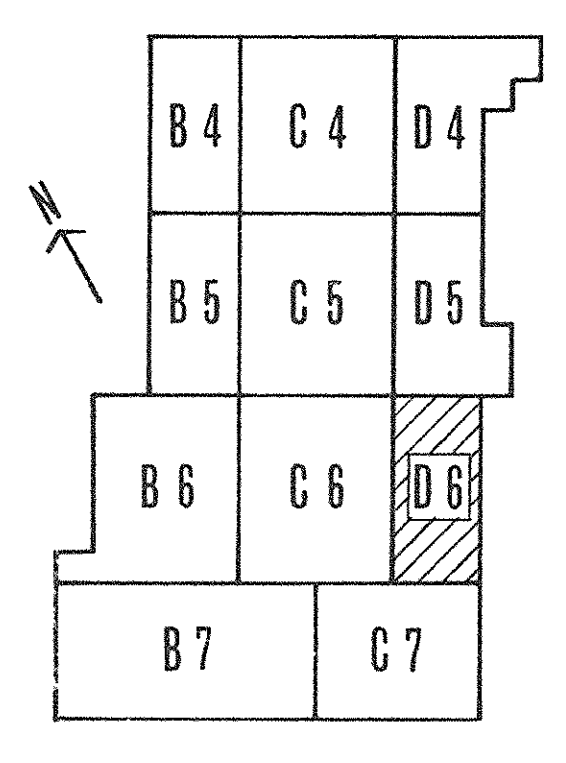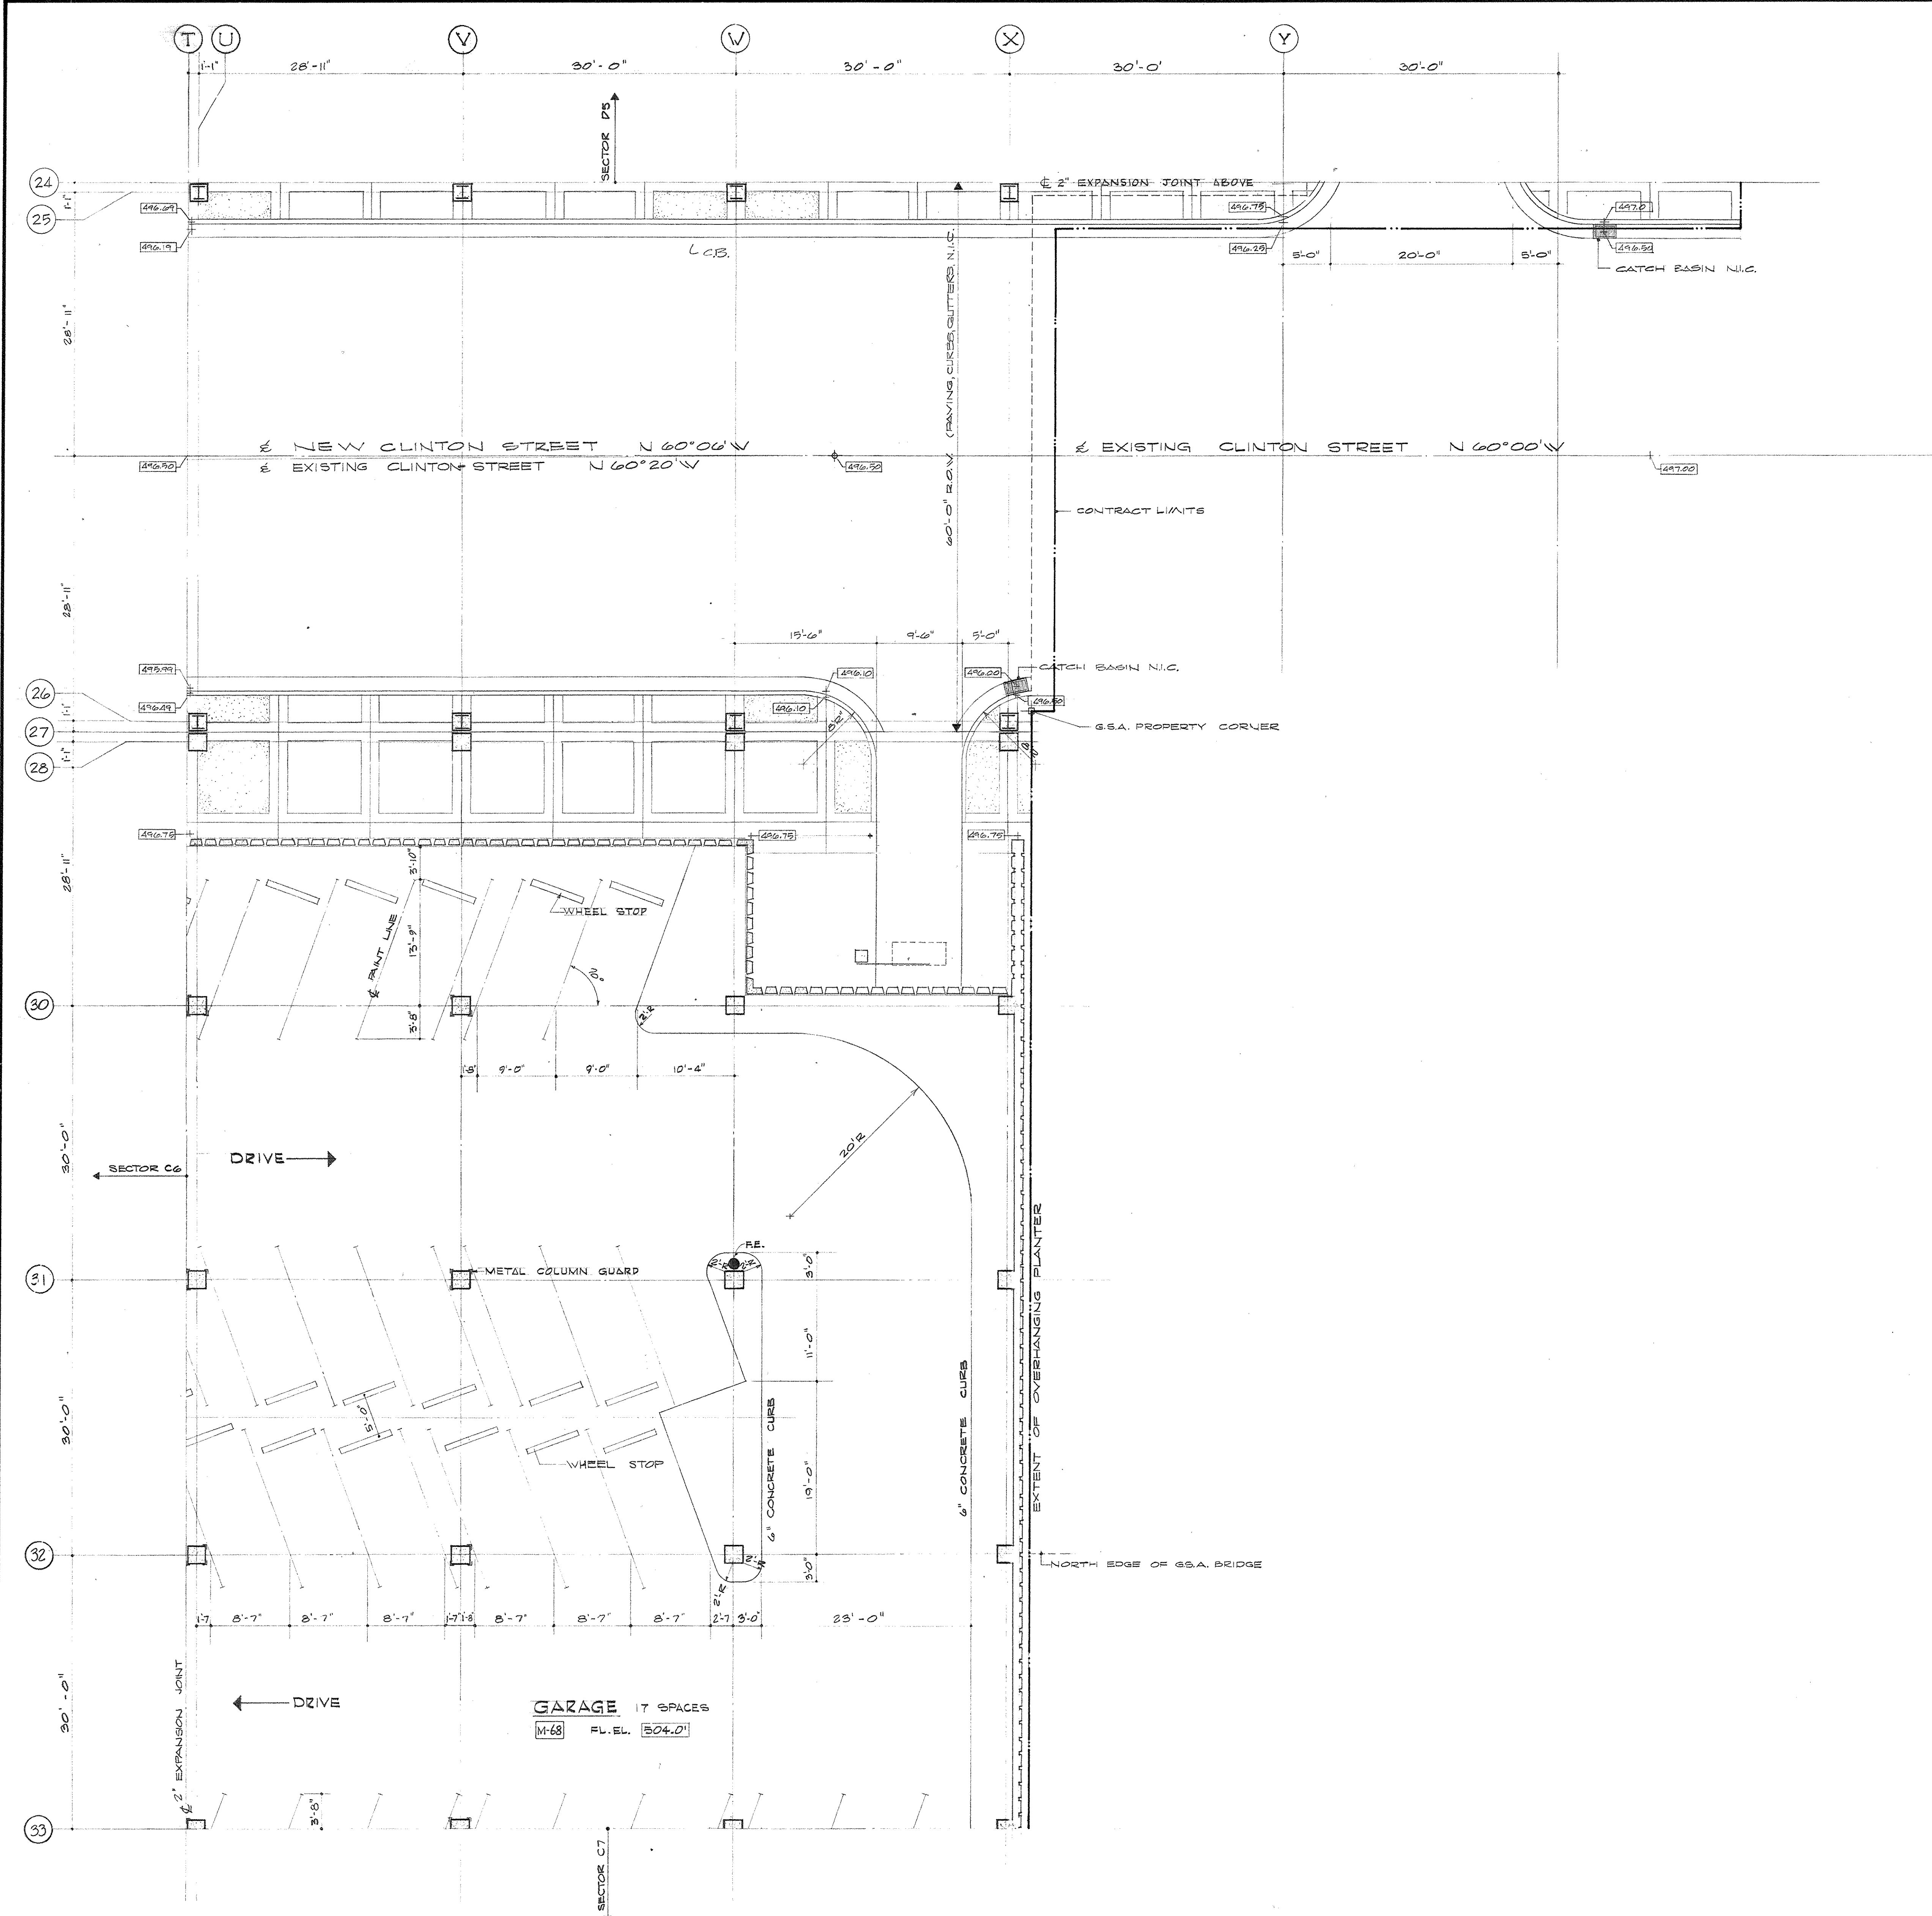


AS BUILT REVISIONS - 8 24 72

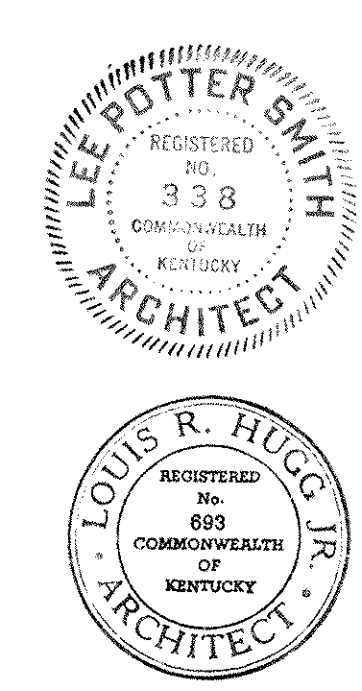


CAPITAL PLAZA DEVELOPMENT PHASE II		
FRANKFORT, KENTUCKY		
DRAWN BY J.B.	DATE OCT. 1967	COMM. NO. 50367
CHECKED BY L.P.S.	MEZZANINE LEVEL PLAN	DRAWING NO. A-27
SECTOR NO. D 6	LEE POTTER SMITH, PRITCHETT, HUGG & CARTER ARCHITECTS 314 WILKINSON STREET FRANKFORT, KENTUCKY	OF A-22
APPROVED BY AGENCY HEAD	COMMONWEALTH OF KENTUCKY DEPARTMENT OF FINANCE - DIVISION OF ENGINEERING FRANKFORT, KENTUCKY	DATE 10-26-67
APPROVED BY OWNER	W.J. McConnell	

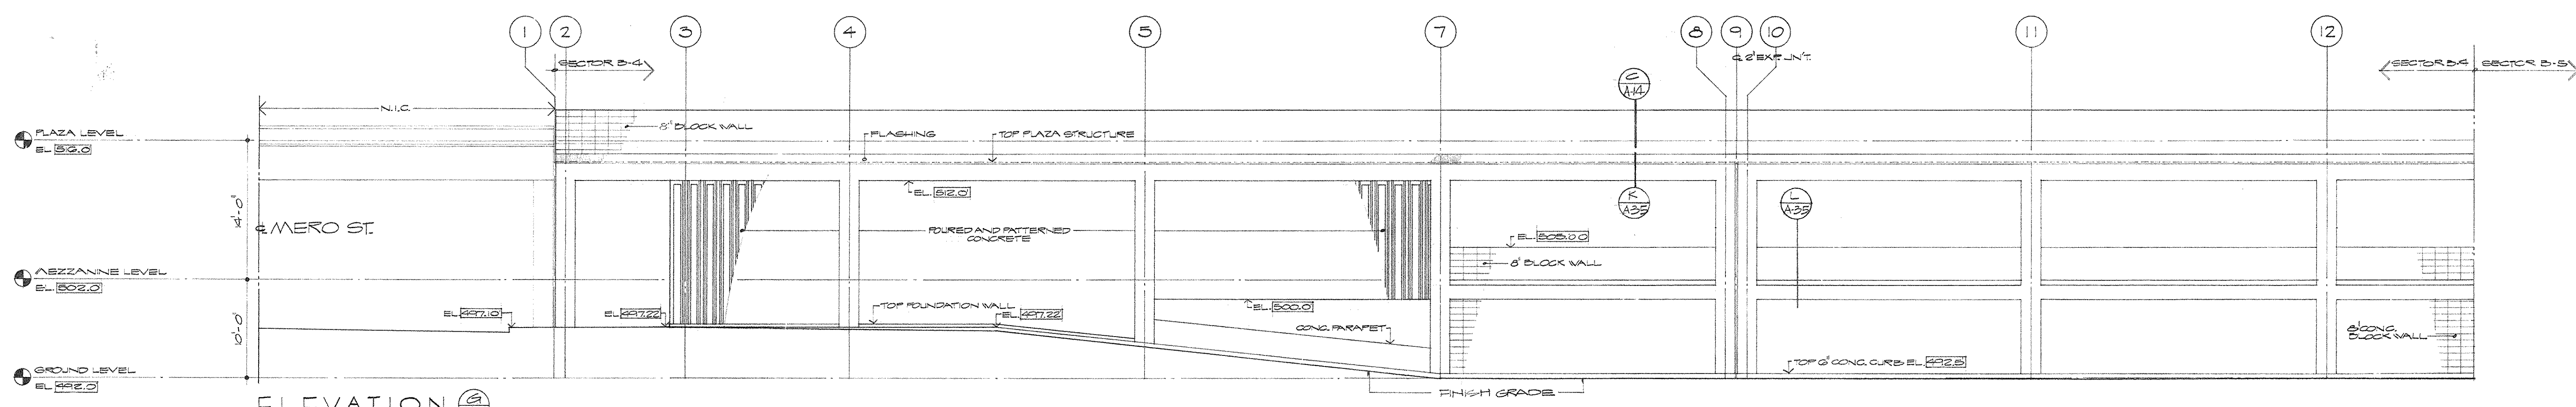


ELEVATION (A)
SCALE 1/8" = 1'-0"

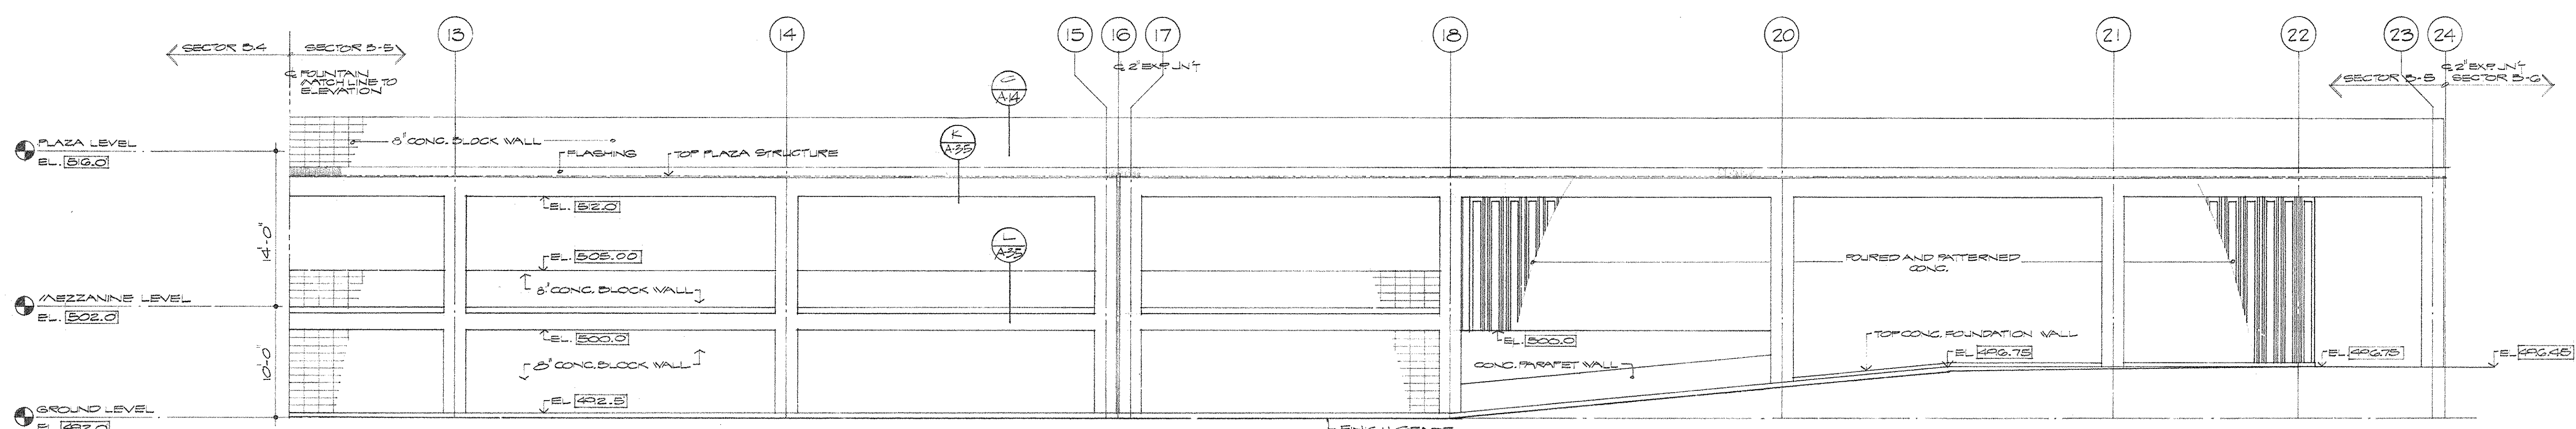


ELEVATION (B)
SCALE 1/8" = 1'-0"

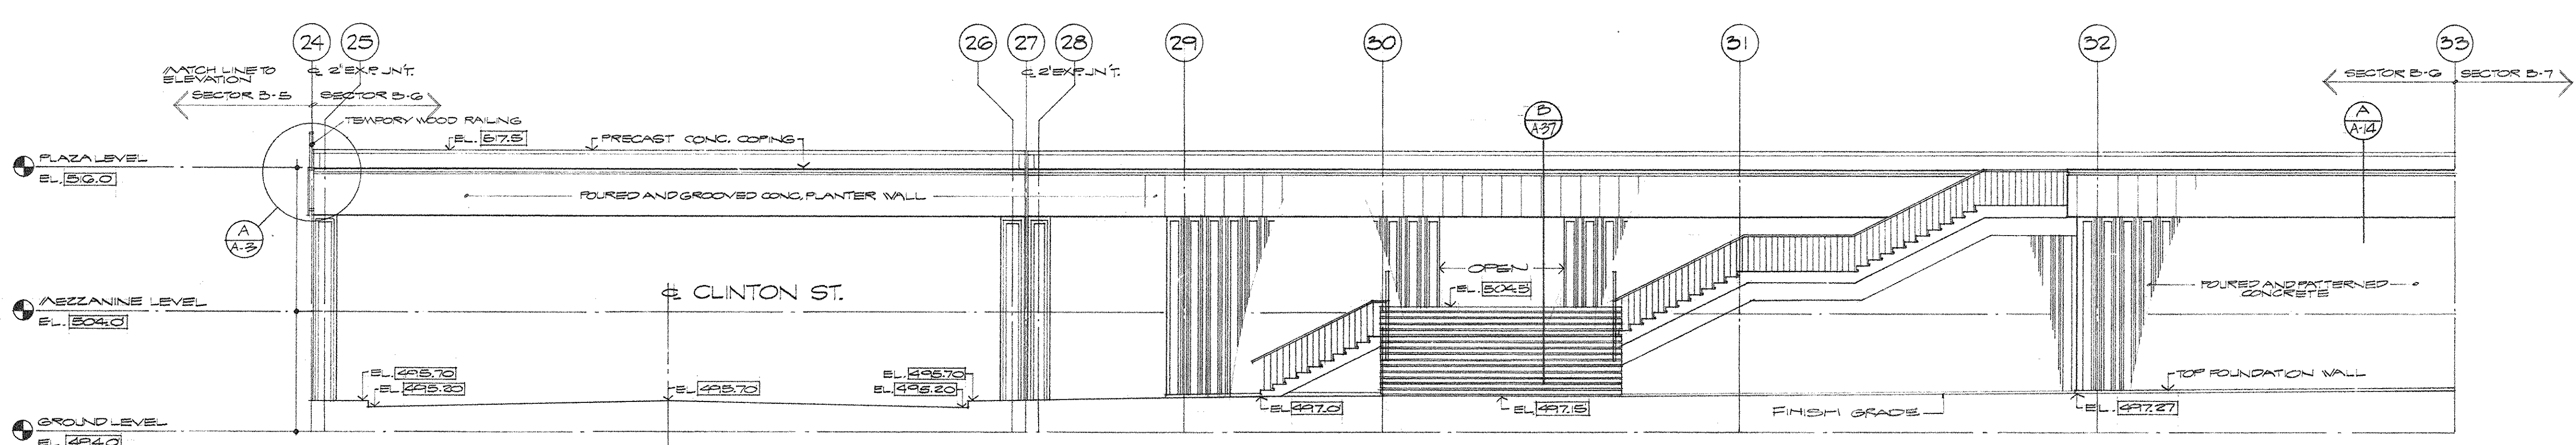


ELEVATION (C)
SCALE 1/8" = 1'-0"

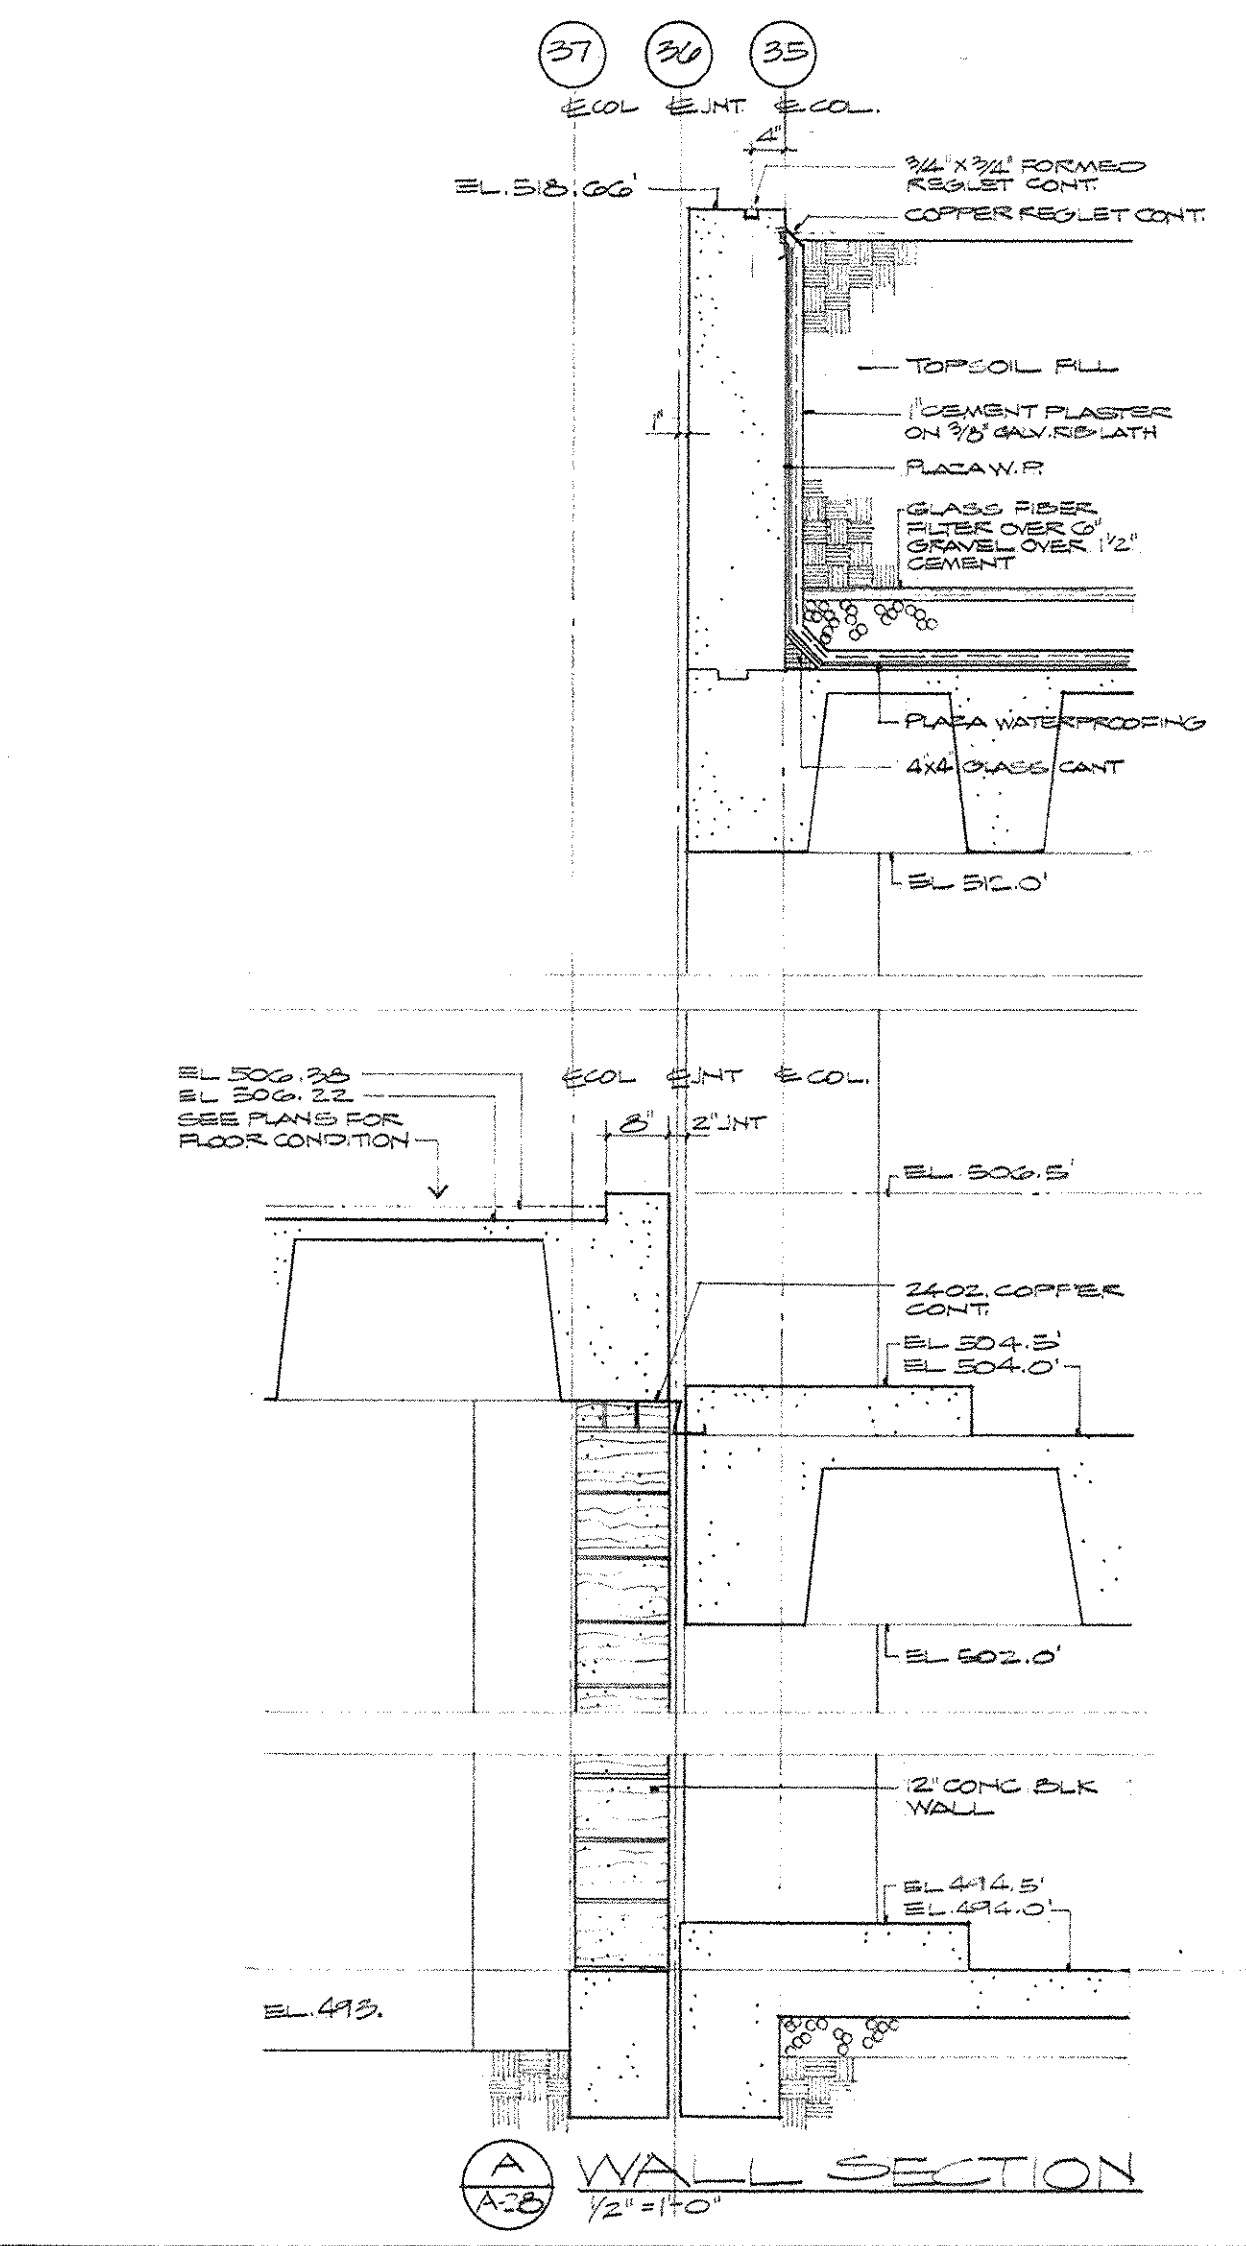


WALL SECTION (A)
SCALE 1/2" = 1'-0"

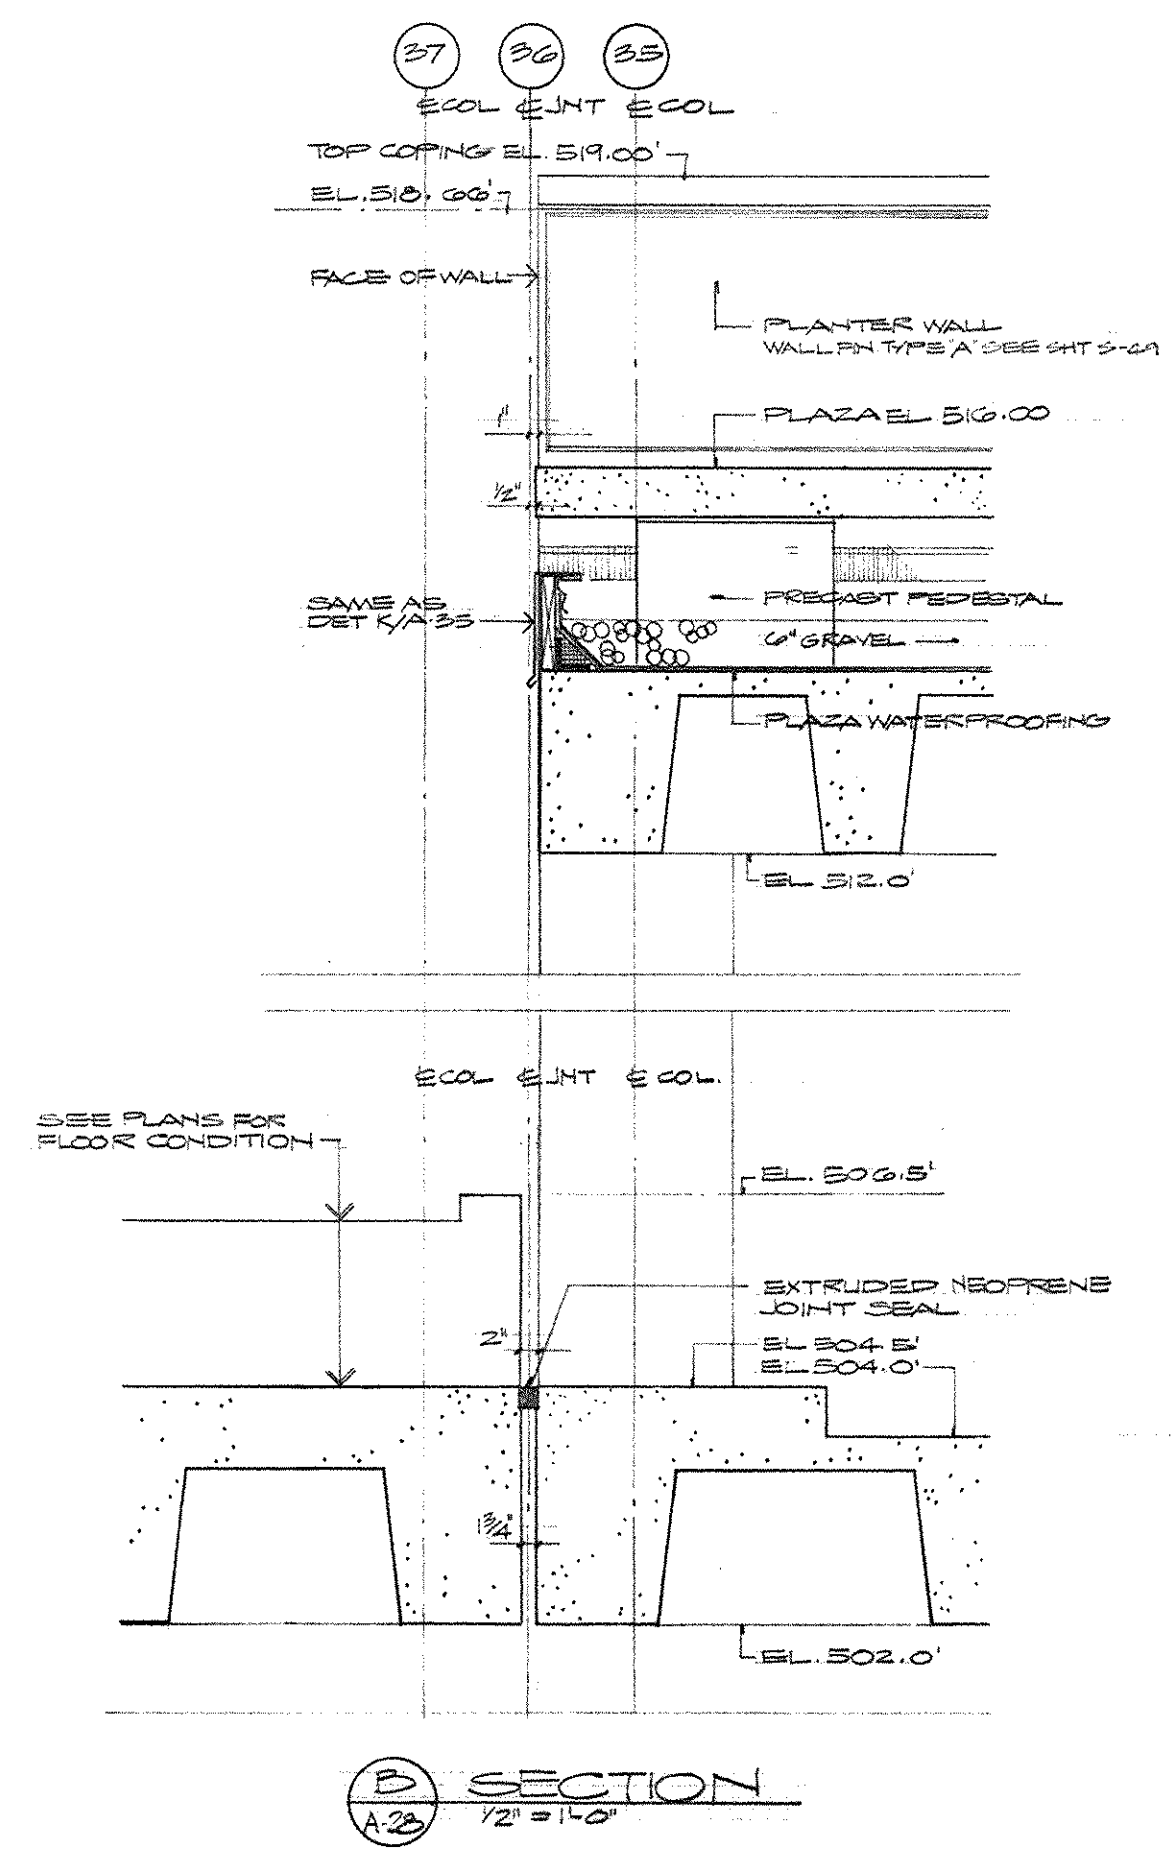


SECTION (B)
SCALE 1/2" = 1'-0"

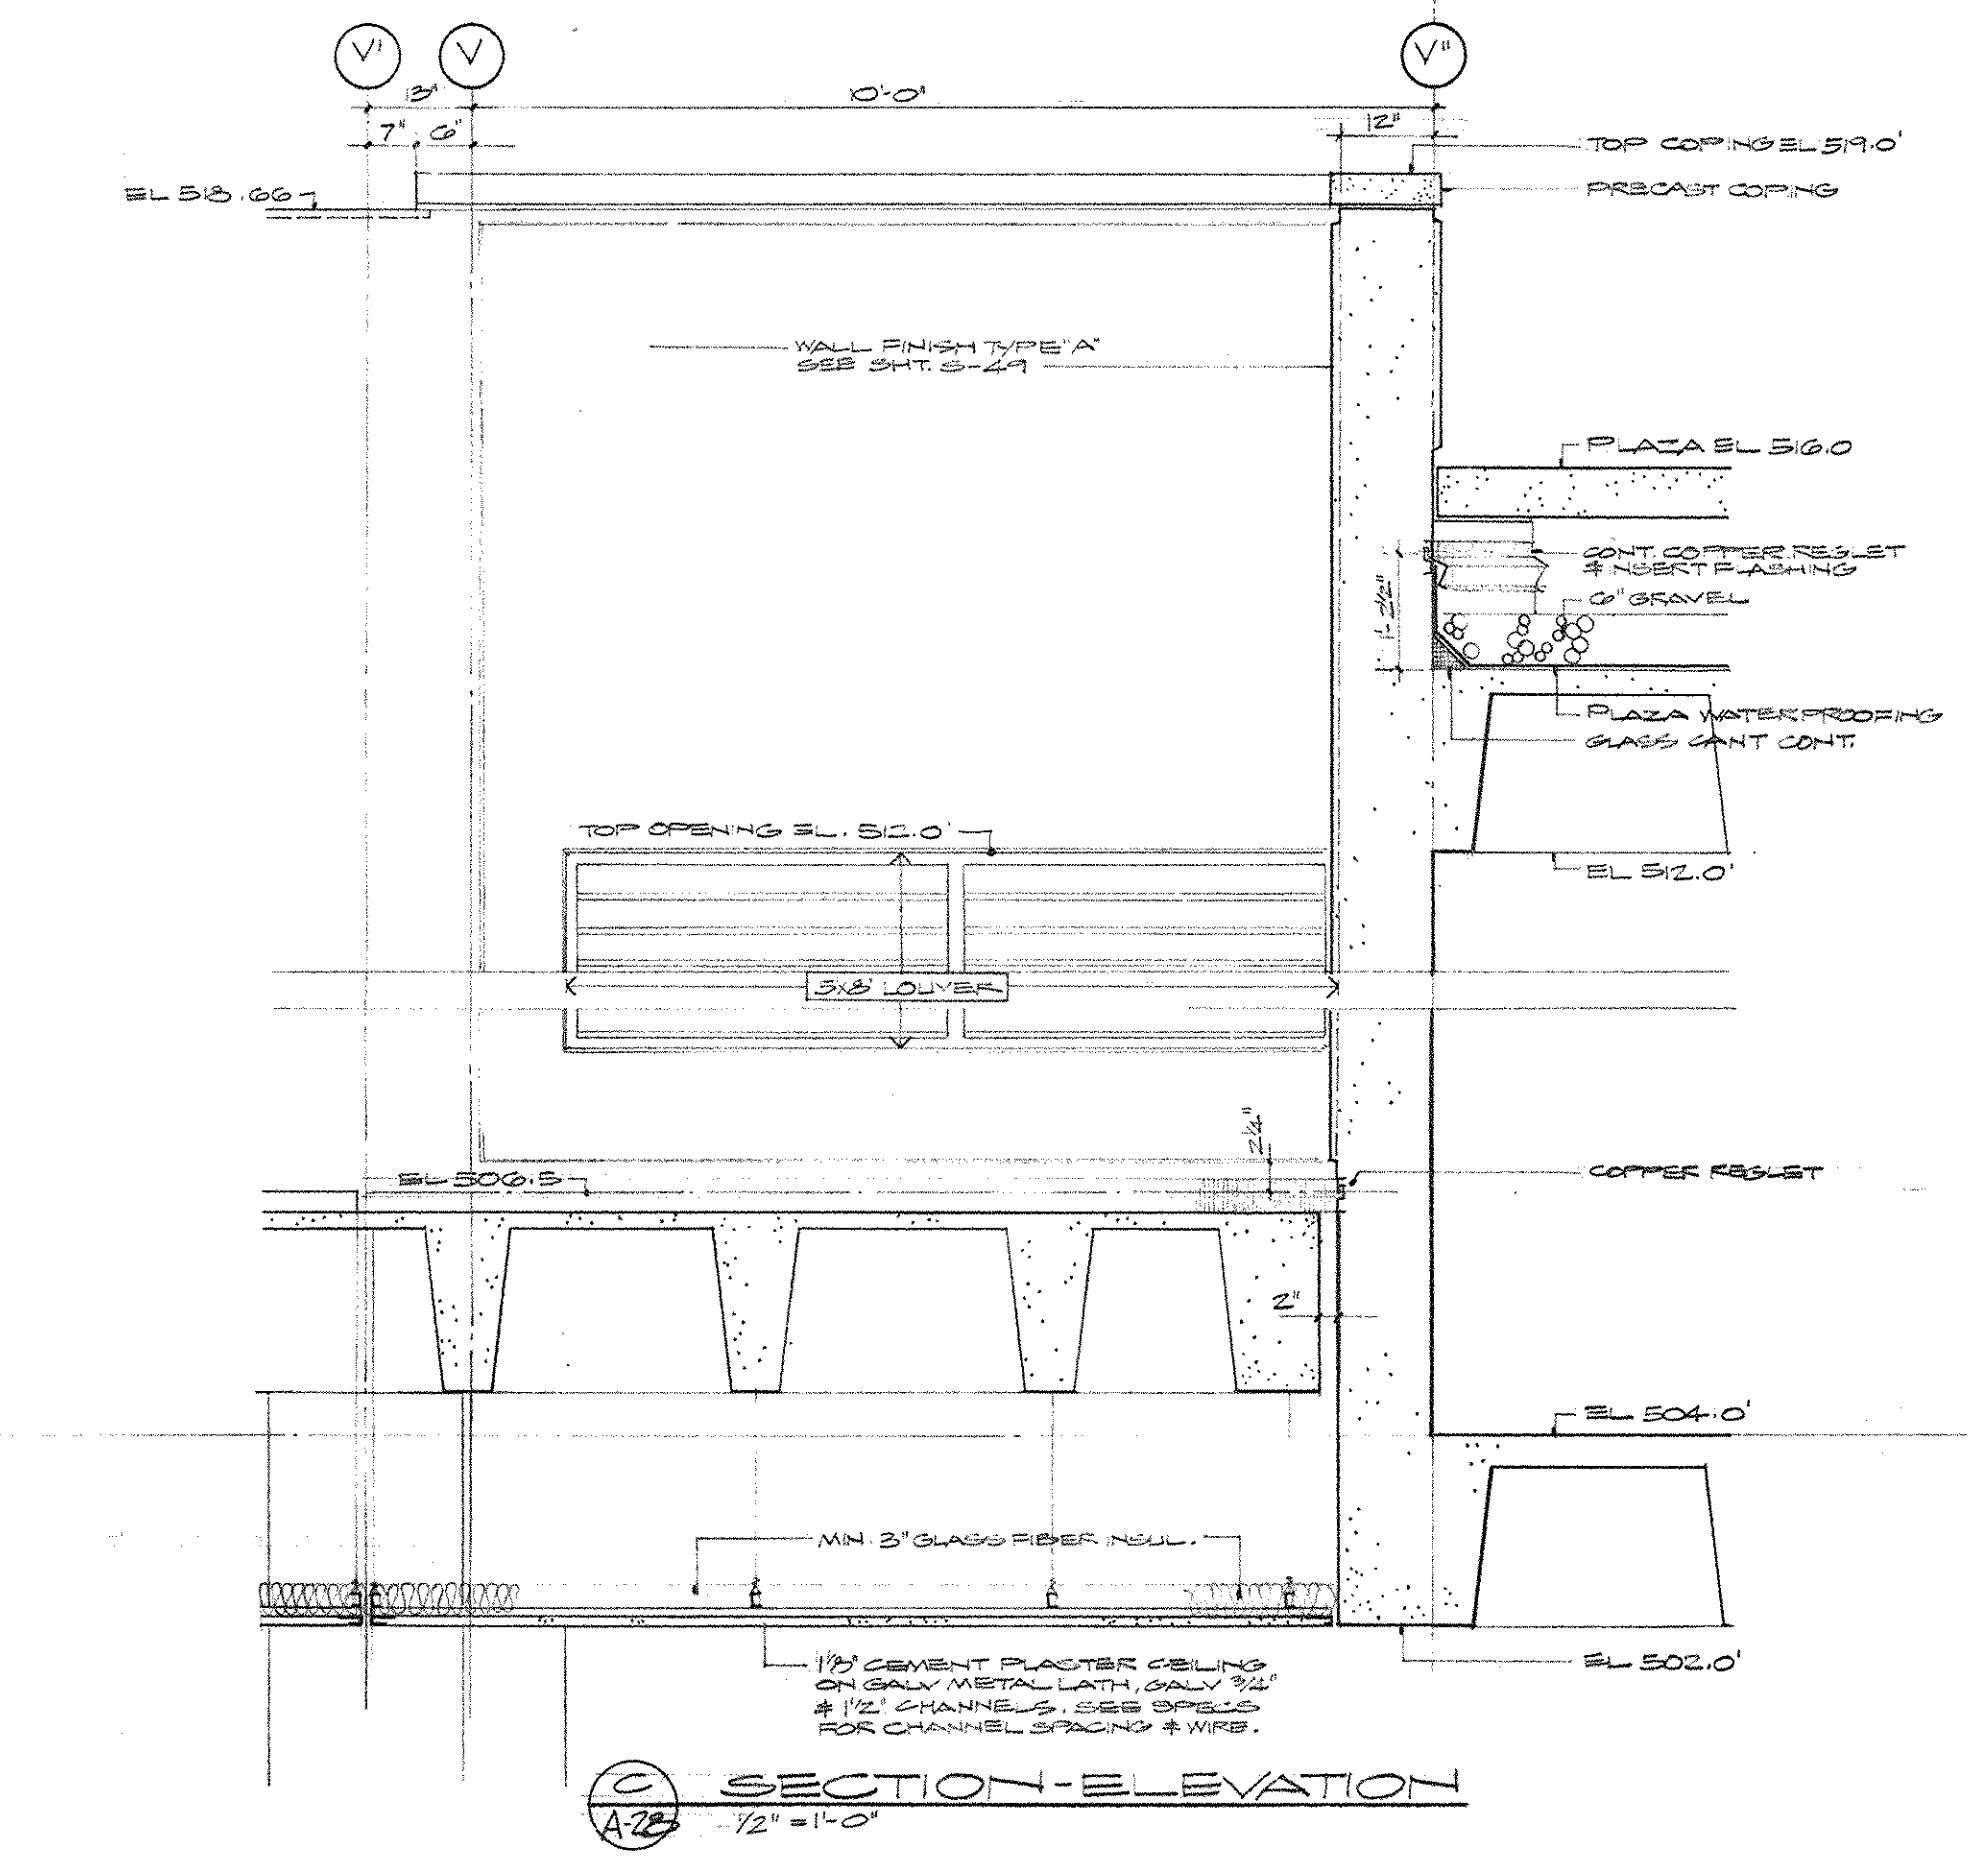


SECTION-ELEVATION (C)
SCALE 1/2" = 1'-0"

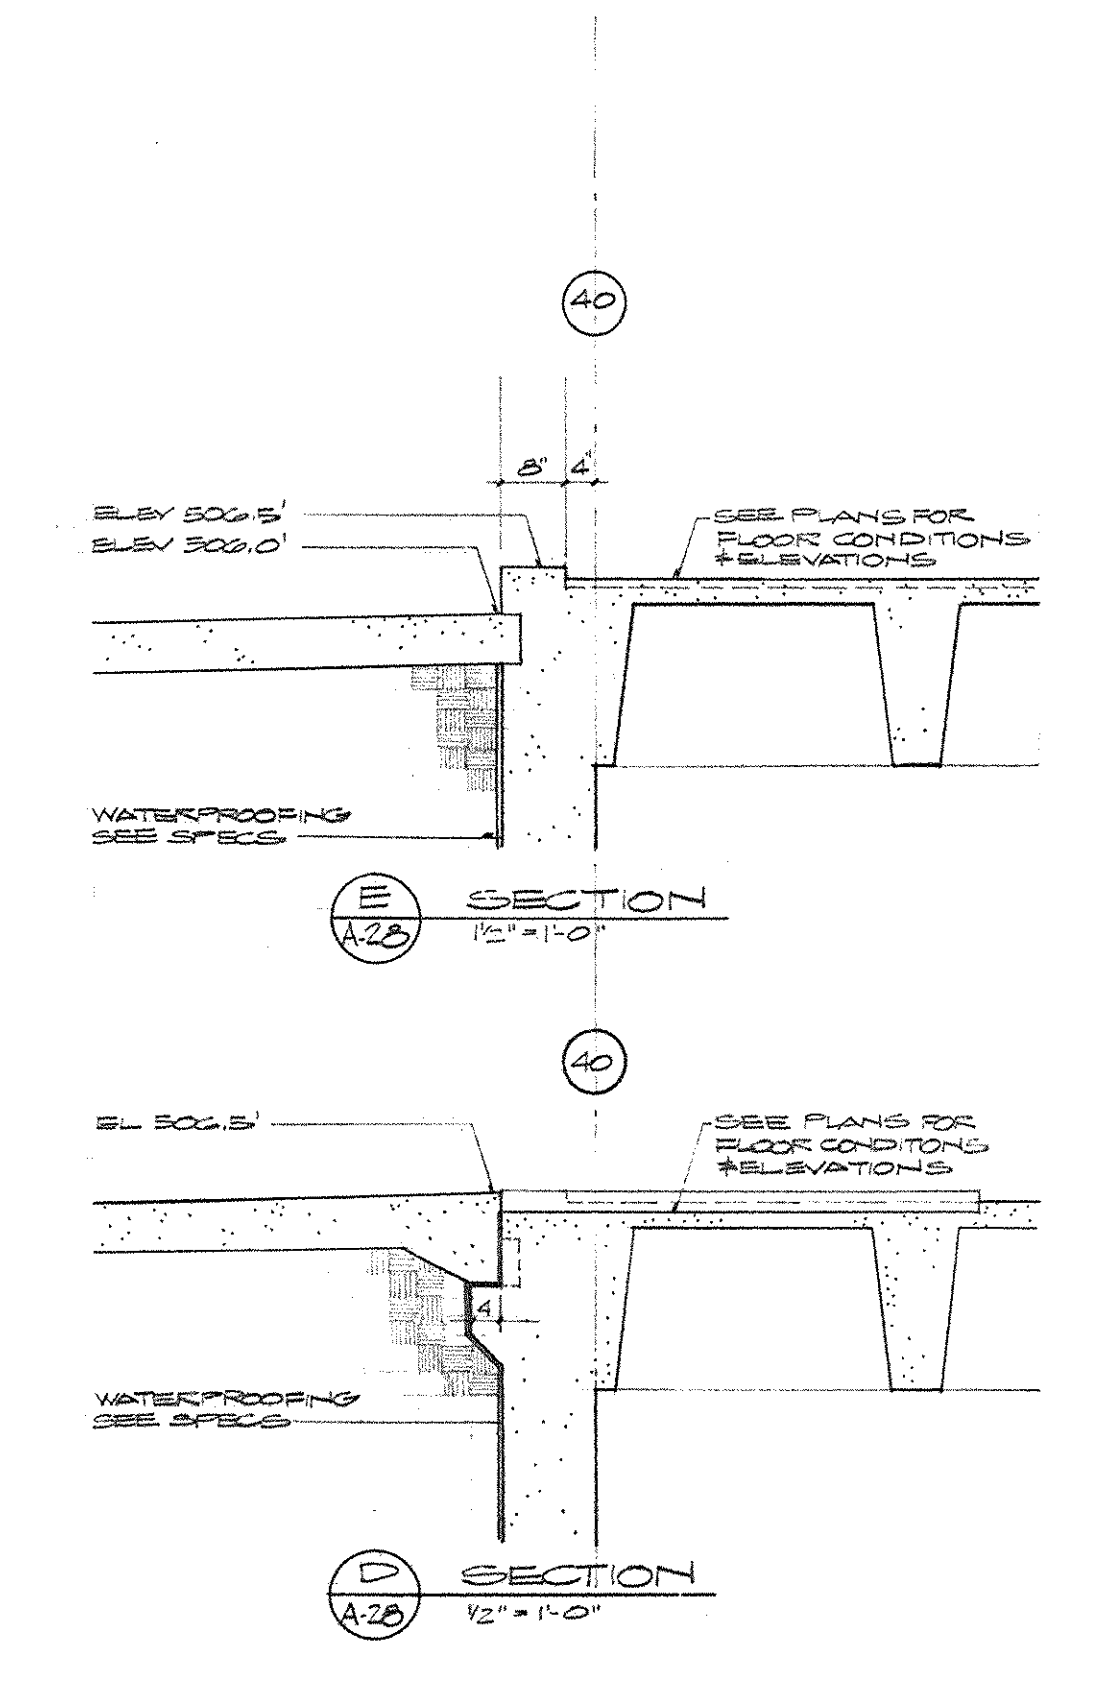

SECTION (D)
SCALE 1/2" = 1'-0"

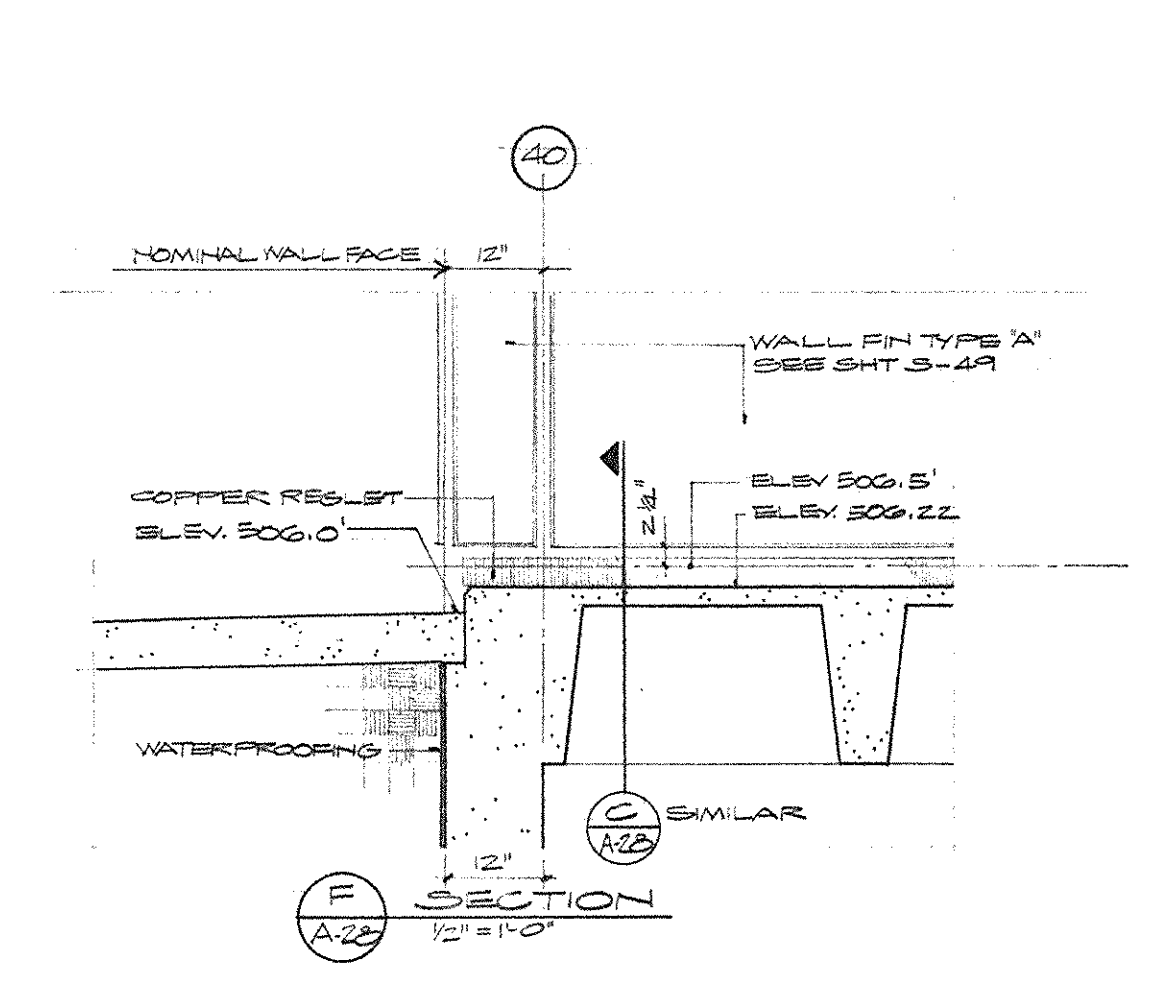


SECTION (E)
SCALE 1/2" = 1'-0"




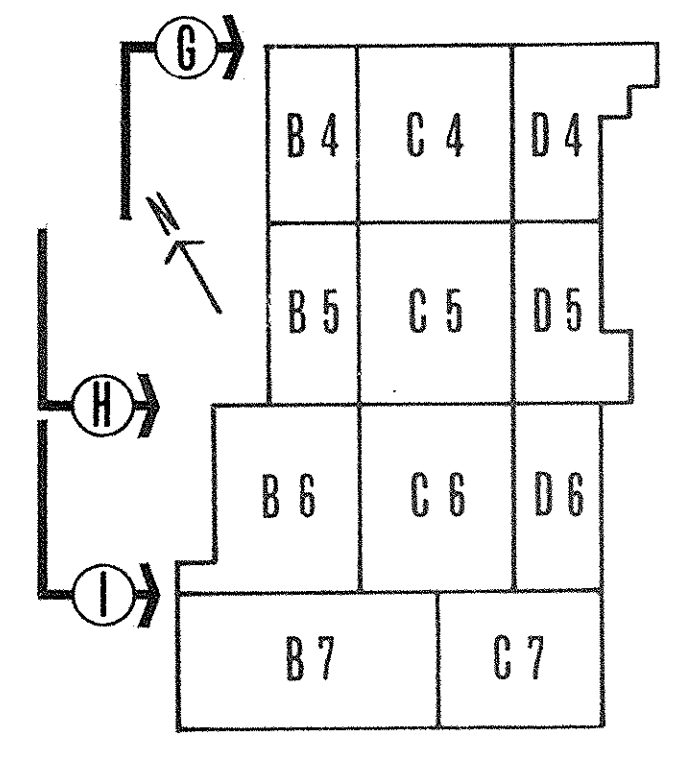


KEY PLAN



AS BUILT REVISIONS 5-21-72

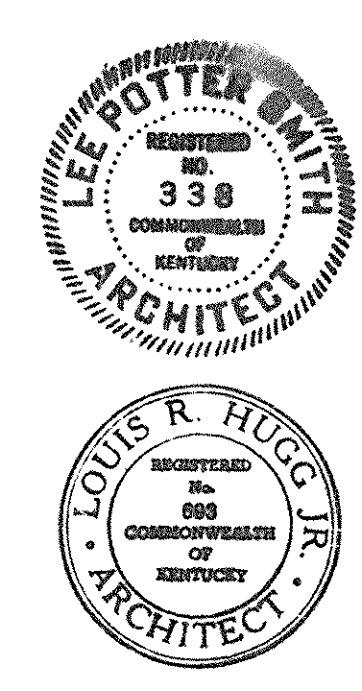

CAPITAL PLAZA DEVELOPMENT PHASE II		
FRANKFORT, KENTUCKY		
DRAWN BY N. D. L.H.	DATE 10-25-71	DATE 10-25-71
CHECKED BY J.P.H.	COMM. NO. 50387	DRAWING NO. A 28
SECTOR NO. CPA-4	LEE POTTER SMITH, PRITCHETT, HUGG & CARTER ARCHITECTS 214 WILKINSON STREET FRANKFORT, KENTUCKY	COMMONWEALTH OF KENTUCKY DEPARTMENT OF FINANCE - DIVISION OF ENGINEERING FRANKFORT, KENTUCKY
APPROVED BY AGENCY HEAD W. M. Connell	DATE 10-26-71	DATE 10-26-71
APPROVED BY OWNER		

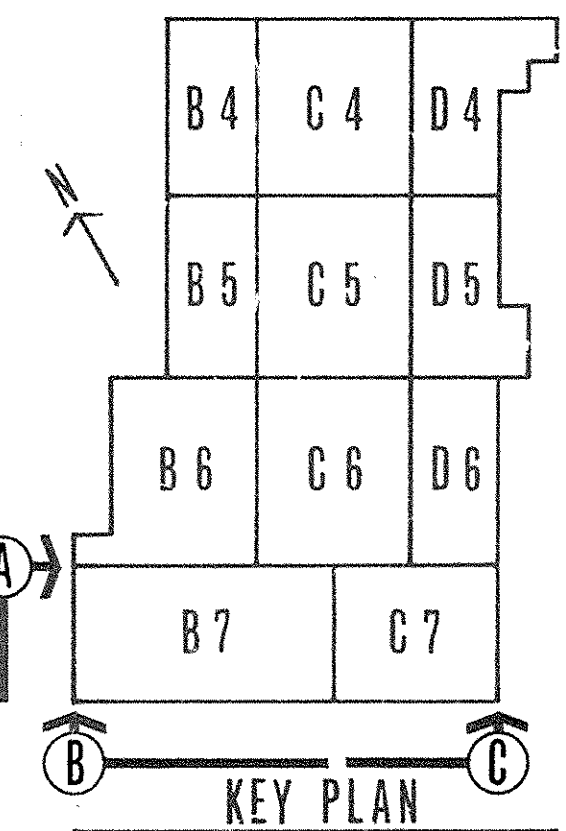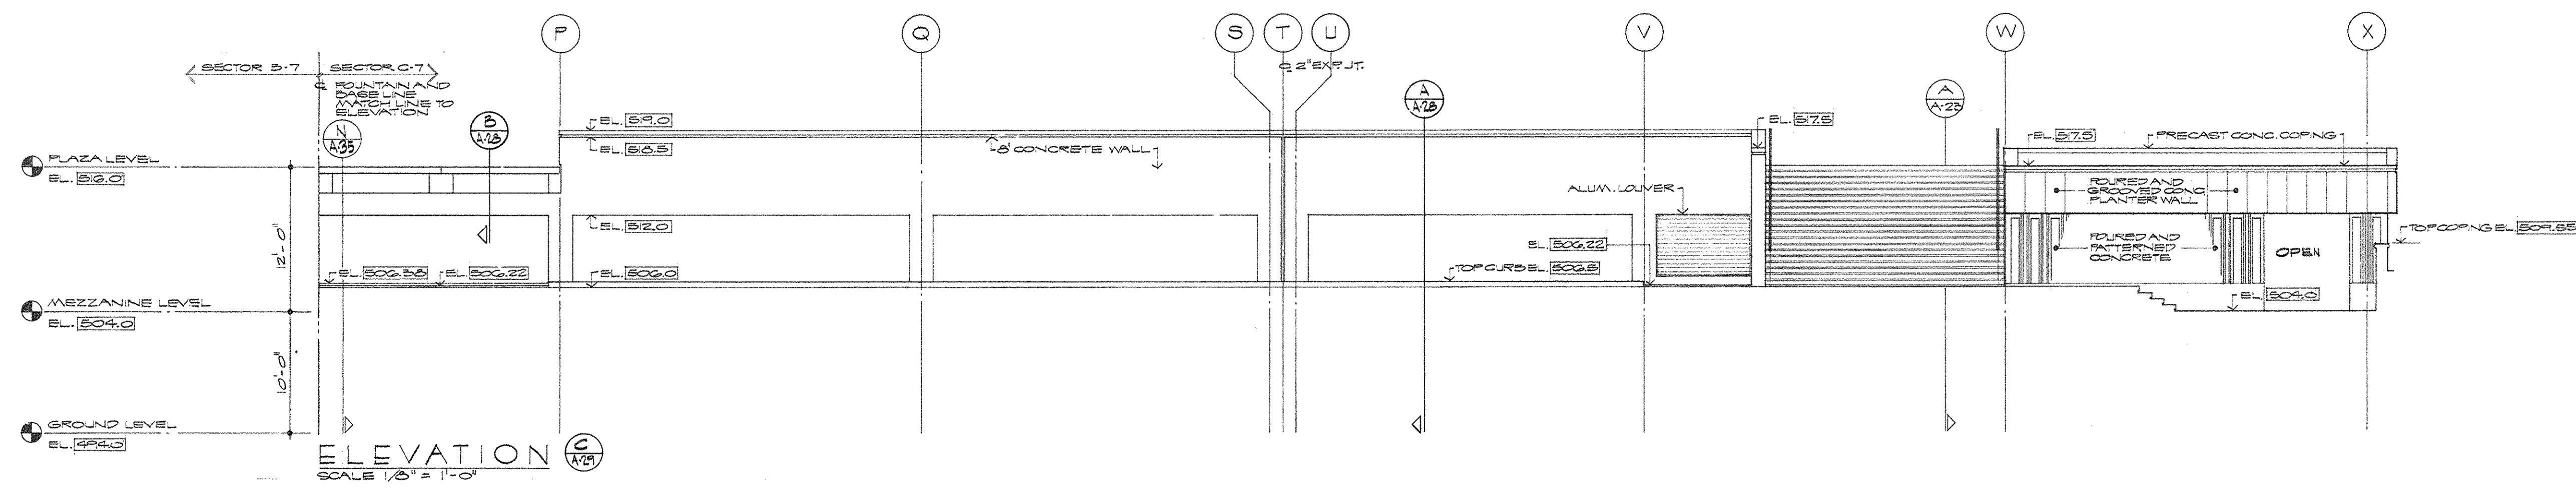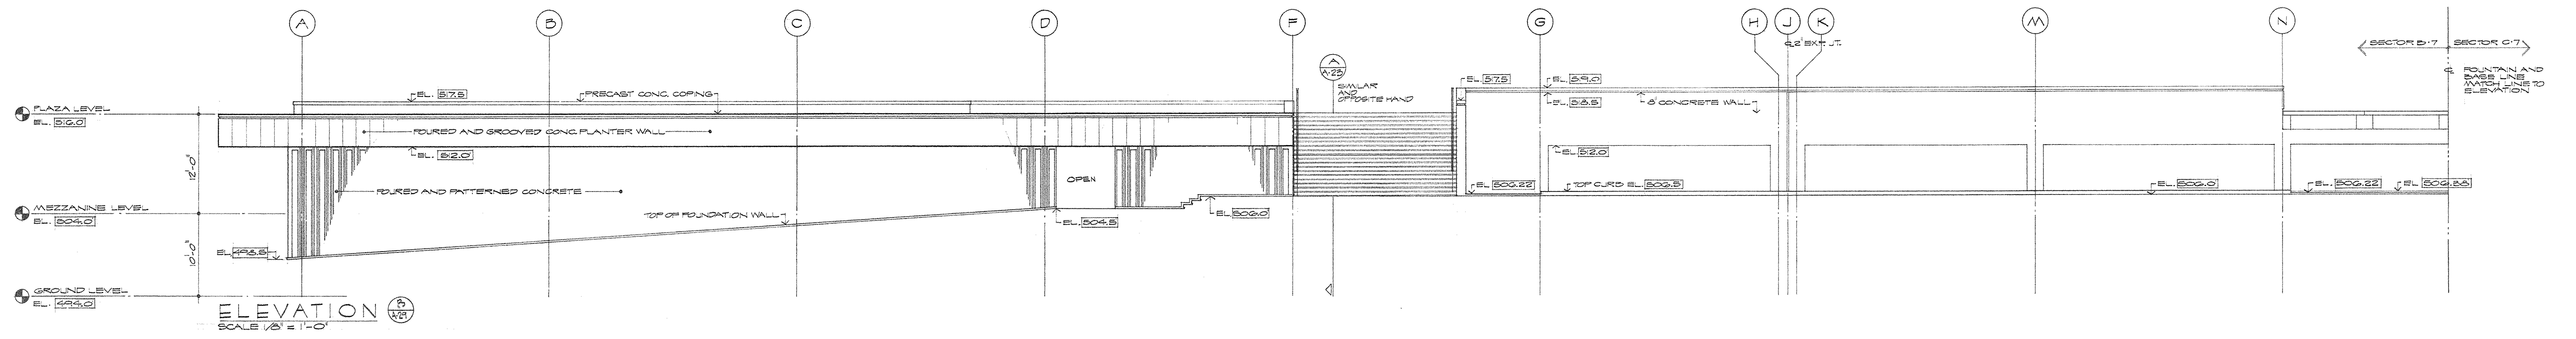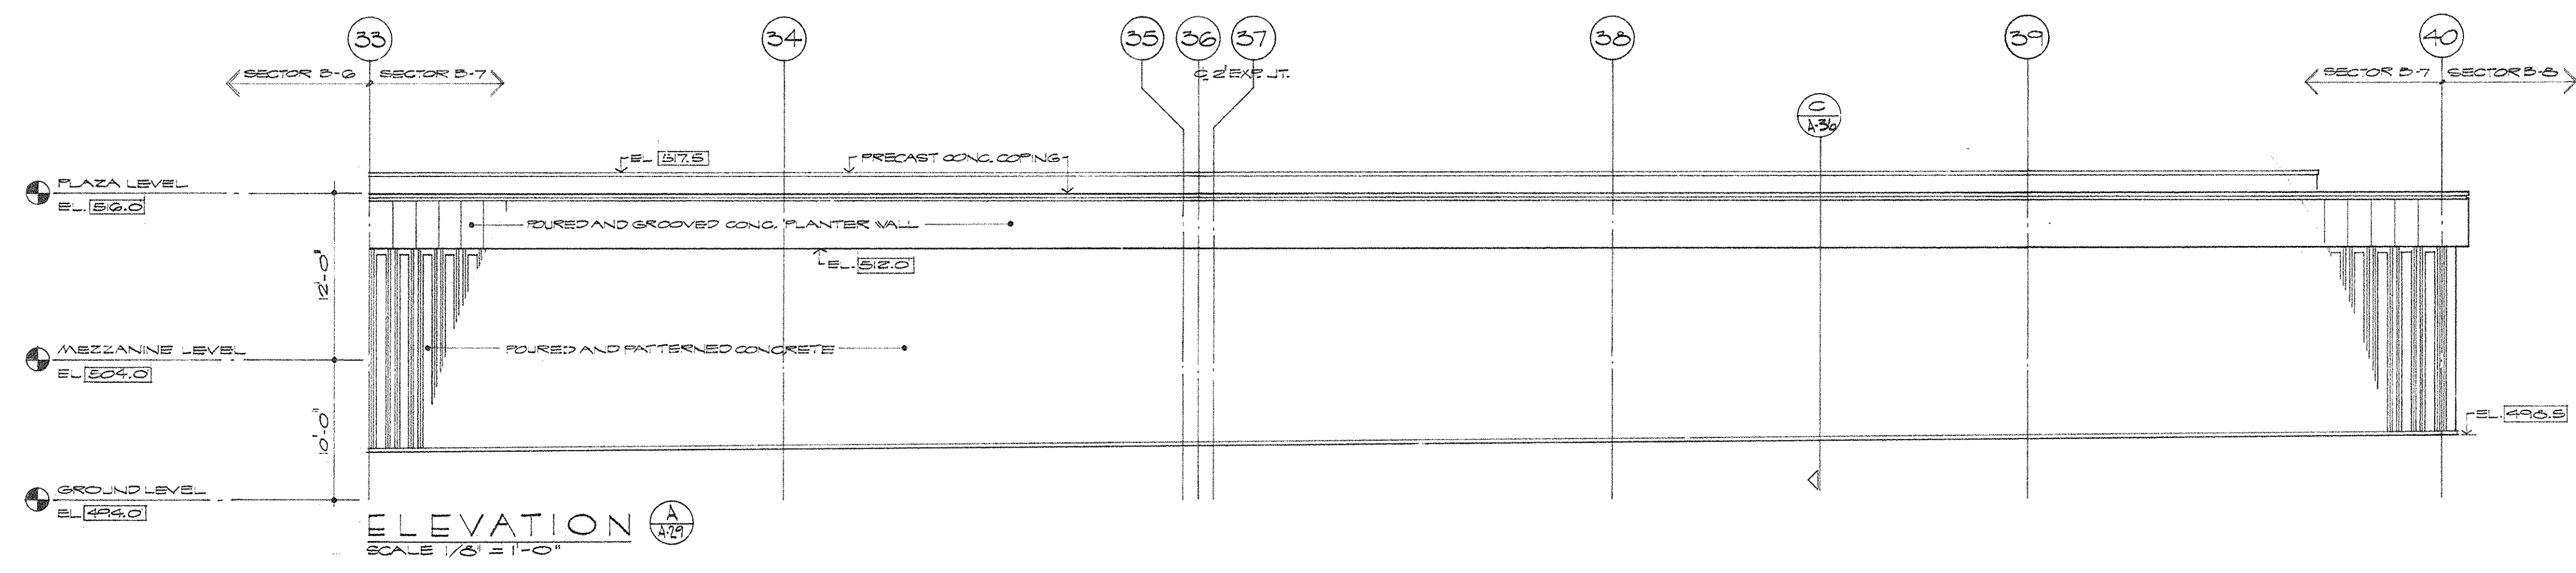


AS BUILT REVISIONS - 8-24-72

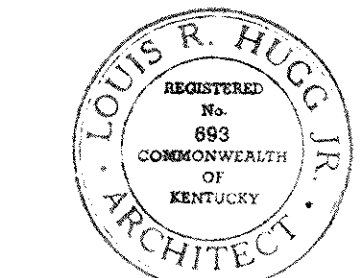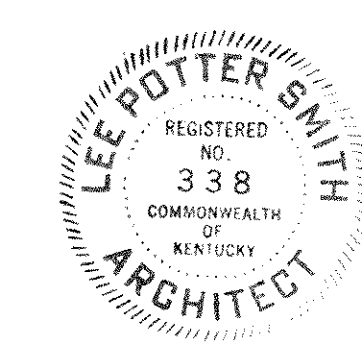


CAPITAL PLAZA DEVELOPMENT PHASE II		
FRANKFORT, KENTUCKY		
DRAWN BY V.D.	ELEVATIONS	DATE 16 OCT. 1967
CHECKED BY L.S.H.		COMM. NO. 50387
SECTOR NO.	LEE POTTER SMITH, PRITCHETT, HUGG & CARTER ARCHITECTS 314 WILKINSON STREET FRANKFORT, KENTUCKY	DRAWING NO. A 29 OF A-42
COMMONWEALTH OF KENTUCKY DEPARTMENT OF FINANCE - DIVISION OF ENGINEERING FRANKFORT KENTUCKY		
APPROVED BY AGENCY HEAD	DATE	
APPROVED BY OWNER	DATE	10-24-67


CPA-315

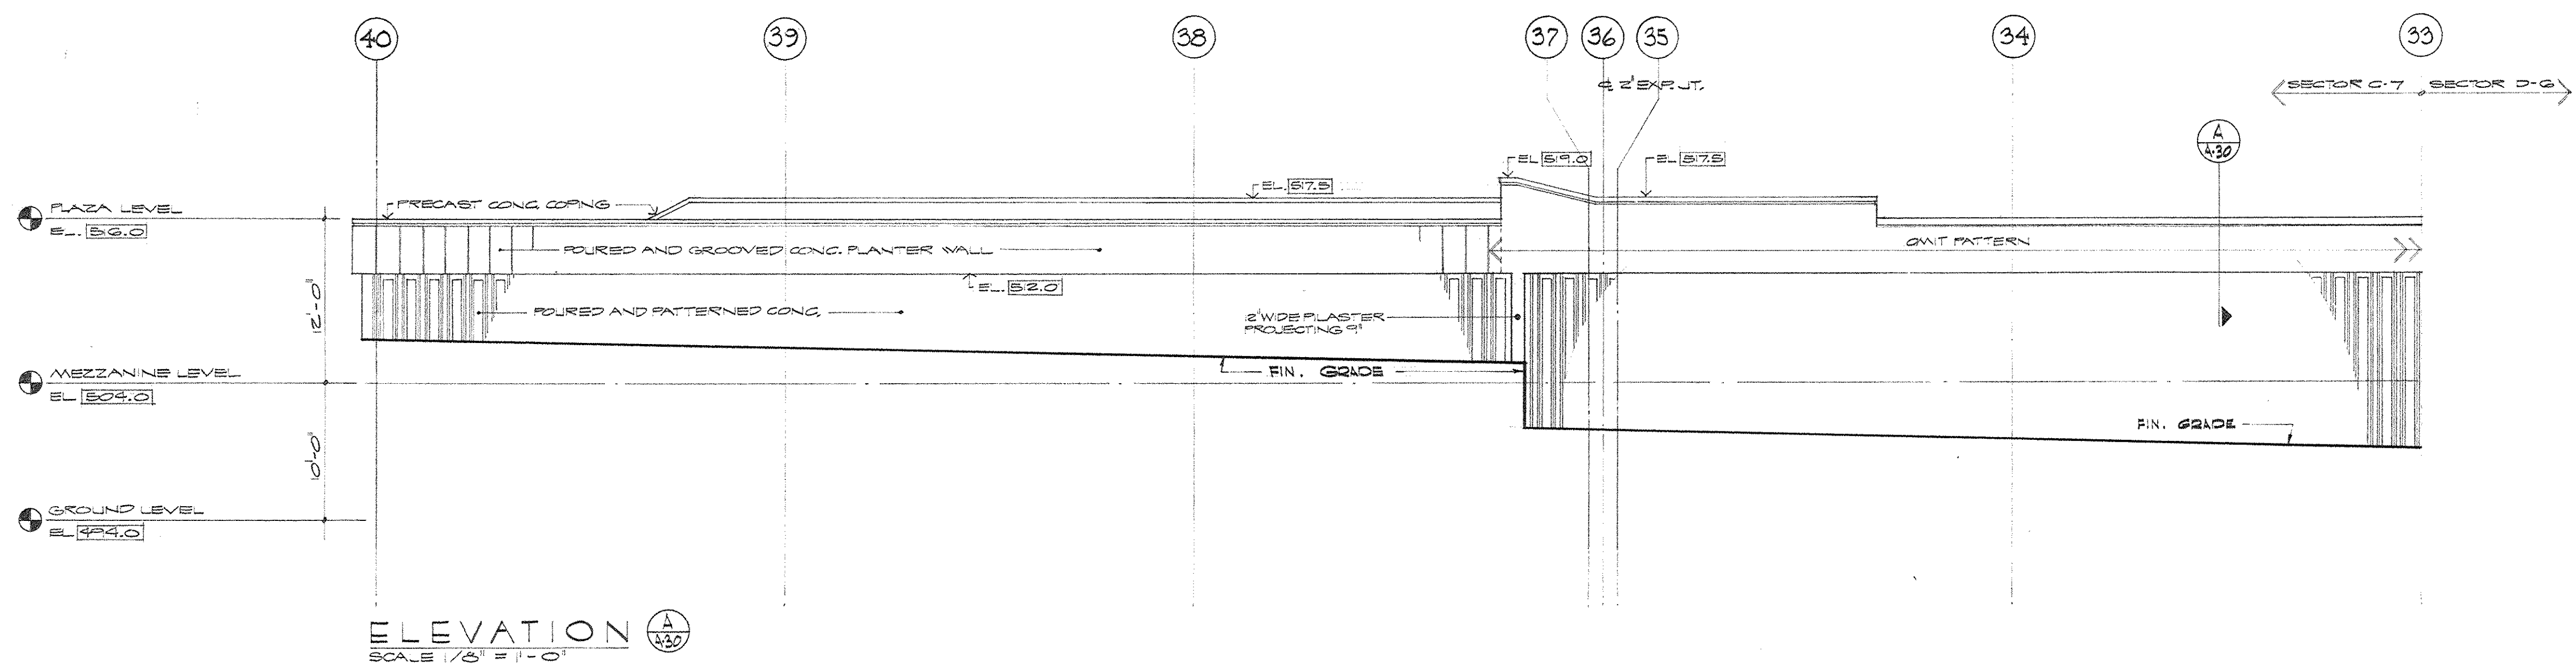


ELEVATION A
SCALE 1/8" = 1'-0"

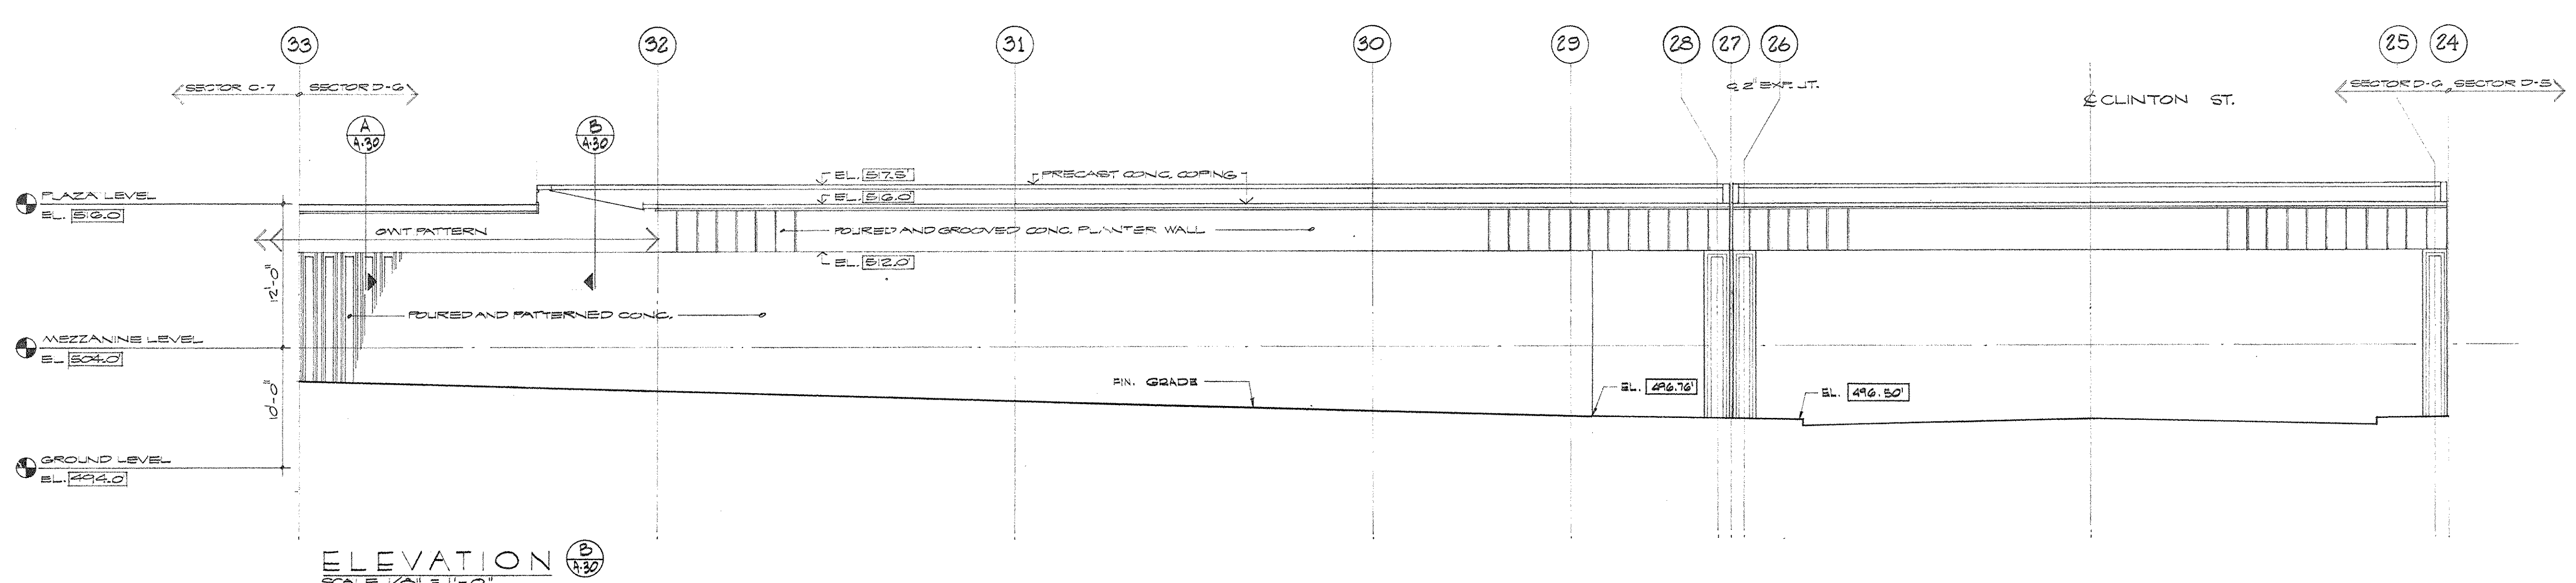


ELEVATION B
SCALE 1/8" = 1'-0"

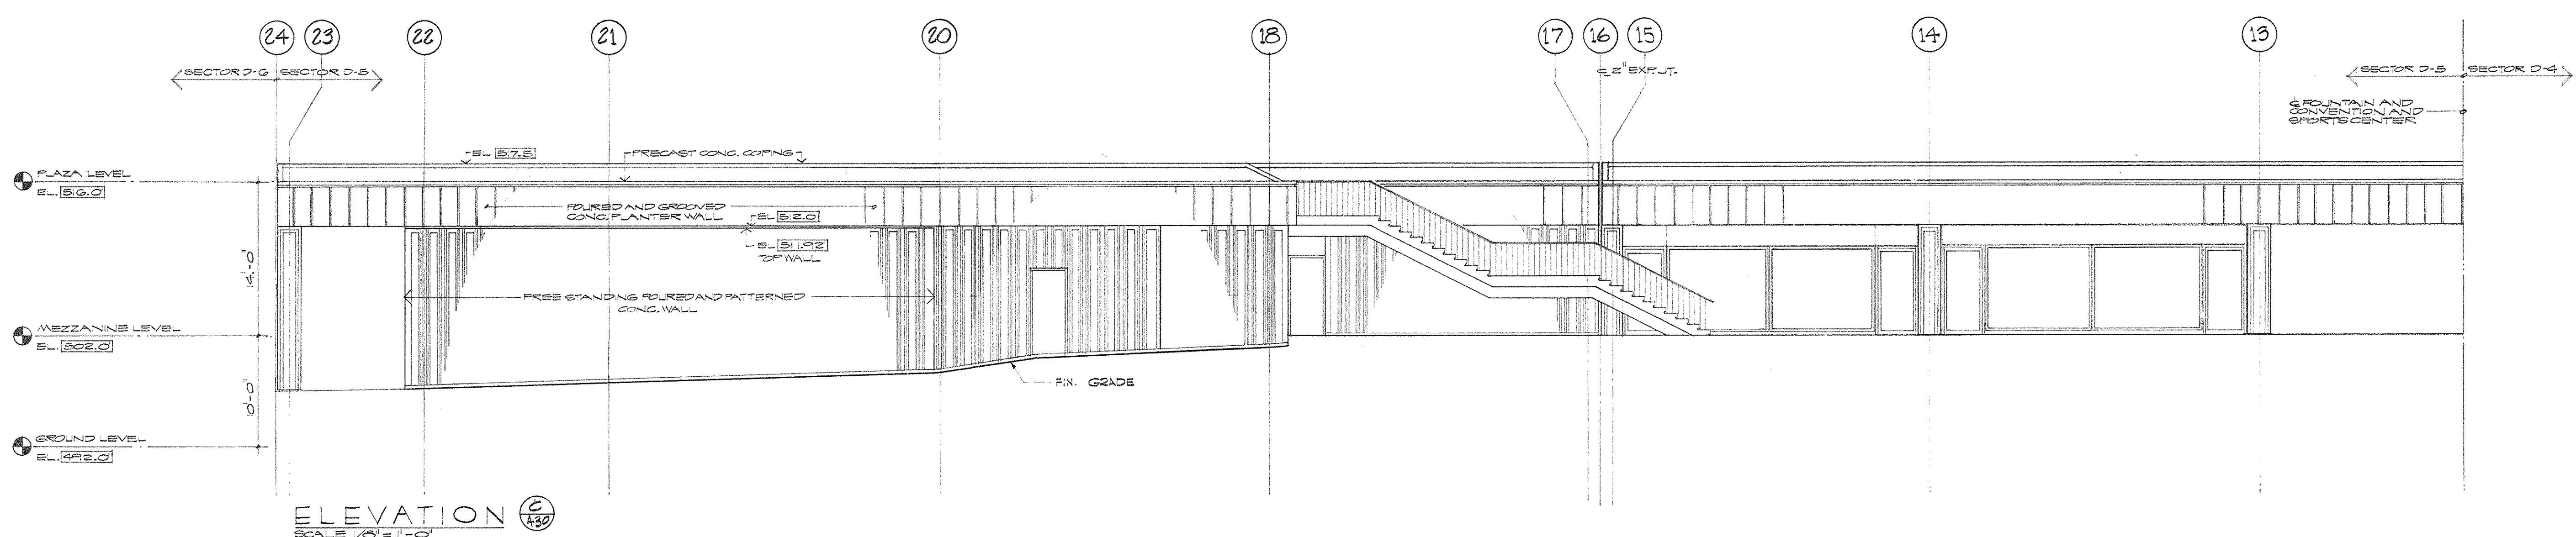


ELEVATION C
SCALE 1/8" = 1'-0"

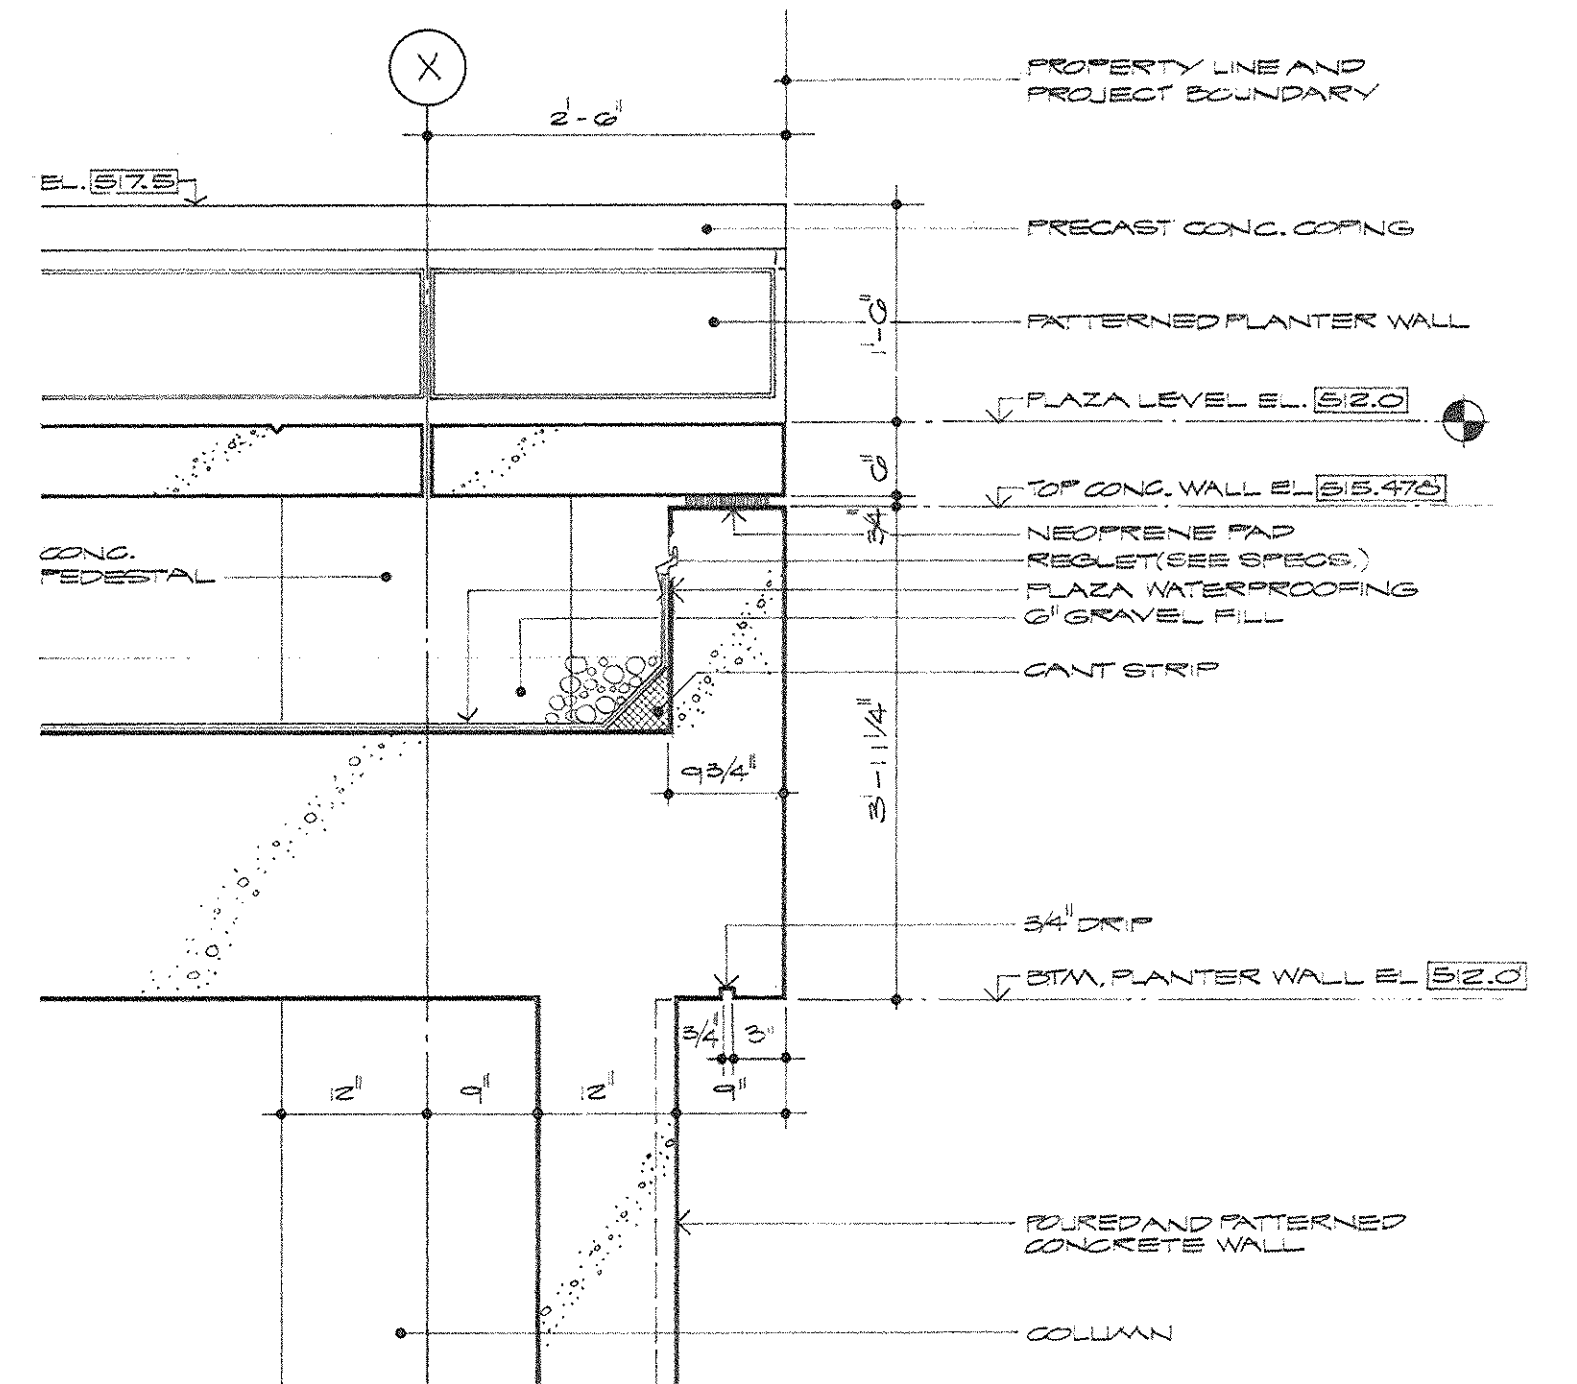

DETAIL A
SCALE 3/4" = 1'-0"


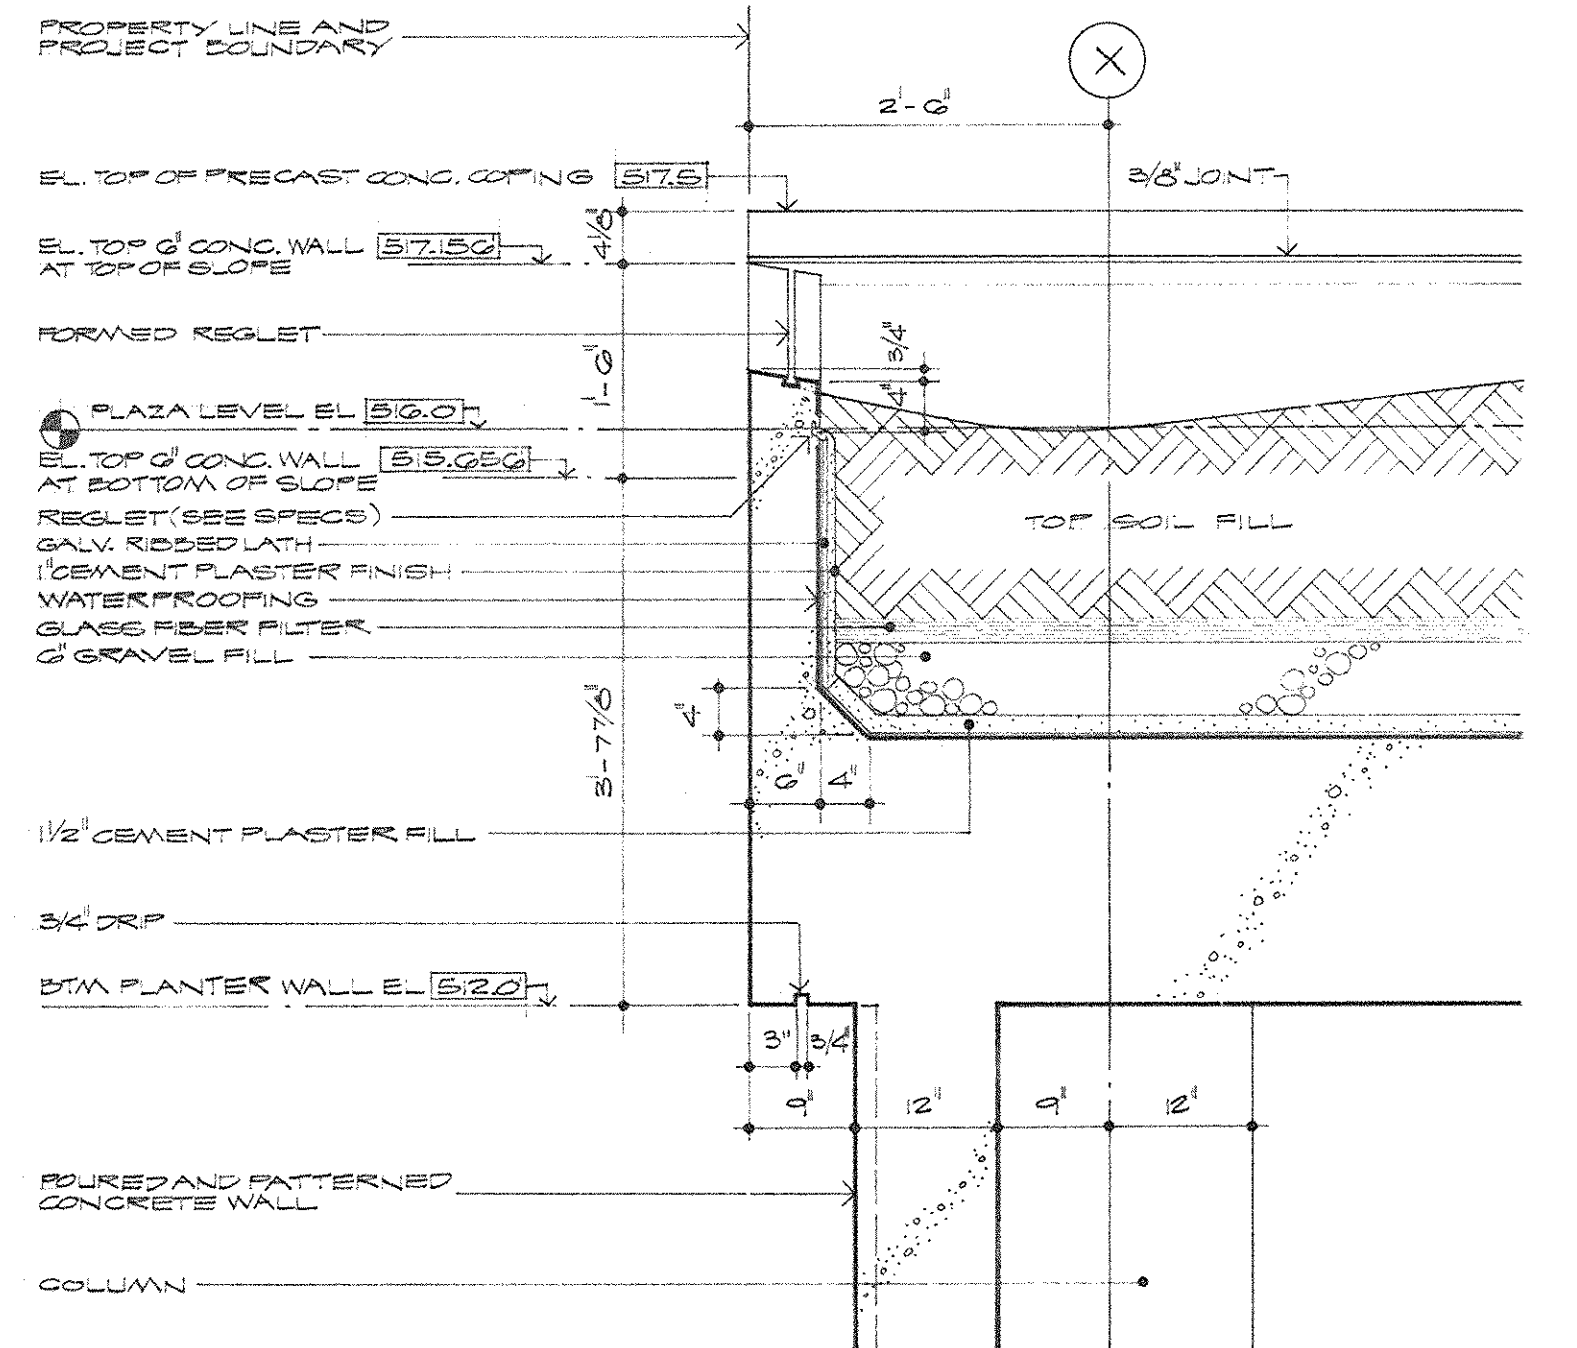


DETAIL B
SCALE 3/4" = 1'-0"

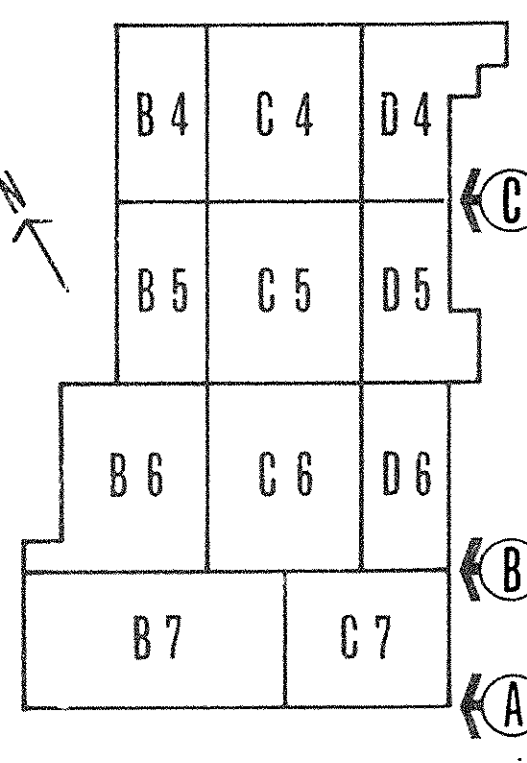


KEY PLAN

AS BUILT REVISIONS - 8-23-72

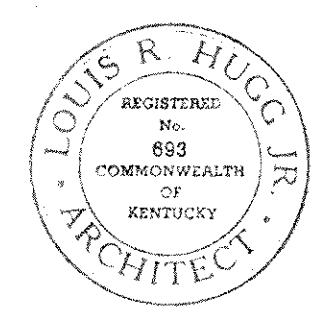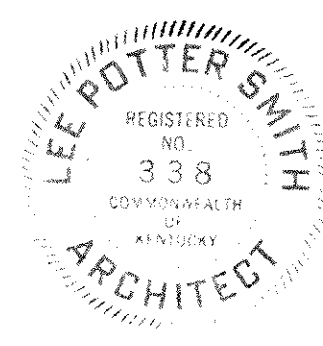


CAPITAL PLAZA DEVELOPMENT PHASE II
FRANKFORT, KENTUCKY


DRAWN BY W.D.	DATE 16 OCT. 1967
CHECKED BY L.P.S.	COMM. NO. 5937
SECTOR NO. LEE POTTER SMITH, PRITCHETT, HUGG & CARTER ARCHITECTS 314 WILKINSON STREET FRANKFORT, KENTUCKY	DRAWING NO. A 30 OF A-42
COMMONWEALTH OF KENTUCKY DEPARTMENT OF FINANCE - DIVISION OF ENGINEERING FRANKFORT, KENTUCKY	
APPROVED BY AGENCY HEAD	DATE
APPROVED BY OWNER	DATE 10-26-67

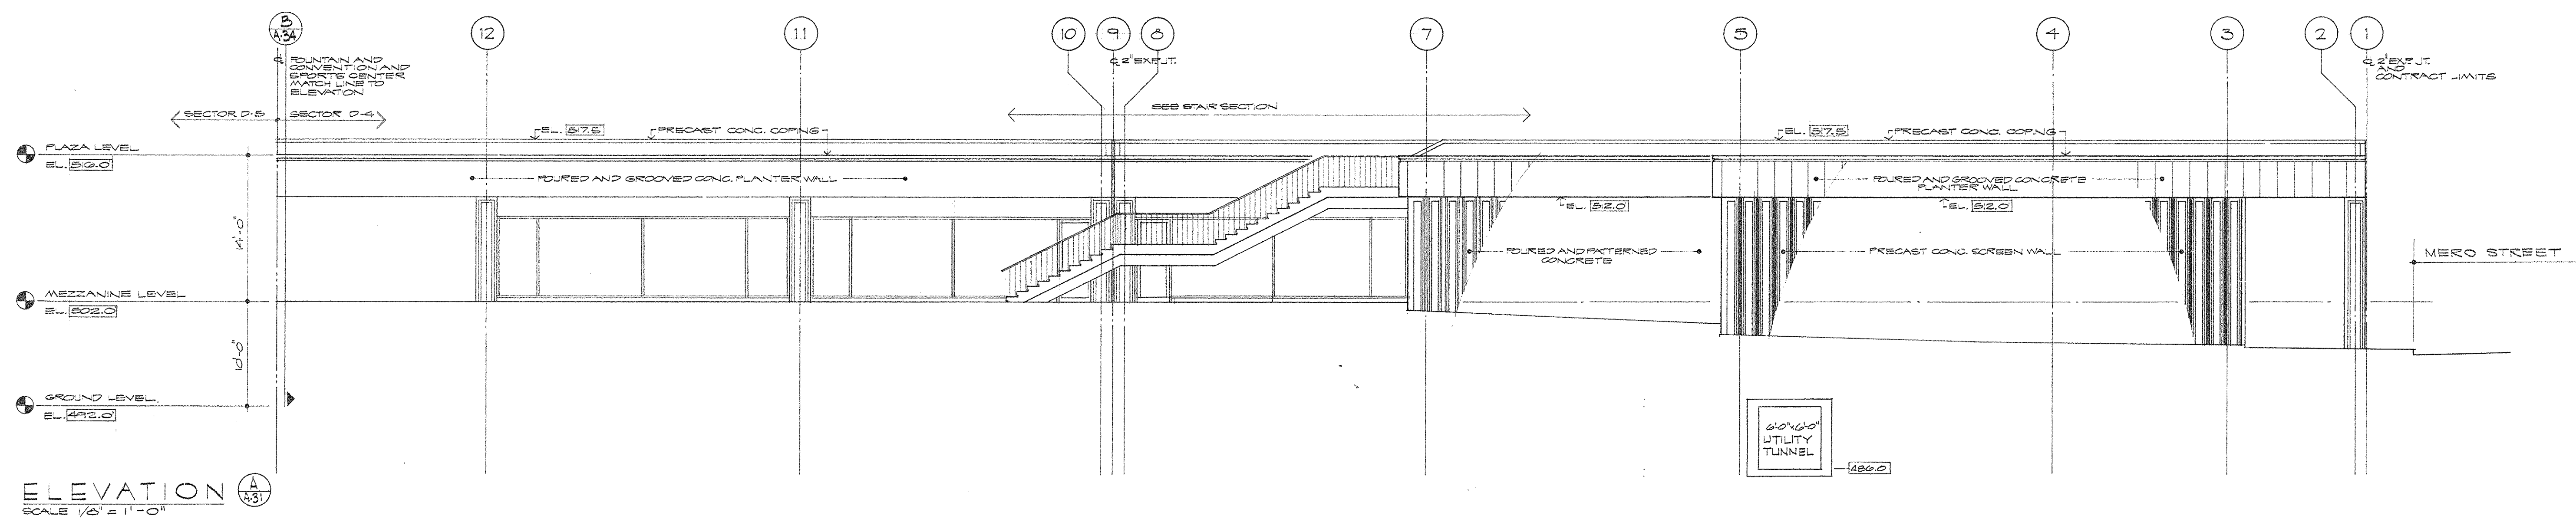


ELEVATION (A)
SCALE 1/8" = 1'-0"

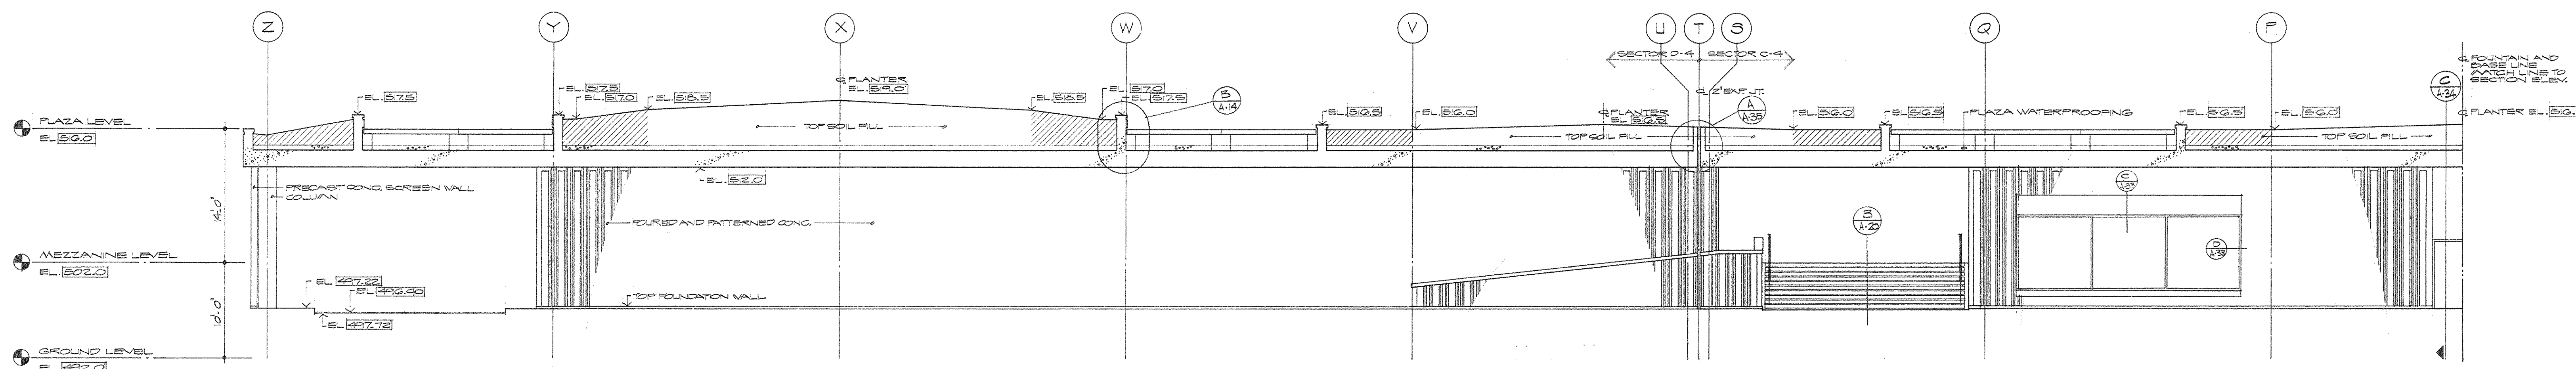


SECTION ELEVATION (B)
SCALE 1/8" = 1'-0"

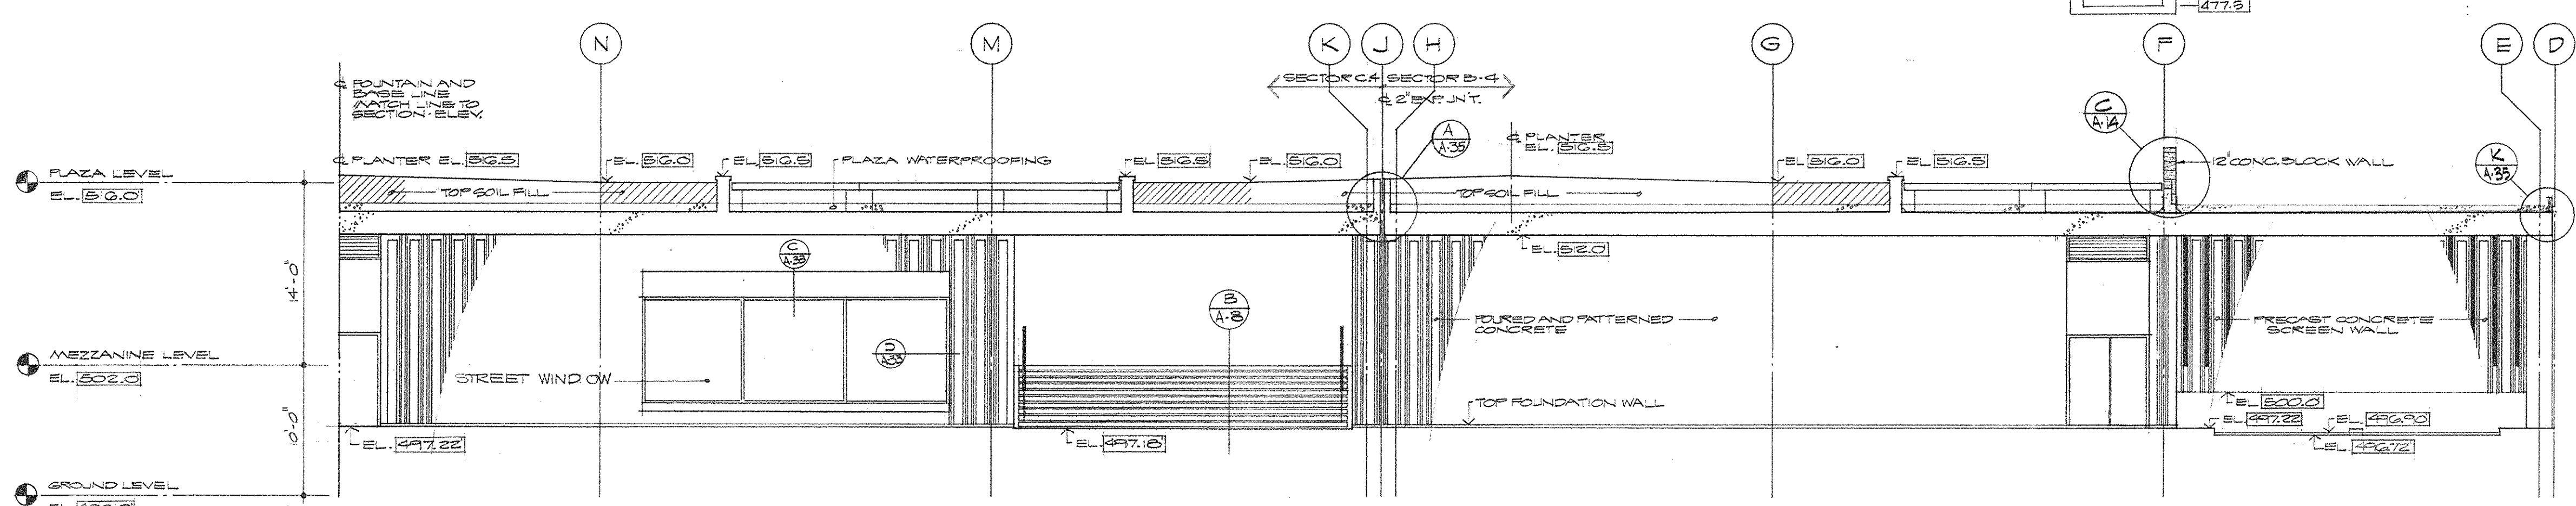

SECTION ELEVATION (C)
SCALE 1/8" = 1'-0"

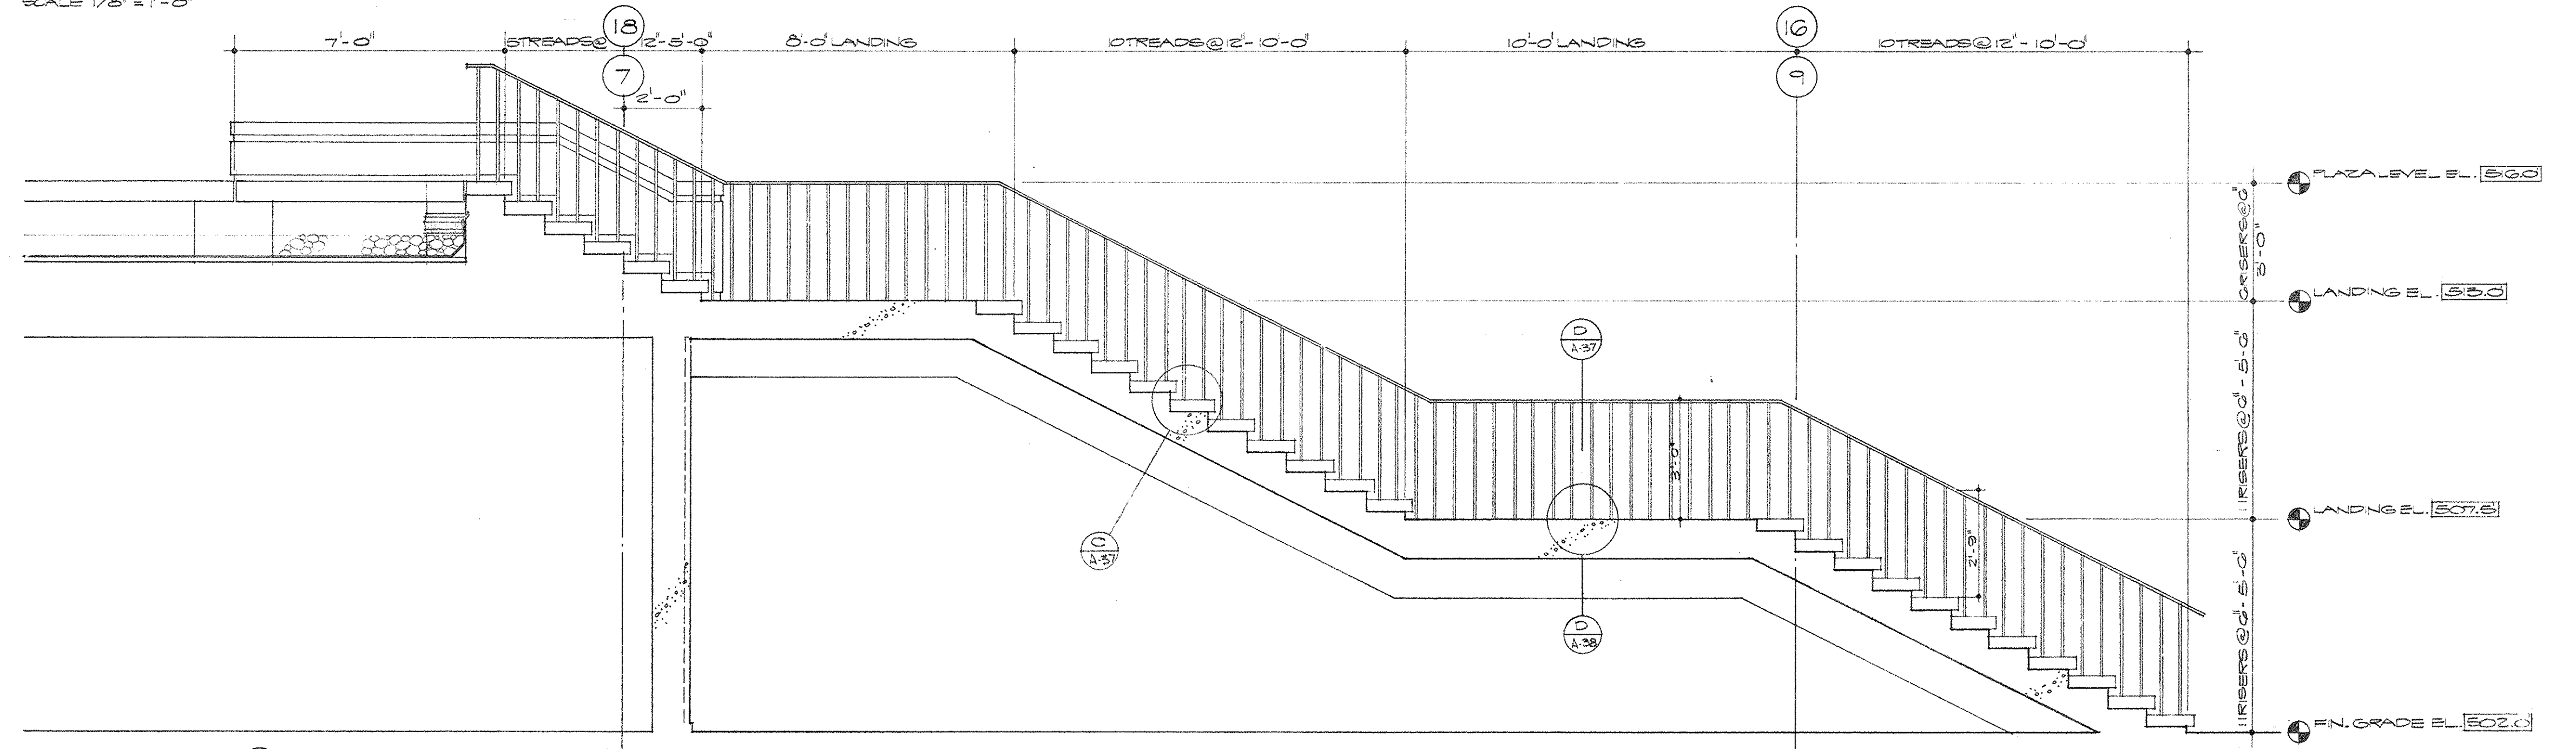


SECTION (D) STAIRS 0 & 9
SCALE 3/8" = 1'-0"

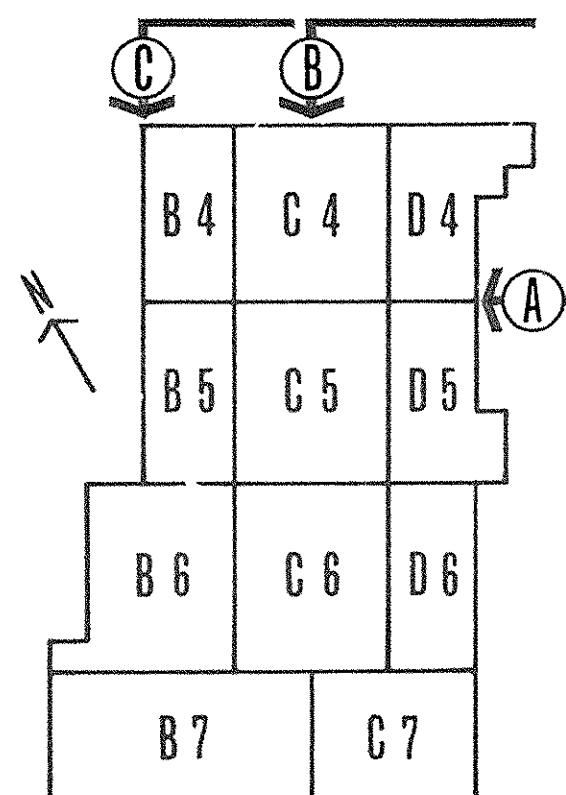


KEY PLAN


AS BUILT REVISIONS 6-24-72

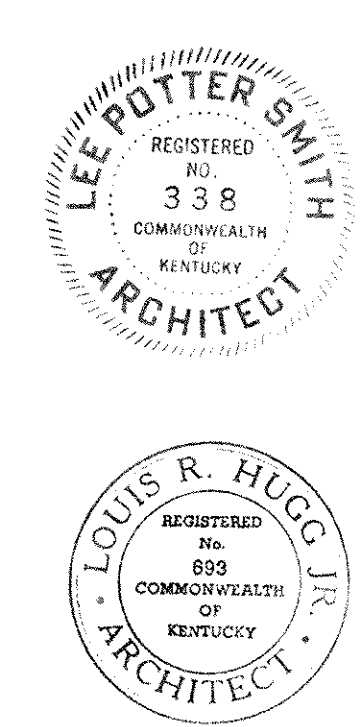



CAPITAL PLAZA DEVELOPMENT PHASE II		
FRANKFORT, KENTUCKY		
DRAWN BY W.D.	ELEVATIONS	DATE 12 OCT. 1967
CHECKED BY L.S.H.	LEE POTTER SMITH, PRITCHETT, HUGG & CARTER ARCHITECTS 314 WILKINSON STREET FRANKFORT, KENTUCKY	COMM. NO. 59367
SECTOR NO.	COMMONWEALTH OF KENTUCKY DEPARTMENT OF FINANCE - DIVISION OF ENGINEERING FRANKFORT, KENTUCKY	DRAWING NO. A 31 OF A 42
APPROVED BY AGENCY HEAD	DATE	
APPROVED BY OWNER	DATE	10-26-67

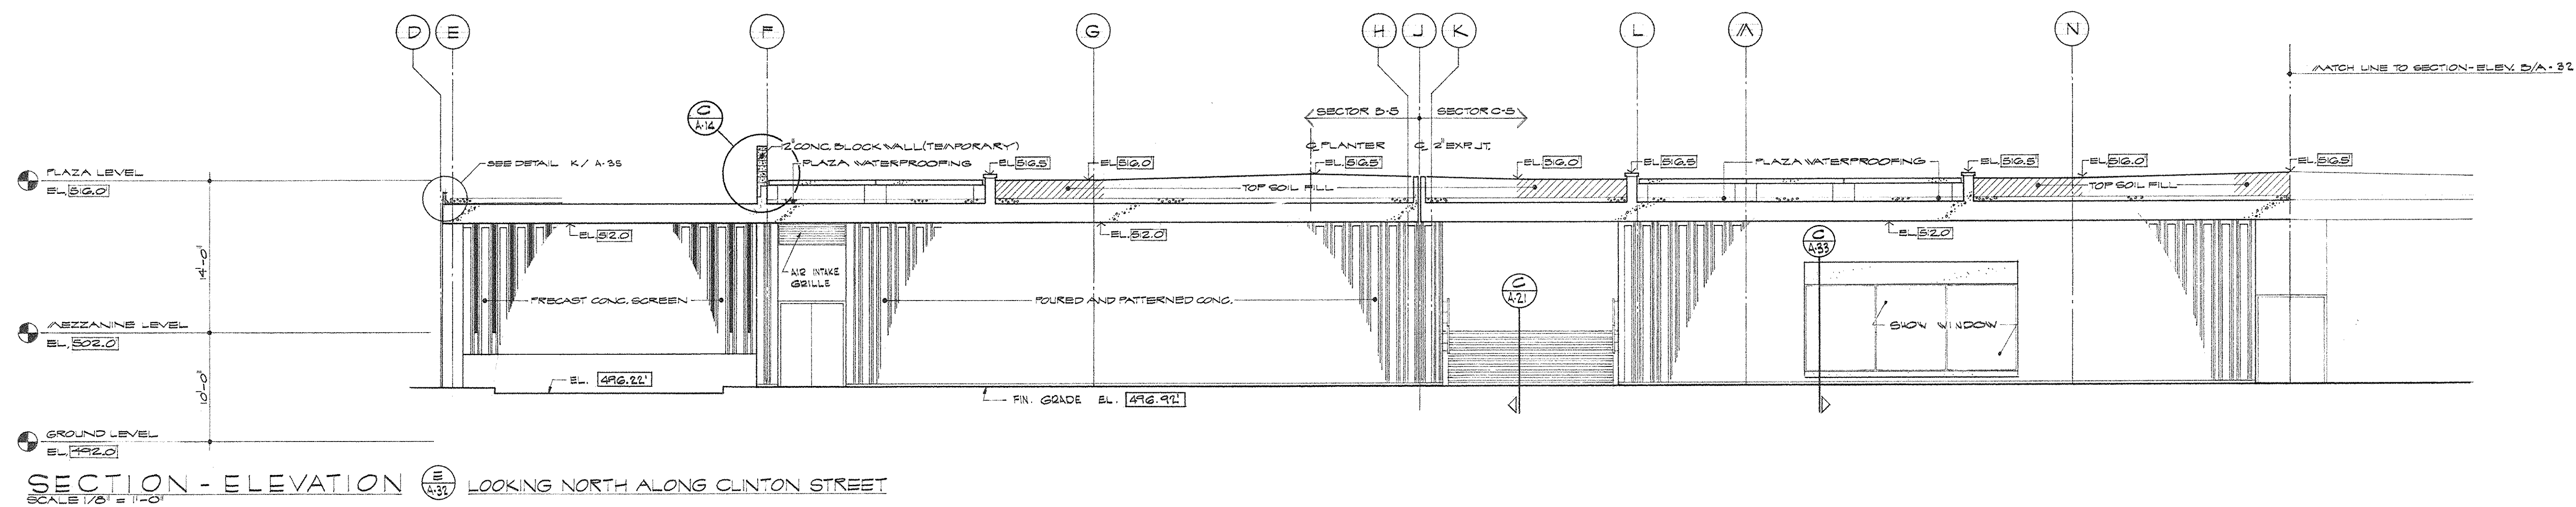

SECTION - ELEVATION (E) LOOKING NORTH ALONG CLINTON STREET
SCALE: 1/8" = 1'-0"


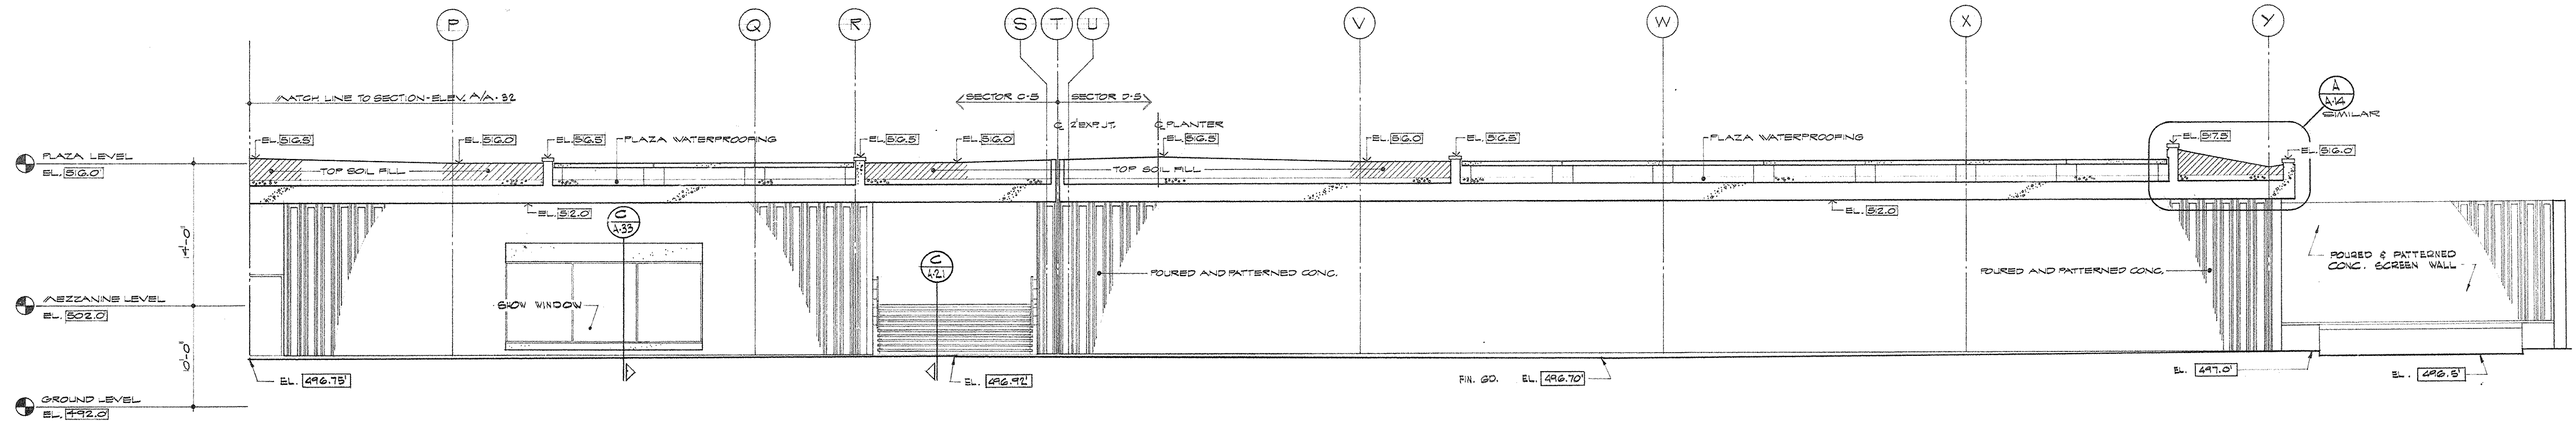


SECTION - ELEVATION (F) LOOKING NORTH ALONG CLINTON STREET
SCALE: 1/8" = 1'-0"

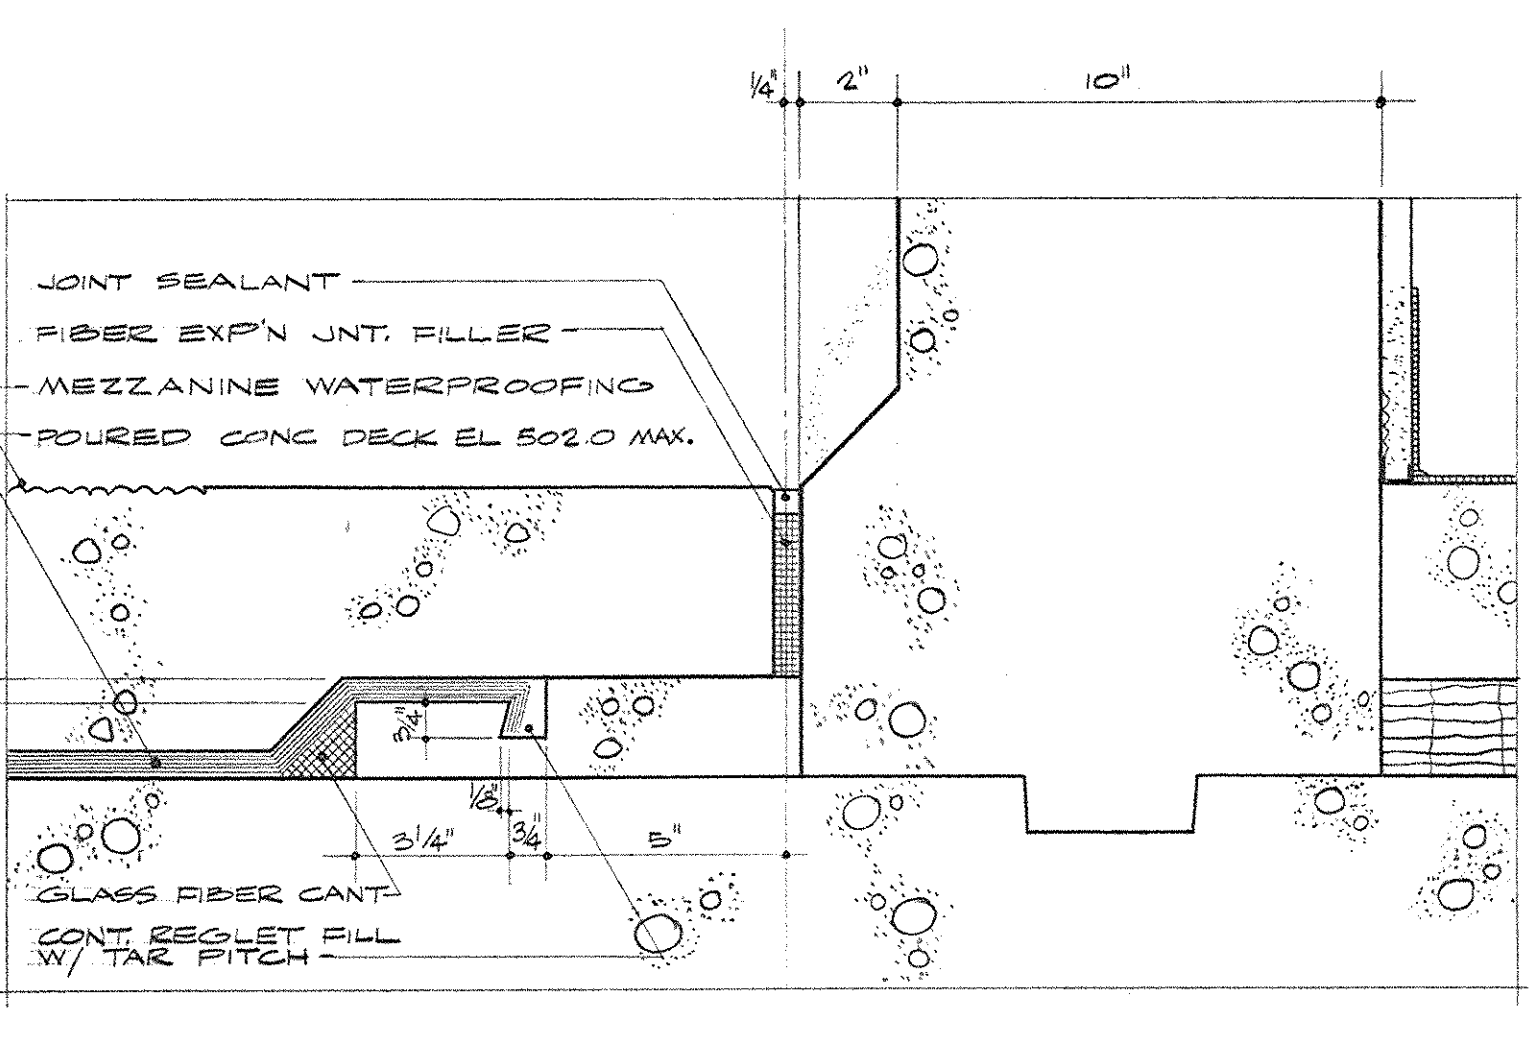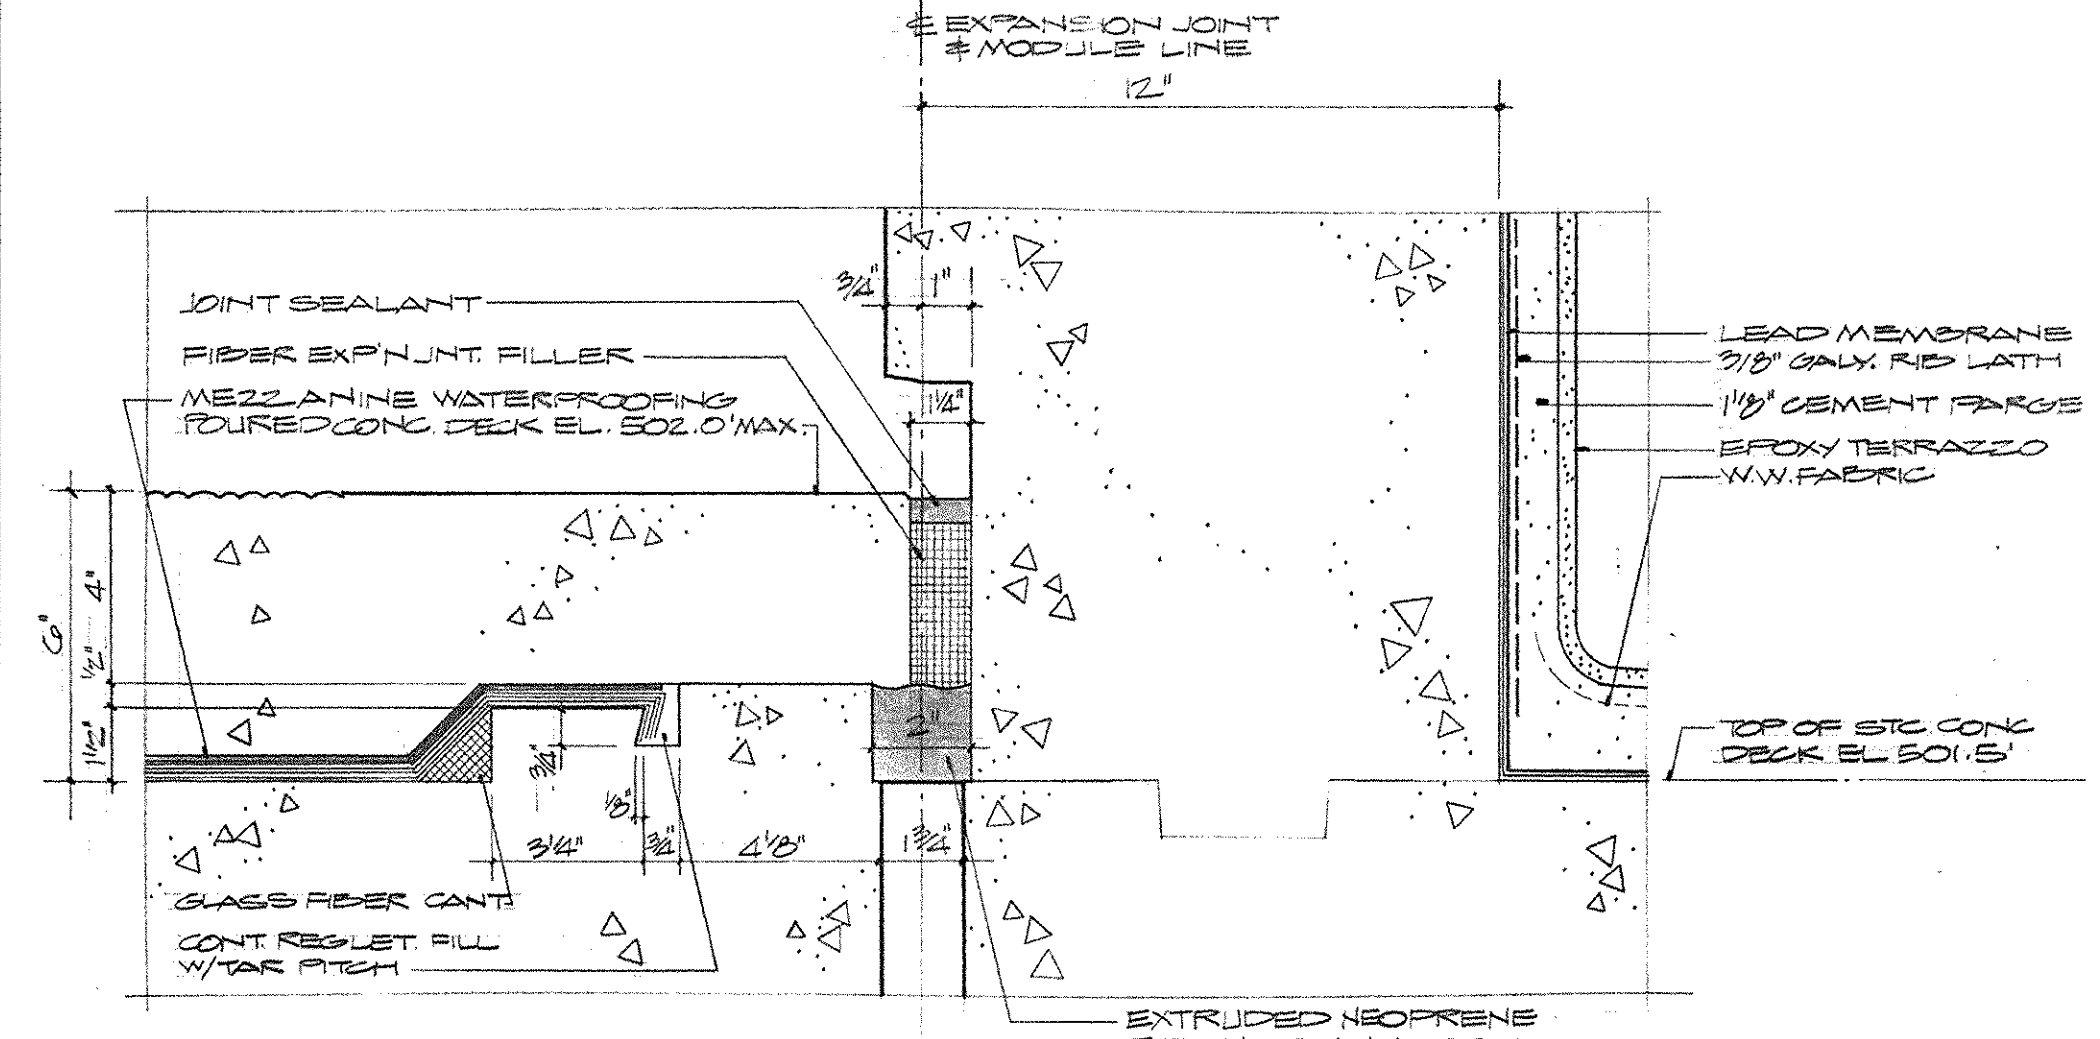


SECTION-DETAIL (A) THRU EXPANSION JOINT AT POOL WALL - MEZZANINE COURT
SCALE: 3/4" = 1'-0"

SECTION-DETAIL (B) THRU EXPANSION JOINT AT POOL WALL - MEZZANINE COURT
SCALE: 3/4" = 1'-0"

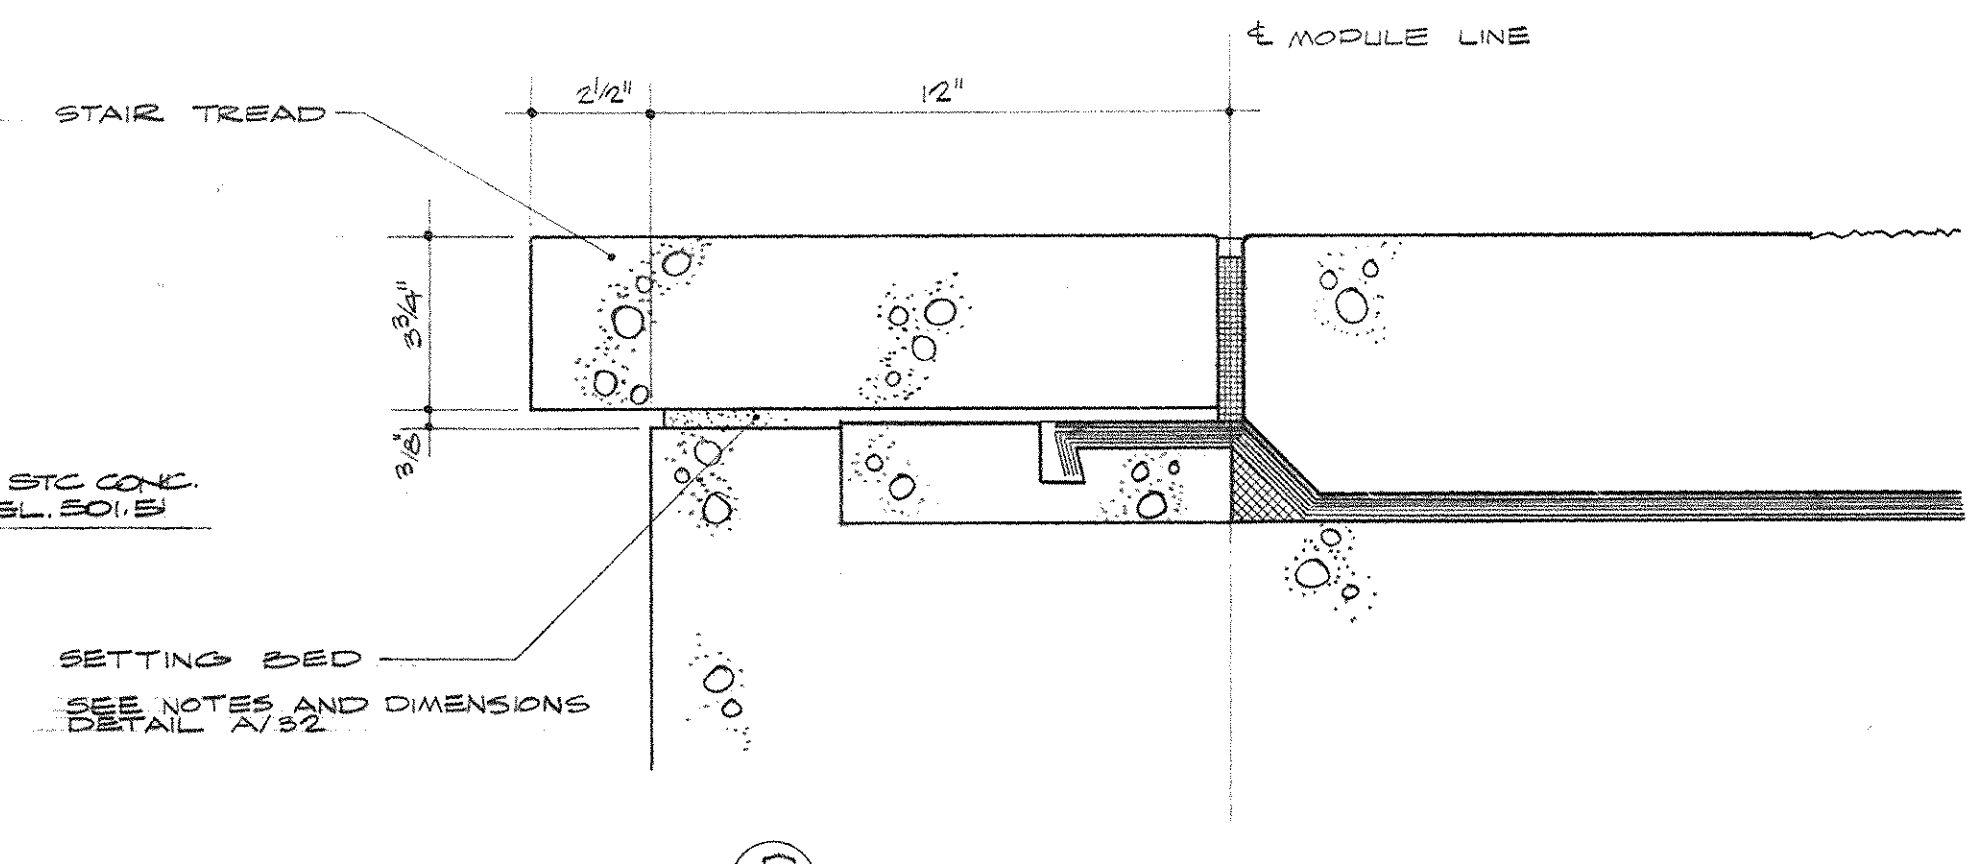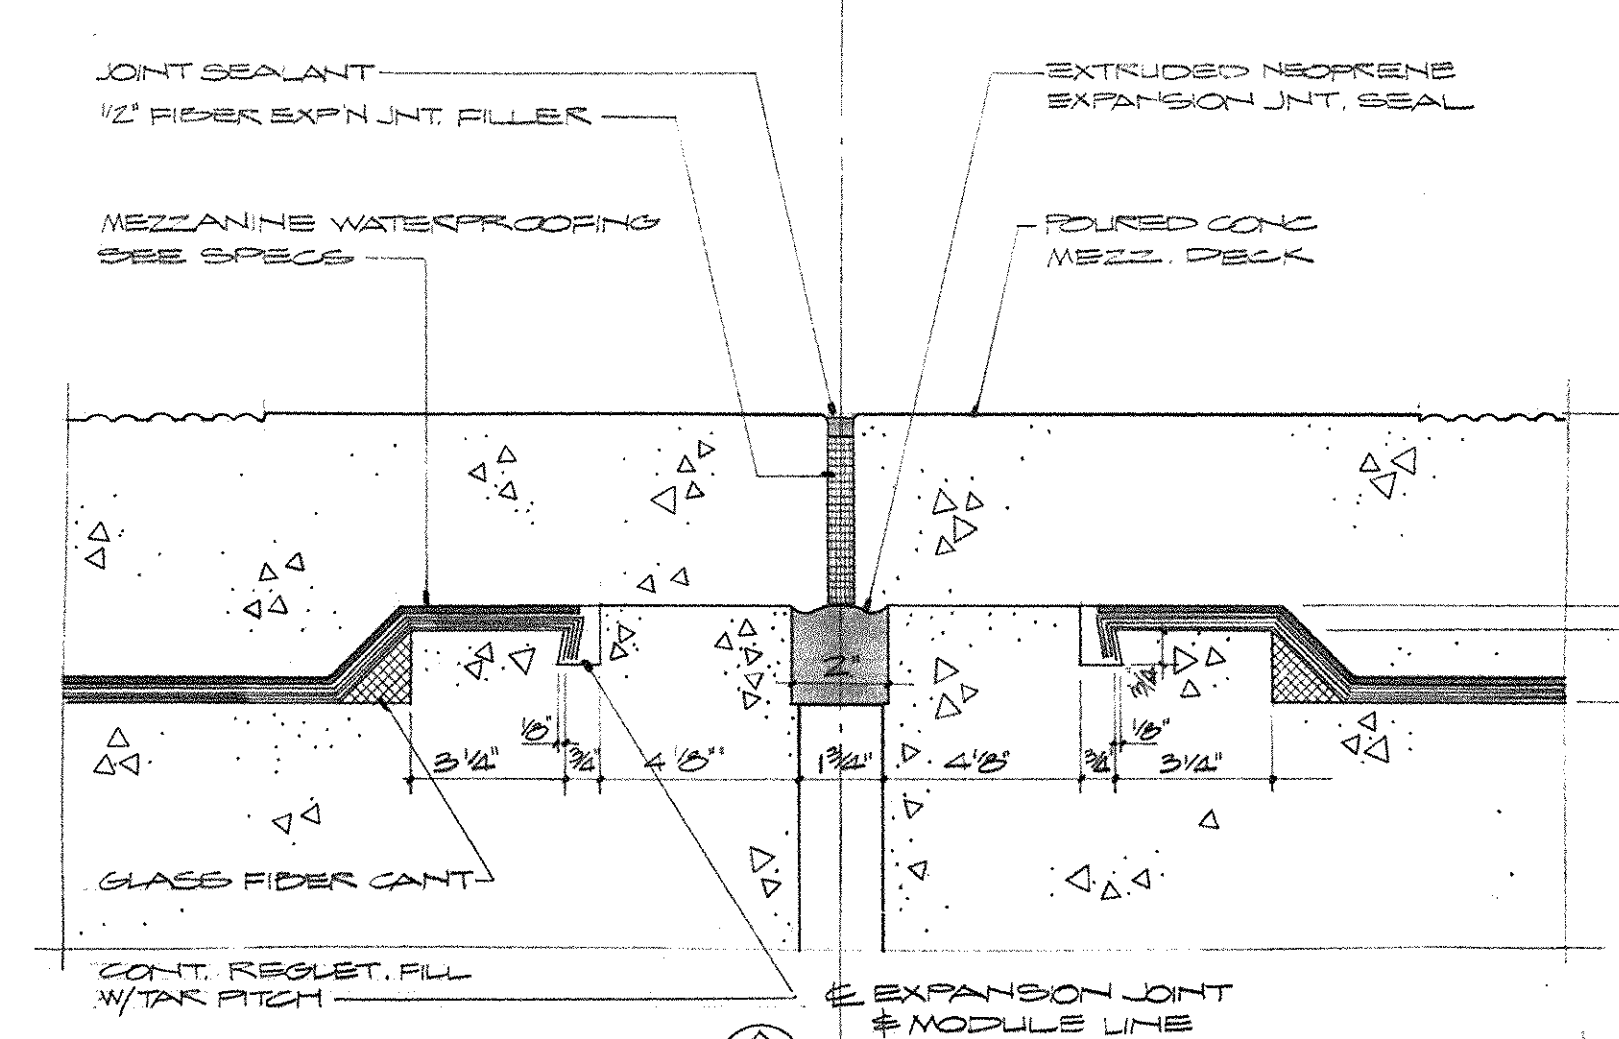



SECTION-DETAIL (C) THRU EXPANSION JOINT AT MEZZANINE COURT
SCALE: 3/4" = 1'-0"

SECTION-DETAIL (D) THRU EXPANSION JOINT AT MEZZANINE COURT
SCALE: 3/4" = 1'-0"

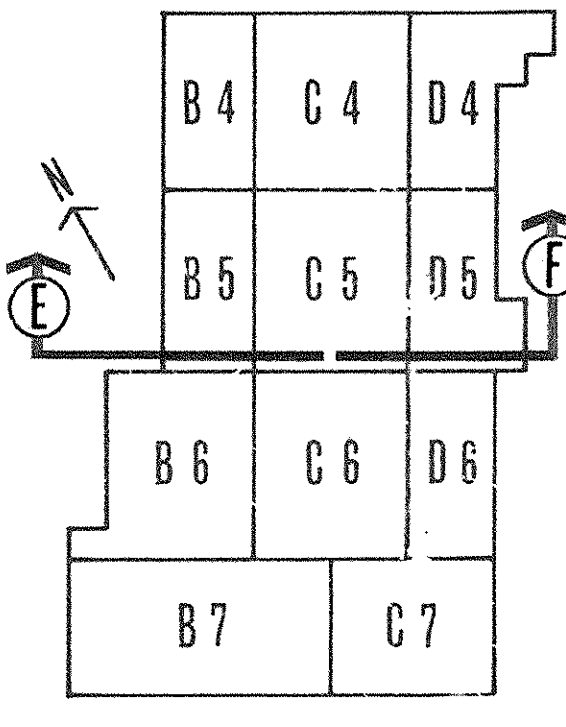


KEY PLAN


AS BUILT REVISIONS - 5-23-72

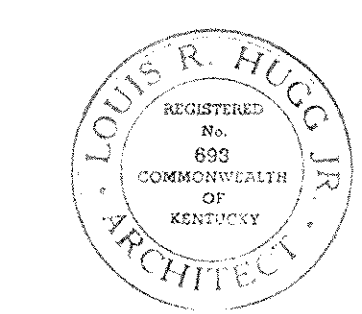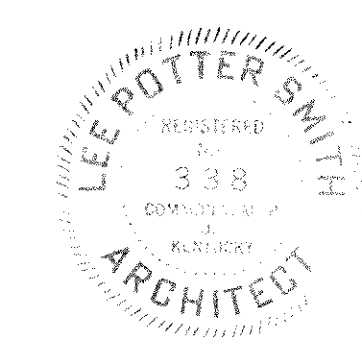


CAPITAL PLAZA DEVELOPMENT PHASE II		
FRANKFORT, KENTUCKY		
DRAWN BY W.D.	DATE 16 OCT 1967	COMM. NO. 50387
CHECKED BY L.R.H.	DRAWING NO. A 32	
SECTOR NO.	ARCHITECTS LEE POTTER SMITH, PRITCHETT, HUGG & CARTER 914 WILKINSON STREET FRANKFORT, KENTUCKY	ENGINEERS COMMONWEALTH OF KENTUCKY DEPARTMENT OF FINANCE - DIVISION OF ENGINEERING FRANKFORT, KENTUCKY
APPROVED BY AGENCY HEAD	DATE 10-24-67	OWNER W.D. Mc Connell

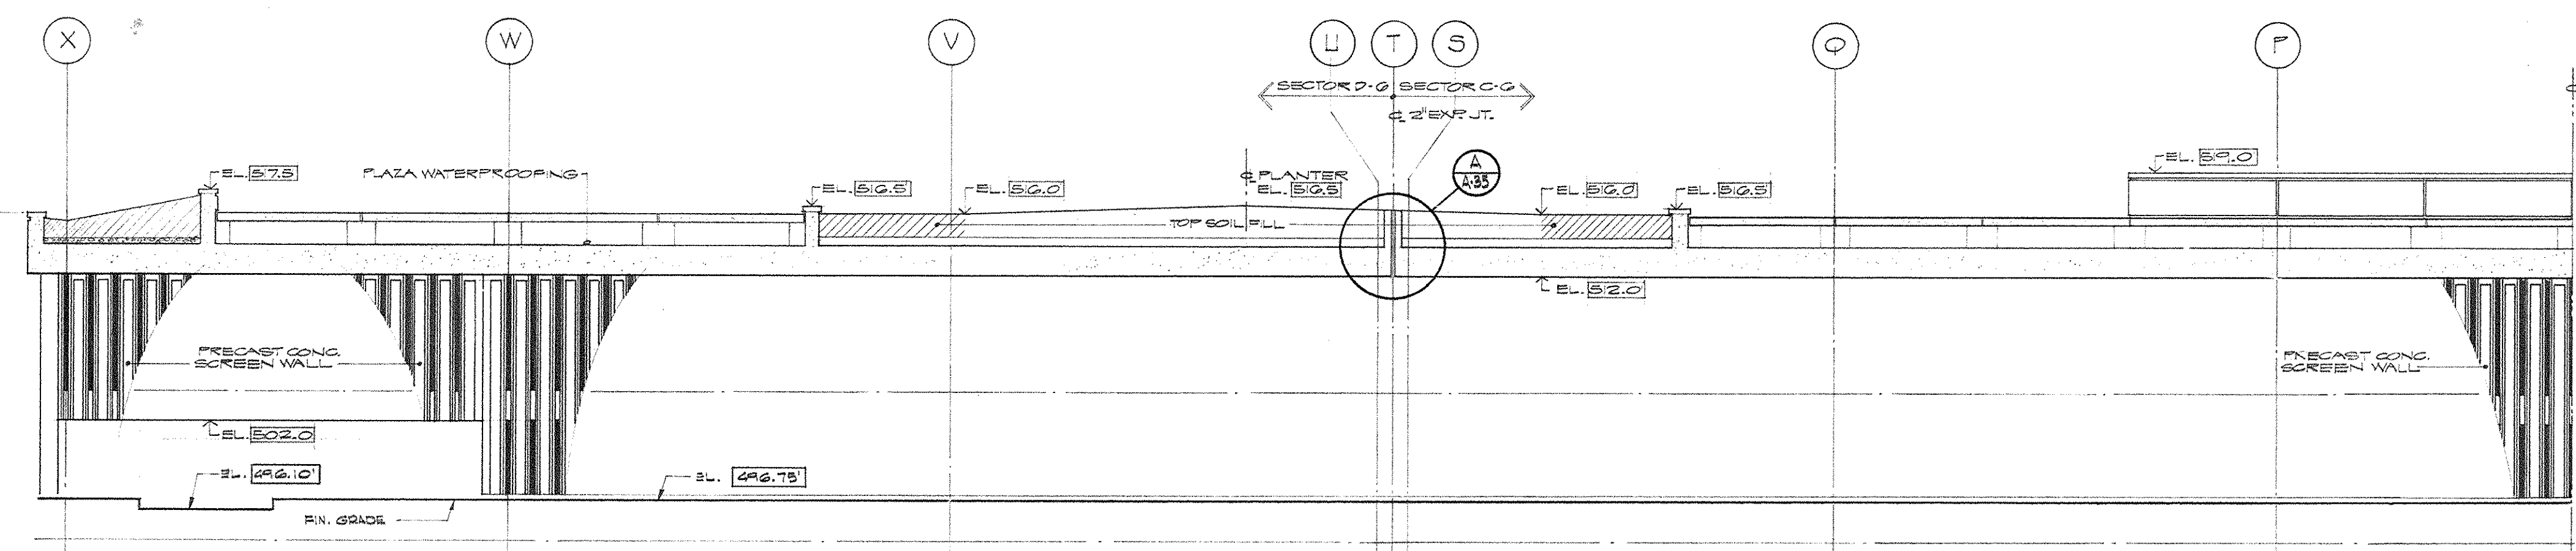


SECTION ELEVATION A-33 LOOKING SOUTH ALONG CLINTON STREET
SCALE: 1/8" = 1'-0"

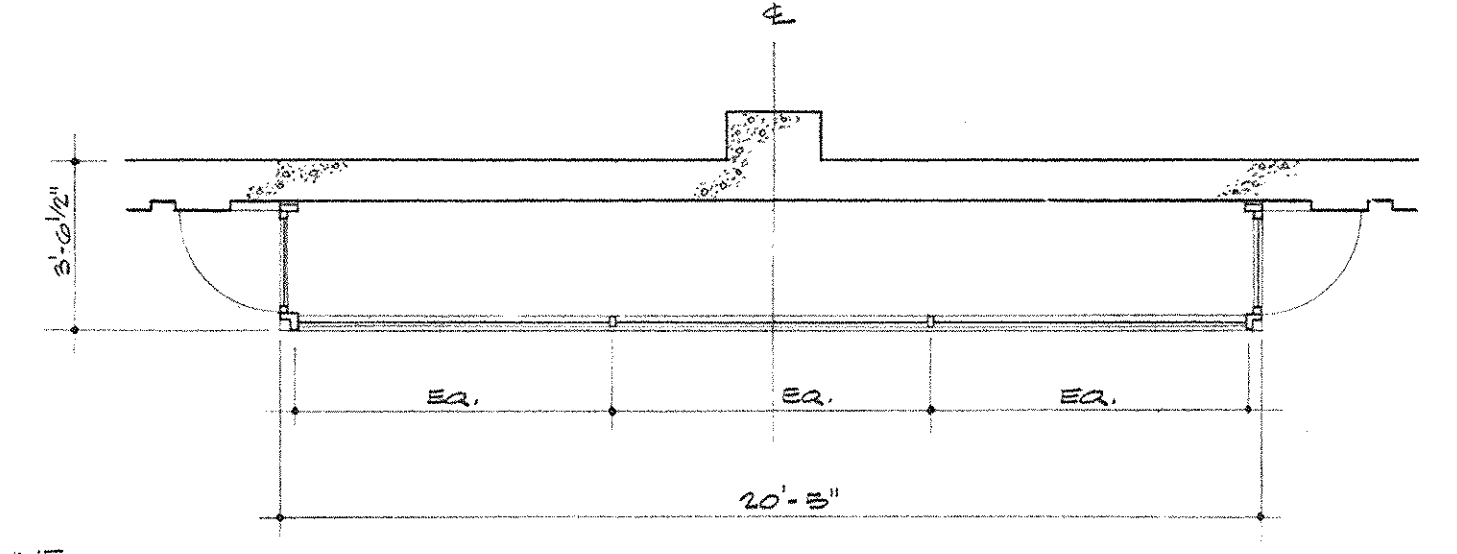


PLAN MEZZANINE WINDOWS
SCALE: 1/4" = 1'-0"

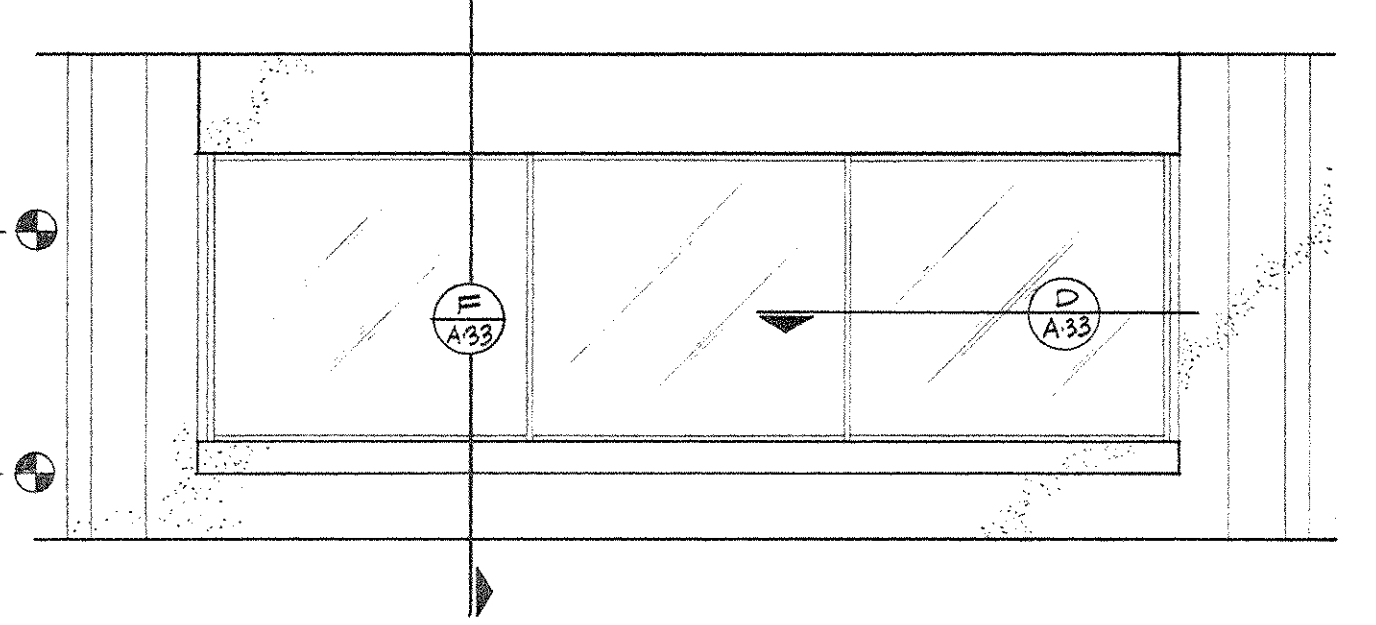


ELEVATION MEZZANINE WINDOWS
SCALE: 1/4" = 1'-0"

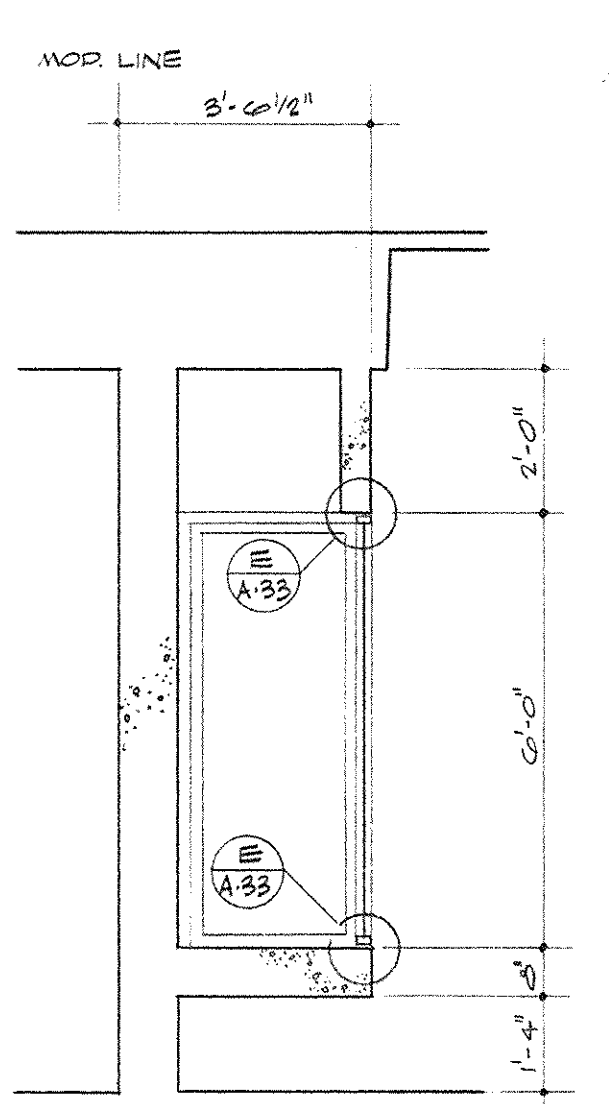


SECTION B-33
SCALE: 3/8" = 1'-0"

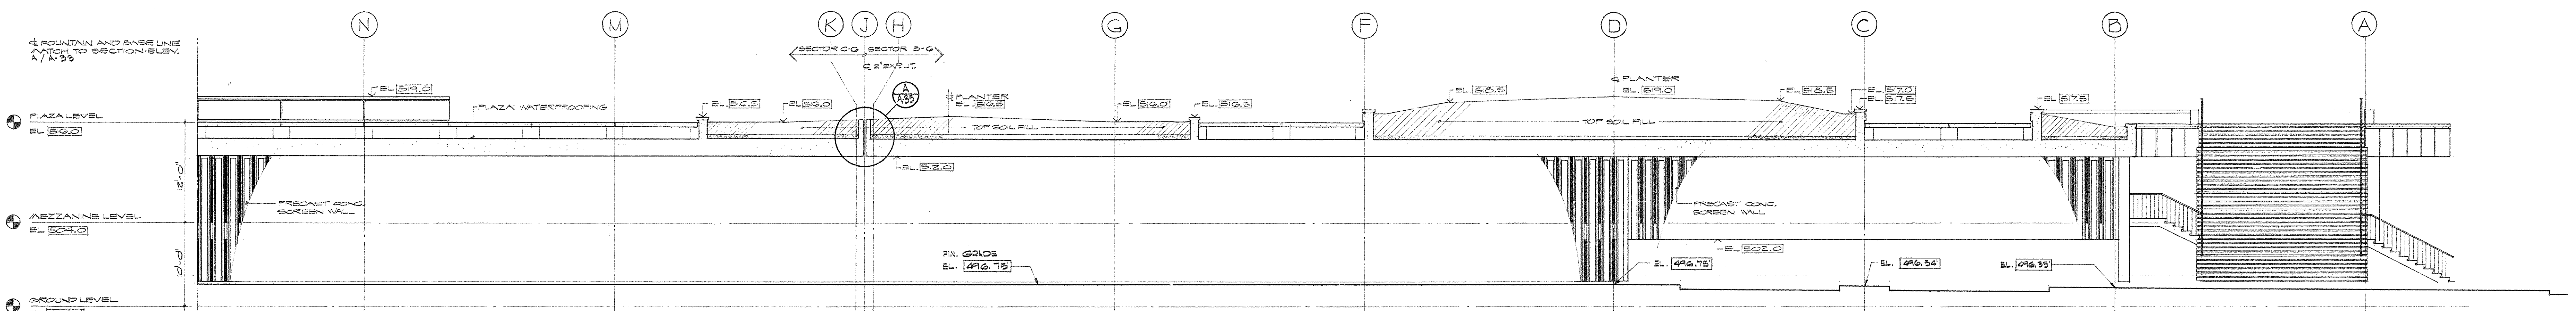


SECTION ELEVATION B-33 LOOK SOUTH ALONG CLINTON STREET
SCALE: 1/8" = 1'-0"

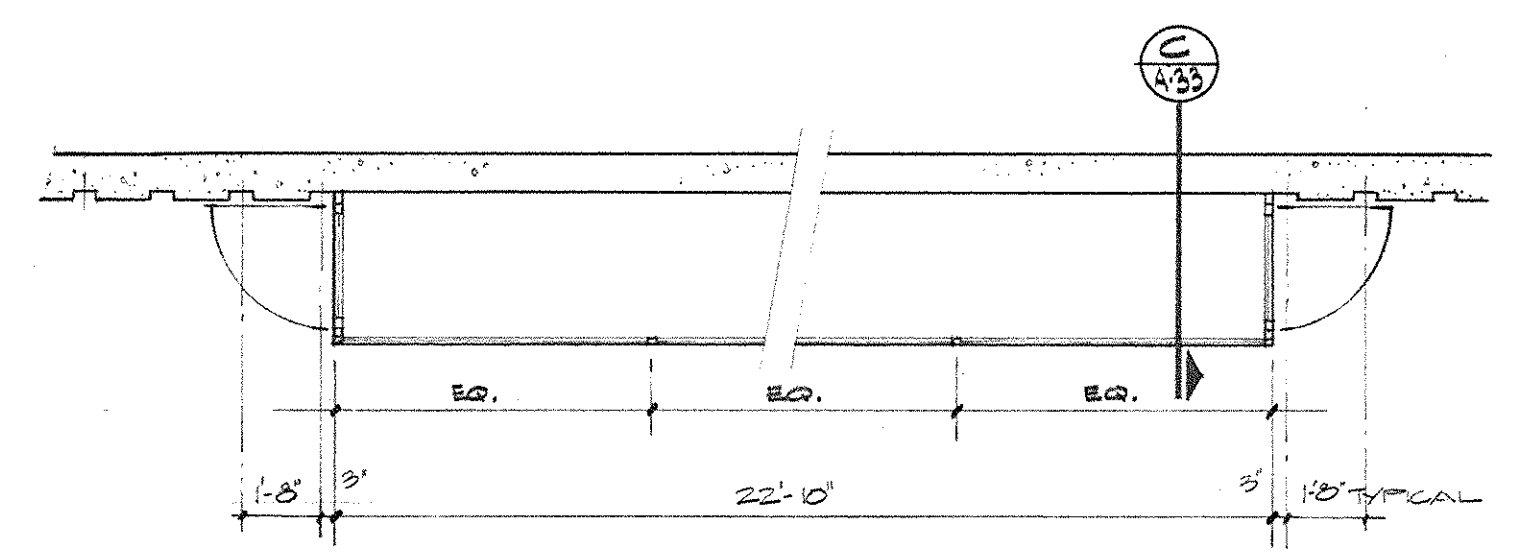


PLAN STREET WINDOWS
SCALE: 1/8" = 1'-0"

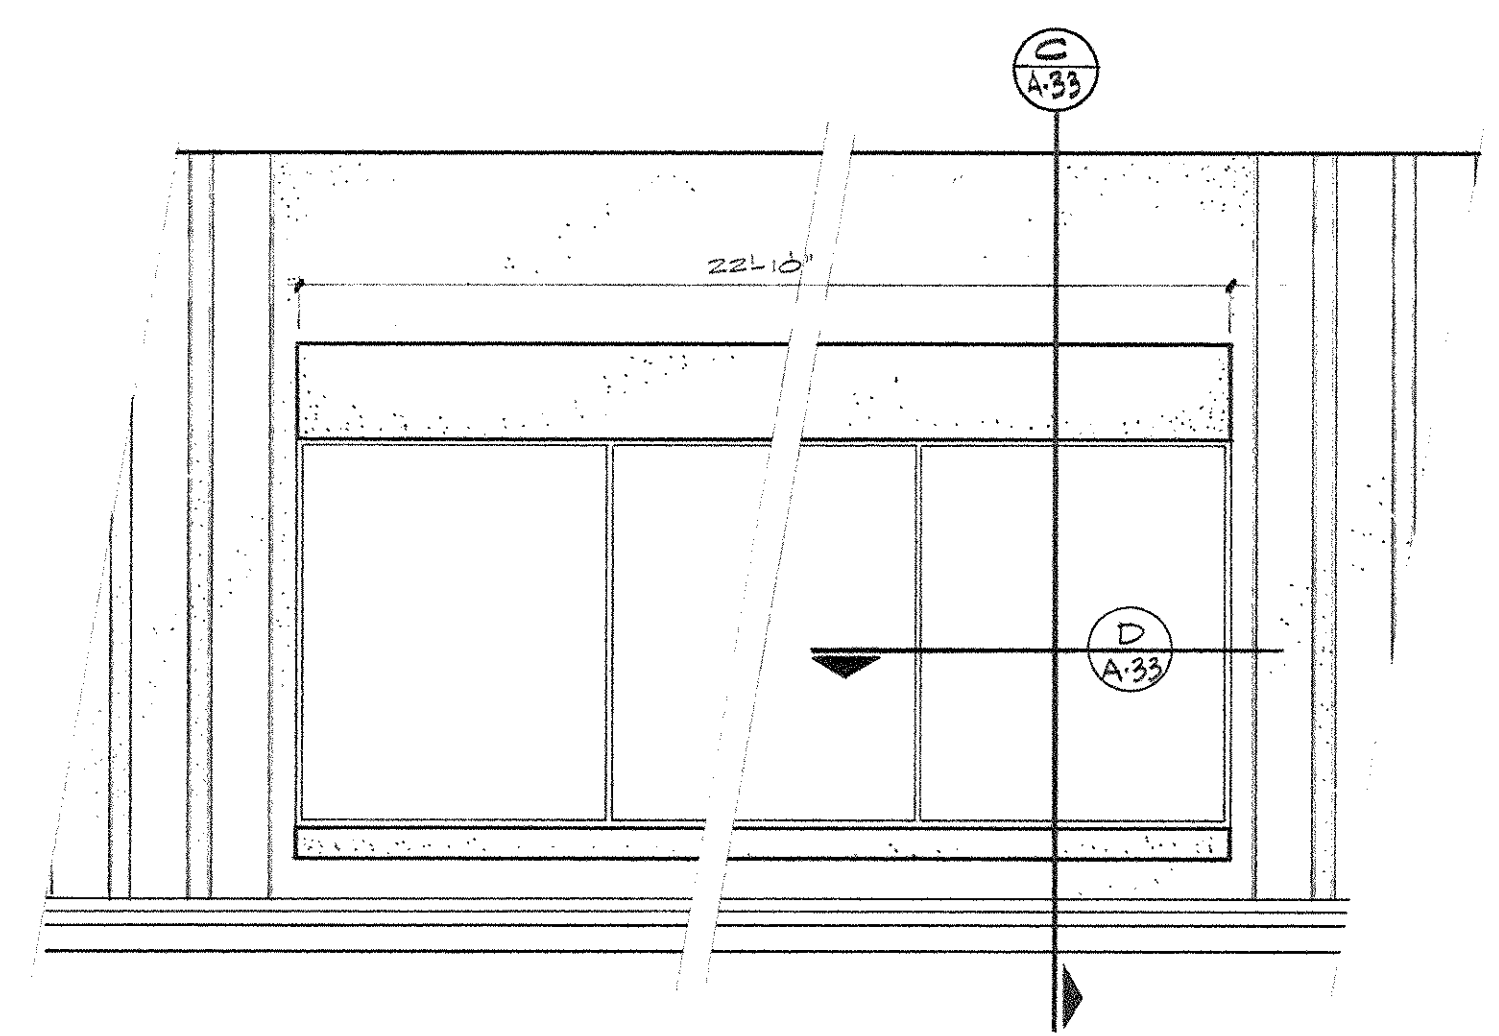


ELEVATION STREET WINDOWS
SCALE: 1/4" = 1'-0"

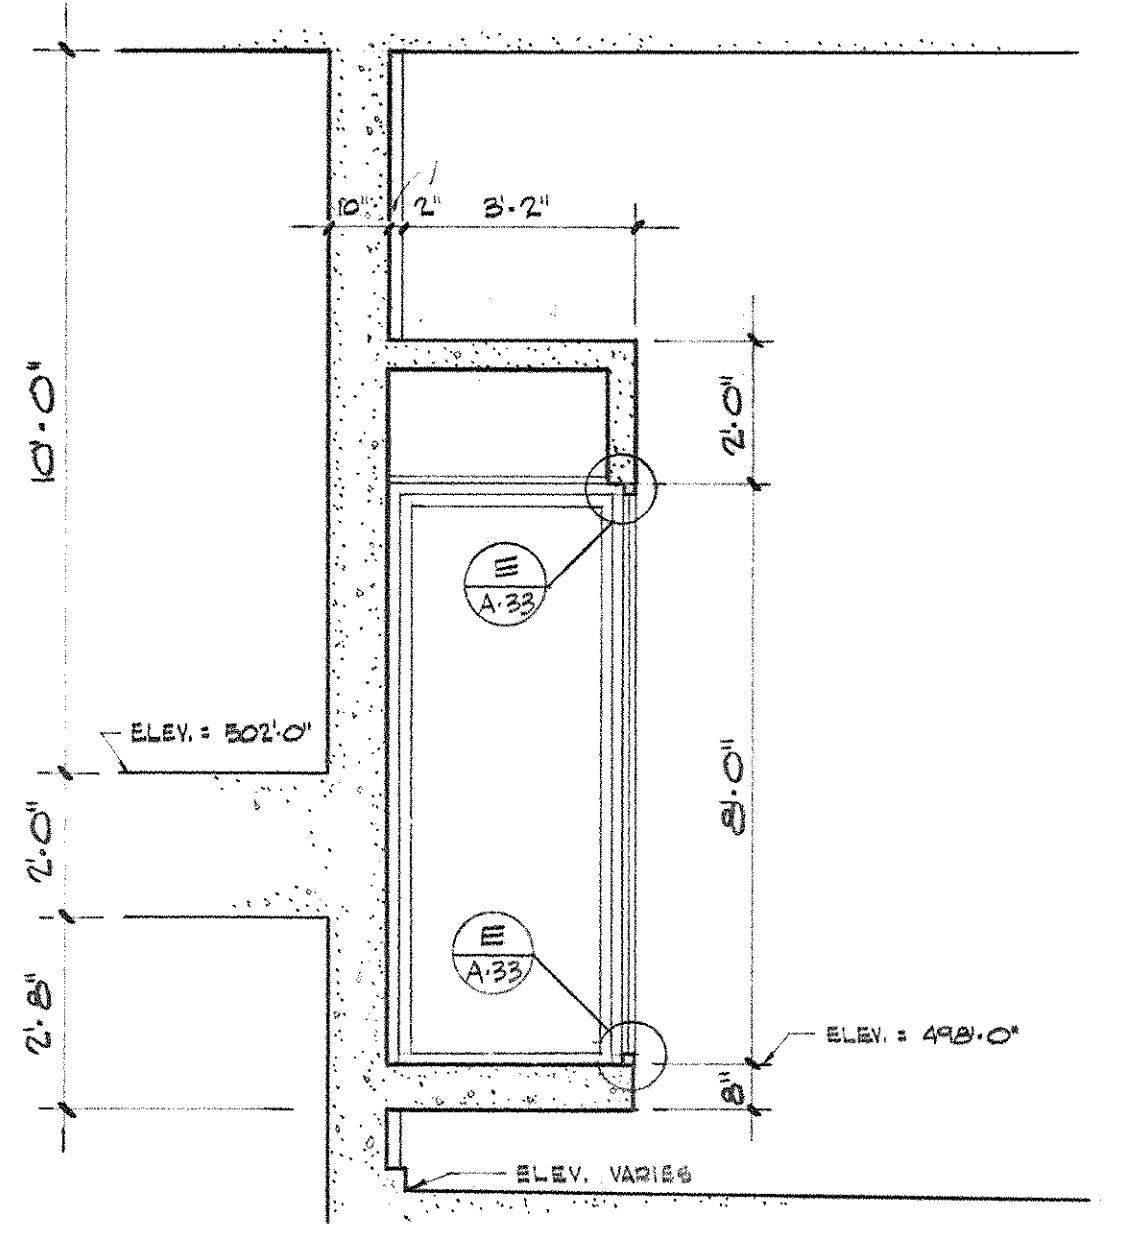


SECTION C-33
SCALE: 1/8" = 1'-0"

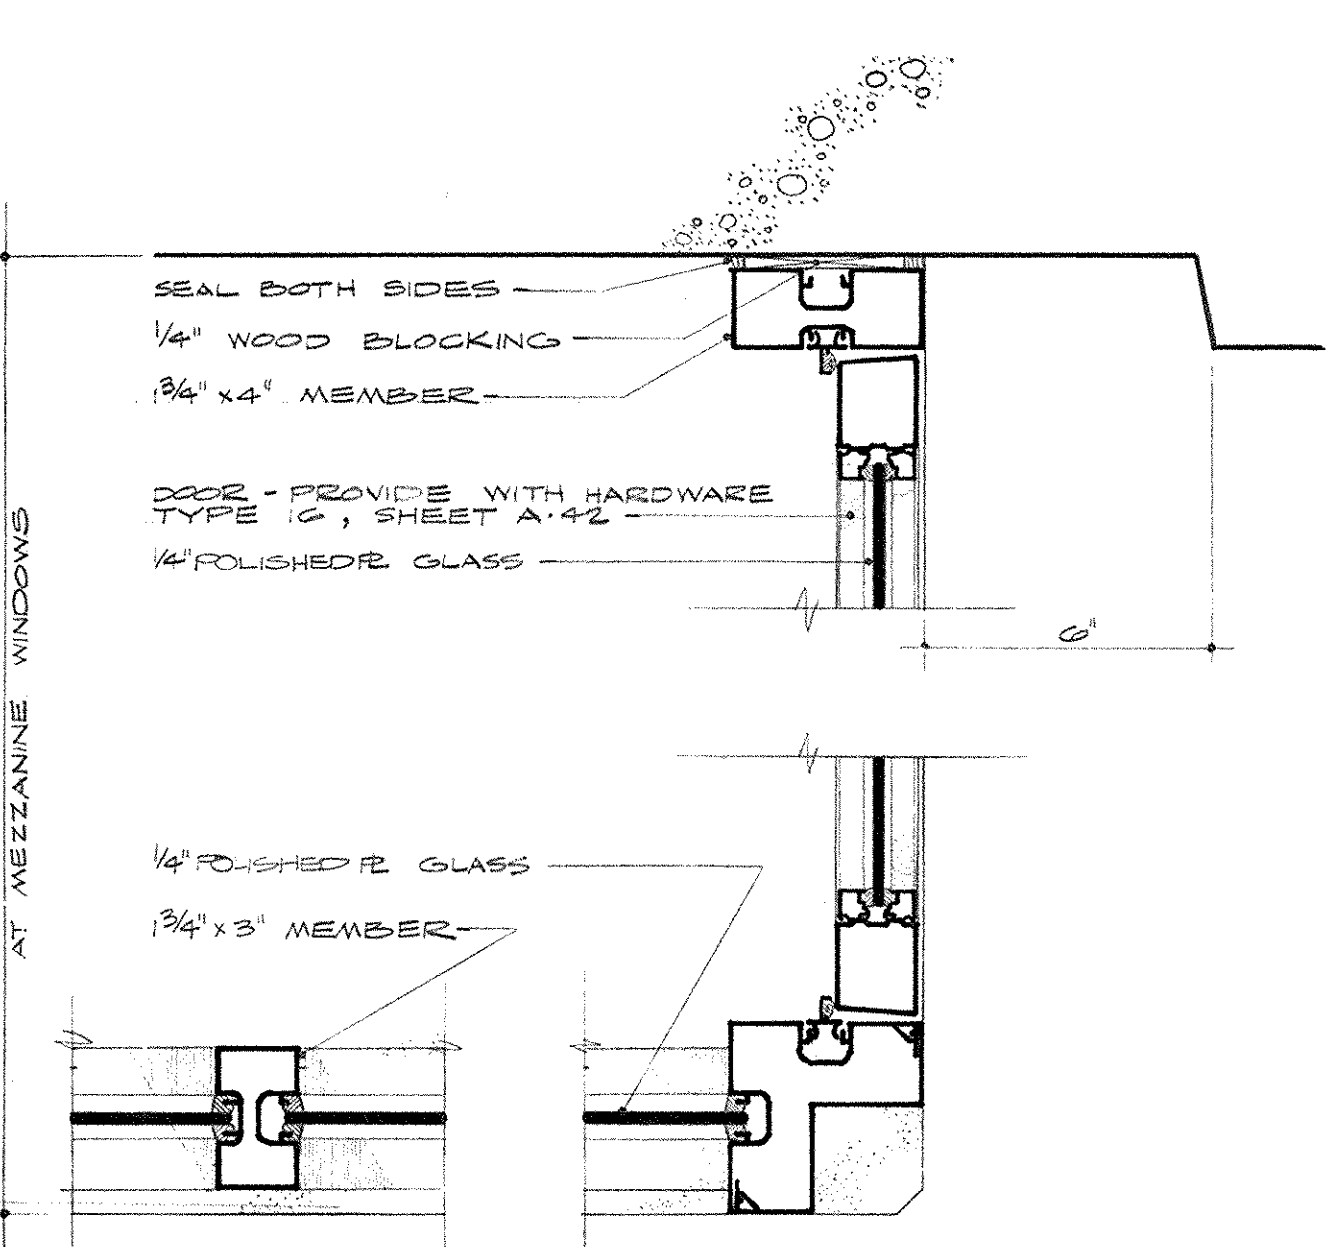

SECTION D-33
SCALE: 3/8" = 1'-0"


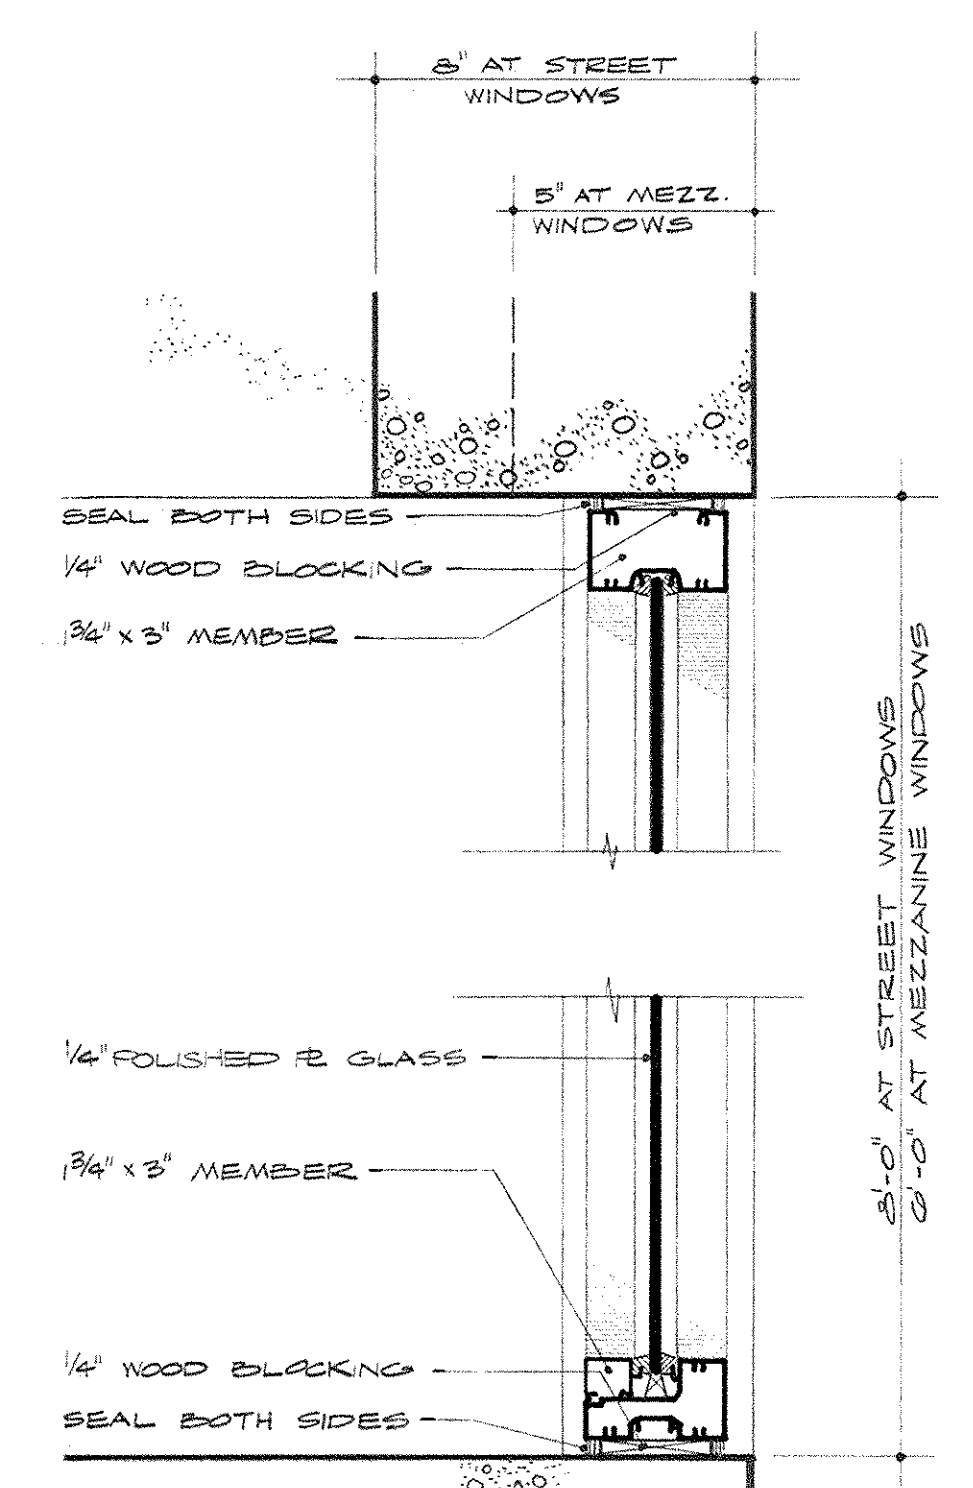


SECTION E-33
SCALE: 3/8" = 1'-0"

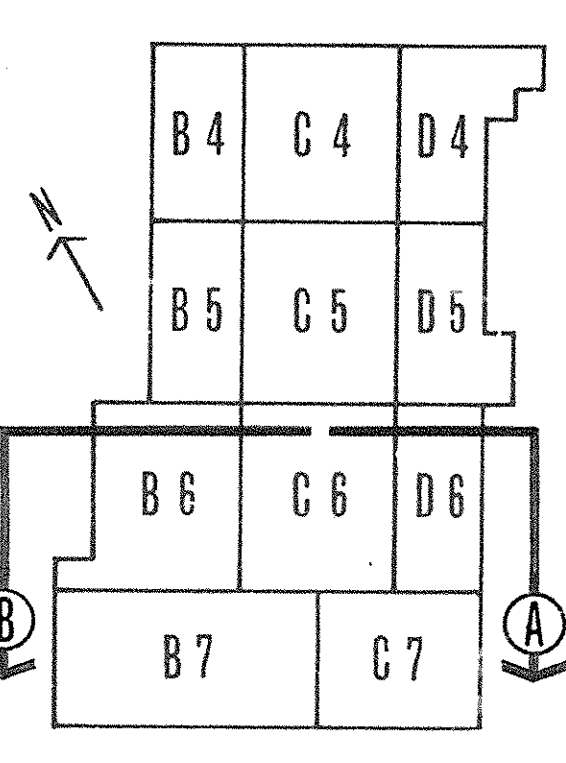


KEY PLAN


AS BUILT REVISIONS: 6-24-72

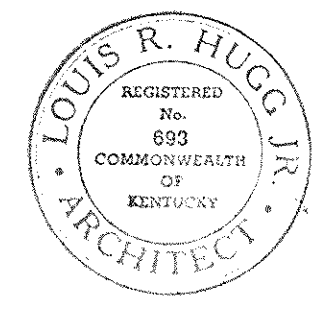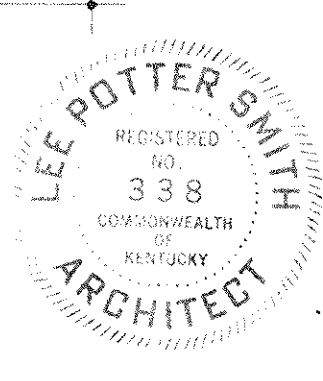


CAPITAL PLAZA DEVELOPMENT PHASE II		FRANKFORT, KENTUCKY	
ELEVATIONS		DATE	16 OCT. 1967
DRAWN BY: W. D. C. J. M. E.		COMM. NO.	50367
CHECKED BY: L. C. M.		DRAWING NO.	A 33
SECTOR NO.:		OF A-42	
LEE POTTER SMITH, PRITCHETT, HUGG & CARTER ARCHITECTS		FRANKFORT, KENTUCKY	
COMMONWEALTH OF KENTUCKY		DEPARTMENT OF FINANCE - DIVISION OF ENGINEERING	
APPROVED BY: AGENCY HEAD		DATE: 10-26-67	
APPROVED BY: OWNER		DATE: 10-26-67	

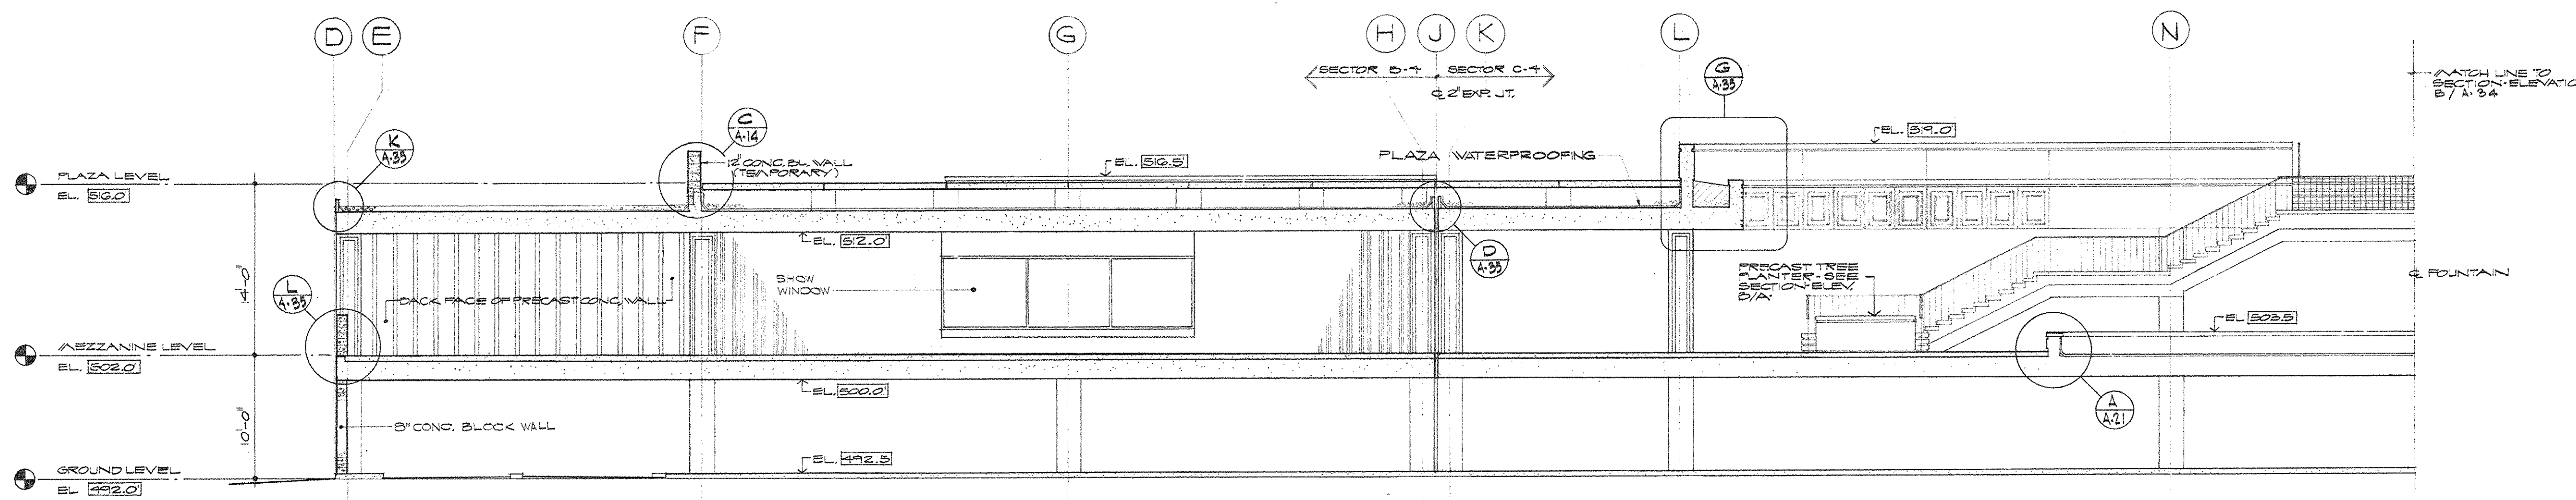


SECTION A
SCALE 1/8" = 1'-0"

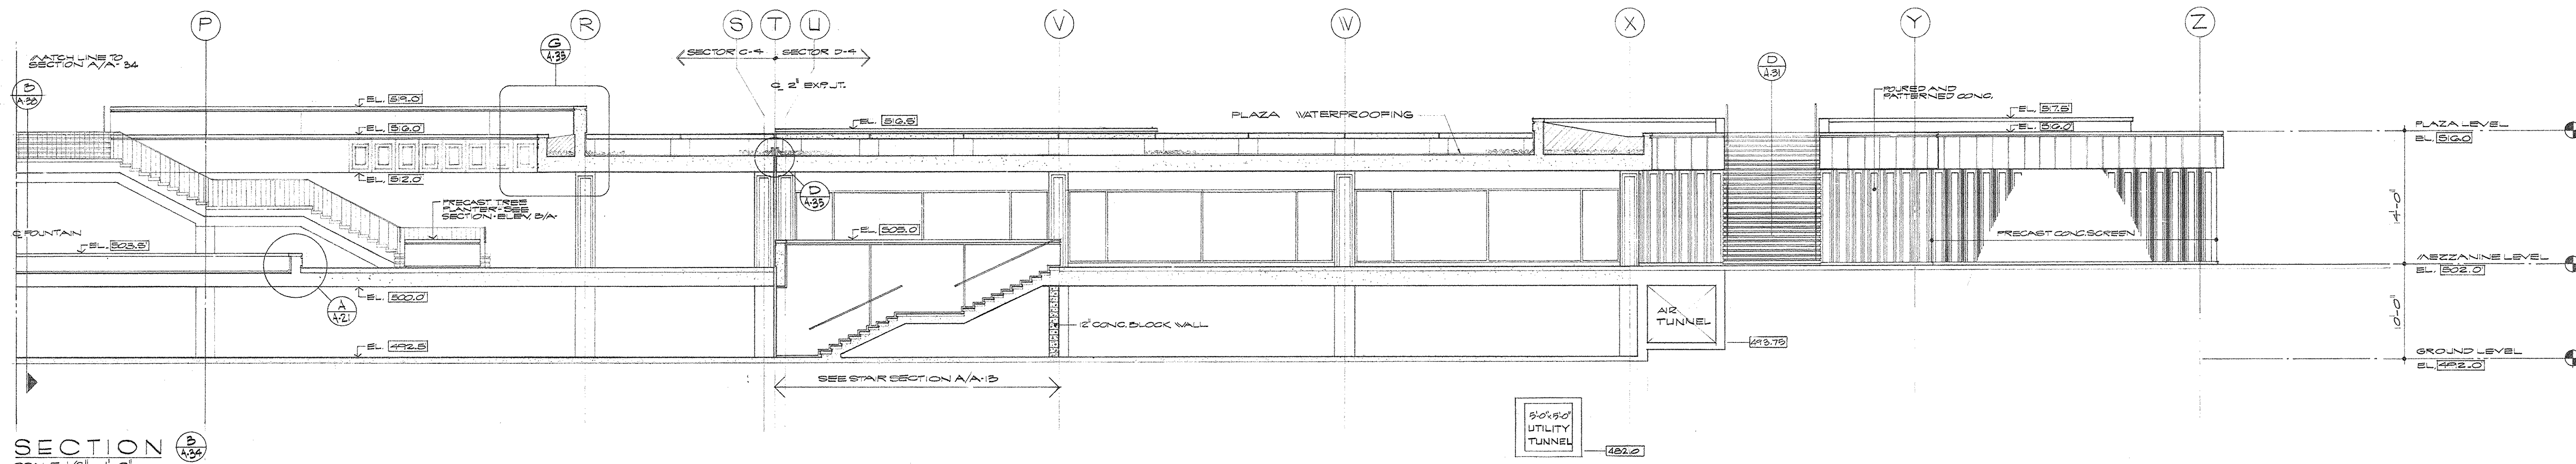


SECTION B
SCALE 1/8" = 1'-0"

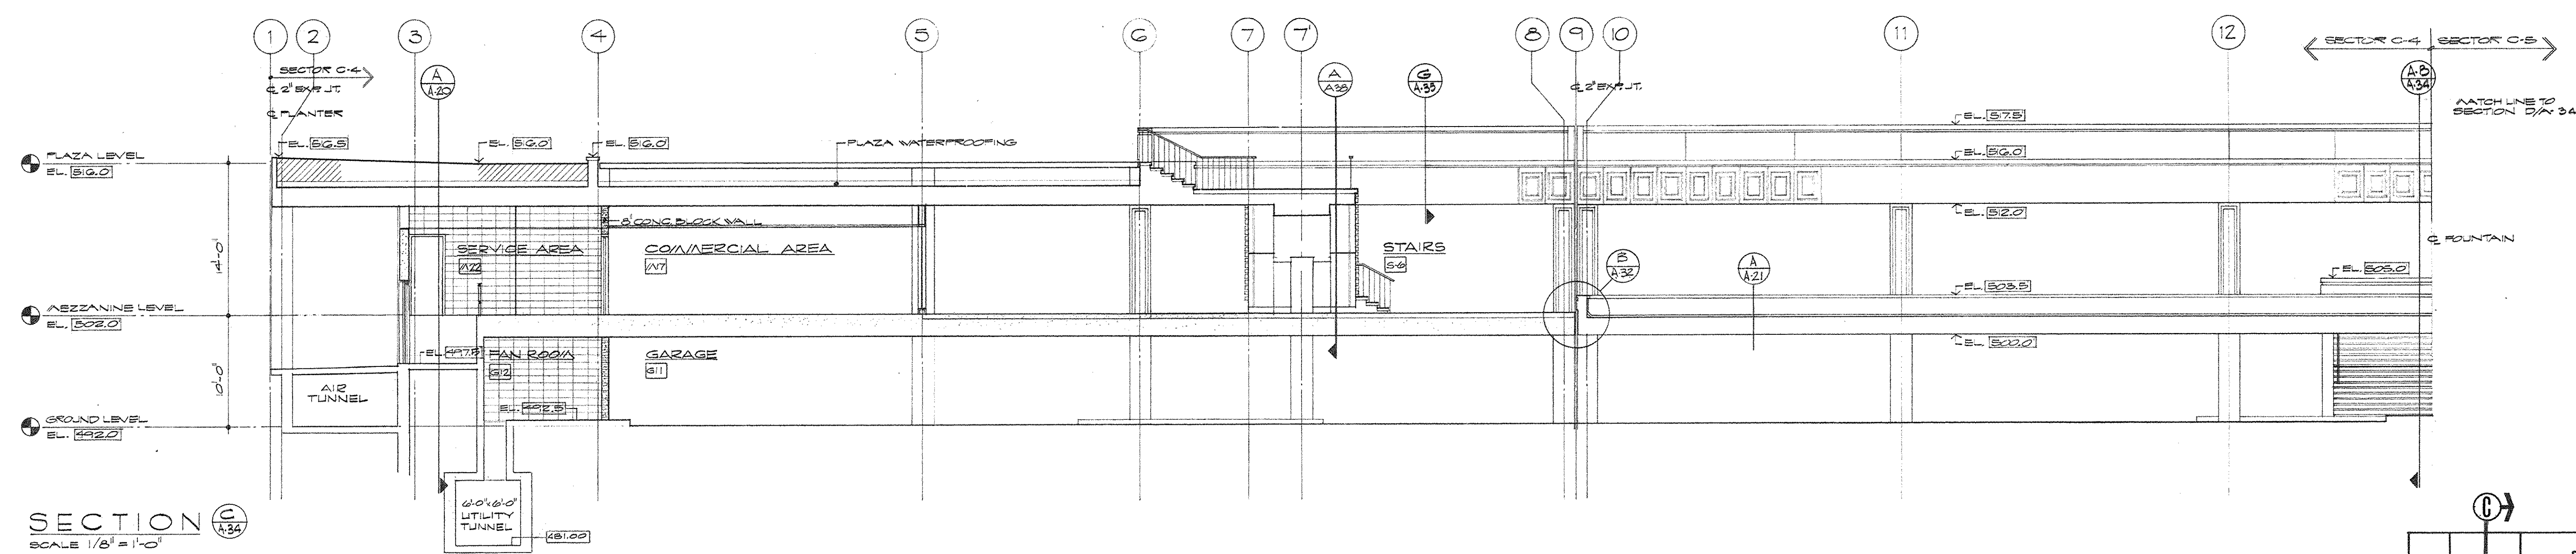

SECTION C
SCALE 1/8" = 1'-0"


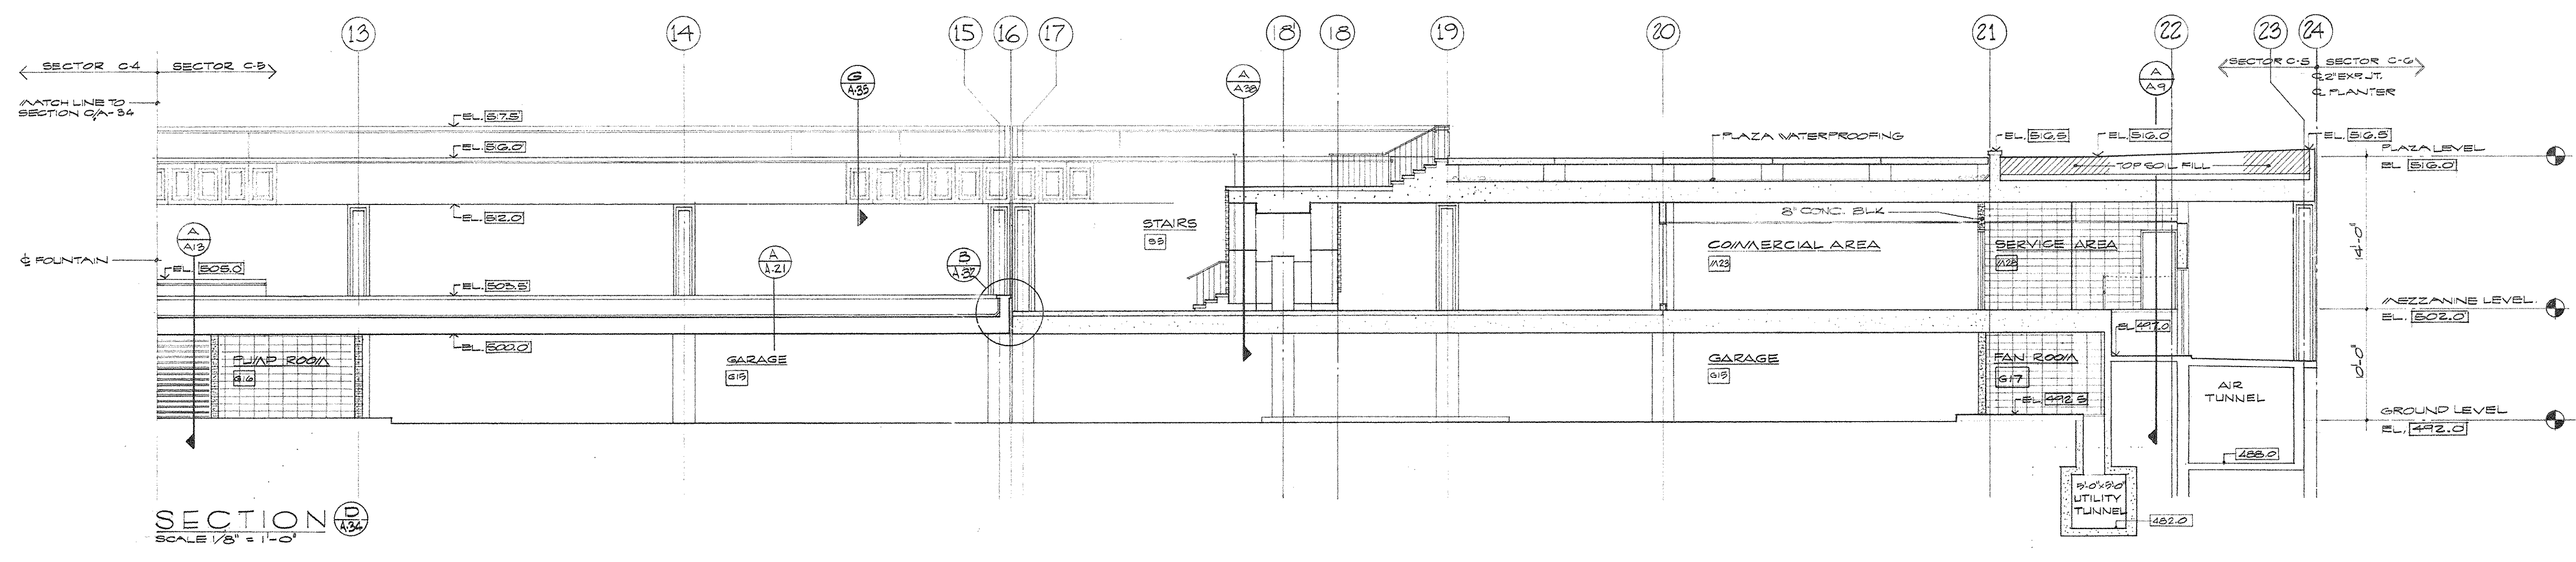


SECTION D
SCALE 1/8" = 1'-0"

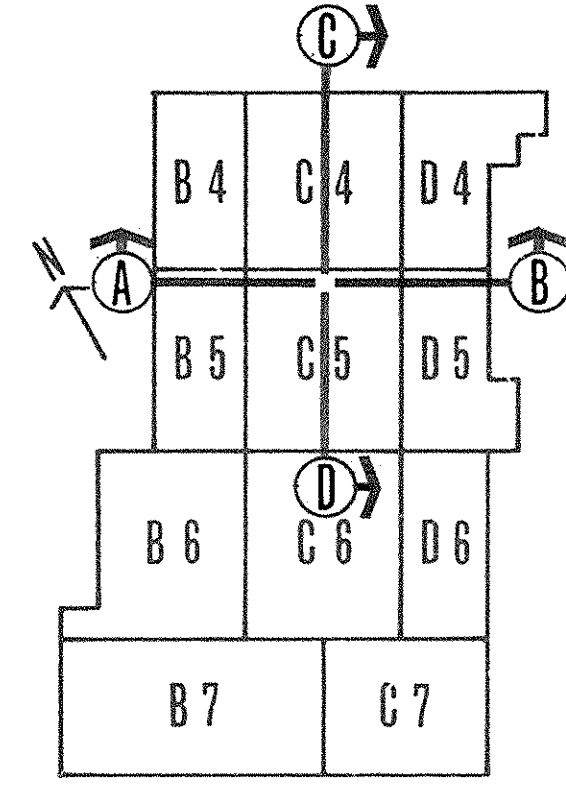


KEY PLAN


AS BUILT REVISIONS - 3 24 72

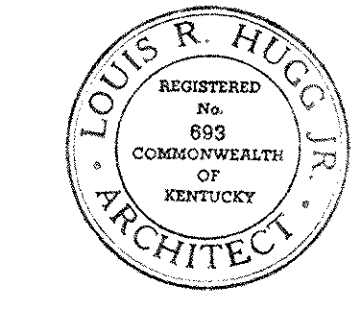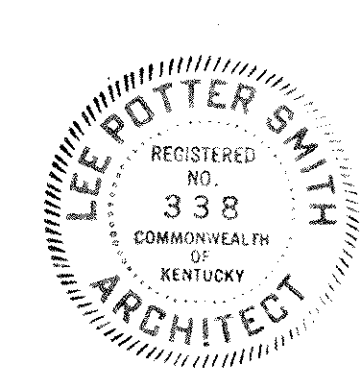


CAPITAL PLAZA DEVELOPMENT PHASE II FRANKFORT, KENTUCKY		
DRAWN BY V.D. & W.T.	DATE 6 OCT. 1967	COMM. NO. 50367
CHECKED BY L. R. H.	ENGINEERS FRANKFORT, KENTUCKY	
SECTOR NO.	LEE POTTER SMITH, FRITCHETT, HUGG & CARTER ARCHITECTS 314 WILKINSON STREET FRANKFORT, KENTUCKY	DRAWING NO. A 34 OF A-42
COMMONWEALTH OF KENTUCKY DEPARTMENT OF FINANCE - DIVISION OF ENGINEERING FRANKFORT		
APPROVED BY AGENCY HEAD	DATE	
APPROVED BY OWNER	DATE 10-26-67	

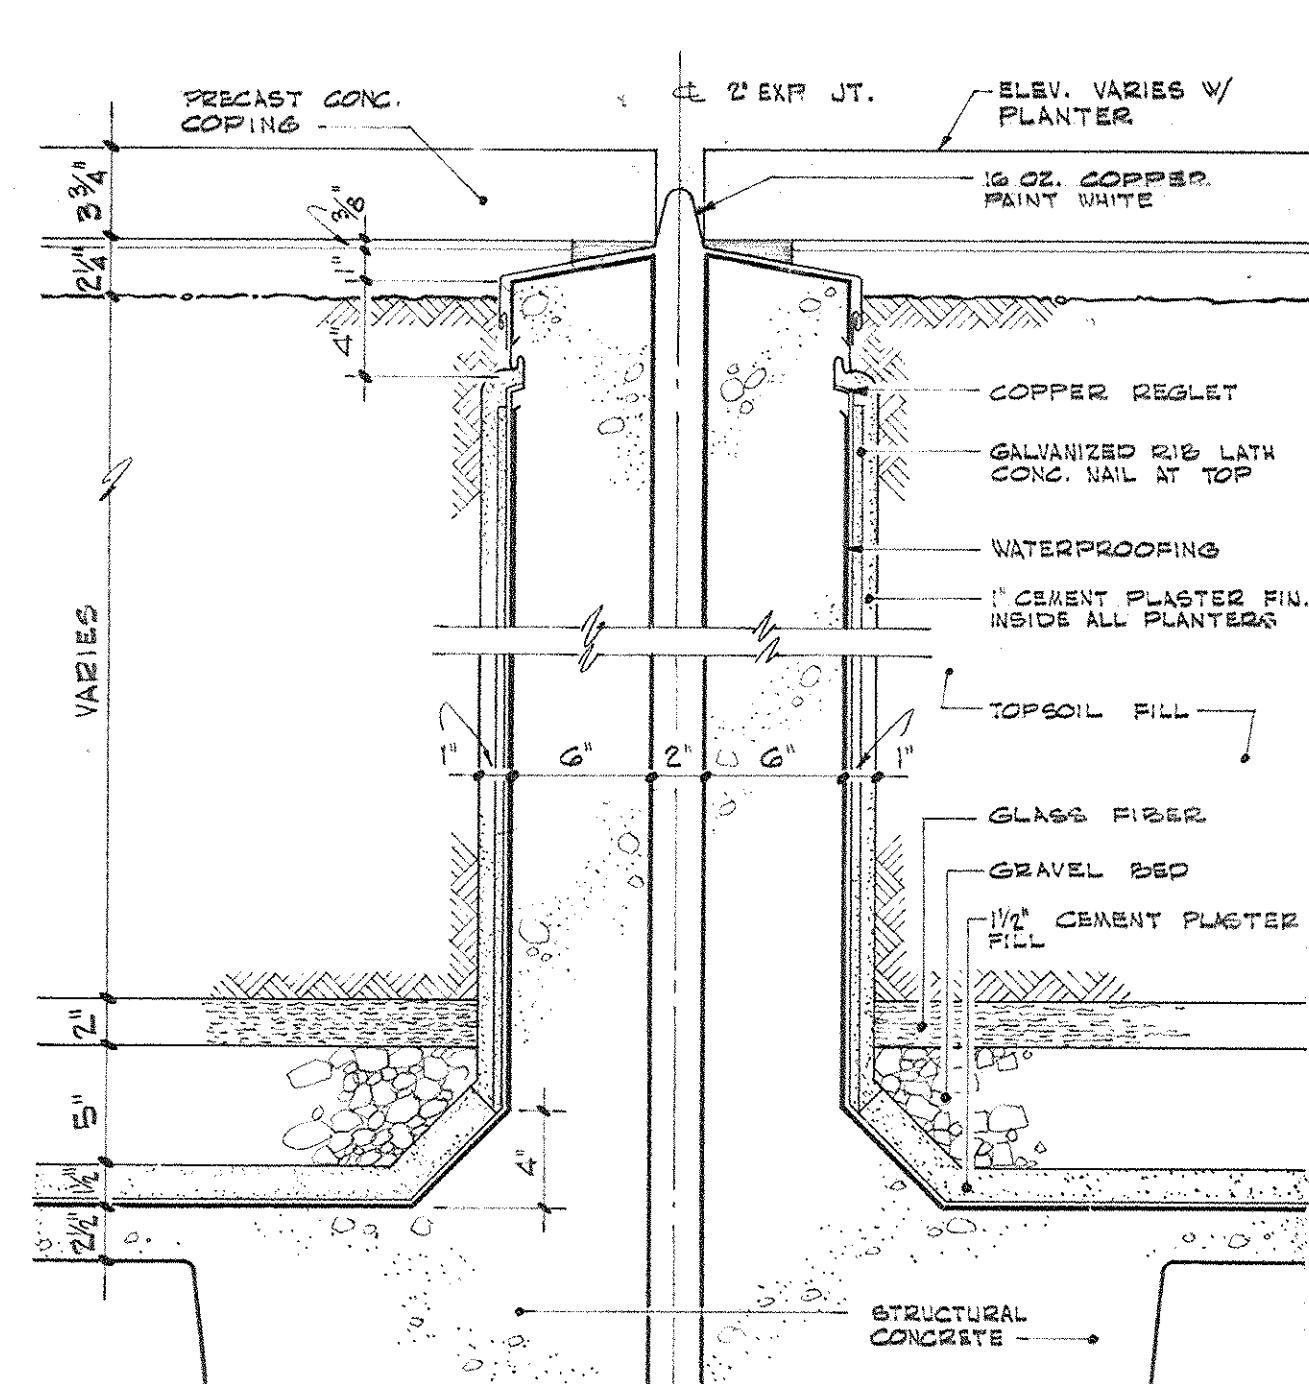


SECTION-ELEV (A) TYP. EXP. JT. THRU PLAZA LEVEL PLANTERS
SCALE: 1/4" = 1'-0"

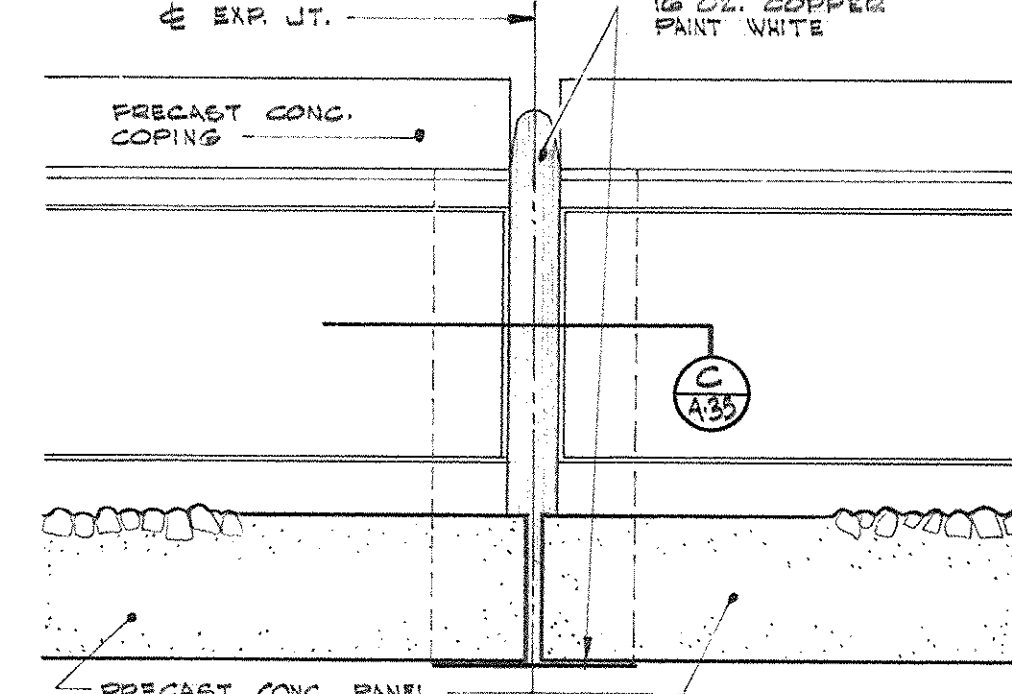


SECTION-ELEV (B) TYP. EXP. JT. THRU PLAZA LEVEL PLANTERS
SCALE: 1/4" = 1'-0"

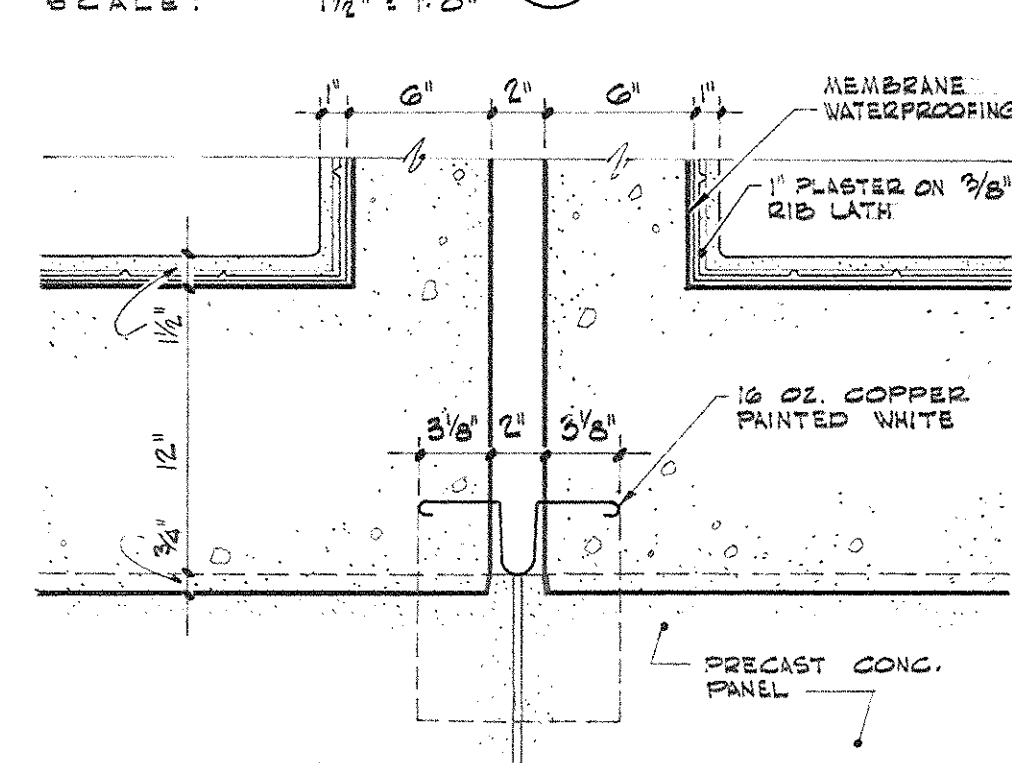

PLAN SECTION (C) TYP. EXP. JT. THRU PLAZA LEVEL PLANTERS
SCALE: 1/4" = 1'-0"

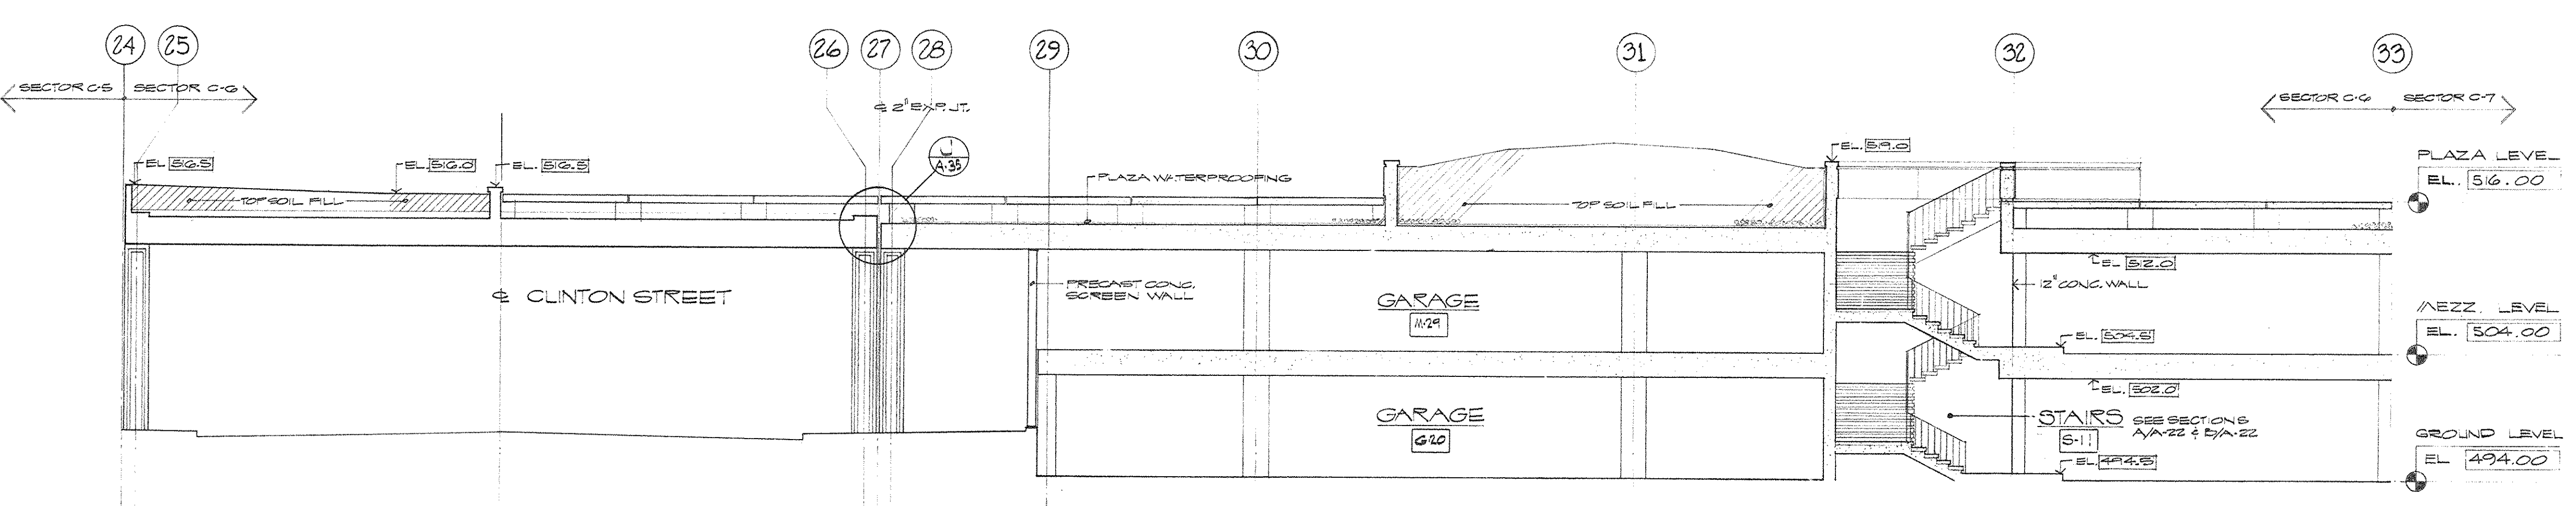


SECTION (M) CLINTON STREET
SCALE: 1/8" = 1'-0"

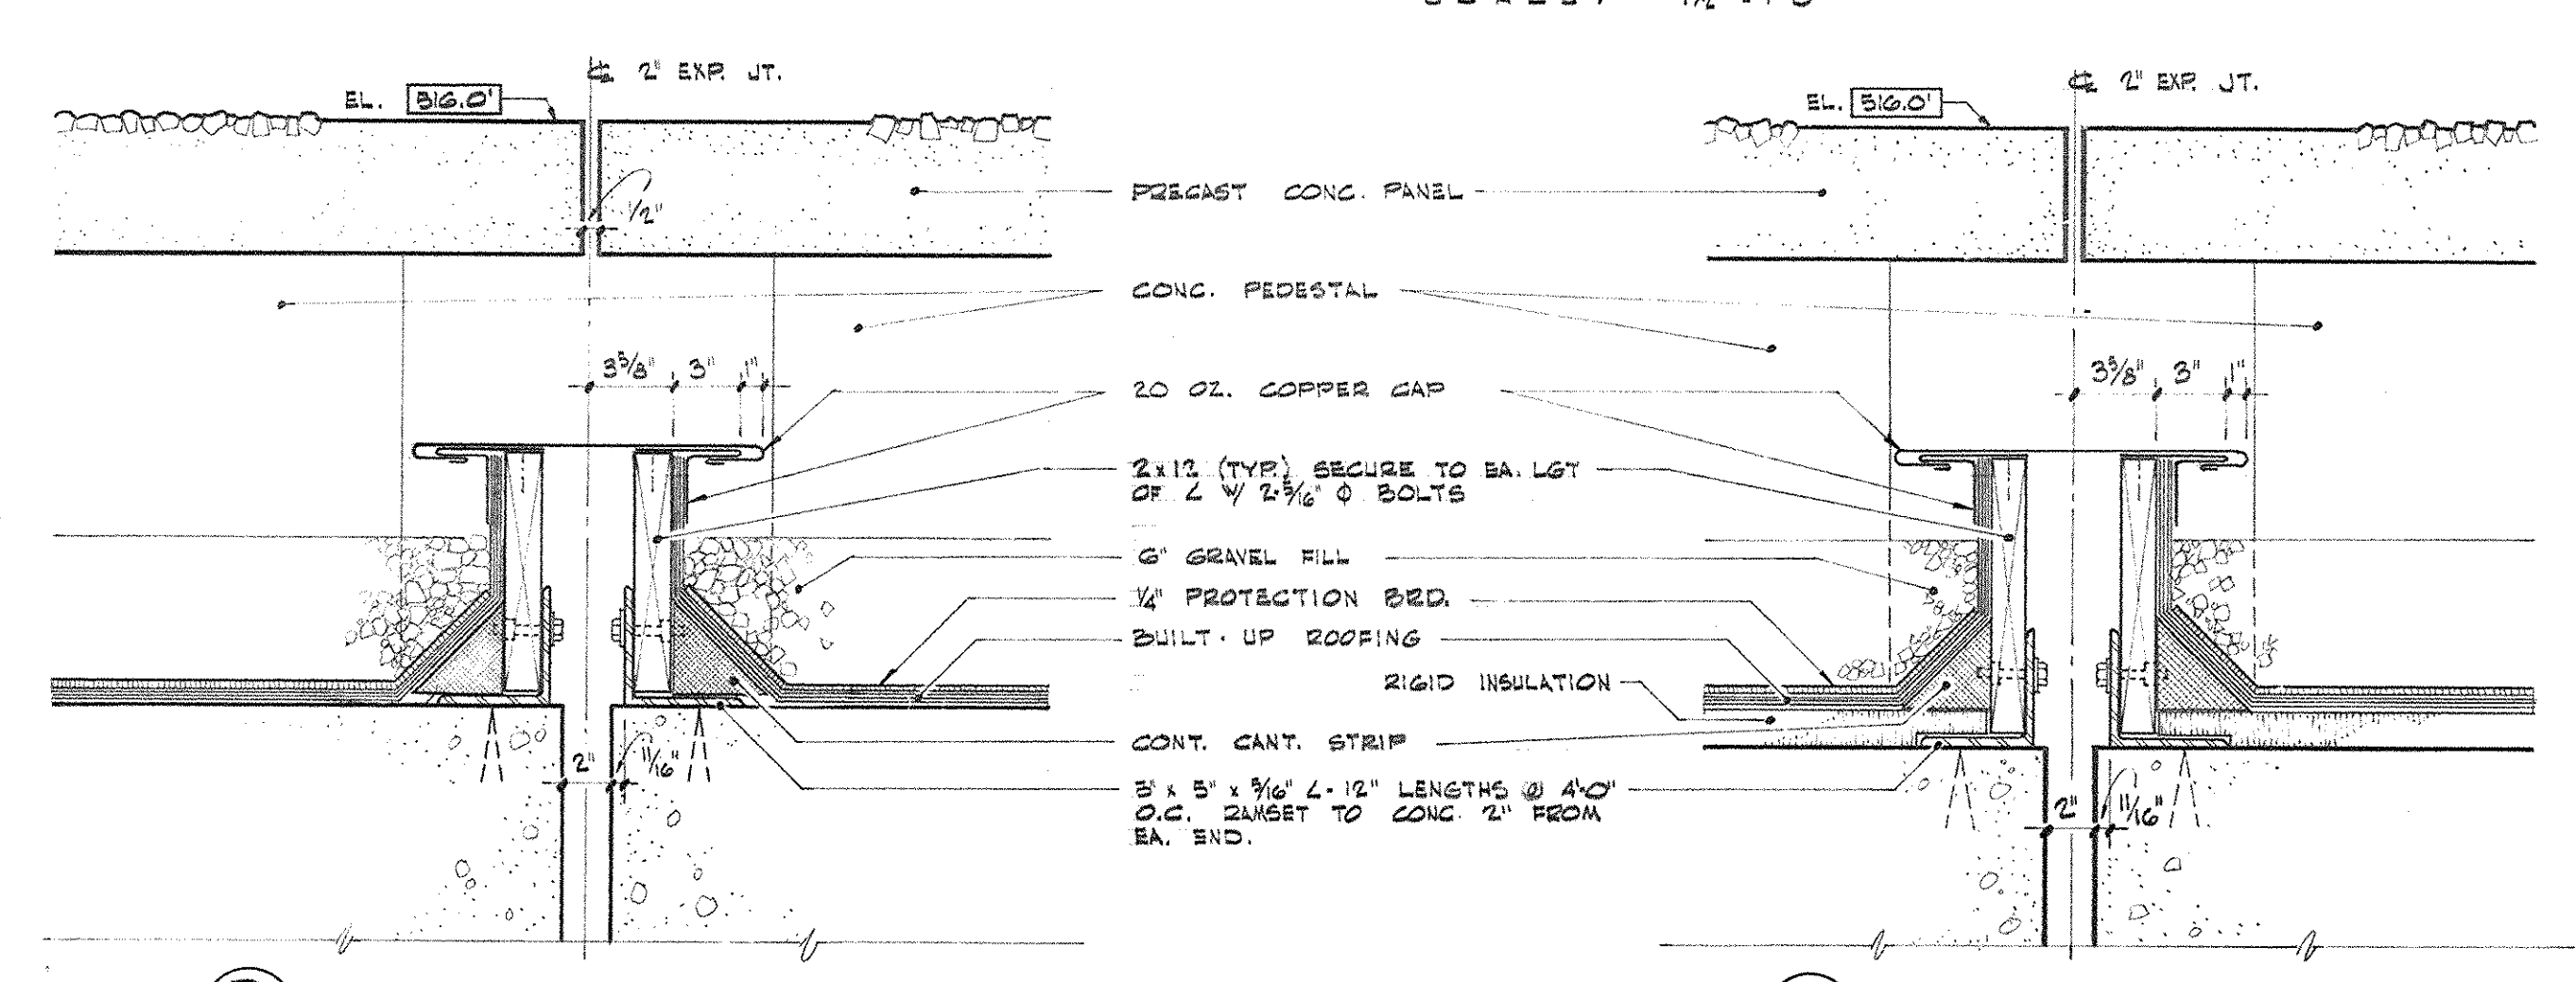


DETAIL (D) TYPICAL EXP. JT. AT PLAZA STRUCTURE
SCALE: 1/4" = 1'-0"

DETAIL (E) EXP. JT. AT PLAZA STRUCTURE OVER HEATED AREAS
SCALE: 1/4" = 1'-0"


PLAZA STRUCTURE EXPANSION JOINT DETAILS
SCALE: AS NOTED

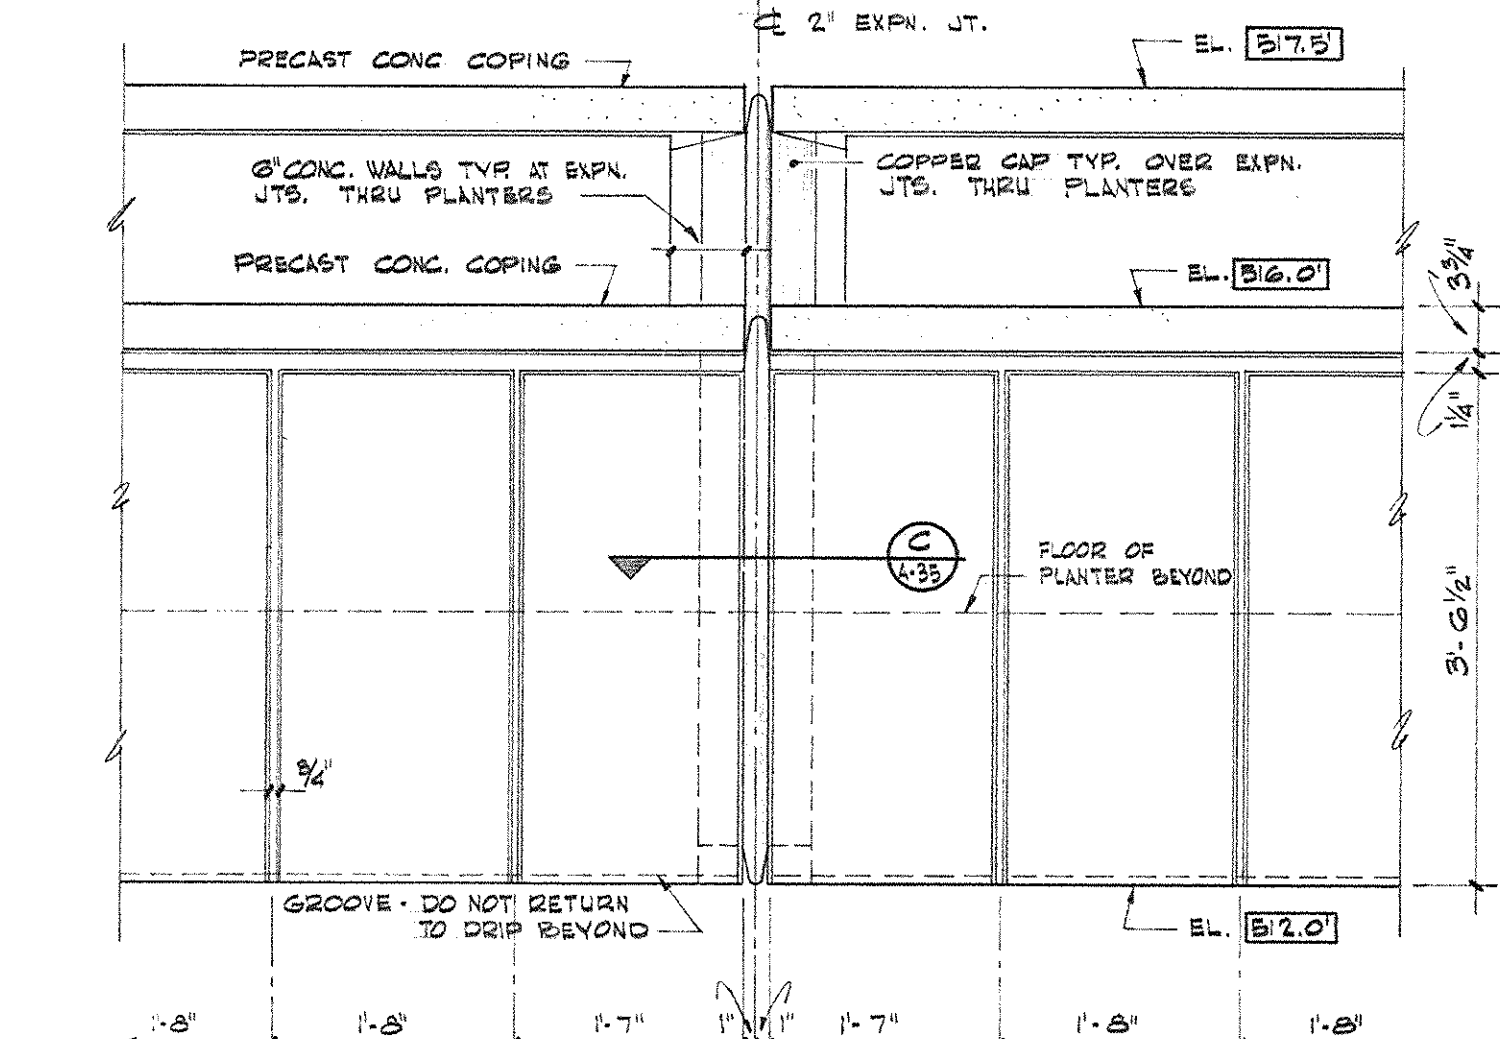


ELEVATION (F) SECTION THRU WELL PLANTER
SCALE: 3/4" = 1'-0"

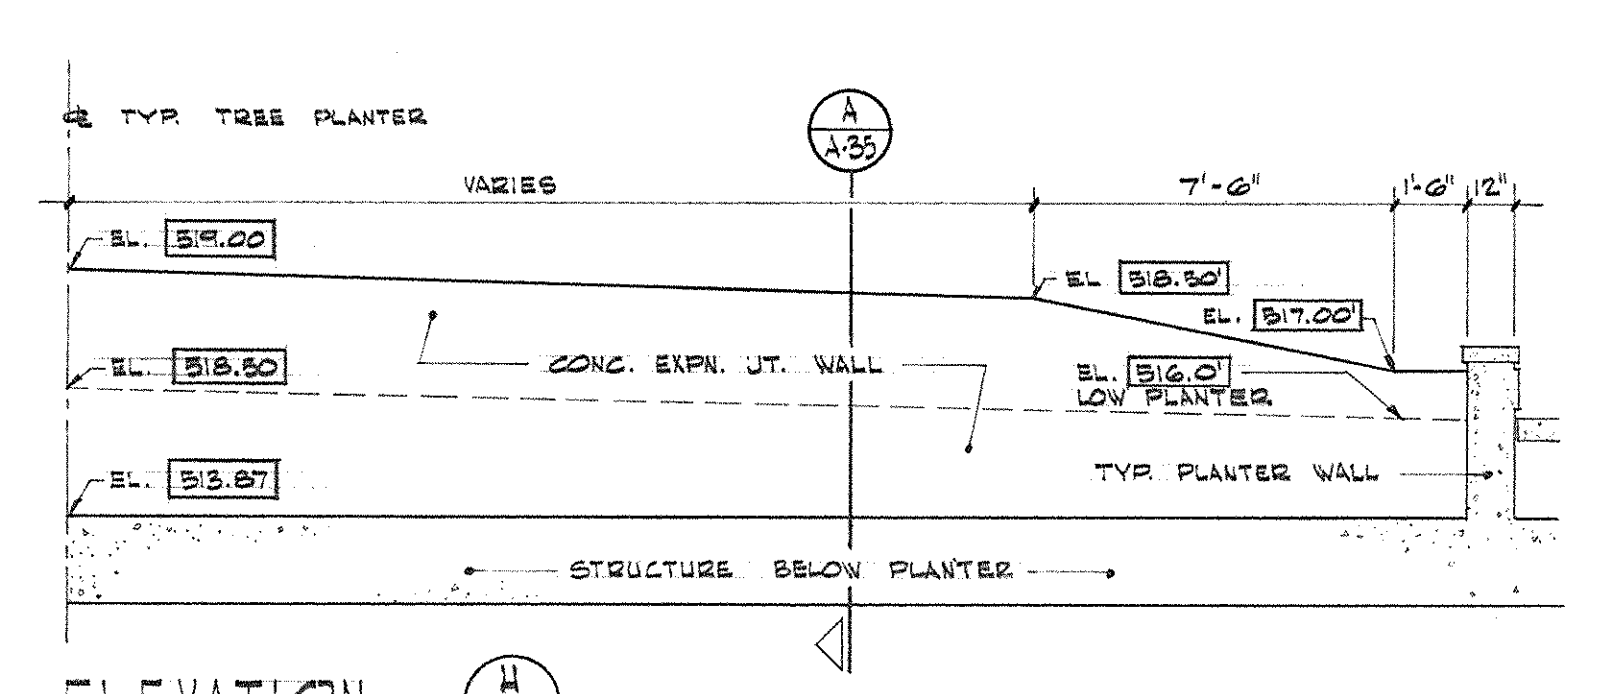


ELEVATION (G) TYP. TREE PLANTER EXPANSION JT. WALL
SCALE: 1/4" = 1'-0"

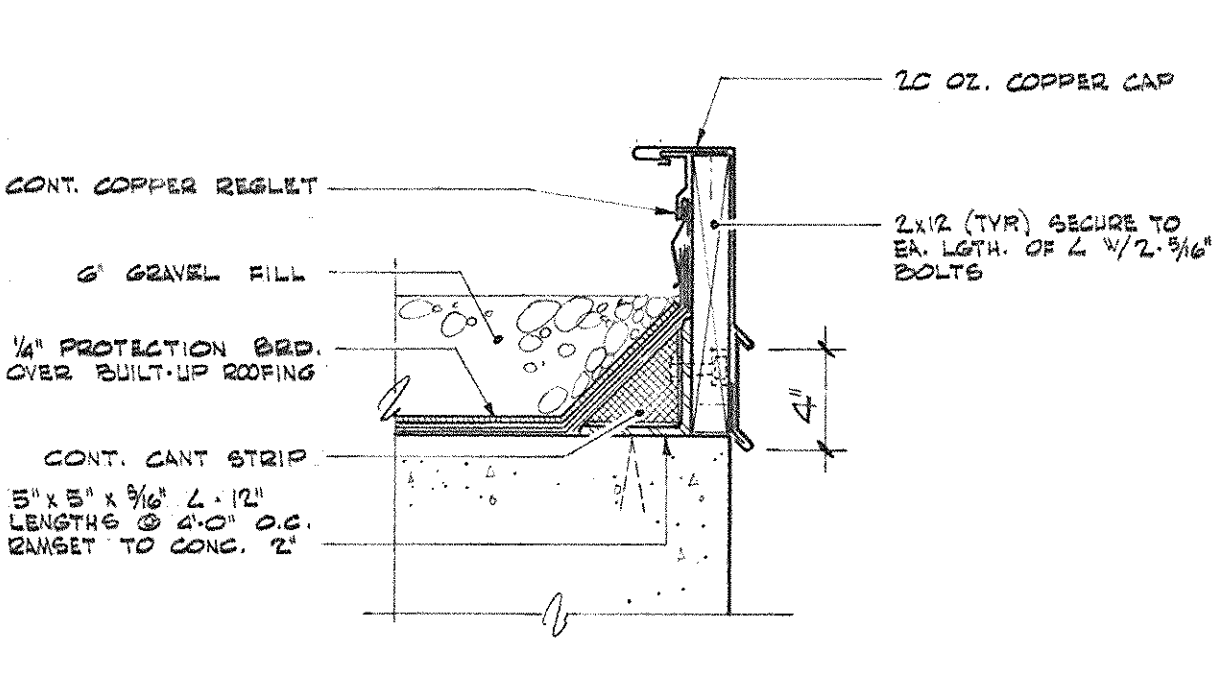


DETAIL (K) TYP. TREE PLANTER EXPANSION JT. WALL
SCALE: 1/4" = 1'-0"

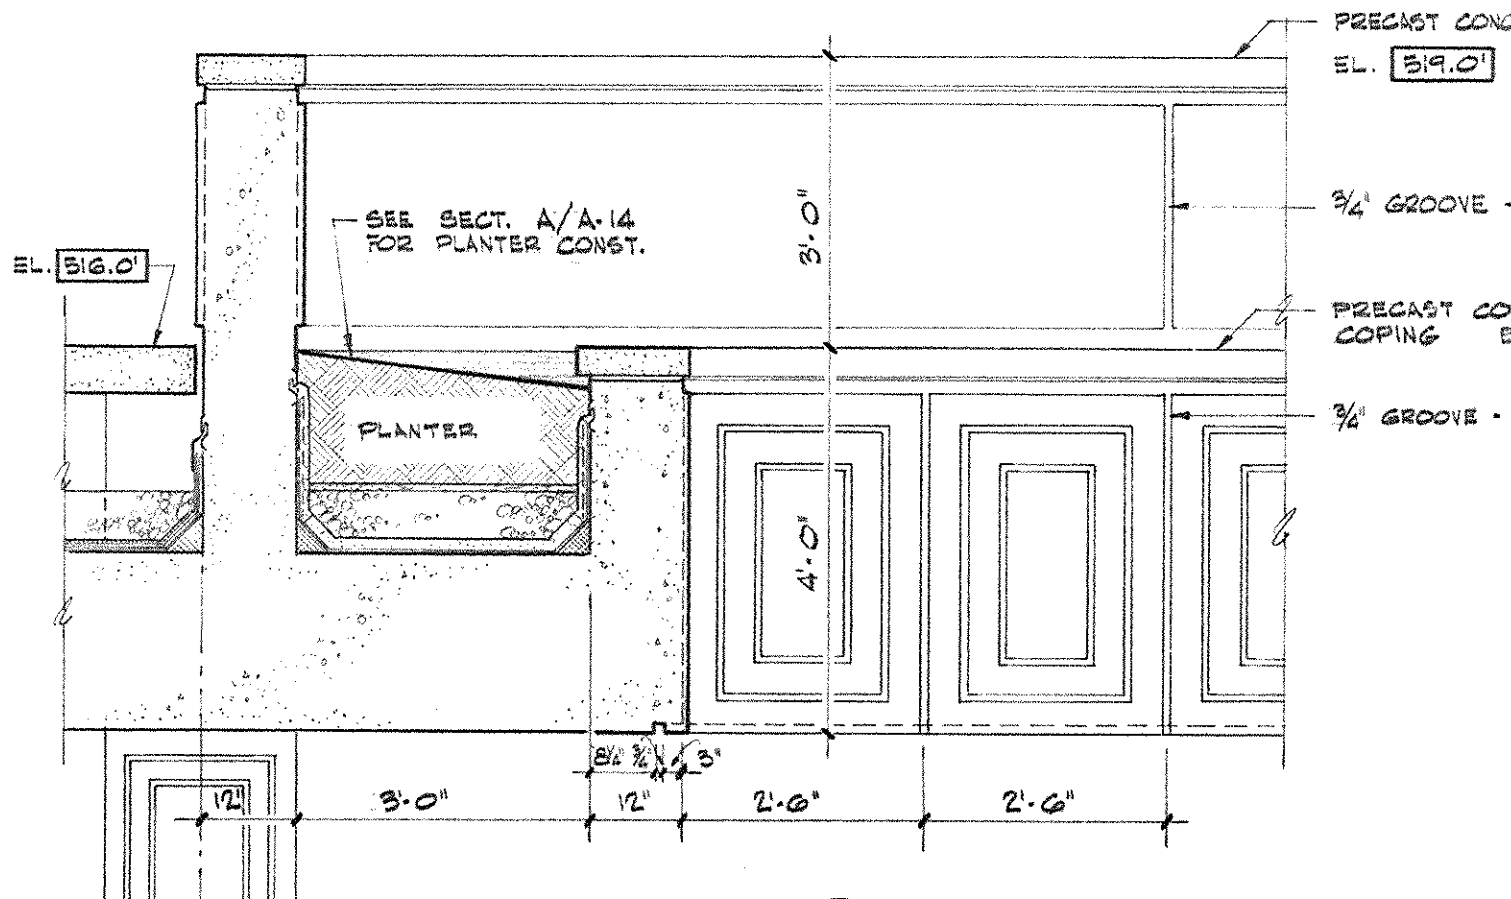


DETAIL (S) SECTION THRU WELL PLANTER
SCALE: 1/4" = 1'-0"

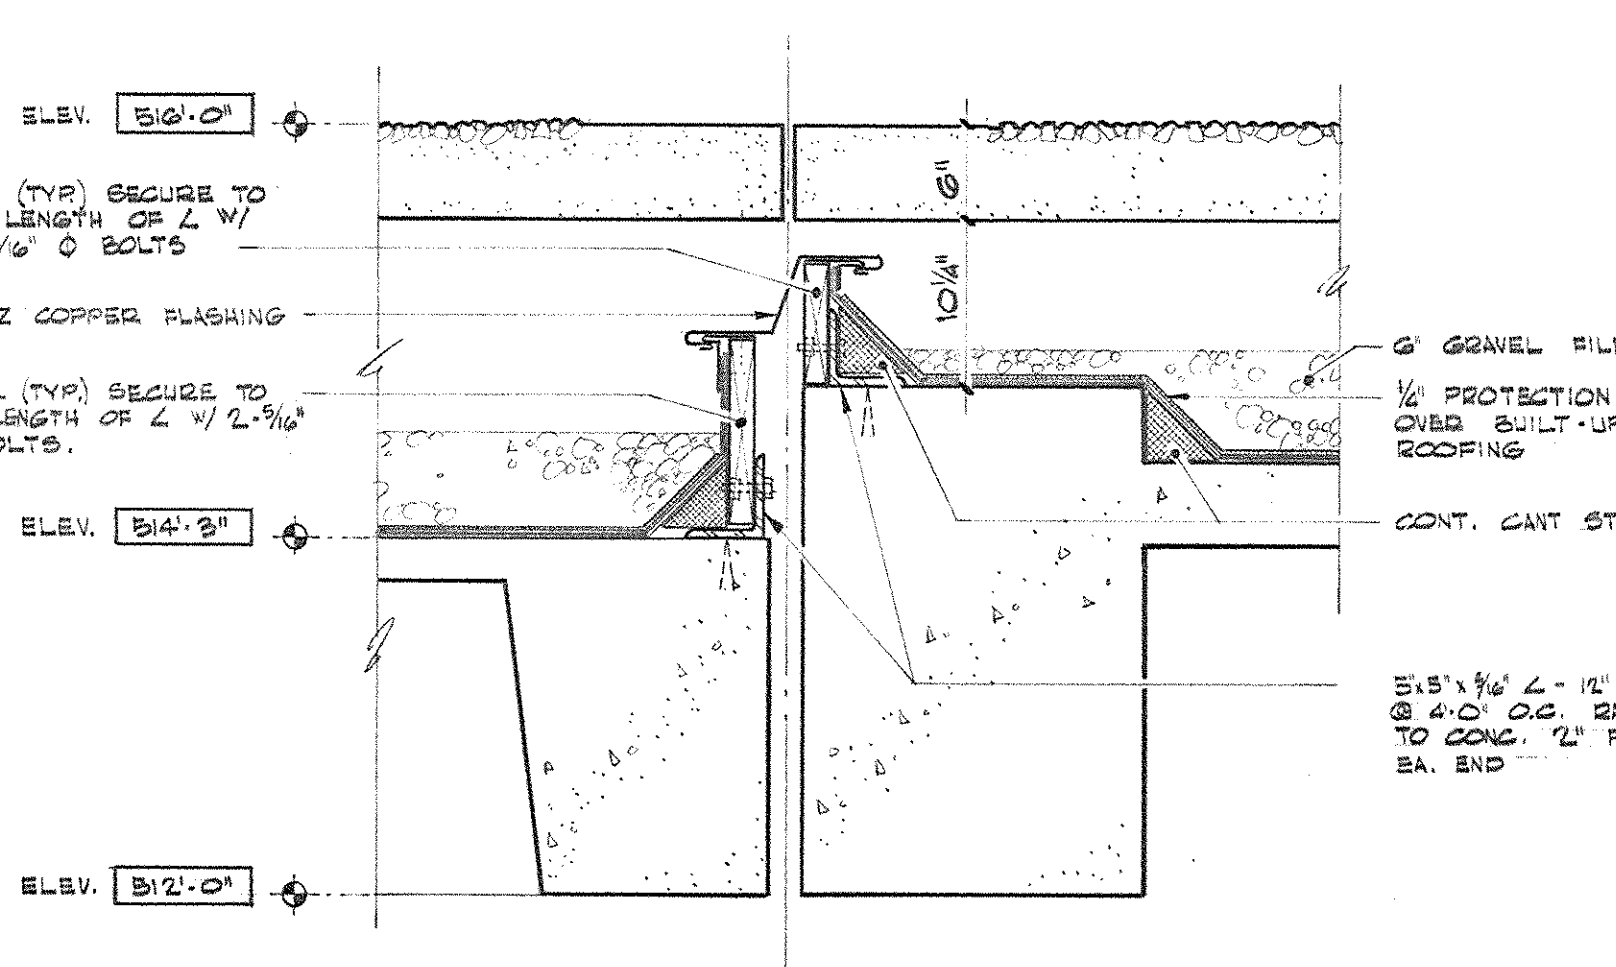

DETAIL (J) EXPANSION JOINT AT BRIDGE
SCALE: 1/4" = 1'-0"

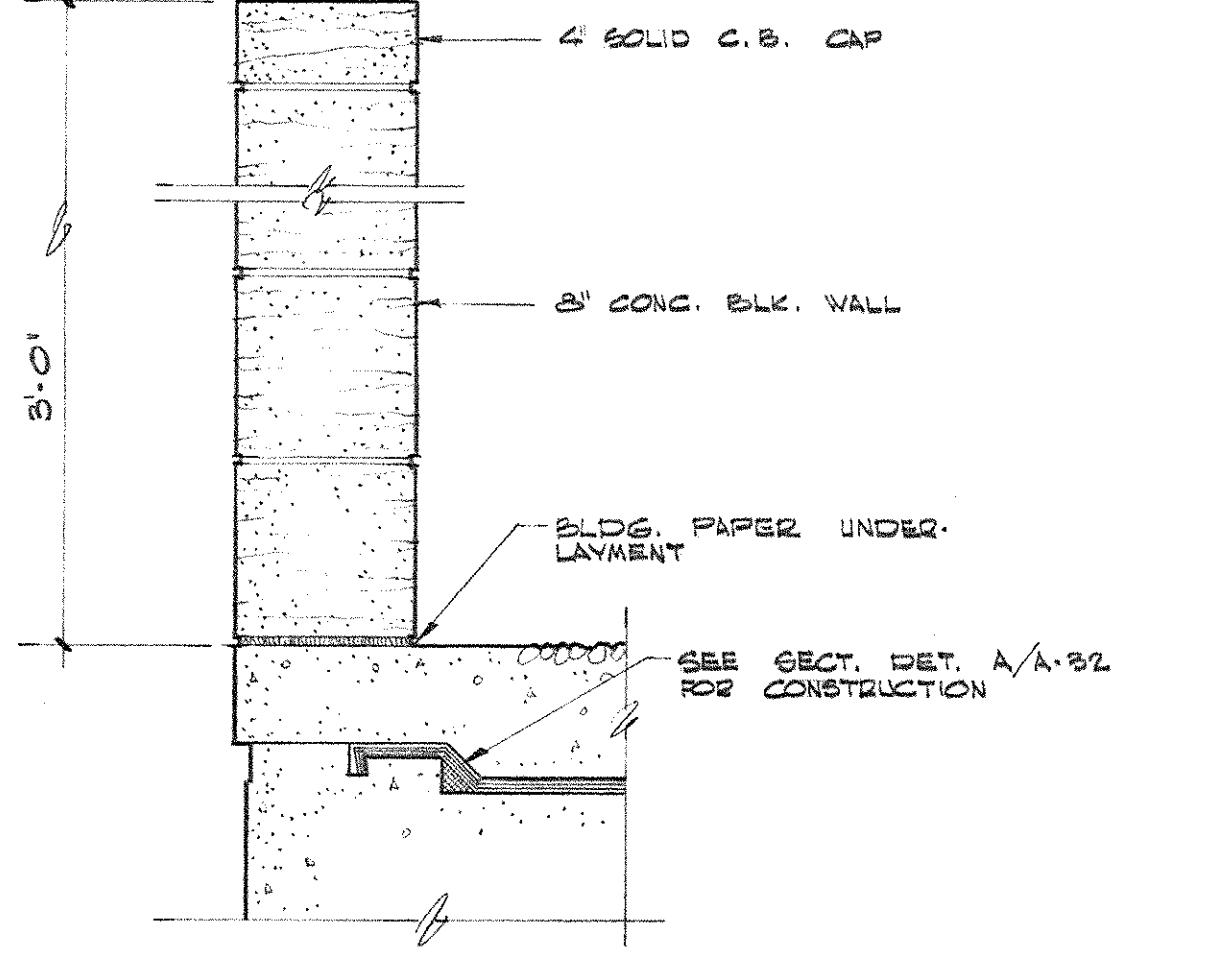



DETAIL (L) EXPANSION JOINT AT BRIDGE
SCALE: 1/4" = 1'-0"

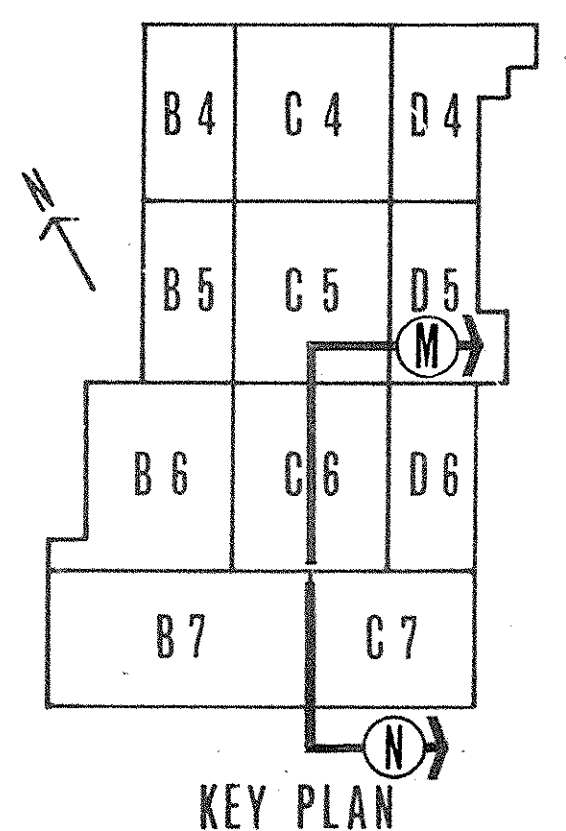


KEY PLAN


AS BUILT REVISIONS - 6-21-72

CAPITAL PLAZA DEVELOPMENT PHASE II			
FRANKFORT, KENTUCKY			
DRAWN BY W.D. D.	ARCHITECTS LEE POTTER SMITH, PRITCHETT, HUGG & CARTER 314 WILKINSON STREET FRANKFORT, KENTUCKY	DATE 10 OCT. 1967	COM. NO. 50367
CHECKED BY L.H.C.	ENGINEERS FRANKFORT, KENTUCKY	DRAWING NO. A 35	OF A 42
SECTOR NO.	COMMONWEALTH OF KENTUCKY DEPARTMENT OF FINANCE - DIVISION OF ENGINEERING FRANKFORT, KENTUCKY	APPROVED BY AGENCY HEAD <i>W.D. Mc Connell</i>	DATE 10-26-67
APPROVED BY OWNER			

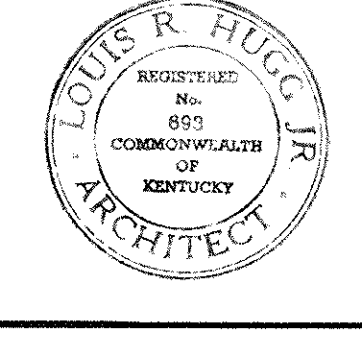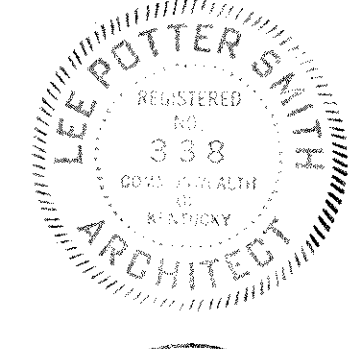


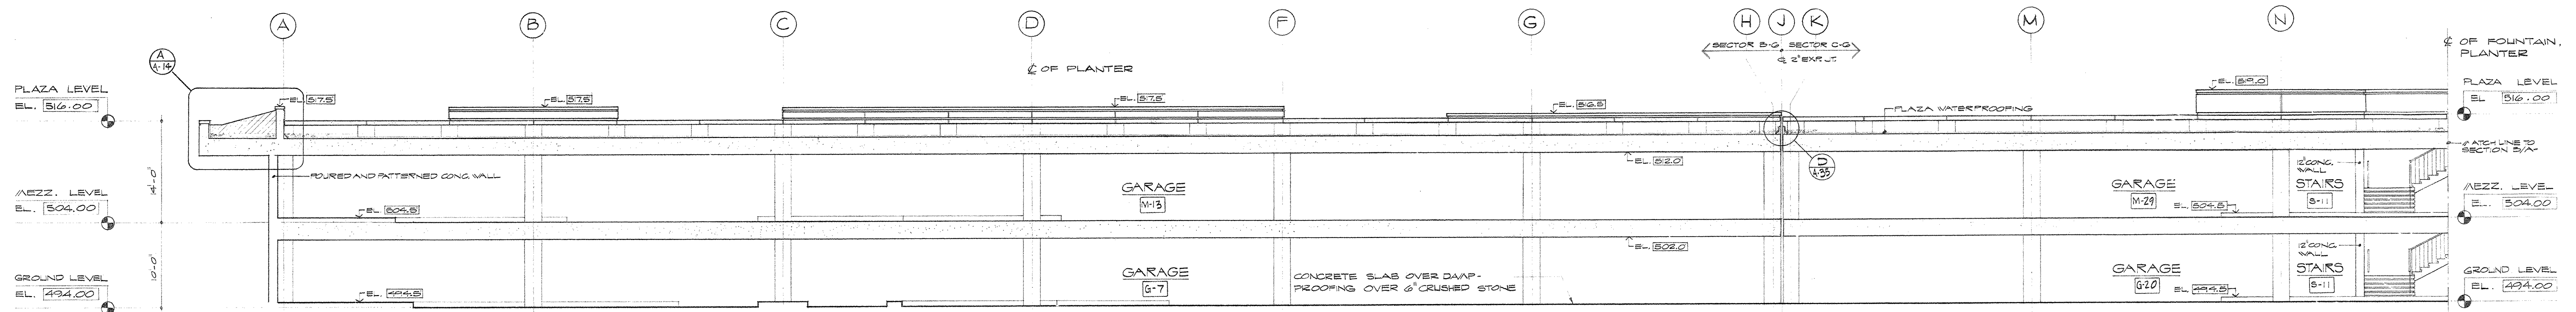


SECTION A-132
SCALE 1/8" = 1'-0"

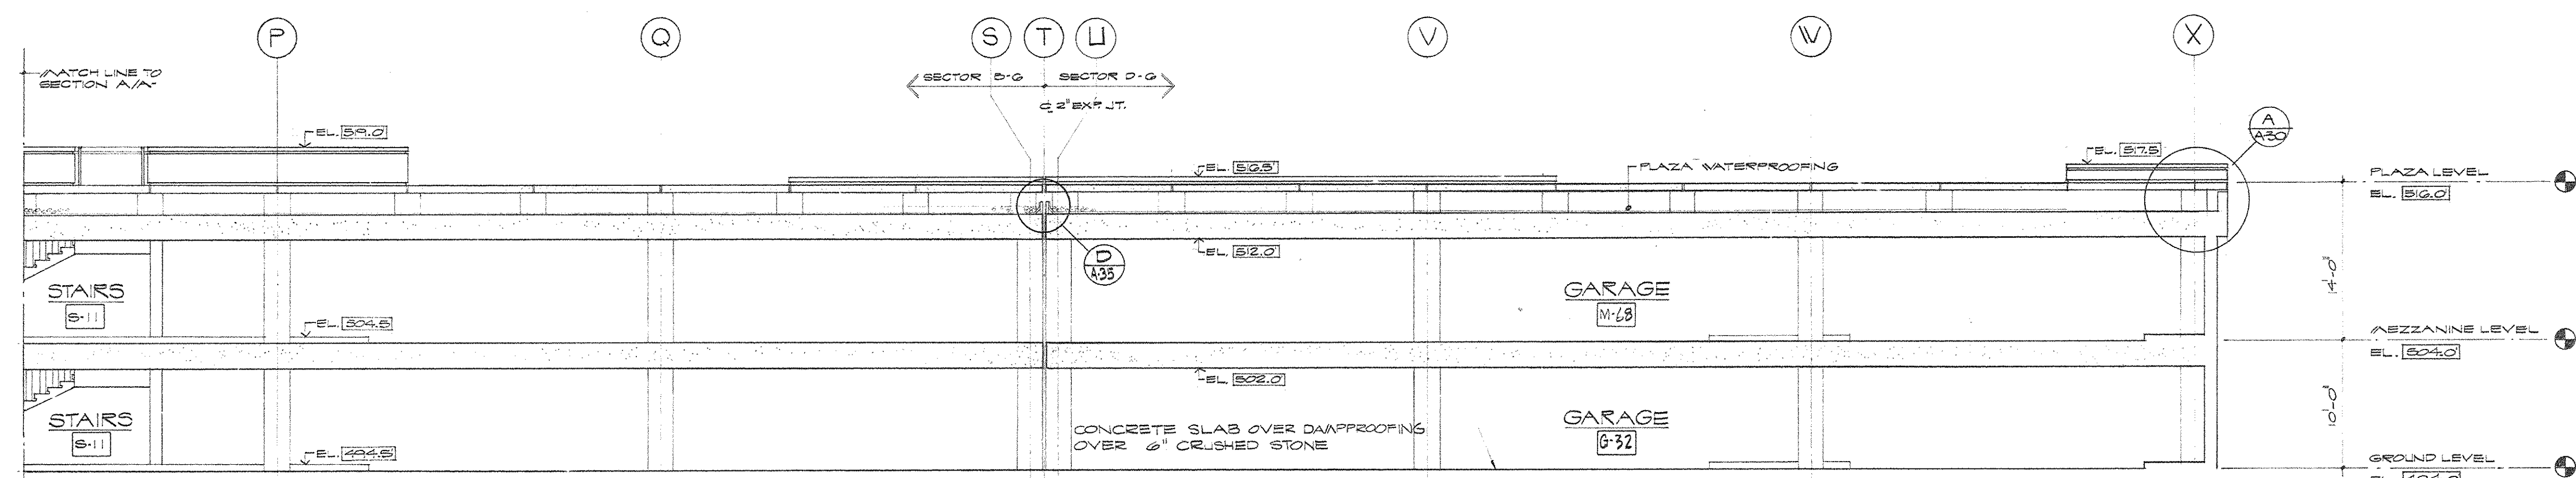


SECTION B-132
SCALE 1/8" = 1'-0"

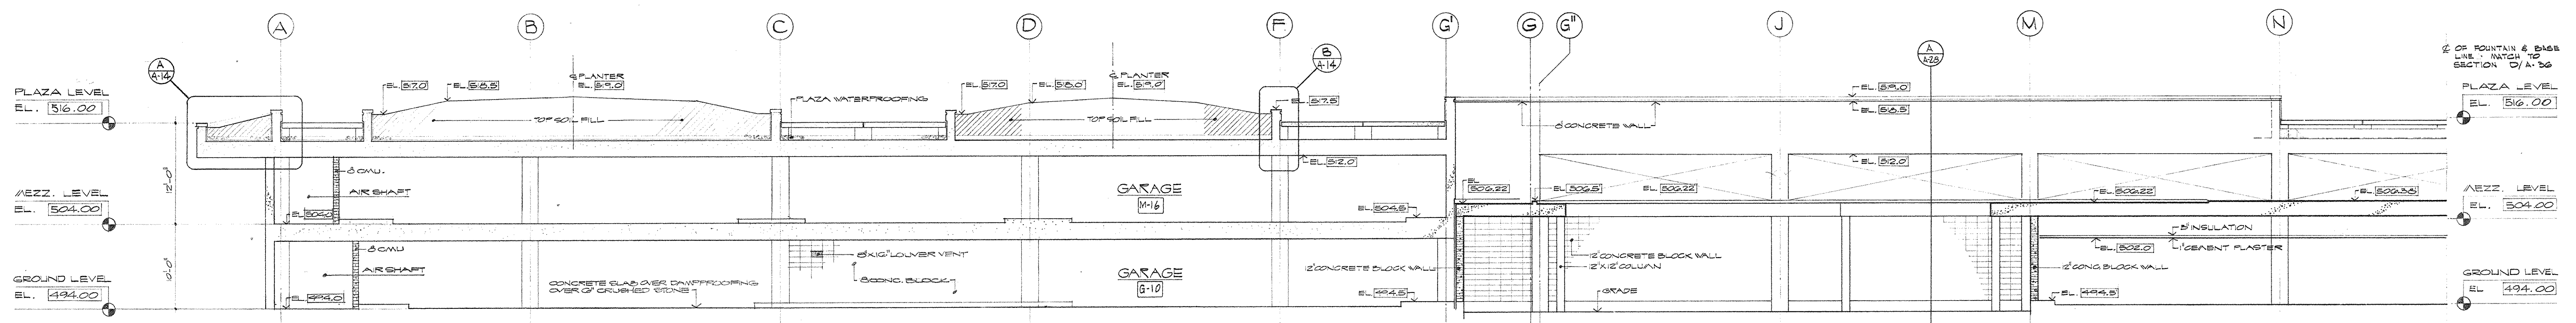

SECTION C-132
SCALE 1/8" = 1'-0"

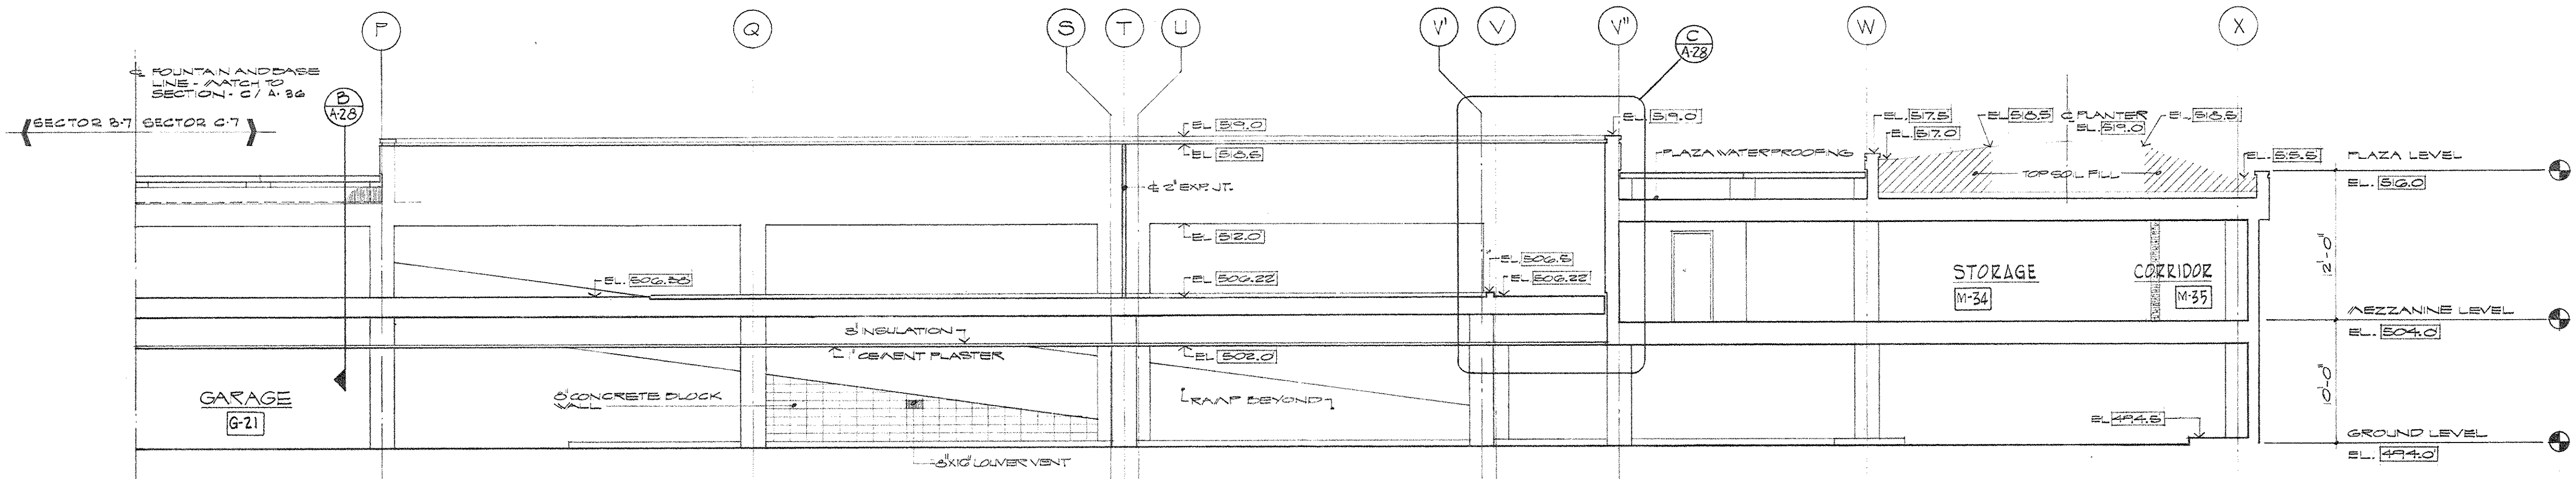


SECTION D-132
SCALE 1/8" = 1'-0"




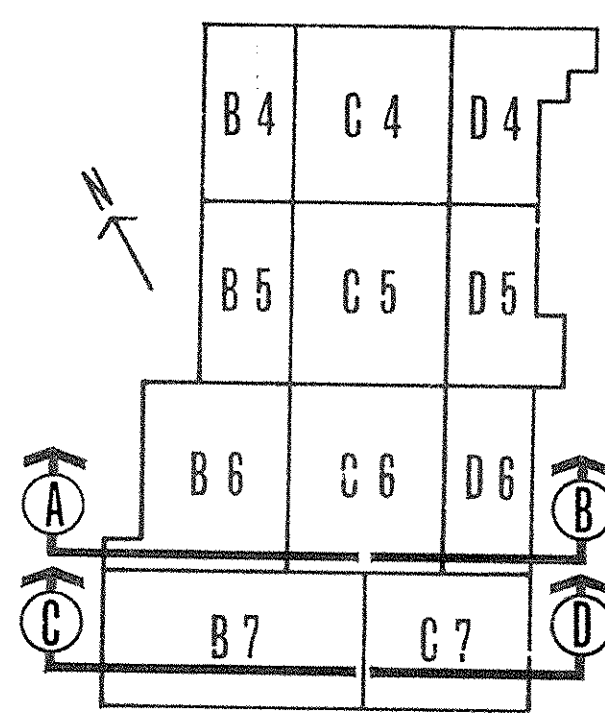


KEY PLAN

AS BUILT REVISIONS - 5-24-72

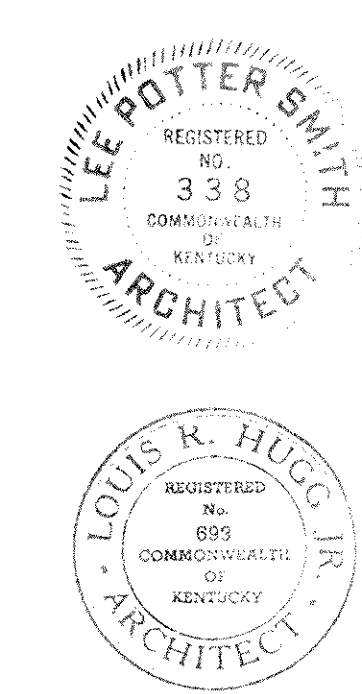


CAPITAL PLAZA DEVELOPMENT PHASE II FRANKFORT, KENTUCKY		
DRAWN BY W.D.	BUILDING SECTIONS	DATE 12 OCT. 1967
CHECKED BY L.S.H.		COMM. NO. 5037
SECTOR NO.	LEE POTTER SMITH, PRITCHETT, HUGG & CARTER ARCHITECTS 314 WILKINSON STREET FRANKFORT, KENTUCKY	DRAWING NO. A 36
	COMMONWEALTH OF KENTUCKY DEPARTMENT OF FINANCE - DIVISION OF ENGINEERING FRANKFORT, KENTUCKY	OF A. 42
APPROVED BY	AGENCY HEAD	DATE
	<i>W.D. Connally</i>	10-26-67
APPROVED BY	OWNER	DATE

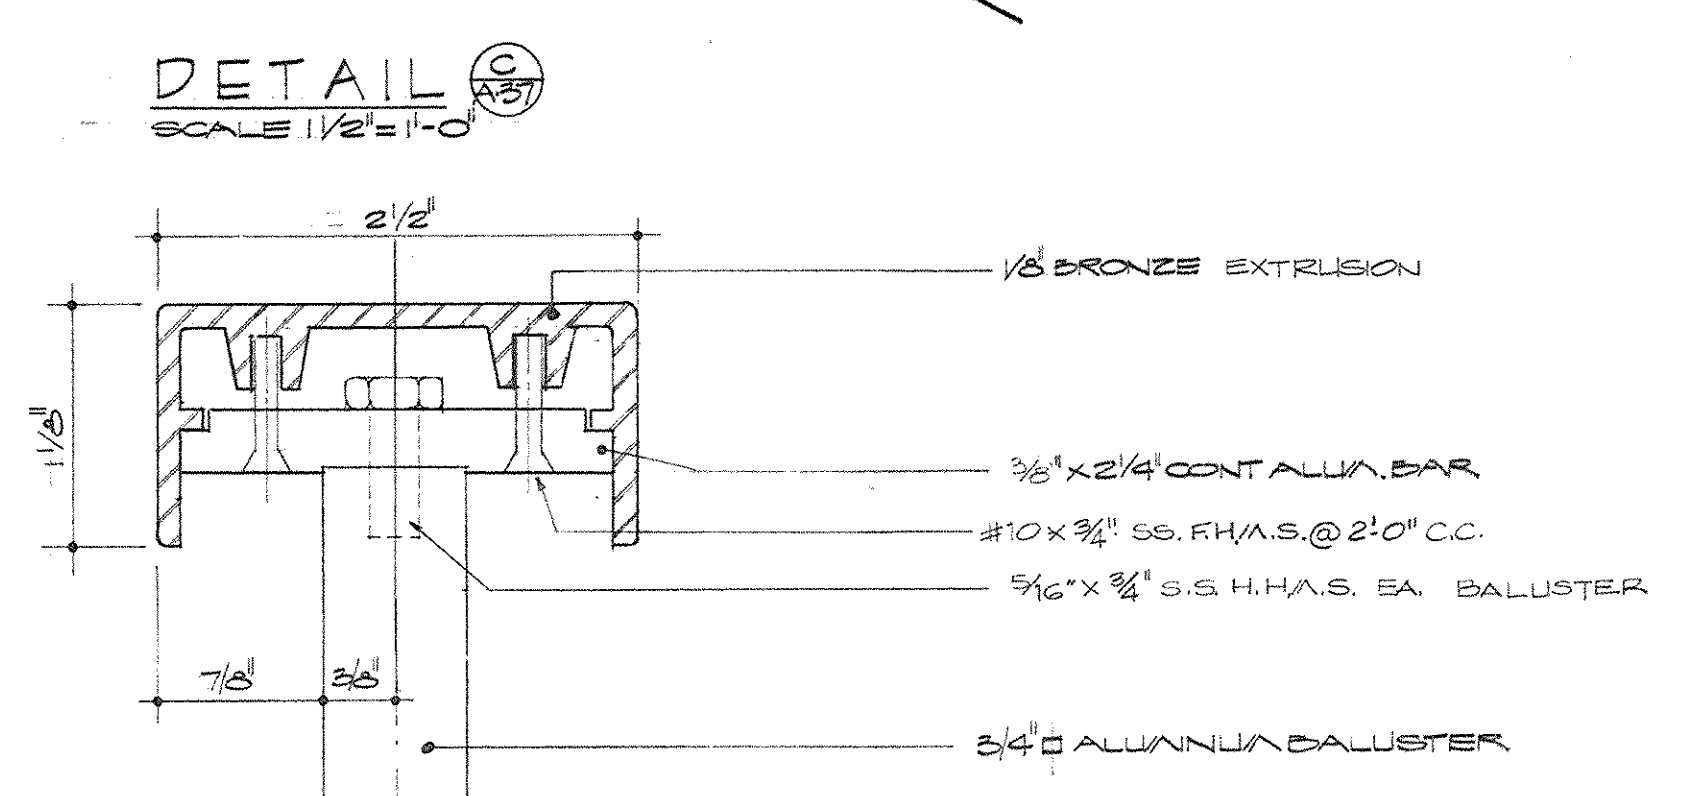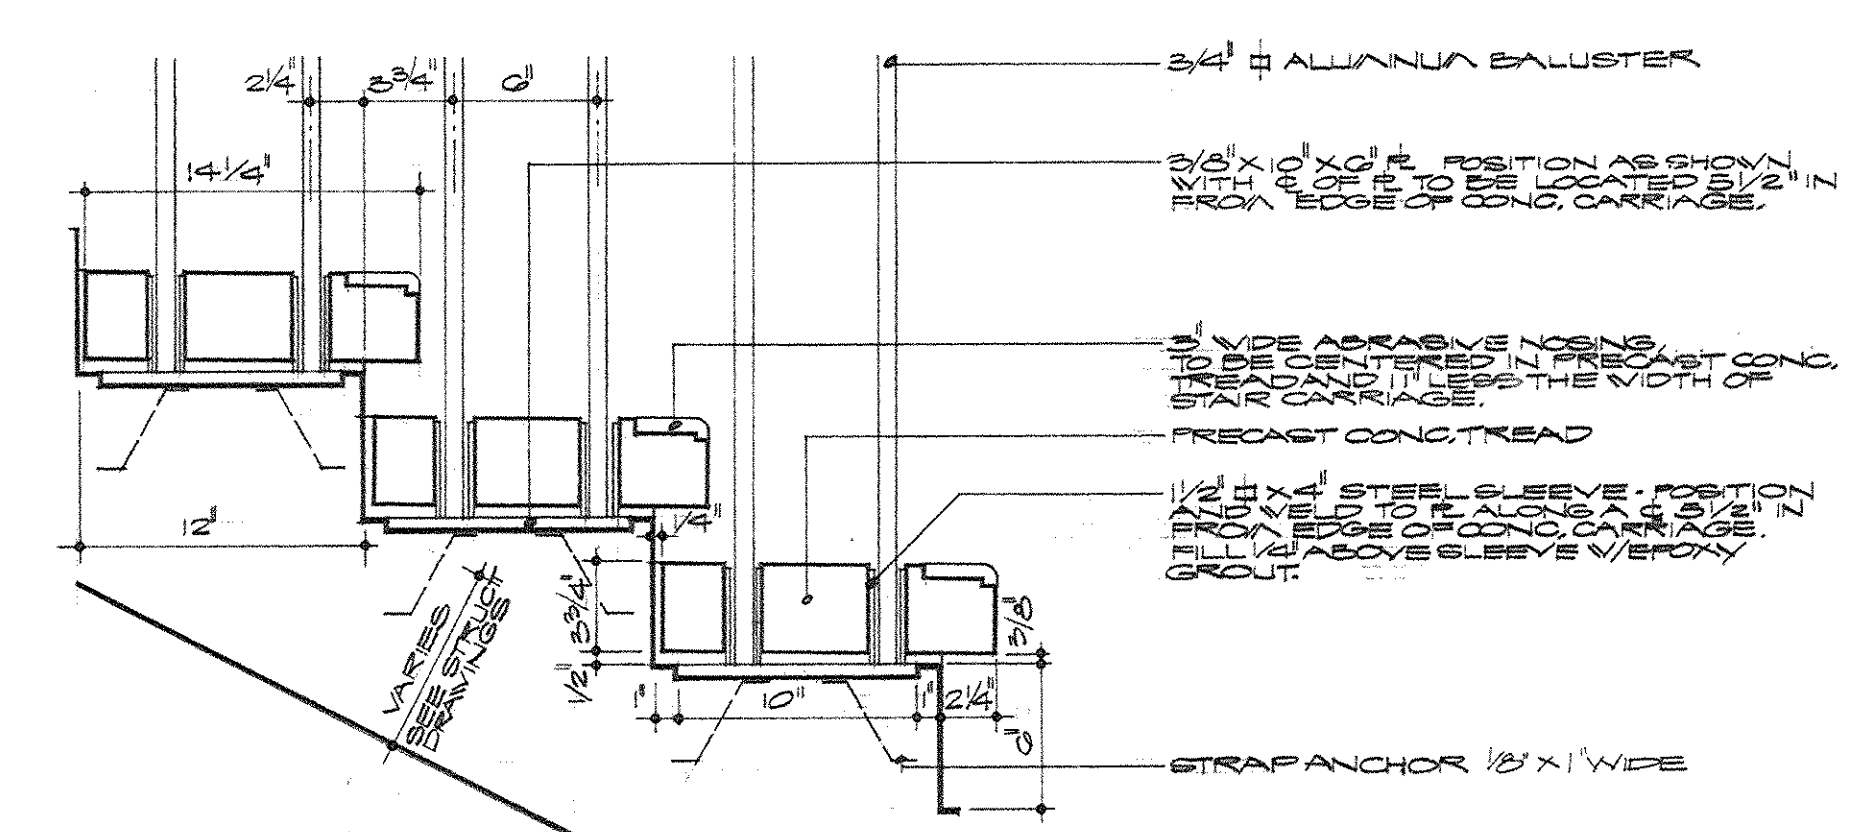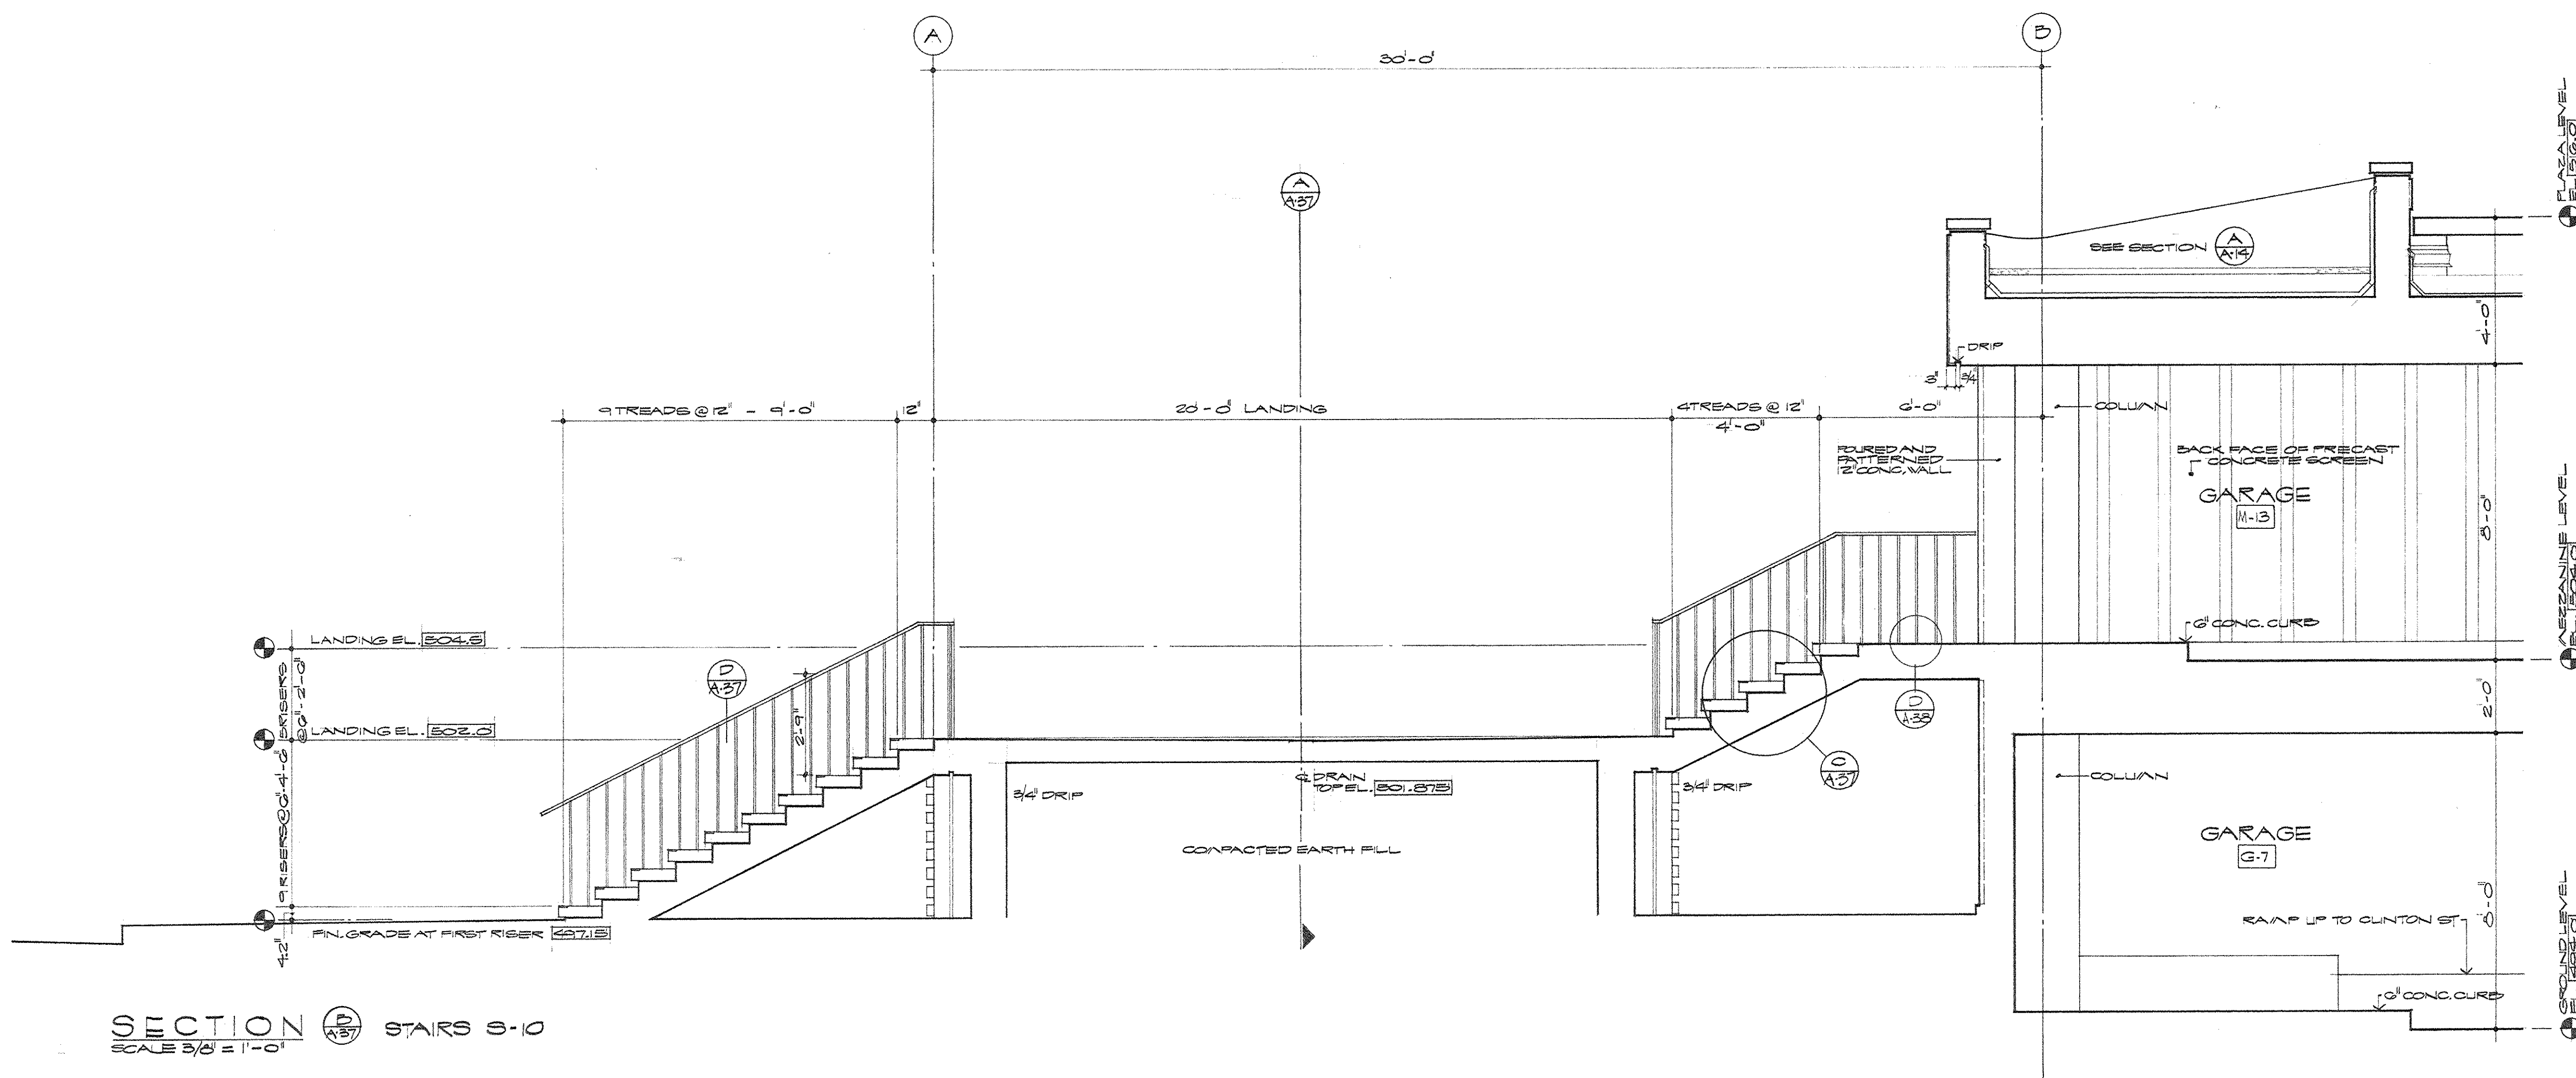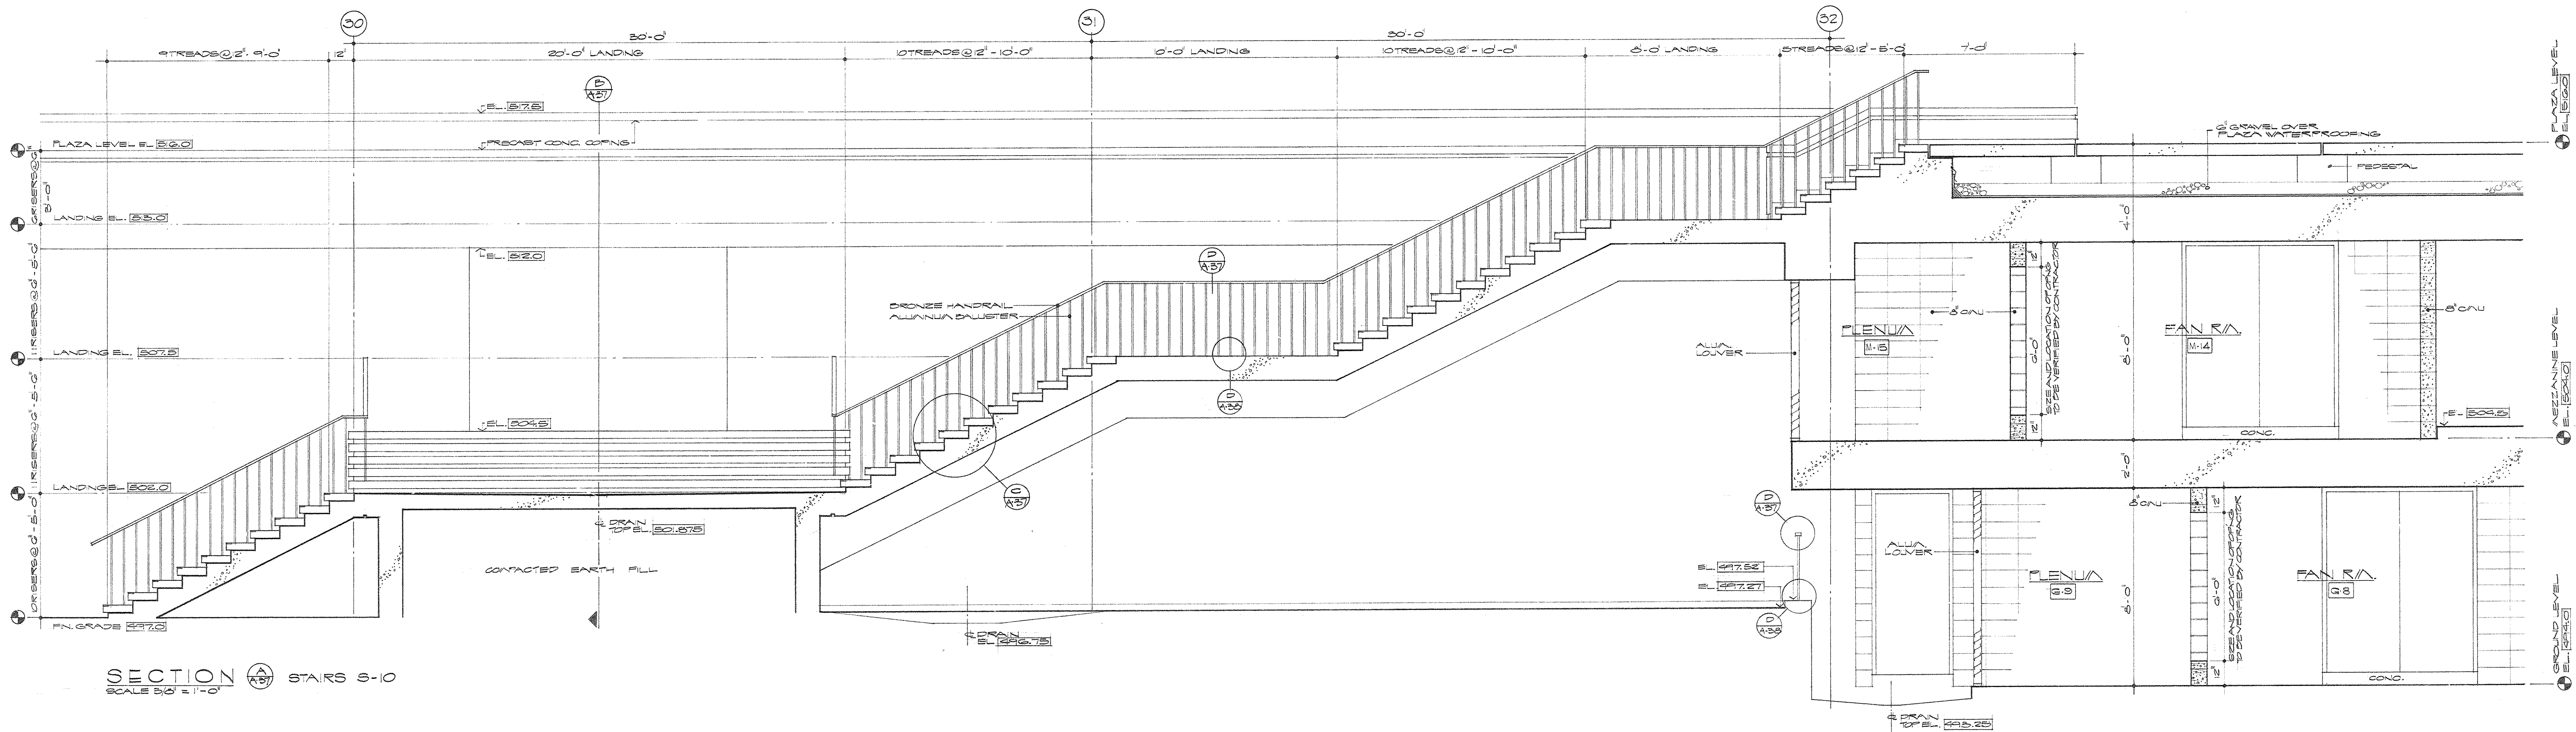


DETAIL E
FULLSCALE

AS BUILT REVISIONS 8 24 72


		CAPITAL PLAZA DEVELOPMENT PHASE II	
		FRANKFORT, KENTUCKY	
DRAWN BY W. Z. CHECKED BY L. C.	ARCHITECTS LEE POTTER SMITH, PRITCHETT, HUGG & CARTER 314 WILKINSON STREET FRANKFORT, KENTUCKY	DATE 16 OCT. 1967 COMM. NO. 50367 DRAWING NO. A 37 OF A 42	DEPARTMENT OF FINANCE - DIVISION OF ENGINEERING FRANKFORT, KENTUCKY
APPROVED BY	AGENCY HEAD	DATE	10-26-67
APPROVED BY	OWNER	DATE	

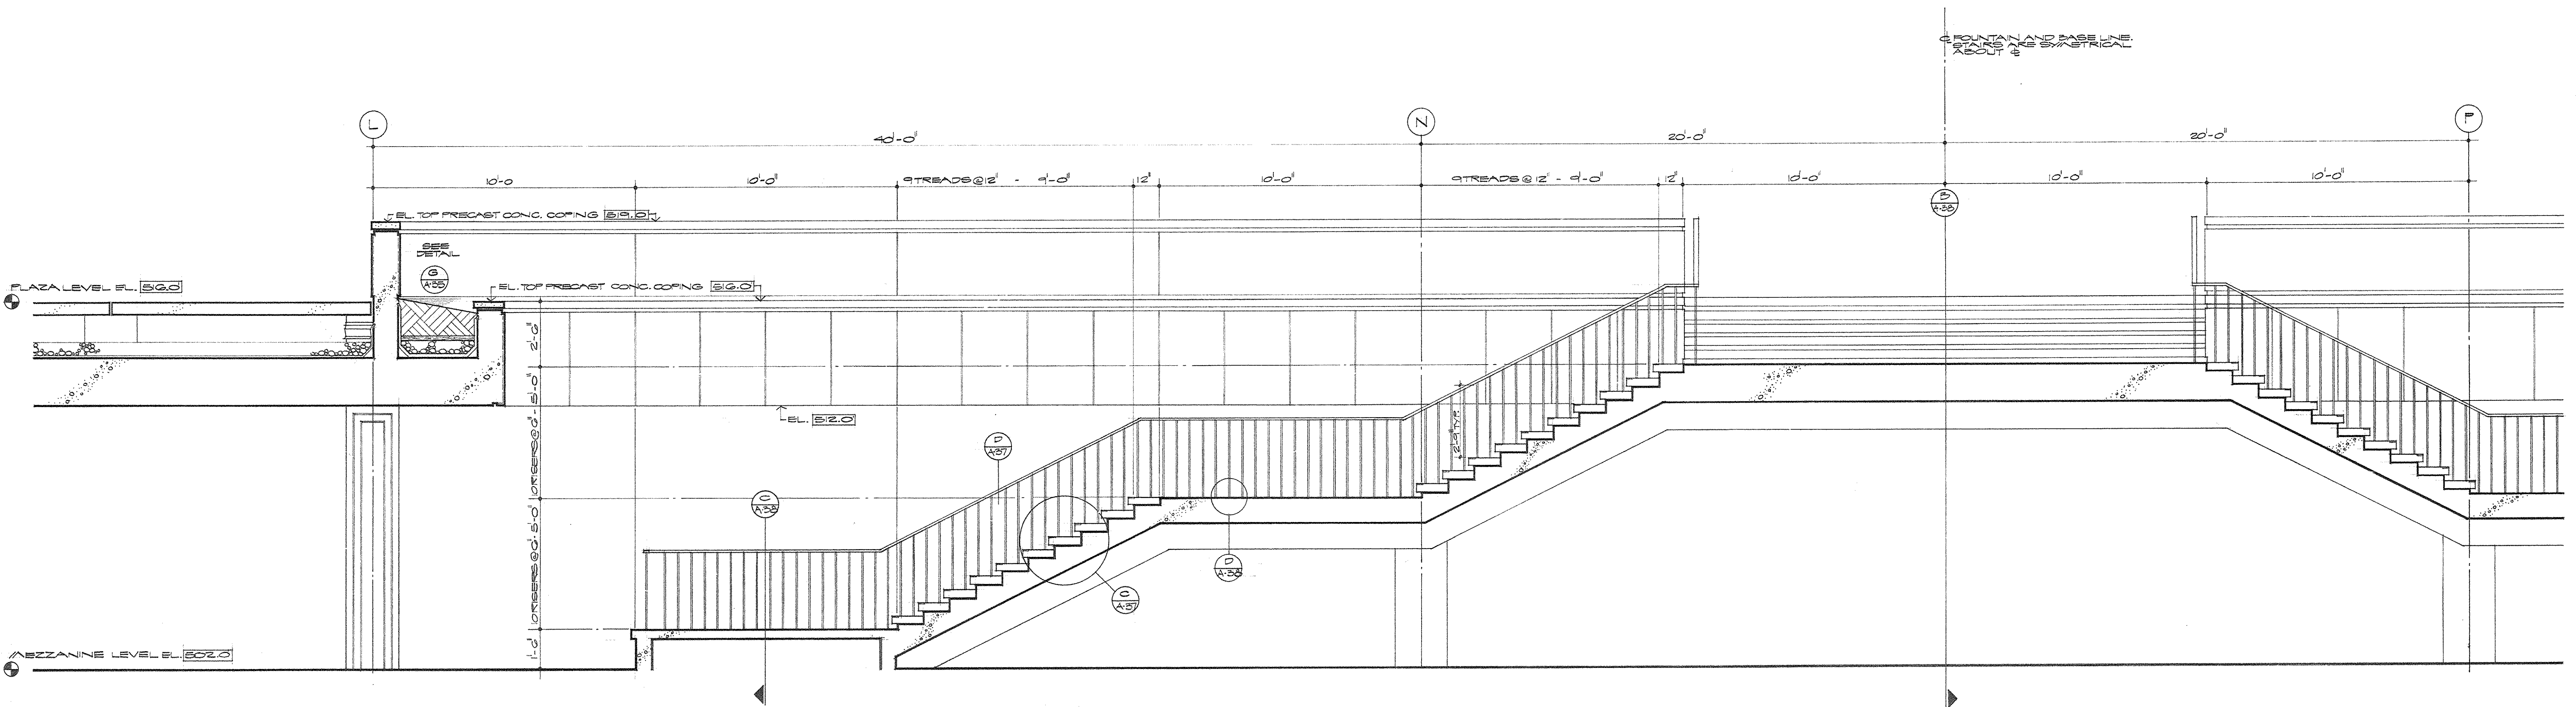


SECTION 100 STAIRS S-5 AND S-6
SCALE 3/8" = 1'-0"

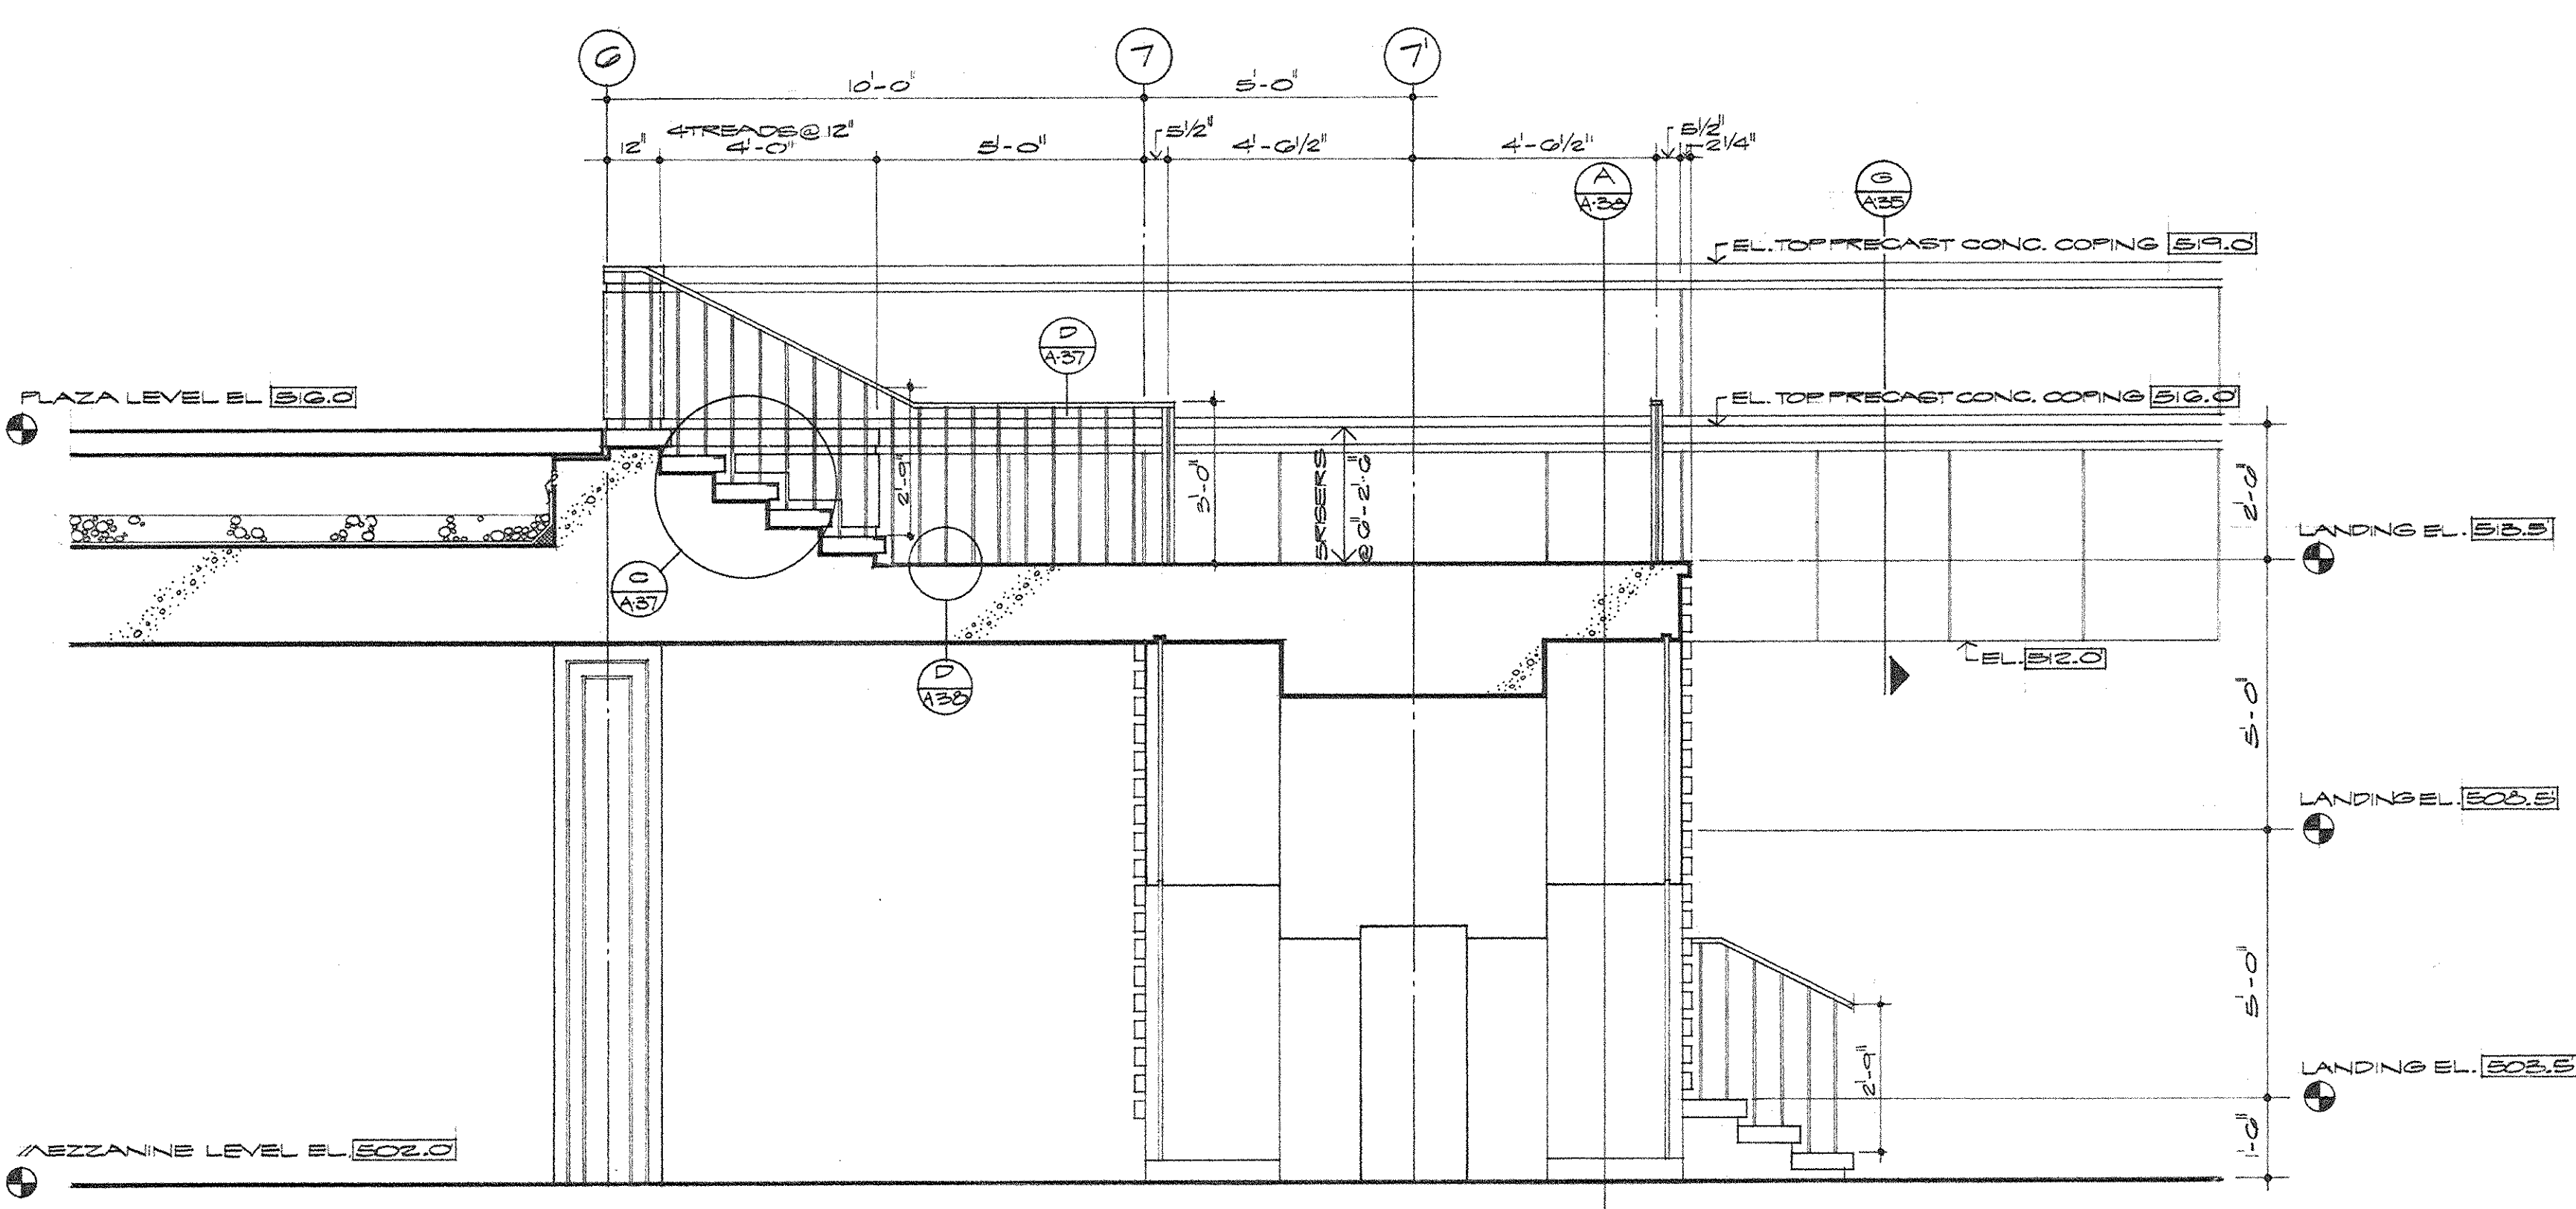


SECTION 100 STAIRS S-5 AND S-6
SCALE 3/8" = 1'-0"

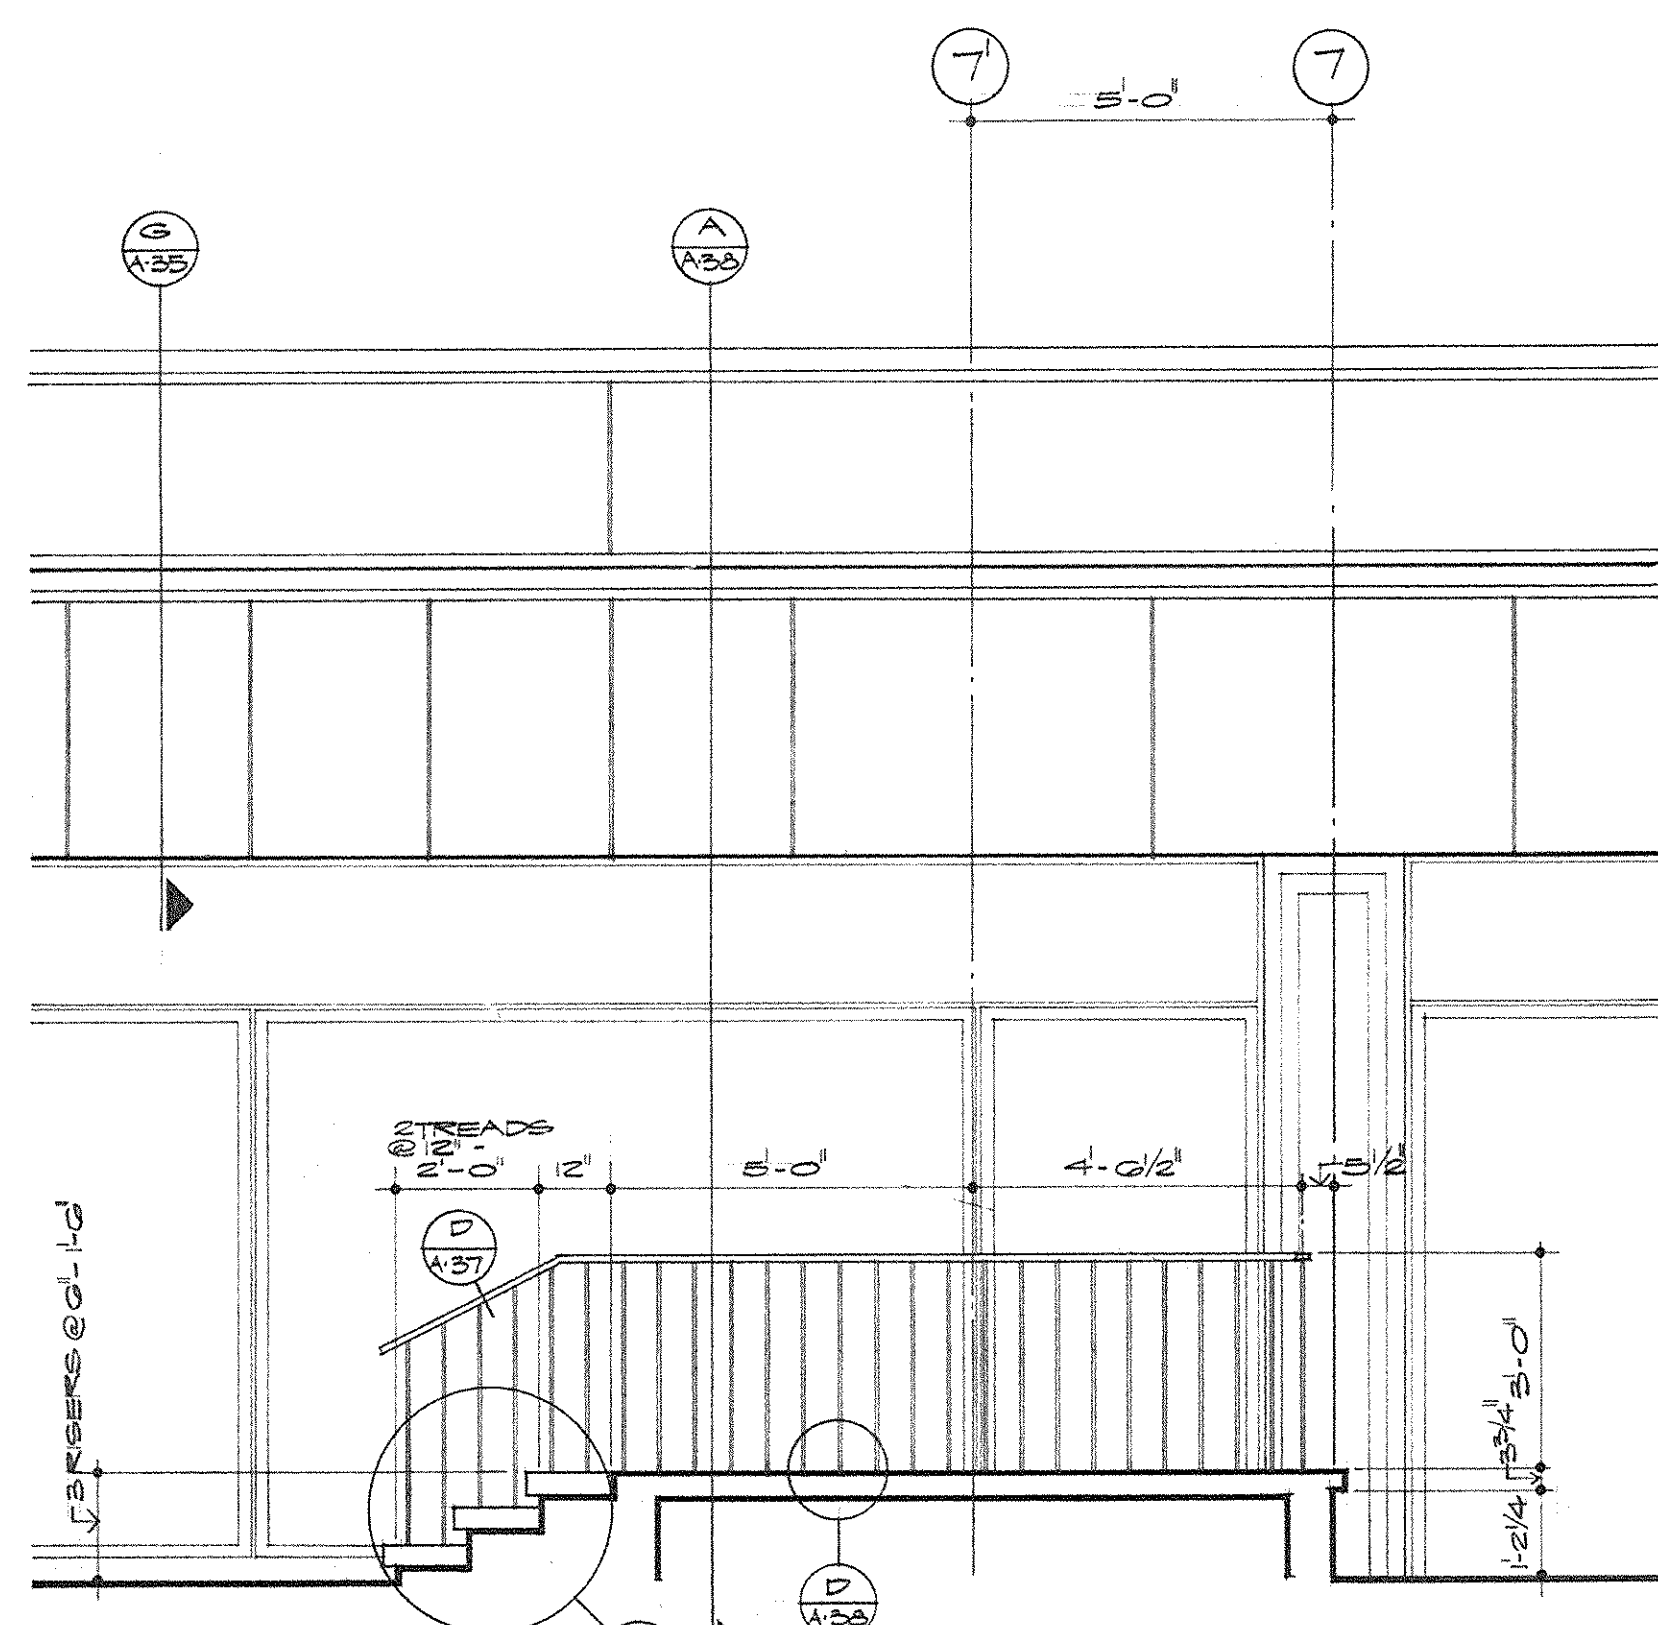


SECTION 100 STAIRS S-5 AND S-6
SCALE 3/8" = 1'-0"

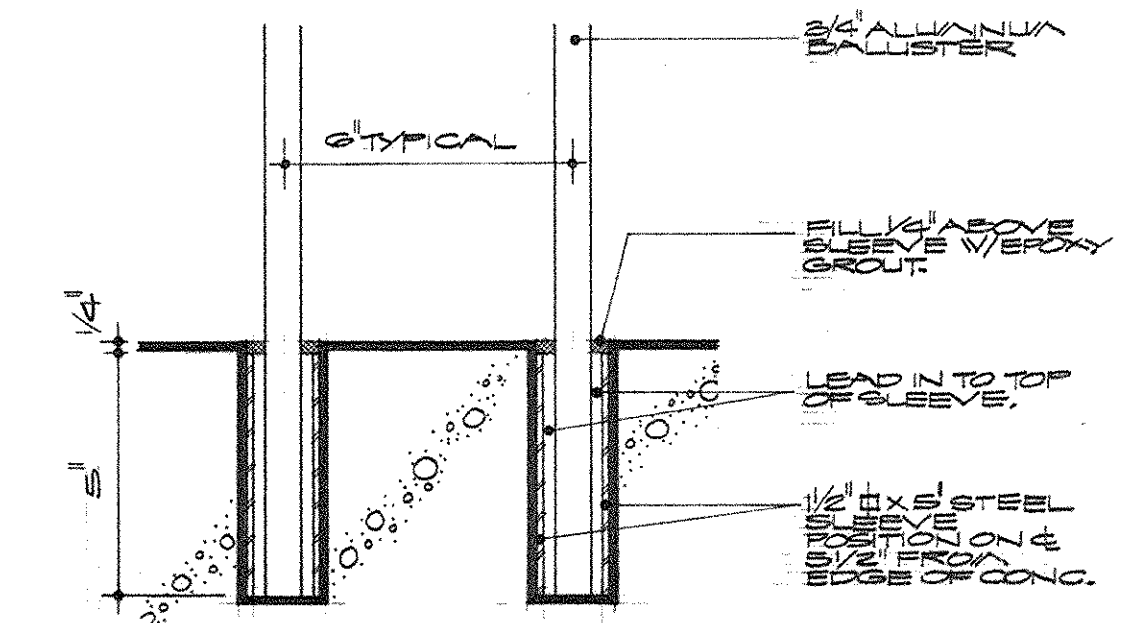


DETAIL 100
SCALE 3/8" = 1'-0"

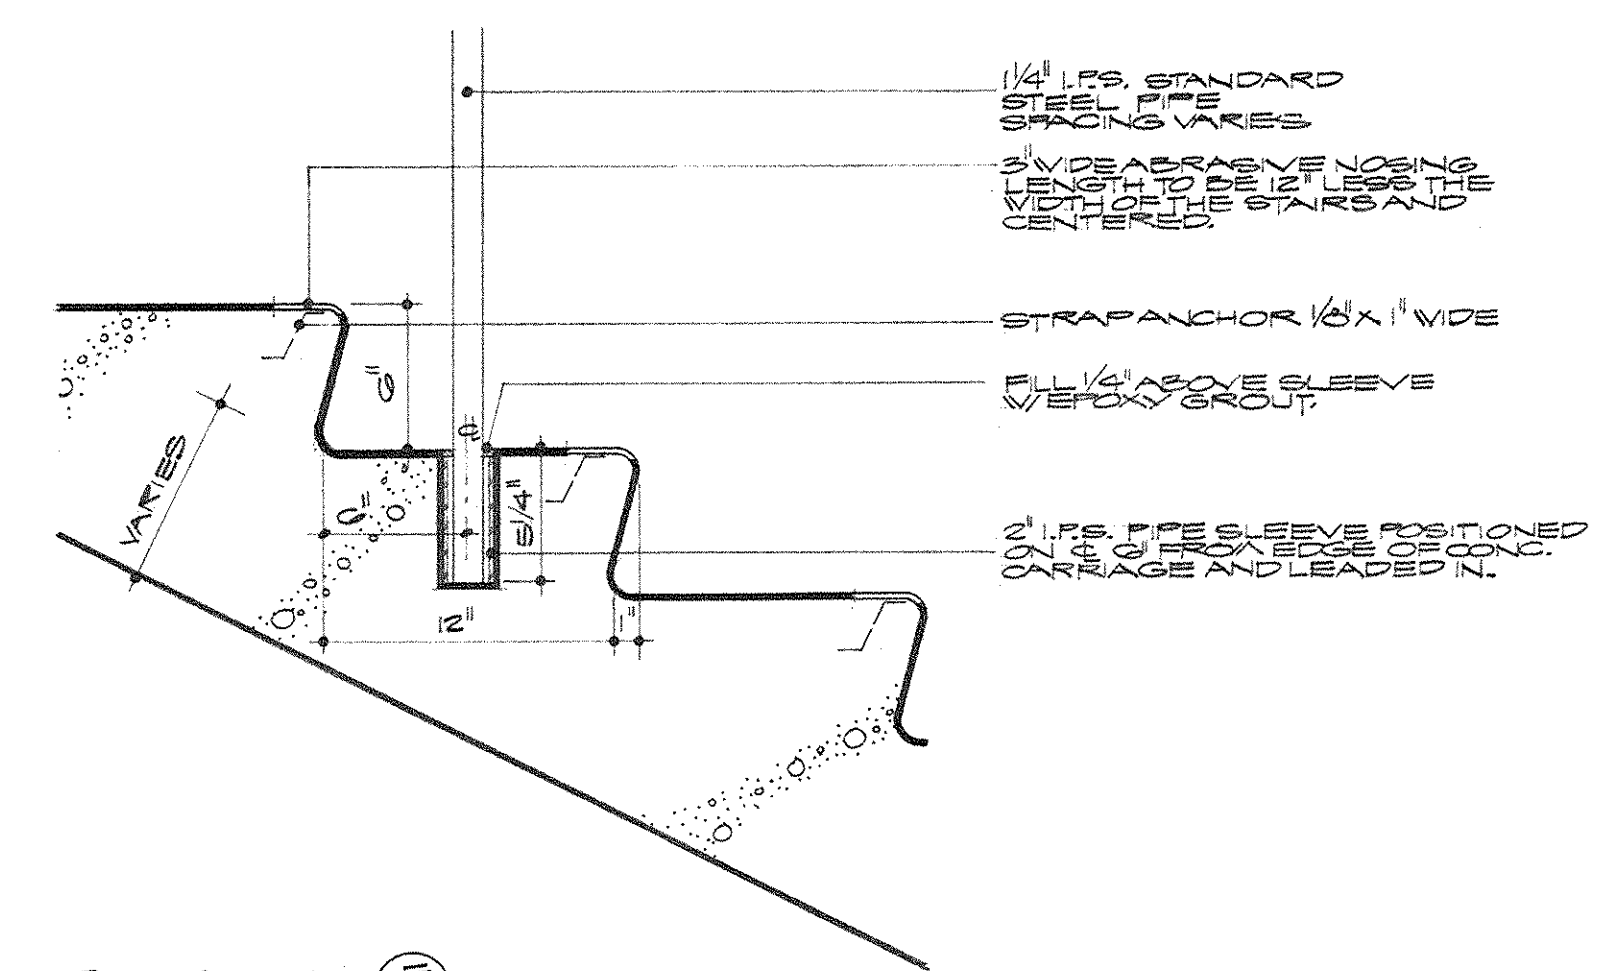

DETAIL 100
SCALE 1/2" = 1'-0"


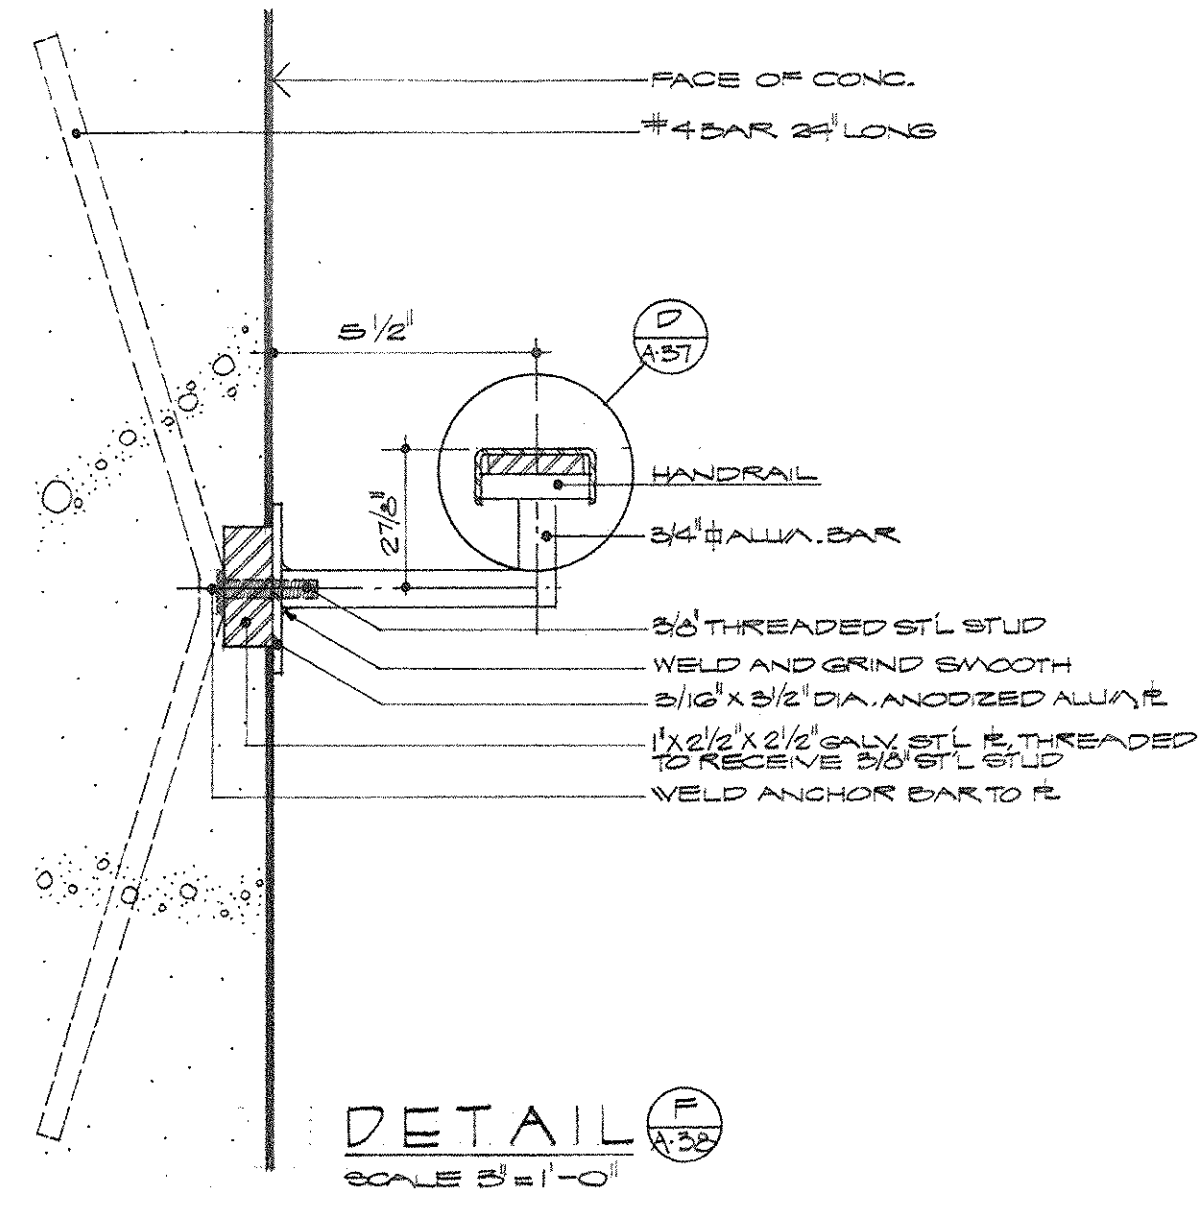


DETAIL 100
SCALE 3/8" = 1'-0"

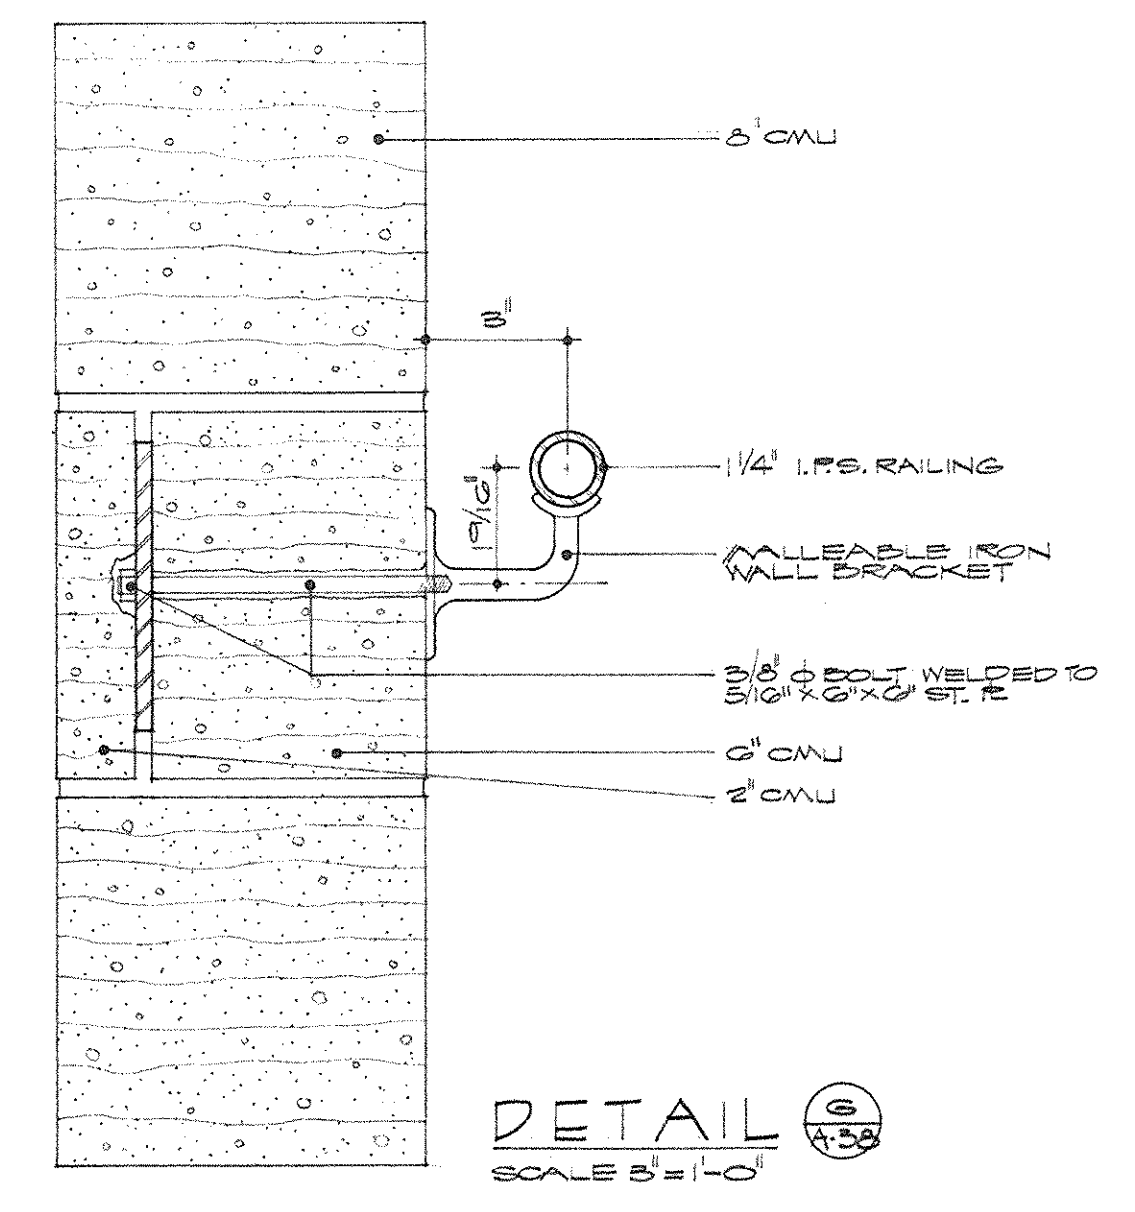


DETAIL 100
SCALE 3/8" = 1'-0"

AS BUILT REVISIONS - 8-24-72

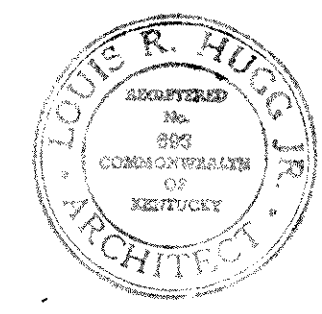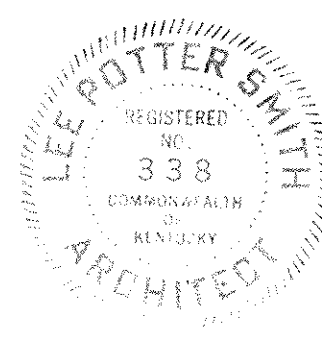

CAPITAL PLAZA DEVELOPMENT PHASE II FRANKFORT, KENTUCKY		
DRAWN BY V.P.Z.	DATE 16 OCT. 1967	
CHECKED BY L.E.H.	COMM. NO. 50387	
SECTION NO.	ARCHITECTS LEE POTTER SMITH, PRITCHETT, HUGG & CARTER 314 WILKINSON STREET FRANKFORT, KENTUCKY	ENGINEERS FRANKFORT, KENTUCKY
	COMMONWEALTH OF KENTUCKY DEPARTMENT OF FINANCE - DIVISION OF ENGINEERING FRANKFORT	
APPROVED BY	AGENCY HEAD <i>W.F. McConell</i>	DATE 10-26-67
APPROVED BY	OWNER	

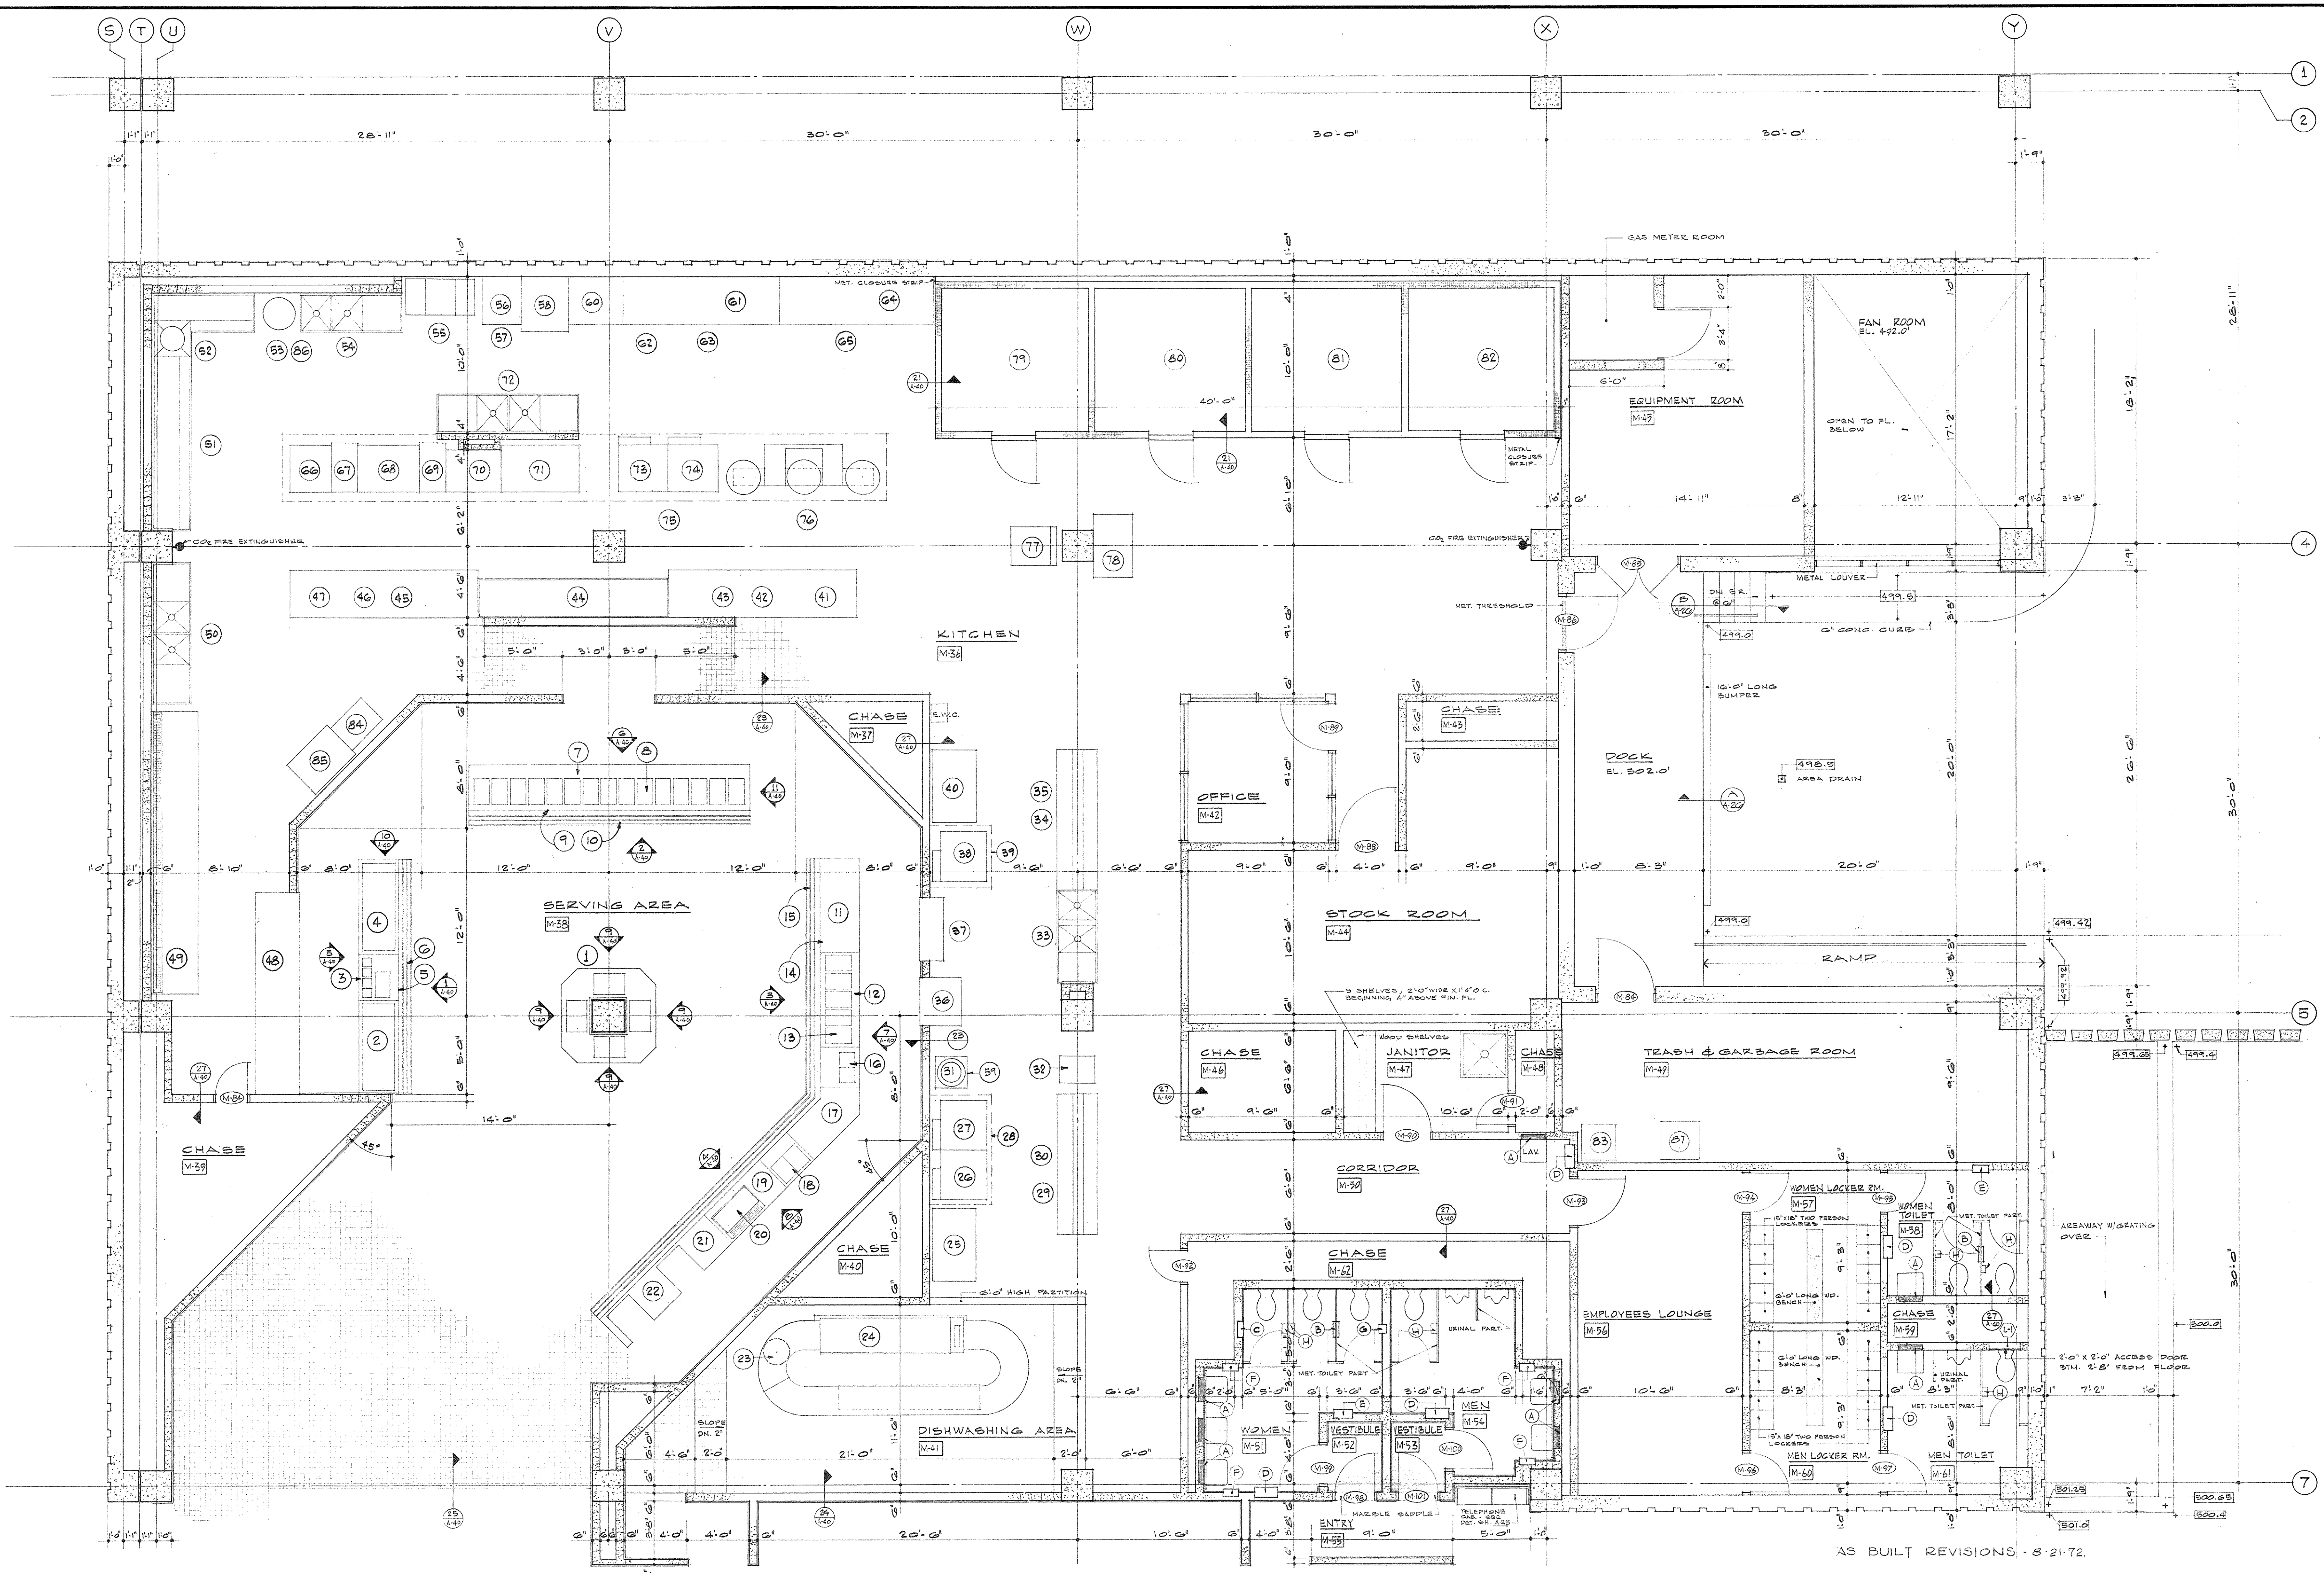


ENLARGED KITCHEN PLAN - SECTOR D-4
1/4" = 1'-0"

- SCHEDULE OF TOILET ACCESSORIES**
SEE SPEC'S FOR DETAILED DESCRIPTION
- A. MULTIPURPOSE UNIT W/ MIRROR
 - B. NAPKIN DISPOSAL
 - C. NAPKIN RECEPTACLE
 - D. WASTE RECEPTACLE
 - E. COMBINATION VENDOR
 - F. ELECTRIC HAND DRYER
 - G. TOILET TISSUE DISPENSER - WALL MOUNTED
 - H. TOILET TISSUE DISPENSER - SURFACE MOUNTED ON SIDE OF TOILET PARTITION


A5 BUILT REVISIONS - 6-21-72.

CAPITAL PLAZA DEVELOPMENT PHASE II		
FRANKFORT, KENTUCKY		
DRAWN BY F.D.	ENLARGED KITCHEN PLAN	DATE 15 OCT 1967
CHECKED BY L.R.H.	LEE POTTER SMITH, PRITCHETT, HUGG & CARTER ARCHITECTS 314 WILKINSON STREET FRANKFORT, KENTUCKY	COMM. NO. 50387
SECTOR NO. D 4	COMMONWEALTH OF KENTUCKY DEPARTMENT OF FINANCE - DIVISION OF ENGINEERING FRANKFORT, KENTUCKY	DRAWING NO. A 39
APPROVED BY AGENCY HEAD	DATE	
APPROVED BY OWNER	DATE	

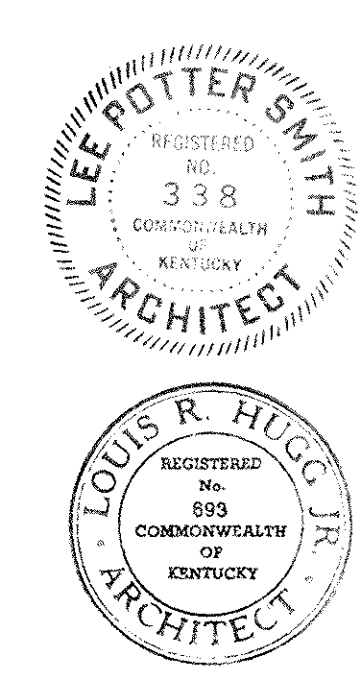

SCHEDULE OF KITCHEN EQUIPMENT

NO.	DESCRIPTION	NO.	DESCRIPTION
1	67" x 27" x 34" H. COUNTER SECTION W/ 4' SELF-LEVELING	48	PASS-THRU REFRIGERATOR
2	30" L x 30" W x 34" H. SELF-CONTAINED REFRIGERATED SAND DISPLAY COUNTER W/ 20" x 20" x 2" RECESSED TOP AND RECESSED FOR MOBILE CARTS UNDER COUNTER.	49	18" L x 30" W x 34" H. SELF-CONTAINED REFRIGERATED SAND DISPLAY COUNTER W/ 20" x 20" x 2" RECESSED TOP AND RECESSED FOR MOBILE CARTS UNDER COUNTER.
3	30" L x 30" W x 34" H. SELF-CONTAINED REFRIGERATED SAND DISPLAY COUNTER W/ 20" x 20" x 2" RECESSED TOP AND RECESSED FOR MOBILE CARTS UNDER COUNTER.	50	TWO COMPARTMENT SINK W/ DRAINBOARD EACH SINK - 18" L x 30" W x 34" H.
4	30" L x 30" W x 34" H. SELF-CONTAINED REFRIGERATED SAND DISPLAY COUNTER W/ 20" x 20" x 2" RECESSED TOP AND RECESSED FOR MOBILE CARTS UNDER COUNTER.	51	18" L x 40" W x 34" H. U-SHAPED DISPOSABLE TABLE W/ 20" W TROUGH.
5	18" L. FOOD PROTECTOR - 4" HIGH W/ SLOPING FRONT AND GLASS FRONT, TOP AND SIDES.	52	DISPOSABLE TO BE INSTALLED ON ITEM #1.
6	18" L. FOUR BAR SLIDE W/ BRACKETS AT 30" @ 6".	53	VEGETABLE PEELER
7	18" L x 30" W x 34" H. 4" HIGH SECTION W/ TOP AND RECESSED FOR MOBILE CARTS UNDER COUNTER.	54	TWO COMPARTMENT SINK W/ DRAINBOARD EACH SINK - 18" L x 30" W x 34" H.
8	18" L. FOOD PROTECTOR - 4" HIGH W/ SLOPING FRONT AND GLASS FRONT, TOP AND SIDES.	55	MOBILE STORAGE RACK FOR 18" x 20" PANS.
9	18" L. FOOD PROTECTOR - 4" HIGH W/ SLOPING FRONT AND GLASS FRONT, TOP AND SIDES.	56	MEAT CHOPPER
10	18" L. FOUR BAR TRAY SLIDE W/ BRACKETS AT 30" @ 6".	57	30" L x 30" W x 34" H. BASE UNIT W/ UNDESHELF
11	30" L x 30" W x 34" H. COUNTER SECTION W/ RECESSED FOR MOBILE CARTS UNDER COUNTER.	58	30" Q.T. PELUXE FOOD MIXER (FLOOR MODEL)
12	30" L x 30" W x 34" H. 4" HIGH SECTION W/ TOP AND RECESSED FOR MOBILE CARTS UNDER COUNTER.	59	24" x 24" x 18" H. ENCLOSED MIXER BATTERS W/ LOOSE TYPE CASTERS AND UNDESHELF
13	INDIVIDUAL SLICE HEAT WELLS W/ THERMOSTAT AND PILOT LIGHT. WELLS TO BE INSTALLED IN ITEM #7.	60	MEAT SAW
14	18" L. FOOD PROTECTOR - 4" HIGH W/ SLOPING FRONT AND GLASS FRONT, TOP AND SIDES.	61	10" L x 30" W x 34" H. WARE TABLE W/ UNDESHELF
15	APPROX. 35" H. FOUR BAR TRAY SLIDE W/ BRACKETS AT EACH STAINLESS STEEL PLASTER	62	TENDERIZER
16	30" L x 30" W x 34" H. SELF-CONTAINED STEAM SECTION CAPABLE OF HOLDING 20 GALS OF BULK ICE CREAM	63	WASHT SLICER
17	10" L x 30" W x 34" H. 4" HIGH SECTION W/ RECESSED FOR MOBILE CARTS UNDER COUNTER.	64	10" L x 30" W x 34" H. WARE TABLE W/ UNDESHELF
18	30" L x 30" W x 34" H. SELF-CONTAINED ICE STORAGE SECTION W/ CAPACITY OF 200 LBS. OF ICE.	65	SECTION SCAL
19	30" L x 30" W x 34" H. URN BASE W/ 1" DEPRESSION FOR URN AND TRAY - SLOUGH IN TOP AND RECESSED FOR MOBILE CARTS UNDER COUNTER.	66	FRY TOP RANGES W/ OVEN UNISEL
20	COFFEE URN - 20 GAL. AUTOMATIC COFFEE MAKER W/ 2 G. GAL. COFFEE CHAMBERS AND 1 1/2 GAL. WATER CHAMBERS	67	DEEP FRYER
21	30" L x 30" W x 34" H. CHECK-OUT SECTION W/ 20" x 20" COUNTER FOR CHECK-OUT PERSON AND RECESSED FOR ICE STORAGE	68	40" L x 30" W x 36" H. WARE TABLE W/ 2" H. BACKPLASH AND UNDESHELF
22	30" L x 30" W x 34" H. CHECK-OUT SECTION W/ 20" x 20" COUNTER FOR CHECK-OUT PERSON AND RECESSED FOR ICE STORAGE	69	DEEP FRYER
23	DISPOSABLE MOUNTED IN PRE-WASH SECTION OF DISHWASHER TABLE.	70	TWO COMPARTMENT STEAM PRESSURE COOKERS
24	DISHWASHER W/ PRE-WASH SECTION	71	TWO COMPARTMENT STEAM PRESSURE COOKERS W/ UNDESHELF SELF-CONTAINED PRESSURE
25	REACH-IN REFRIGERATOR	72	TWO COMPARTMENT SINK W/ DRAINBOARD EACH SINK - 18" L x 30" W x 34" H.
26	TWO DECK CONVECTION OVEN	73	TWO DECK CONVECTION OVEN
27	TWO DECK CONVECTION OVEN	74	TWO DECK CONVECTION OVEN
28	EXHAUST HOOD W/ 4" x 20" x 2" GREASE FILTERS	75	EXHAUST HOOD W/ 4" x 20" x 2" GREASE FILTERS
29	10" L x 30" W x 34" H. BATTER TABLE W/ 1" H. WELLS TOP TIE OF 2" x 20" x 2" DIS. PRESSURE 18" H. UNDESHELF OPEN FOR FRY TOP BINS, 18" H. ELEVATED SHELF OVER TABLE	76	STEAM JACKETED KETTLE BATTERY
30	THREE PORTABLE STORAGE BINS - SA. 20" x 22" x 24"	77	RECEIVING DIAL SCAL
31	30" Q.T. BENCH TYPE FOOD MIXER	78	30" L x 30" W x 42" H. DECK W/ 2" x 20" x 2" DEEP PRESSURE AND UNDESHELF
32	COOLING RACK FOR 18" x 20" PANS OR TRAYS	79	30" L x 10" W x 34" H. WALK-IN COOLER W/ REMOTE CONDENSER
33	TWO COMPARTMENT SINK W/ DRAINBOARD EACH SINK - 18" L x 30" W x 34" H.	80	10" L x 10" W x 34" H. WALK-IN COOLER W/ REMOTE CONDENSER
34	18" L x 30" W x 34" H. BATTER TABLE W/ 1" H. WELLS TOP TIE OF 2" x 20" x 2" DIS. PRESSURE 18" H. UNDESHELF OPEN FOR FRY TOP BINS, 18" H. ELEVATED SHELF OVER TABLE	81	10" L x 10" W x 34" H. WALK-IN COOLER W/ REMOTE CONDENSER
35	THREE PORTABLE STORAGE BINS - SA. 20" x 22" x 24"	82	10" L x 10" W x 34" H. WALK-IN FREEZER W/ REMOTE CONDENSER
36	PASS-THRU HOT FOOD STORAGE UNIT	83	BOTTLE AND CAN CRUSHER
37	PASS-THRU STORAGE DISPLAY UNIT - 4" L x 18" W x 18" H.	84	ICE FLAKES W/ STAND
38	TWO DECK CONVECTION OVEN	85	ICE STORAGE BIN
39	EXHAUST HOOD W/ 2" x 20" x 2" GREASE FILTERS	86	DISPOSABLE - TO BE INSTALLED ON ITEM #25
40	REACH-IN REFRIGERATOR	87	CAN WASH
41	UNDESHELF COUNTER HOT FOOD STORAGE UNIT	88	4" L x 18" W x 28" H. WAITRESS STATION W/ DRAIN, TWO UNDESHELF
42	18" L x 30" W x 34" H. WARE TABLE W/ 2" x 20" x 2" DEEP PRESSURE AND 10" L.	89	4" L x 18" W x 28" H. WAITRESS STATION W/ DRAIN, TWO UNDESHELF
43	2" H. ELEVATED SHELVES W/ STOP HEAT LAMPS UNISEL	90	4" L x 18" W x 28" H. WAITRESS STATION W/ DRAIN, TWO UNDESHELF
44	18" L x 30" W x 34" H. HOT PAN MADE W/ 2" WIDE PAN, 18" L UNDESHELF, 2" x 20" HEATING ELEMENTS W/ THERMOSTAT		
45	18" L x 30" W x 34" H. WARE TABLE W/ 2" x 20" x 2" DEEP PRESSURE AND 10" L. UNDESHELF		
46	2" H. ELEVATED SHELVES W/ STOP HEAT LAMPS UNDER		
47	UNDESHELF COUNTER HOT FOOD STORAGE UNIT		

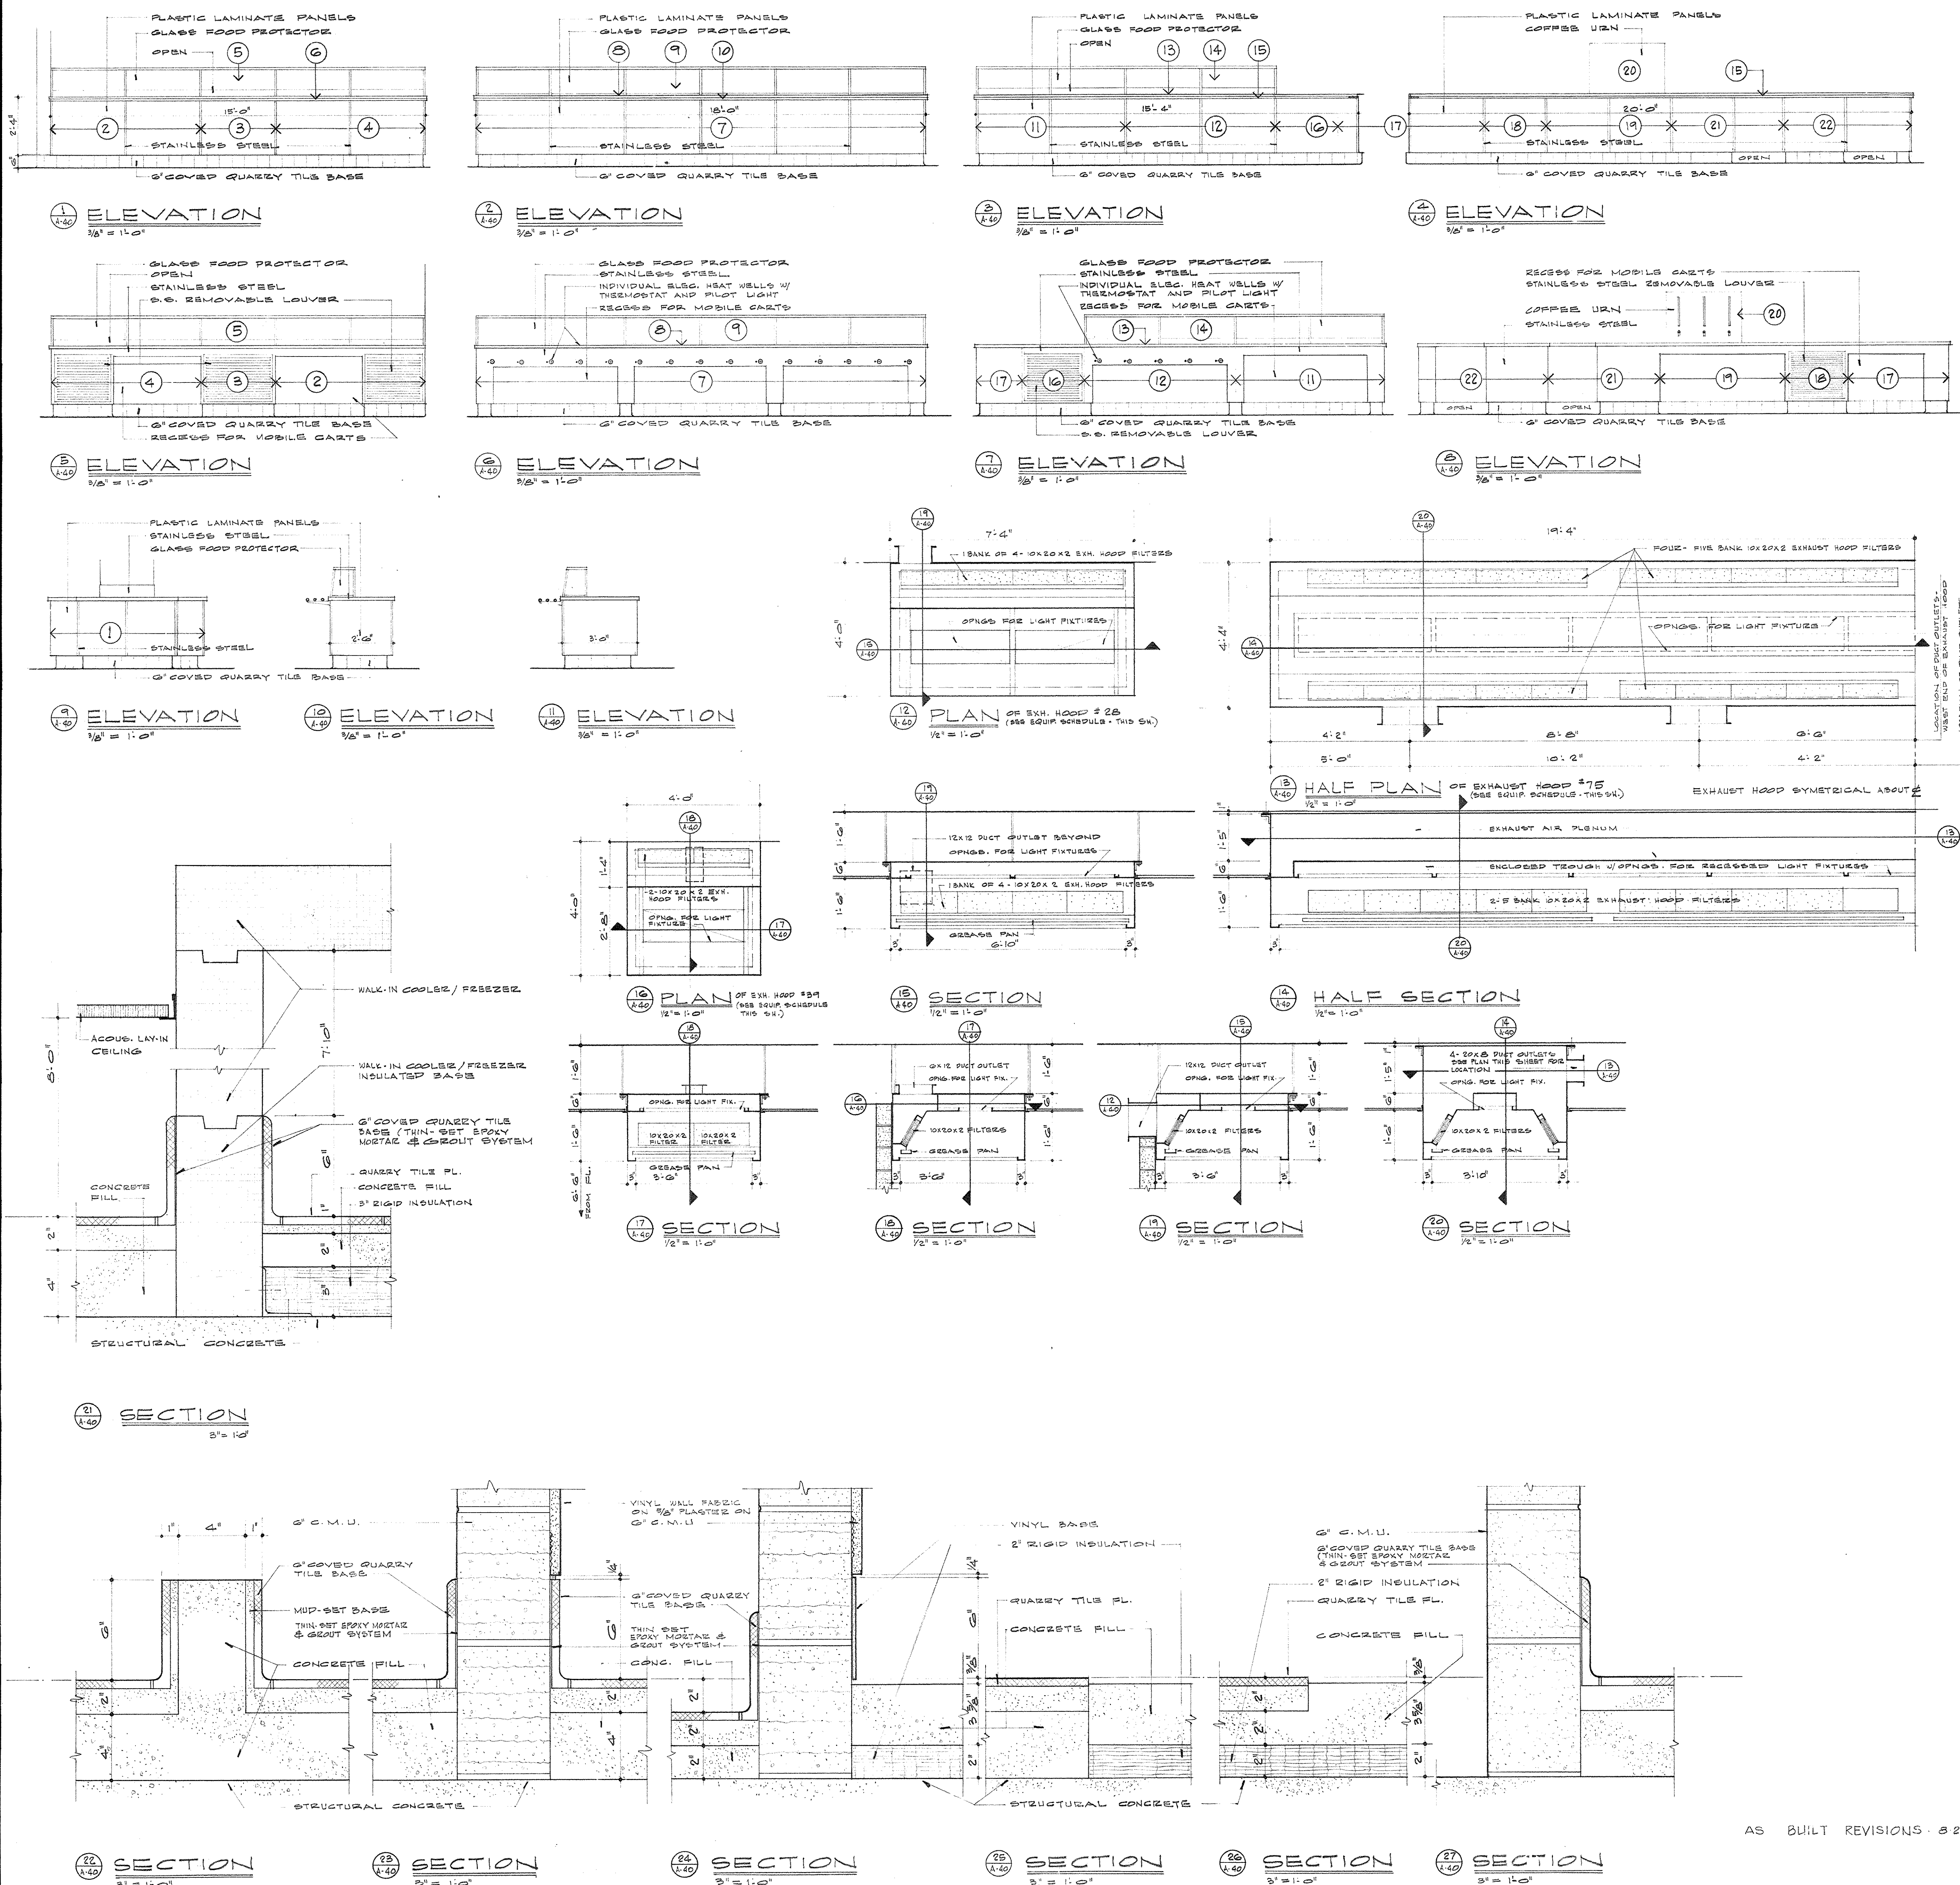

AS BUILT REVISIONS - 5 24 72

CAPITAL PLAZA DEVELOPMENT PHASE II

FRANKFORT, KENTUCKY

DRAWN BY E.C.	KITCHEN EQUIPMENT SCHEDULE	DATE 5 OCT. 1967
CHECKED BY L. R. P.	ARCHITECTS LEE POTTER SMITH, PRITCHETT, HUGG & CARTER 314 WILKINSON STREET, FRANKFORT, KENTUCKY	COMM. NO. 50387
SECTOR NO. D 4	ENGINEERS COMMONWEALTH OF KENTUCKY DEPARTMENT OF FINANCE - DIVISION OF ENGINEERING FRANKFORT, KENTUCKY	DRAWING NO. A 40
APPROVED BY AGENCY HEAD	DATE 10-26-67	
APPROVED BY OWNER	DATE	

DOOR SCHEDULE





DOOR NUMBER	LOCATION	DOOR TYPE	FRAME TYPE	FRAME PROFILE	HARDWARE TYPE	LINTEL TYPE	KEY GROUP	DOOR SIGN	DOOR NOTES
G-1	G-2	B	G	2	1	2	-	-	PAINTED
G-2	G-5	4	5	2	1	2	-	-	PAINTED
G-3	G-8	5	11	2	2	1	-	-	PAINTED
G-4	G-9	2	2	2	3	1	-	-	PAINTED
G-20	G-9	5	5	2	1	1	-	-	PAINTED
G-5	G-12	7	12	2	1	1	-	-	PAINTED
G-6	G-16	5	5	2	1	1	-	-	PAINTED
G-7	G-13	5	5	2	1	1	-	-	PAINTED
G-8	G-10	3	21	2	1	1	-	-	PAINTED
G-9	G-17	7	12	2	1	1	-	-	PAINTED
G-10	S-15	5	5	2	1	1	-	-	PAINTED
G-11	G-18	5	7	2	1	1	-	-	PAINTED
G-12	G-22	5	5	2	1	1	-	-	PAINTED
G-13	G-25	11	14	2	4	1	-	-	PAINTED
G-14	G-28	1	1	2	2	1	-	-	PAINTED
G-15	G-26	3	3	2	5	1	-	-	PAINTED
G-16	G-26	5	3	2	2	1	-	-	PAINTED
G-17	G-28	5	11	2	2	1	-	-	PAINTED
G-18	G-30	5	5	2	2	1	2	-	-
G-19	G-31	2	2	2	1	1	-	-	PAINTED
M-1	M-1	12	16	NOTE 1	G	-	-	-	-
M-2	M-1	12	16	NOTE 1	G	-	-	-	-
M-17	M-1	2	2	2	7	1	-	-	-
M-18	M-1	2	2	2	7	1	-	-	-
M-19	M-1	2	2	2	7	1	-	-	-
M-20	M-1	2	2	2	7	1	-	-	-
M-21	M-1	2	2	2	7	1	-	-	-
M-22	M-3	10	13	2	2	1	-	-	-
M-23	M-4	2	2	2	1	1	-	-	PAINTED
M-24	M-5	2	2	2	1	1	-	-	PAINTED
M-25	M-6	2	2	2	1	2	-	-	PAINTED
M-26	M-7	12	16	NOTE 1	G	-	-	-	-
M-27	M-7	12	16	NOTE 1	G	-	-	-	-
M-41	M-8	12	16	NOTE 1	G	-	-	-	-
M-42	M-7	2	2	2	7	1	-	-	-
M-43	M-7	2	2	2	7	1	-	-	-
M-44	M-7	2	2	2	7	1	-	-	-
M-45	M-7	2	2	2	7	1	-	-	-
M-46	M-7	2	2	2	7	1	-	-	-
M-47	M-9	10	13	2	2	1	-	-	-
M-48	M-10	2	2	2	1	1	-	-	PAINTED
M-49	M-11	2	2	2	1	1	-	-	PAINTED
M-50	M-12	2	2	2	1	2	-	-	PAINTED
M-51	M-14	5	11	2	2	1	-	-	PAINTED
M-52	M-15	2	2	2	2	1	-	-	PAINTED

FINISH SCHEDULE

SPACE NO.	SPACE	FLOOR TYPE	BASE TYPE	WALL TYPE	CILING TYPE	CILING HEIGHT	REMARKS
G-1	GARAGE	A	NONE	B/C	C	-	-
G-2	LIFT EQUIPMENT RM.	F	NONE	B/C	C	-	-
G-3	CHASSIS	A	NONE	F/G	E	-	-
G-4	GARAGE	A	NONE	B/C	C	-	-
G-5	LIFT EQUIPMENT RM.	F	NONE	B/C	C	-	-
G-6	CHASSIS	A	NONE	F/G	E	-	-
G-7	GARAGE	A	NONE	B/C	C	-	-
G-8	FAN ROOM	F	NONE	B/C	C	-	-
G-9	PLENUM	A	NONE	B/C	C	-	-
G-10	GARAGE	A	NONE	B/C	C/G	-/8'-0"	-
G-11	GARAGE	A	NONE	B/C	C	-	-
G-12	FAN ROOM	F	NONE	B/C	C	-	-
G-13	LIFT EQUIPMENT RM.	F	NONE	B/C	C	-	-
G-14	ELECTRICAL ROOM	F	NONE	B/C	C	-	-
G-15	STAIRS	A	NONE	B/C	NOTE 1	-	-
G-16	GARAGE	A	NONE	B/C	C	-	-
G-17	PUMP ROOM	F	NONE	B/C	C	-	-
G-18	FAN ROOM	F	NONE	B/C	C	-	-
G-19	LIFT EQUIPMENT RM.	F	NONE	B/C	C	-	-
G-20	ELECTRICAL ROOM	F	NONE	B/C	C	-	-
G-21	GARAGE	A	NONE	B/C	C/G	-/8'-0"	-
G-22	STORAGE	A	NONE	B/C	C	-	-
G-23	STAIRS	A	NONE	B/C	C	-	-
G-24	GARAGE	A	NONE	B/C	C	-	-
G-25	STORAGE	A	NONE	B/C	C	-	-
G-26	FAN ROOM	F	NONE	B/C	C	-	-
G-27	GARAGE	A	NONE	B/C	C	-	-
G-28	STORAGE	A	NONE	B/C	C	-	-
G-29	CHASSIS	A	NONE	F/G	E	-	-
G-30	STORAGE	A	NONE	B/C	C	-	-
G-31	FAN ROOM	F	NONE	B/C	C	-	-
G-32	GARAGE	A	NONE	B/C	C	-	-
M-1	COMMERCIAL AREA	C	B	E/J	B	8'-0"	-
M-2	CORRIDOR	C	B	B/C	B	7'-9"	-
M-3	SERVICE AREA	A	NONE	B/C	B	7'-9"	-
M-4	TRASH	F	NONE	H/I	C	-	-
M-5	ELECTRICAL ROOM	F	NONE	B/C	C	-	-
M-6	FAN ROOM	F	NONE	B/C	C	-	-
M-7	COMMERCIAL AREA	C	B	E/J	B	8'-0"	-
M-8	CORRIDOR	C	B	B/C	B	7'-9"	-
M-9	SERVICE AREA	A	NONE	B/C	B	7'-9"	-
M-10	TRASH	F	NONE	H/I	C	-	-
M-11	ELECTRICAL ROOM	F	NONE	B/C	C	-	-
M-12	FAN ROOM	F	NONE	B/C	C	-	-
M-13	COMMERCIAL AREA	C	B	E/J	B	8'-0"	-
M-14	FAN ROOM	F	NONE	B/C	C	-	-
M-15	PLENUM	A	NONE	B/C	C	-	-
M-16	COMMERCIAL AREA	C	B	E/J	B	8'-0"	-
M-17	COMMERCIAL AREA	C	B	E/J	B	8'-0"	-
FINISH TYPES


TYPE	DESCRIPTION
FLOOR	
A	CONCRETE, HARDENED AND UNPAINTED
B	QUARRY TILE AND BED, 2" THICK
C	VINYL ASBESTOS TILE FLOOR COVERING
D	CERAMIC TILE AND BED, 2" THICK
E	
F	CONCRETE, HARDENED AND PAINTED
BASE	
A	QUARRY COVE, 6" HIGH
B	VINYL COVE, 4" HIGH
C	CERAMIC COVE
D	VINYL, 6" HIGH
WALL	
A	VINYL WALL COVERING ON 5/8" PLASTER ON G.C.M.U. AND/OR CONCRETE
B	EXPOSED CONCRETE CONSTRUCTION, PAINTED
C	G.C.M.U., PAINTED
D	1" CERAMIC TILE AND SETTING BED ON G.C.M.U. AND/OR CONCRETE
E	5/8" PLASTER ON G.C.M.U. AND/OR CONCRETE, PAINTED
F	EXPOSED CONCRETE CONSTRUCTION, UNPAINTED
G	G.C.M.U., UNPAINTED
H	G.C.M.U., EPOXY FINISH
I	EXPOSED CONCRETE CONSTRUCTION, EPOXY FINISH
J	GLASS IN METAL FRAME
CEILING	
A	SUSPENDED 3/4" GYP. PLASTER AND METAL LATH ON 3/4" CHANNELS 16" C/C AND 1/2" CHANNELS 4'-0" C/C, PAINTED
B	SUSPENDED EXPOSED TEE AND LAY-IN 3' X 3' ACOUSTICAL TILE SYSTEM - SEE ELECTRICAL DWGS FOR TEE SPACING
C	EXPOSED CONCRETE CON

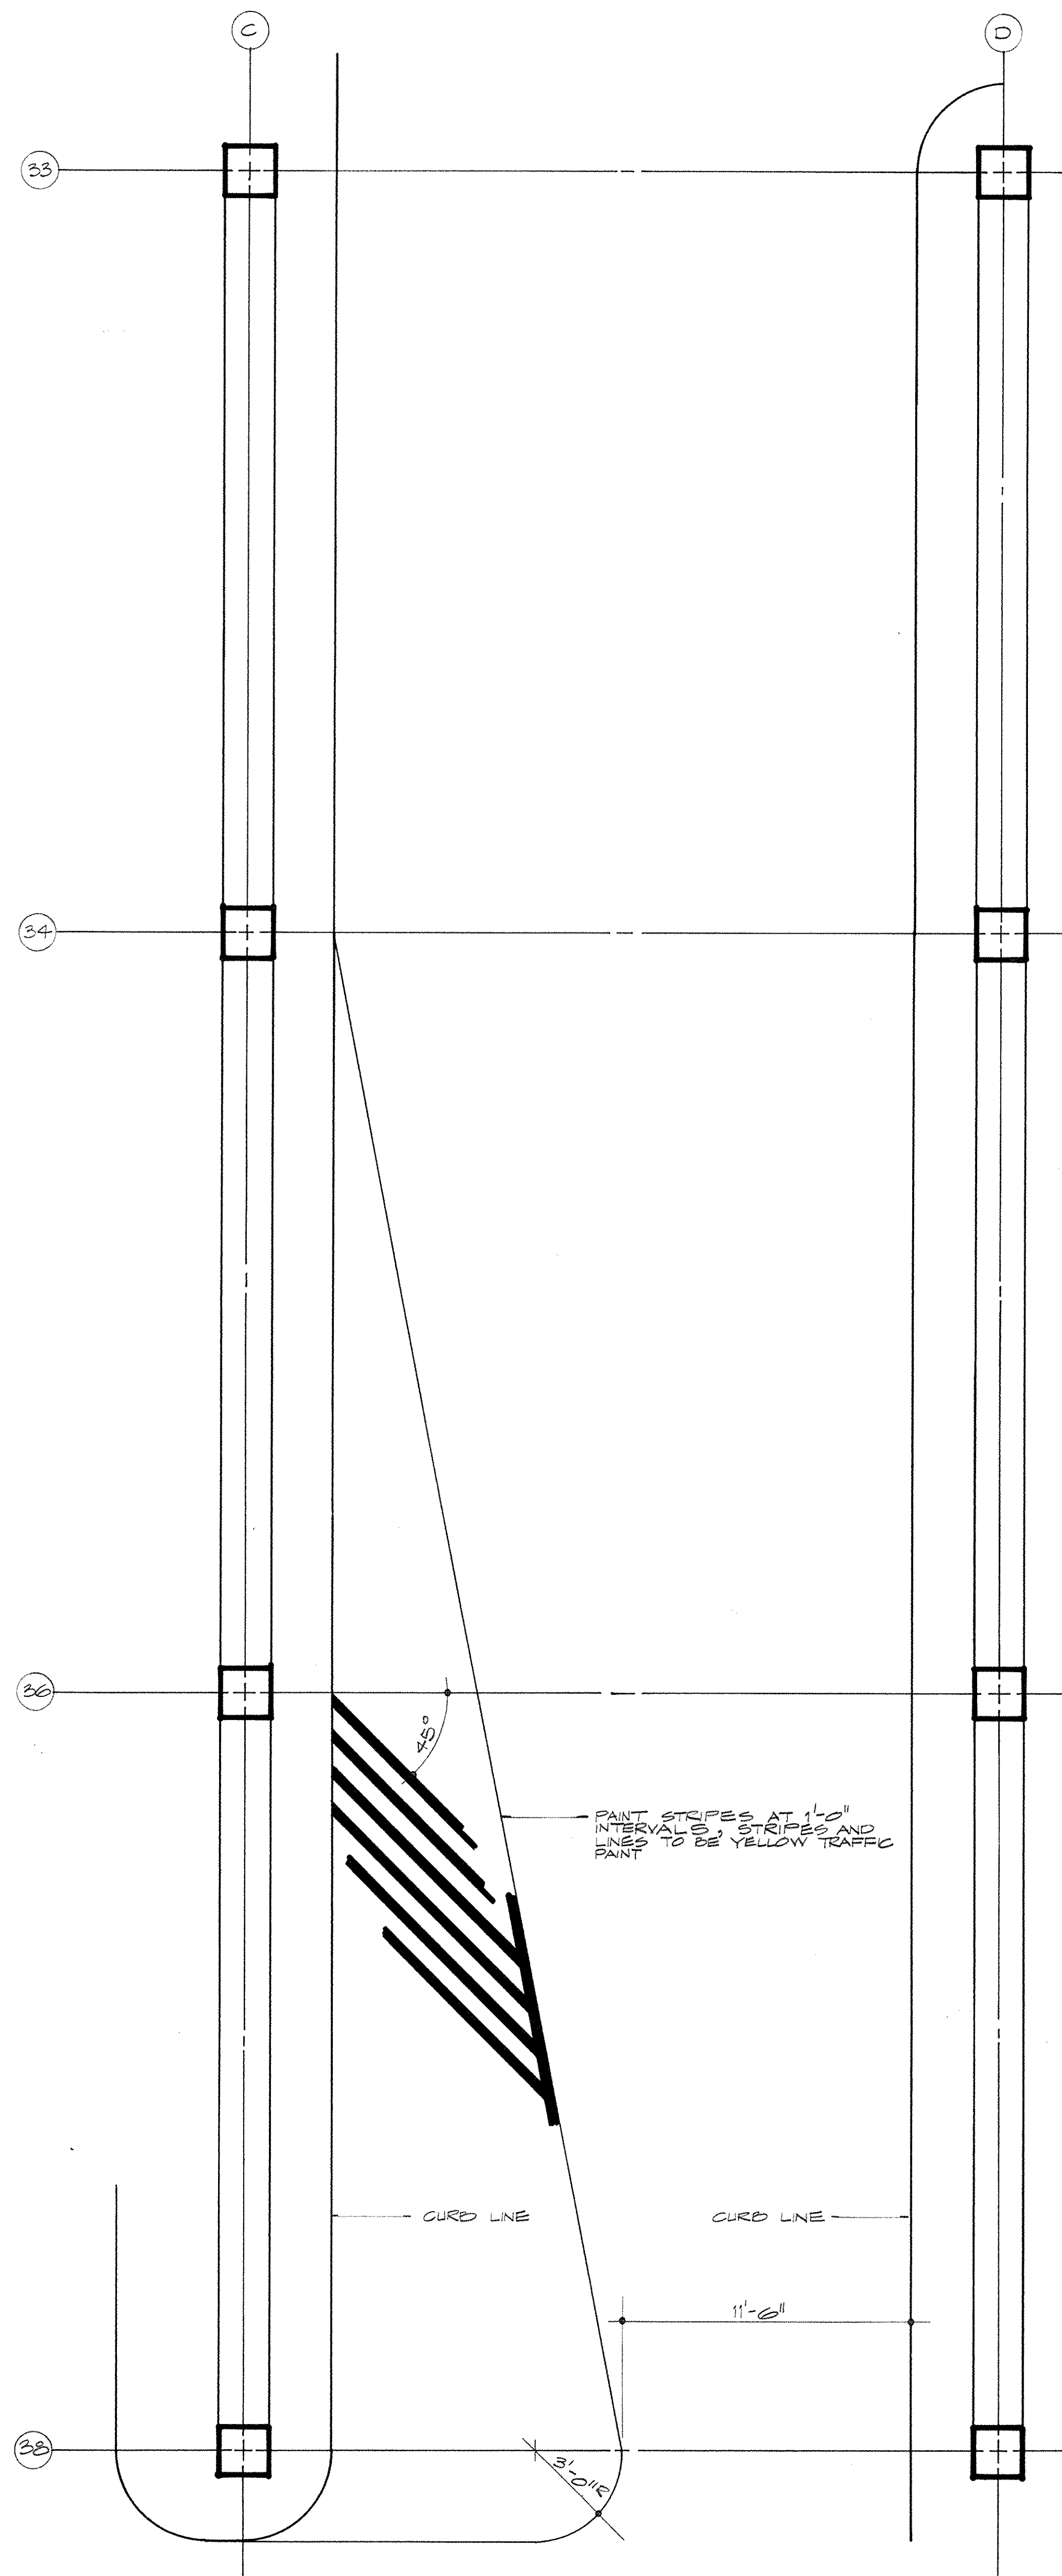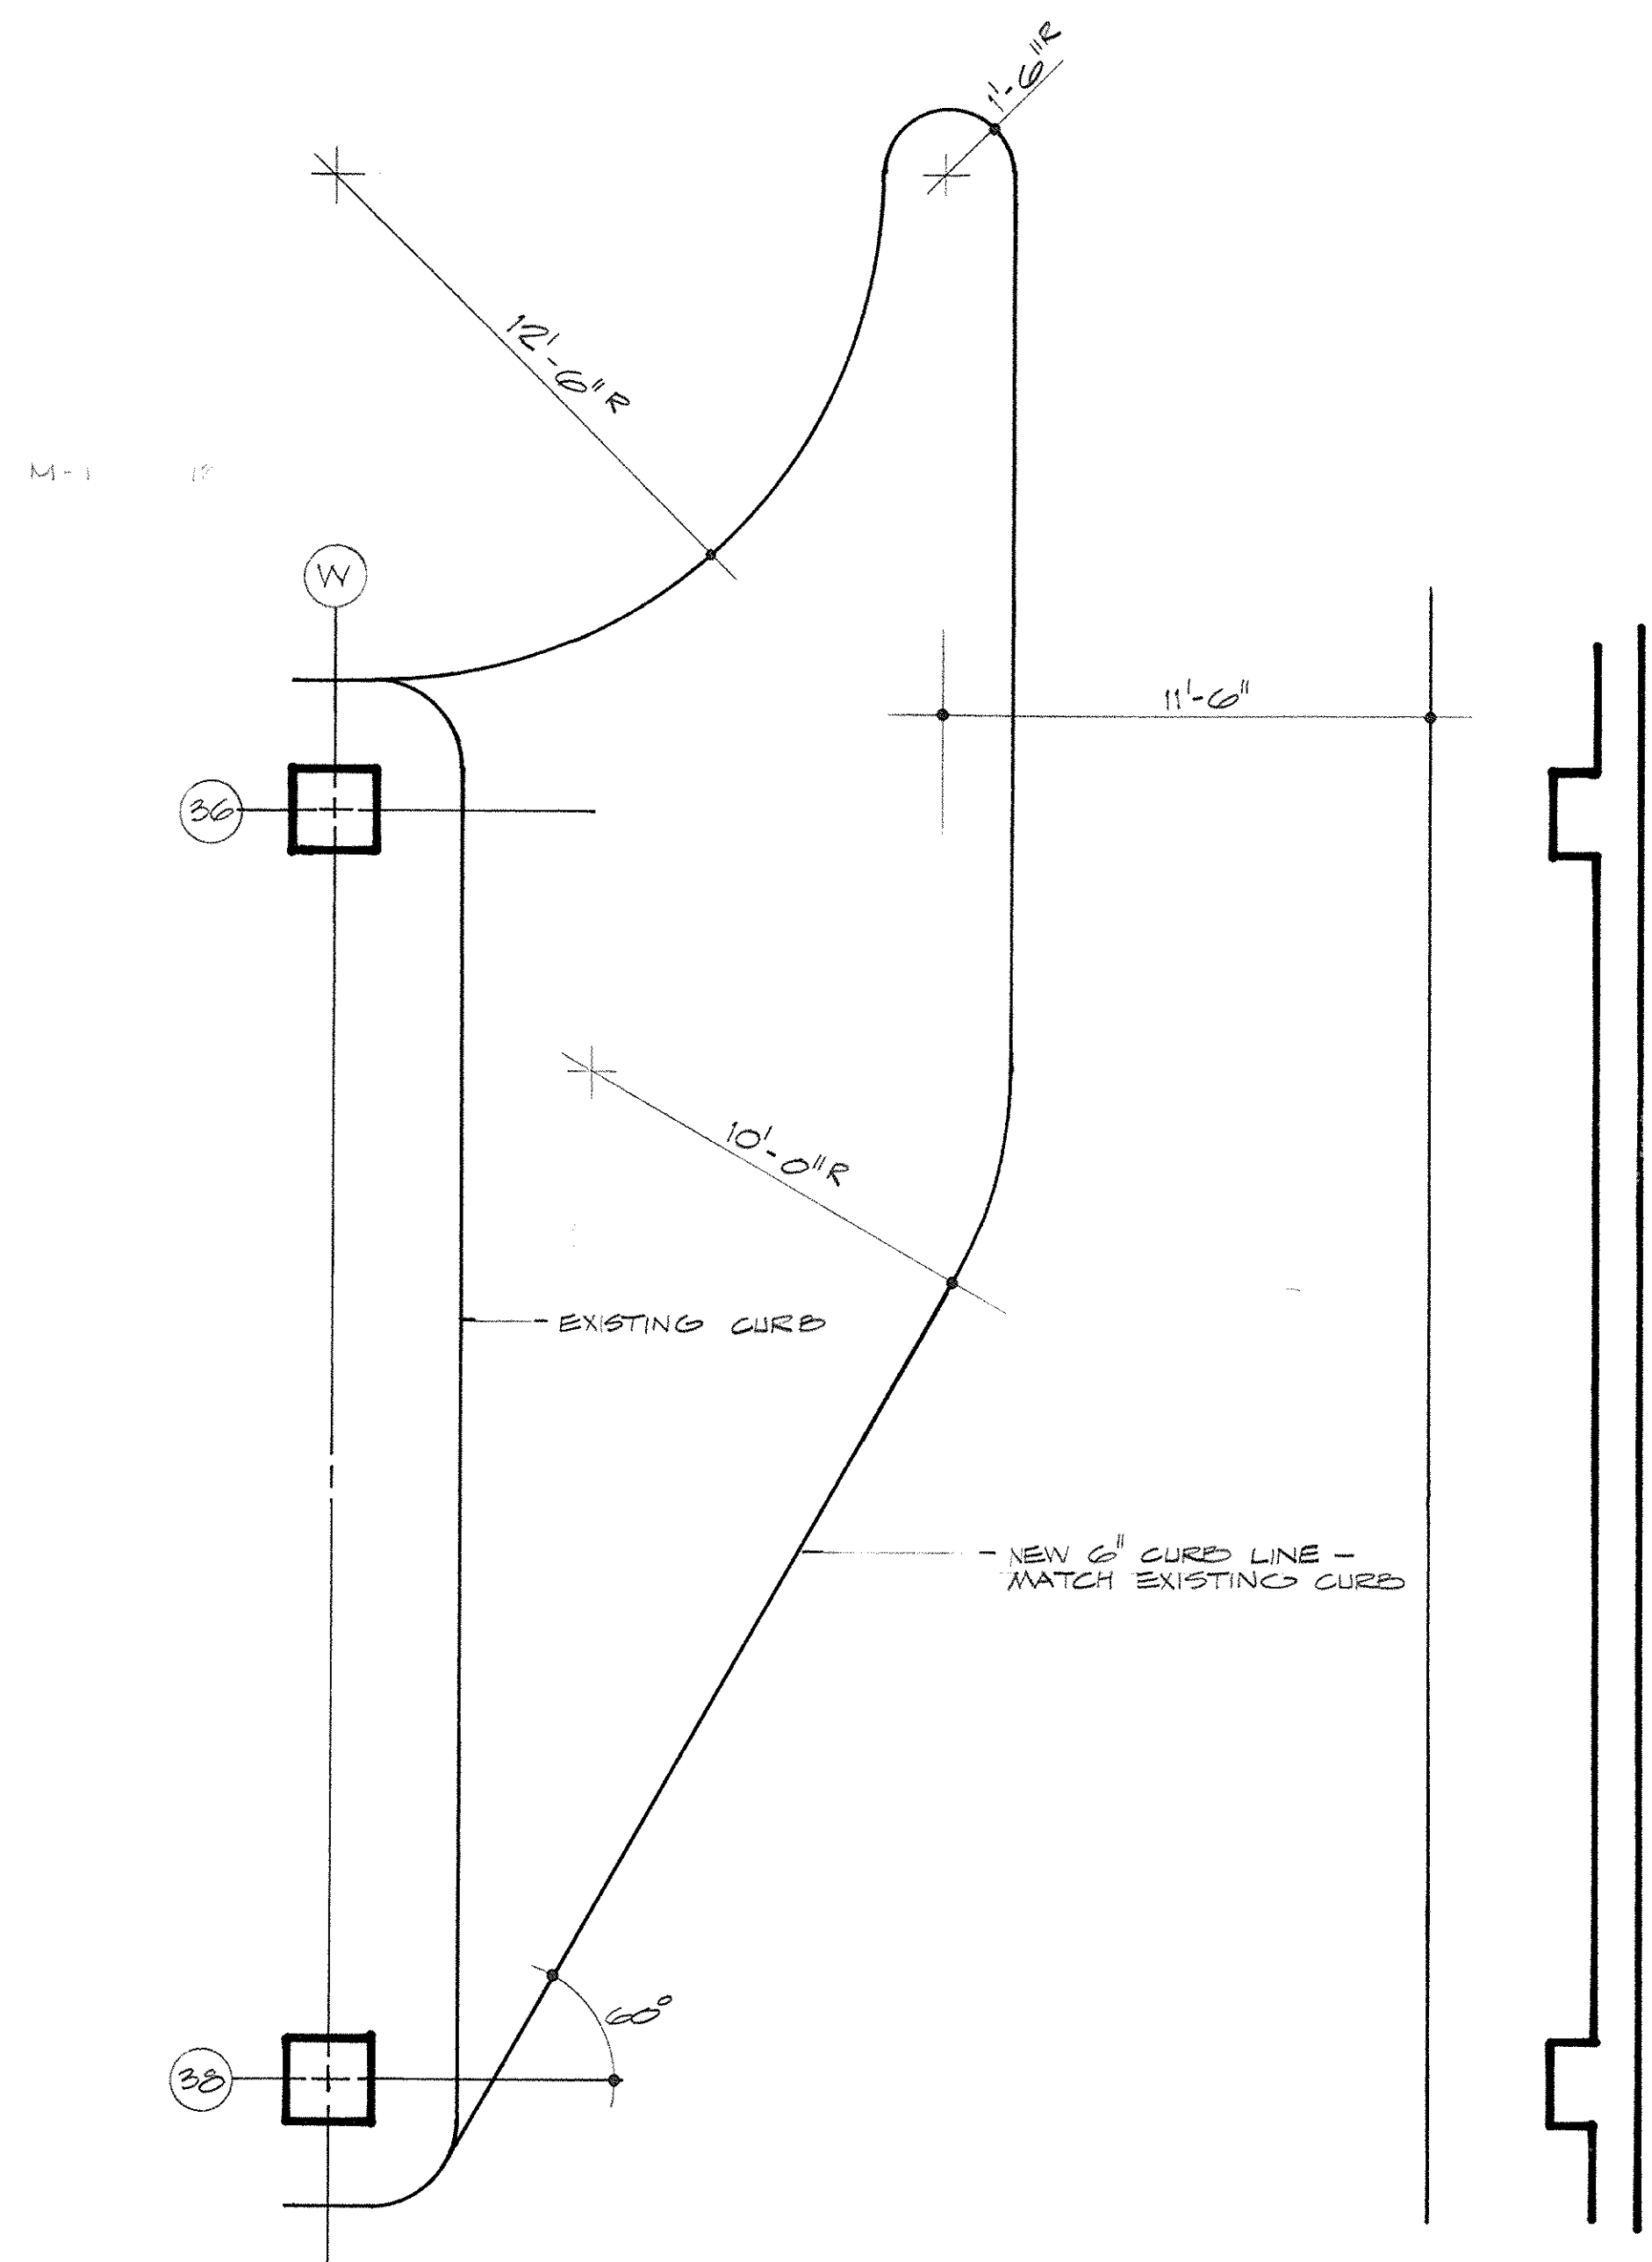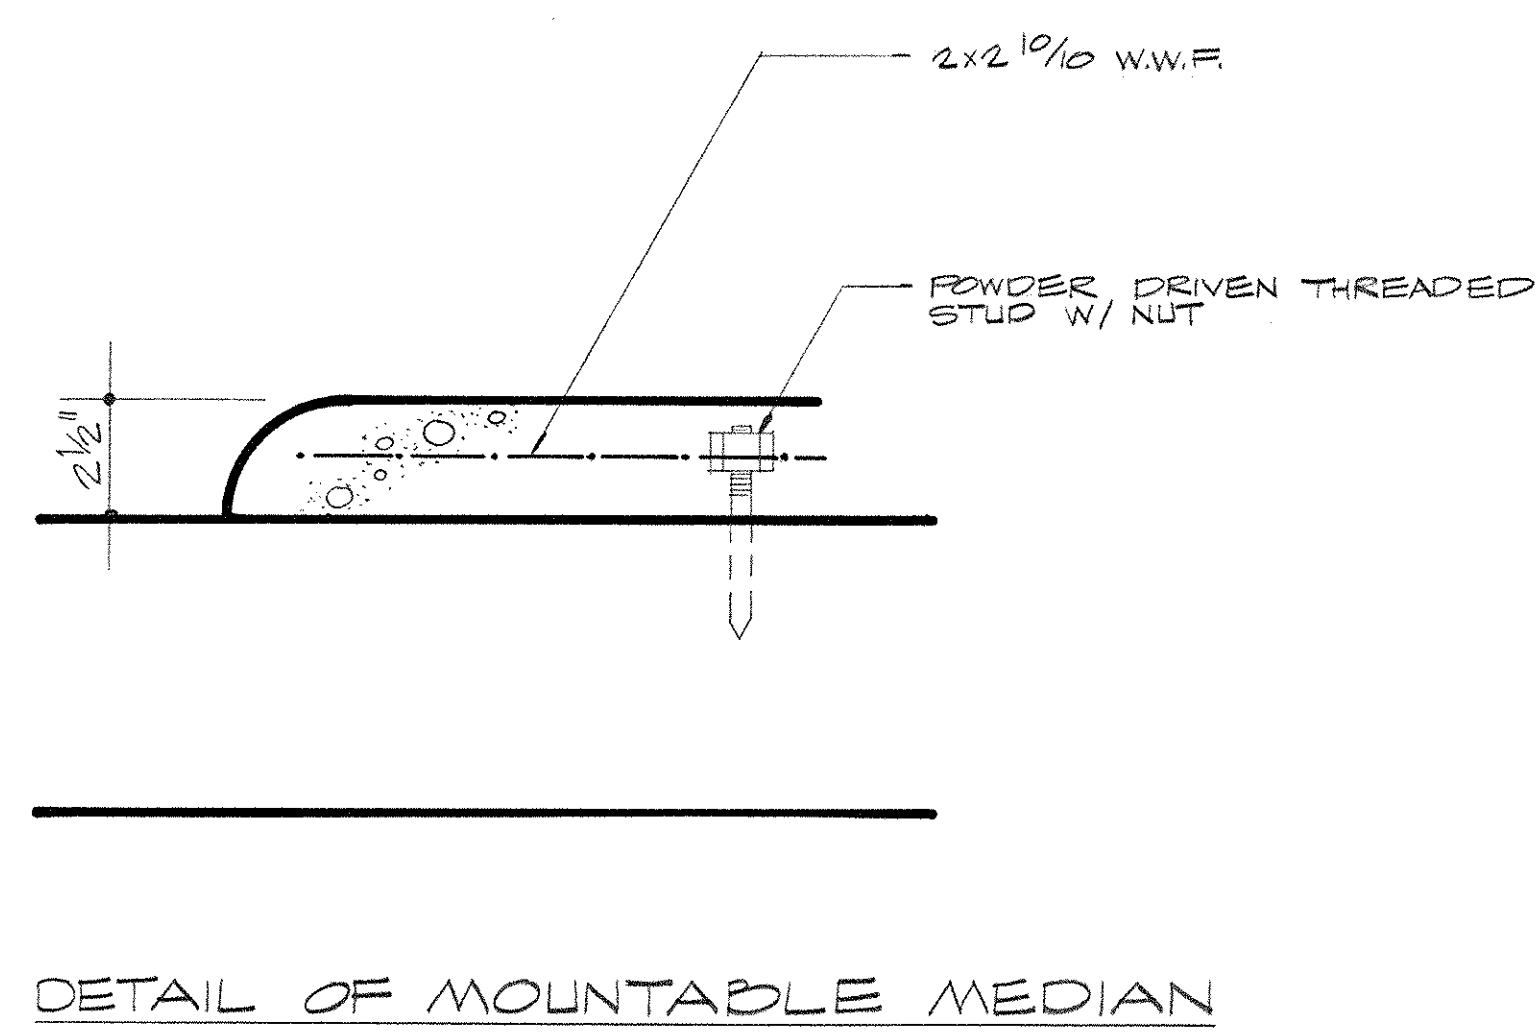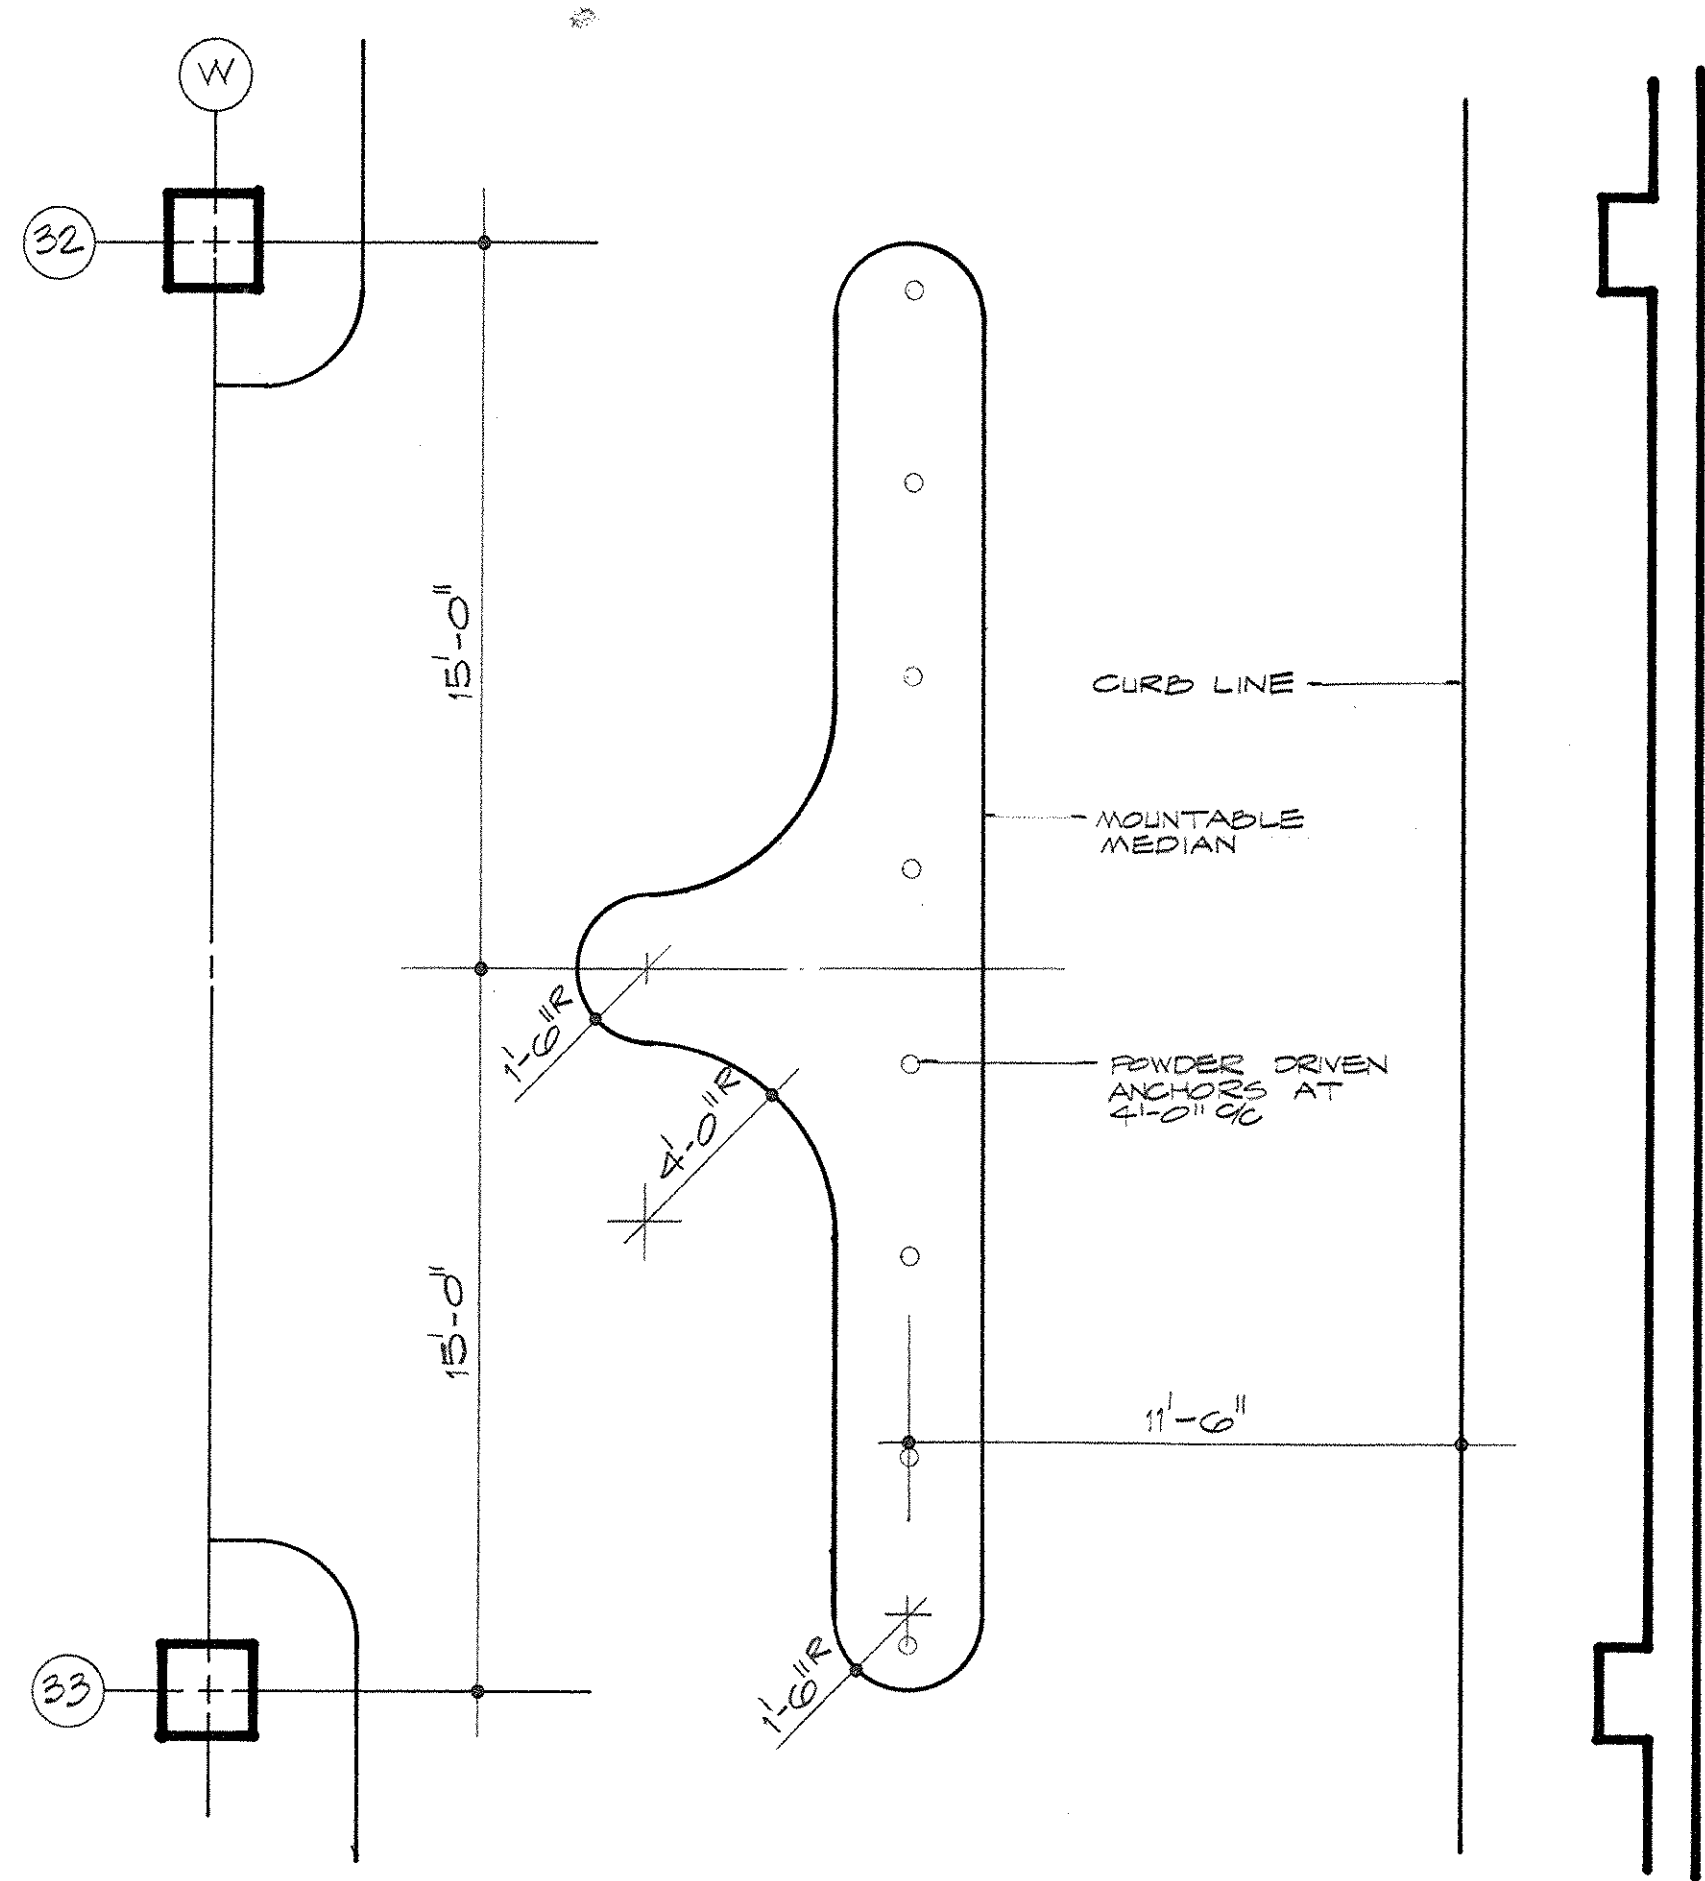


CHANGE ORDER #27 ITEM #1

TRAFFIC CONTROLS PARKING STRUCTURE SOUTH OF CLINTON		DATE FEB 1 1972
CAPITAL PLAZA DEVELOPMENT PHASE II FRANKFORT, KENTUCKY		COMM. NO.
HUGG, CARTER & BLAKEMAN ARCHITECTS 314 WILKINSON STREET FRANKFORT, KENTUCKY		DRAWING NO.
COMMONWEALTH OF KENTUCKY DEPARTMENT OF FINANCE - DIVISION OF ENGINEERING FRANKFORT KENTUCKY		OF
APPROVED BY AGENCY HEAD	DATE	
APPROVED BY OWNER	DATE	

244-327A

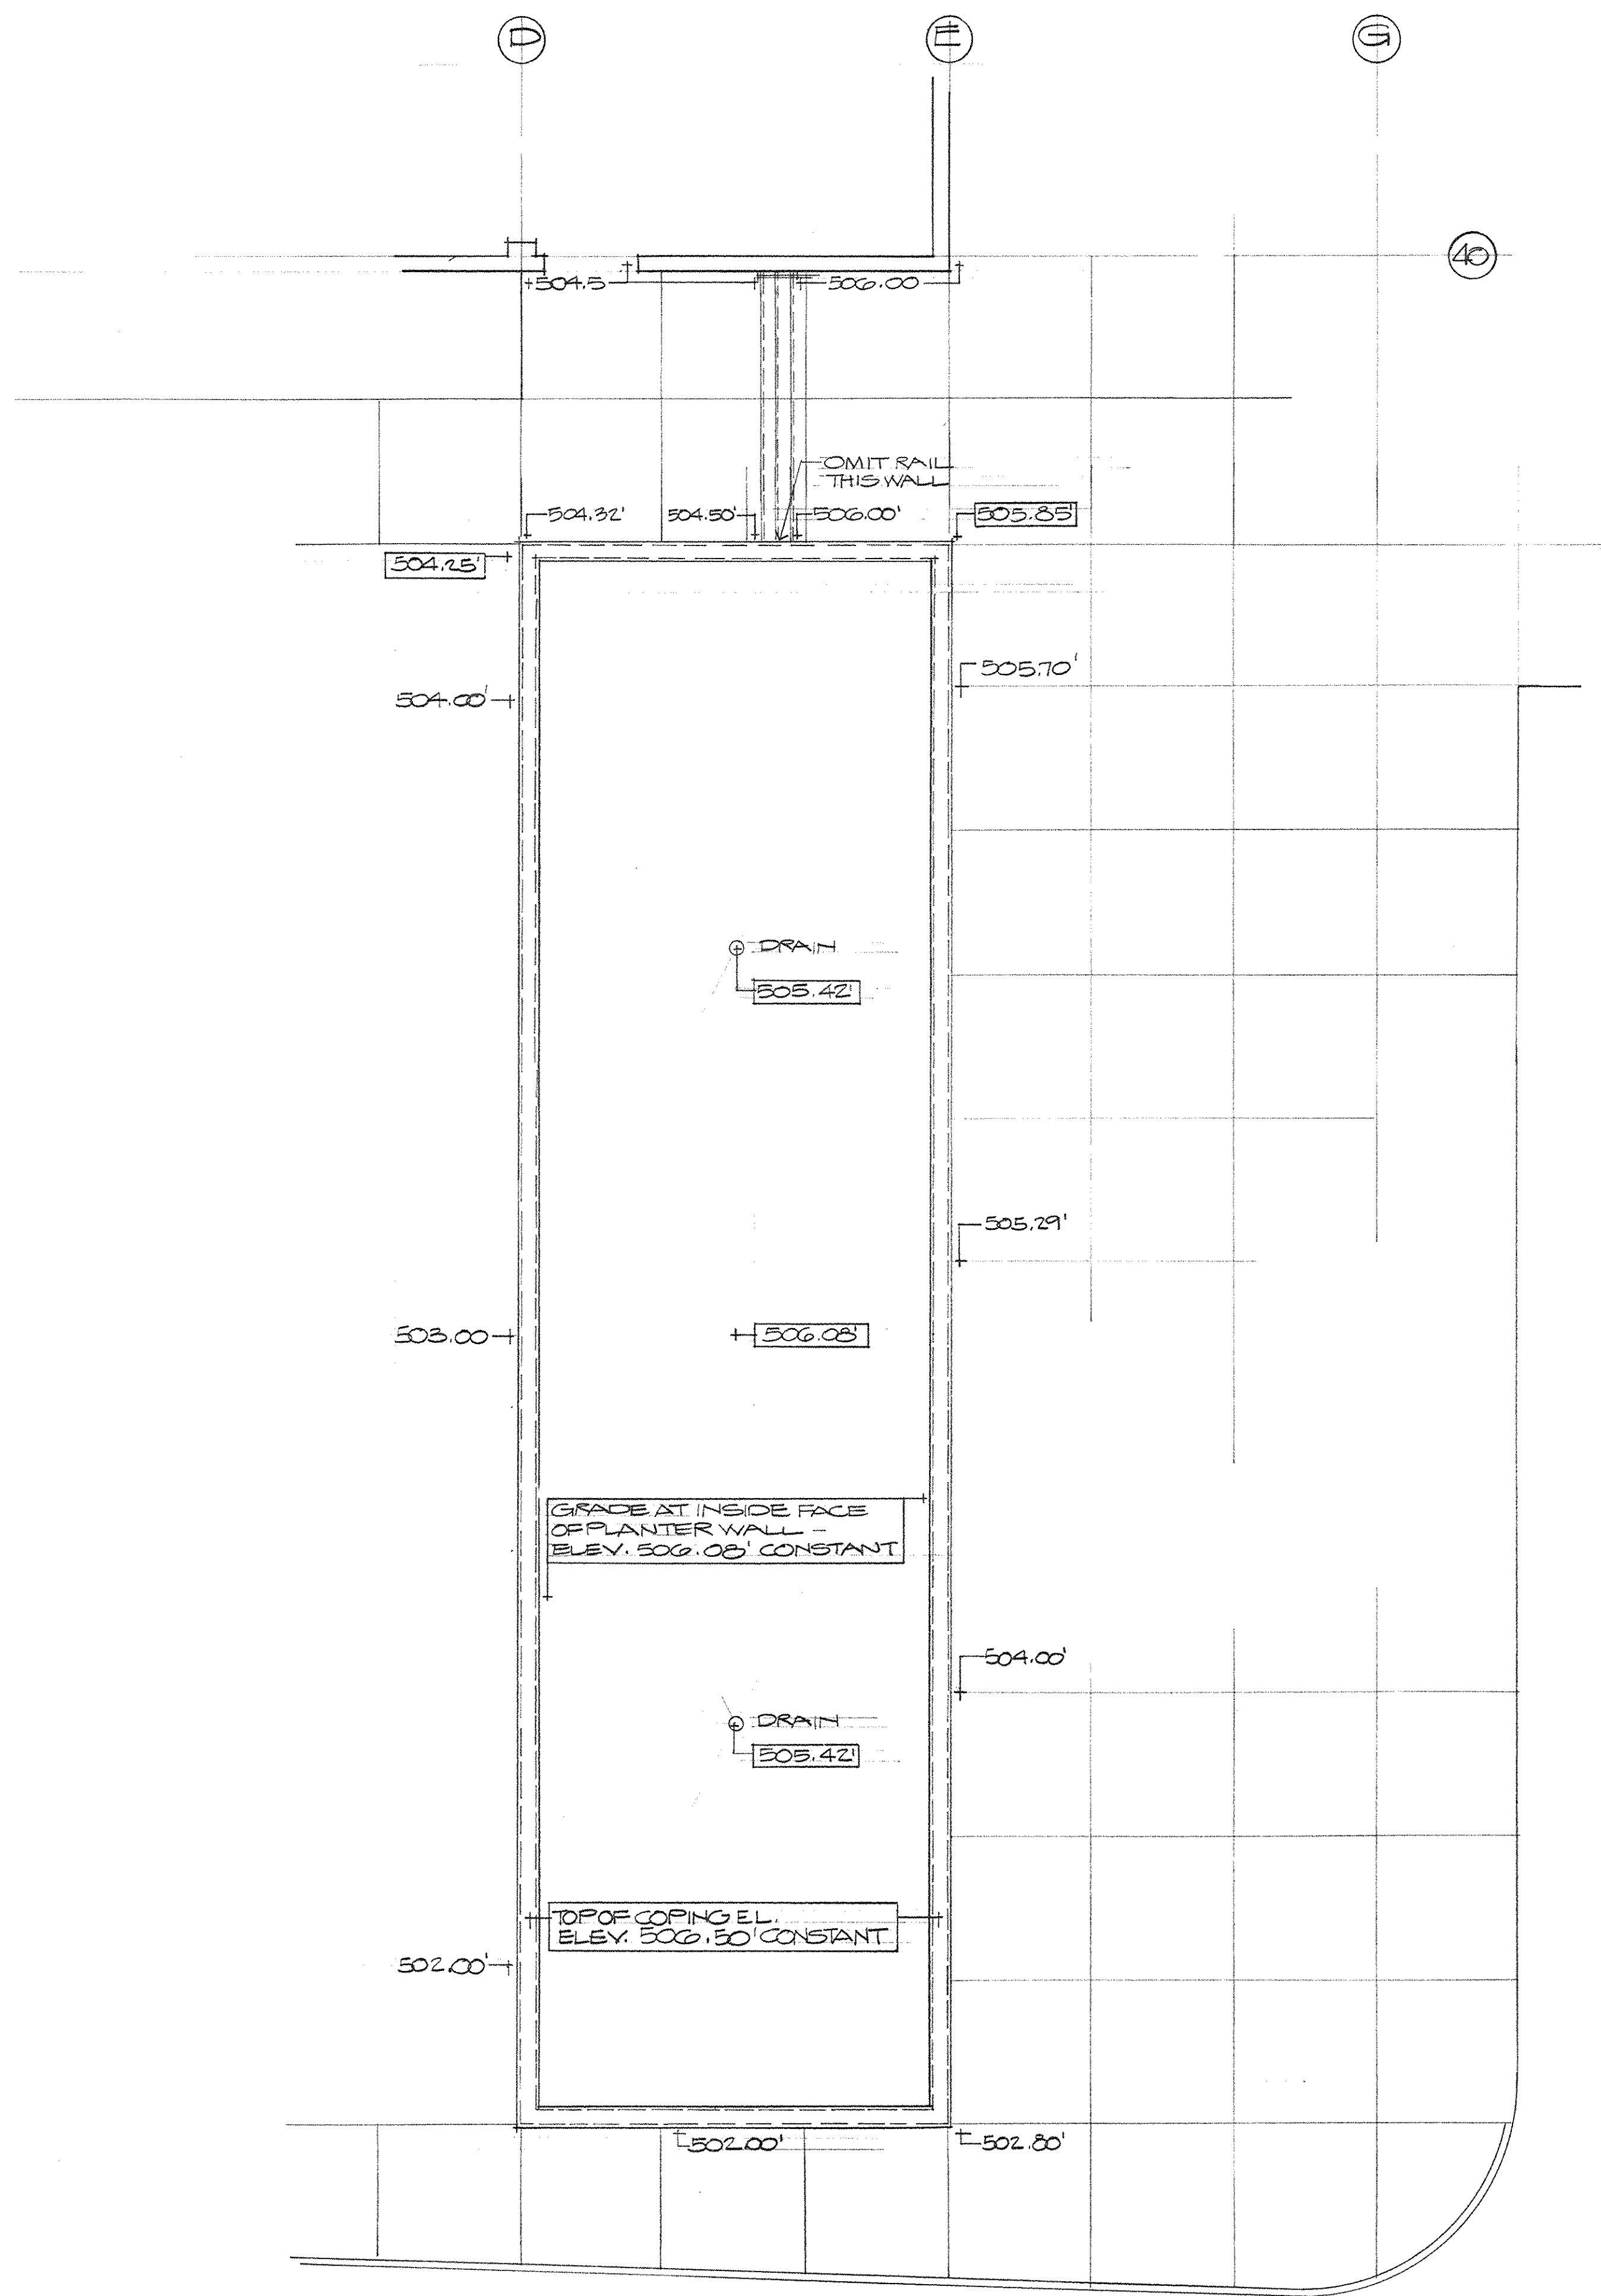


PLANTER AT SECTOR D8
SCALE 1/8" = 1'-0"

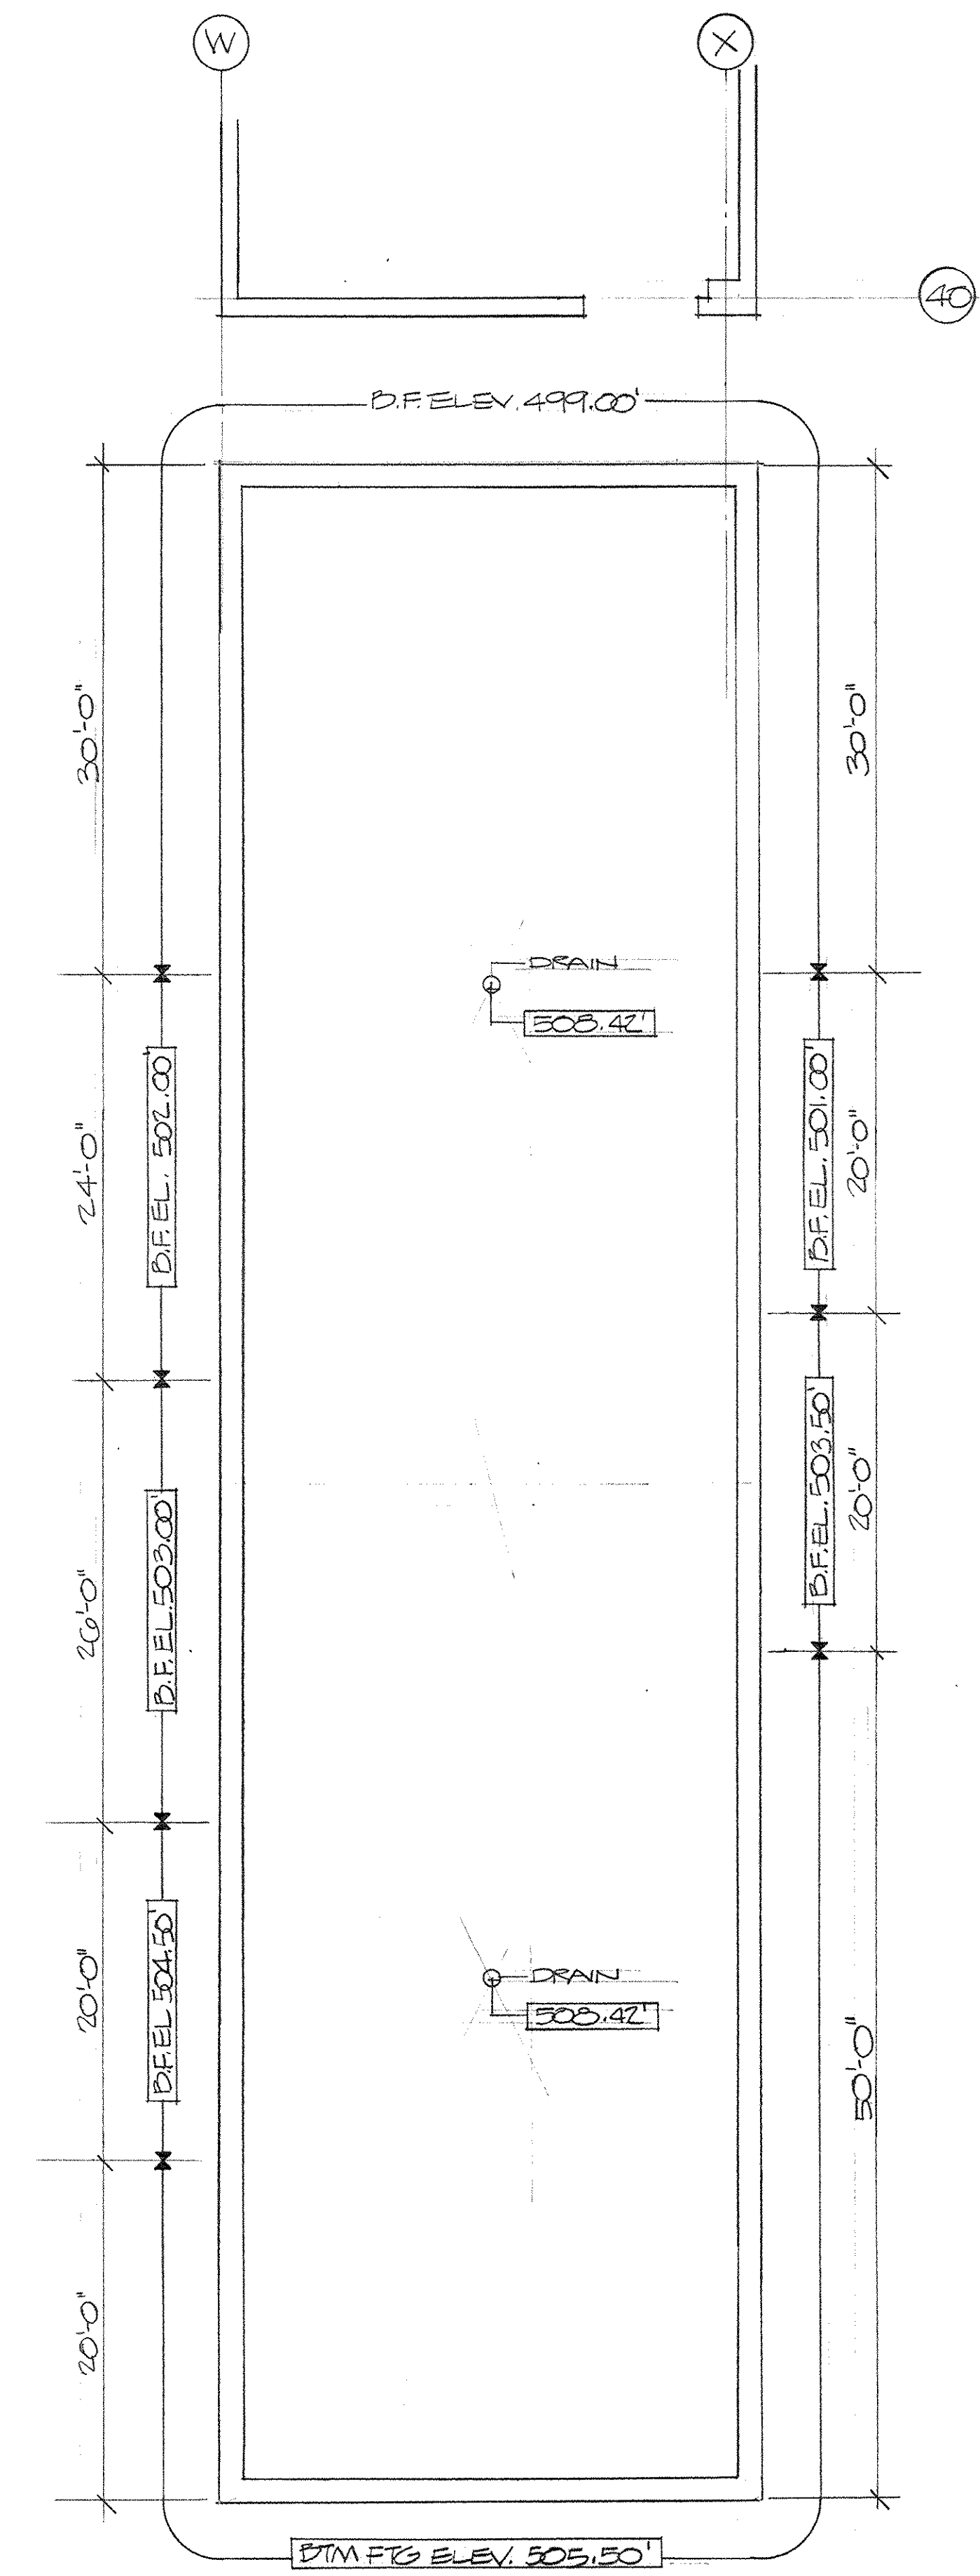

PLANTER AT SECTOR C8
SCALE 1/8" = 1'-0"




LEGEND	
500.00'	ORIGINAL CONTRACT FINISH SPOT ELEV.
500.00'	REVISED FINISH SPOT ELEVATION

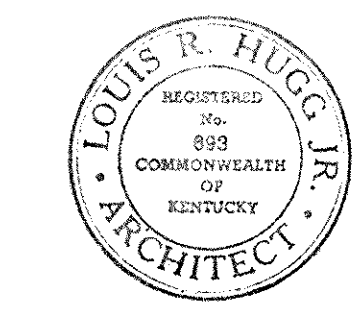


CHANGE ORDER NO. 22 ITEM NO. 1		
CAPITAL PLAZA DEVELOPMENT PHASE II FRANKFORT, KENTUCKY		
DRAWN BY	REVISED PLANTER GRADES	DATE 3/20/11
CHECKED BY		COMM. NO. 50367
SECTOR NO.	LEE POTTER SMITH, PRITCHETT, HUGG & CARTER ARCHITECTS ENGINEERS 314 WILKINSON STREET FRANKFORT, KENTUCKY	DRAWING NO. 1
B8-C8	COMMONWEALTH OF KENTUCKY DEPARTMENT OF FINANCE - DIVISION OF ENGINEERING FRANKFORT KENTUCKY	OF ONE
APPROVED BY	AGENCY HEAD	DATE
APPROVED BY	OWNER	DATE

FRAME TYPES

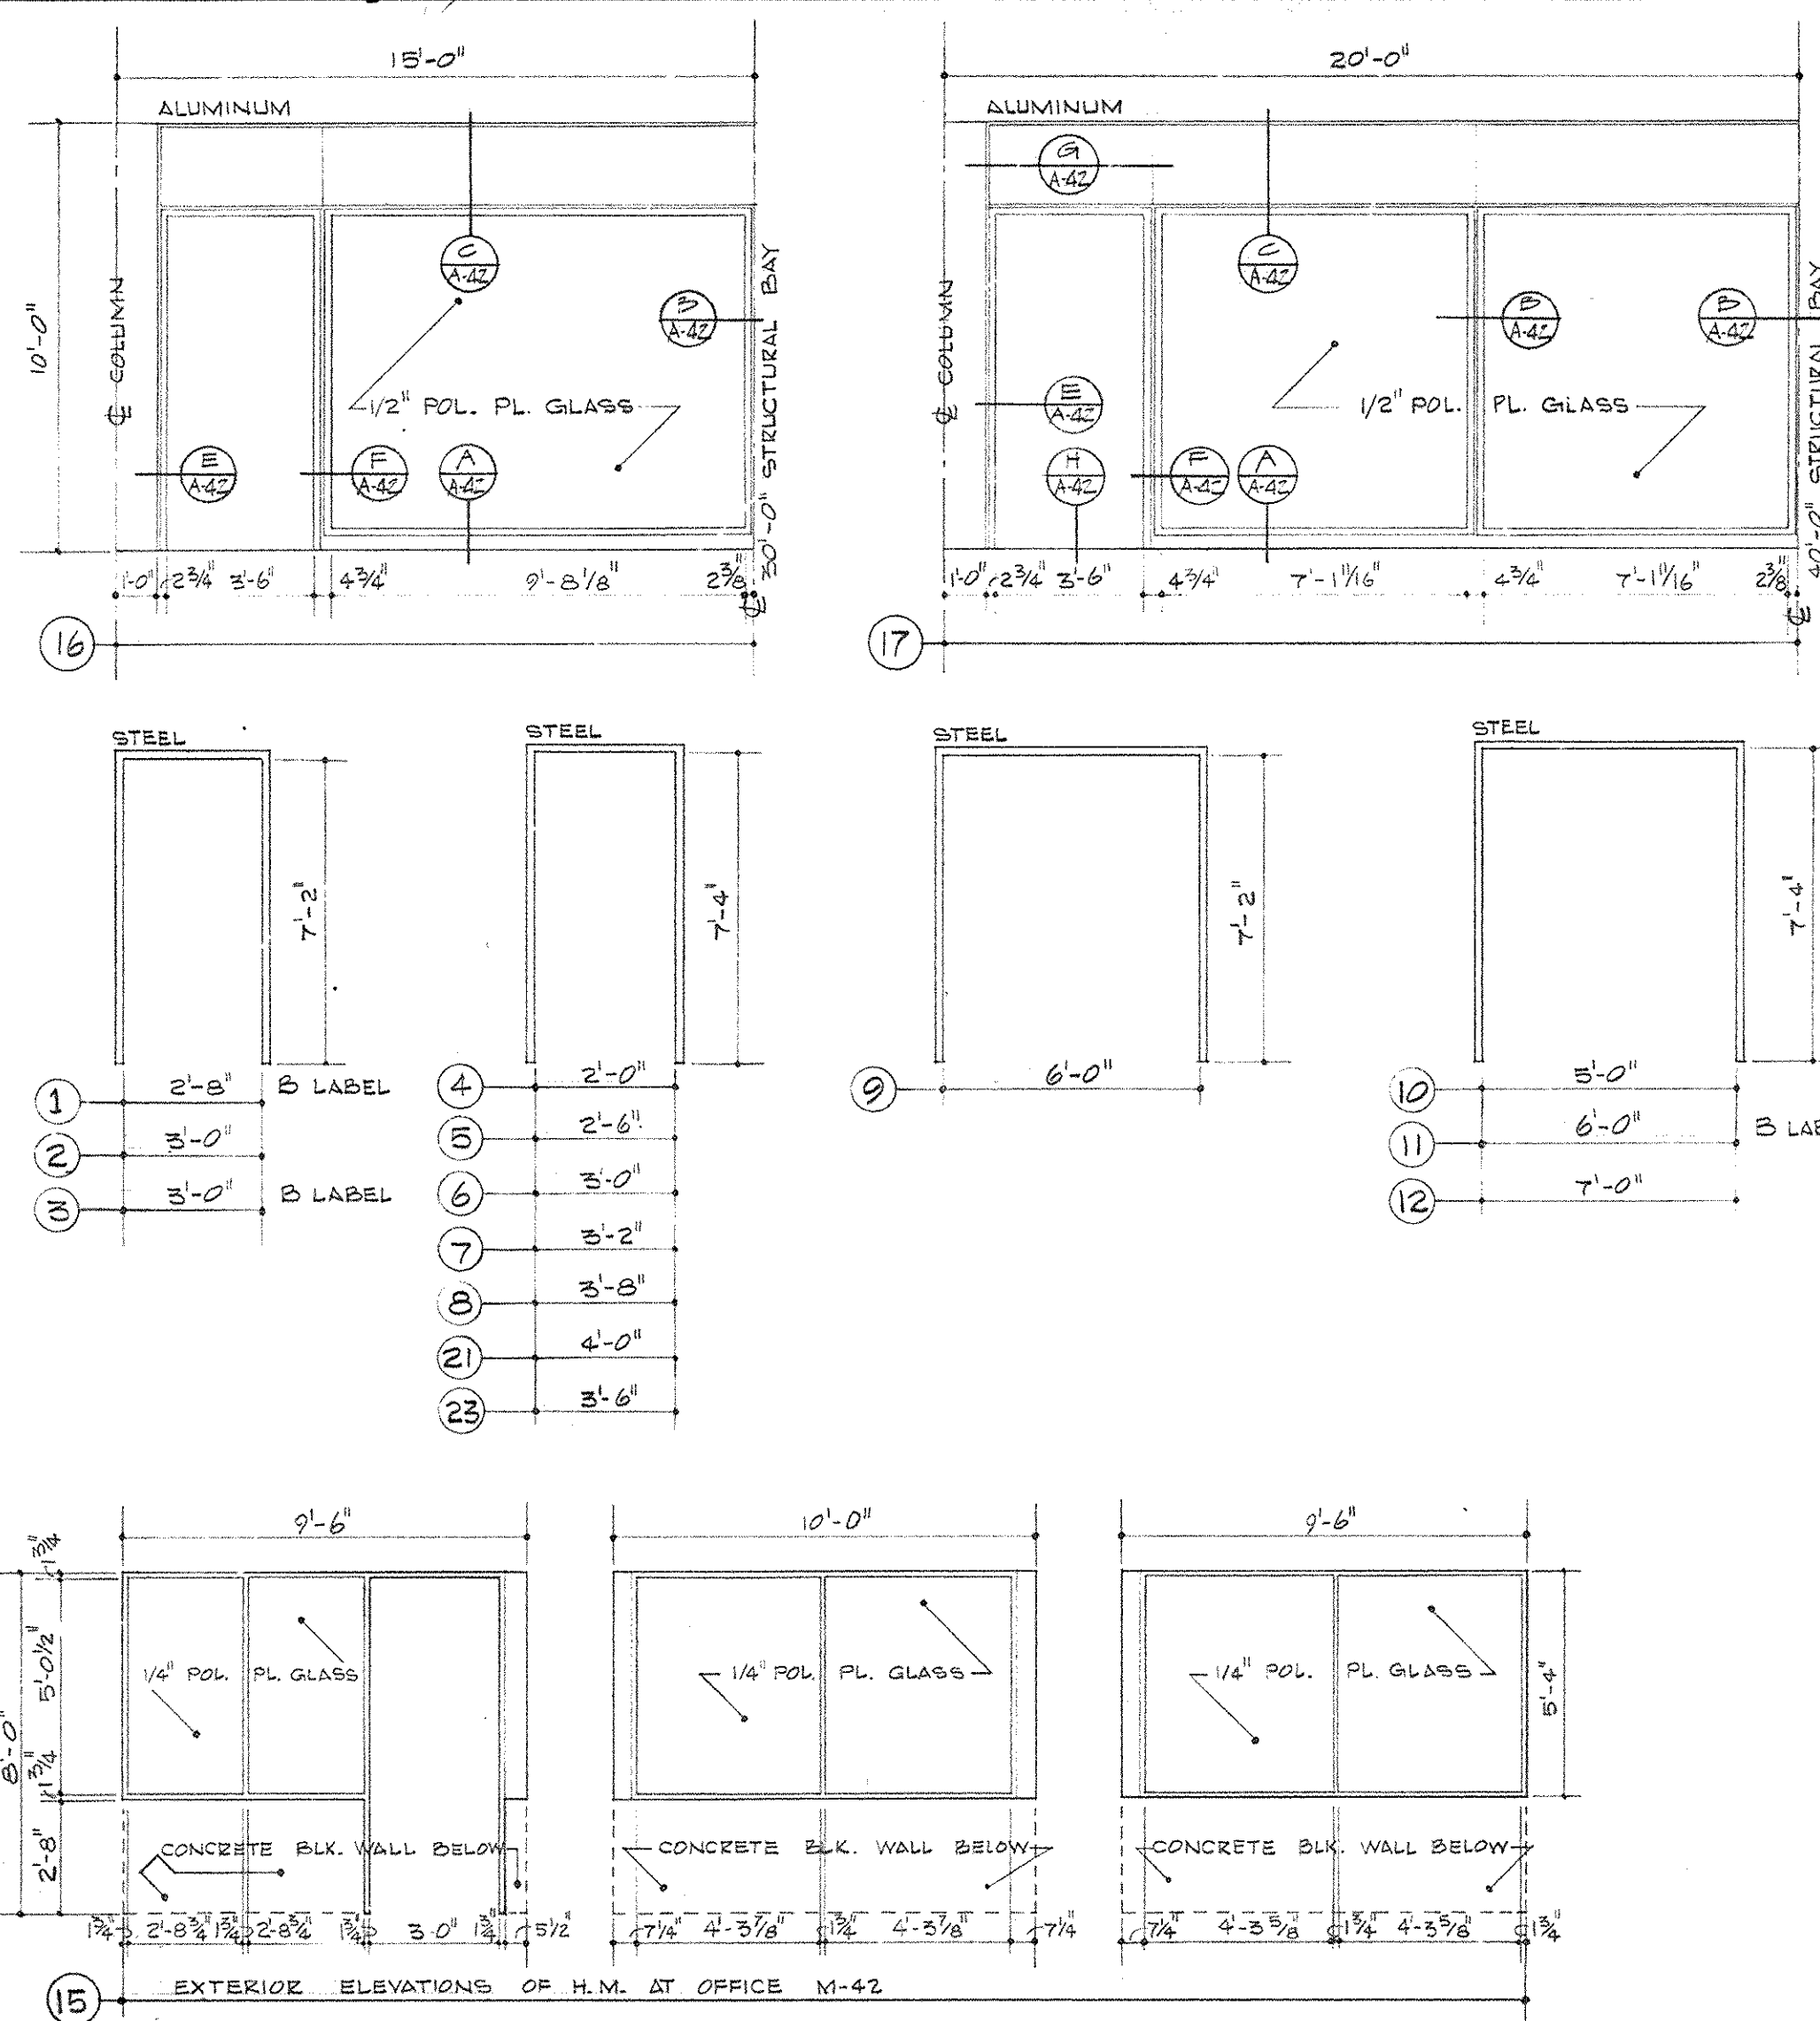

DOOR TYPES

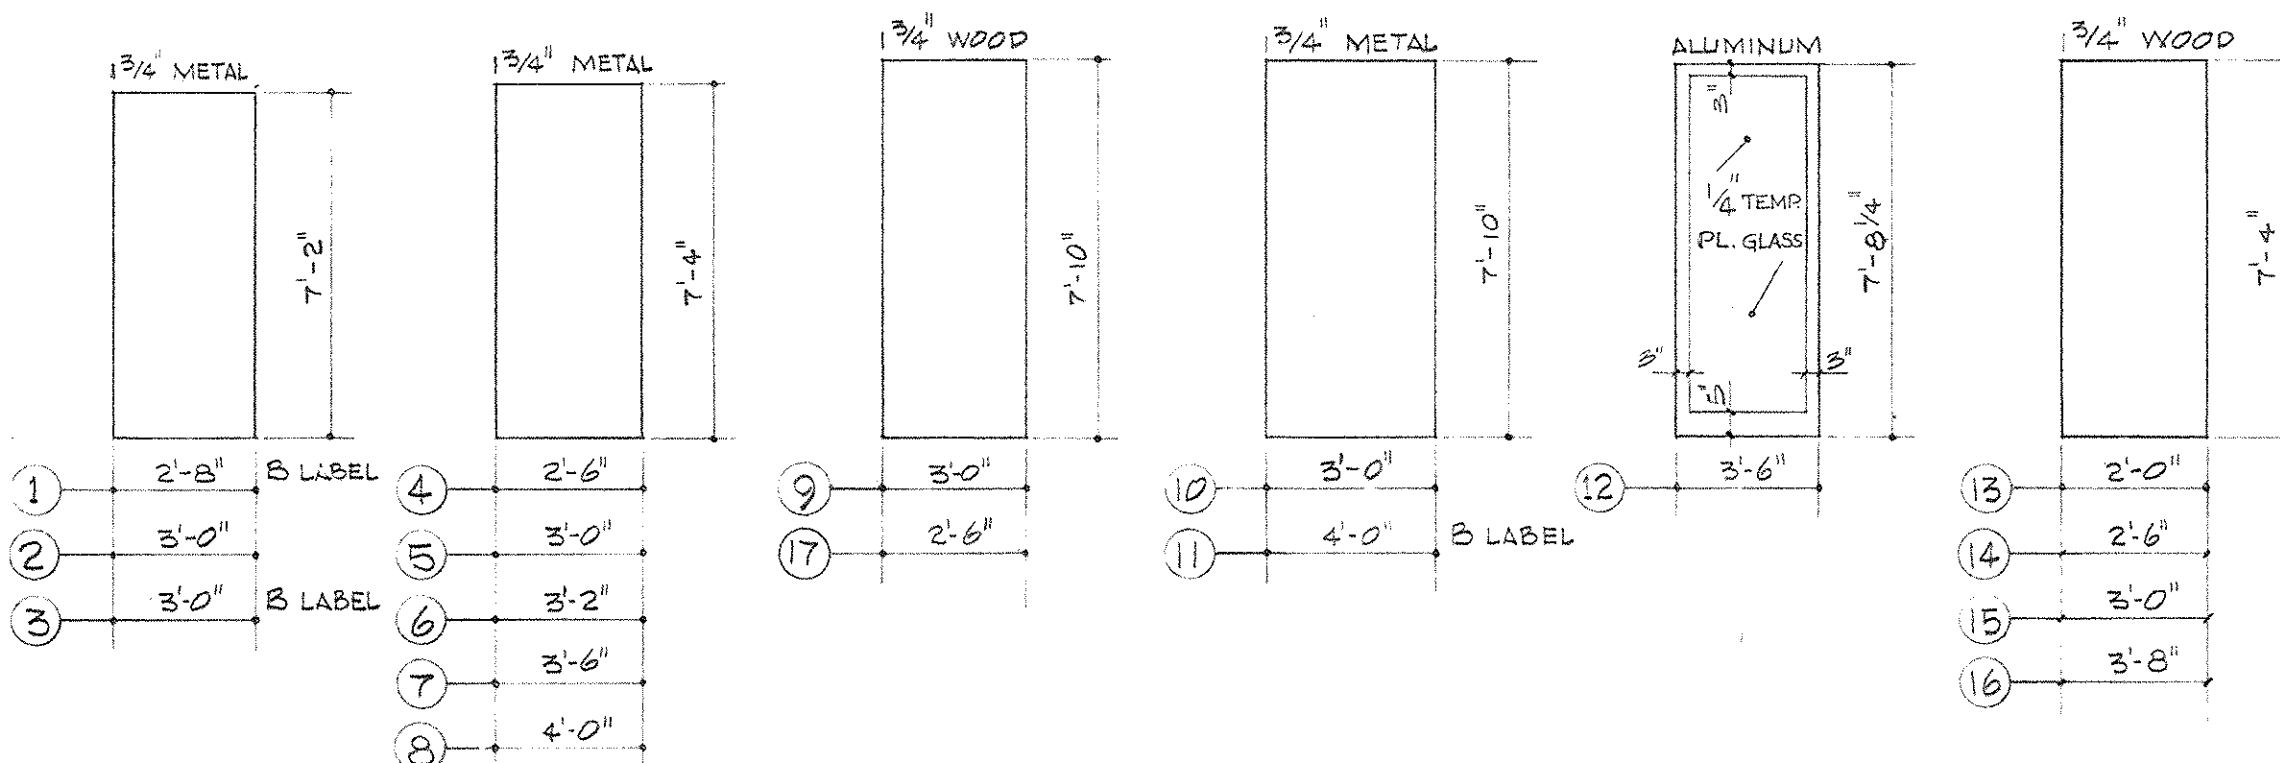


HARDWARE TYPES

HARDWARE	1	2	3	4	5	6	7	8	9	10	11	12	13	14	15	16	17	18	19	20
1	8648																			
2	8648																			
3	8232																			
4	8648	B		2	3															
5	8648	B		1	1/2															
6																				
7	8648				1/2															
8	8648			2	4															
9	8648			1	1/2															
10	8648			2	3															
11	8661			1	1/2															
12	8676				2															
13					1/2															
14					2															
15	8648				1	2														
16					1/2															
17																				
18																				
19																				
20																				

LINTEL TYPES


TYPE	DESCRIPTION
1	3/8\"/>
2	3/8\"/>
3	2-L'S 3/2\"/>
4	2-L'S 5\"/>
5	

FRAME PROFILES

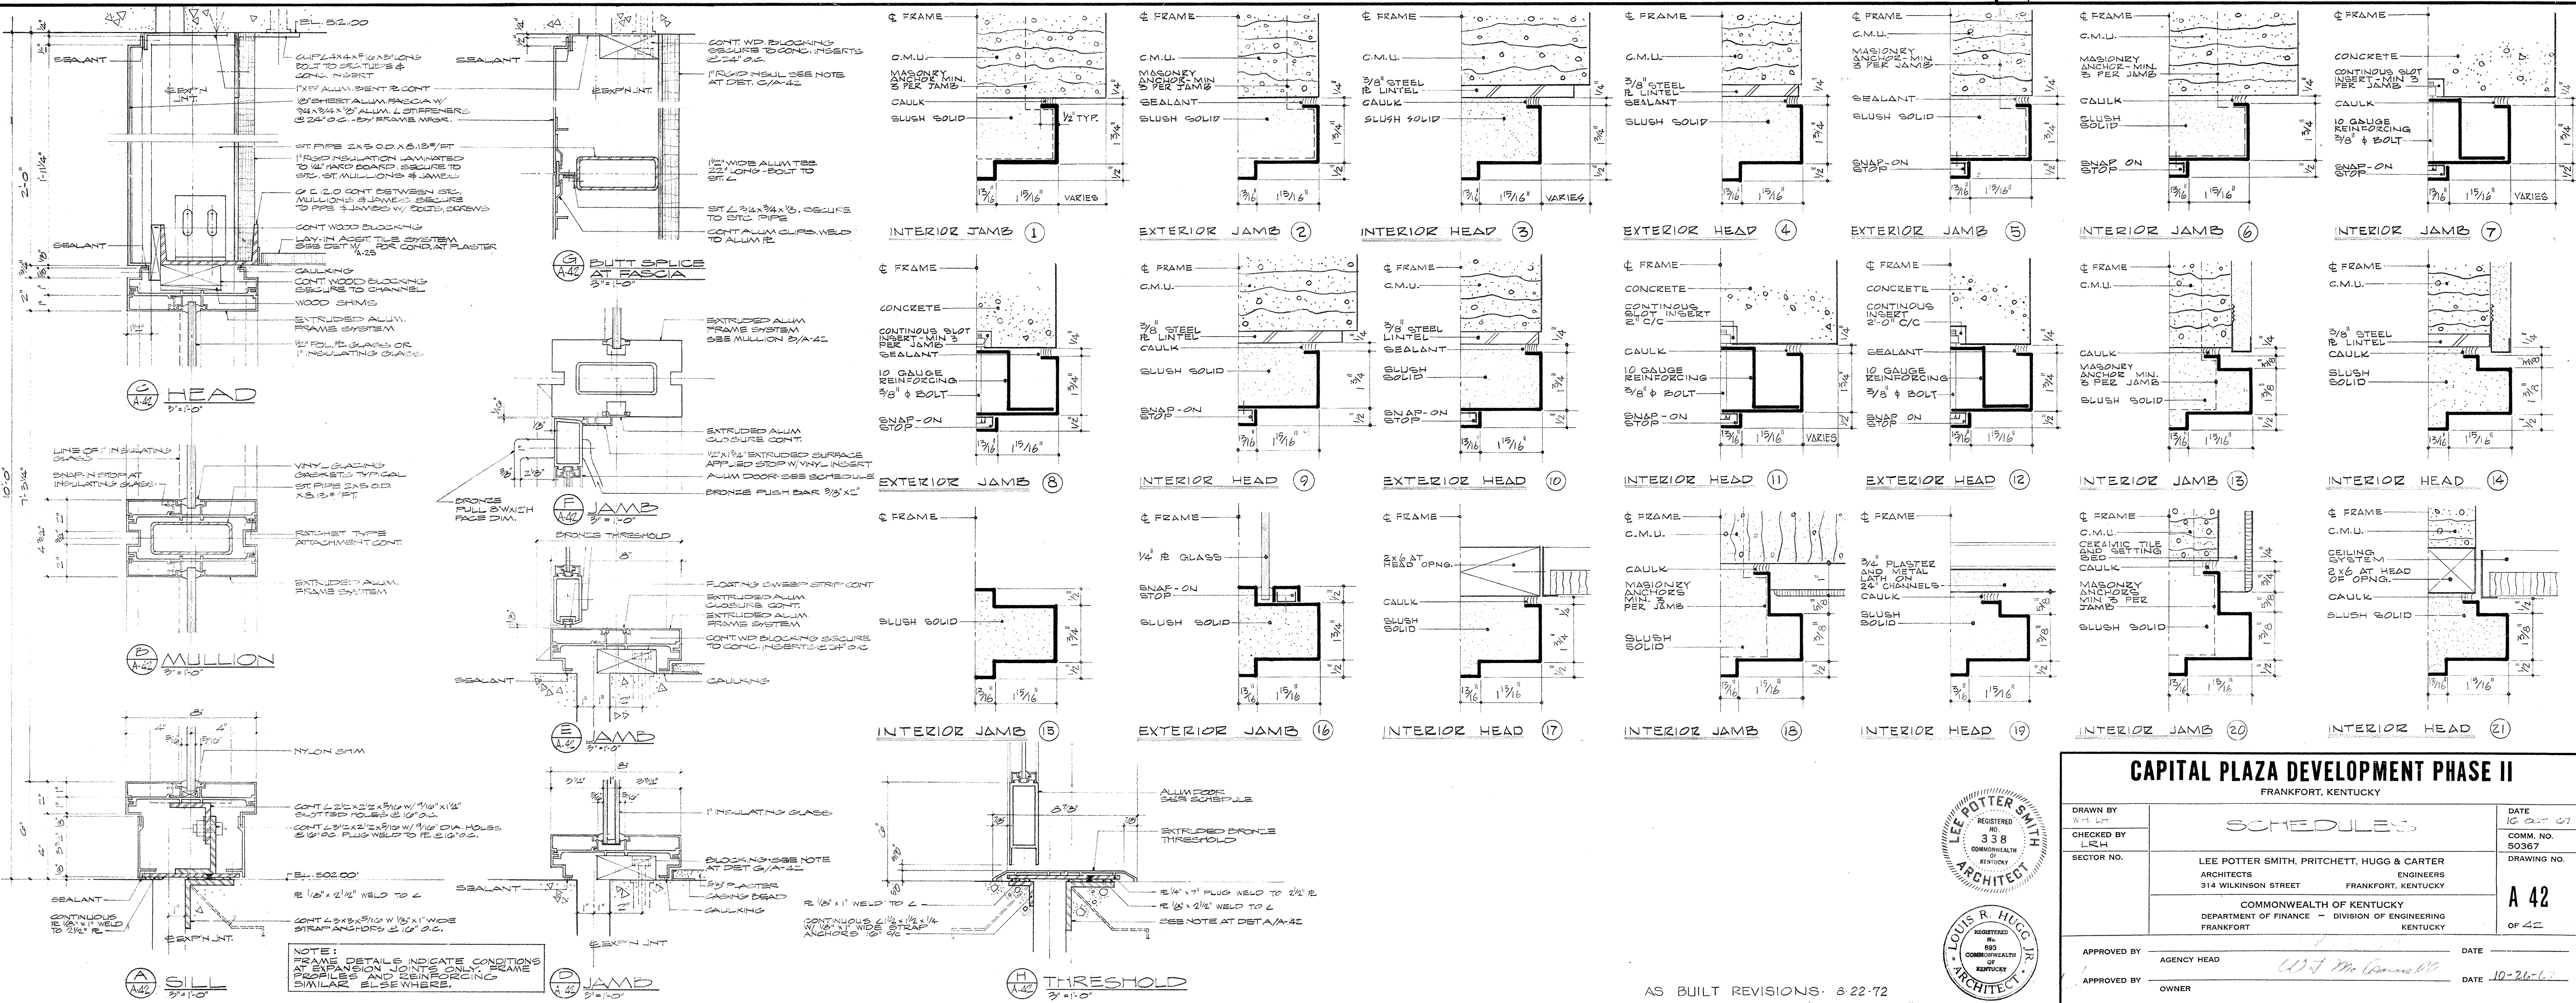

CAPITAL PLAZA DEVELOPMENT PHASE II

FRANKFORT, KENTUCKY		DATE	12-21-67
SCHEDULES		COMM. NO.	50367
ARCHITECTS		ENGINEERS	
LEE POTTER SMITH, PRITCHETT, HUGG & CARTER		FRANKFORT, KENTUCKY	
314 WILKINSON STREET		COMMONWEALTH OF KENTUCKY	
DEPARTMENT OF FINANCE - DIVISION OF ENGINEERING		FRANKFORT, KENTUCKY	
APPROVED BY	AGENCY HEAD	DATE	10-26-67
APPROVED BY	OWNER		

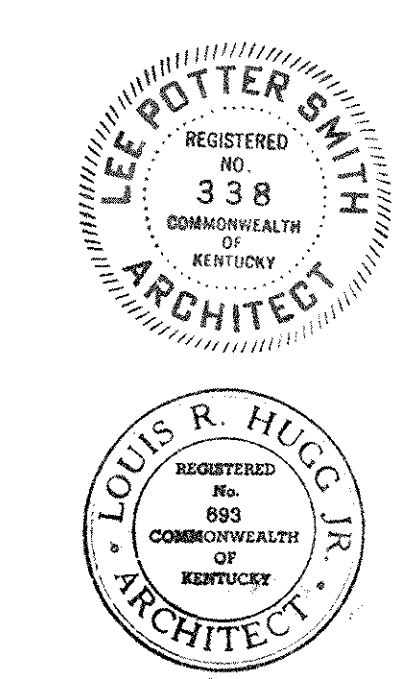

AS BUILT REVISIONS: 8-22-72