

OFFICE DWG NO	ARCH DWG NO	BLD'G SECTOR	NAME OF BUILDING	TITLE OF DRAWING	BRANCH OF WORK	DRAWN BY	DATE	REMARKS
CPA-165	PH-16	E-3	Capital Plaza Office Bldg Frankfort, Ky.	Plumbing & Ventilating Plan - Mezzanine Level	Mechanical & Elect	D S	5/15/67	Lee Potter Smith & Assoc
166	PH-17	B-1		Plan - Plaza Level		SWIFT		
167	PH-18	B-2		" " " "		"		
168	PH-19	B-3		" " " "		"		
169	PH-20	C-1		" " " "		"		
170	PH-21	C-3		" " " "		"		
171	PH-22	D-1		" " " "		"		
172	PH-23	D-2		" " " "		"		
173	PH-24	D-3		" " " "		"		
174	PH-25	E-1		" " " "		D S		
175	PH-26	E-2		" " " "		SWIFT		
176	PH-27	E-3		" " " "		"		
177	PH-28	C-3		Arrival Court Fountain Plan & Diagrams		"		
178	PH-29	E-1		St. Clair Street " " "		"		
179	PH-30	C-1		Hill Street " " "		"		
180	PH-31	A-1		Cooling Tower Plan & Details		D G C		
181	P-1	C-1		Plumbing Plan - Ground Level		DSC/DS		
182	P-2	C-2		" " " "		SWIFT		
183	P-3	C-2		" " Mezzanine Level		"		
184	P-4	C-2		" " Lobby Level		"		
185	P-5	C-2		" " Floor 13 A		"		
186	P-5	C-2		" " Penthouse & Roof		"		
187	P-7	C-2		Office Cores		"		
188	P-8			Sanitary Waste & Vent Diagram		"		
189	P-9			Sanitary Waste & Vent Diagram		"		
190	P-10			Sanitary Waste & Vent Diagram		"		
191	P-11			Domestic Water Piping Diagram		"		
192	P-12			" " " "		"		
193	P-13			" " " "		"		
194	P-14			Mechanical Room Plans - Diagram		"		
195	H-1	C-1		Heating & Air Conditioning Plan - Ground Level	M E C H	T F		
196	H-2	C-2		" " " " " "		T F		
197	H-3	C-2		" " " " " Mezzanine Level		"		
198	H-4	C-2		" " " " " Lobby Level		"		
199	H-5	C-2		" " " " " Floors thru 12 & 15 thru 23		"		
200	H-6	C-2		" " " " " 1st Floor		"		
201	H-7	C-2		" " " " " 2nd Floor		"		
202	H-8	C-2		" " " " " Roof & Penthouse		"		
203	H-9	C-2		Enlarged Core Plan		"		
204	H-10	C-2		Enlarged Core Plan & Details		"		

COMMONWEALTH OF KENTUCKY
EDWARD T. BREATHITT, GOVERNOR

DEPARTMENT OF FINANCE
DIVISION OF ENGINEERING

CAPITAL PLAZA OFFICE BUILDING
FRANKFORT, KENTUCKY

EDWARD DURELL STONE

ARCHITECT




LEE POTTER SMITH AND ASSOCIATES

ASSOCIATE ARCHITECTS AND ENGINEERS


PRAEGER · KAVANAGH · WATERBURY

STRUCTURAL ENGINEERS

MECHANICAL
ELECTRICAL

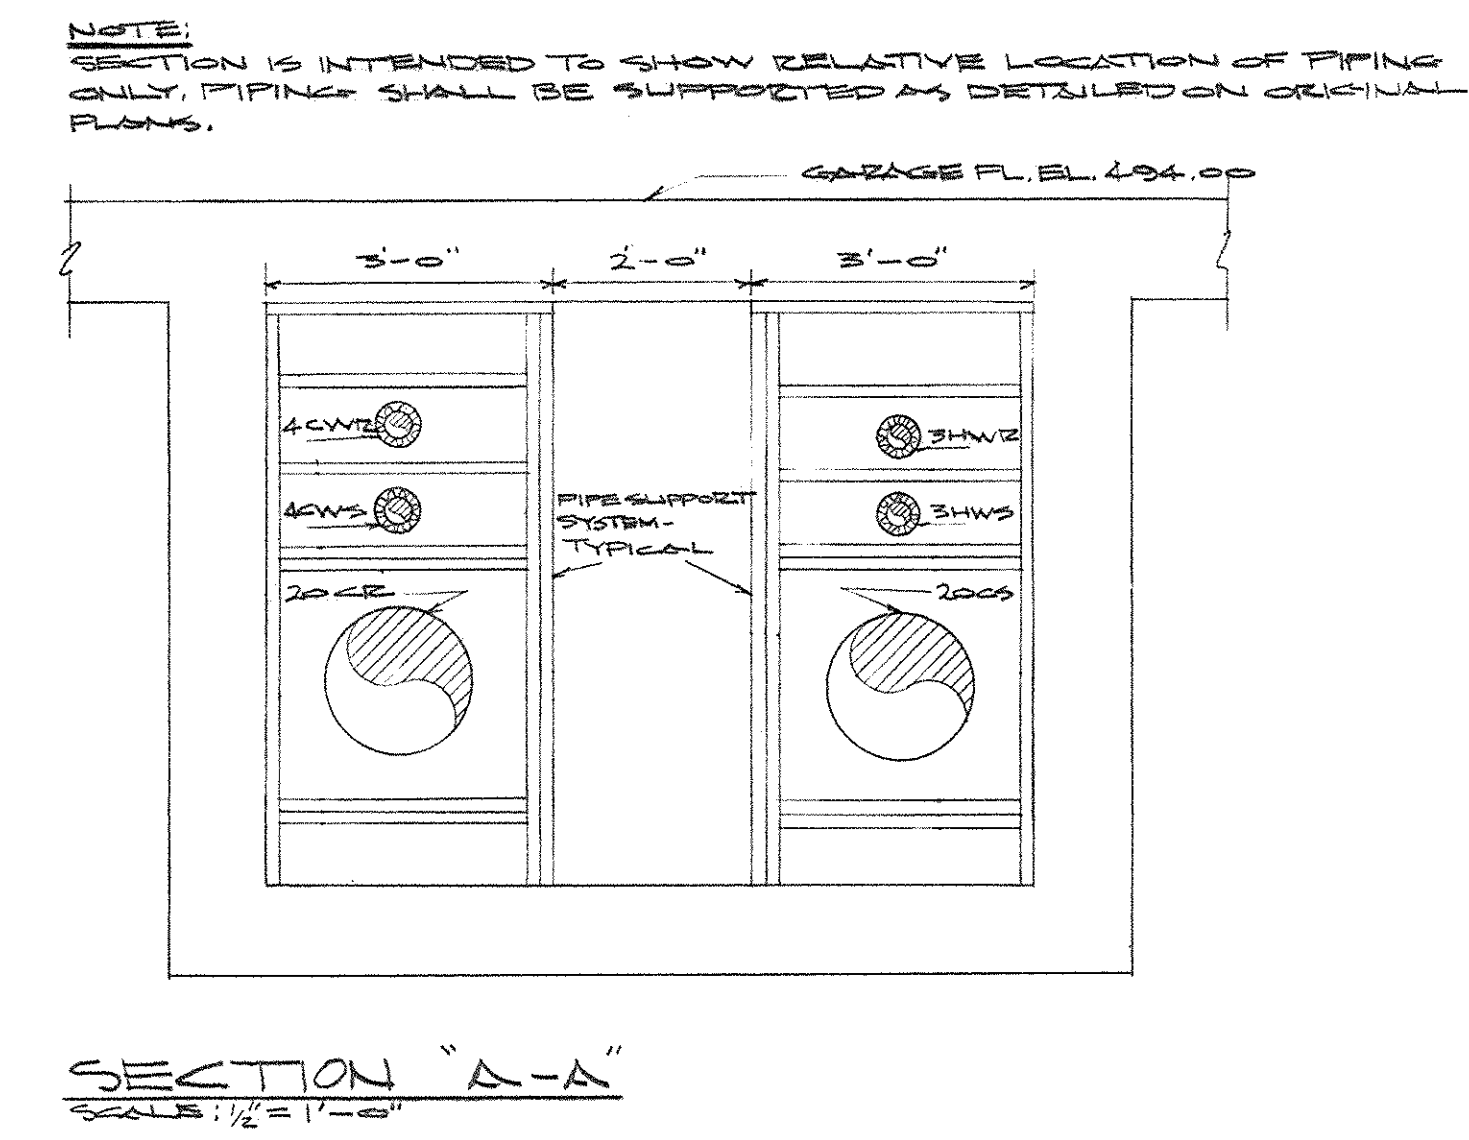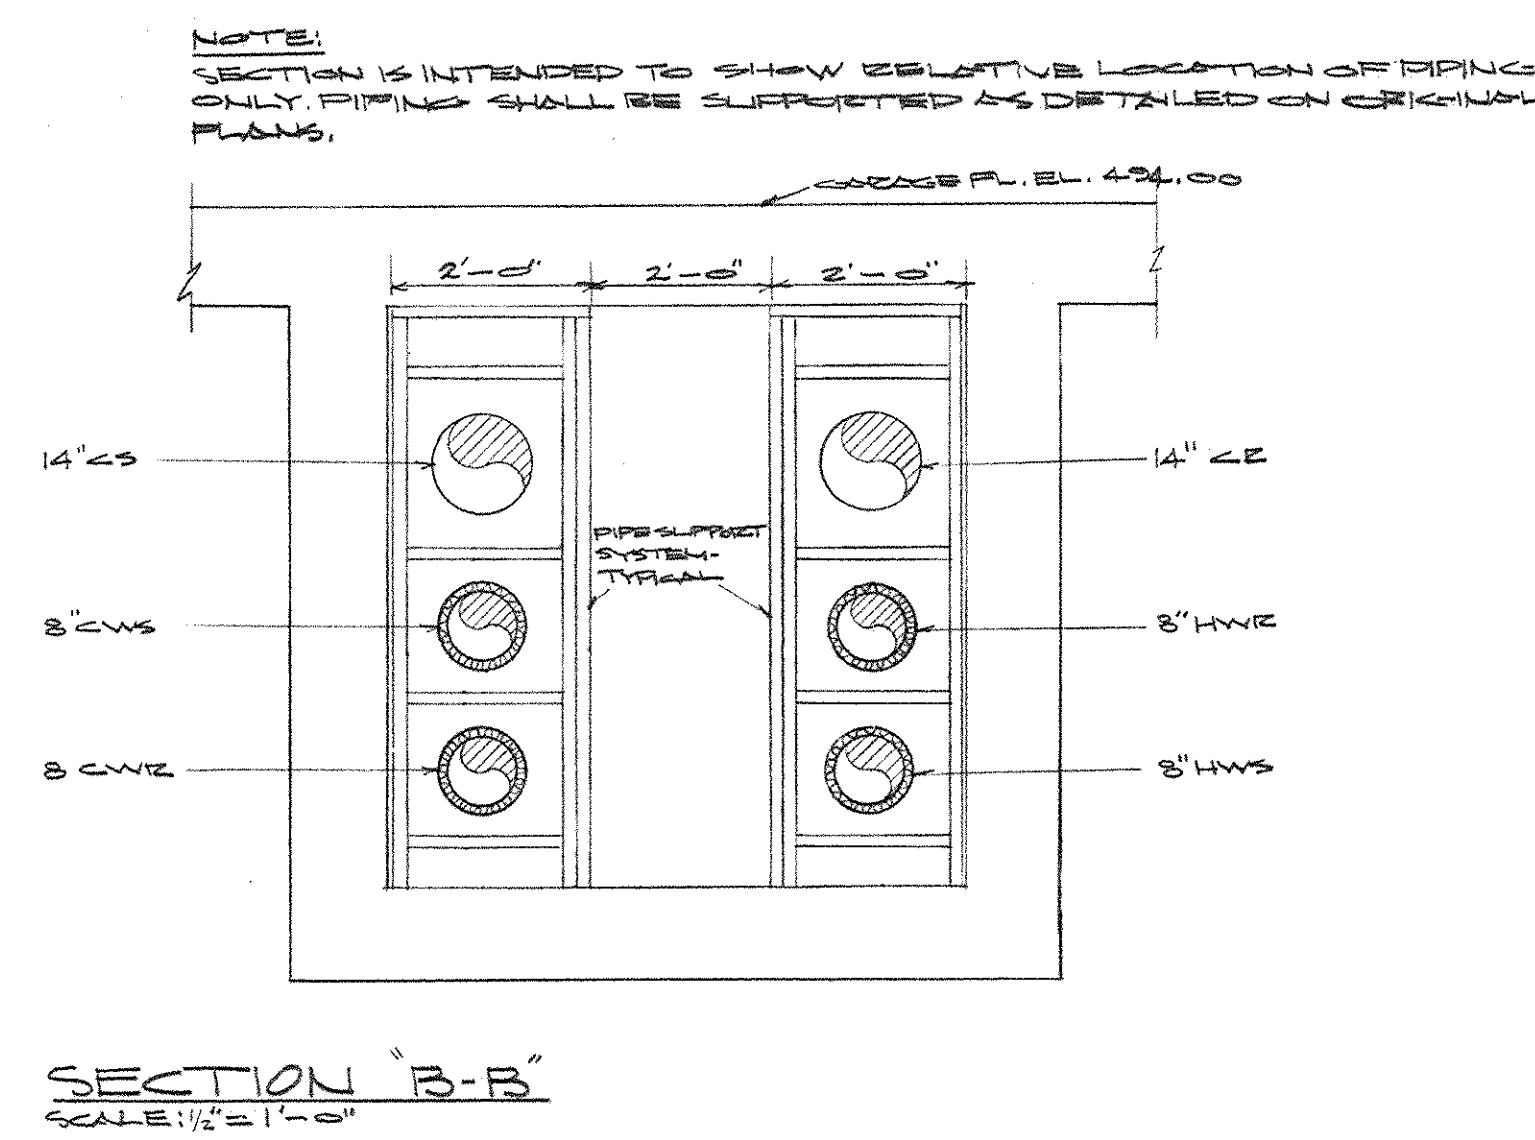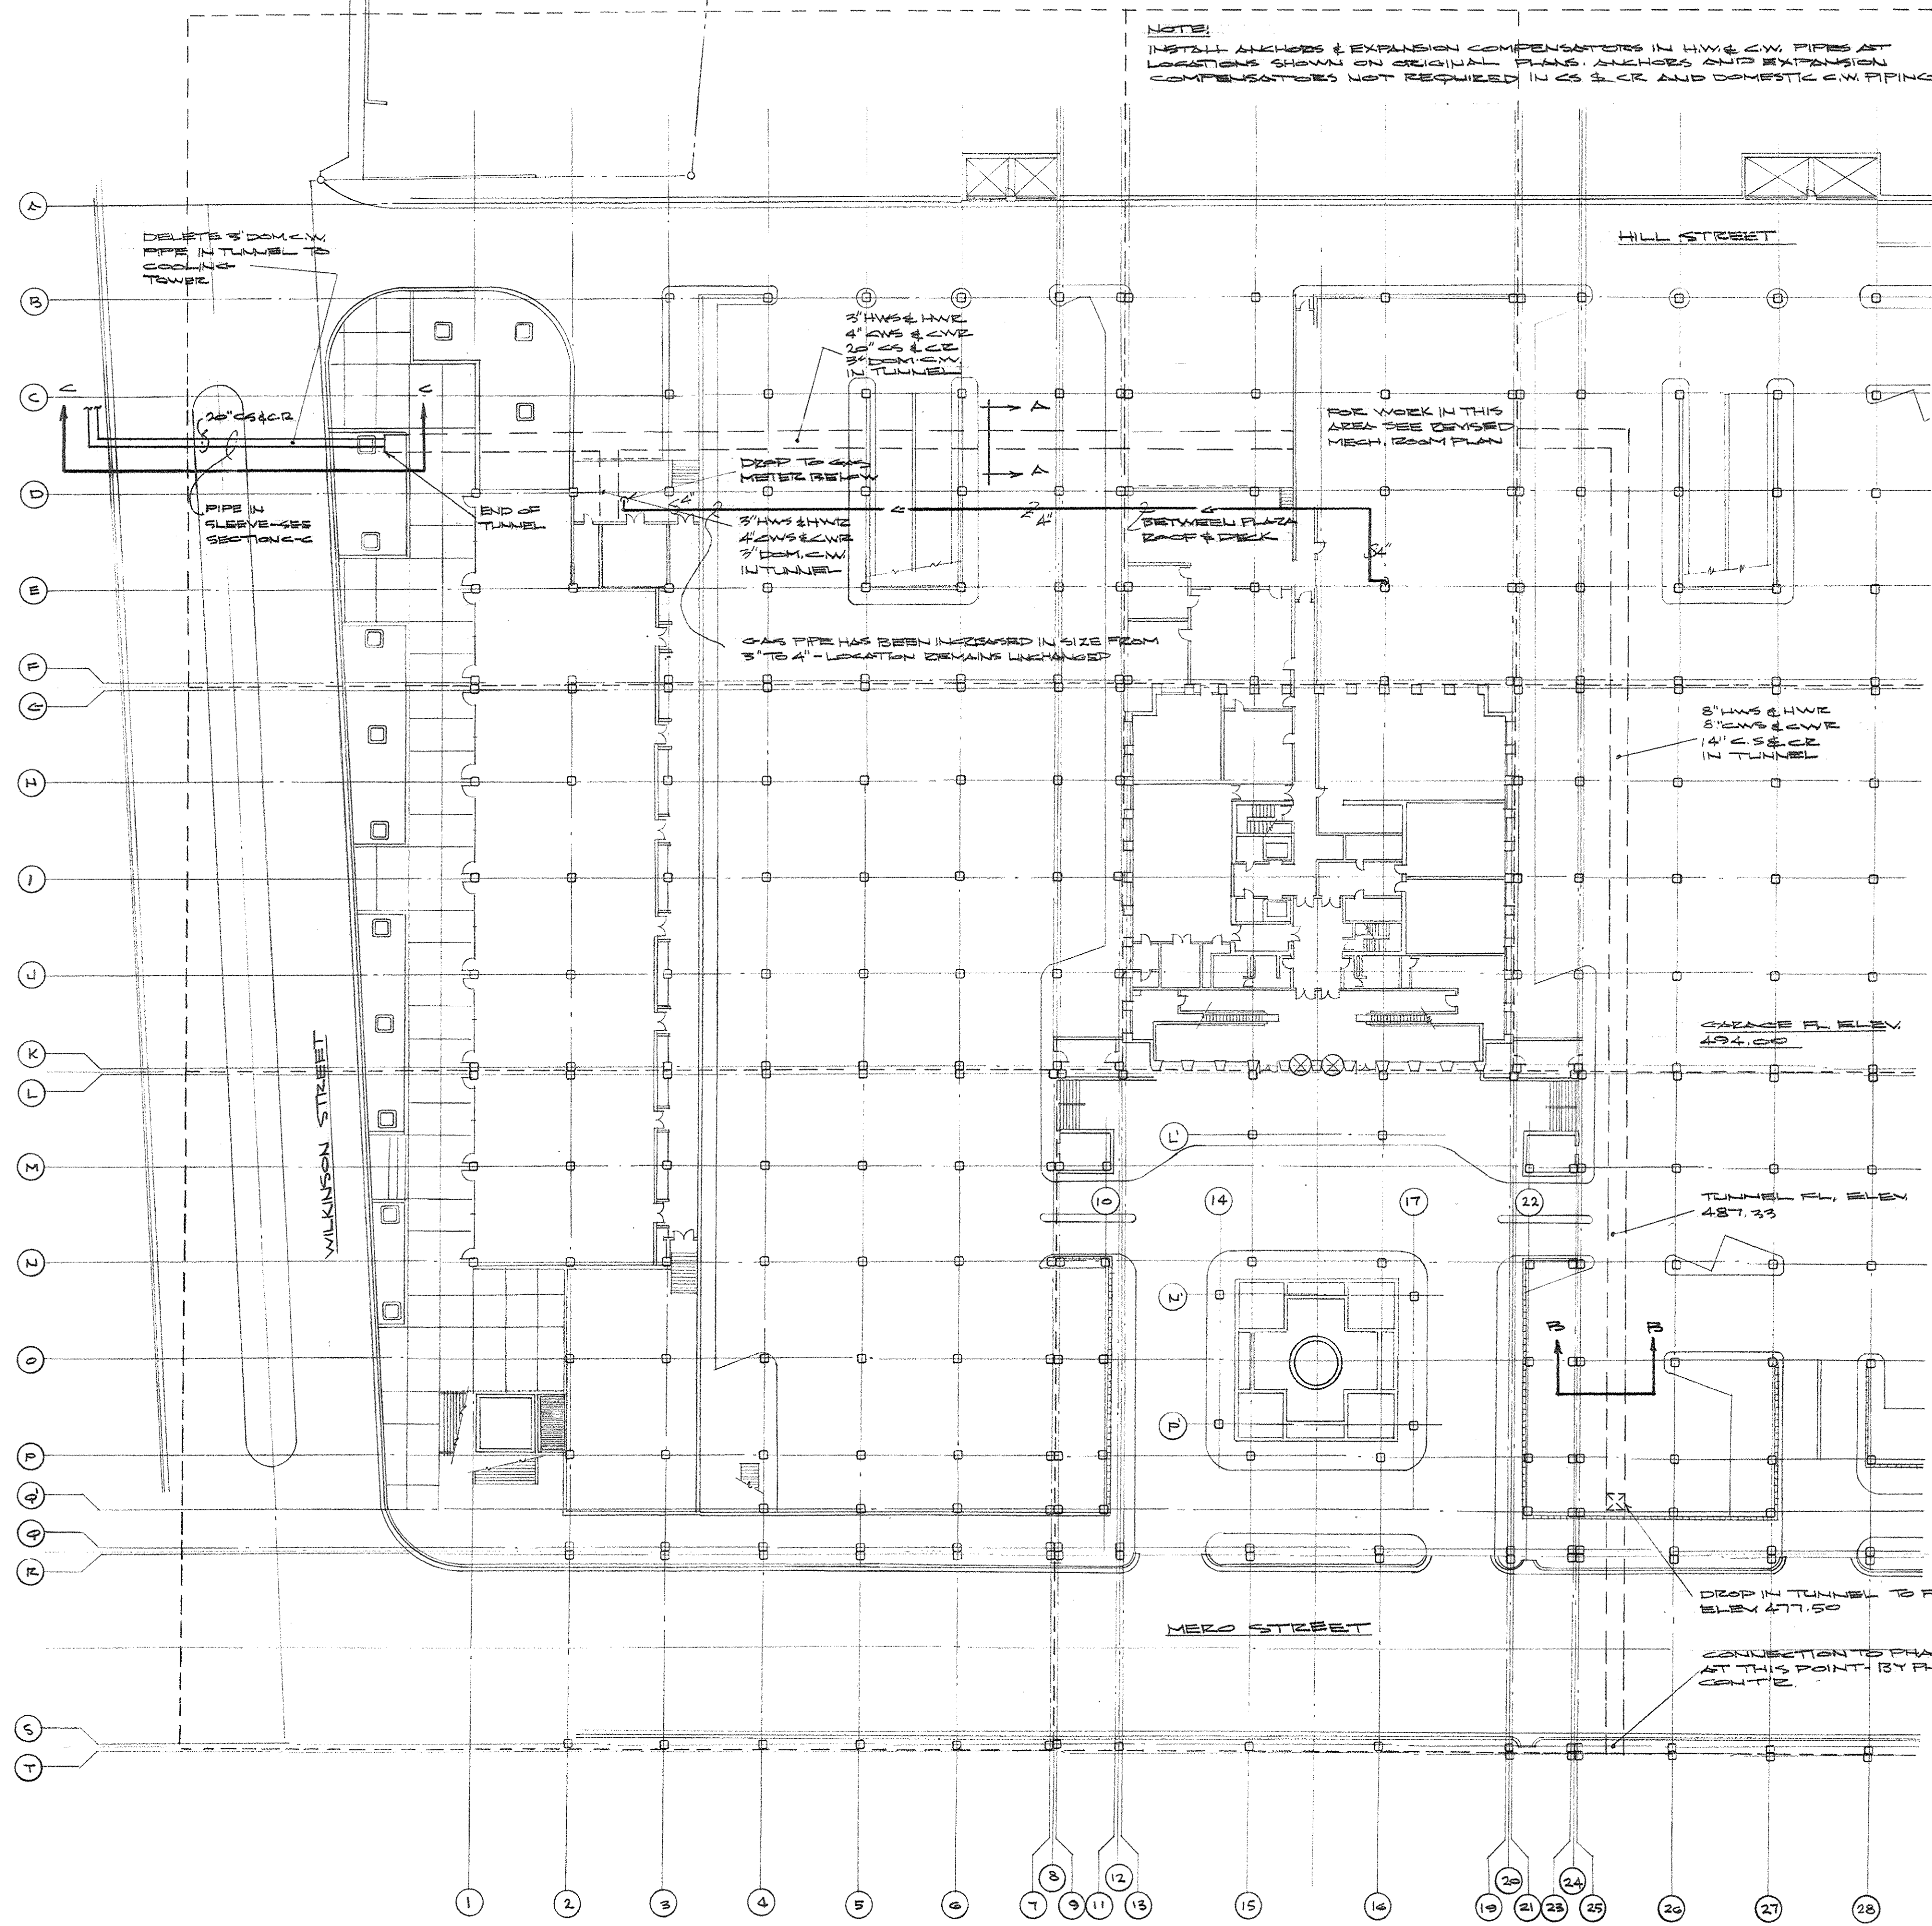

REVISED SECTOR MASTER PLAN - GROUND LEVEL

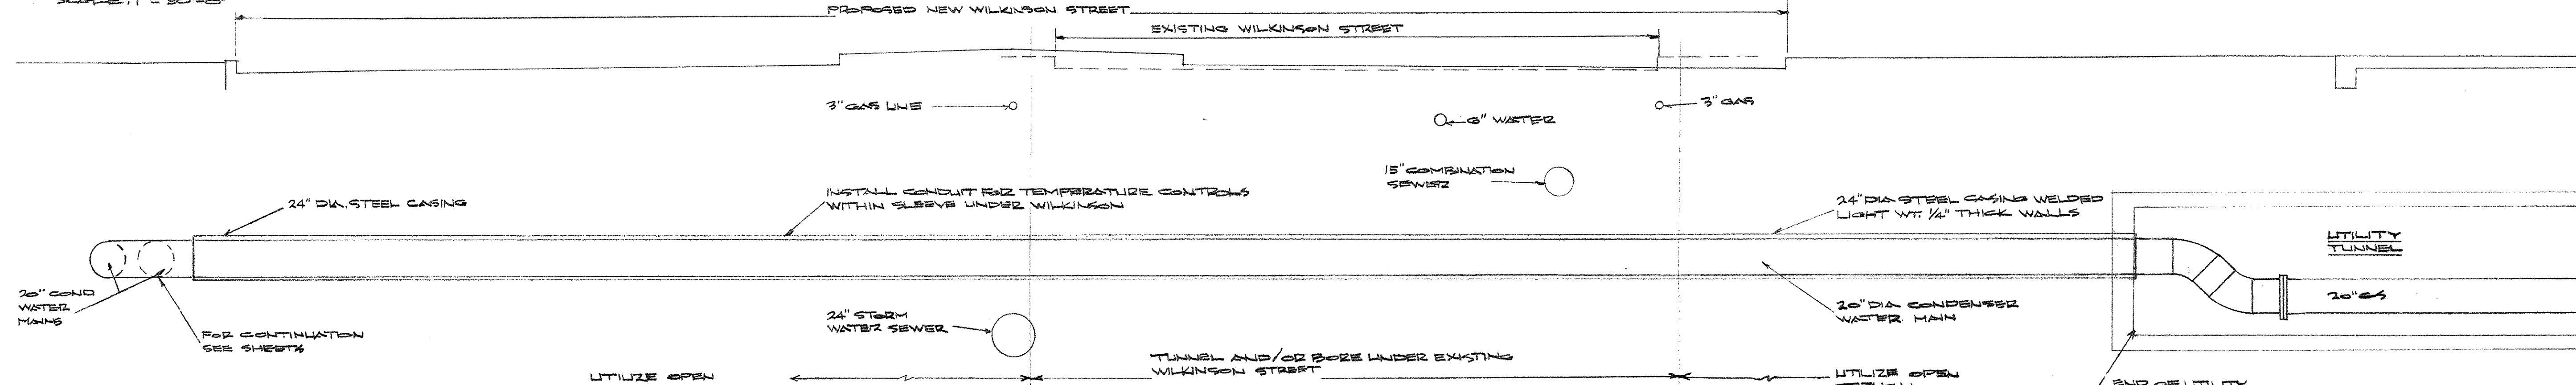


AS-BUILT DRAWINGS
DATE: JAN 73
MURD, CARTER & BLANKEN, INC. 11 JUN 68

CHANGE ORDER 13 - 71 NO. 2
CAPITAL PLAZA OFFICE BUILDING
FRANKFORT, KENTUCKY


DRAWN BY M.C.B.	REVISED SECTOR MASTER	DATE JUN 68
TRACED BY M.C.B.	ARCHITECT EDWARD DURELL STONE	SCALE AS SHOWN
CHECKED BY M.C.B.	7 EAST 87TH STREET NEW YORK, N. Y.	COMM. NO. S-100-60
SECTOR NO.	ASSOCIATE ARCHITECTS & ENGINEERS LEE POTTER SMITH & ASSOCIATES 314 WILKINSON FRANKFORT, KENTUCKY COMMONWEALTH OF KENTUCKY DEPARTMENT OF FINANCE - ENGINEERING STAFF FRANKFORT, KENTUCKY	DRAWING NO. R 1 OF 7
APPROVED BY ARCHITECT	DATE	
APPROVED BY AGENCY HEAD	DATE	
APPROVED BY OWNER	DATE	



CPA-148 R

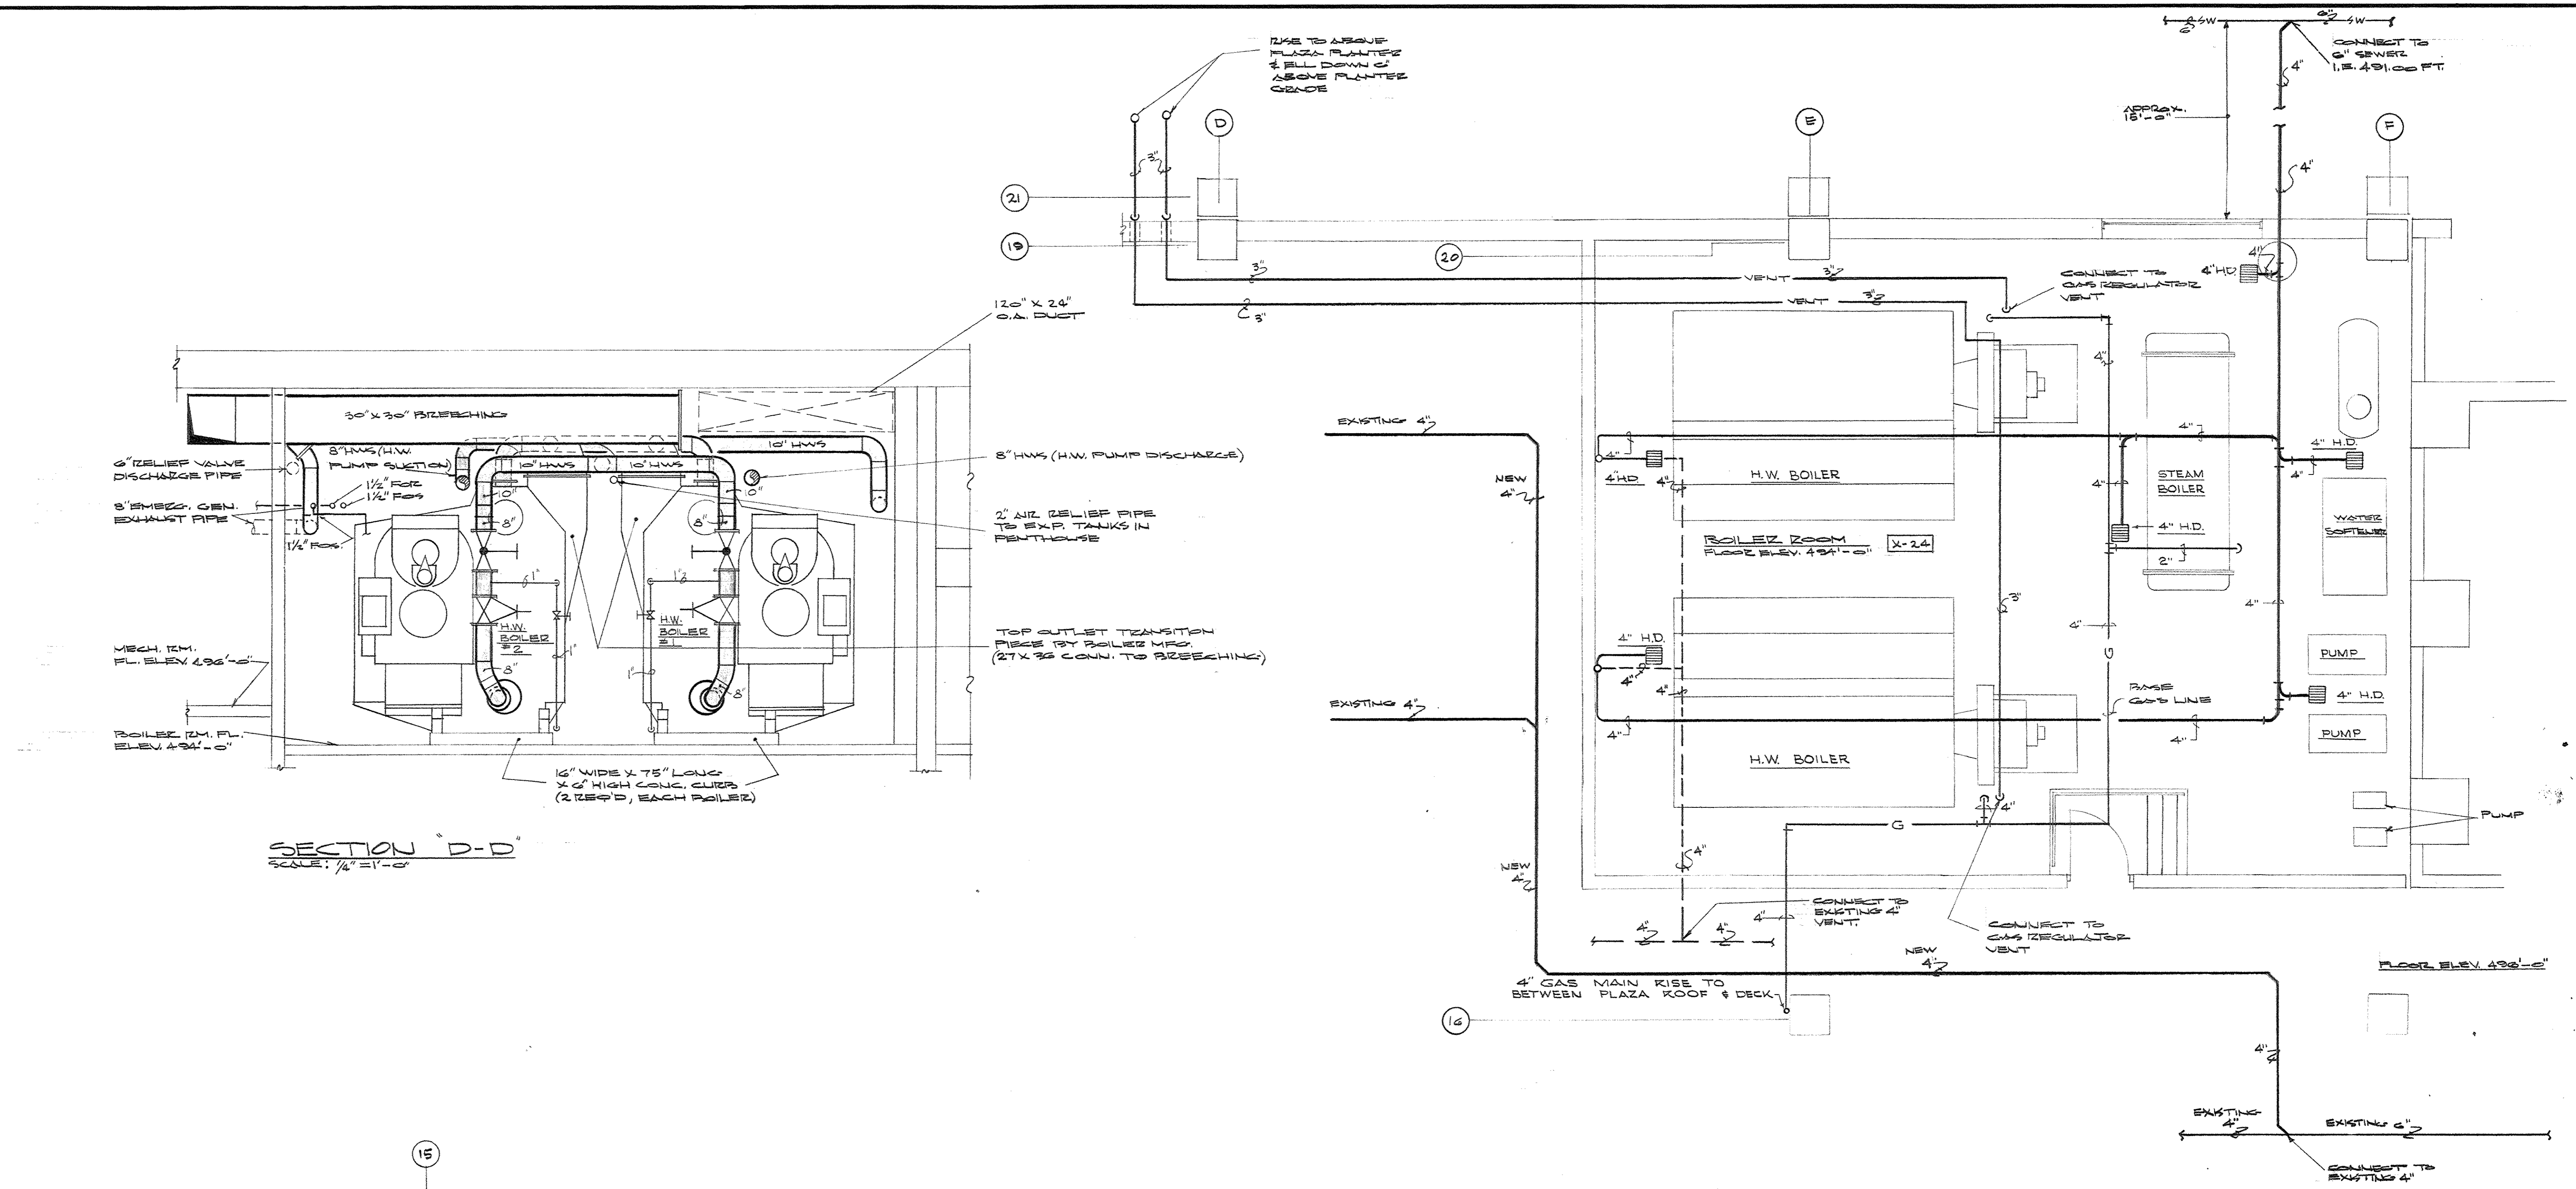

REVISION PLUMBING PLAN - BOILER ROOM
SCALE: 1/4" = 1'-0"

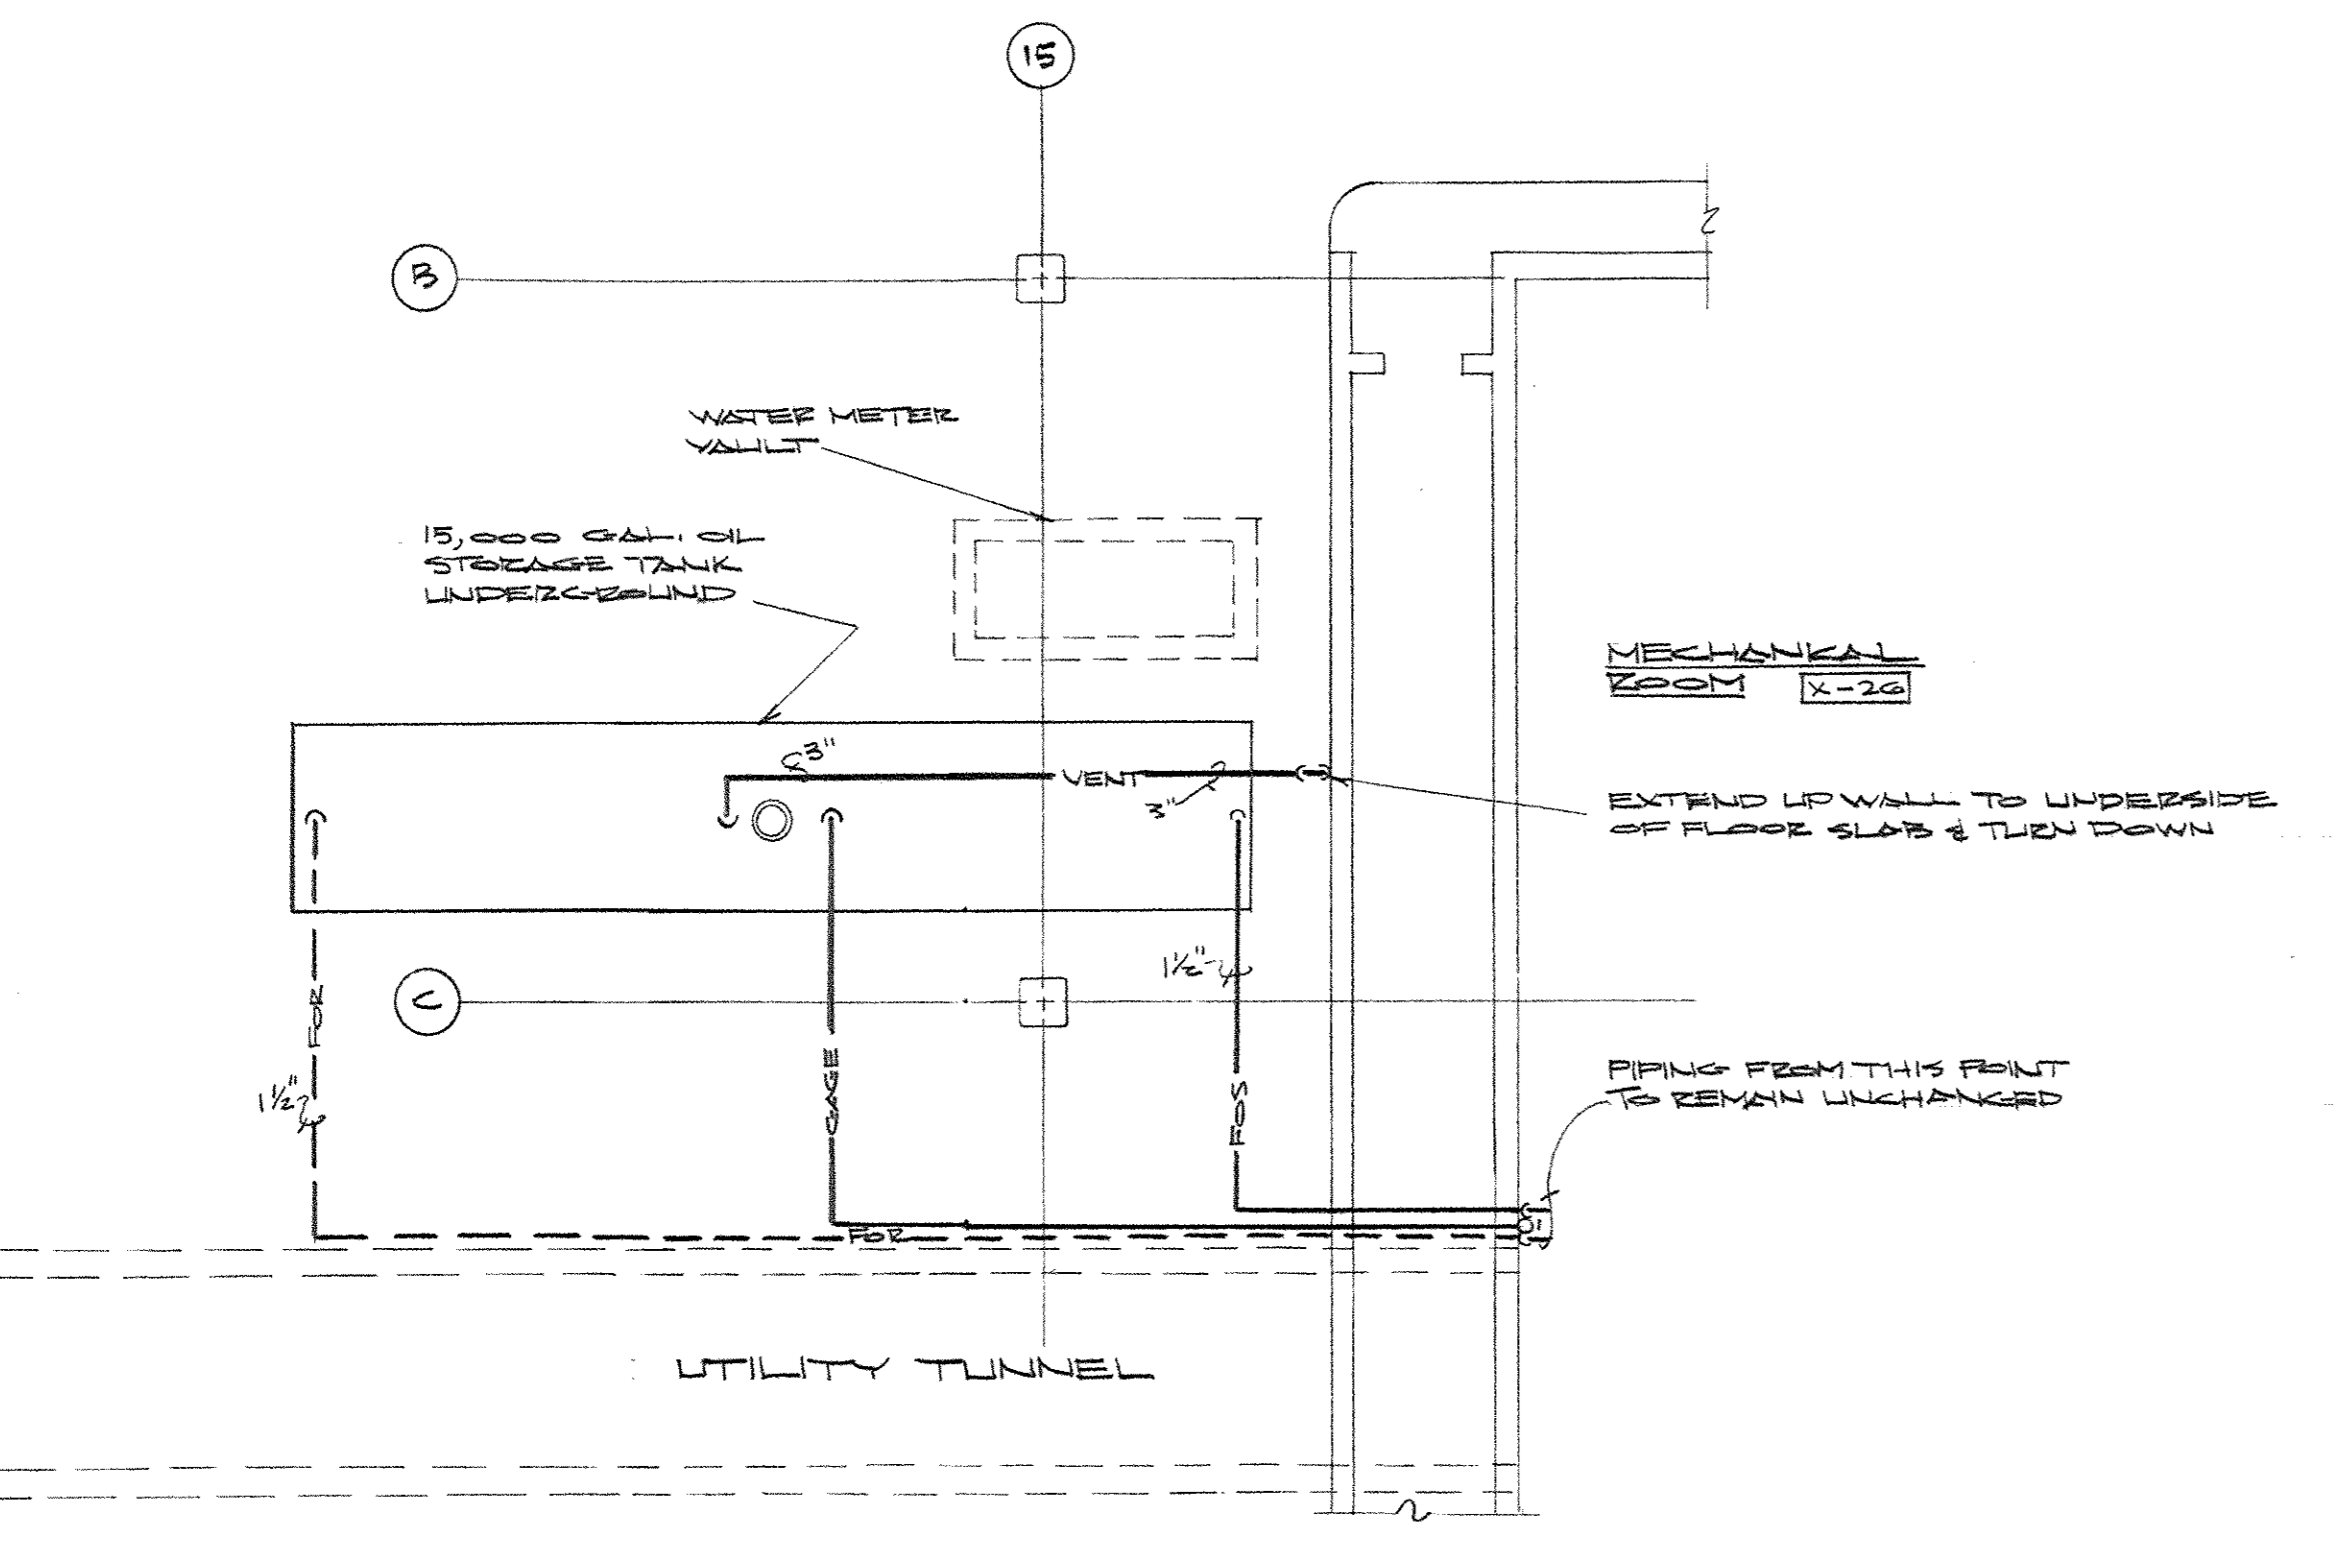


REVISION PARTIAL PLAN - GROUND LEVEL - SECTOR C-1
SCALE: 1/4" = 1'-0"


AS-BUILT DRAWINGS
DATE: JAN 73
HUBB, GARDNER & BLACKMAN, INC.
CHANGE ORDER

11 JUN 68
NO. 2


CAPITAL PLAZA OFFICE BUILDING FRANKFORT, KENTUCKY		
DRAWN BY TJE	ARCHITECT REVISED PLANS	DATE JUN 68
TRACED BY CSC	EDWARD DURELL STONE	SCALE AS SHOWN
CHECKED BY CSC	7 EAST 87TH STREET NEW YORK N. Y.	COMM. NO. 500-50
SECTOR NO.	ASSOCIATE ARCHITECTS & ENGINEERS LEE POTTER SMITH & ASSOCIATES 314 WILKINSON FRANKFORT, KENTUCKY	DRAWING NO. R 2
APPROVED BY	ARCHITECT	DATE
APPROVED BY	AGENCY HEAD	DATE
APPROVED BY	OWNER	DATE

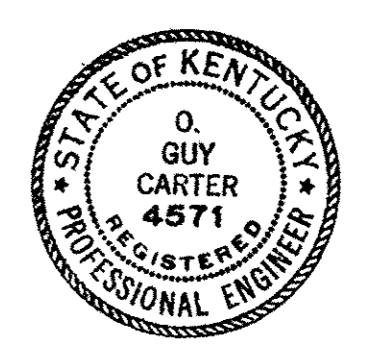


CPP-148 B

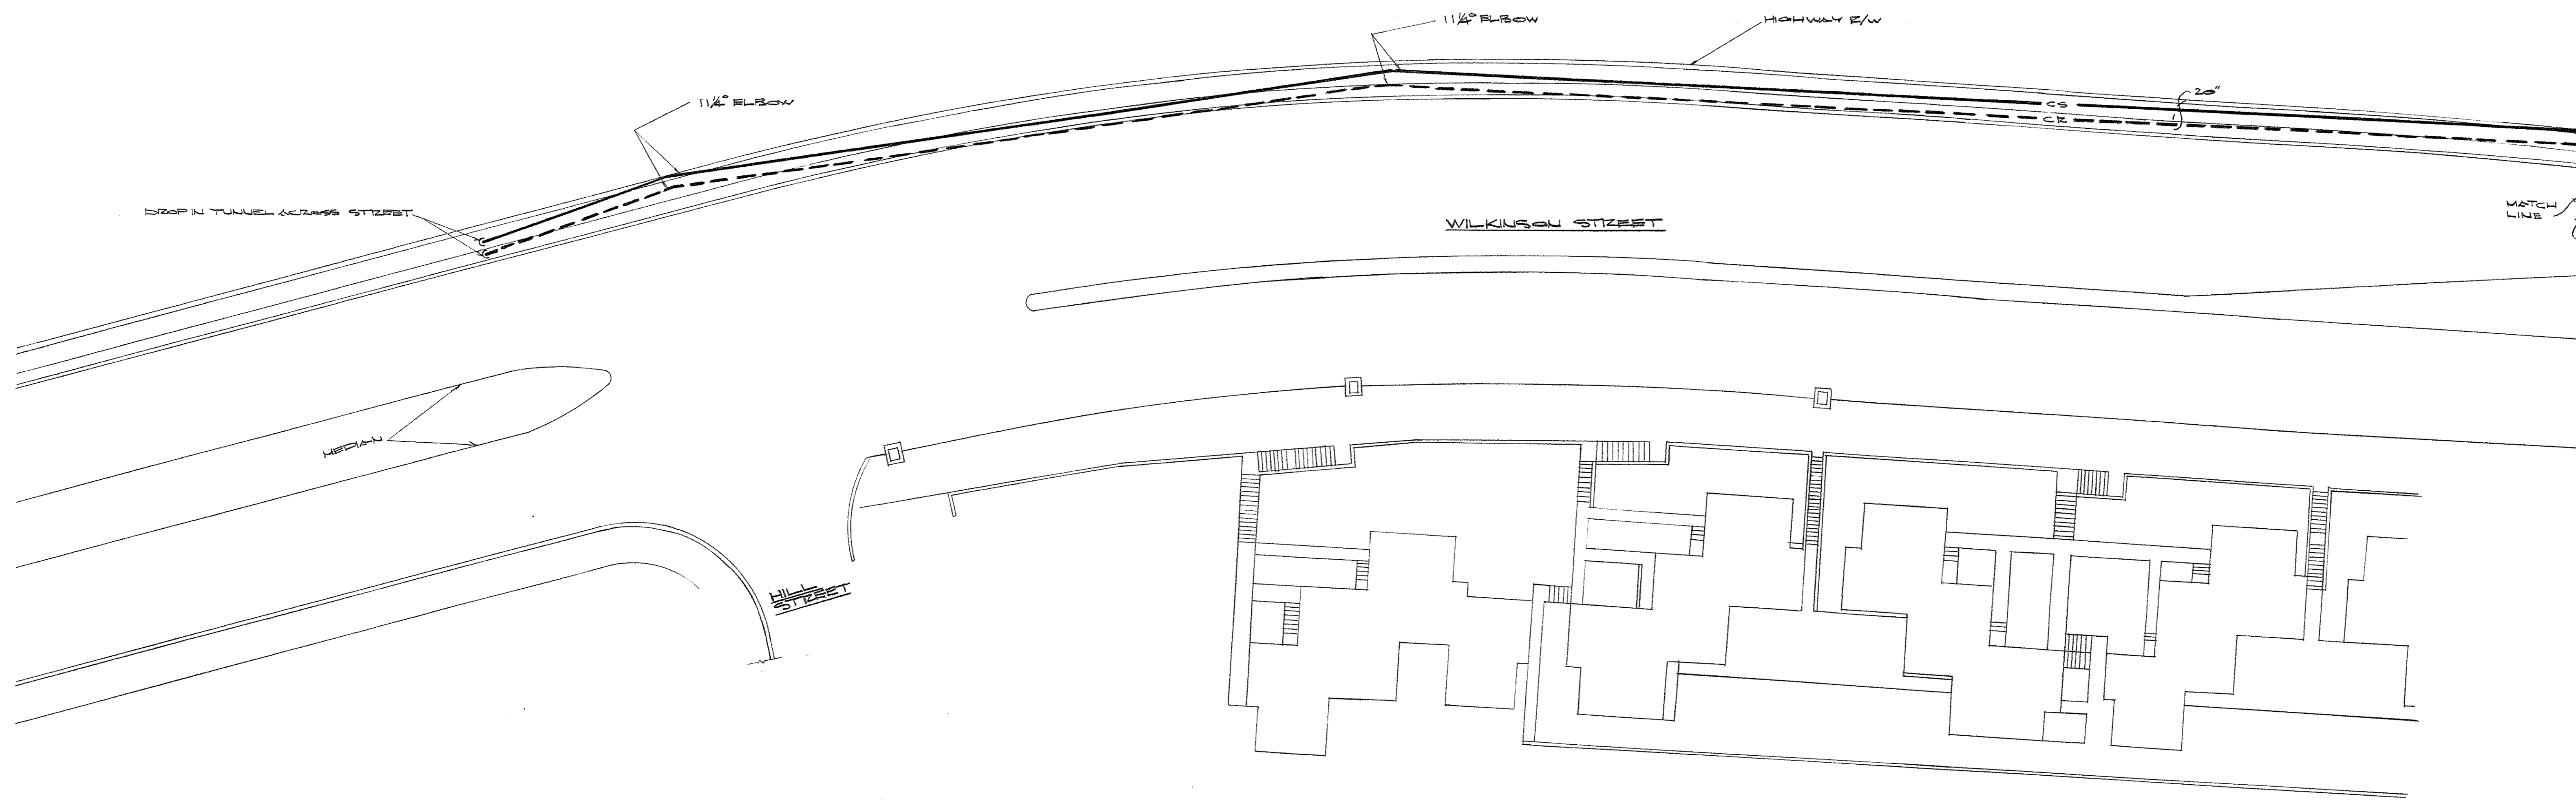


SITE UTILITIES PLAN
SCALE: 1/2" = 1'-0"

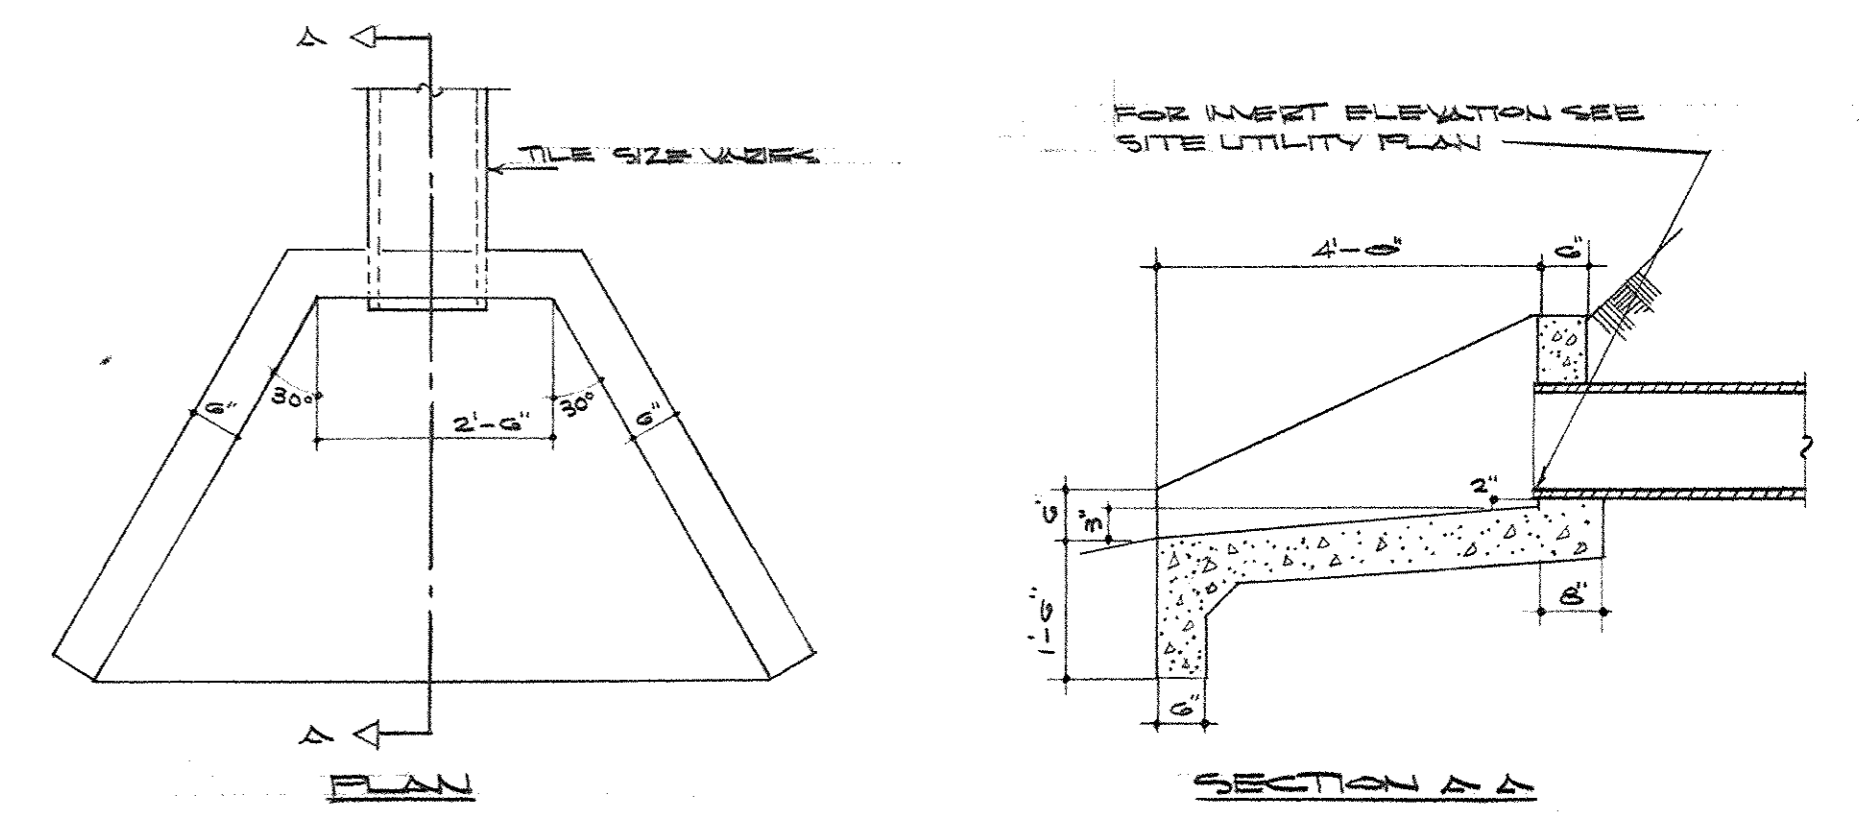

DETAIL OF HEADWALL
SCALE: 1/2" = 1'-0"

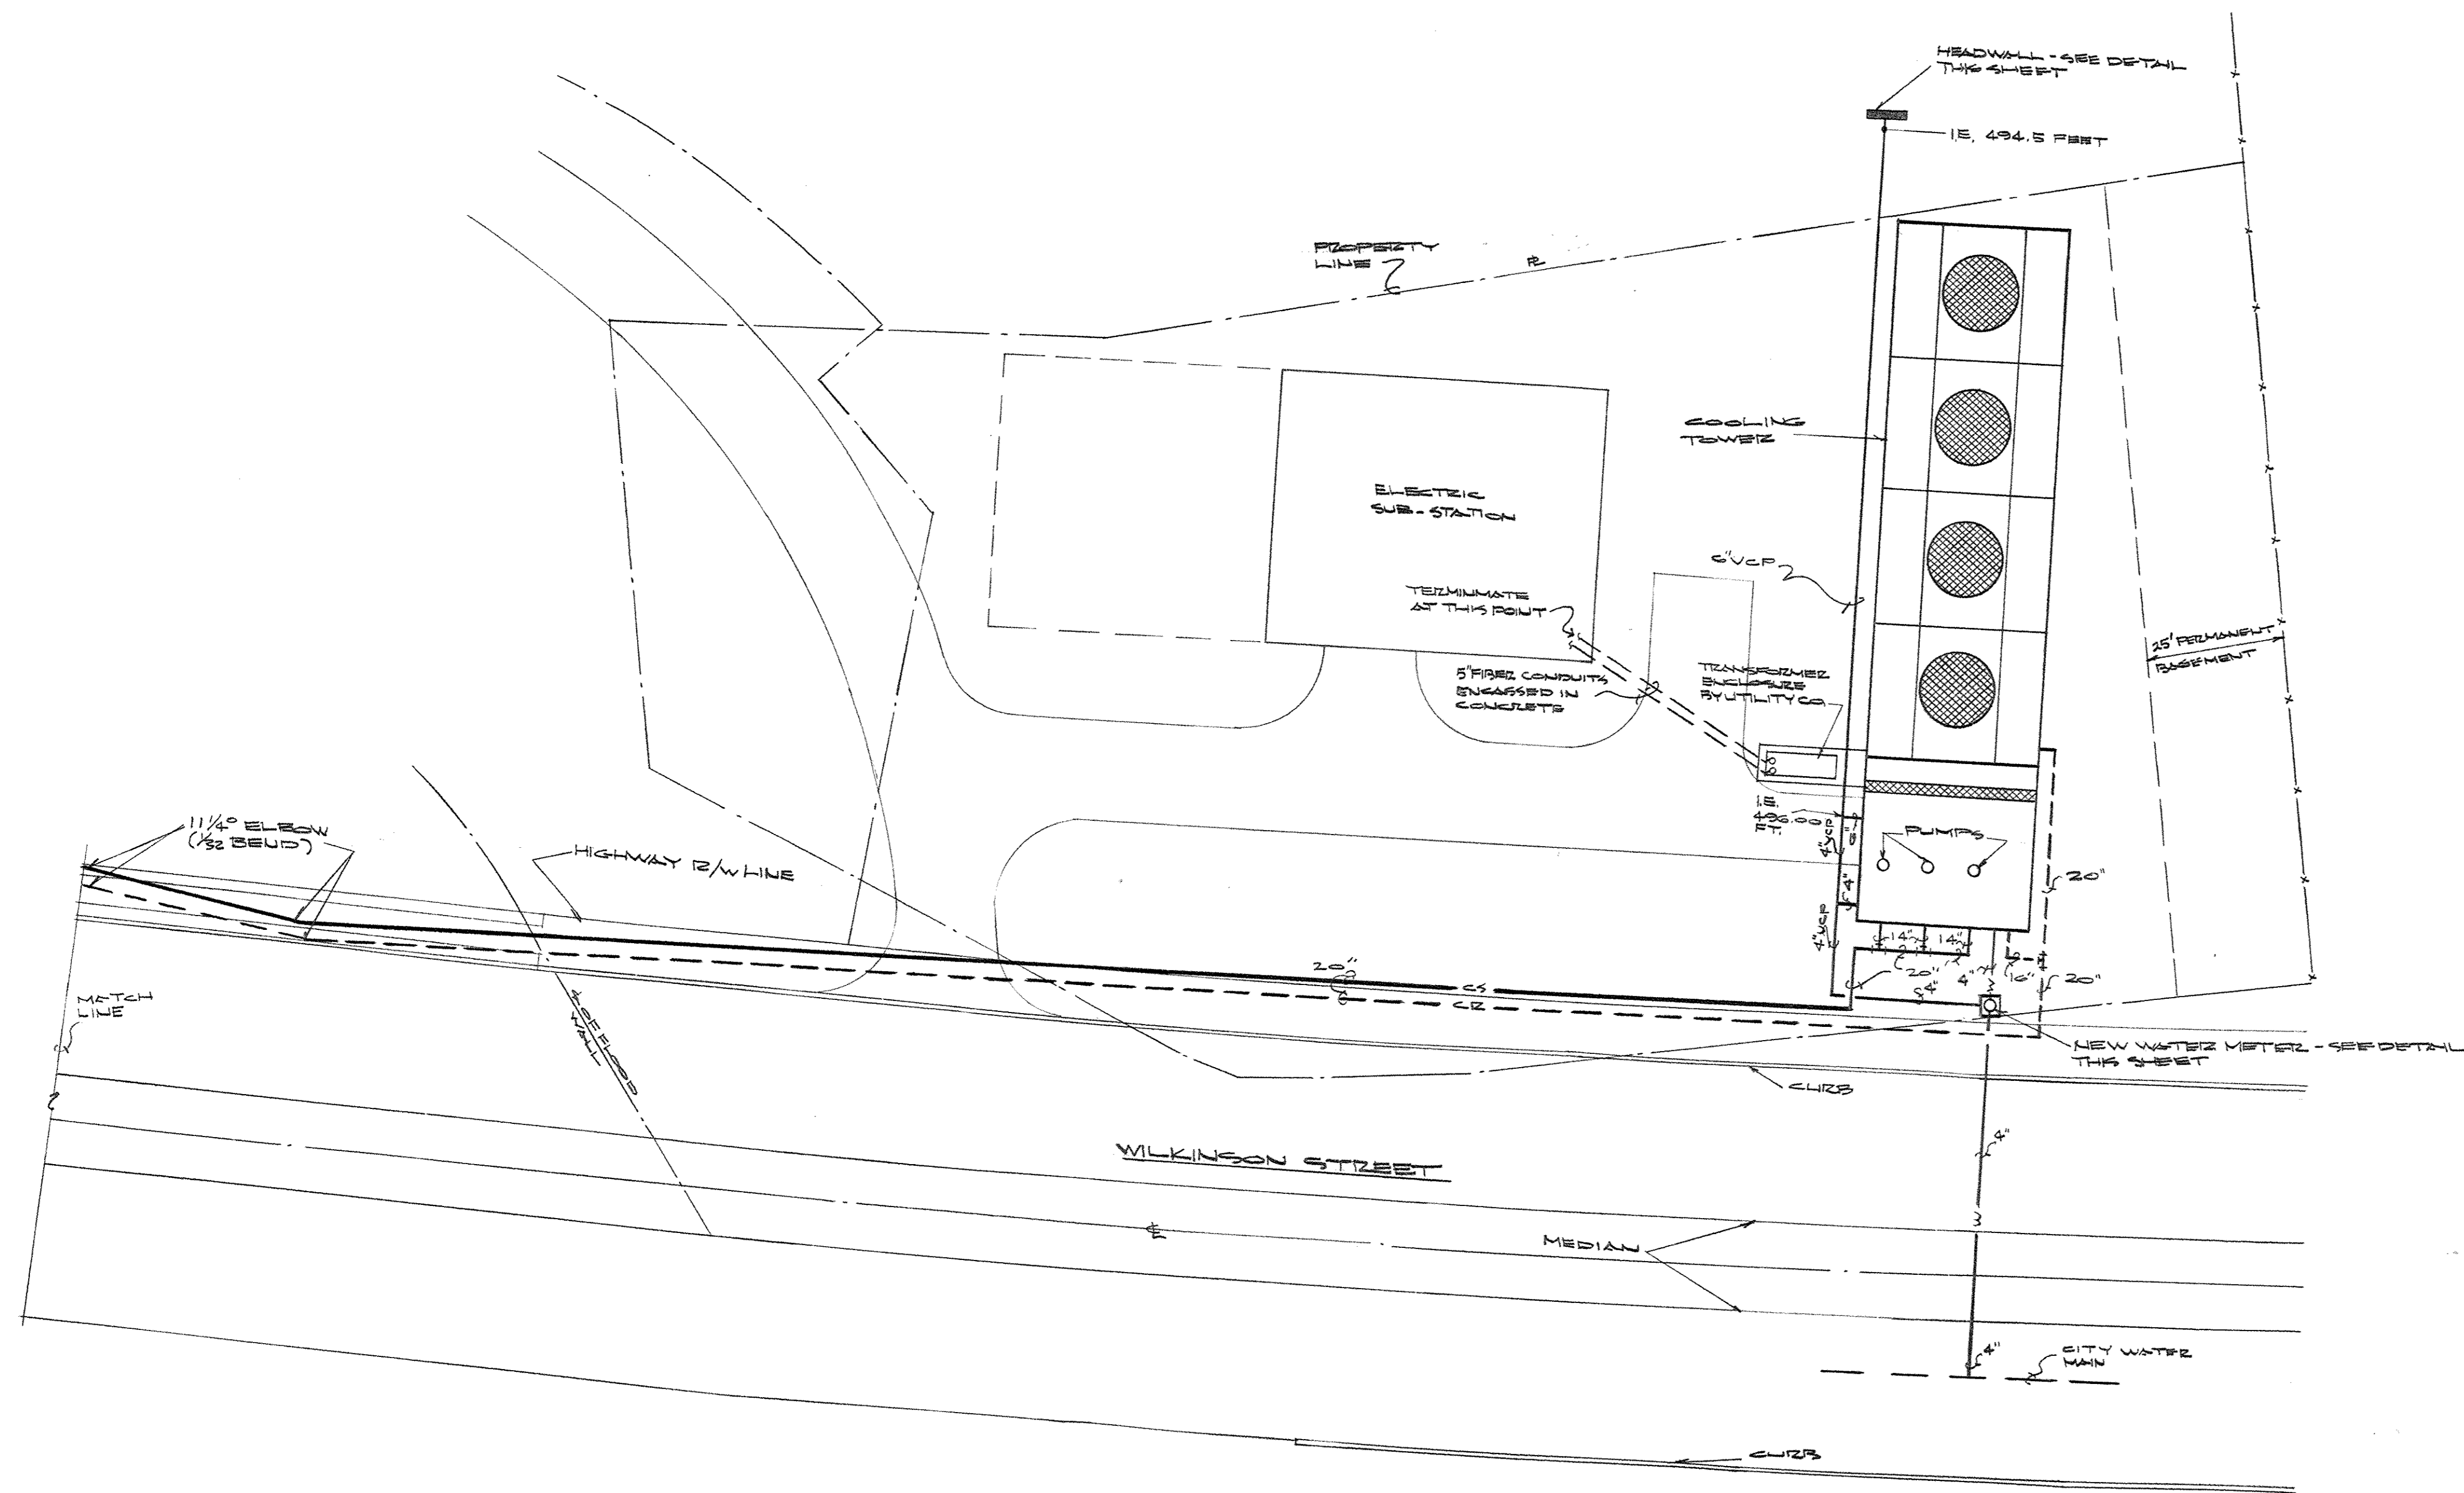

SITE UTILITIES PLAN
SCALE: 1/2" = 1'-0"

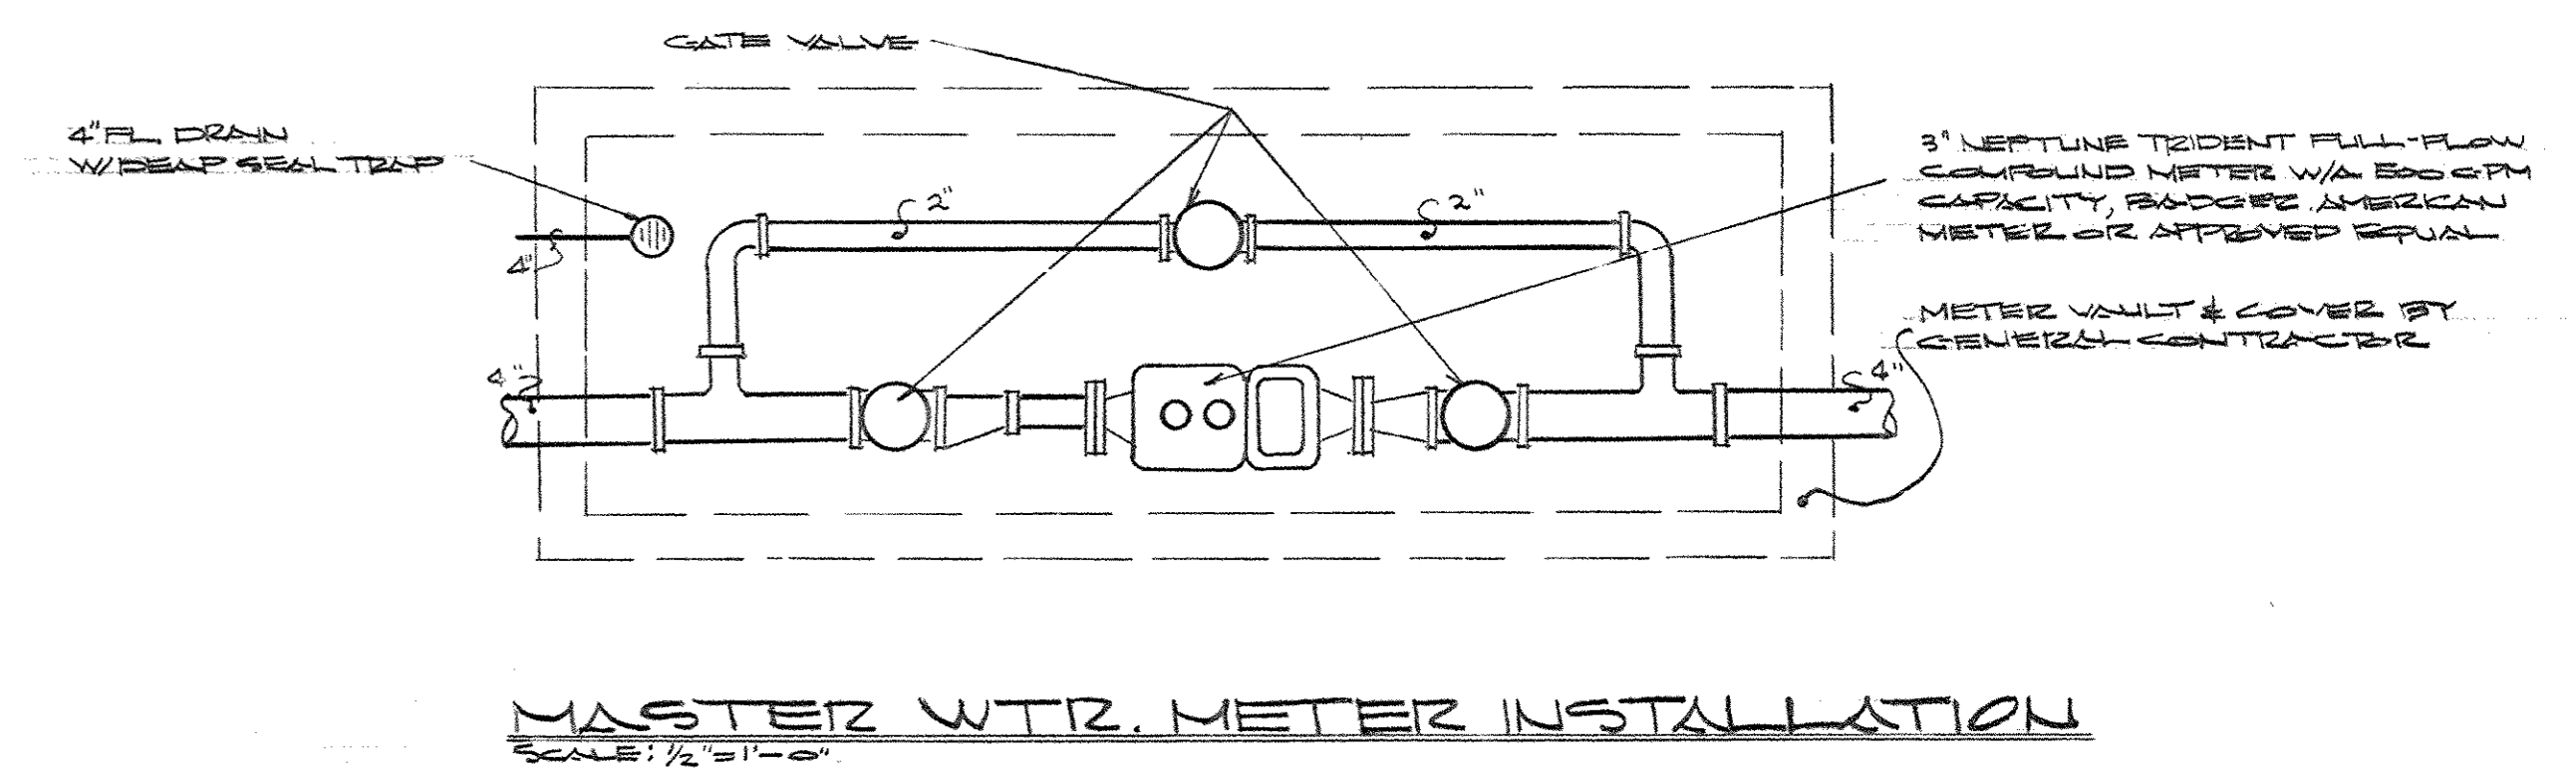


AS-BUILT DRAWINGS
DATE: JAN 73
MURDO, CARTER & BLAKEMAN, INC.
11 JUN 68
CHANGE ORDER NO. 2


CAPITAL PLAZA OFFICE BUILDING FRANKFORT, KENTUCKY		
DRAWN BY S.F.	ARCHITECT EDWARD DURELL STONE 7 EAST 87TH STREET NEW YORK, N.Y.	DATE JUN 1968
TRACED BY S.F.	ARCHITECT LEE POTTER SMITH & ASSOCIATES 314 WILKINSON FRANKFORT, KENTUCKY	SCALE AS SHOWN
CHECKED BY S.F.	ASSOCIATE ARCHITECTS & ENGINEERS COMMONWEALTH OF KENTUCKY DEPARTMENT OF FINANCE - ENGINEERING STAFF FRANKFORT, KENTUCKY	CONTR. NO. 90000
SECTOR NO.		DRAWING NO. R 4
APPROVED BY	ARCHITECT	DATE
APPROVED BY	AGENCY HEAD	DATE
APPROVED BY	OWNER	DATE



CPA 148D

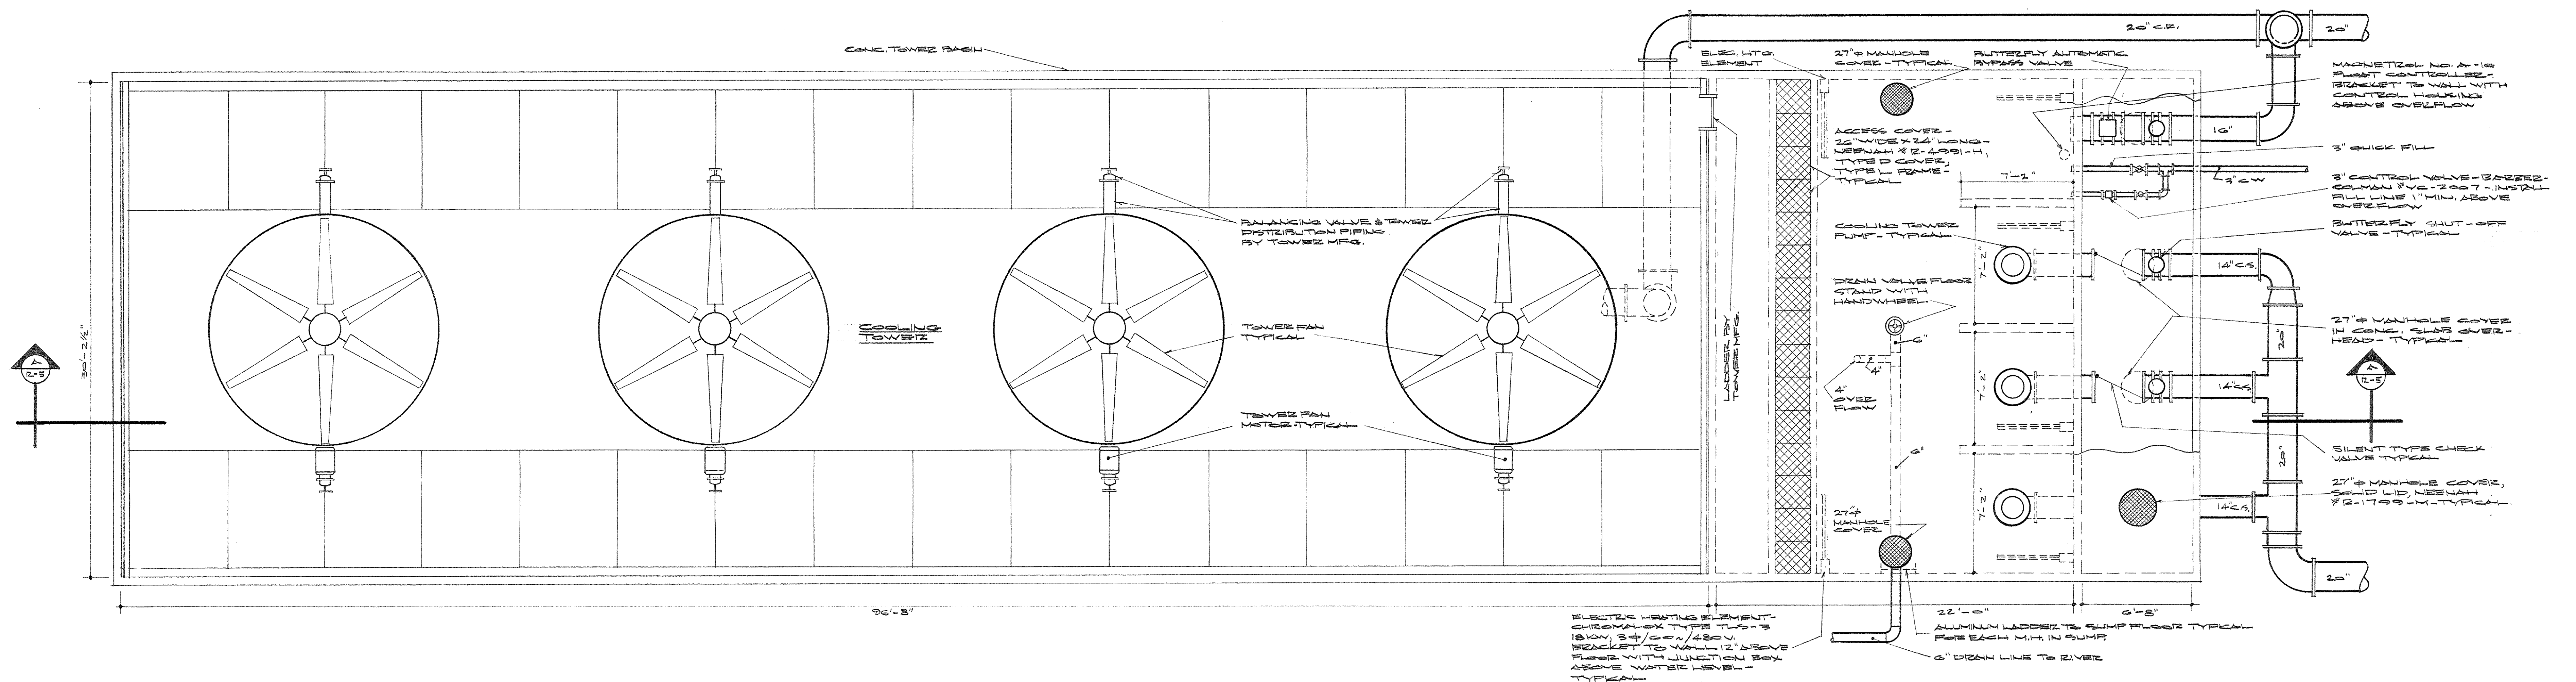


ENLARGED PLAN - COOLING TOWER
SCALE: 1/2" = 1'-0"

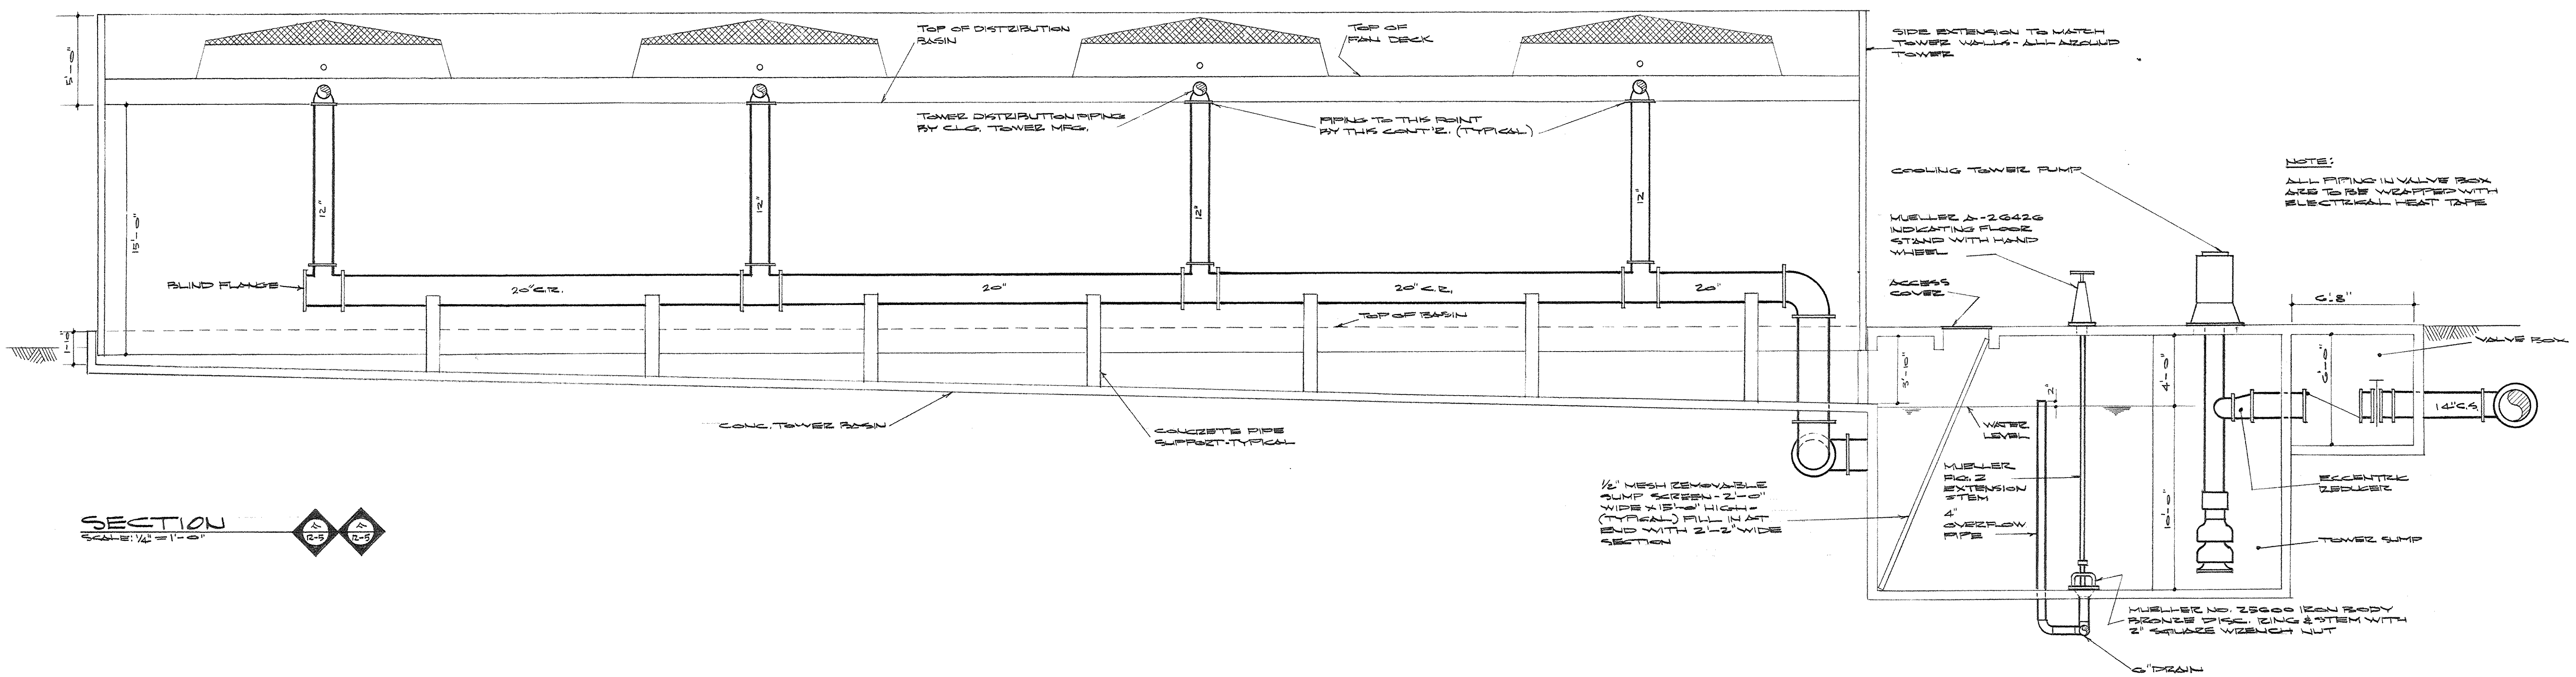


SECTION
SCALE: 1/2" = 1'-0"


AS-BUILT DRAWINGS DATE JAN 73		HUGG, CARTER & BLAKEMAN, INC.		11 JUN. 68
		CHANGE ORDER NO. 2		
CAPITAL PLAZA OFFICE BUILDING				
FRANKFORT, KENTUCKY				
DRAWN BY ATP	COOLING TOWER PLAN			DATE JUN 68
TRACED BY MCM	ARCHITECT	EDWARD DURELL STONE	7 EAST 67TH STREET NEW YORK N. Y.	SCALE AS SHOWN
CHECKED BY CWC	ASSOCIATE ARCHITECTS & ENGINEERS	LEE POTTER SMITH & ASSOCIATES	314 WILKINSON FRANKFORT, KENTUCKY	COMM. NO. 90000
SECTOR NO.	COMMONWEALTH OF KENTUCKY DEPARTMENT OF FINANCE - ENGINEERING STAFF FRANKFORT, KENTUCKY			DRAWING NO. R 5
APPROVED BY: ARCHITECT				DATE
APPROVED BY: AGENCY HEAD				DATE
APPROVED BY: OWNER				DATE

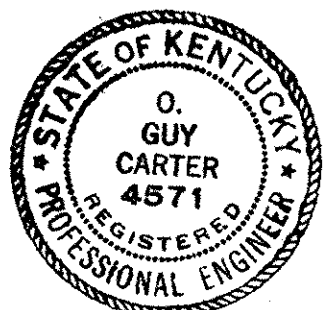

CPA-148E

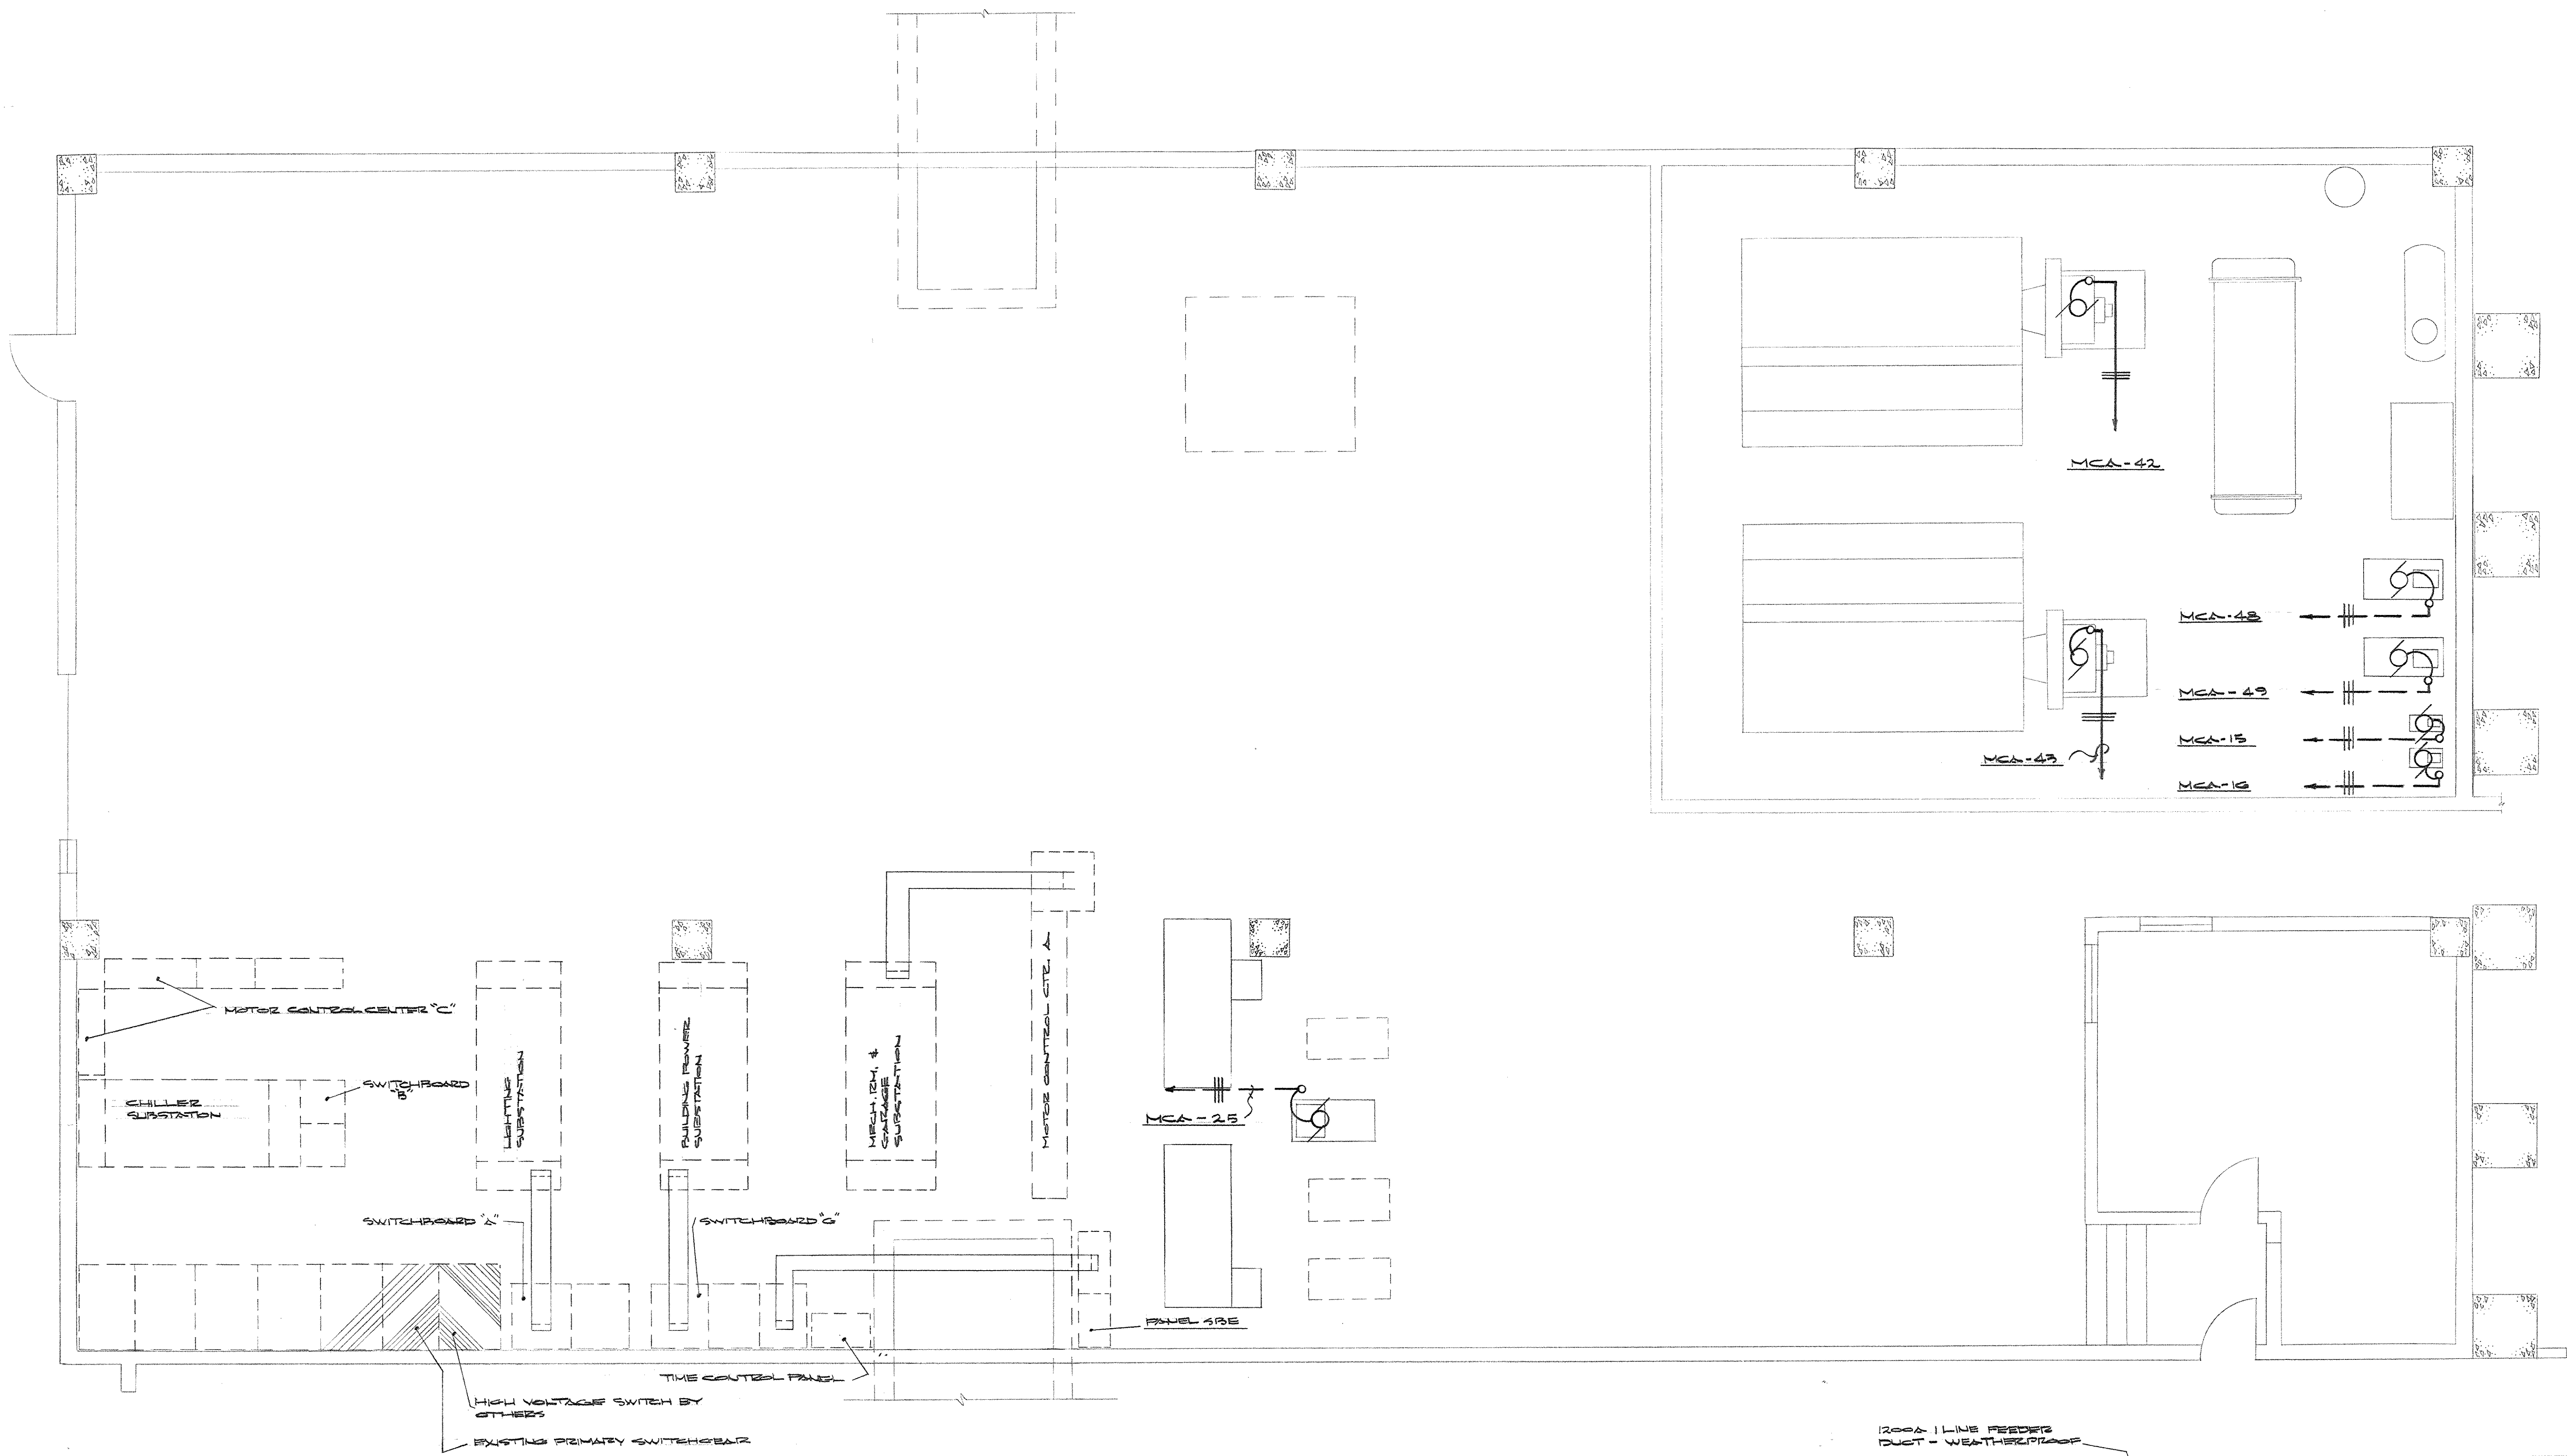

REVISIONS - ELECTRICAL PLAN MECHANICAL ROOM

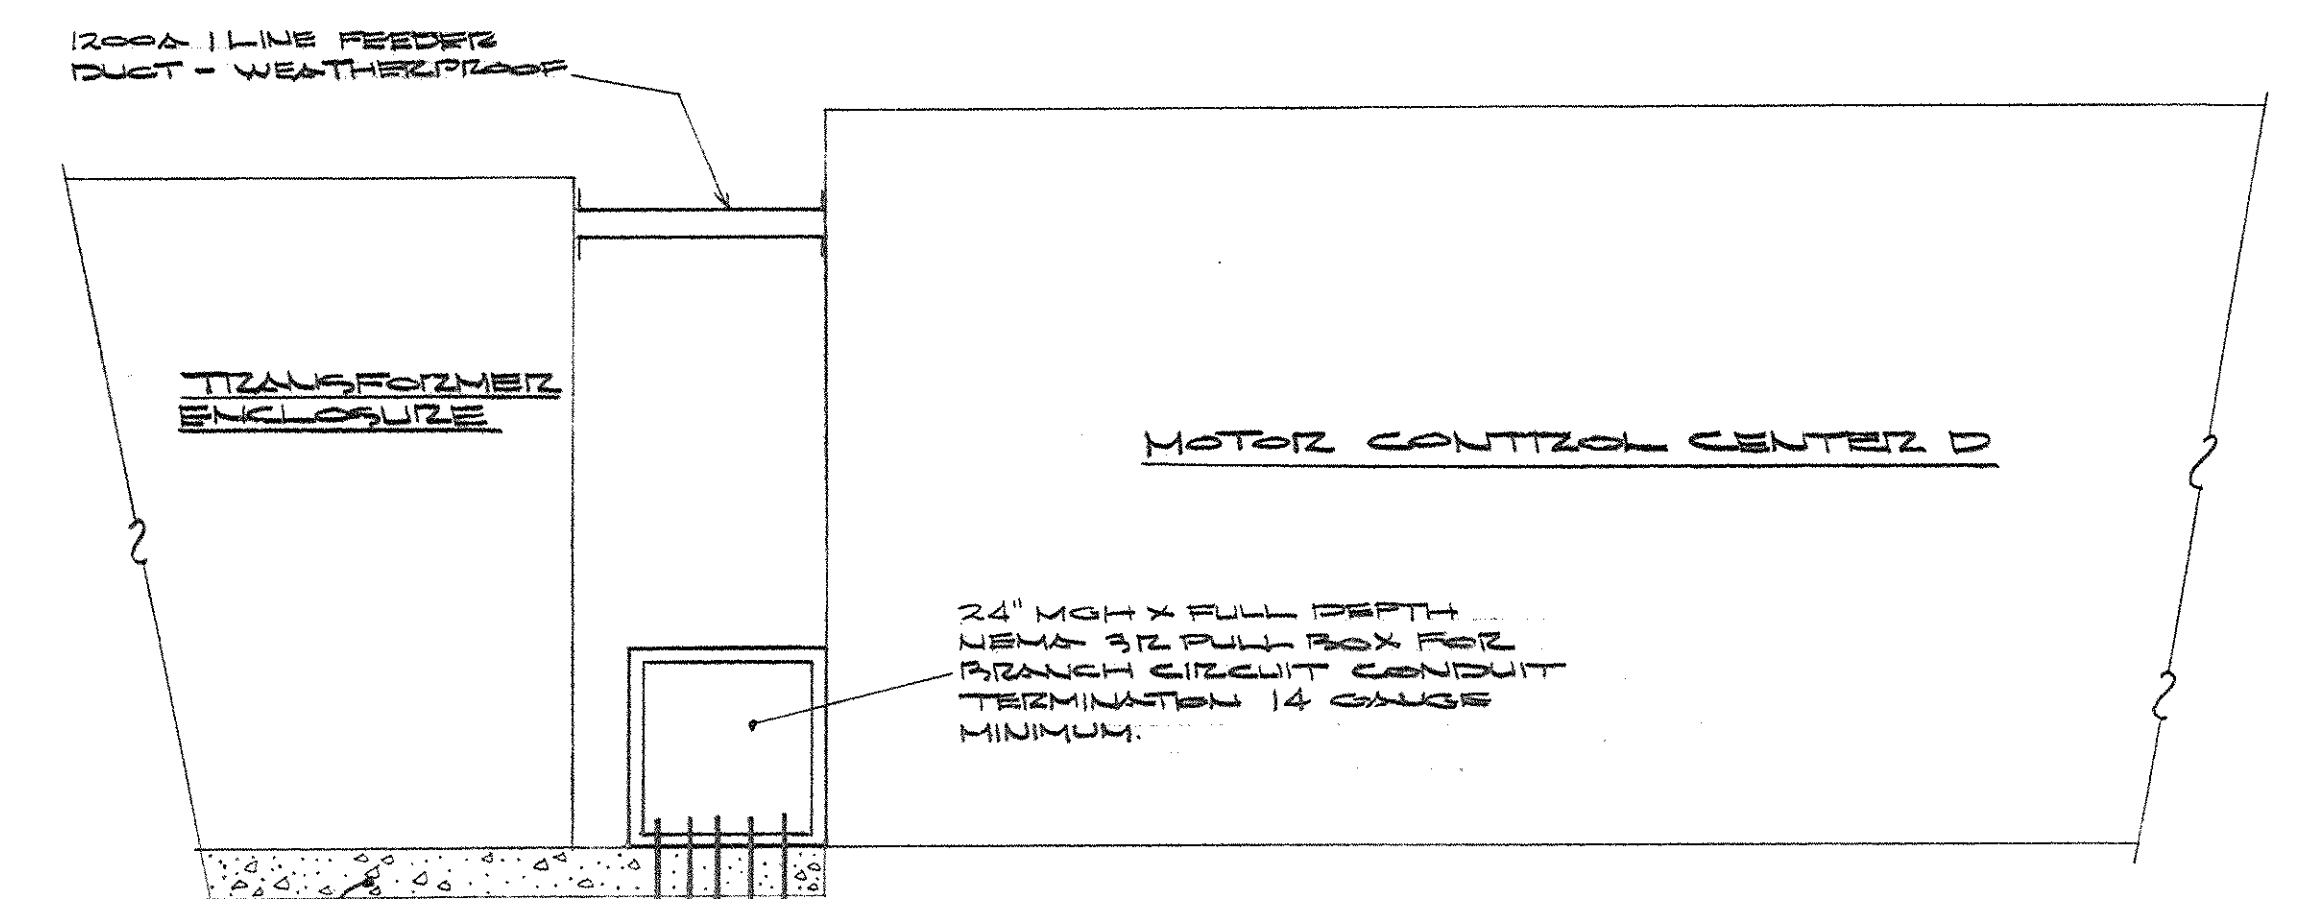


ELEVATION
SCALE: 1/2" = 1'-0"

AS-BUILT DRAWINGS
DATE: JAN 73
HUGG, CARTER & BLAKEMAN, INC.

11 JUN 68
CHANGE ORDER NO. 2

CAPITAL PLAZA OFFICE BUILDING
FRANKFORT, KENTUCKY


DRAWN BY FR. L.T.	ELECTRICAL PLAN - MECHANICAL ROOM	DATE JAN. 68
TRACED BY R.C.	ARCHITECT	SCALE NOTED
CHECKED BY FR. L.T.	EDWARD DURELL STONE 7 EAST 67TH STREET NEW YORK, N. Y.	COMM. NO. 80026
SECTOR NO.	ASSOCIATE ARCHITECTS & ENGINEERS LEE POTTER SMITH & ASSOCIATES 314 WILKINSON FRANKFORT, KENTUCKY	DRAWING NO. R 6 OF 7
APPROVED BY	ARCHITECT	DATE
APPROVED BY	AGENCY HEAD	DATE
APPROVED BY	OWNER	DATE

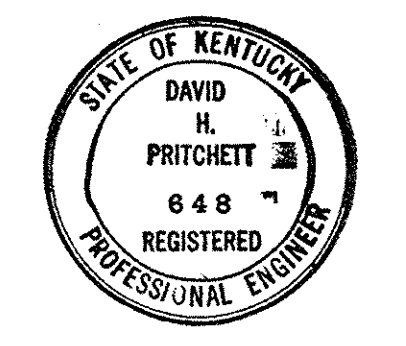


CPA-143F

TAG	DESCRIPTION	SWITCH	FUSE	STARTER	FEEDER #/OR REMARKS
1	N.C.	N.C.	N.C.		N.C.
2	SPACE ONLY				
3	N.C.	N.C.	N.C.		N.C.
4	N.C.	N.C.	N.C.		N.C.
5	N.C.	N.C.	N.C.		N.C.
6	N.C.	N.C.	N.C.		N.C.
7	N.C.	N.C.	N.C.		N.C.
8	N.C.	N.C.	N.C.		N.C.
9	N.C.	N.C.	N.C.		N.C.
10	N.C.	N.C.	N.C.		N.C.
11	N.C.	N.C.	N.C.		N.C.
12	N.C.	N.C.	N.C.		N.C.
13	N.C.	N.C.	N.C.		N.C.
14	N.C.	N.C.	N.C.		N.C.
15	SPACE				
16	FUEL PUMP N° 1				
17	FUEL PUMP N° 2				
18	N.C.	N.C.	N.C.		N.C.
19	N.C.	N.C.	N.C.		N.C.
20	N.C.	N.C.	N.C.		N.C.
21	N.C.	N.C.	N.C.		N.C.
22	N.C.	N.C.	N.C.		N.C.
23	N.C.	N.C.	N.C.		N.C.
24	N.C.	N.C.	N.C.		N.C.
25	PHASE II C.W. PUMP	3P20	30A	NEMA 2	3 N° 6'S - 1" C.
26	N.C.	N.C.	N.C.		N.C.
27	N.C.	N.C.	N.C.		N.C.
42	BOILER N° 1	3P20	45A		3 N° 6'S - 1" C.
43	BOILER N° 2	3P20	45A		3 N° 6'S - 1" C.
44	N.C.	N.C.	N.C.		N.C.
45	N.C.	N.C.	N.C.		N.C.
46	N.C.	N.C.	N.C.		N.C.
47	N.C.	N.C.	N.C.		N.C.
48	PHASE II H.W. PUMP	3P20	45A	NEMA 2	3 N° 6'S - 1" C.
49	PHASE II H.W. PUMP (STANDBY)	3P20	45A	NEMA 2	3 N° 6'S - 1" C.
50	N.C.	N.C.	N.C.		N.C.

* - N.C. INDICATES NO CHANGE FROM ORIGINAL CONTRACT DOCUMENTS.

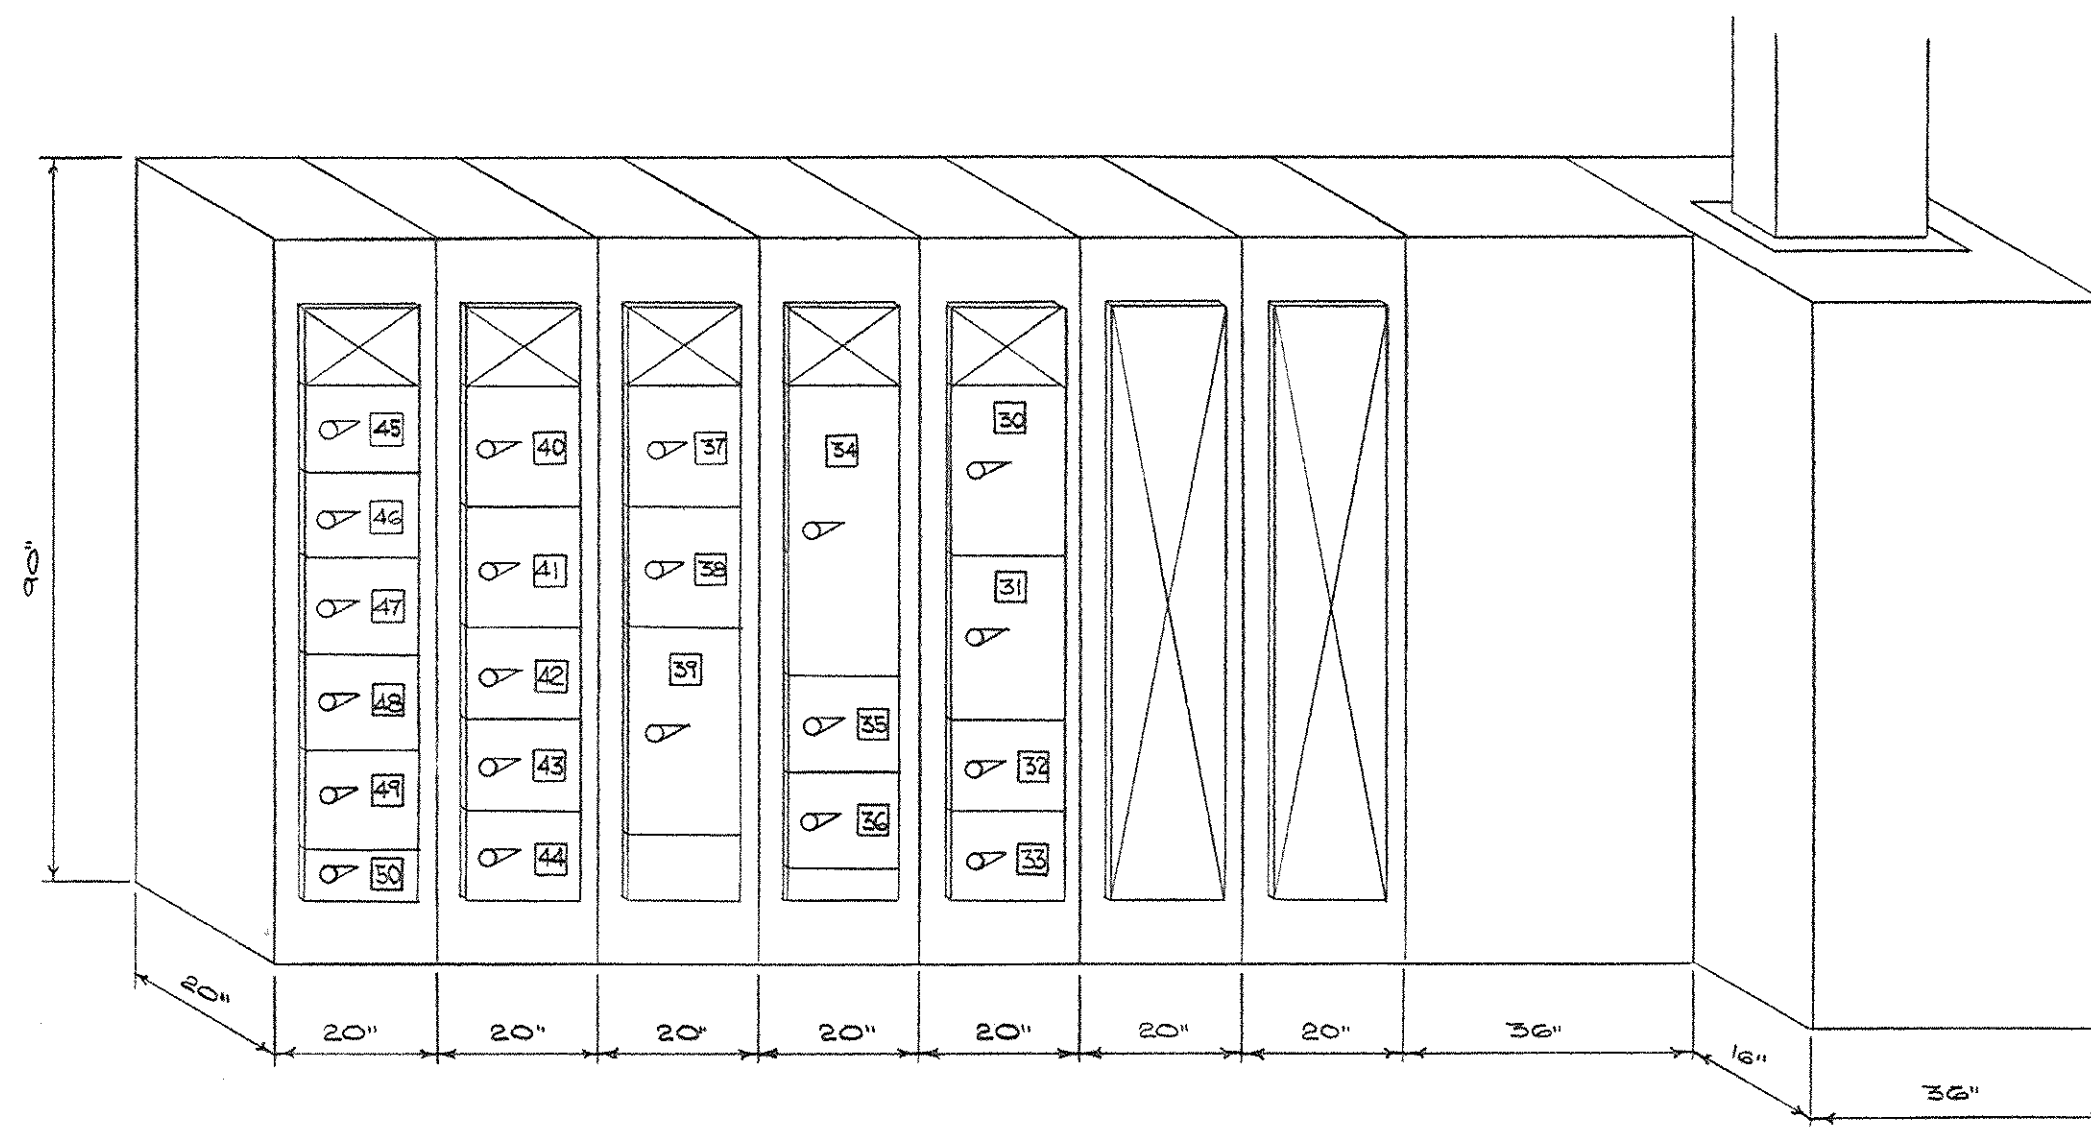


REAR ELEVATION

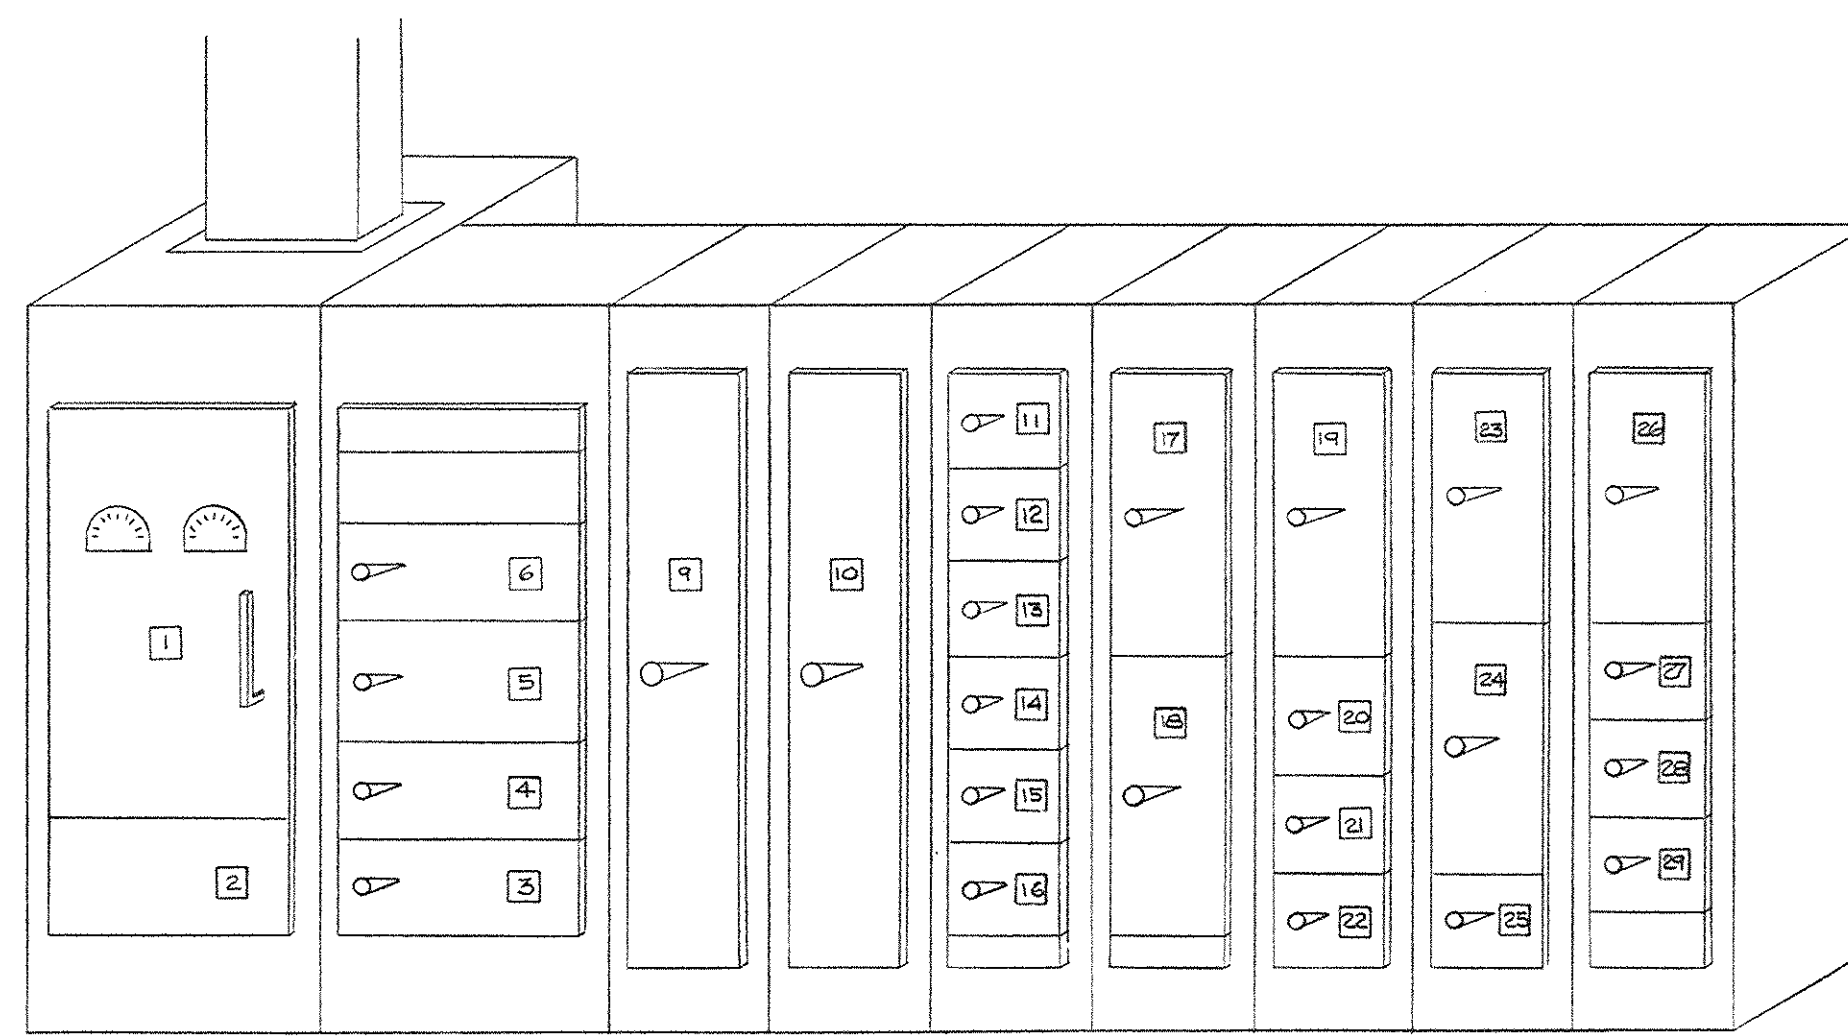

FRONT ELEVATION

VOLTMETER 0-600V W/PHASE SELECTOR AMMETER 0-5000A W/PHASE SELECTOR

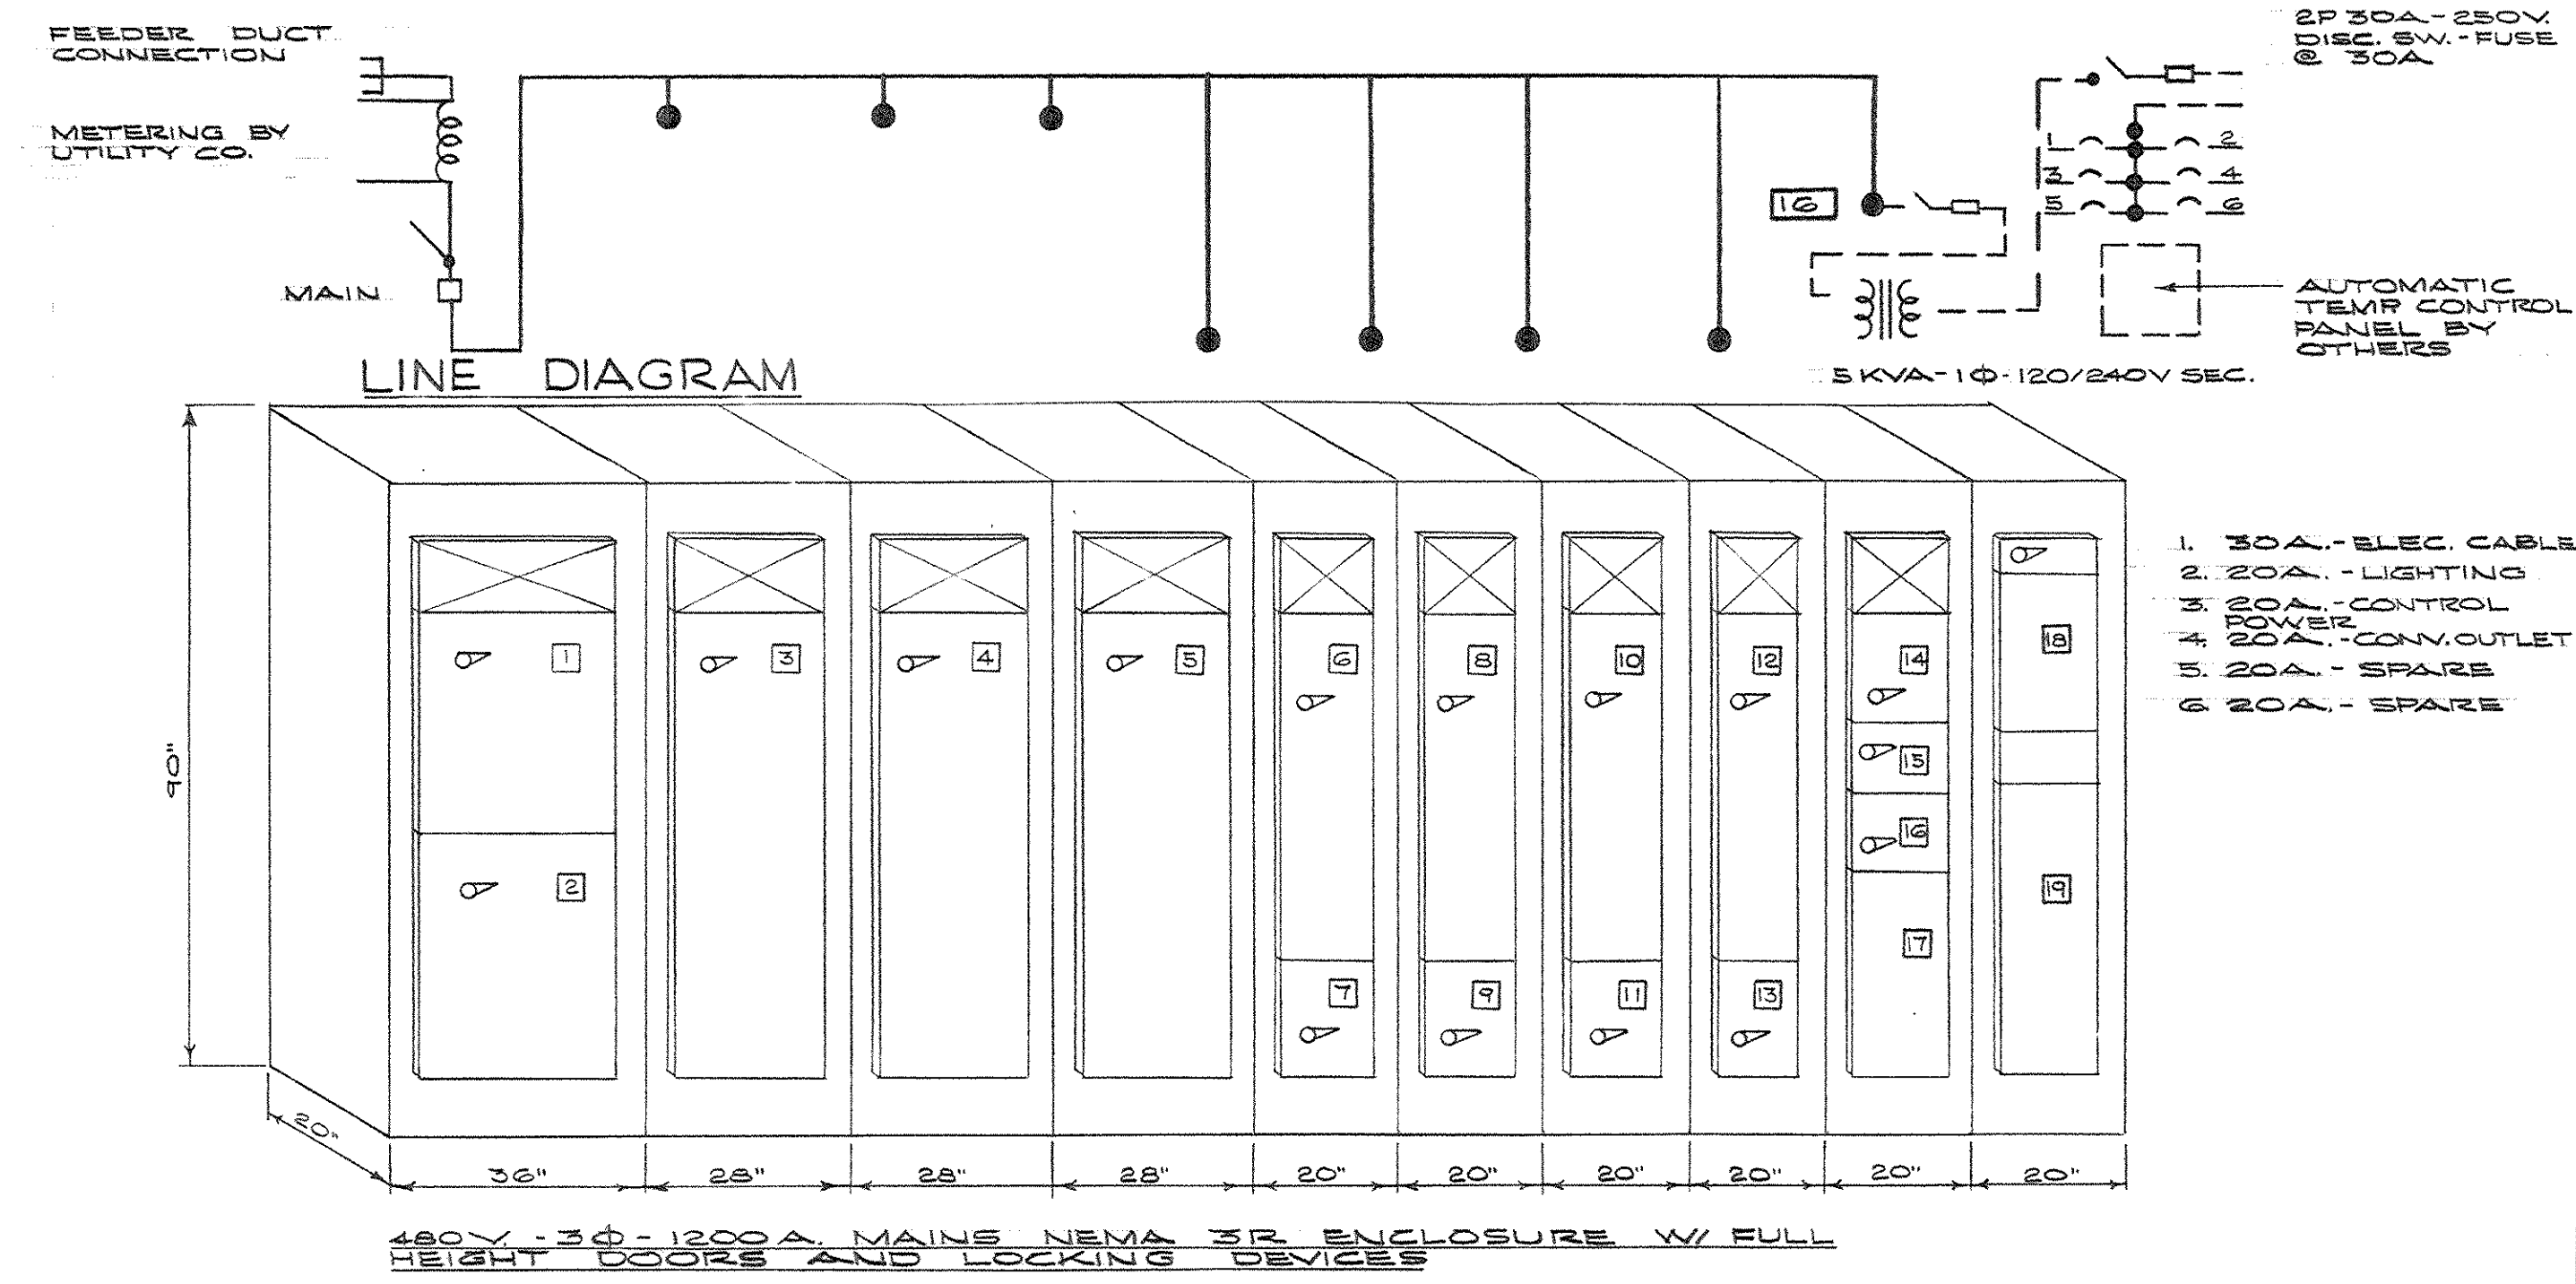


MOTOR CONTROL CENTER "D"

TAG	DESCRIPTION	SWITCH	FUSE	STARTER	FEEDER #/OR REMARKS
1	METERING				SEE LINE DIAGRAM
2	SECONDARY MAIN	3P1200A	1200A		BOLT LOCK SWITCH
3	TOWER PUMP N° 1	3P400	250A	NEMA4PW	6 N° 250 MCM THW-3 1/2" C
4	TOWER PUMP N° 2	3P400	250A	NEMA4PW	6 N° 250 MCM THW-3 1/2" C
5	TOWER PUMP N° 3	3P400	250A	NEMA4PW	6 N° 250 MCM THW-3 1/2" C
6	TOWER FAN N° 1	3P20	45A	NEMA 1	6 N° 6'S - 1 1/2" C. (SEE NOTE 2)
7	SUMP HTR. N° 1	3P30	30A	30A CONTACTOR	3 N° 10'S - 3/4" C.
8	TOWER FAN N° 2	3P20	45A	NEMA 1	6 N° 6'S - 1 1/2" C. (SEE NOTE 2)
9	SUMP HTR. N° 2	3P30	30A	30A CONTACTOR	3 N° 10'S - 3/4" C.
10	TOWER FAN N° 3	3P20	45A	NEMA 1	6 N° 6'S - 1 1/2" C. (SEE NOTE 2)
11	SUMP HTR. N° 3	3P30	30A	30A CONTACTOR	3 N° 10'S - 3/4" C.
12	TOWER FAN N° 4	3P20	45A	NEMA 1	6 N° 6'S - 1 1/2" C.
13	SUMP HTR. N° 4	3P30	30A	30A CONTACTOR	3 N° 10'S - 3/4" C.
14	SUMP HTR. N° 5	3P30	30A	30A CONTACTOR	3 N° 10'S - 3/4" C.
15	SPACE				
16	LIGHTING	2P30	15A*		* LIMITRON
17	TRANSFORMER				SEE DIAGRAM
18	120/240 VOLT PANEL				SEE DIAGRAM
19	AUTOMATIC TEMP CONTROL				SPACE ONLY-NO BUSSING

NOTES:
 1. ORIGINAL CONTRACT SPECIFICATIONS SHALL REMAIN VALID AS TO CONSTRUCTION PLATES TRANSFORMERS H.O.A. SWITCHES ETC.
 2. STARTERS 6, 8 & 10 SHALL BE TWO SPEED FOR SINGLE WINDING CONSEQUENTLY FOLLOWS MOTORS WITH SUIT IN TIME DELAY (30 SEC.) BETWEEN SPEED TRANSITION IN BOTH DIRECTIONS.

MOTOR CONTROL CENTER "A" - MECHANICAL ROOM - PANEL "MCA"

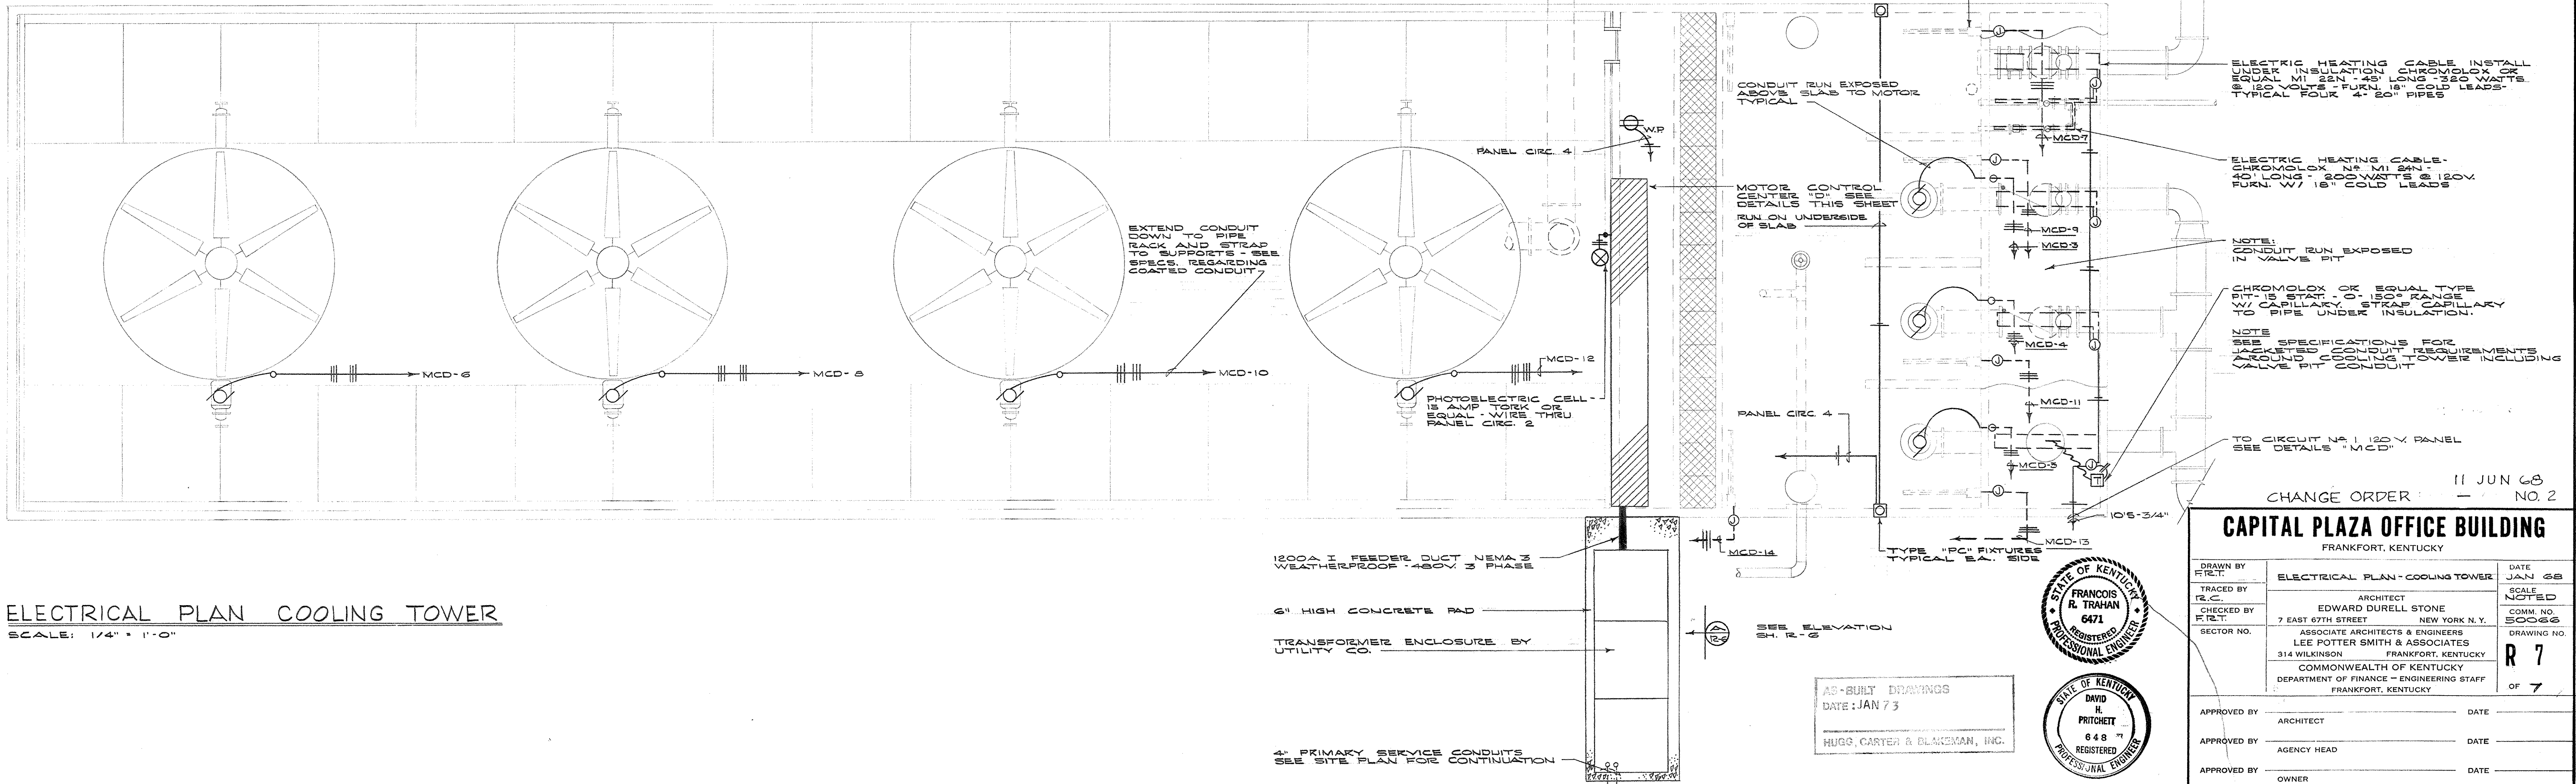


ELECTRICAL PLAN COOLING TOWER

SCALE: 1/4" = 1'-0"


CHANGE ORDER: 11 JUN 68 NO. 2
CAPITAL PLAZA OFFICE BUILDING
 FRANKFORT, KENTUCKY

DRAWN BY F.R.T.	ELECTRICAL PLAN - COOLING TOWER	DATE JAN 68
TRACED BY F.R.C.	ARCHITECT EDWARD DURELL STONE	SCALE NOTED
CHECKED BY F.R.T.	7 EAST 67TH STREET NEW YORK N. Y.	COMM. NO. 50026
SECTOR NO.	ASSOCIATE ARCHITECTS & ENGINEERS LEE ROTTER SMITH & ASSOCIATES 314 WILKINSON FRANKFORT, KENTUCKY	DRAWING NO. R 7
APPROVED BY	ARCHITECT	DATE
APPROVED BY	AGENCY HEAD	DATE
APPROVED BY	OWNER	DATE

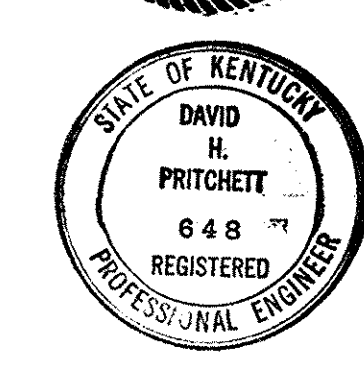


AS-BUILT DRAWINGS
 DATE: JAN 73
 HUGO, CARTER & BLANKMAN, INC.

CPA-148G


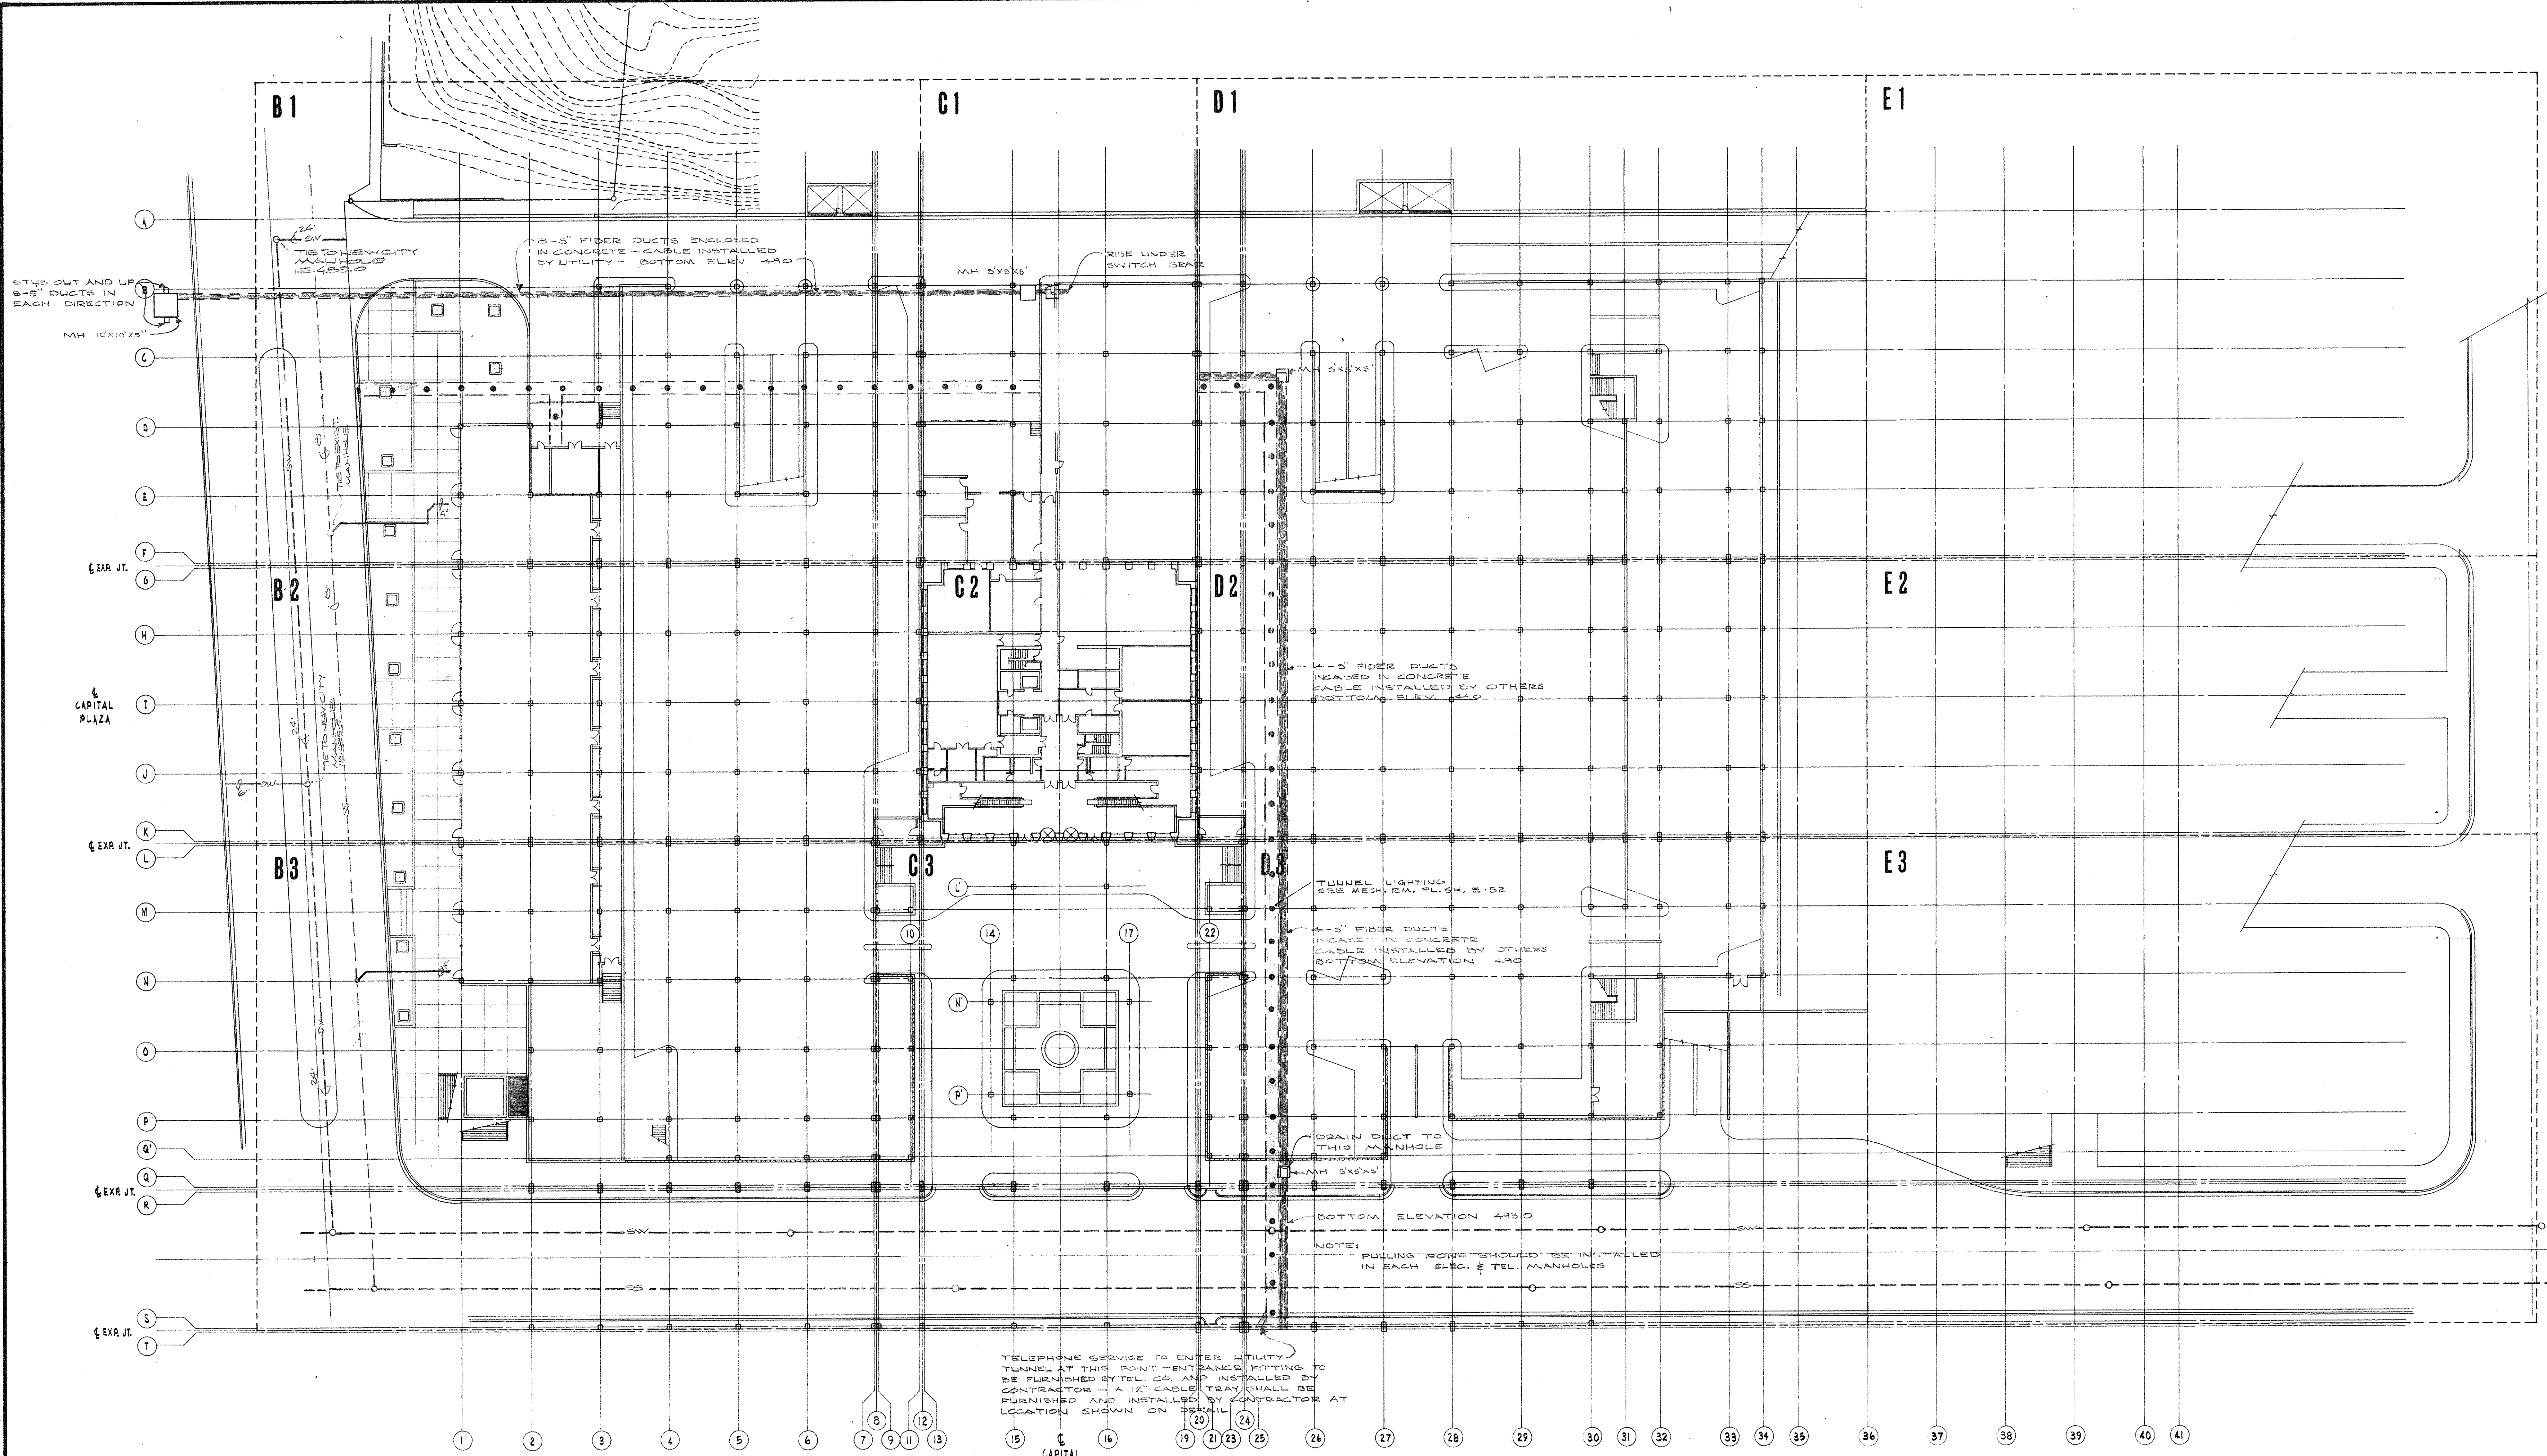




SECTOR MASTER - GROUND LEVEL
SCALE 1"=30'-0"

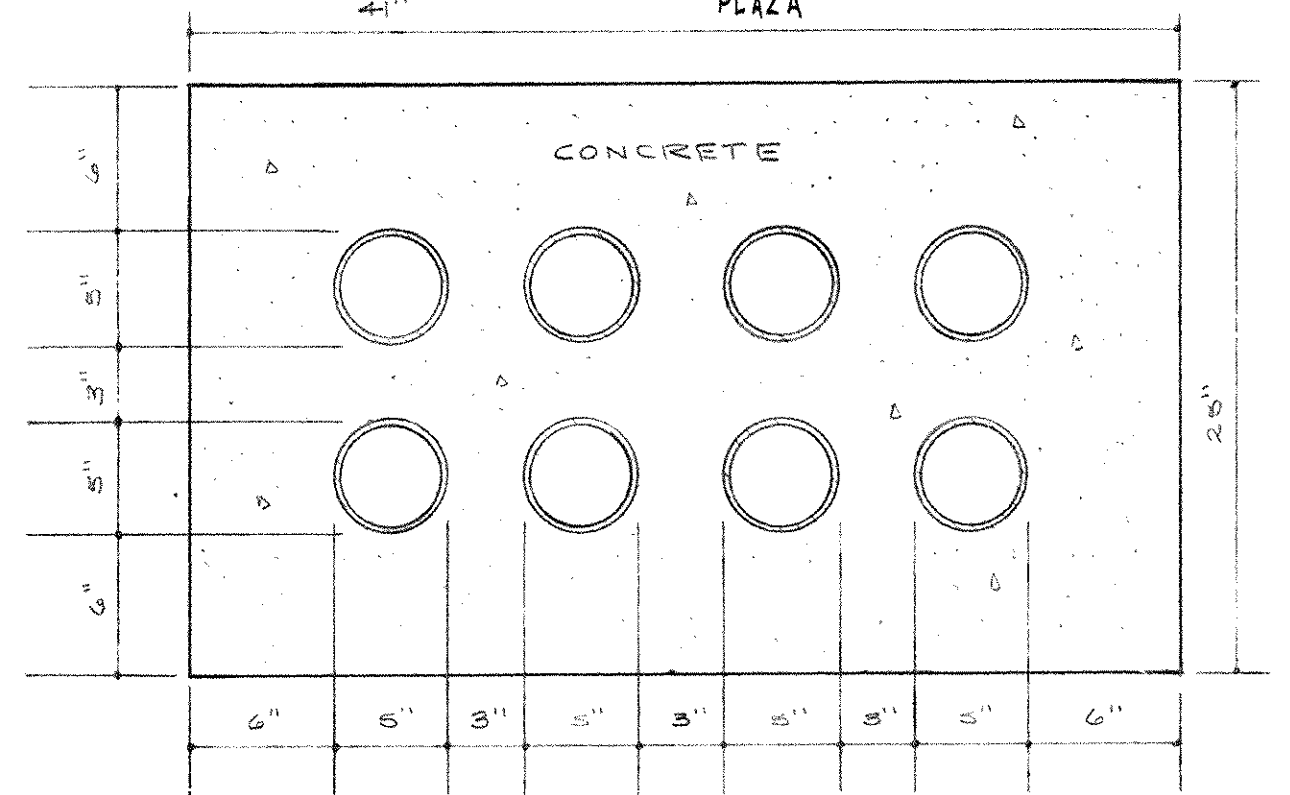

FIBER DUCT INSTALLATION
DETAIL: 3/8"=1'-0"

CAPITAL PLAZA OFFICE BUILDING FRANKFORT, KENTUCKY		
DRAWN BY	DAVID R. PRITCHETT	DATE: 12, MAY 1967
CHECKED BY	EDWARD DURELL STONE	SCALE: AS SHOWN
SECTOR NO.	7 EAST 6TH STREET FRANKFORT, KENTUCKY	COMM. NO. 648
	ASSOCIATE ARCHITECTS & ENGINEERS LEE POTTER SMITH & ASSOCIATES 314 WILKINSON FRANKFORT, KENTUCKY	DRAWING NO. U 1
APPROVED BY	ARCHITECT	DATE
APPROVED BY	AGENCY HEAD	DATE: MAY 24 1967
APPROVED BY	OWNER	DATE

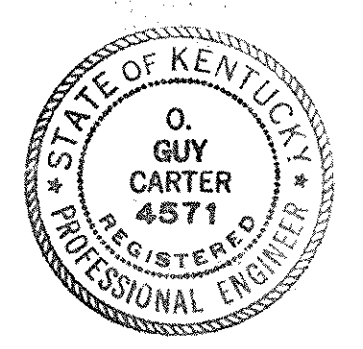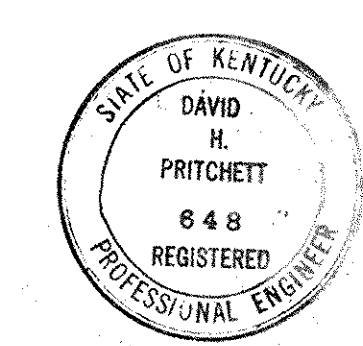


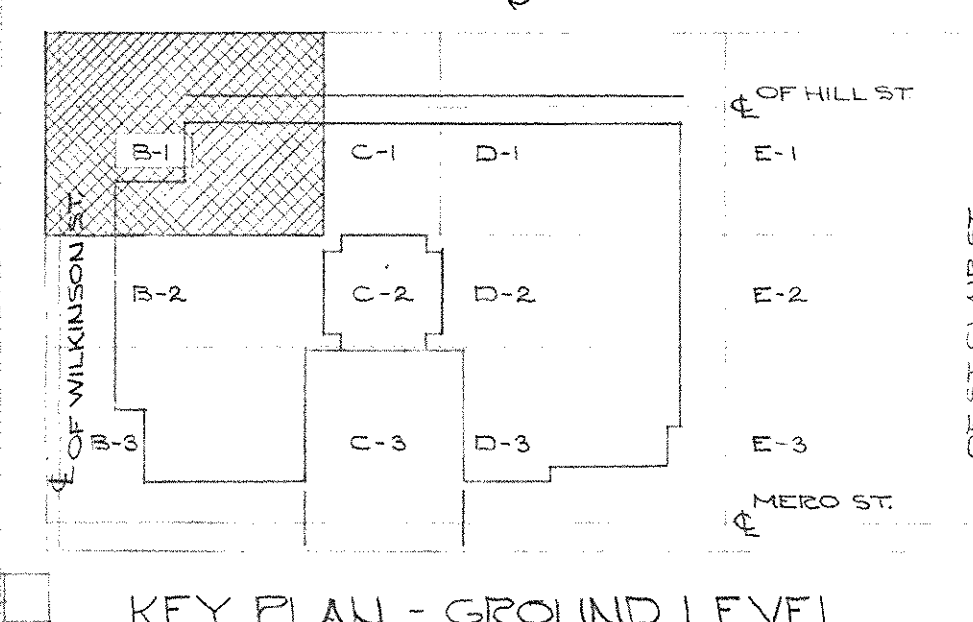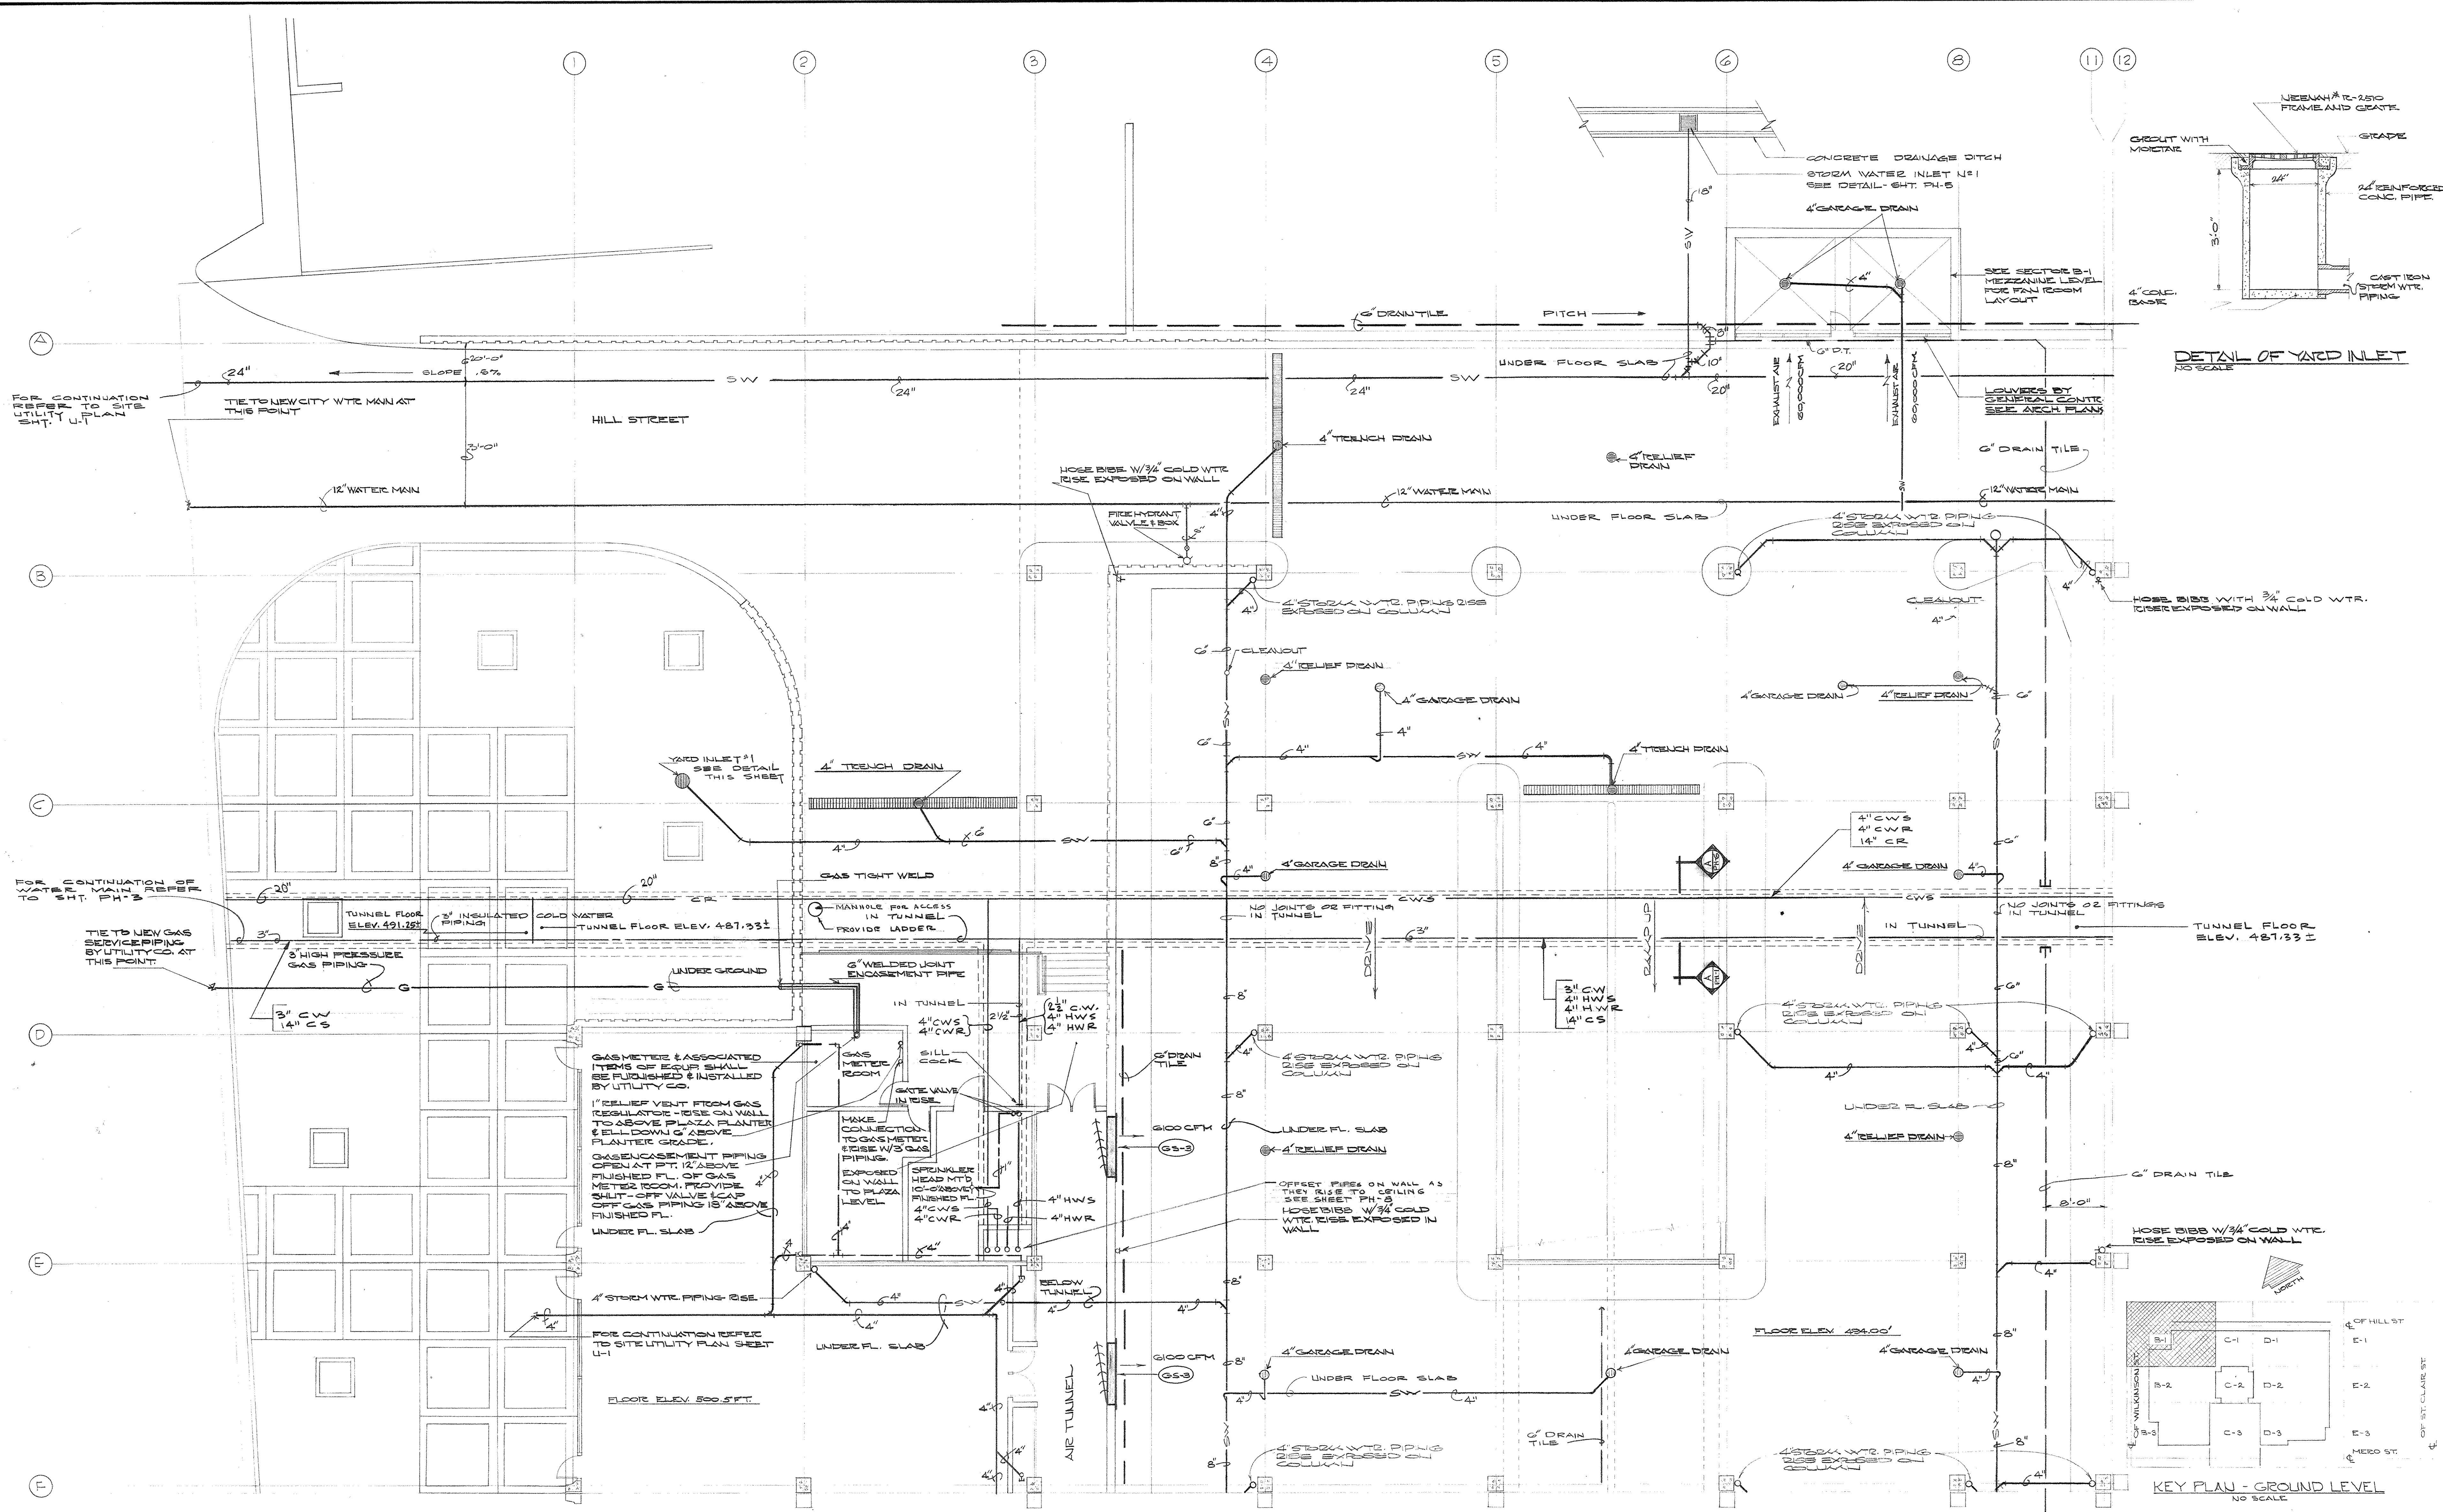


PLUMBING AND VENTILATING PLAN - GROUND LEVEL - SECTOR B-1
SCALE 1/8\"/>


NOTE
MECHANICAL ROOMS SUPPLEMENTED BY THE INCLUSION
OF THE FOLLOWING:
1 CHANGE ORDER DWS, NPG ITEM #2 DATED 27 FEB 67

CAPITAL PLAZA OFFICE BUILDING FRANKFORT, KENTUCKY		
DRAWN BY S.M.	PLUMBING AND VENTILATING PLAN - GROUND LEVEL - SECTOR B-1	DATE 15 MAY, 1967
TRACED BY S.M.	ARCHITECT EDWARD DURELL STONE	SCALE AS NOTED
CHECKED BY D.S.C.	7 EAST 67TH STREET NEW YORK, N. Y.	CONTR. NO. 5785 G.S.
SECTOR NO. B 1	ASSOCIATE ARCHITECTS & ENGINEERS LEE POTTER SMITH & ASSOCIATES 314 WILKINSON FRANKFORT, KENTUCKY	DRAWING NO. PH 31 OF PH-31
APPROVED BY ARCHITECT	DATE	
APPROVED BY AGENCY HEAD	DATE	MAY 24 1967
APPROVED BY OWNER	DATE	

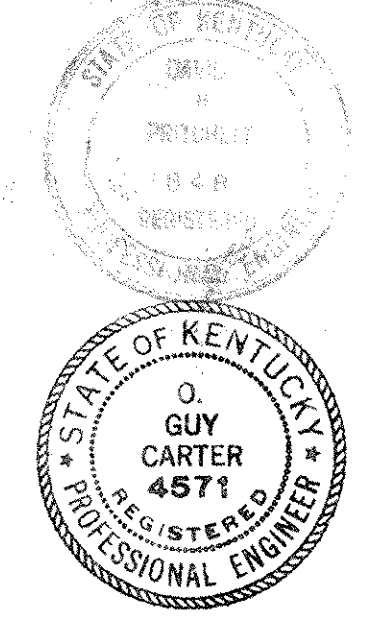


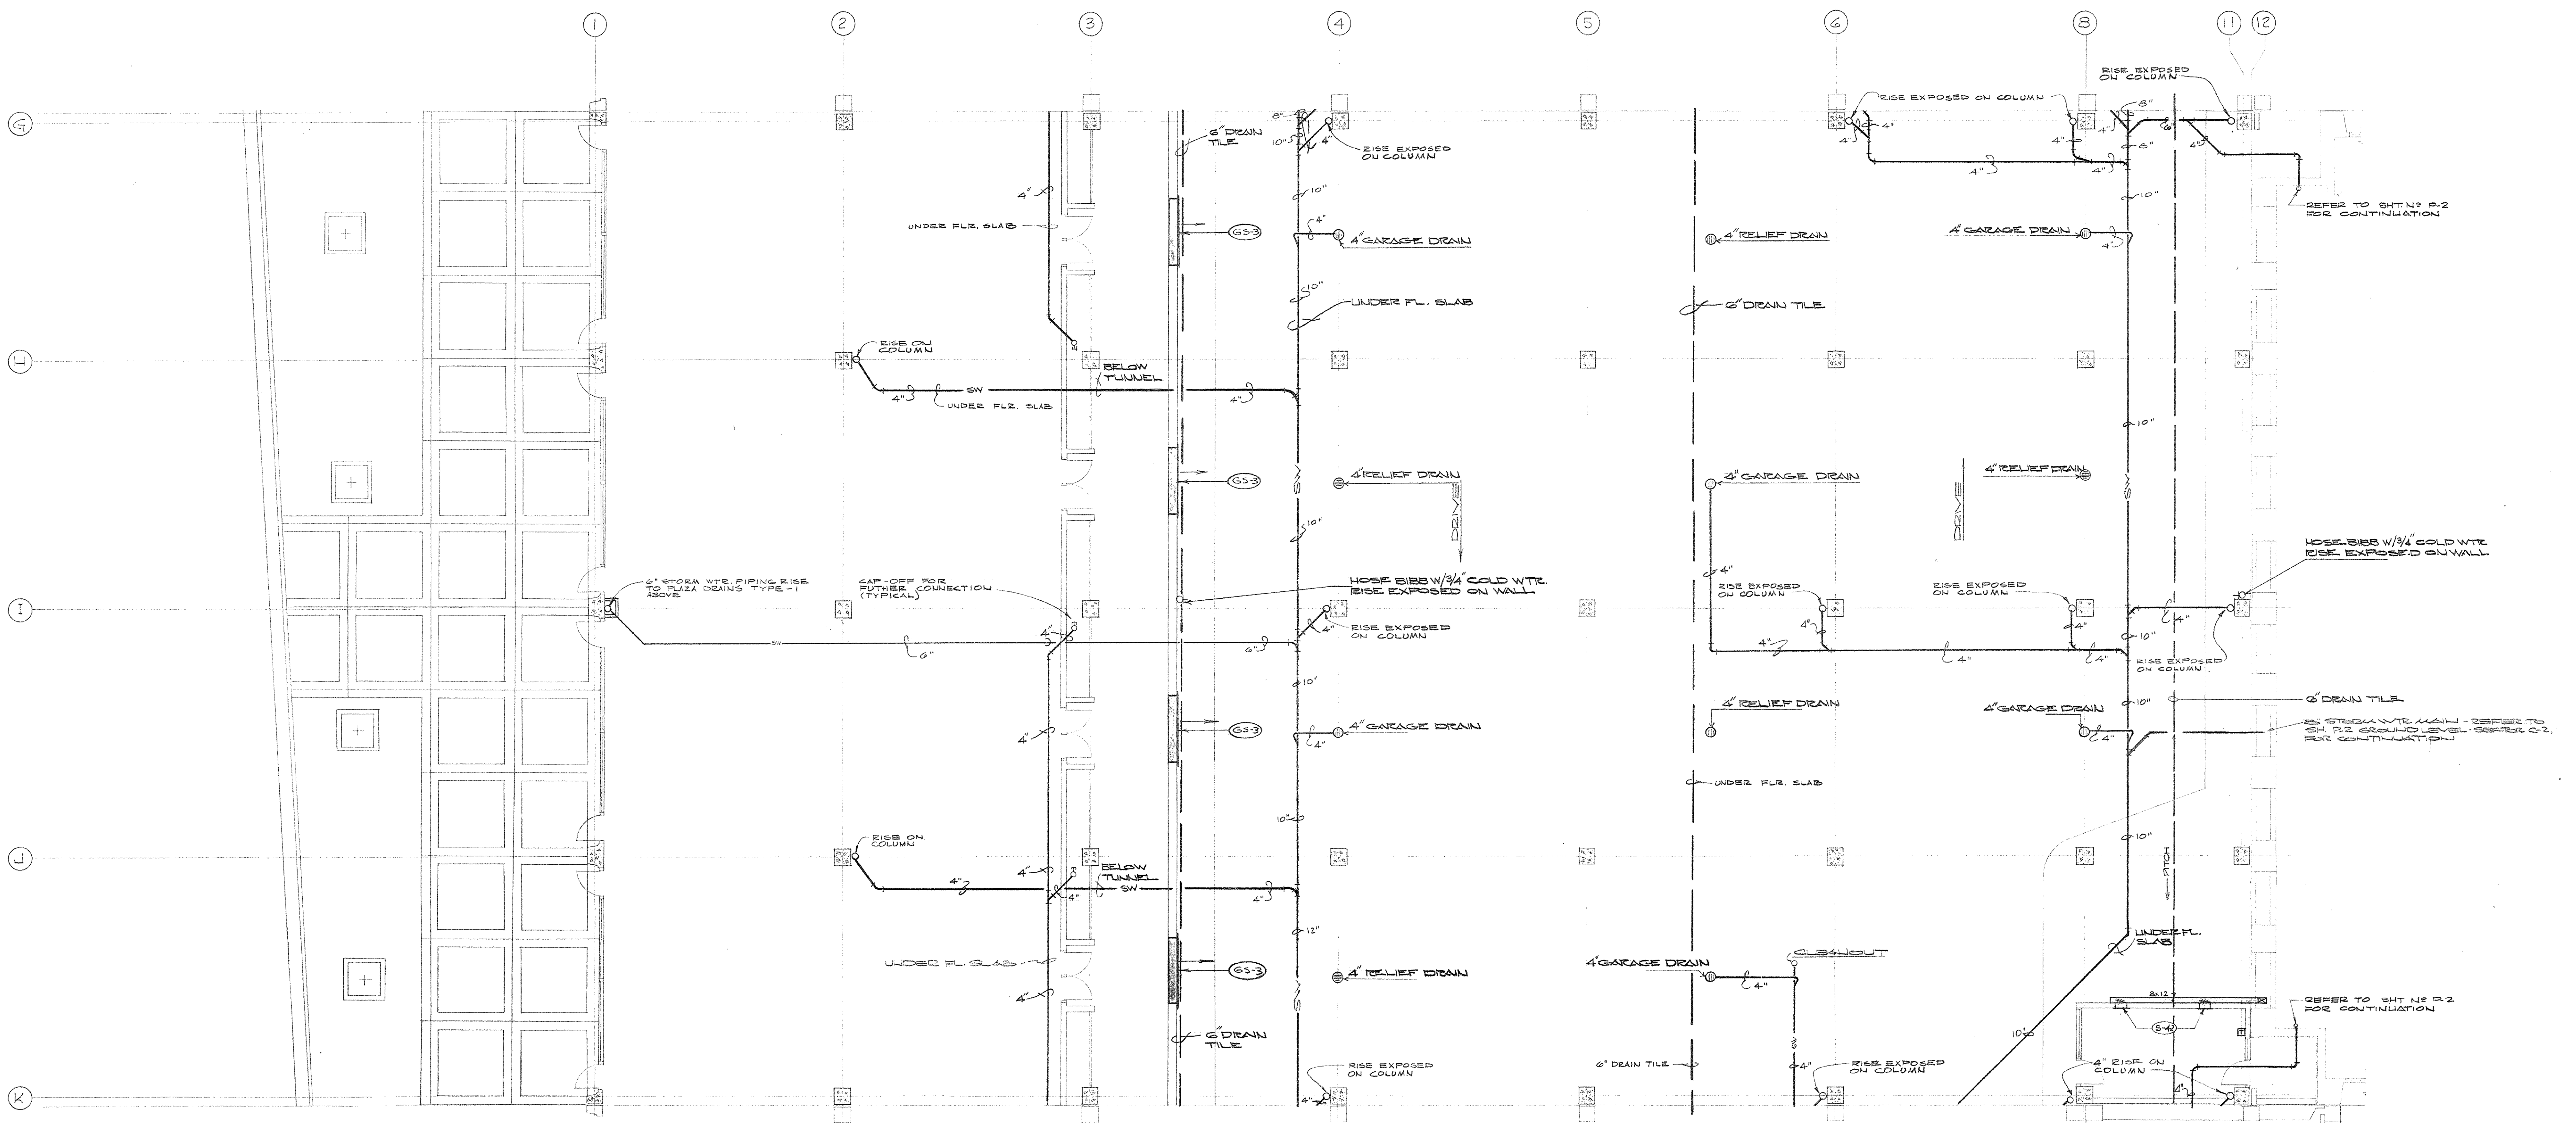


PLUMBING AND VENTILATING PLAN - GROUND LEVEL - SECTOR B-2
SCALE - 1/8" = 1'-0"

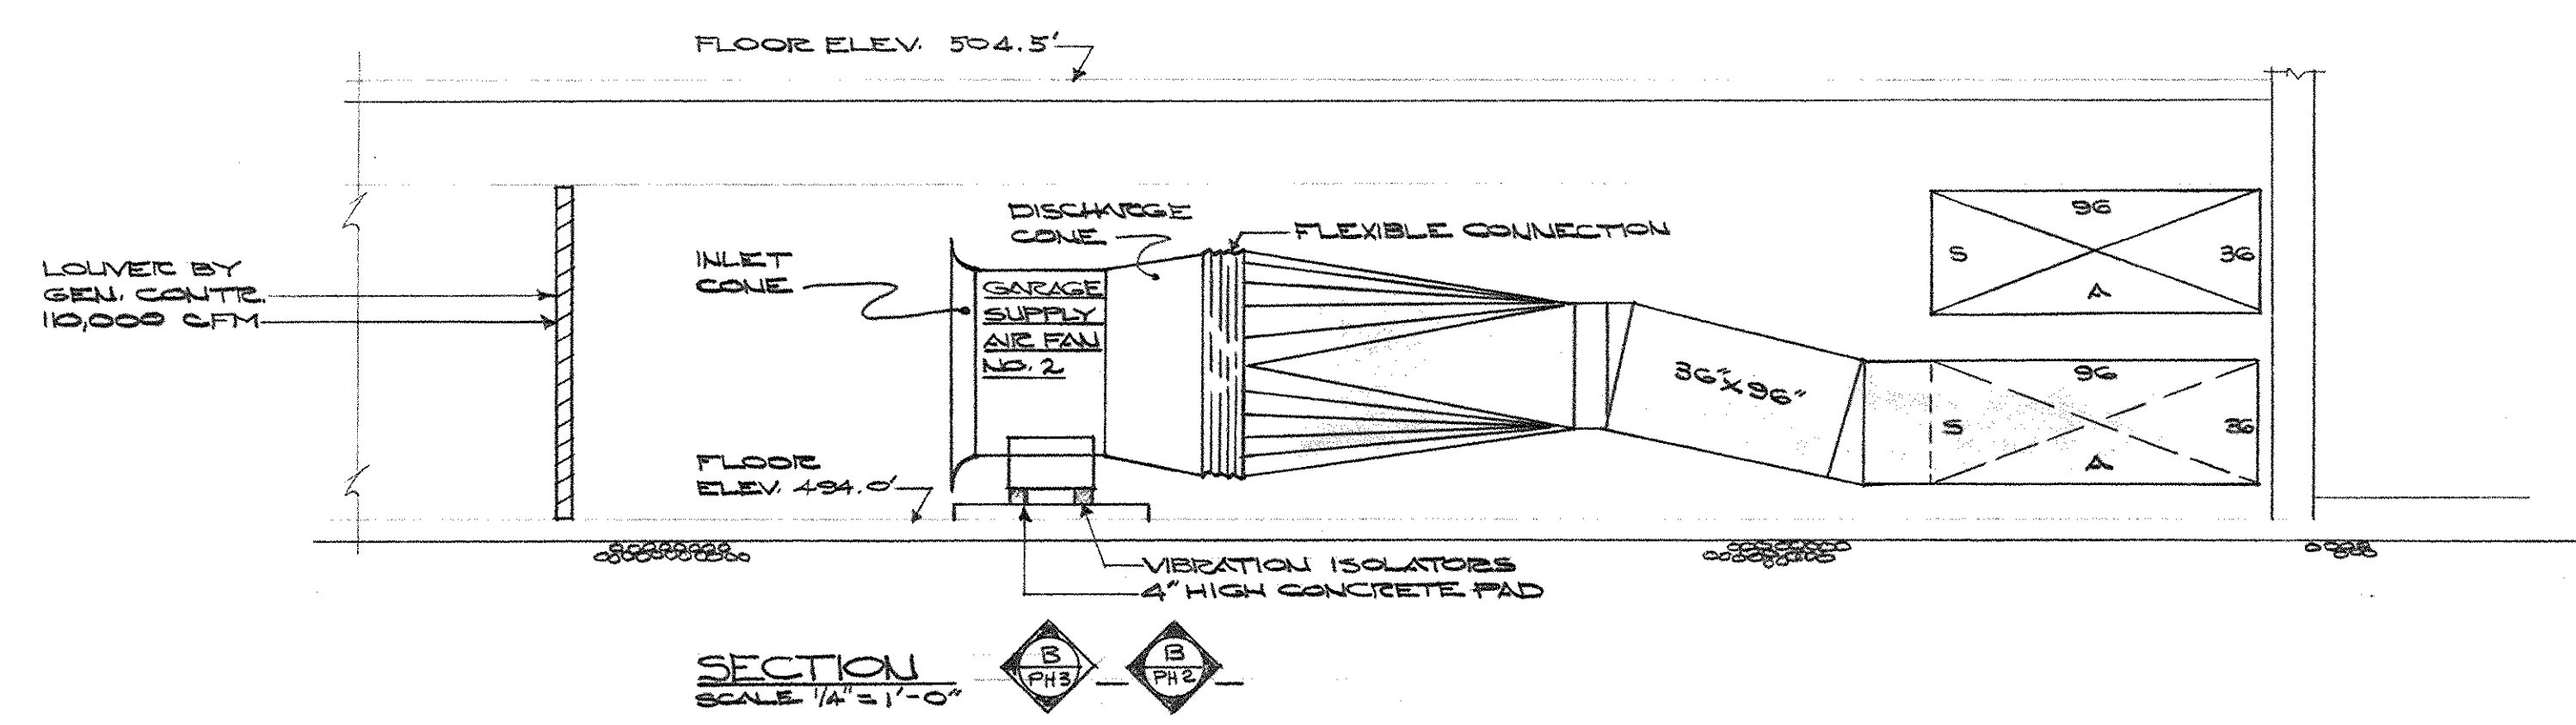

SECTION
SCALE 1/4" = 1'-0"

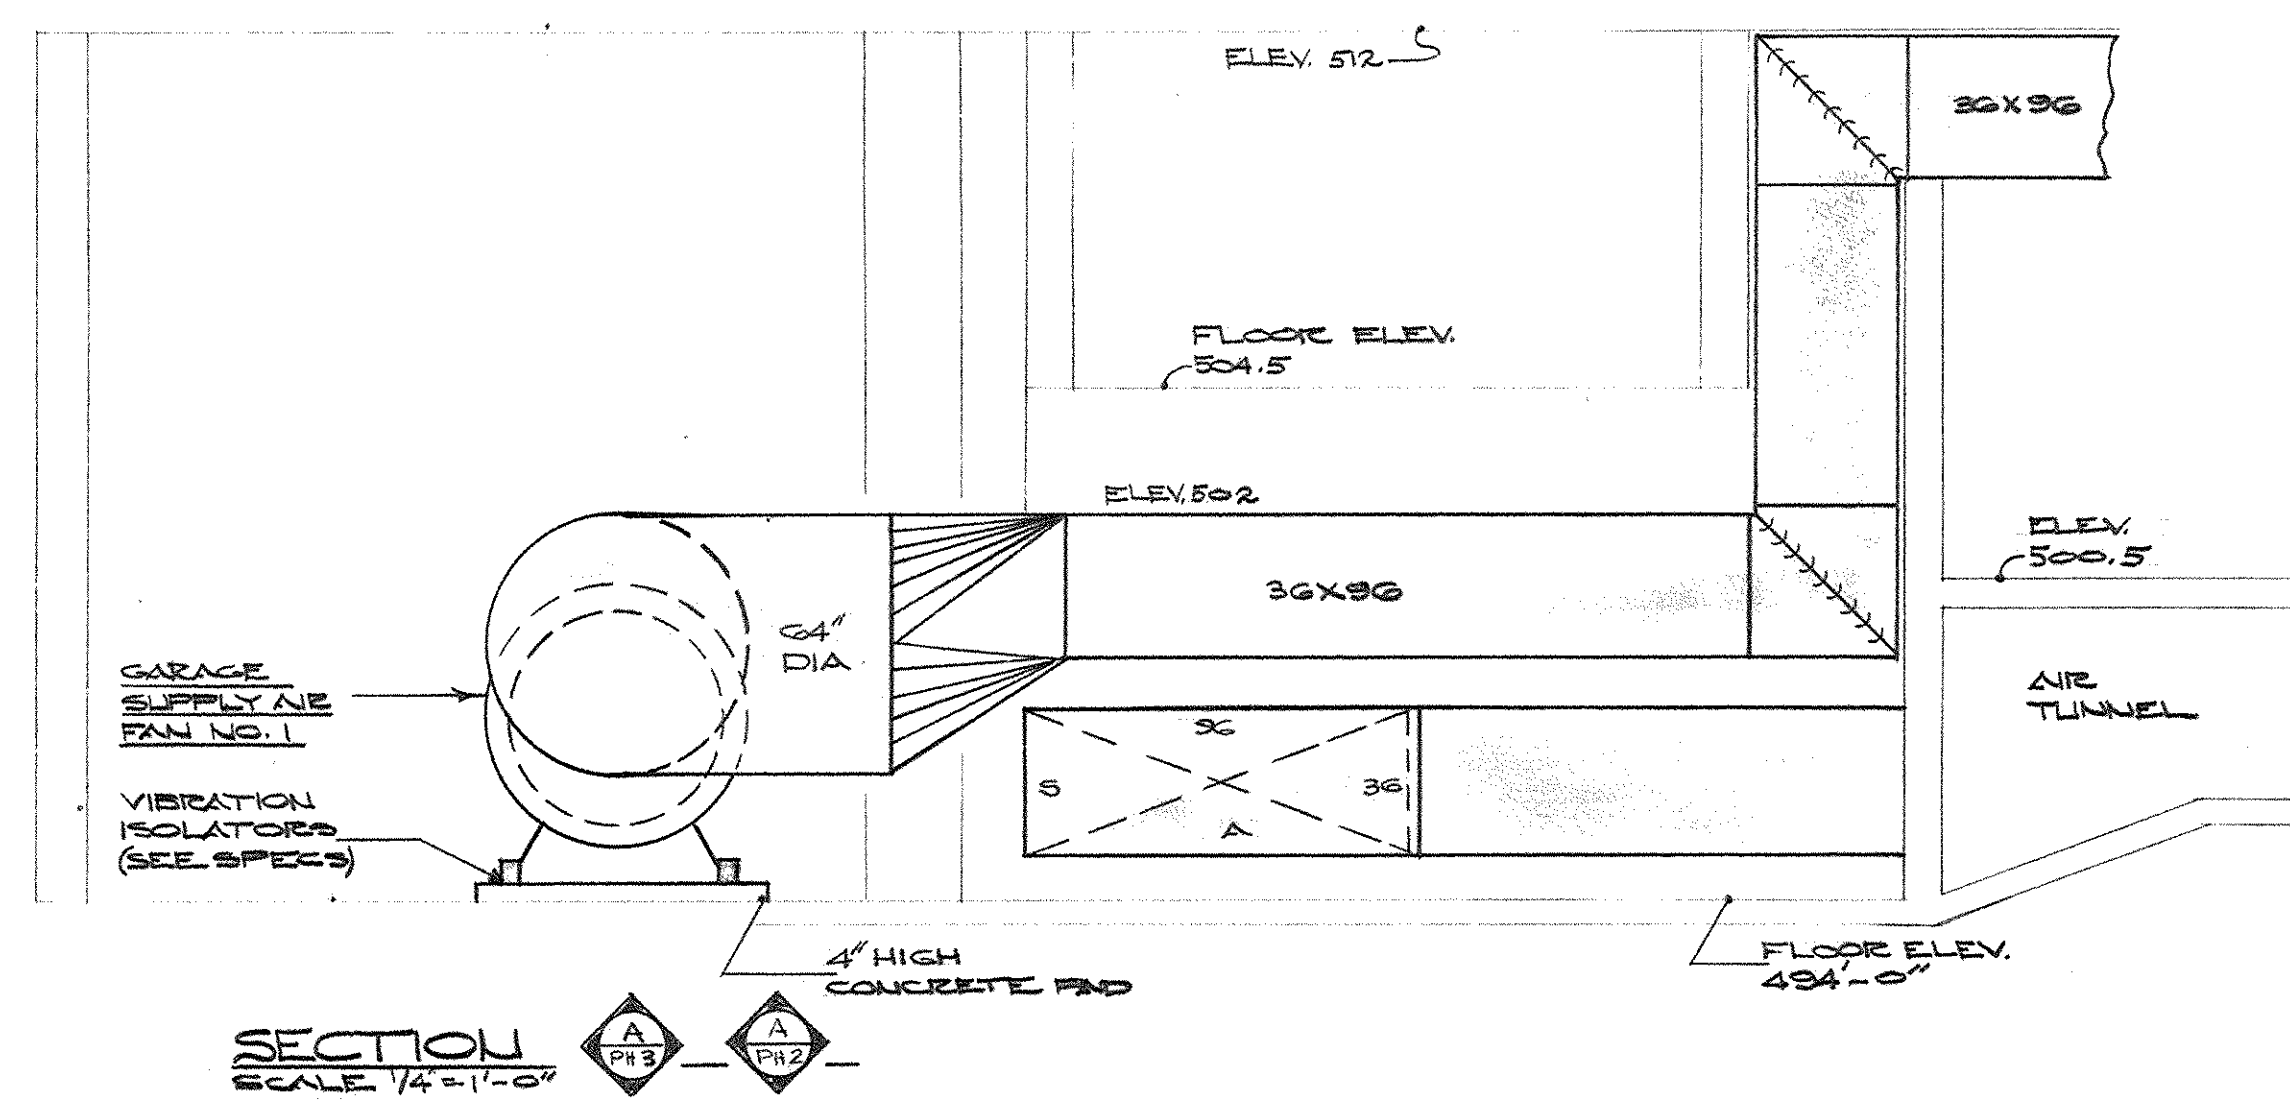



SECTION
SCALE 1/4" = 1'-0"

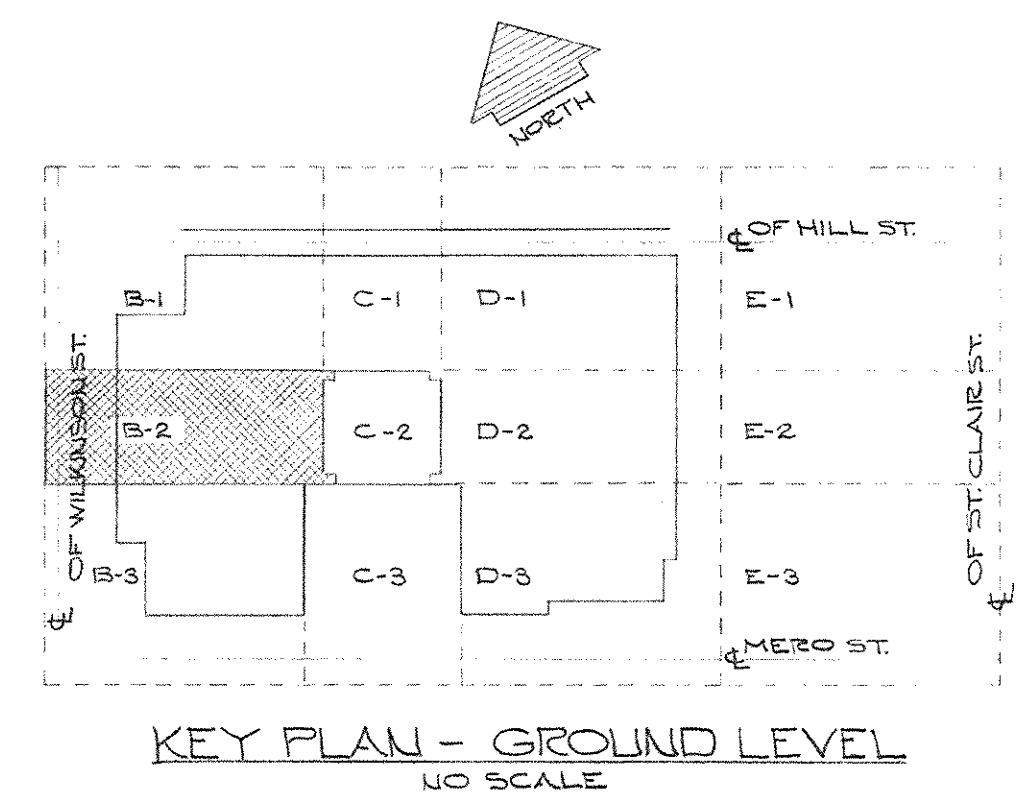


CAPITAL PLAZA OFFICE BUILDING
FRANKFORT, KENTUCKY

DRAWN BY D.S.C. & D.S.	PLUMBING AND VENTILATING PLAN GROUND LEVEL - SECTOR B-2	DATE 15, MAY, 1967
TRACED BY D.S.	ARCHITECT	SCALE 1/8" = 1'-0"
CHECKED BY O.G.C.	EDWARD DURELL STONE 7 EAST 6TH STREET NEW YORK, N. Y.	COMM. NO. 80266
SECTOR NO. B 2	ASSOCIATE ARCHITECTS & ENGINEERS LEE POTTER SMITH & ASSOCIATES 314 WILKINSON FRANKFORT, KENTUCKY	DRAWING NO. PH 2 OF PH-31
DEPARTMENT OF FINANCE - ENGINEERING STAFF FRANKFORT, KENTUCKY		


APPROVED BY ARCHITECT	DATE
APPROVED BY AGENCY HEAD	DATE
APPROVED BY OWNER	DATE

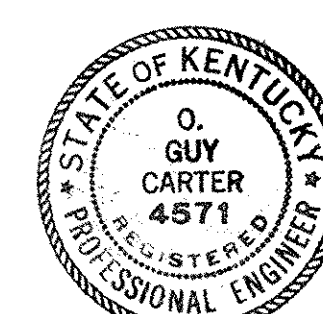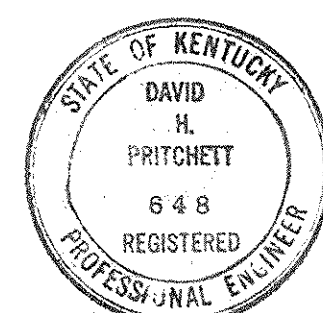

W. C. COLETT & BLANKENHORN, INC.

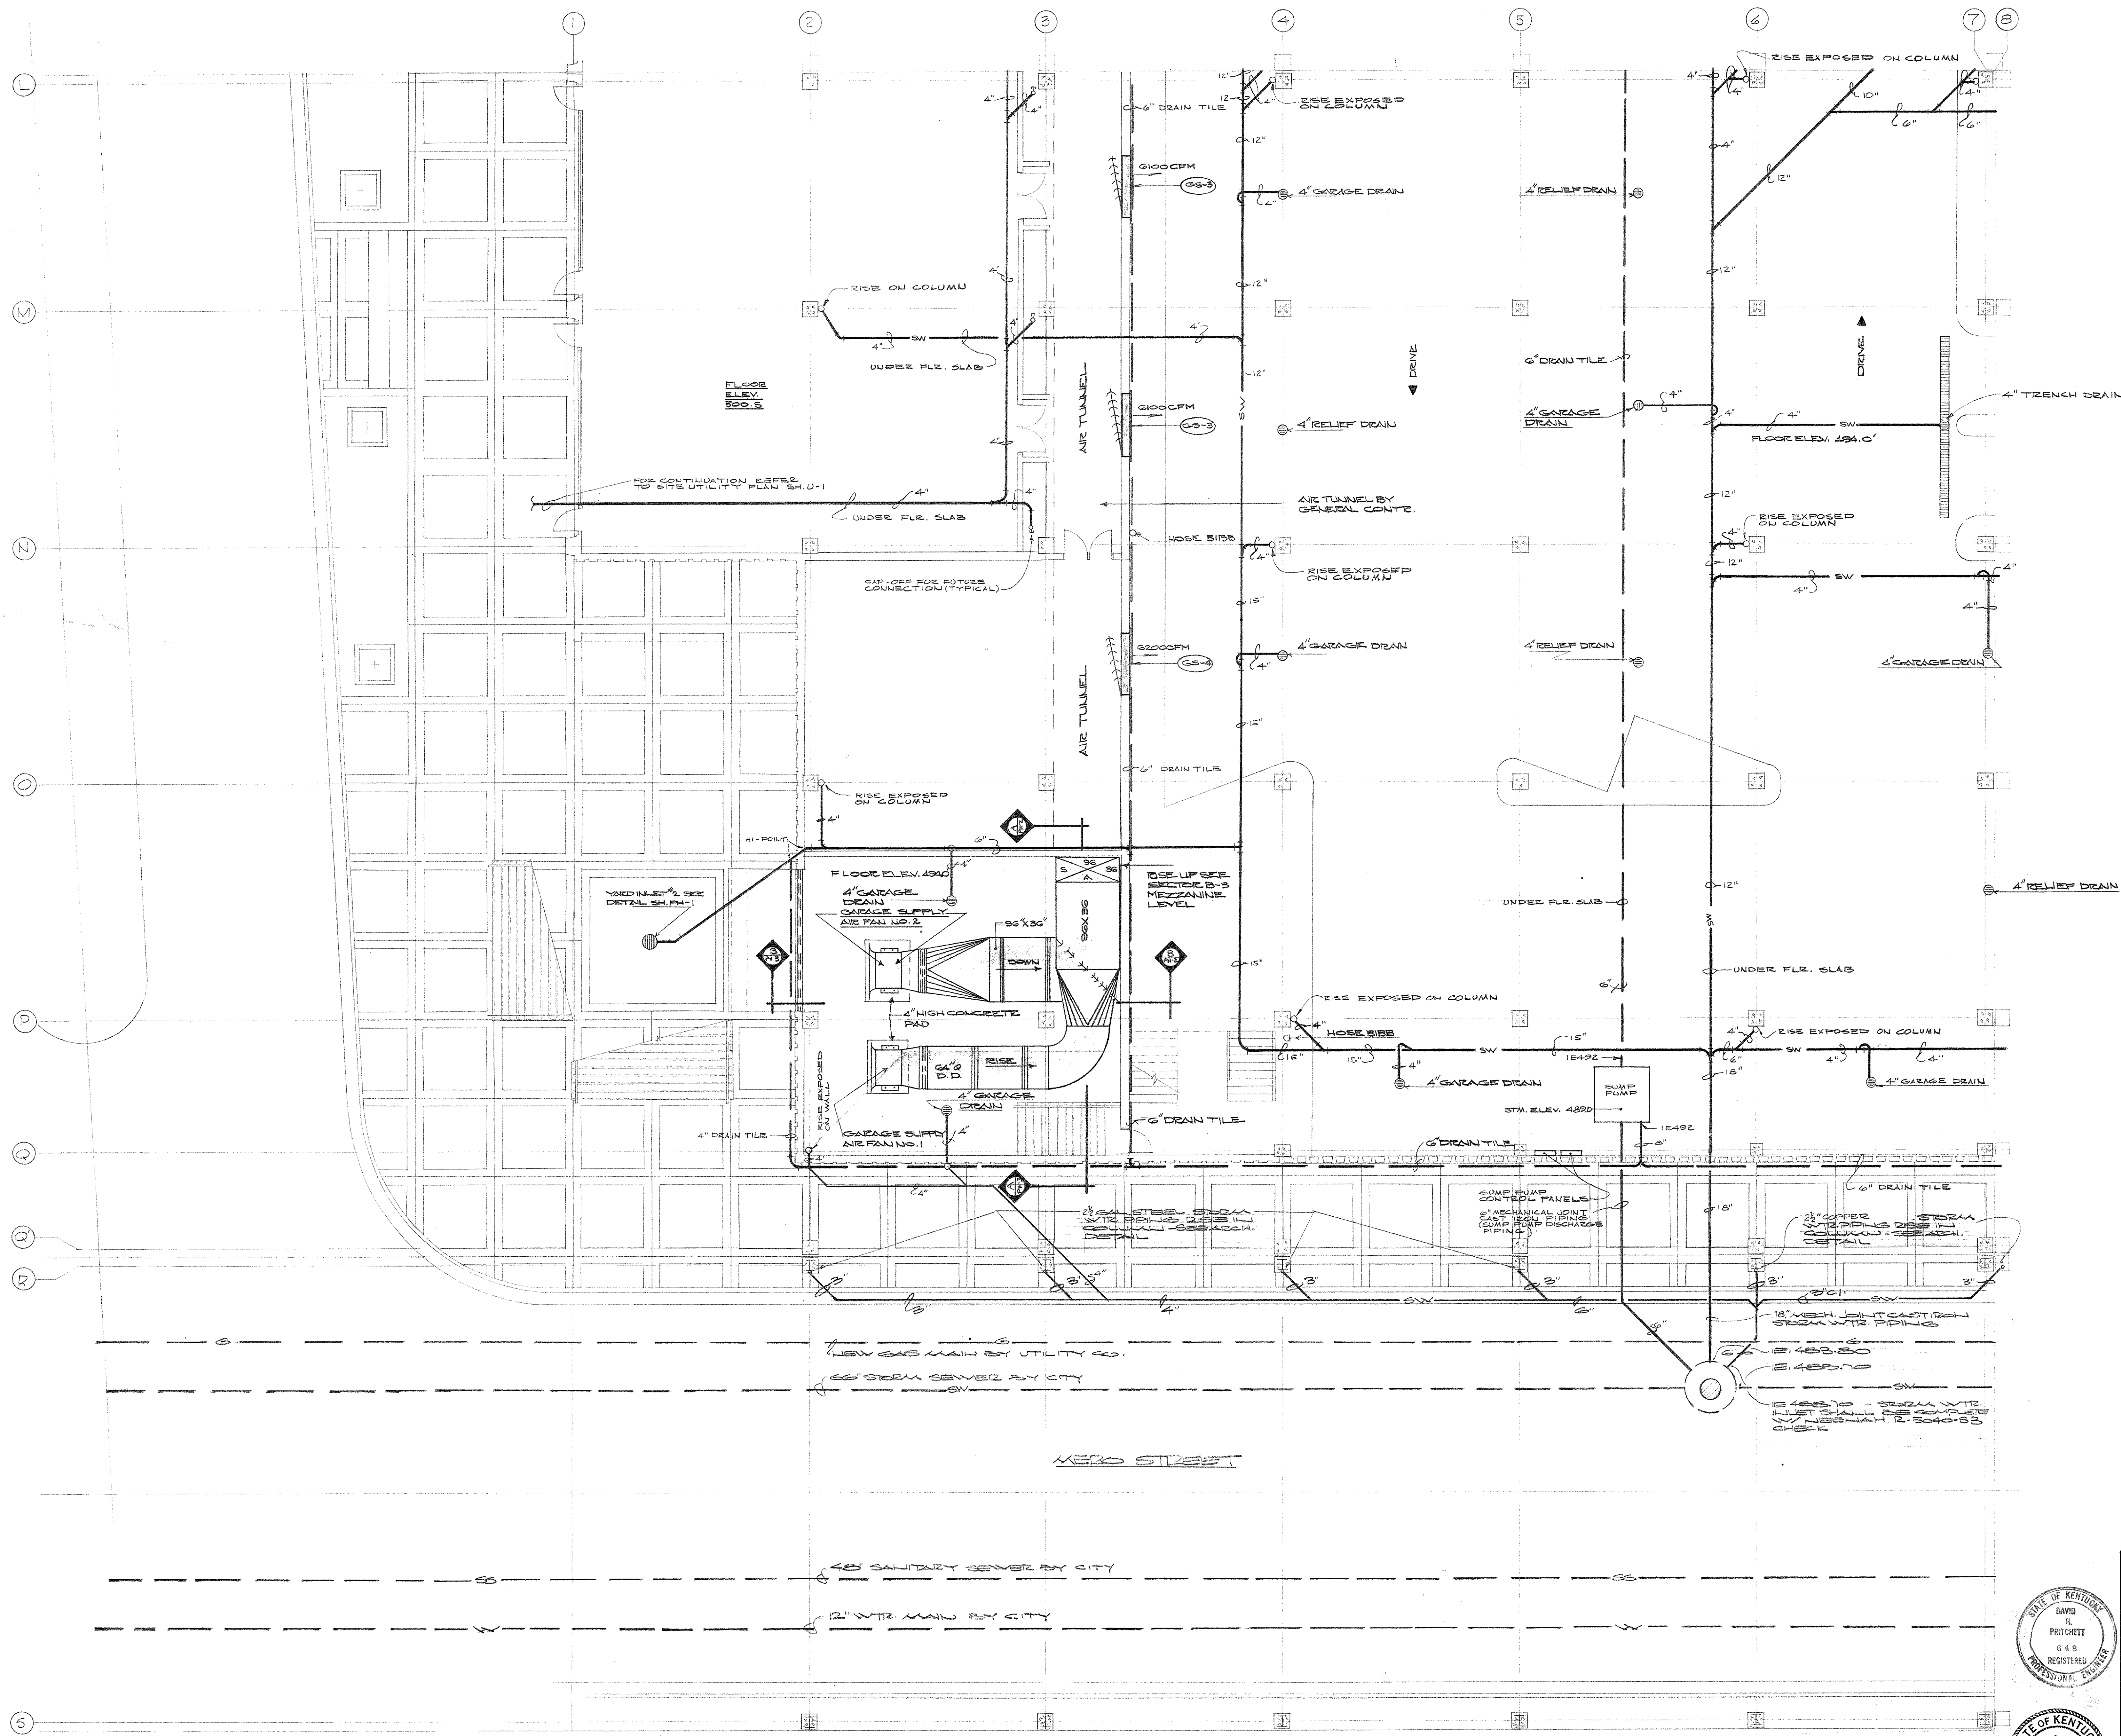



PLUMBING AND VENTILATING PLAN - GROUND LEVEL - SECTOR B-3
SCALE - 1/8" = 1'-0"

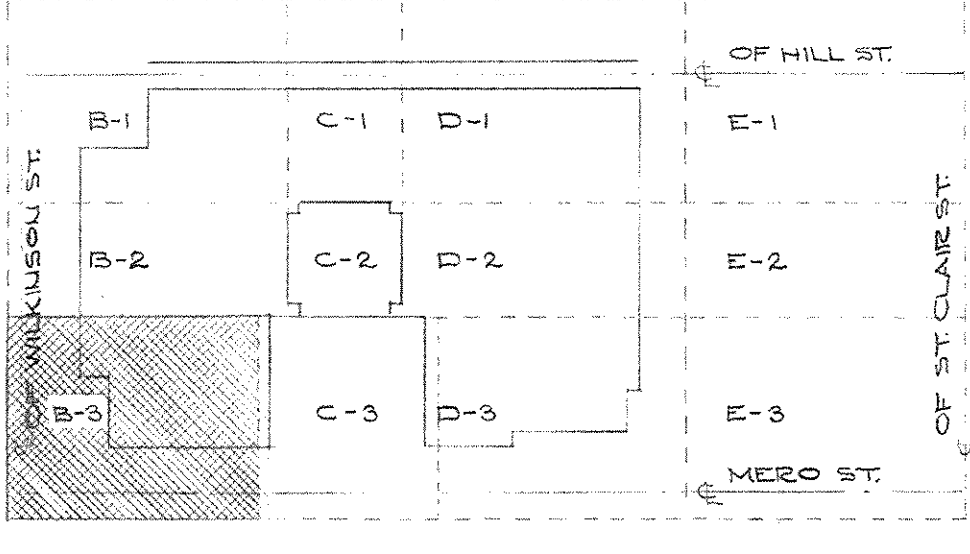


KEY PLAN - GROUND LEVEL
NO SCALE

CAPITAL PLAZA OFFICE BUILDING
FRANKFORT, KENTUCKY

DRAWN BY O.S.C.R.S.	PLUMBING AND VENTILATION PLAN GROUND LEVEL - SECTOR B-3	DATE 15, MAY, 1967
TRACED BY O.S.	ARCHITECT	SCALE 1/8" = 1'-0"
CHECKED BY O.S.C.	EDWARD DURELL STONE 7 EAST 87TH STREET NEW YORK, N.Y.	COMM. NO. 50952
SECTOR NO. B 3	ASSOCIATE ARCHITECTS & ENGINEERS LEE POTTER SMITH & ASSOCIATES 314 WILKINSON FRANKFORT, KENTUCKY	DRAWING NO. PH 3
APPROVED BY ARCHITECT	COMMONWEALTH OF KENTUCKY DEPARTMENT OF FINANCE - ENGINEERING STAFF FRANKFORT, KENTUCKY	DATE MAY 24 1967

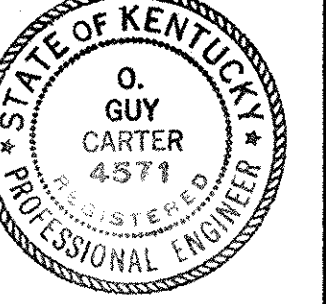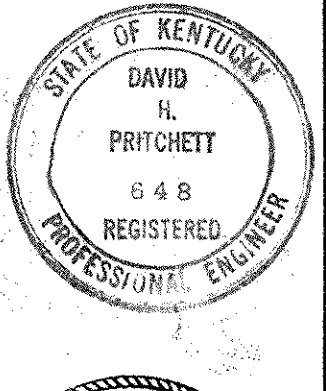

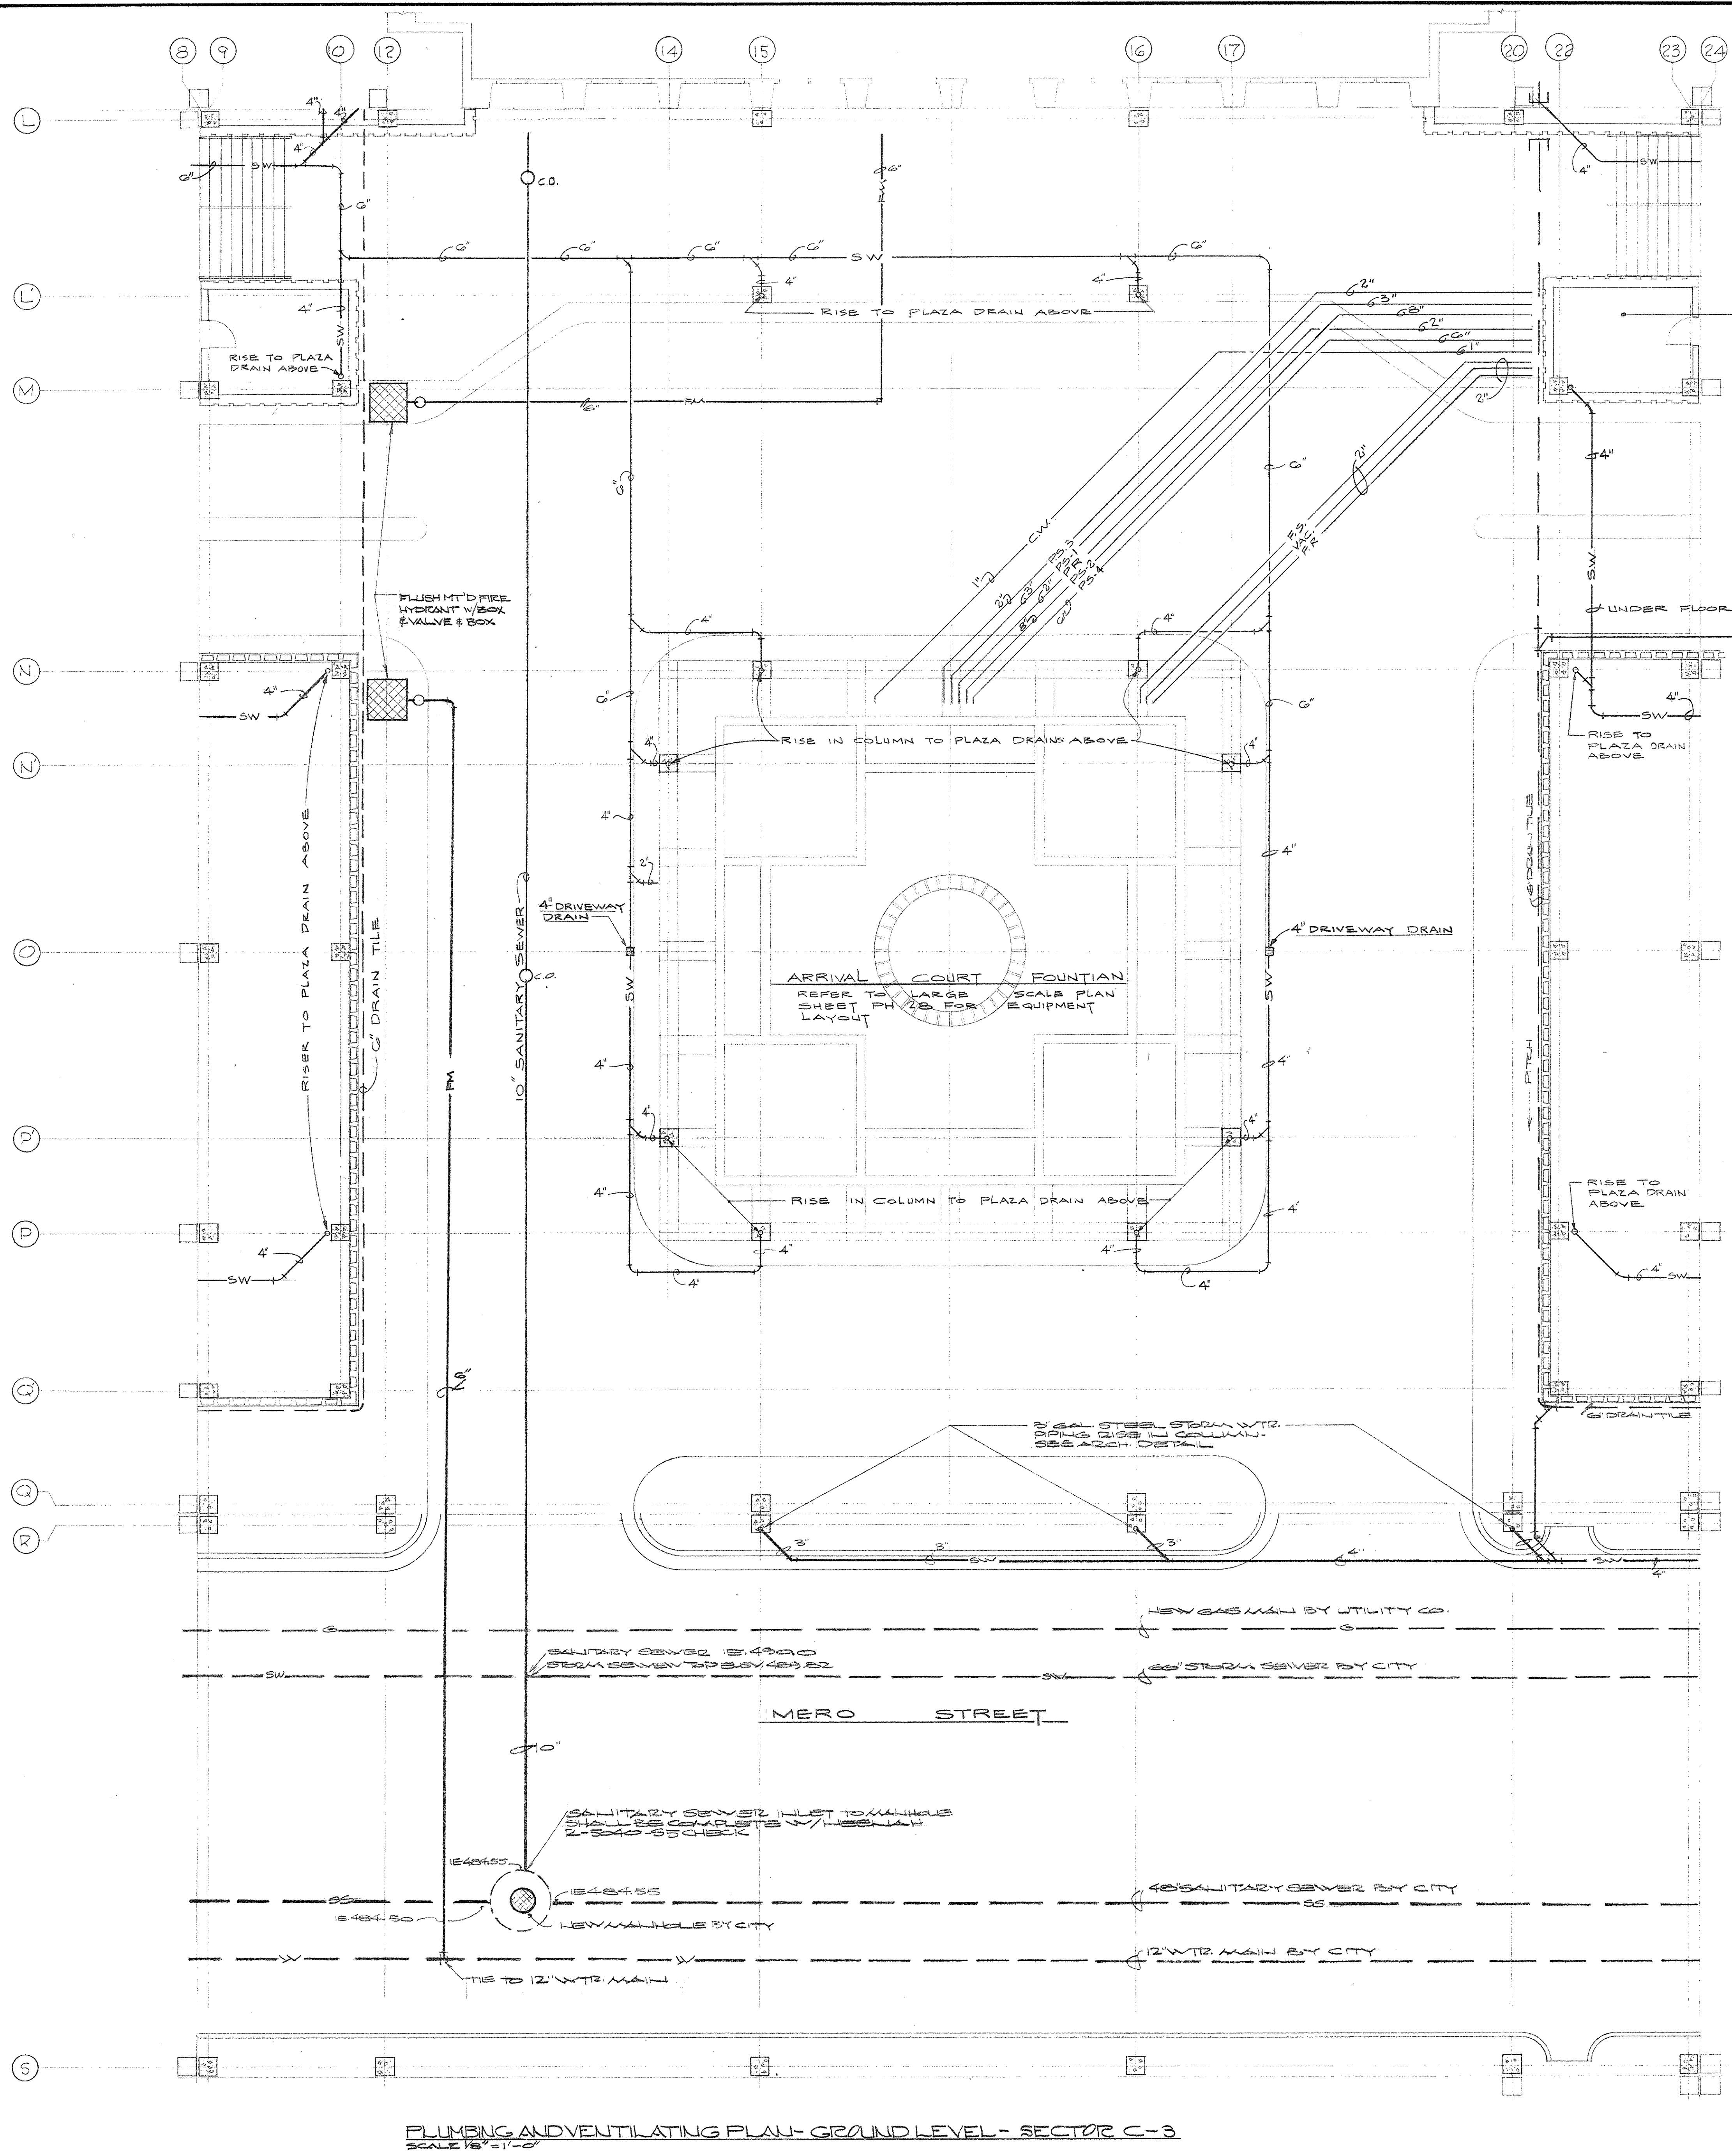


FOUNTAIN PUMP ROOM
REFER TO LARGE SCALE
PLAN SHEET PH-28 FOR
PIPING LAYOUT

ARRIVAL COURT FOUNTAIN
REFER TO LARGE SCALE PLAN
SHEET PH 28 FOR
EQUIPMENT LAYOUT

2\"/>

MERO STREET



PLUMBING AND VENTILATING PLAN - GROUND LEVEL - SECTOR C-3
SCALE 1/8\"/>


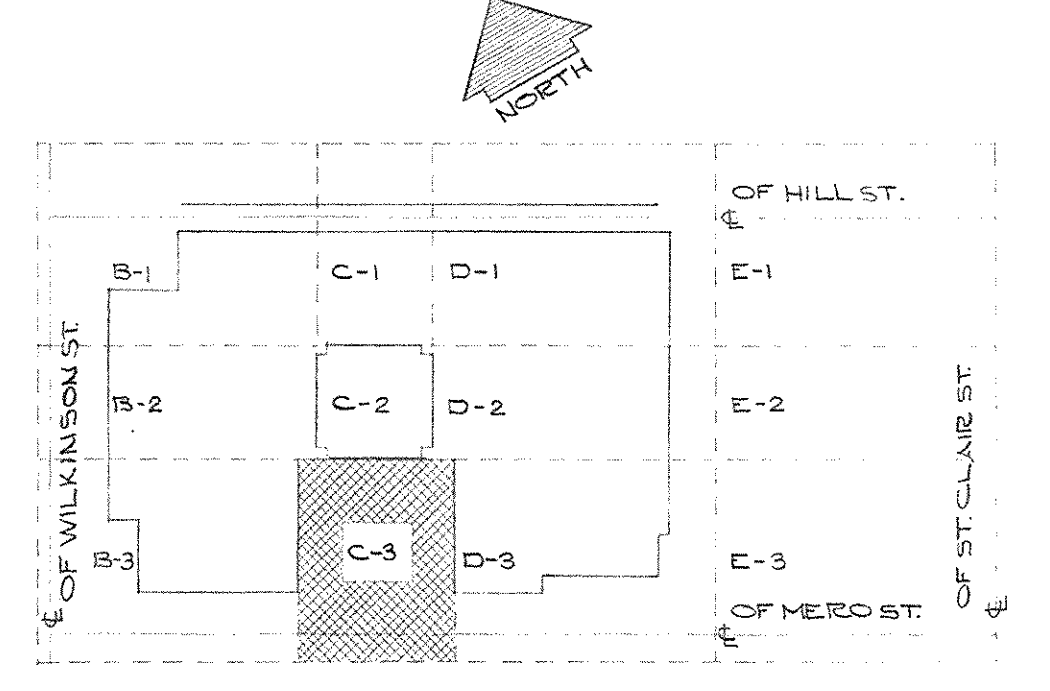


KEY PLAN - GROUND LEVEL
NO SCALE


CAPITAL PLAZA OFFICE BUILDING
FRANKFORT, KENTUCKY

DRAWN BY DS	PLUMBING AND VENTILATING PLAN - GROUND LEVEL - SECTOR C-3	DATE 15, MAY, 1967
TRACED BY DS	ARCHITECT	SCALE 1/8\"/>
CHECKED BY GSC	EDWARD DURELL STONE 7 EAST 67TH STREET NEW YORK, N. Y.	COMM. NO. S-5959
SECTOR NO. C 3	ASSOCIATE ARCHITECTS & ENGINEERS LEE POTTER SMITH & ASSOCIATES 314 WILKINSON FRANKFORT, KENTUCKY	DRAWING NO. PH 4 OF PH-31
APPROVED BY ARCHITECT	DATE	
APPROVED BY AGENCY HEAD	DATE	
APPROVED BY OWNER	DATE MAY 28 1967	

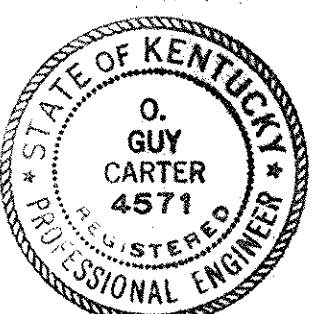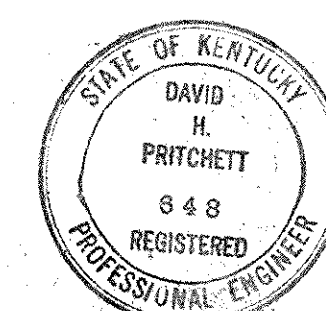

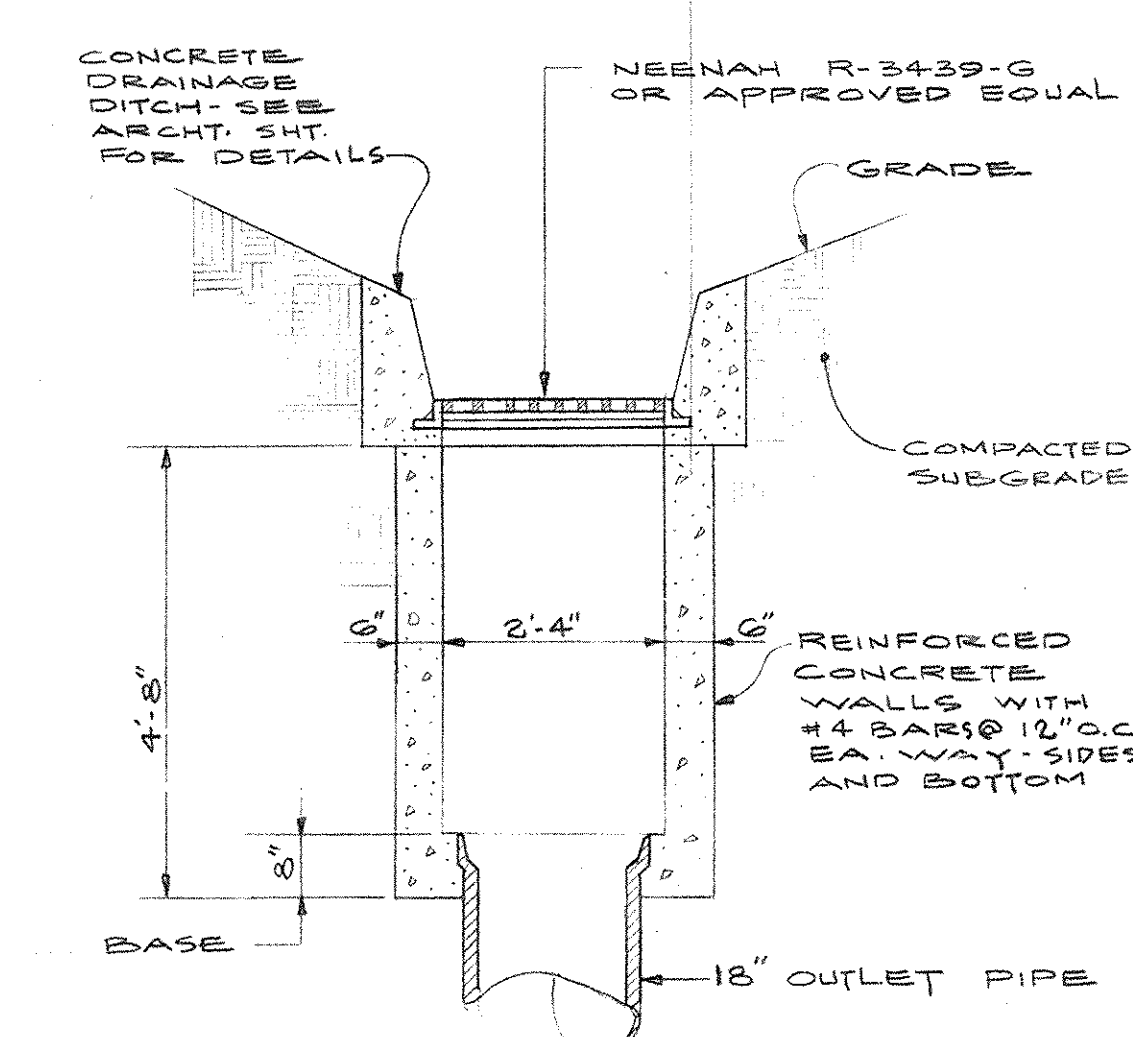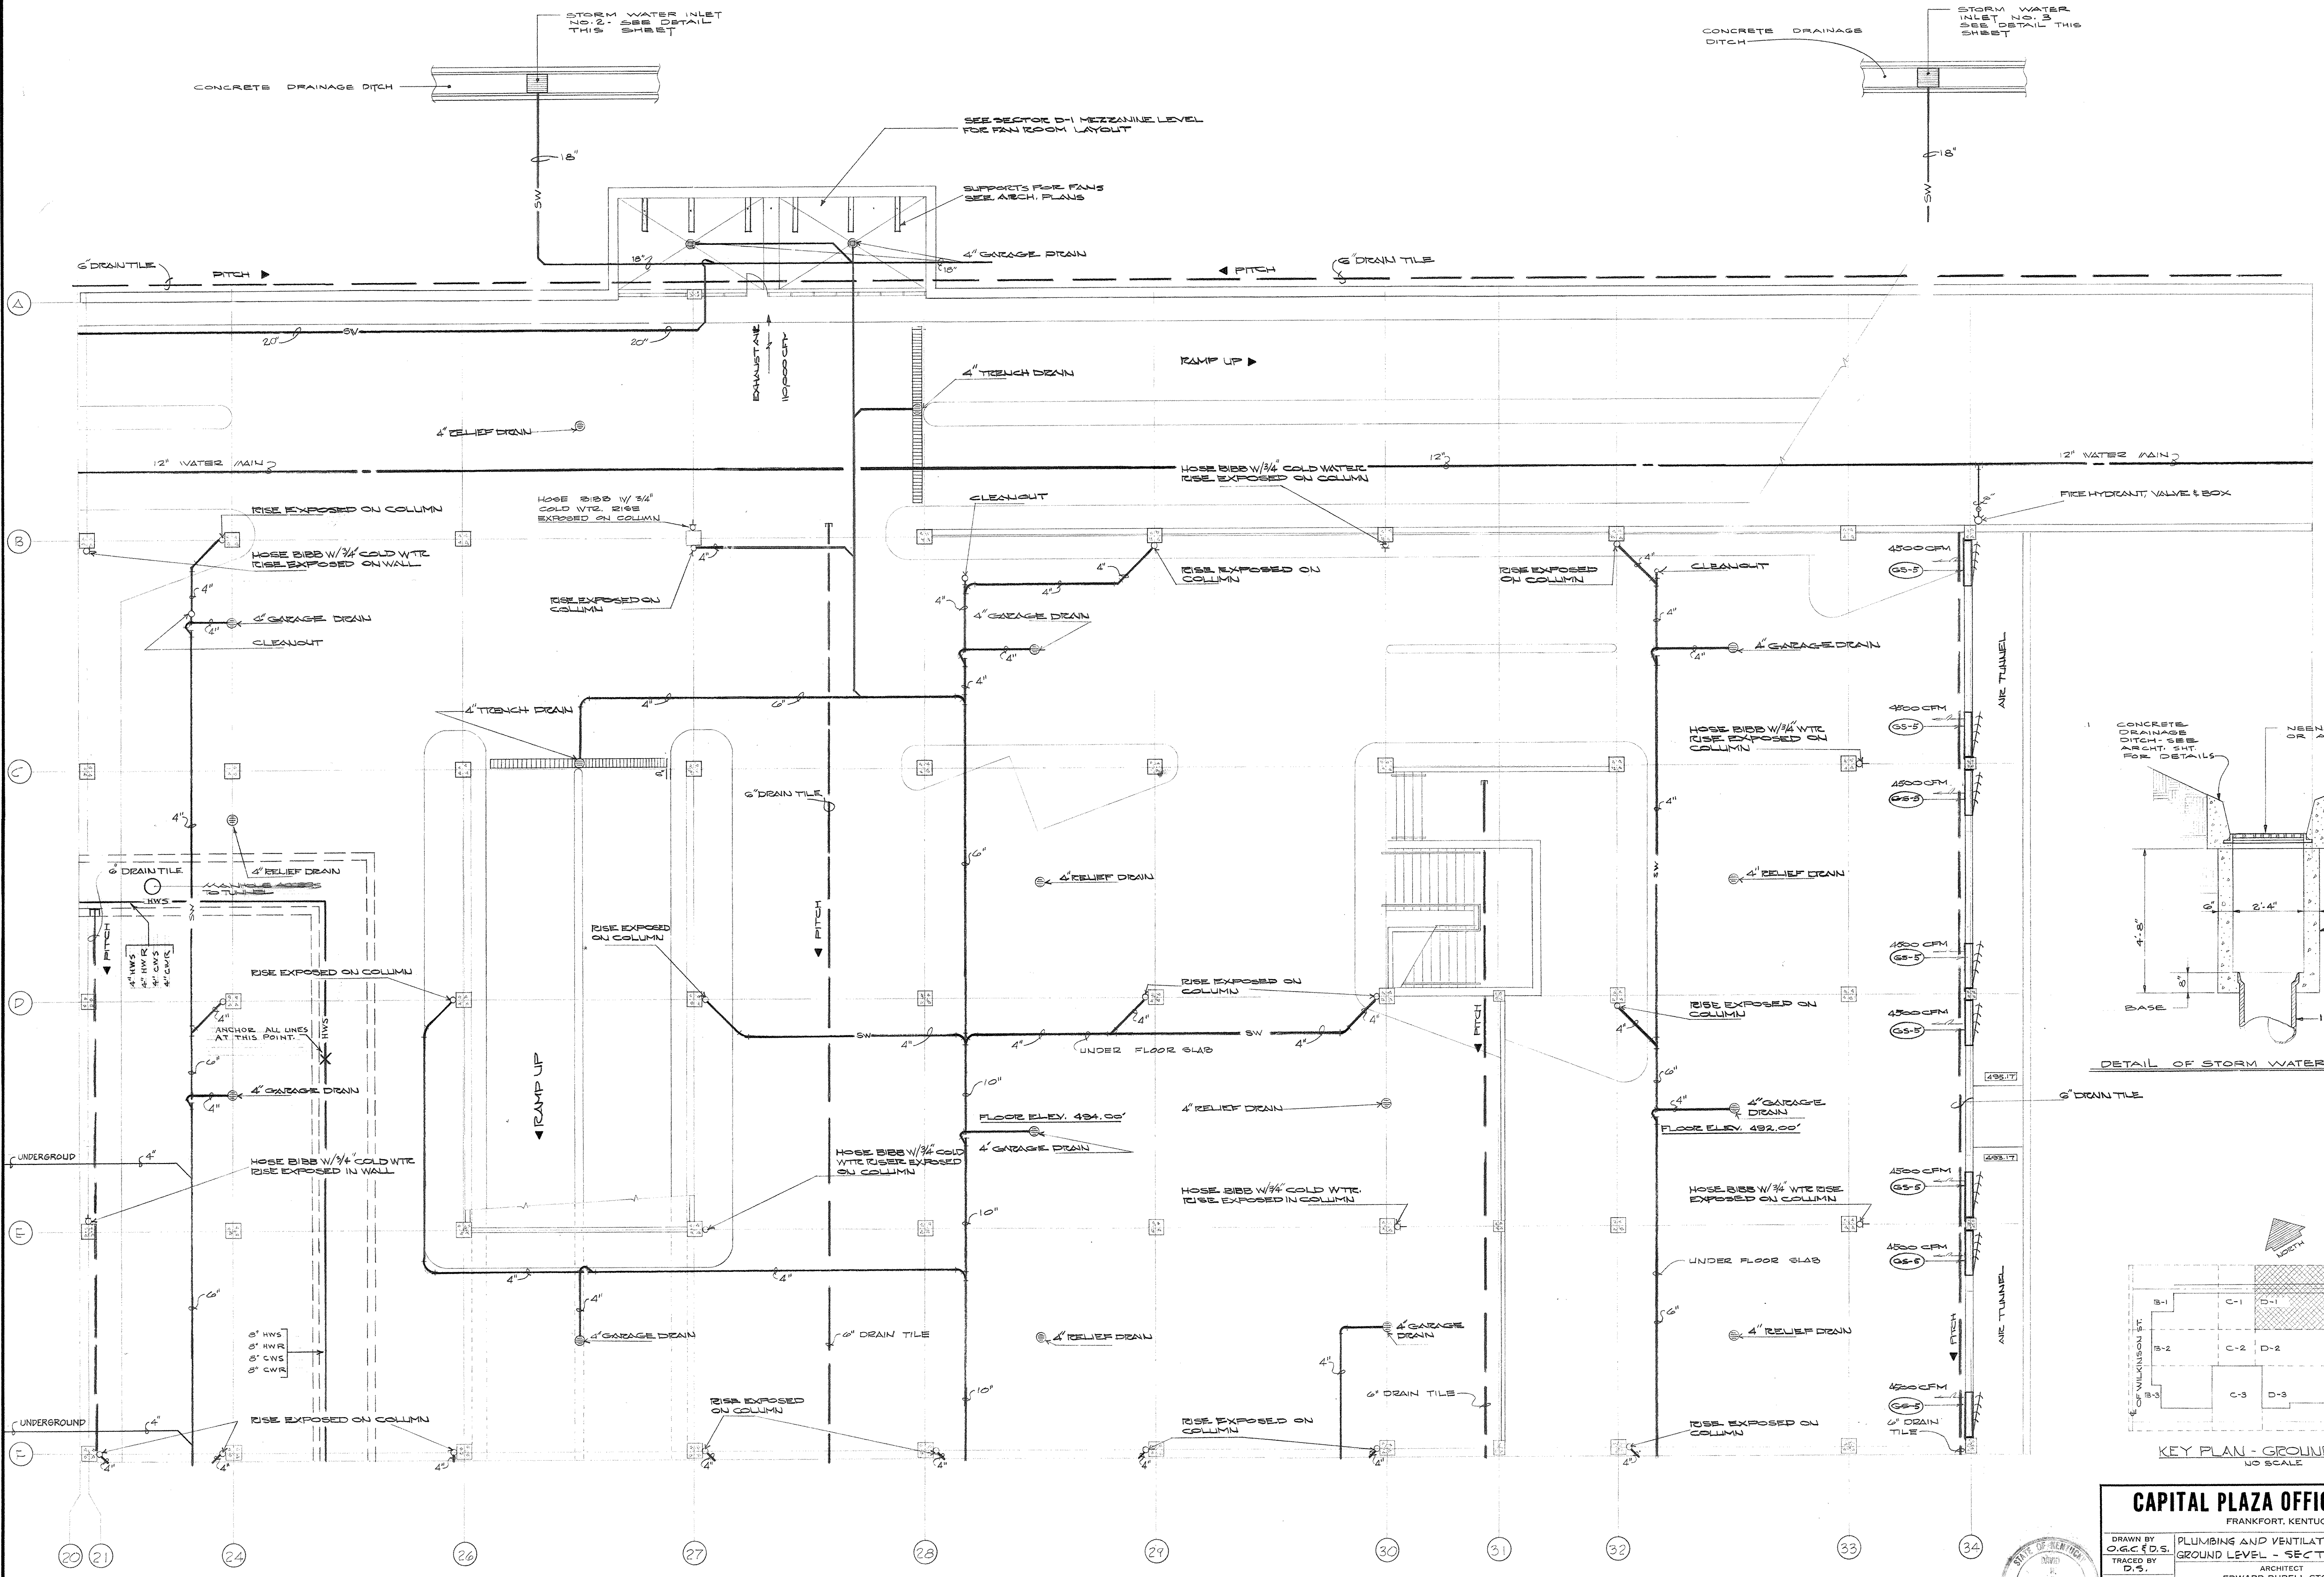


DETAIL OF STORM WATER INLET 1, 2, & 3
SCALE 1/2\"/>

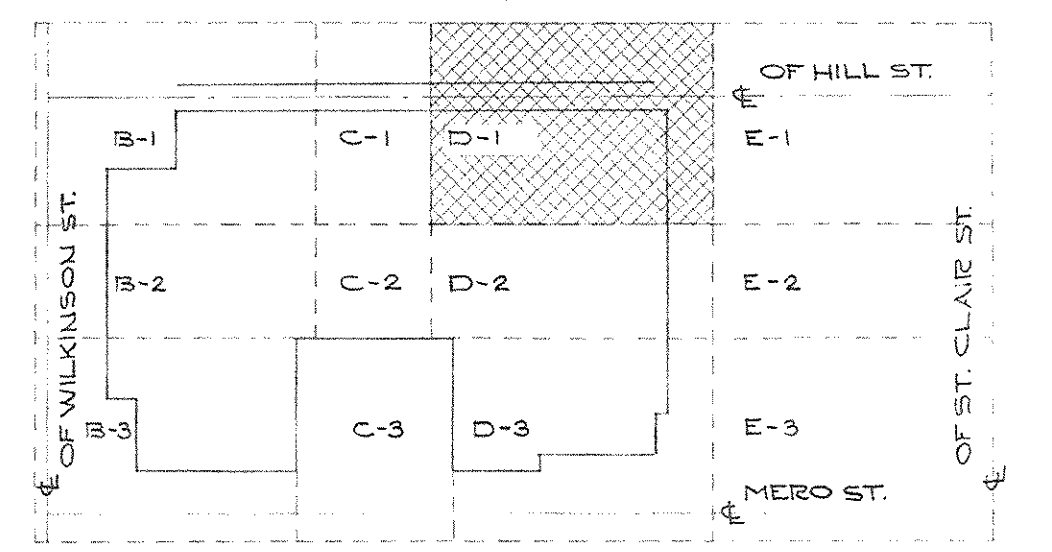


KEY PLAN - GROUND LEVEL
NO SCALE

PLUMBING AND VENTILATING PLAN - GROUND LEVEL - SECTOR D-1
SCALE - 1/8\"/>


CAPITAL PLAZA OFFICE BUILDING		
FRANKFORT, KENTUCKY		
DRAWN BY O.G.C. & D.S.	PLUMBING AND VENTILATING PLAN - GROUND LEVEL - SECTOR D-1	DATE 15, MAY, 1967
TRACED BY D.S.	ARCHITECT EDWARD DURELL STONE	SCALE AS NOTED
CHECKED BY O.G.C.	7 EAST 6TH STREET NEW YORK, N. Y.	OWNER 500 G&G
SECTOR NO. D-1	ASSOCIATE ARCHITECTS & ENGINEERS LEE POTTER SMITH & ASSOCIATES FRANKFORT, KENTUCKY	DRAWING NO. PH 5
COMMONWEALTH OF KENTUCKY DEPARTMENT OF FINANCE - ENGINEERING STAFF FRANKFORT, KENTUCKY		
APPROVED BY	ARCHITECT	DATE
APPROVED BY	AGENCY HEAD	DATE MAY 14 1967
APPROVED BY	OWNER	DATE

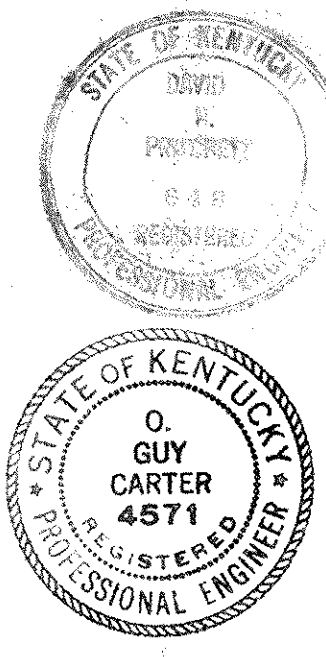

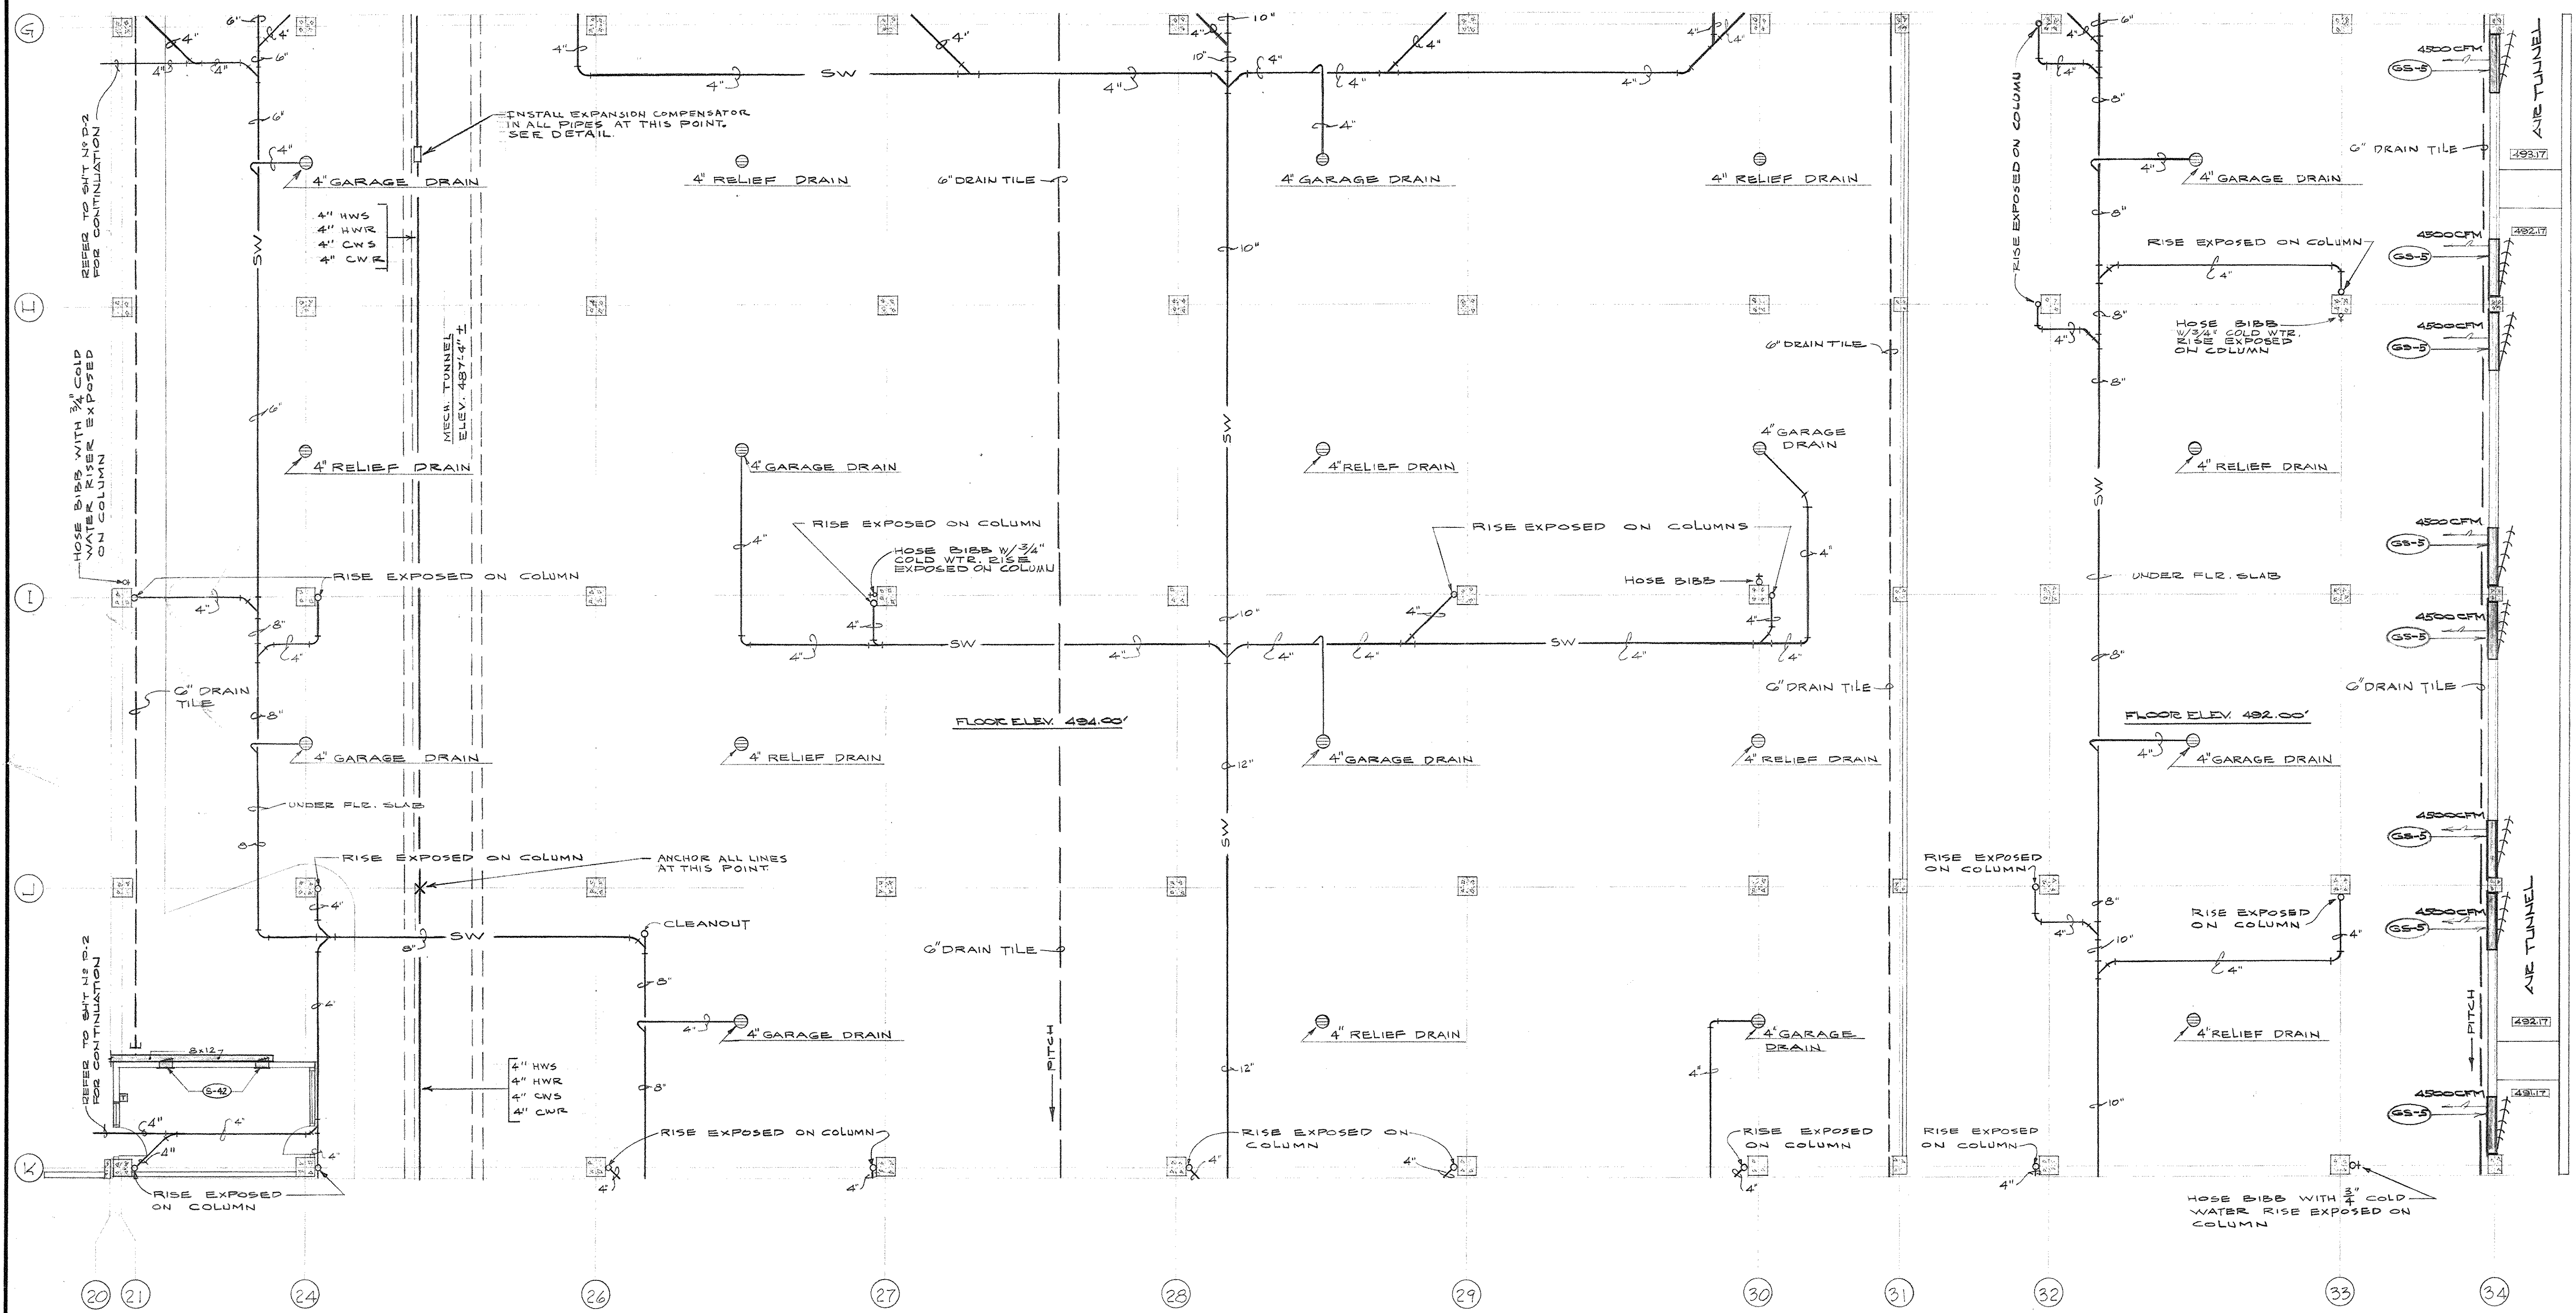


PLUMBING AND VENTILATING PLAN - GROUND LEVEL - SECTOR D-2
SCALE 1/8"=1'-0"

- NOTES:**
1. PROVIDE ELCON FIG. 905B HOLD-DOWN CLAMP AND BASE PLATE FOR PIPE ANCHOR CLAMP TO BE WELDED TO PIPE AND BOLTED TO CHANNEL. PROVIDE AT POINTS WHERE ANCHORS ARE REQUIRED.
 2. SECTION TYPICAL FOR ALL UTILITIES TUNNEL.

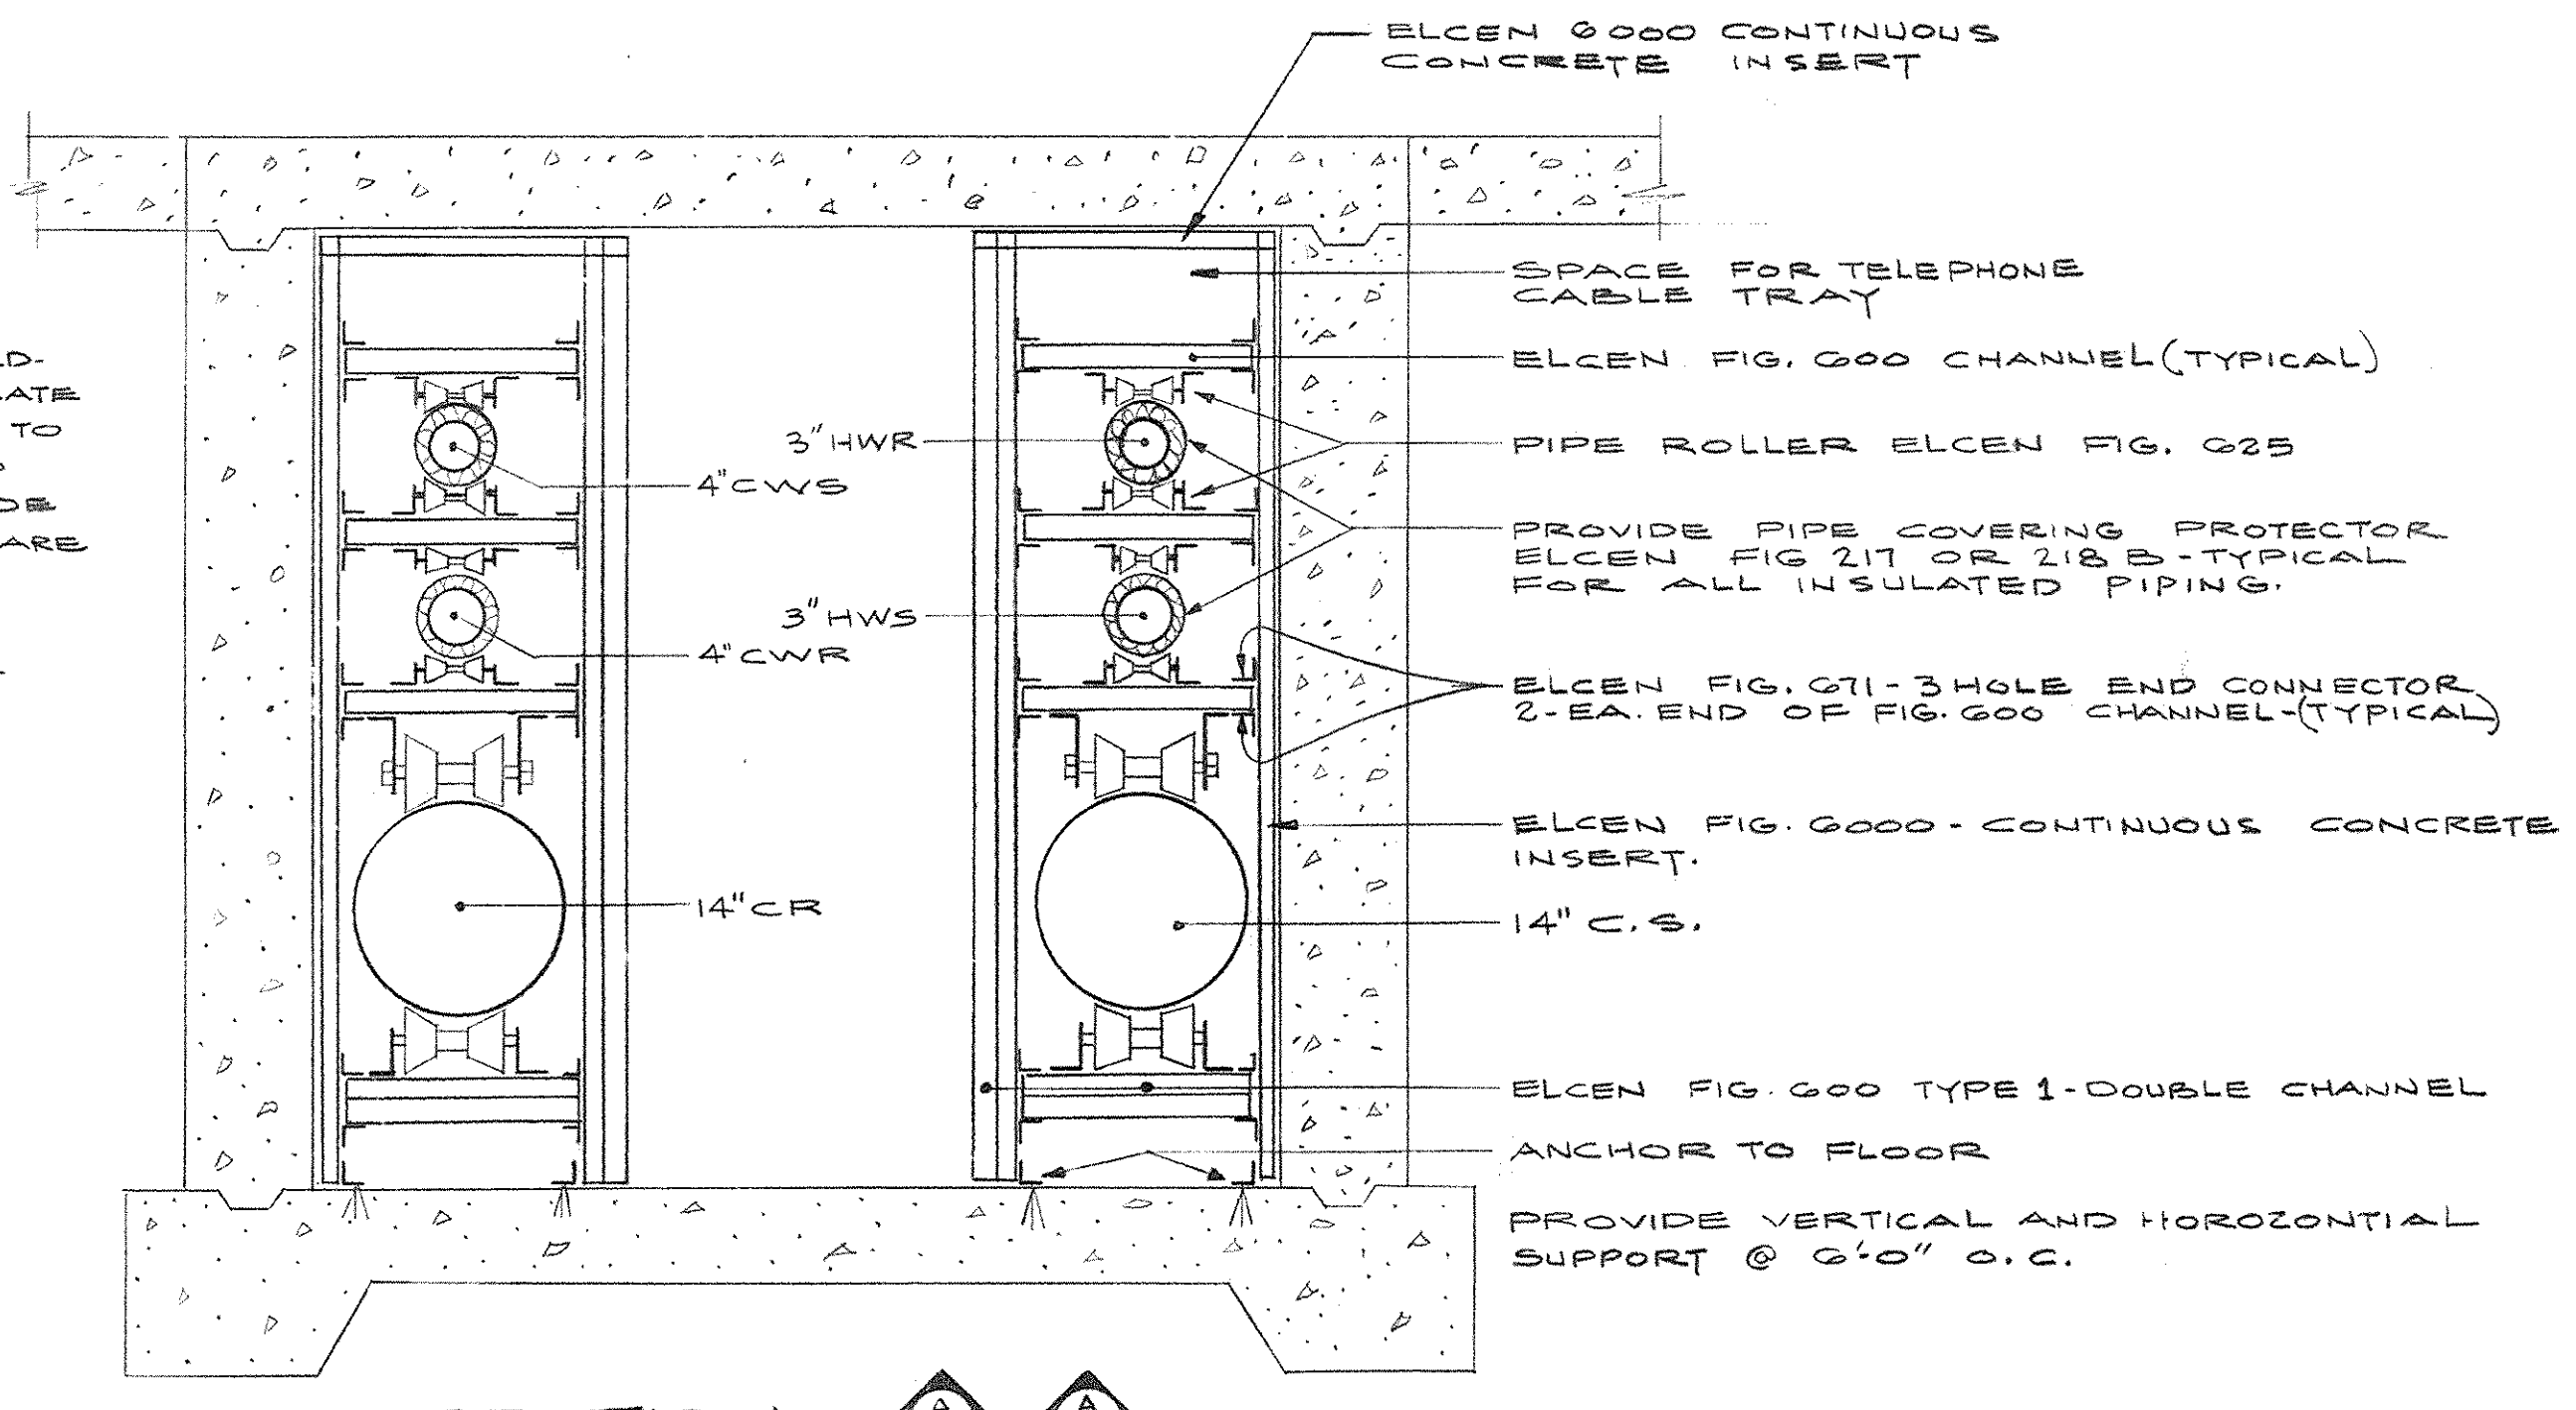


SECTION
SCALE 1"=1'-0"

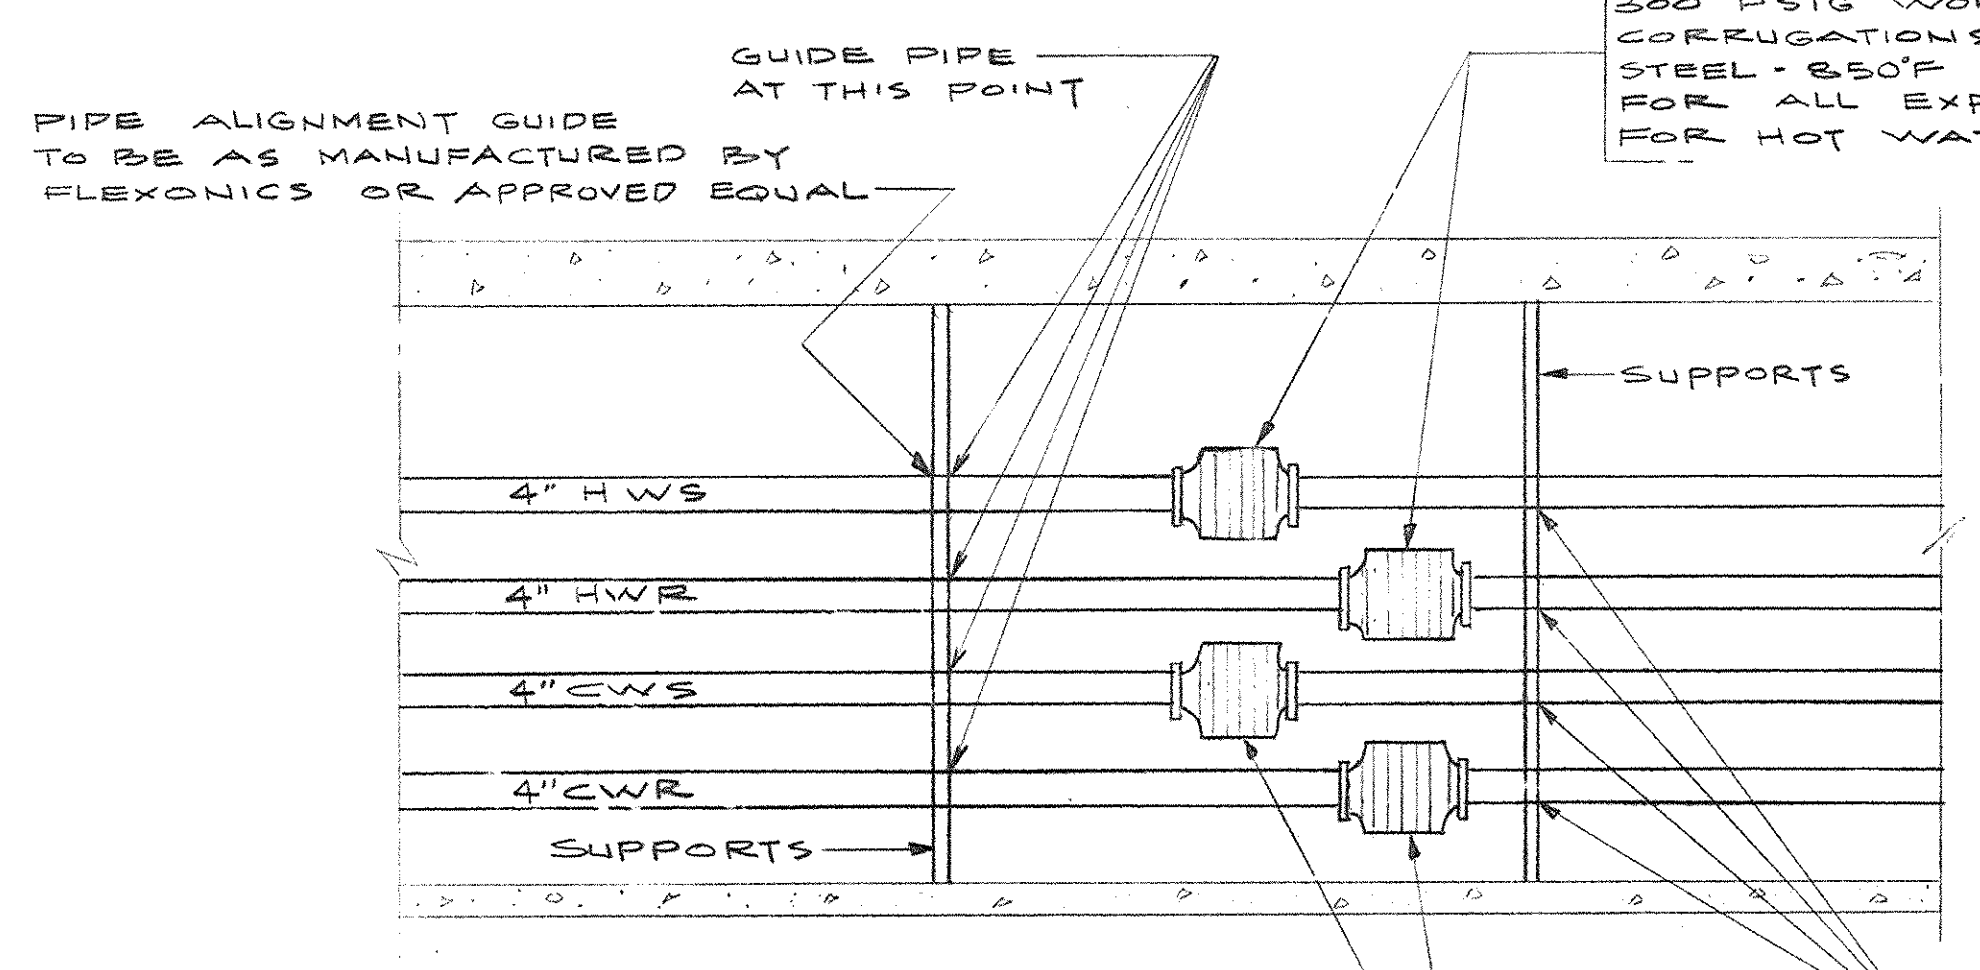



FLEXONICS OR APPROVED EQUAL, HIGH PRESSURE 300 PSIG WORKING PRESSURE, 300°F FLANGES, 0 CORRUGATIONS, 2 5/8" AXIAL TRAVEL, CARRIER STAINLESS STEEL 850°F RINGS NICKEL IRON 800°F TYPICAL FOR ALL EXPANSION JOINTS IN MECH. TUNNEL FOR CHILLED WATER LINES.


DETAIL OF EXPANSION JOINTS IN MECHANICAL TUNNEL
SCALE 1/2"=1'-0"

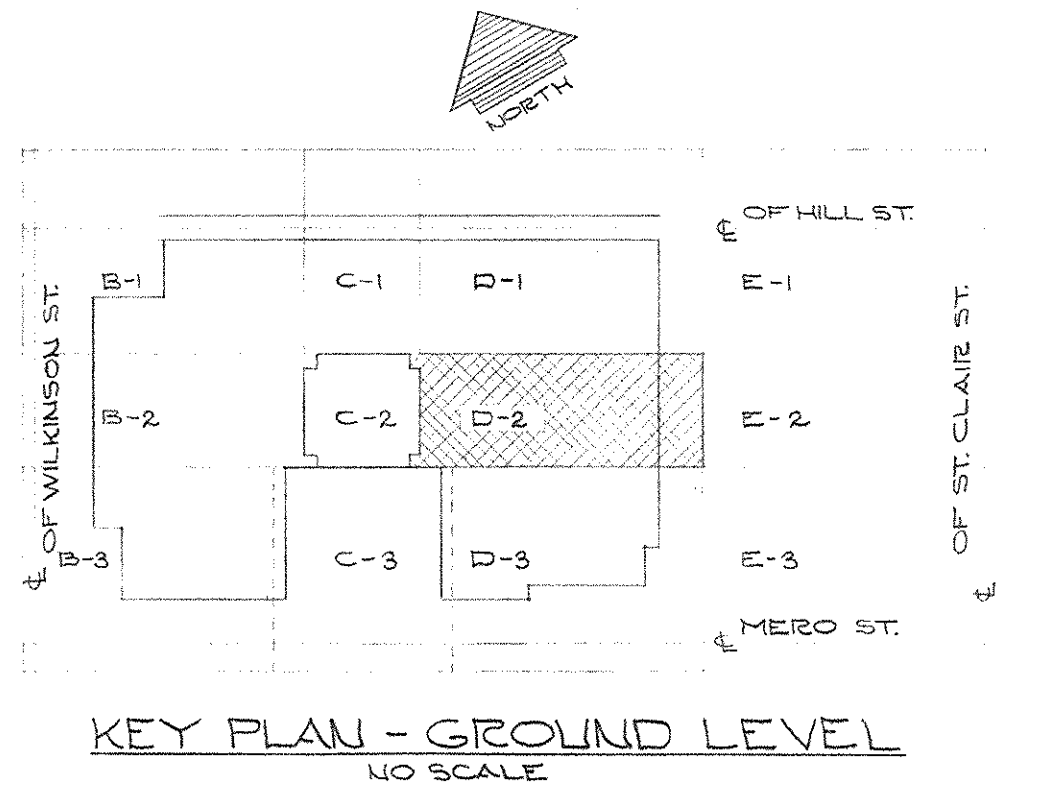


KEY PLAN - GROUND LEVEL
NO SCALE

CAPITAL PLAZA OFFICE BUILDING FRANKFORT, KENTUCKY			
DRAWN BY O.G.C. (D.S.)	PLUMBING AND VENTILATING PLAN - GROUND LEVEL - SECTOR D-2	DATE 15, MAY 1967	SCALE 1/8"=1'-0"
TRACED BY D.S.	ARCHITECT EDWARD DURELL STONE 7 EAST 87TH STREET NEW YORK N. Y.	COMMON NO. 50066	DRAWING NO. PH 6
CHECKED BY O.G.C.	ASSOCIATE ARCHITECTS & ENGINEERS LEE POTTER SMITH & ASSOCIATES 314 WILKINSON FRANKFORT, KENTUCKY	DEPARTMENT OF FINANCE - ENGINEERING STAFF FRANKFORT, KENTUCKY	DATE MAY 24 1967
SECTOR NO. D 2	APPROVED BY ARCHITECT	DATE	OF PH-31
APPROVED BY AGENCY HEAD	DATE	DATE	DATE
APPROVED BY OWNER	DATE	DATE	DATE

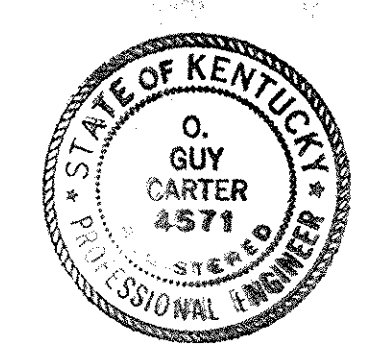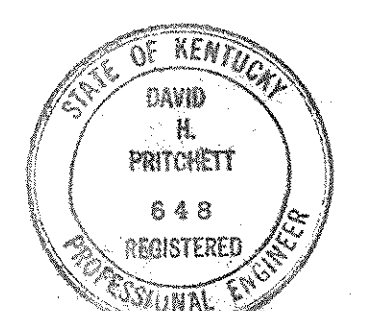

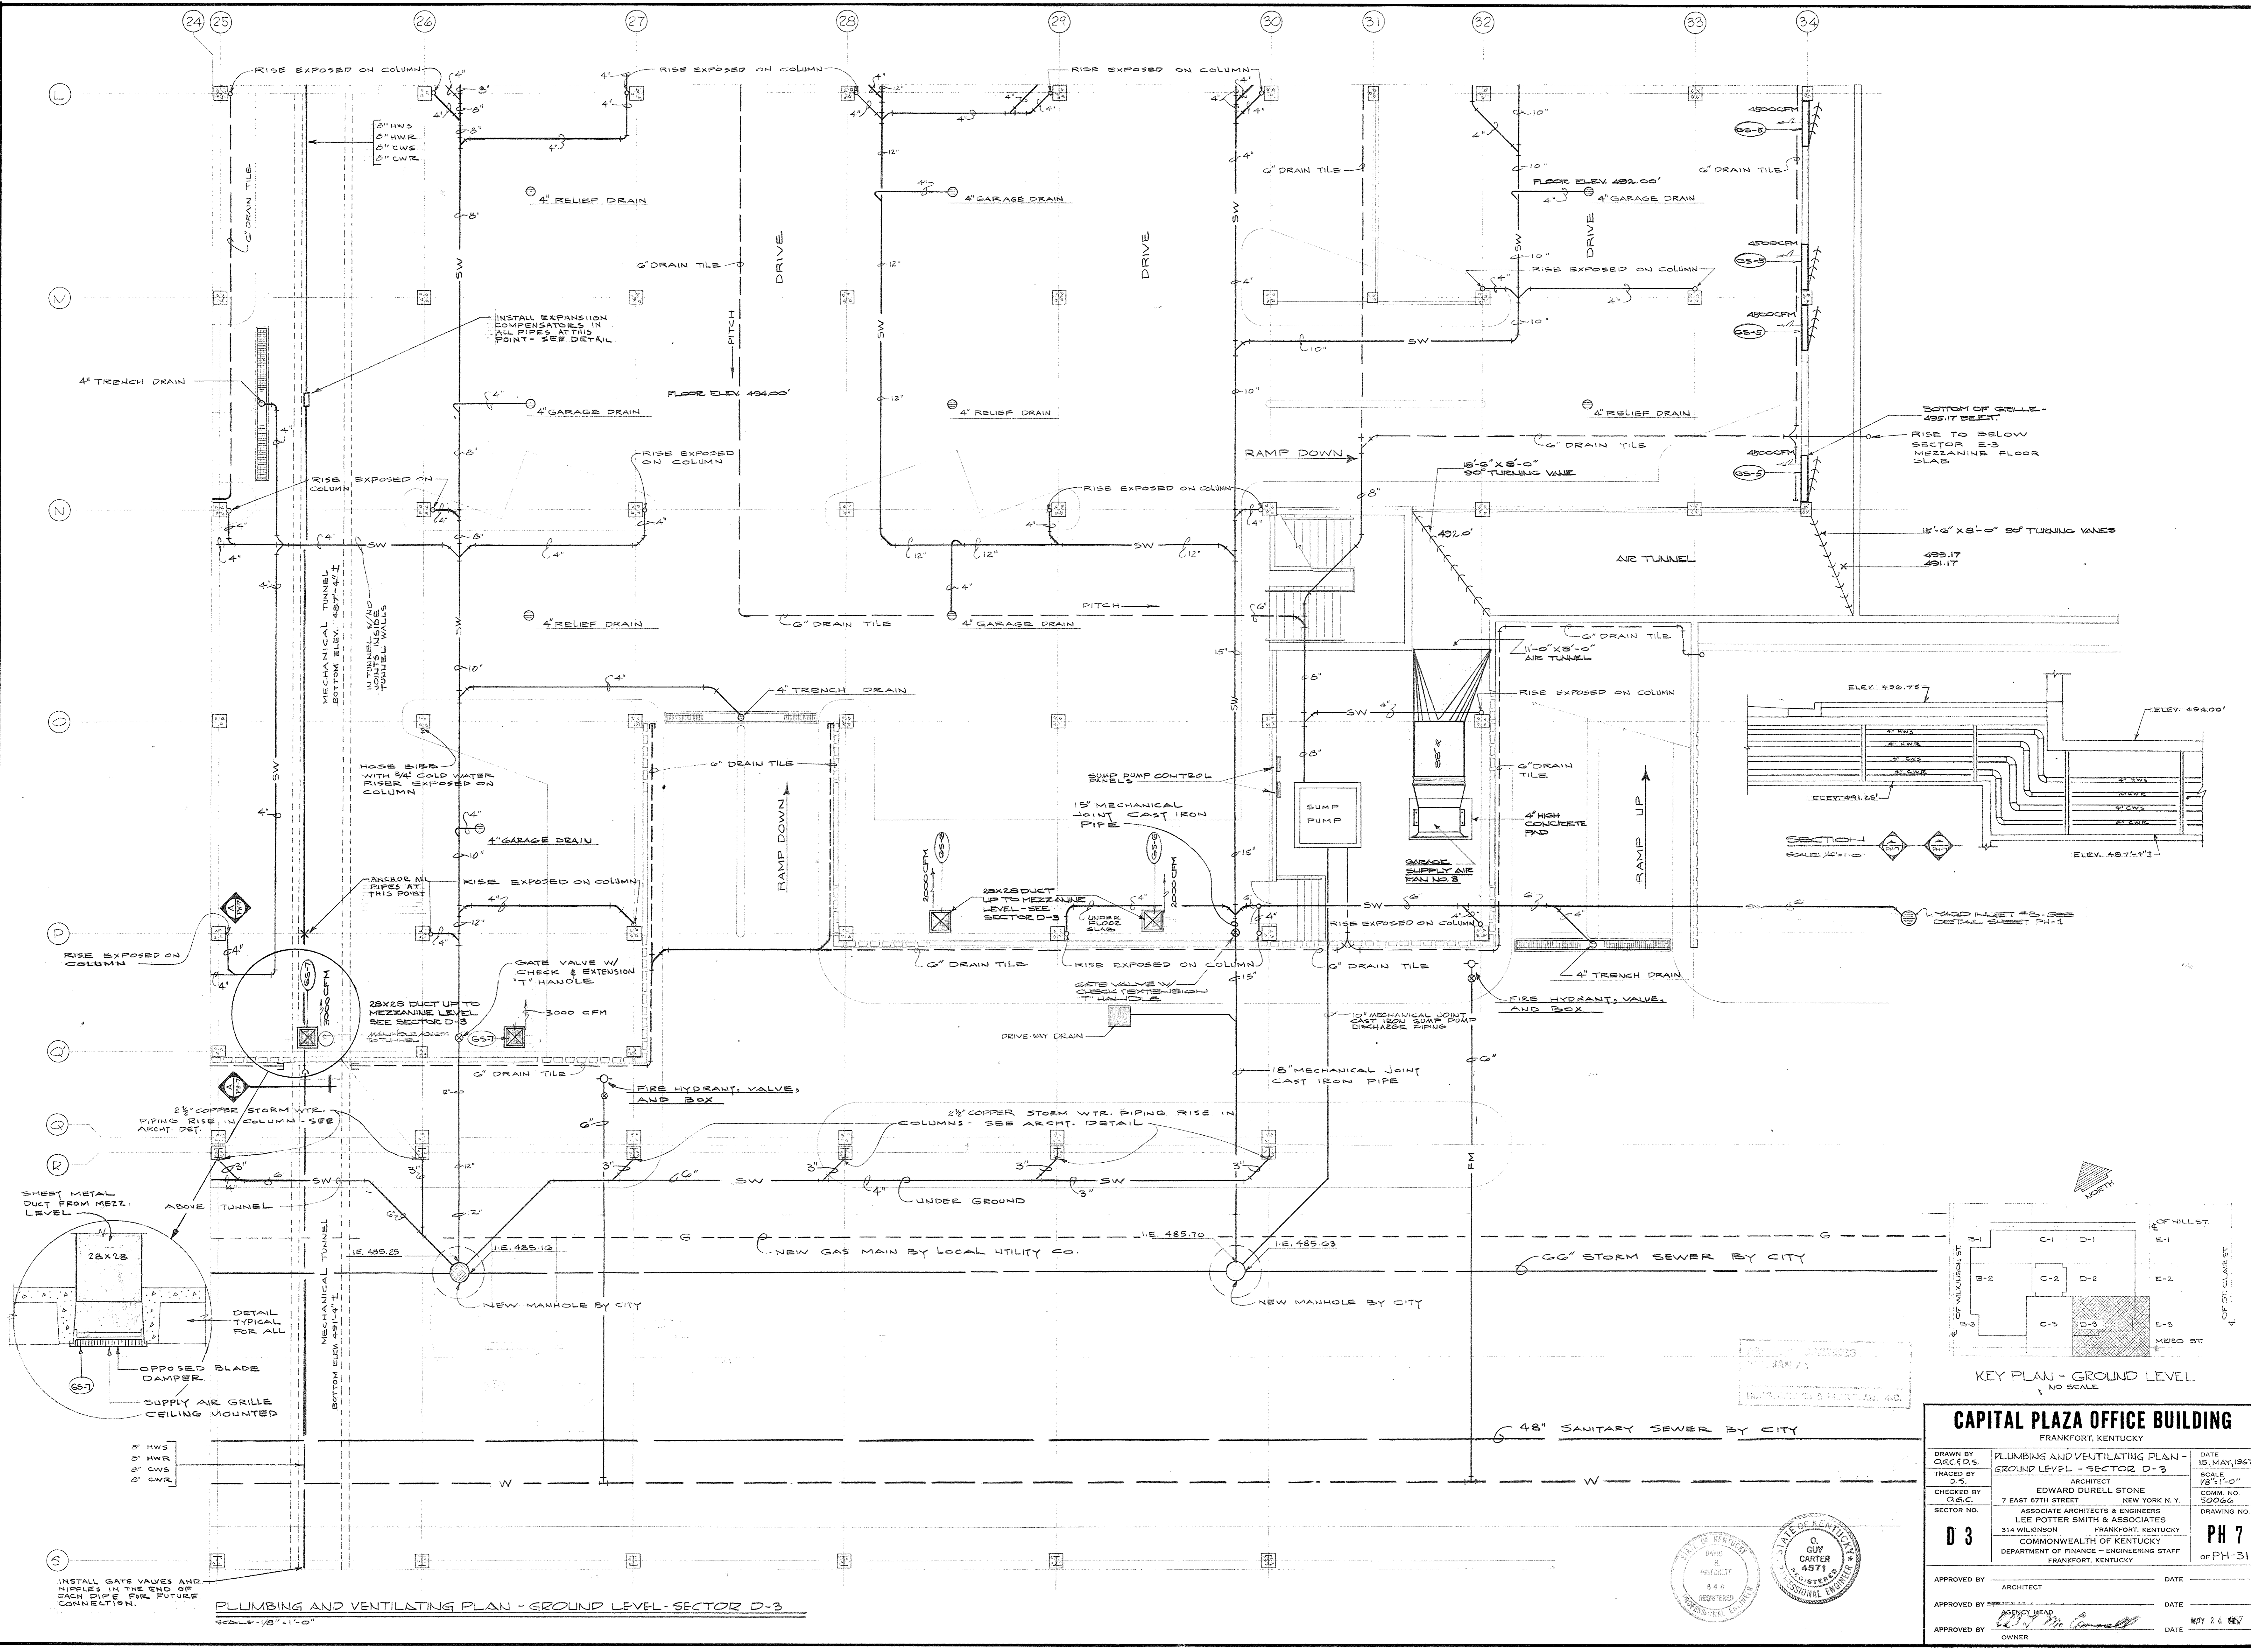

DATE: 5/11/67
 DRAWN BY: D.S.
 CHECKED BY: O.E.C.
 PROJECT NO. 50066

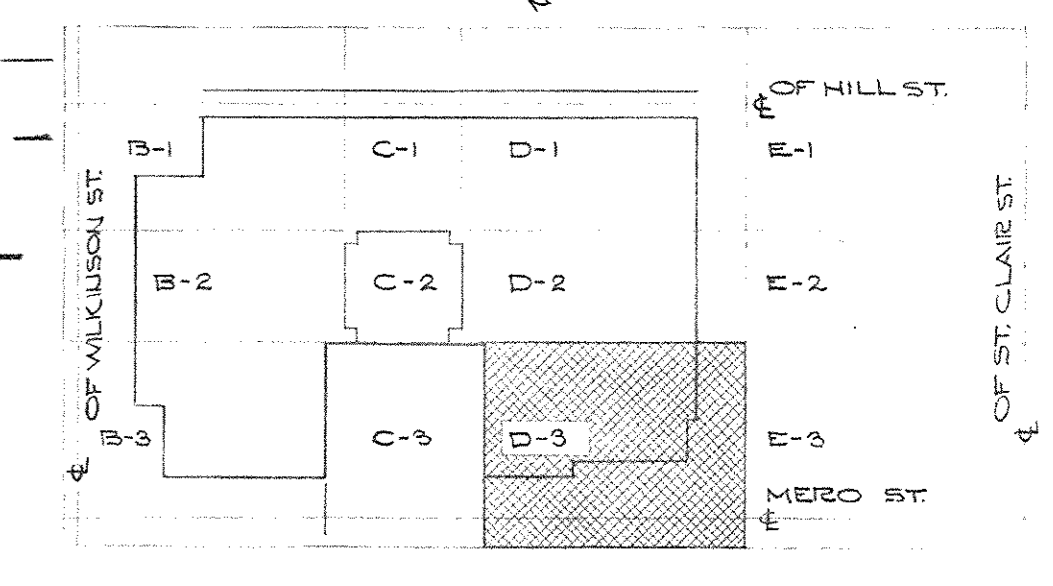


KEY PLAN - GROUND LEVEL
 NO SCALE


CAPITAL PLAZA OFFICE BUILDING
 FRANKFORT, KENTUCKY

DRAWN BY	PLUMBING AND VENTILATING PLAN - GROUND LEVEL - SECTOR D-3	DATE	15, MAY, 1967
TRACED BY	D.S.	SCALE	1/8" = 1'-0"
CHECKED BY	O.E.C.	ARCHITECT	EDWARD DURELL STONE
SECTOR NO.	D 3	NEW YORK N.Y.	7 EAST 67TH STREET
		ASSOCIATE ARCHITECTS & ENGINEERS	LEE POTTER SMITH & ASSOCIATES
		FRANKFORT, KENTUCKY	314 WILKINSON
		COMMONWEALTH OF KENTUCKY	DEPARTMENT OF FINANCE - ENGINEERING STAFF
		FRANKFORT, KENTUCKY	


APPROVED BY	ARCHITECT	DATE	
APPROVED BY	AGENCY HEAD	DATE	
APPROVED BY	OWNER	DATE	MAY 24 1967

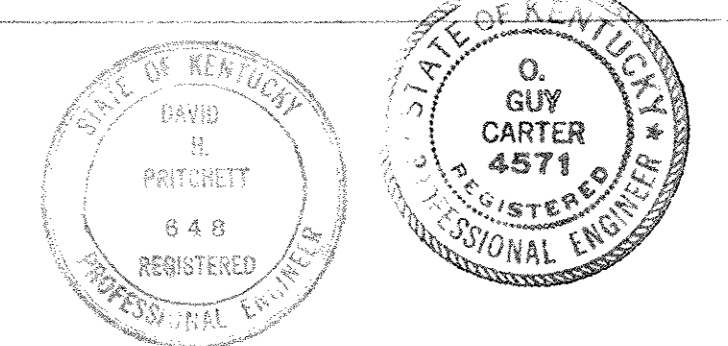


PLUMBING AND VENTILATING PLAN - GROUND LEVEL - SECTOR D-3
 SCALE: 1/8" = 1'-0"

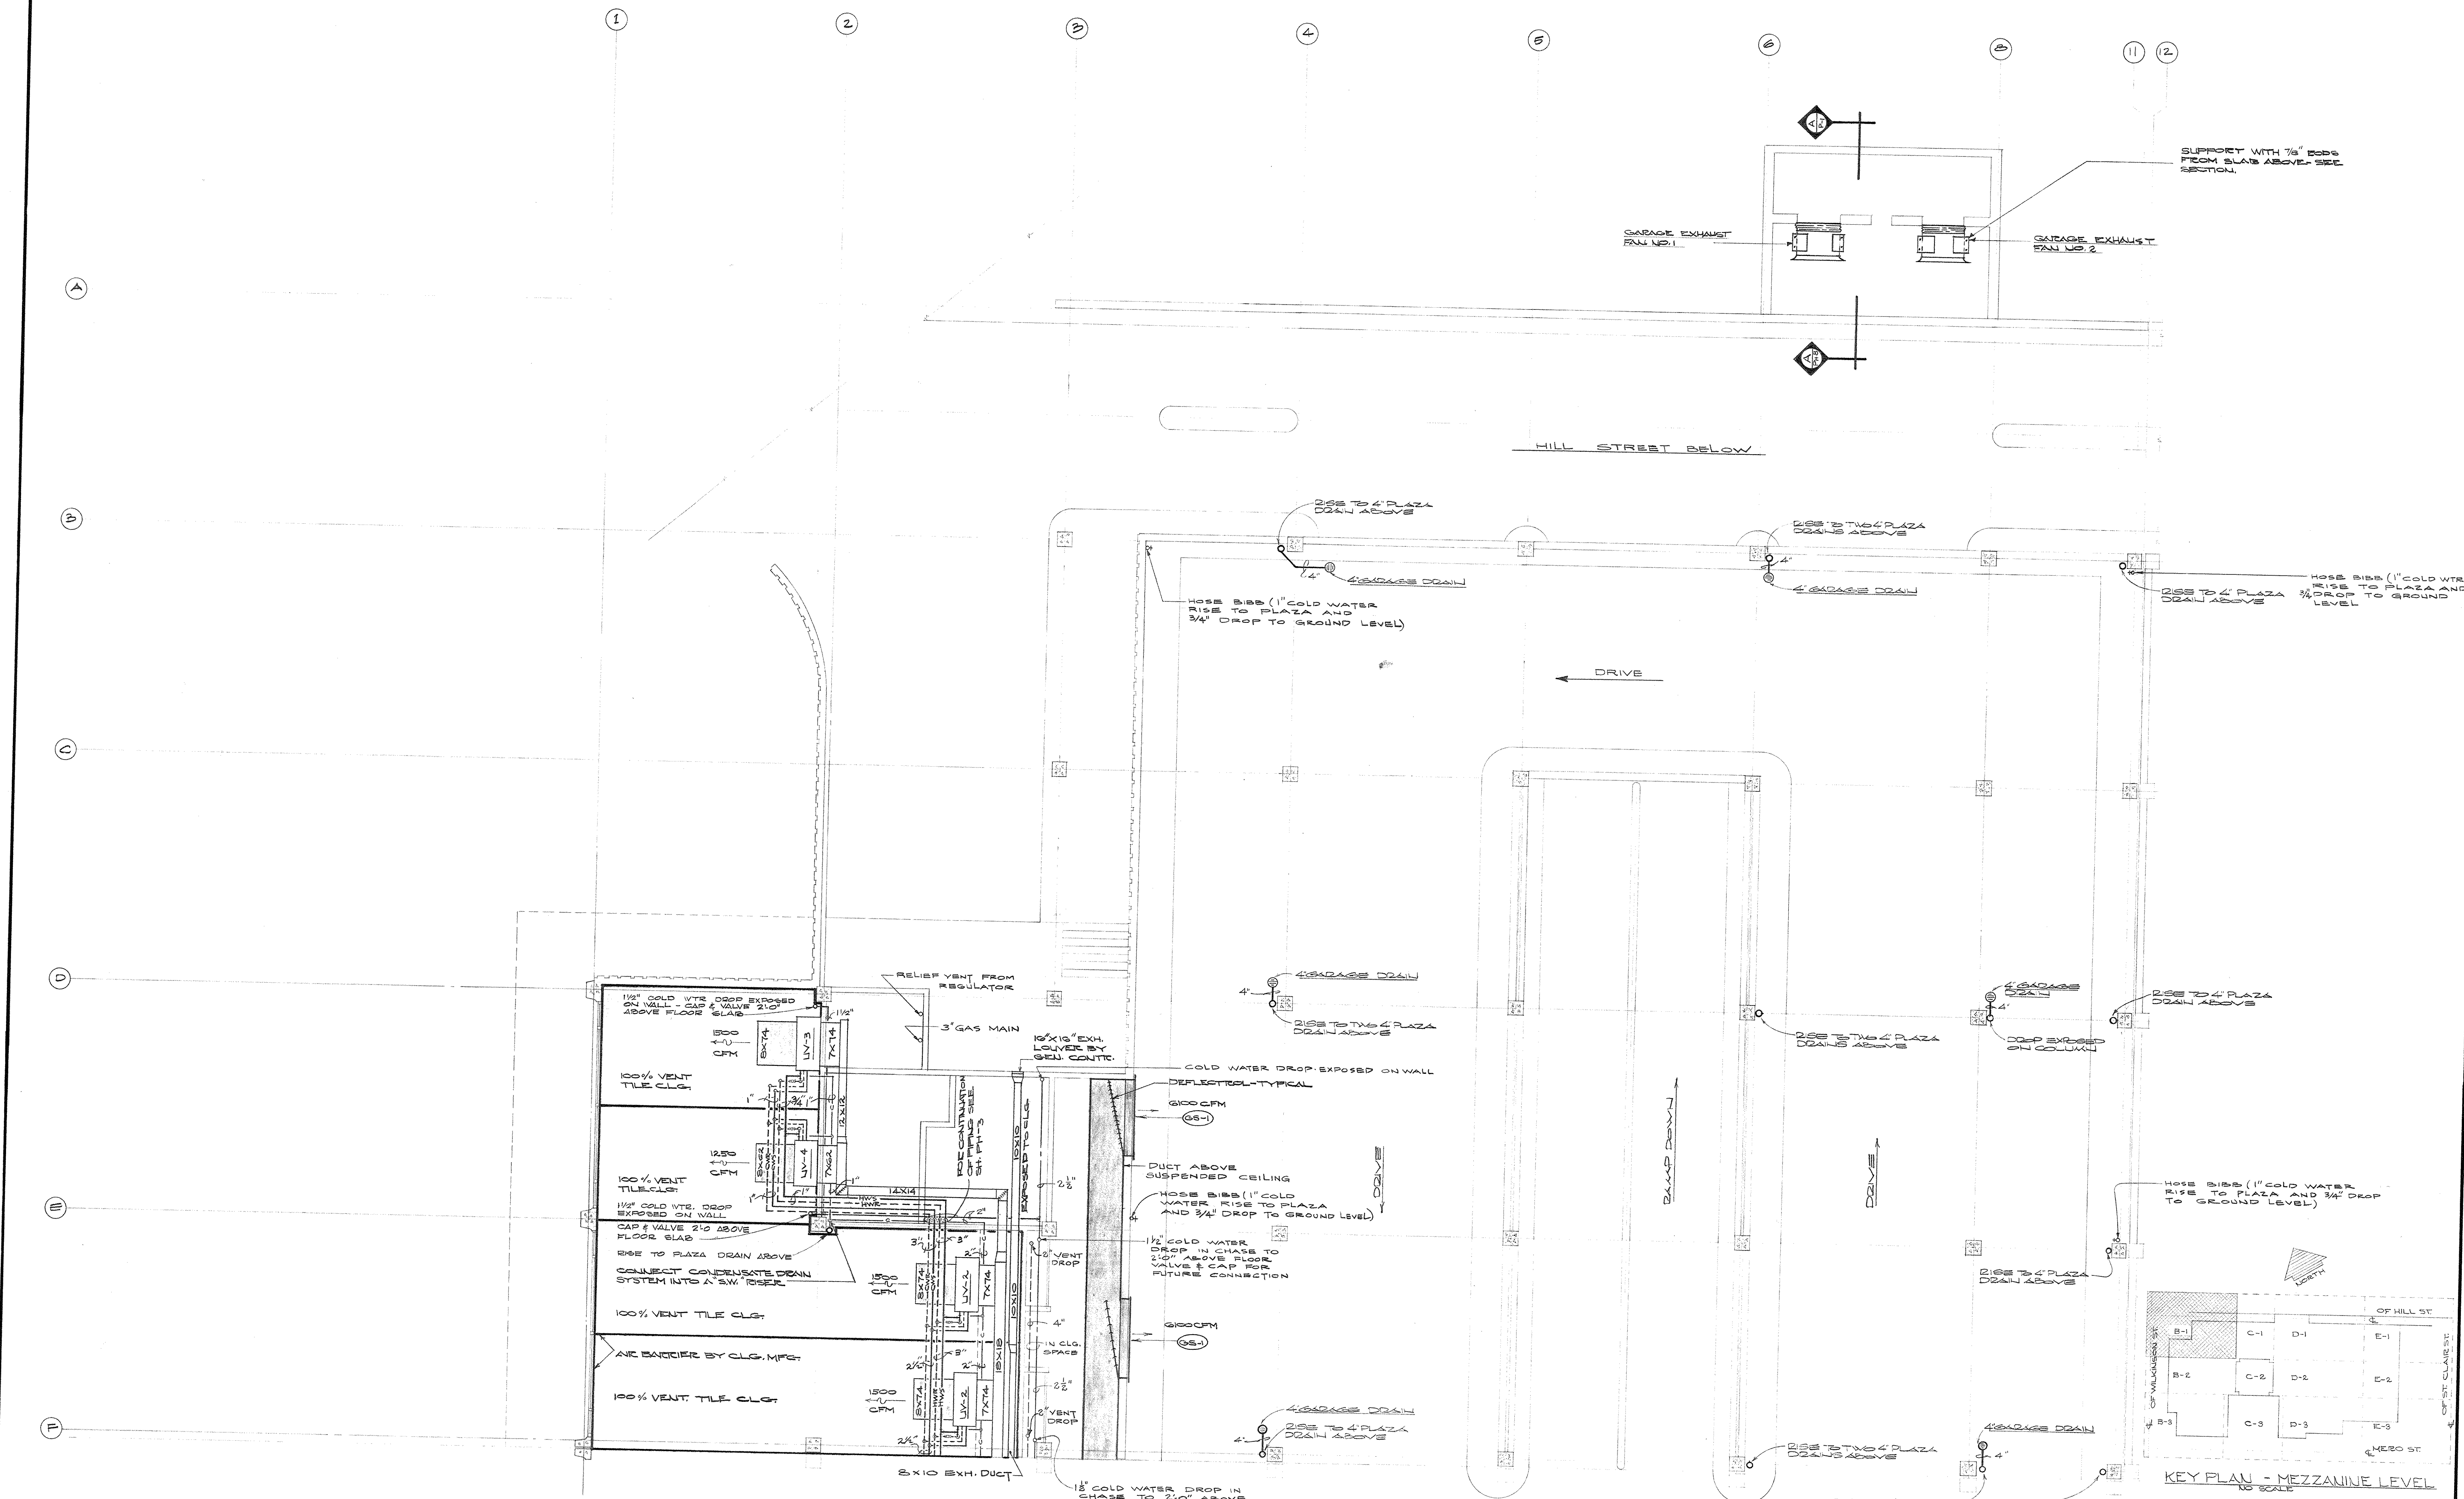


PLUMBING AND AIR CONDITIONING PLAN - MEZZANINE LEVEL - SECTOR B-1
SCALE 1/8" = 1'-0"

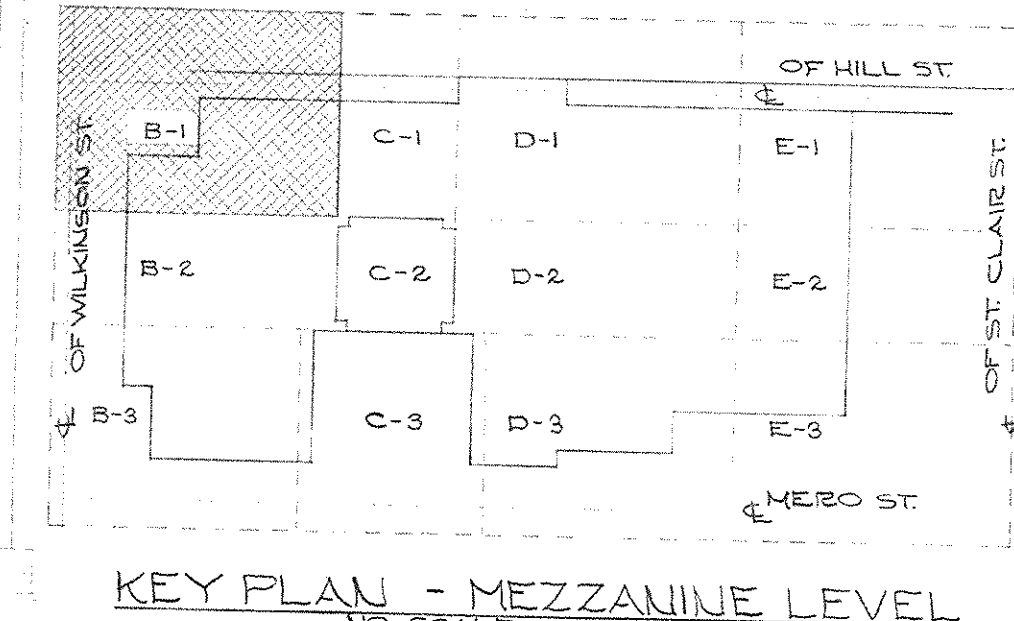


CAPITAL PLAZA OFFICE BUILDING		
FRANKFORT, KENTUCKY		
DRAWN BY DS	PLUMBING AND AIR CONDITIONING PLAN - MEZZANINE LEVEL - SECTOR B-1	DATE 15, MAY, 1967
TRACED BY DS	ARCHITECT EDWARD DURELL STONE	SCALE 1/8" = 1'-0"
CHECKED BY G.S.C.	7 EAST 67TH STREET NEW YORK N. Y.	COMM. NO. 20000
SECTOR NO. B 1	ASSOCIATE ARCHITECTS & ENGINEERS LEE POTTER SMITH & ASSOCIATES 314 WILKINSON FRANKFORT, KENTUCKY	DRAWING NO. PH 8
	COMMONWEALTH OF KENTUCKY DEPARTMENT OF FINANCE - ENGINEERING STAFF FRANKFORT, KENTUCKY	OF PH - 31
APPROVED BY	ARCHITECT	DATE
APPROVED BY	AGENCY HEAD	DATE
APPROVED BY	OWNER	DATE

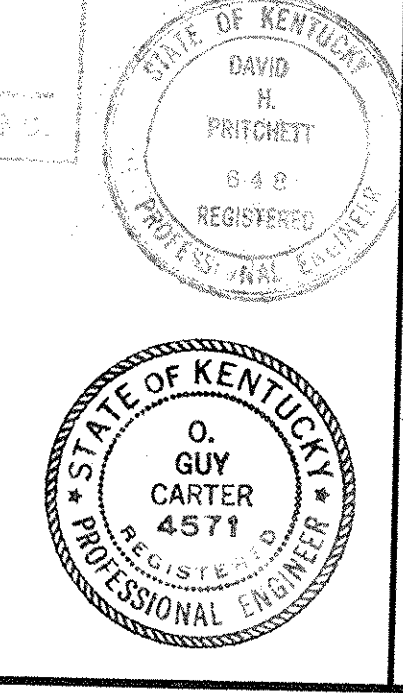


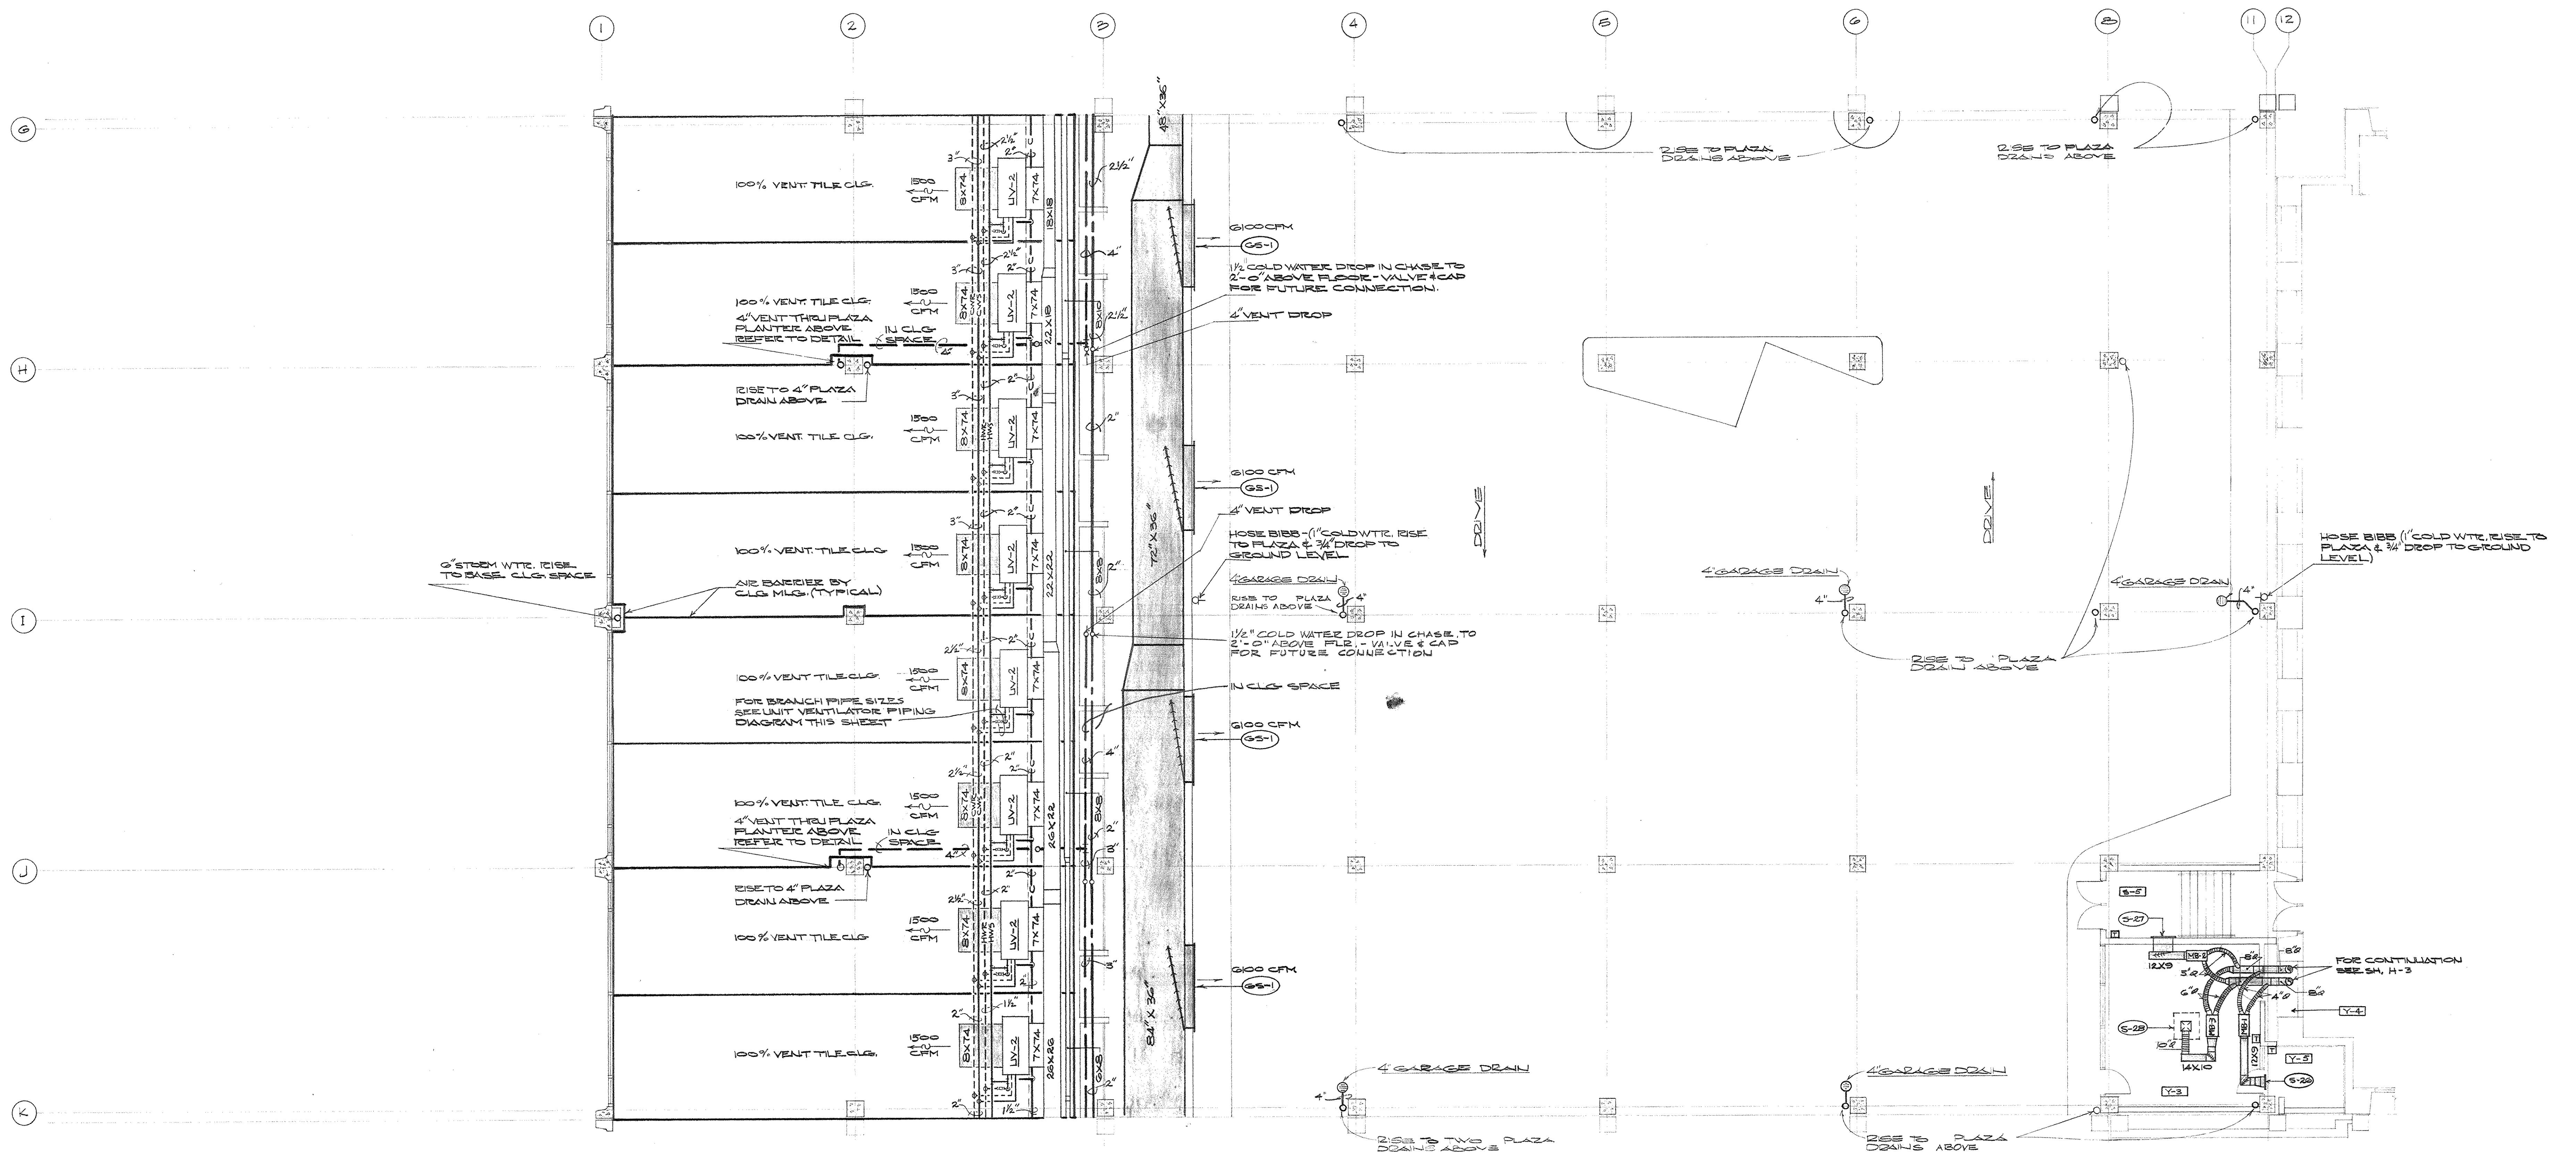


PLUMBING AND AIR CONDITIONING PLAN - MEZZANINE LEVEL - SECTOR B-2
SCALE - 1/8" = 1'-0"

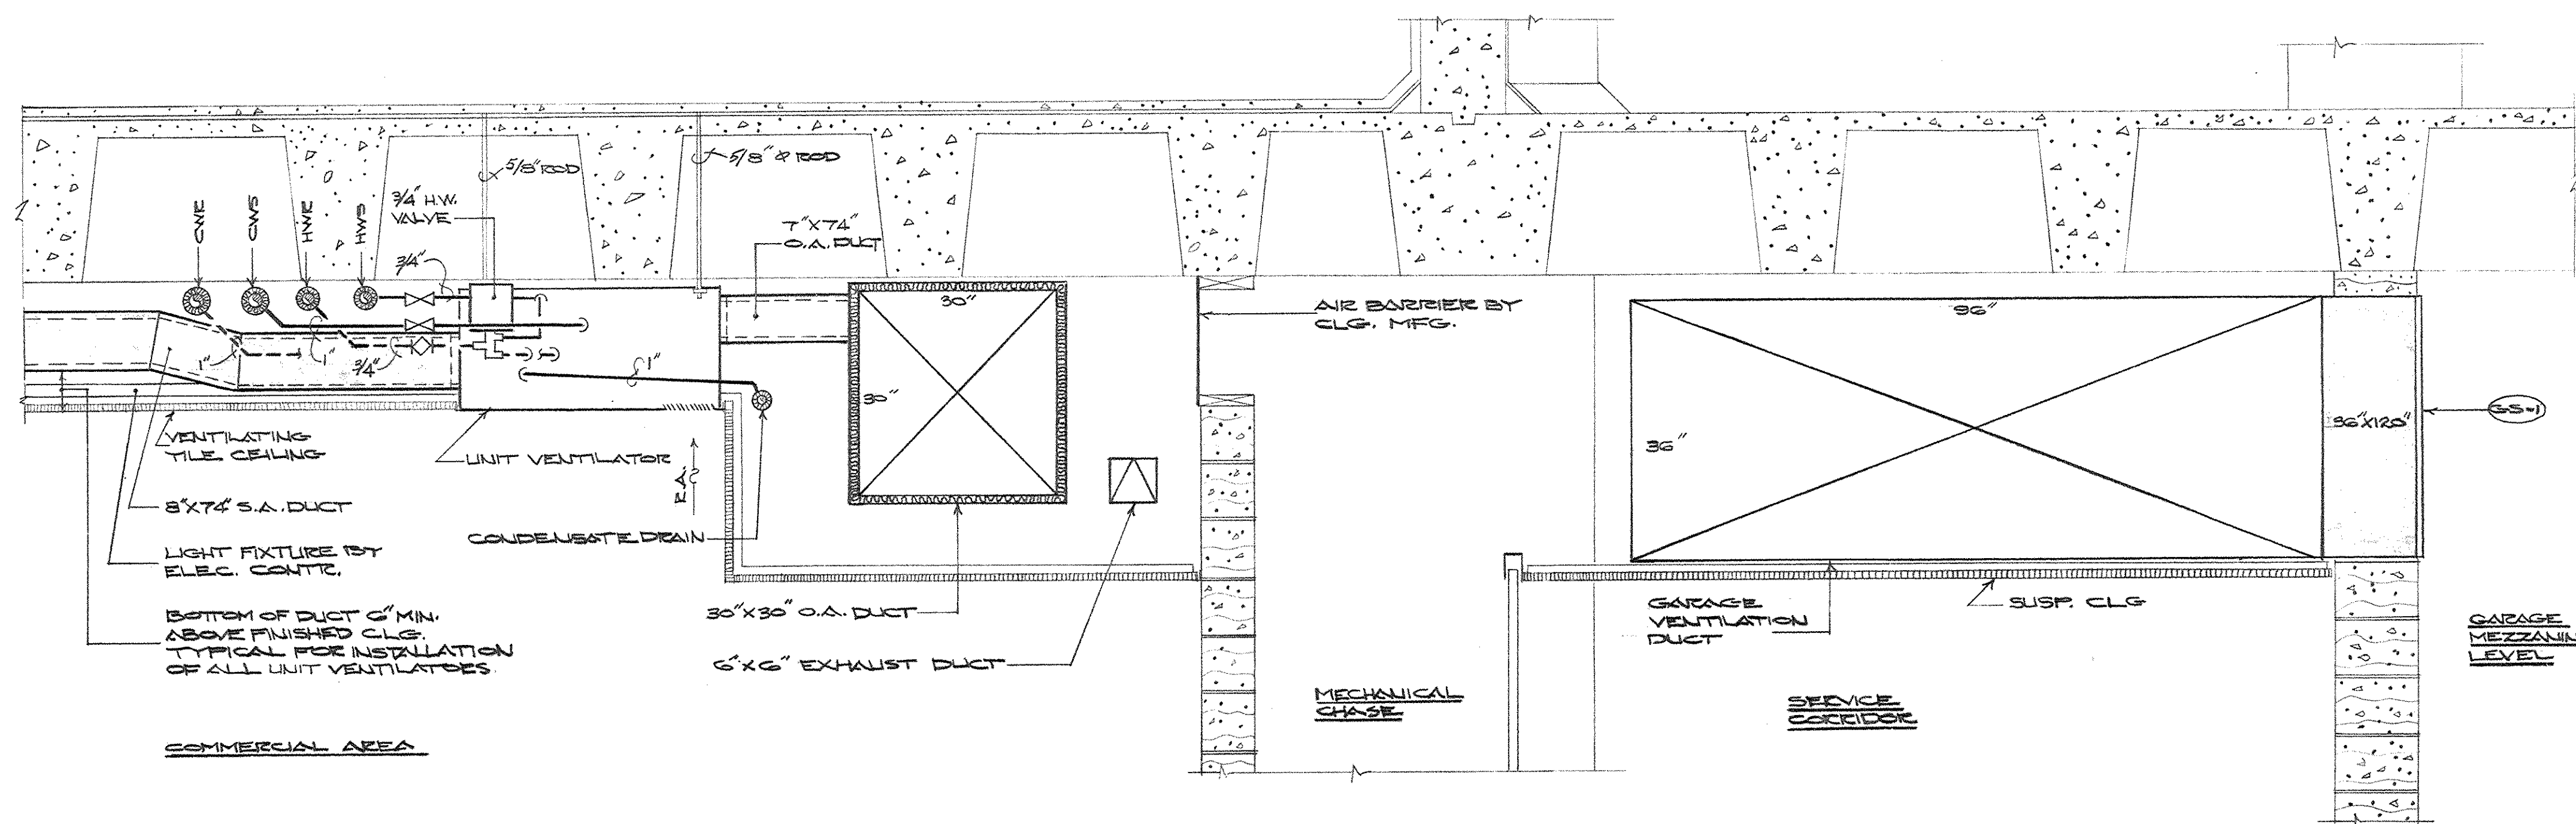

SECTION
SCALE 3/8" = 1'-0"

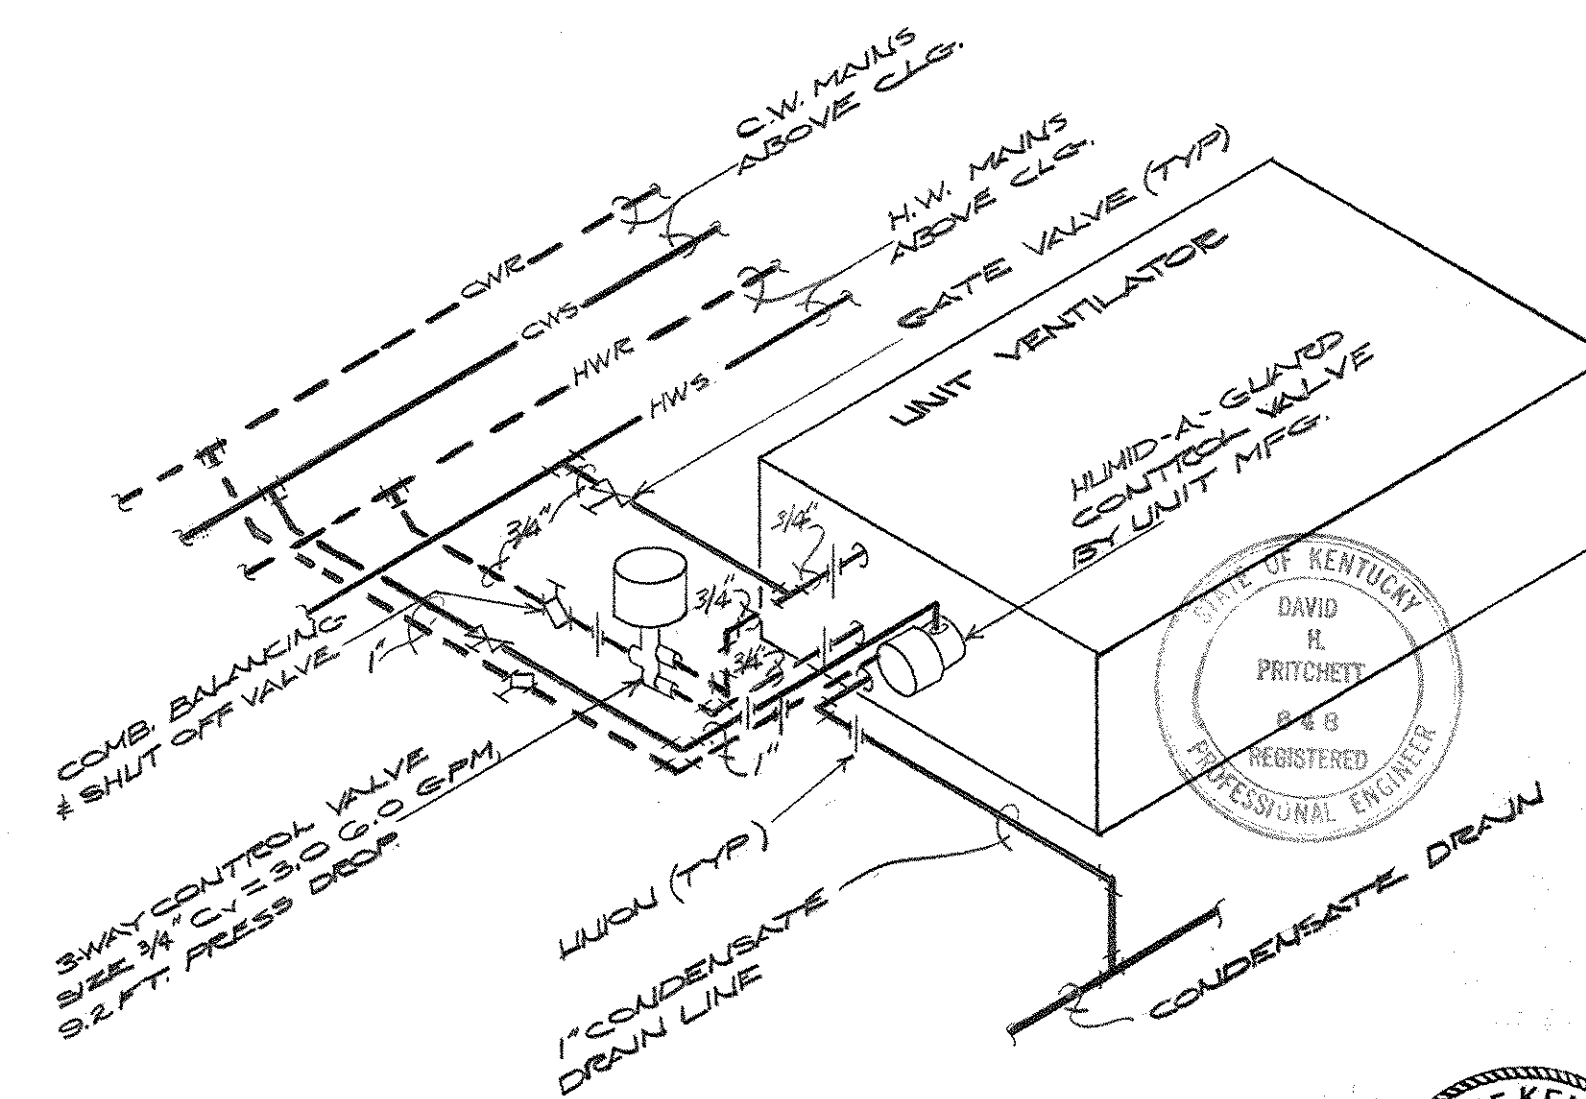



UNIT VENTILATOR PIPING DIAGRAM
NO SCALE

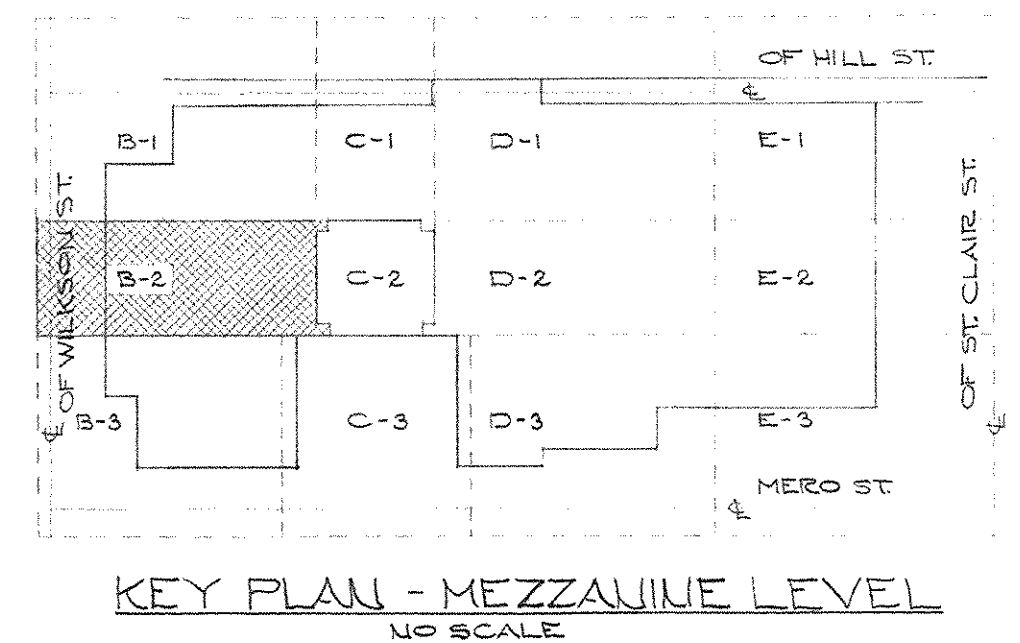


KEY PLAN - MEZZANINE LEVEL
NO SCALE

CAPITAL PLAZA OFFICE BUILDING		
FRANKFORT, KENTUCKY		
DRAWN BY C.O.G.C.P. 5	ARCHITECT EDWARD DURELL STONE 7 EAST 67TH STREET NEW YORK, N. Y.	DATE 15 MAY, 1967
TRACED BY D.S.	ASSOCIATE ARCHITECTS & ENGINEERS LEE POTTER SMITH & ASSOCIATES 314 WILKINSON FRANKFORT, KENTUCKY	SCALE 1/8" = 1'-0"
CHECKED BY O.G.C.C.	COMMONWEALTH OF KENTUCKY DEPARTMENT OF FINANCE - ENGINEERING STAFF FRANKFORT, KENTUCKY	COMM. NO. 50066
SECTOR NO. B 2		DRAWING NO. PH 9
APPROVED BY ARCHITECT	DATE	OF PH-31
APPROVED BY AGENCY HEAD <i>W. J. Mc Connell</i>	DATE 2 4 1967	
APPROVED BY OWNER	DATE	

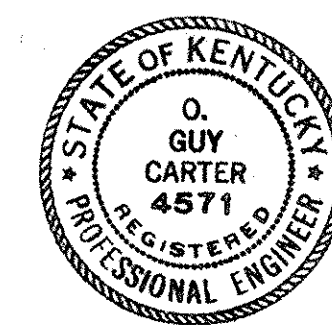

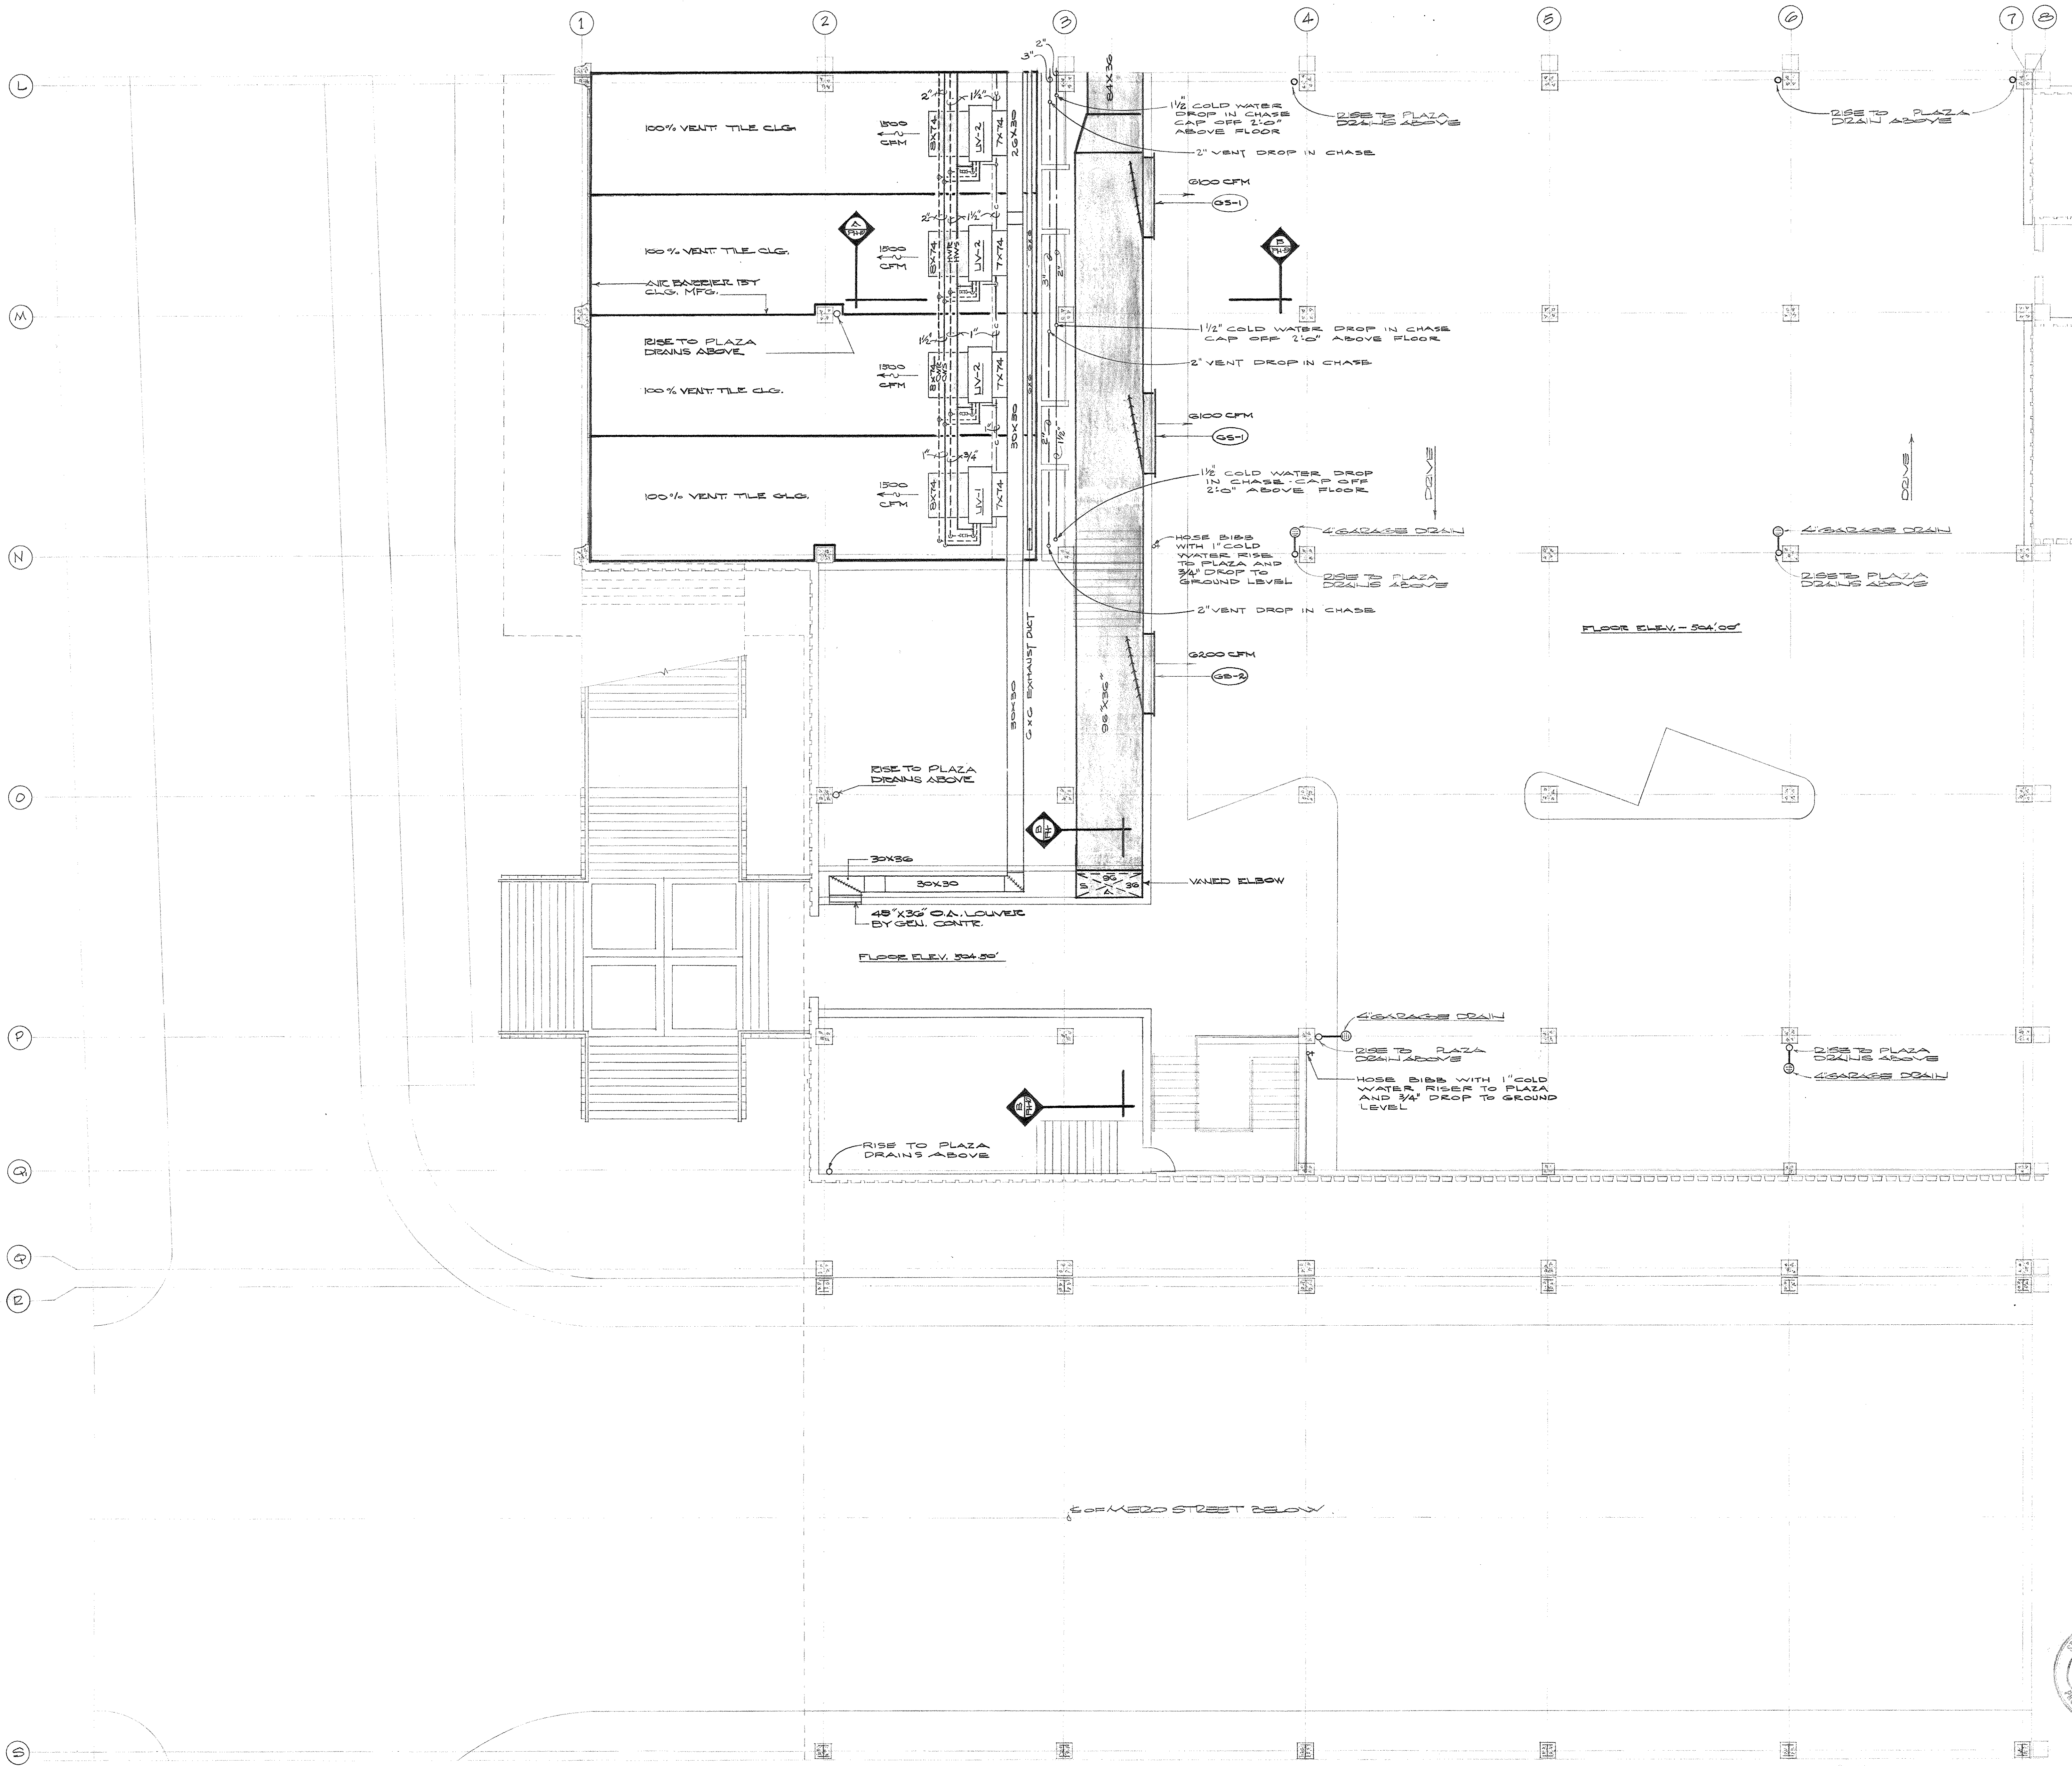


PLUMBING AND AIR CONDITIONING PLAN - MEZZANINE LEVEL - SECTOR B-3
 SCALE - 1/8" = 1'-0"

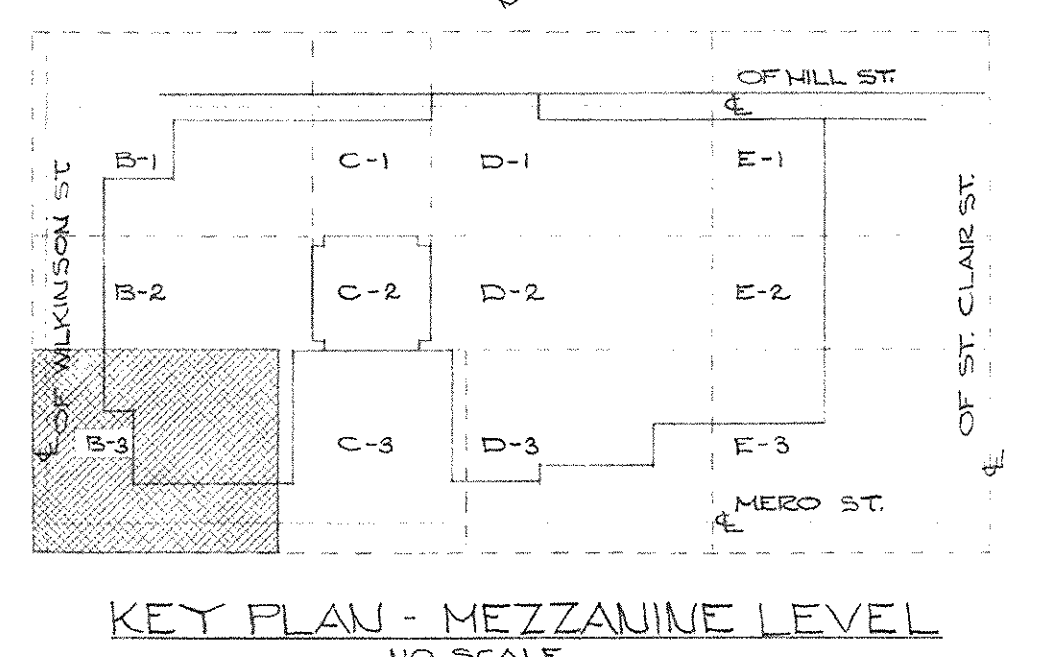


CAPITAL PLAZA OFFICE BUILDING
 FRANKFORT, KENTUCKY


DRAWN BY O.C.D.S. TRACED BY D.S. CHECKED BY O.G.C. SECTOR NO. B 3	PLUMBING AND AIR CONDITIONING PLAN - MEZZANINE LEVEL - SECTOR B-3 ARCHITECT EDWARD DURELL STONE 7 EAST 67TH STREET ASSOCIATE ARCHITECTS & ENGINEERS LEE POTTER SMITH & ASSOCIATES 314 WILKINSON COMMONWEALTH OF KENTUCKY DEPARTMENT OF FINANCE - ENGINEERING STAFF FRANKFORT, KENTUCKY	DATE 15, MAY, 1967 SCALE 1/8" = 1'-0" COMM. NO. 50266 DRAWING NO. PH 10 OF PH-31
--	---	--

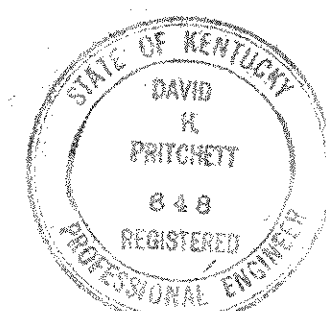

APPROVED BY	ARCHITECT	DATE
APPROVED BY	AGENCY HEAD	DATE
APPROVED BY	OWNER	DATE

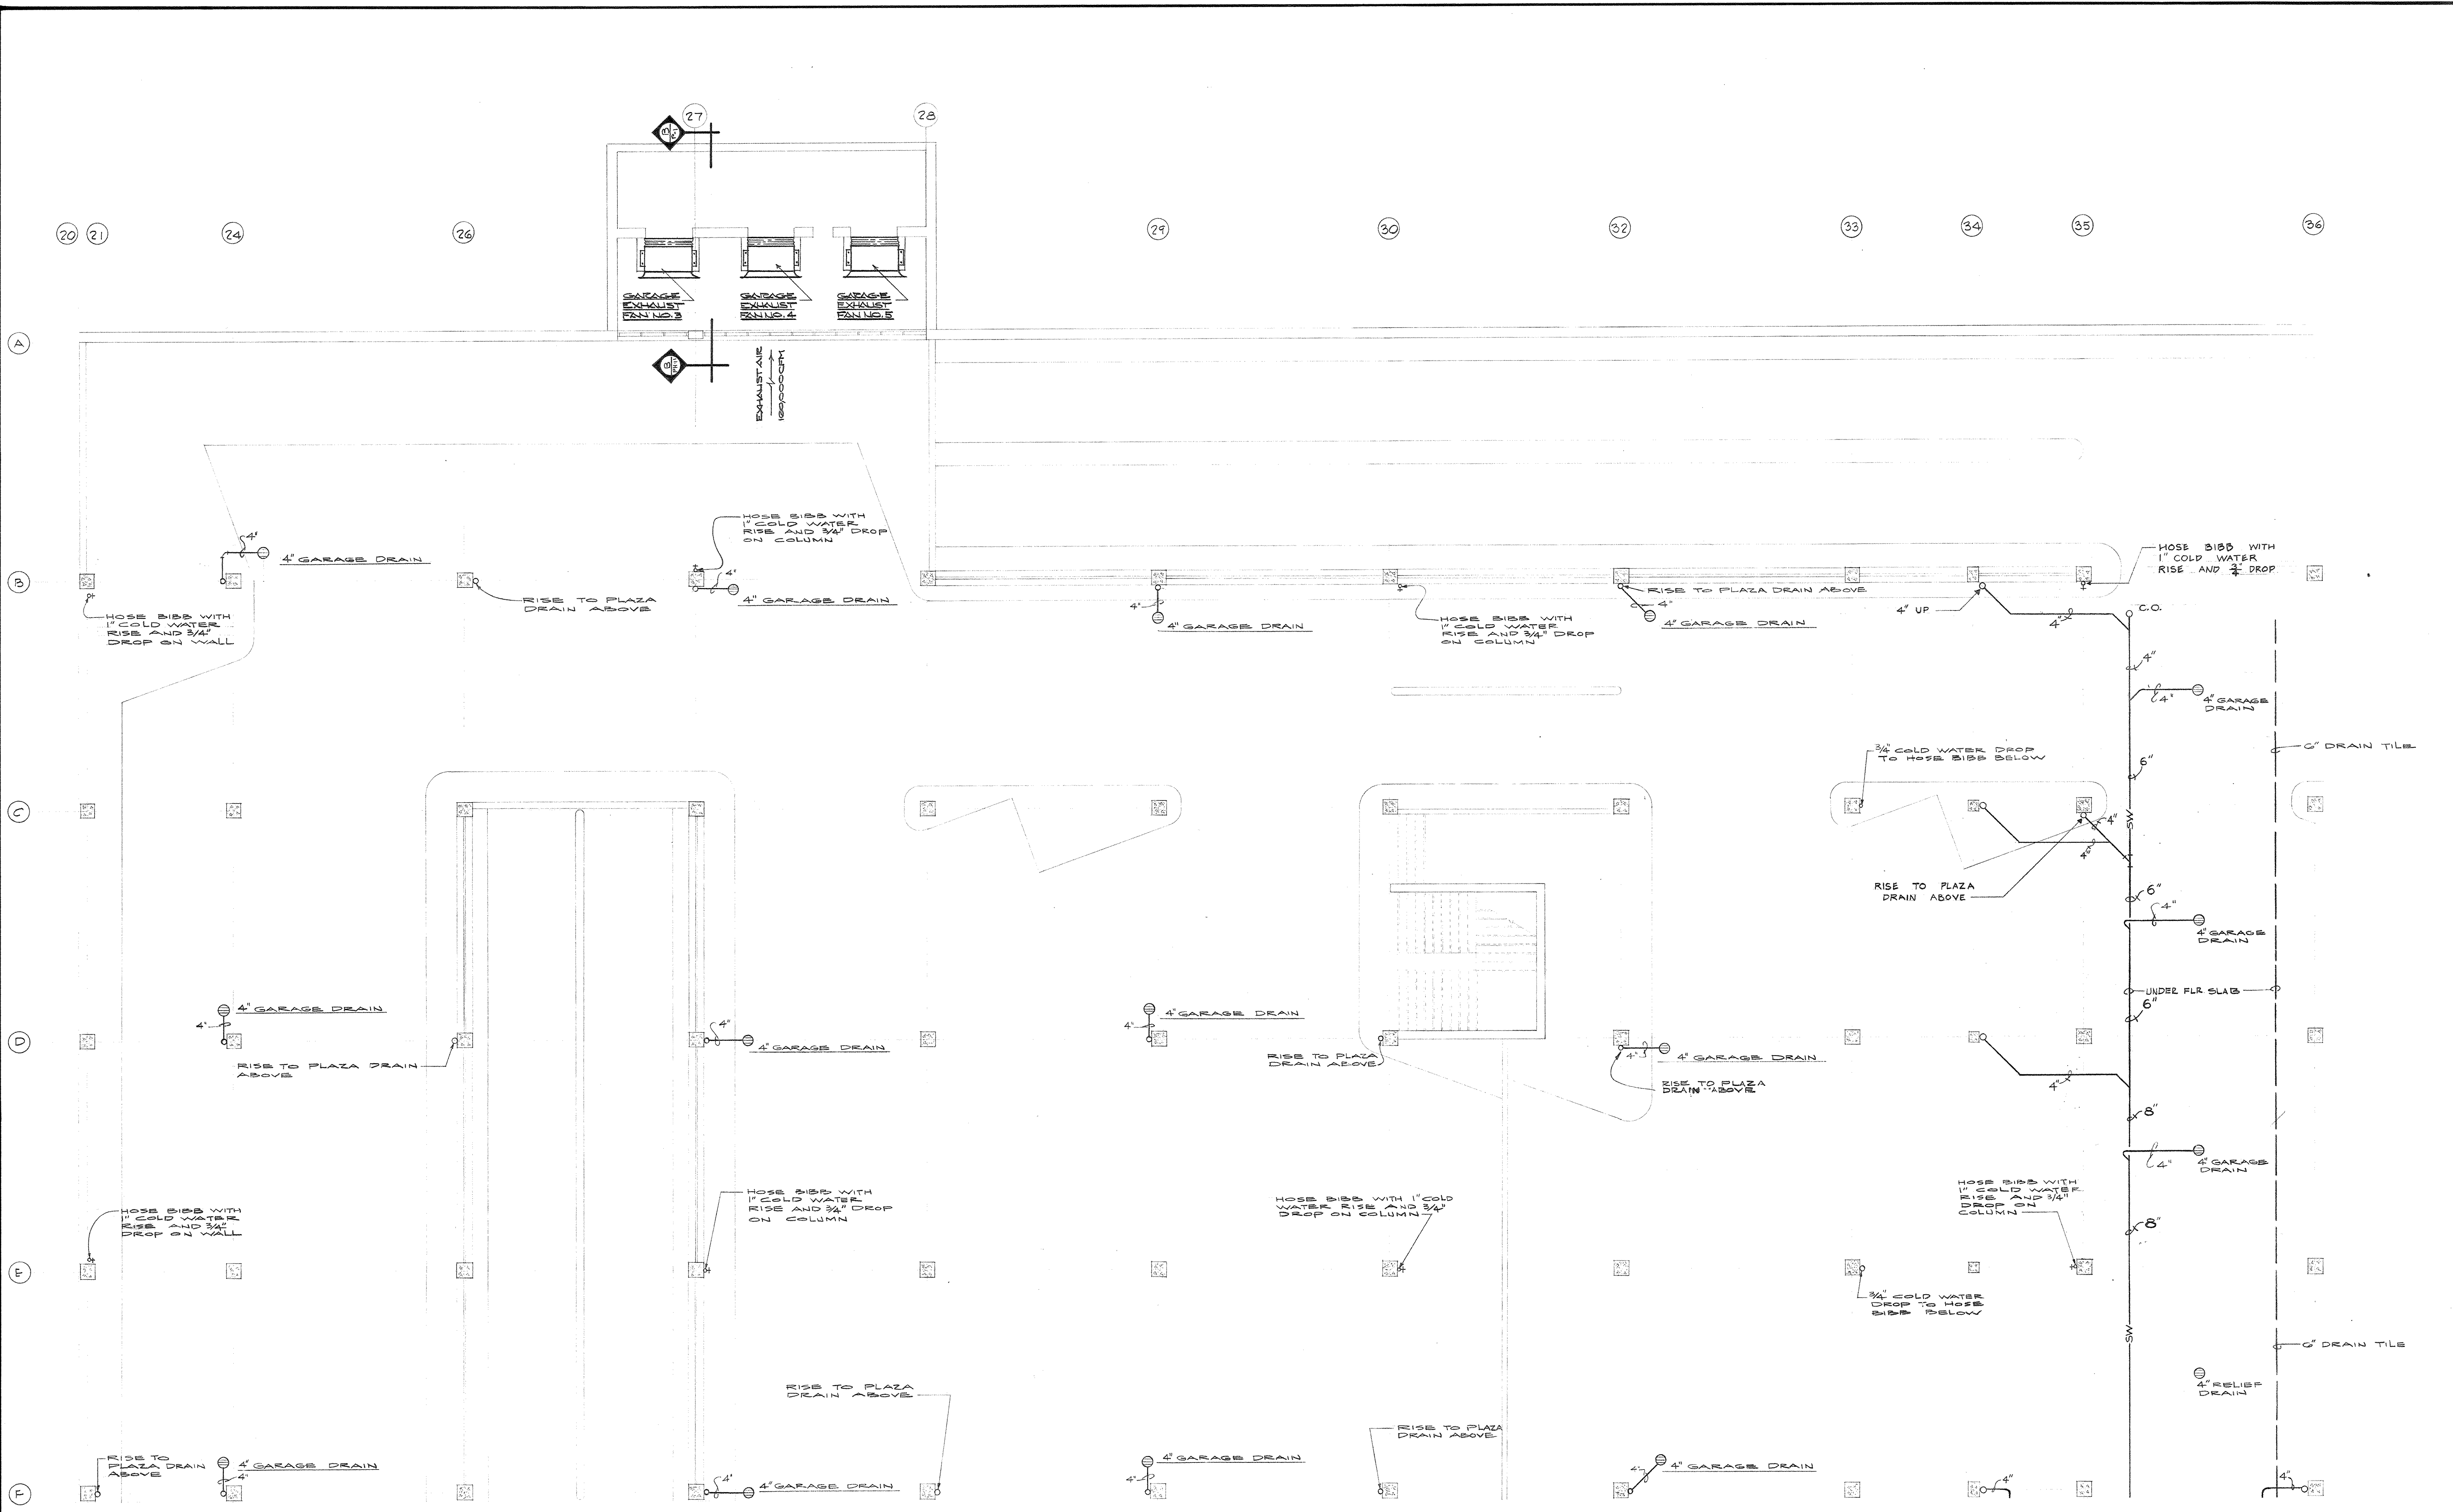



PLUMBING AND VENTILATING PLAN - MEZZANINE LEVEL - SECTOR D-1
SCALE - 1/8" = 1'-0"

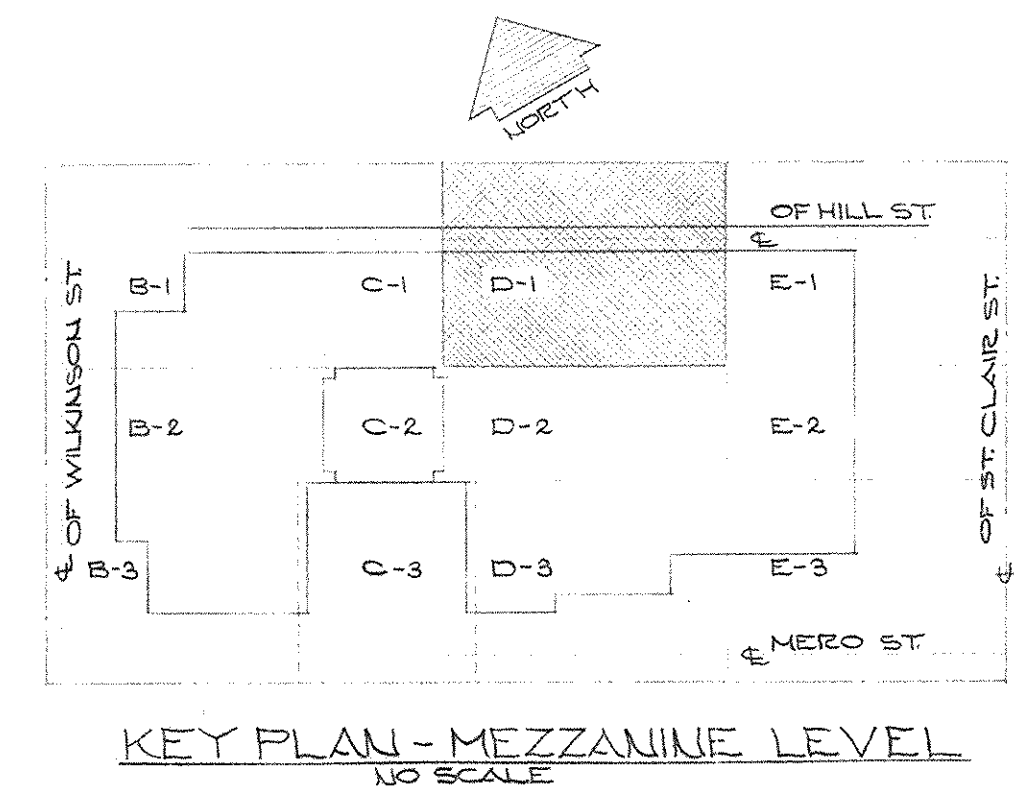


AS BUILT REVISIONS AUGUST 1972


CAPITAL PLAZA OFFICE BUILDING
FRANKFORT, KENTUCKY

DRAWN BY DS	PLUMBING AND VENTILATING PLAN - MEZZANINE LEVEL - SECTOR D-1	DATE 15 MAY 1967
TRACED BY DS	ARCHITECT EDWARD DURELL STONE	SCALE 1/8"
CHECKED BY SAC	7 EAST 67TH STREET NEW YORK N.Y.	COMM. NO. 25-664
SECTOR NO. D 1	ASSOCIATE ARCHITECTS & ENGINEERS LEE POTTER SMITH & ASSOCIATES FRANKFORT, KENTUCKY	DRAWING NO. PH 11
APPROVED BY	COMMONWEALTH OF KENTUCKY DEPARTMENT OF FINANCE - ENGINEERING STAFF FRANKFORT, KENTUCKY	OF PH - 31
APPROVED BY	ARCHITECT	DATE
APPROVED BY	AGENCY HEAD <i>W. J. McConnelly</i>	DATE
APPROVED BY	OWNER	DATE

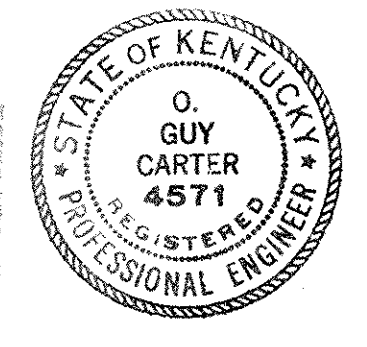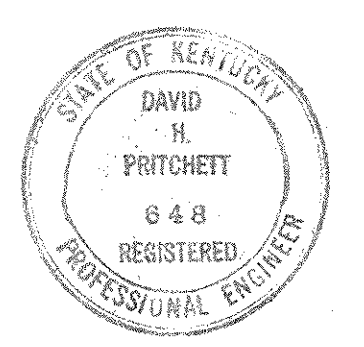

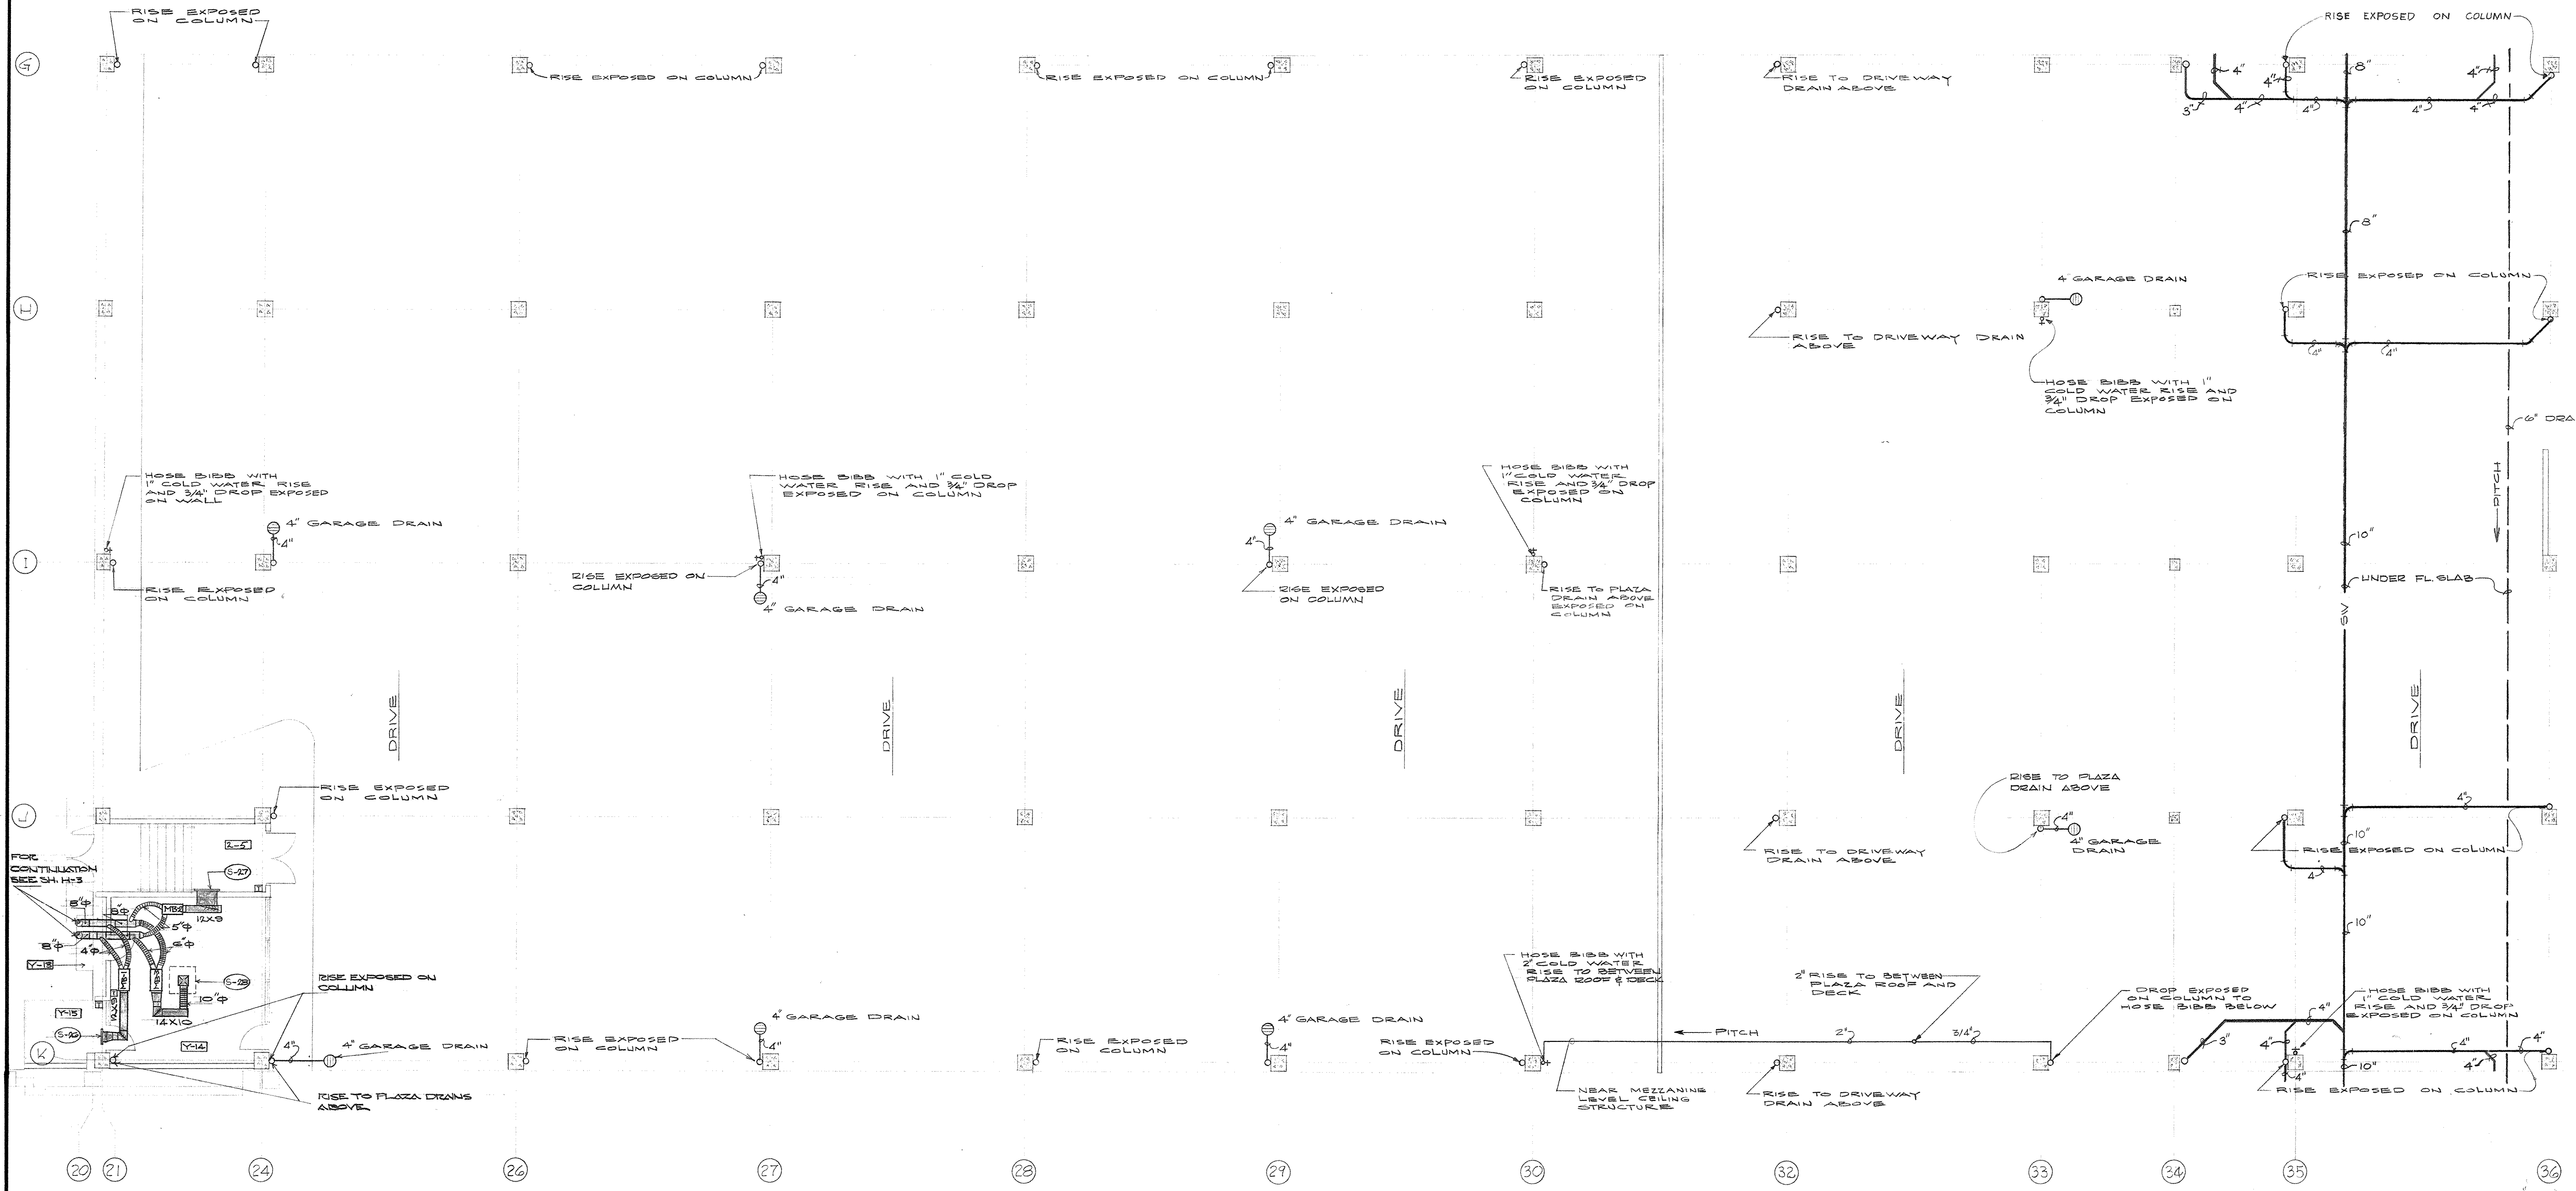



PLUMBING AND VENTILATING PLAN - MEZZANINE LEVEL - SECTOR D-2
SCALE 1/8" = 1'-0"

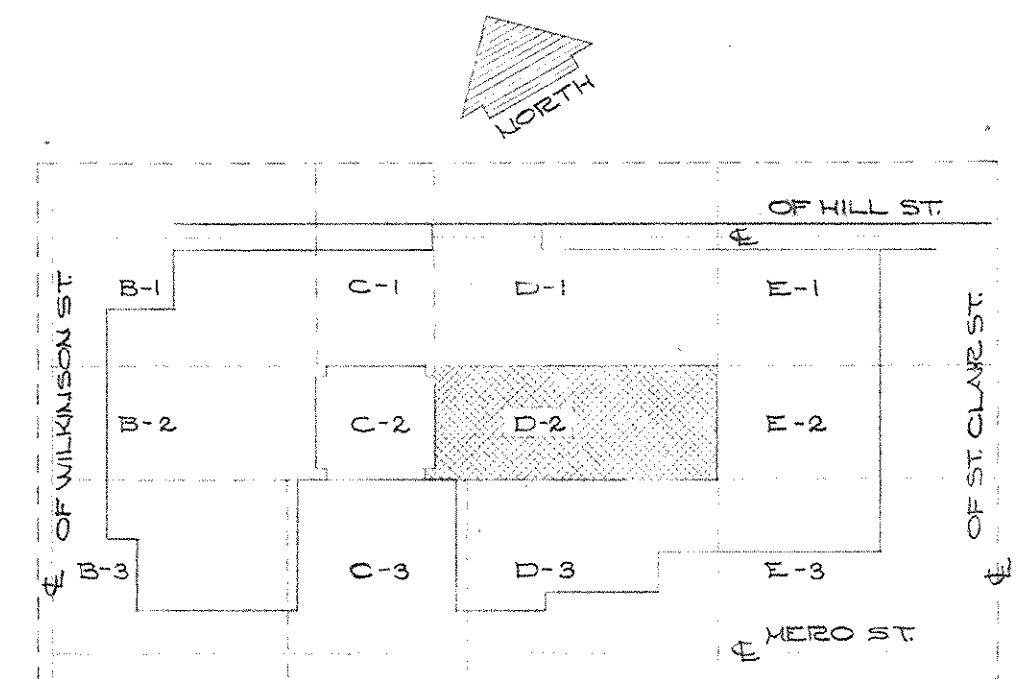


KEY PLAN - MEZZANINE LEVEL
NO SCALE


CAPITAL PLAZA OFFICE BUILDING
FRANKFORT, KENTUCKY

DRAWN BY DS TRACED BY DS CHECKED BY GOC SECTOR NO. D 2 APPROVED BY APPROVED BY APPROVED BY	ARCHITECT EDWARD DURELL STONE 7 EAST 67TH STREET NEW YORK N. Y. ASSOCIATE ARCHITECTS & ENGINEERS LEE POTTER SMITH & ASSOCIATES 314 WILKINSON FRANKFORT, KENTUCKY COMMONWEALTH OF KENTUCKY DEPARTMENT OF FINANCE - ENGINEERING STAFF FRANKFORT, KENTUCKY	DATE 15 MAY, 1967 SCALE 1/8" = 1'-0" DRAWING NO. 58666 PH 12 of PH-31 DATE MAY 24 1967
---	---	--

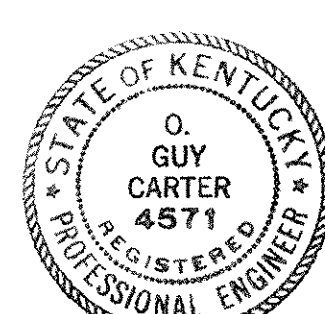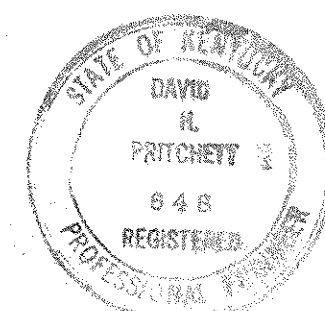

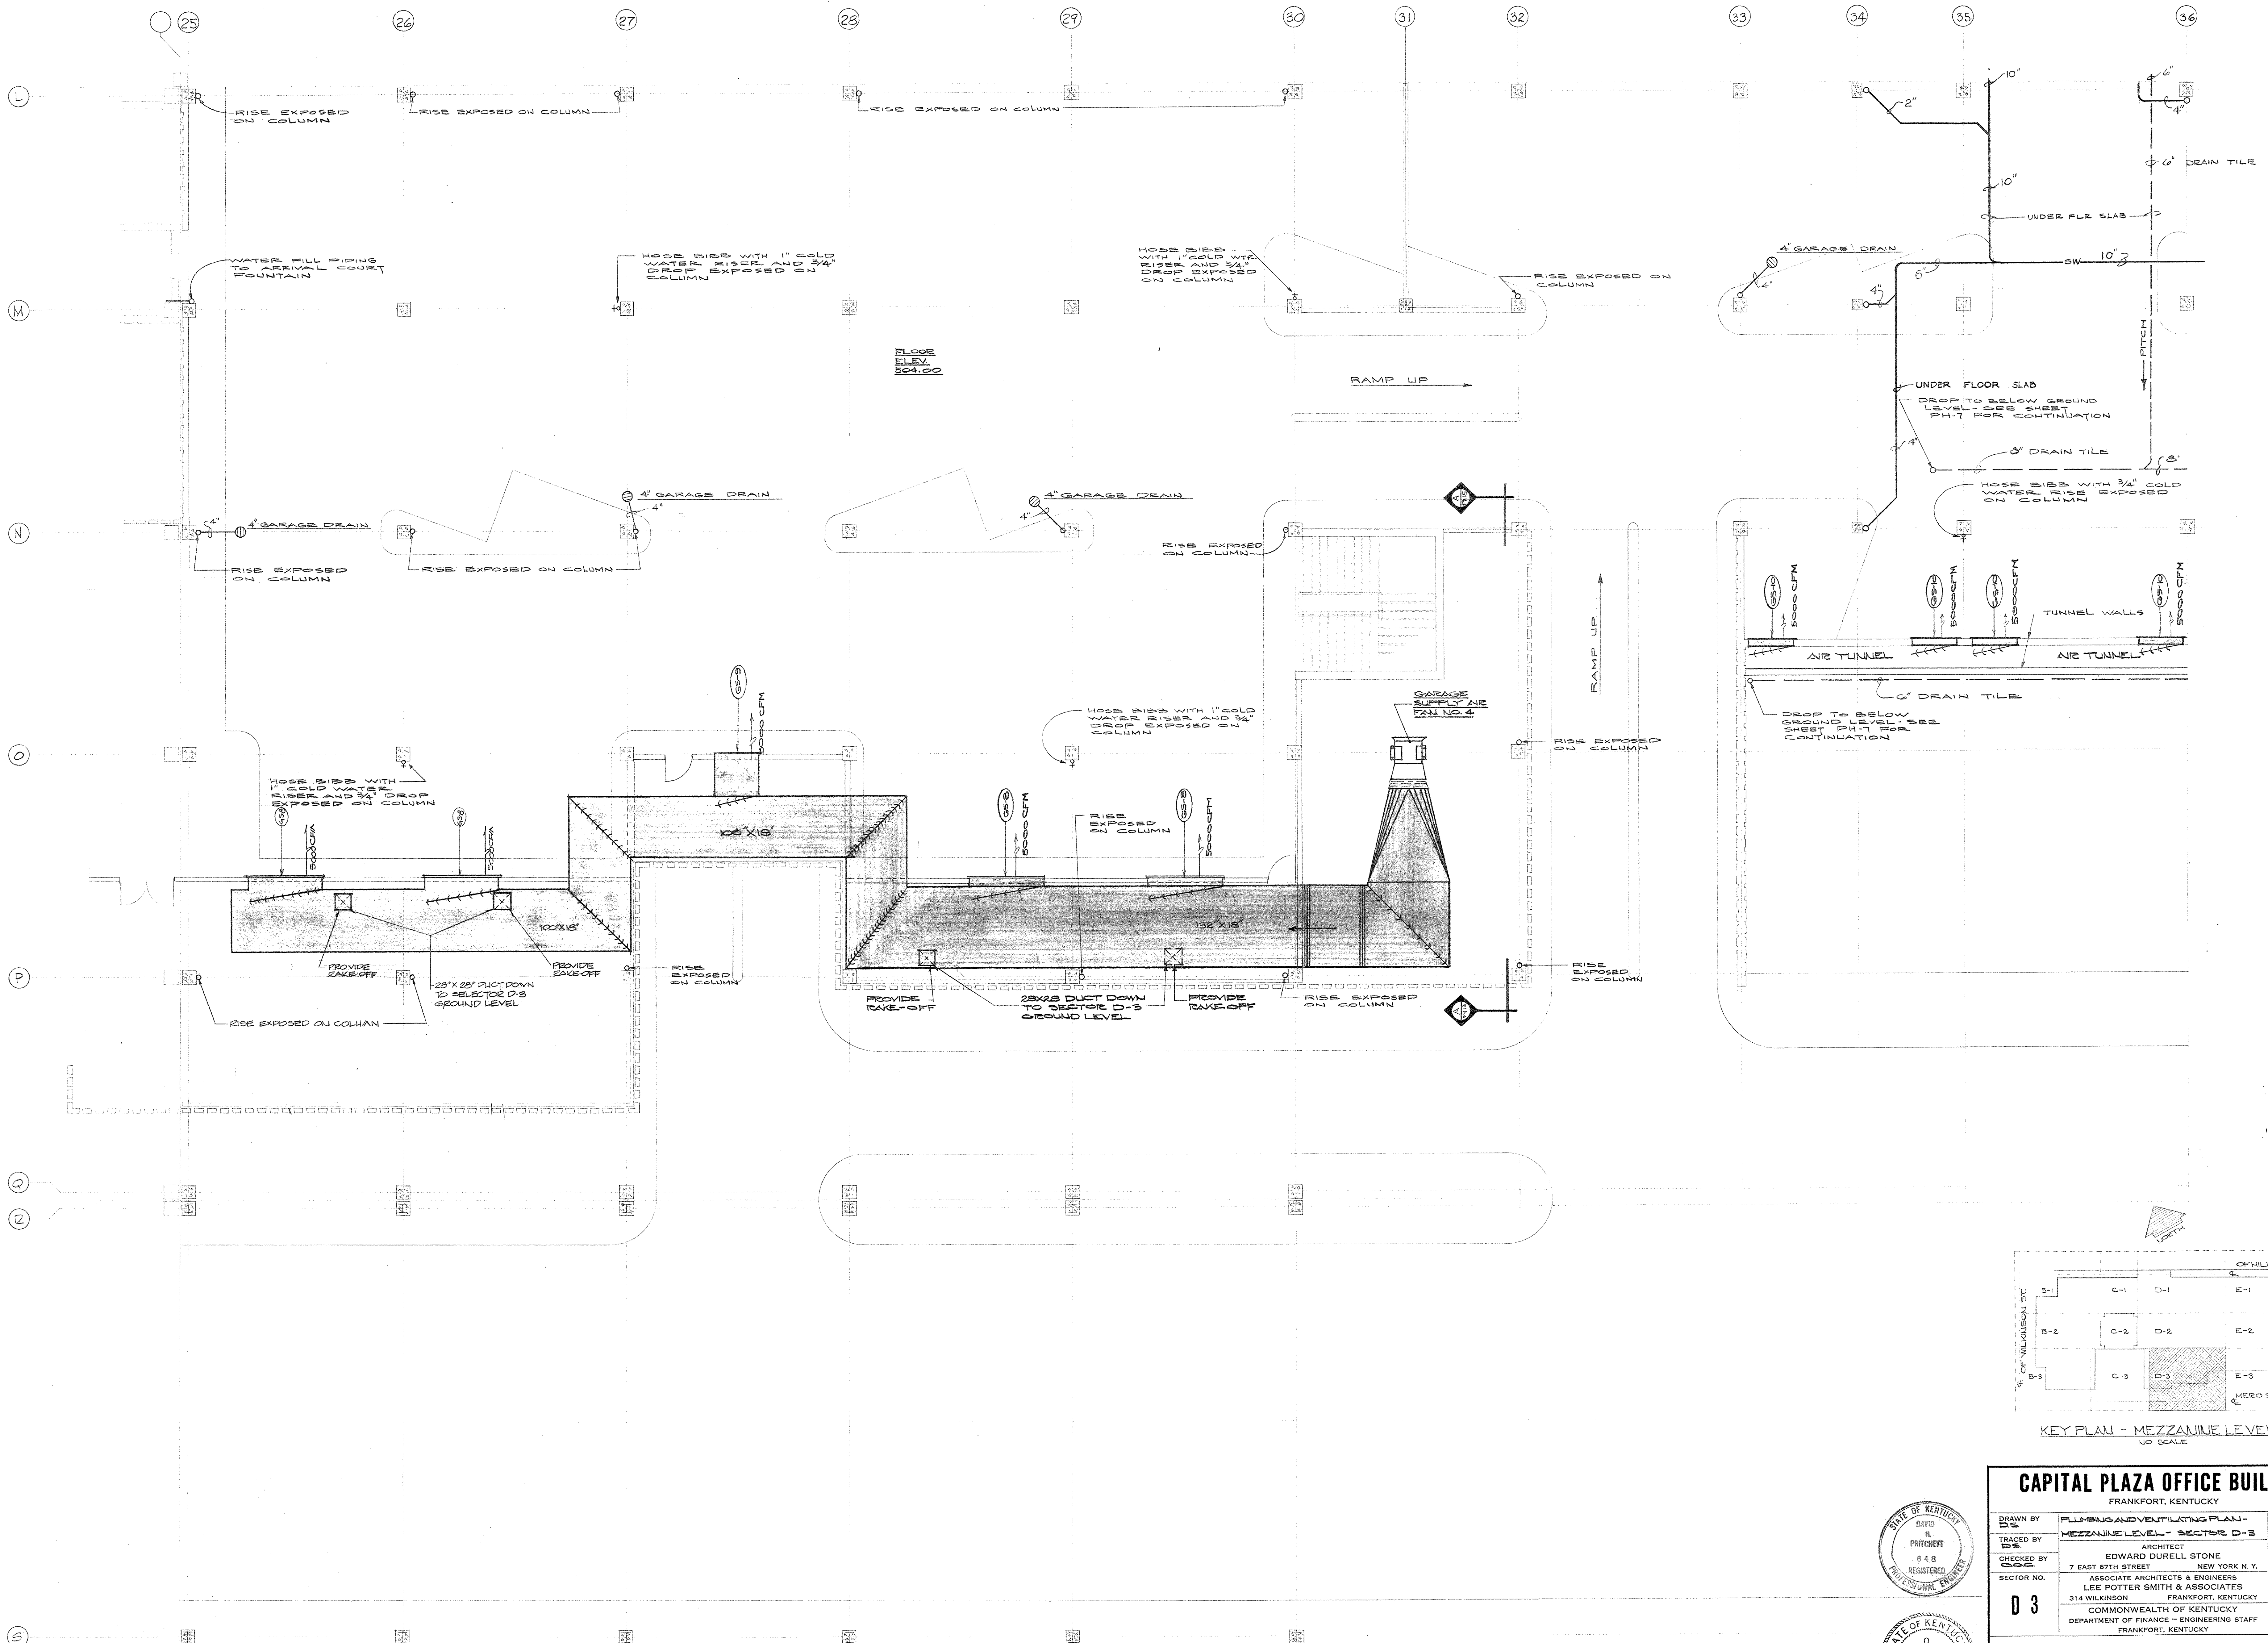



PLUMBING AND VENTILATING PLAN - MEZZANINE LEVEL - SECTOR D-3
SCALE 1/8" = 1'-0"

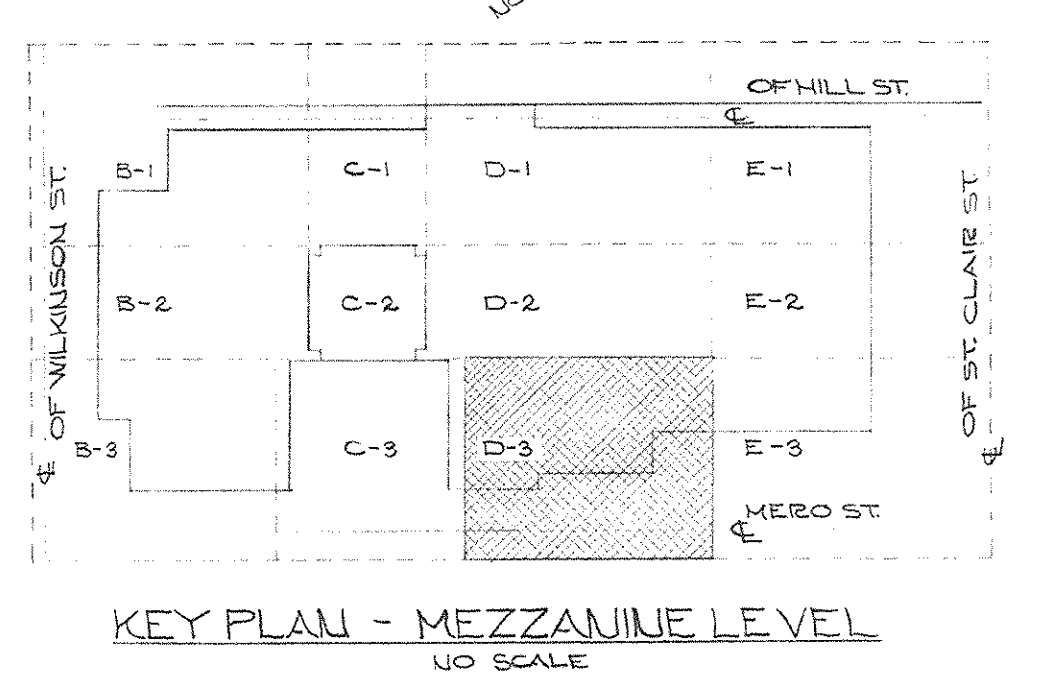


KEY PLAN - MEZZANINE LEVEL
NO SCALE


CAPITAL PLAZA OFFICE BUILDING
FRANKFORT, KENTUCKY

DRAWN BY D 3	PLUMBING AND VENTILATING PLAN - MEZZANINE LEVEL - SECTOR D-3	DATE 15, MAY, 1967
TRACED BY D 3	ARCHITECT	SCALE 1/8" = 1'-0"
CHECKED BY D 3	EDWARD DURELL STONE 7 EAST 6TH STREET NEW YORK N. Y.	COMM. NO. 300000
SECTOR NO. D 3	ASSOCIATE ARCHITECTS & ENGINEERS LEE POTTER SMITH & ASSOCIATES 314 WILKINSON FRANKFORT, KENTUCKY	DRAWING NO. PH 13
APPROVED BY ARCHITECT	DATE	OF PH-31
APPROVED BY OWNER	DATE MAY 24 1967	

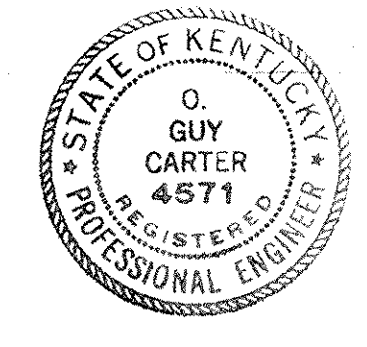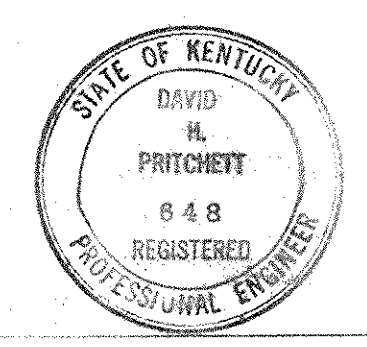

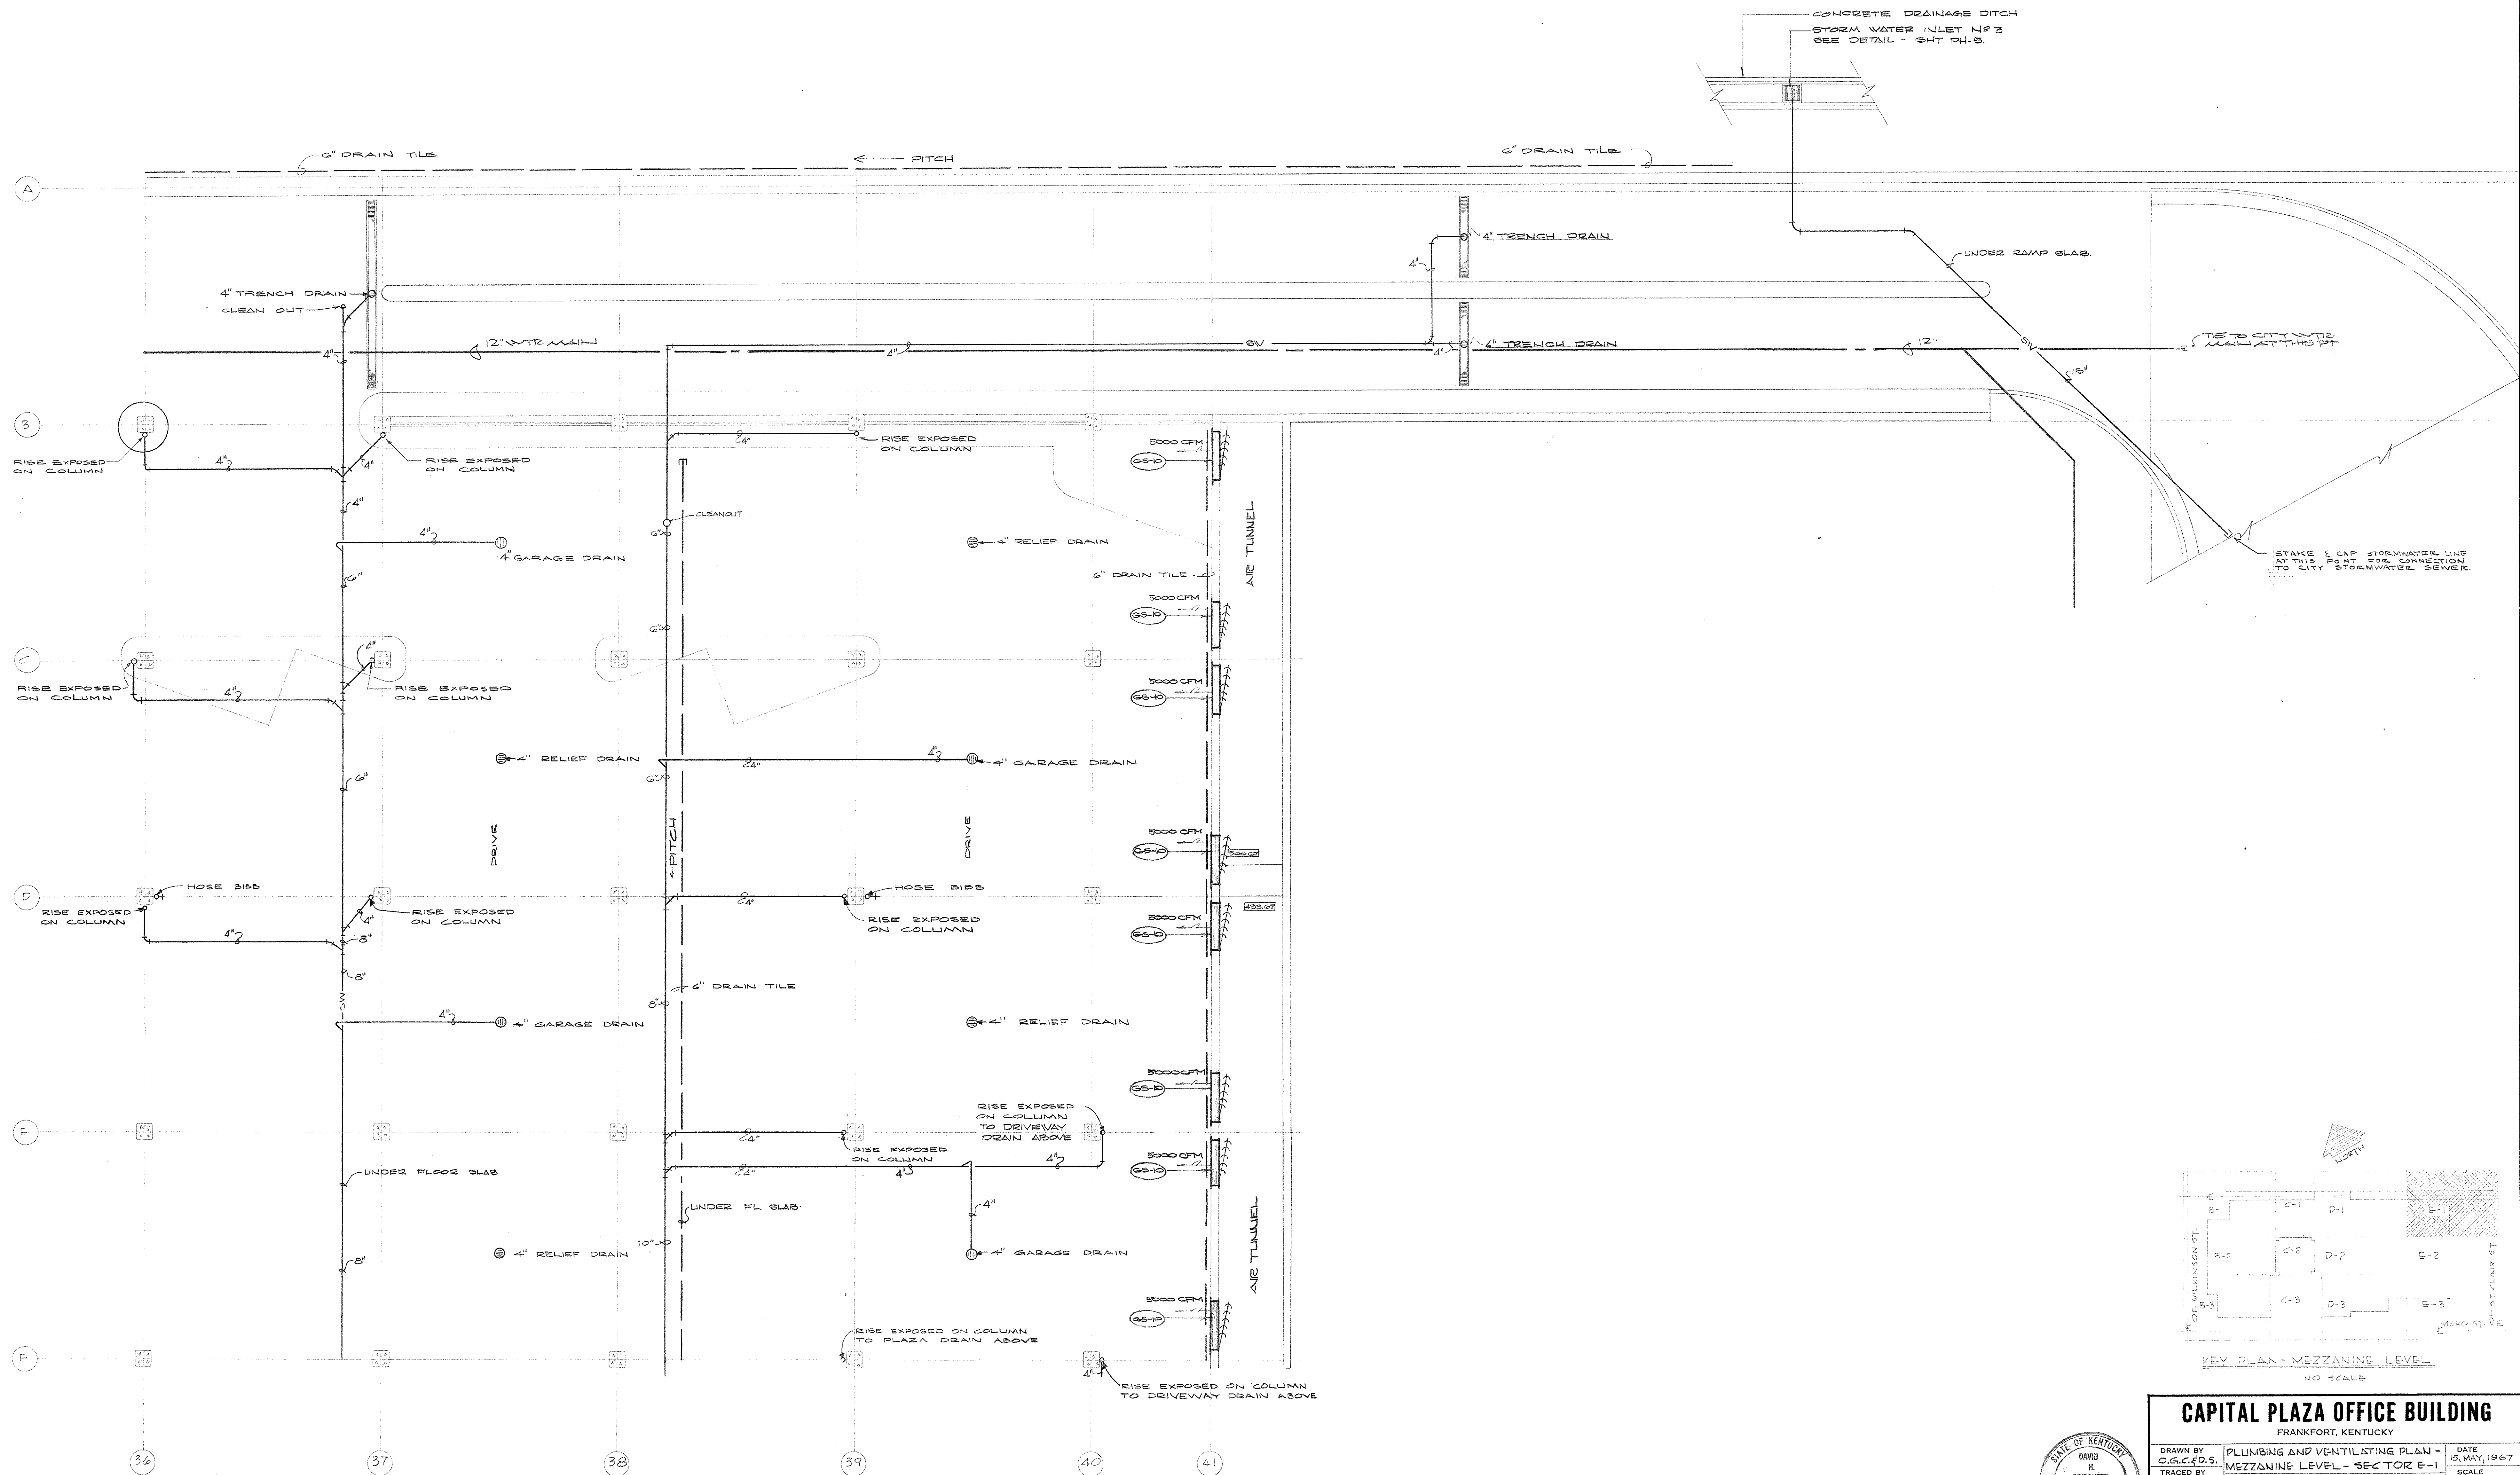




PLUMBING AND VENTILATING PLAN - MEZZANINE LEVEL - SECTOR E-1
SCALE - 1/8" = 1'-0"

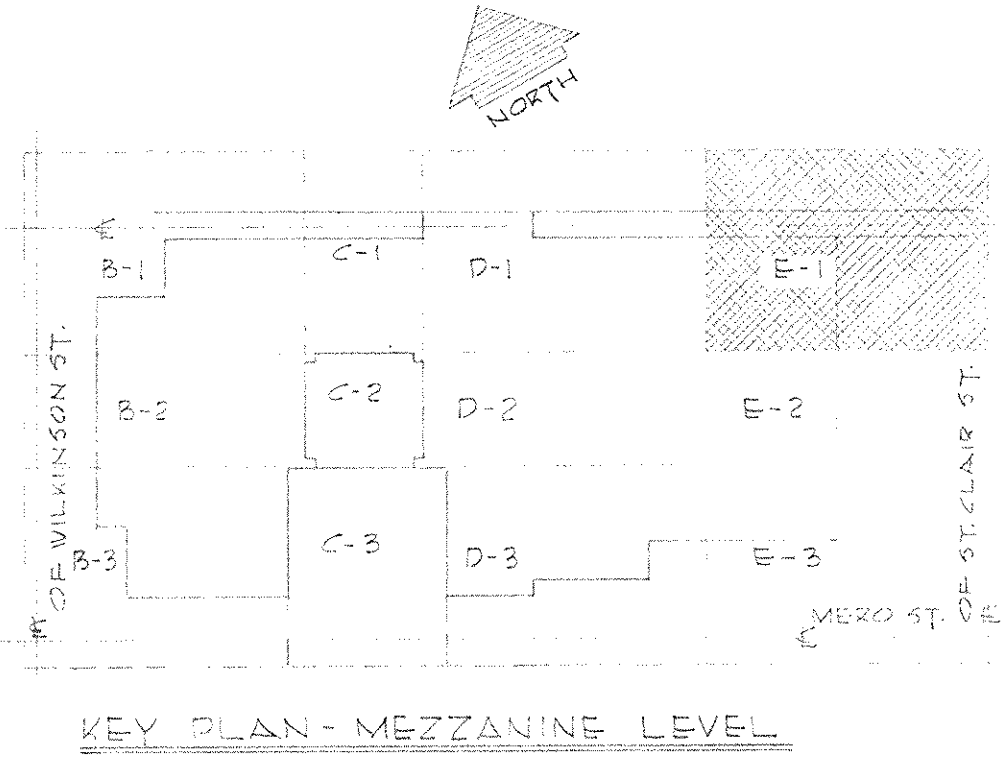


KEY PLAN - MEZZANINE LEVEL
NO SCALE

CAPITAL PLAZA OFFICE BUILDING
FRANKFORT, KENTUCKY

DRAWN BY O.S.C.F.D.S.	PLUMBING AND VENTILATING PLAN - MEZZANINE LEVEL - SECTOR E-1	DATE 15, MAY, 1967
TRACED BY D.S.	ARCHITECT	SCALE 1/8" = 1'-0"
CHECKED BY O.S.C.F.D.S.	EDWARD DURELL STONE 7 EAST 6TH STREET NEW YORK, N. Y.	EDM. NO. 500669
SECTOR NO. E 1	ASSOCIATE ARCHITECTS & ENGINEERS LEE POTTER SMITH & ASSOCIATES 314 WILKINSON FRANKFORT, KENTUCKY	DRAWING NO. PH 14 OF PH-31
APPROVED BY ARCHITECT	DATE	
APPROVED BY AGENCY HEAD W. M. Donnell	DATE 5/15/67	
APPROVED BY OWNER	DATE	

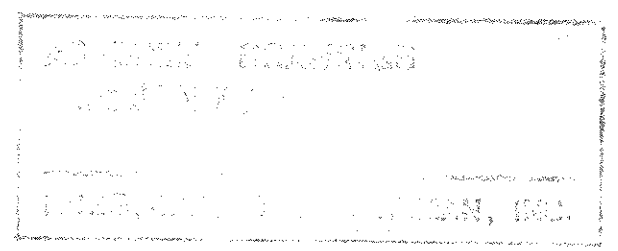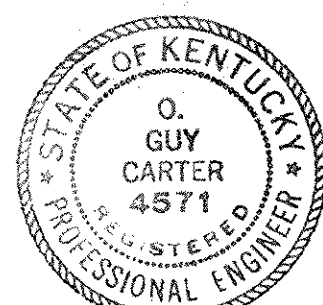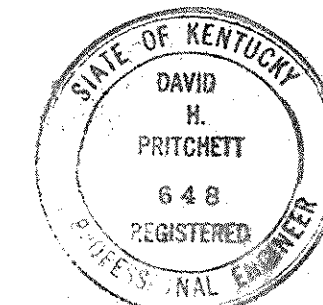


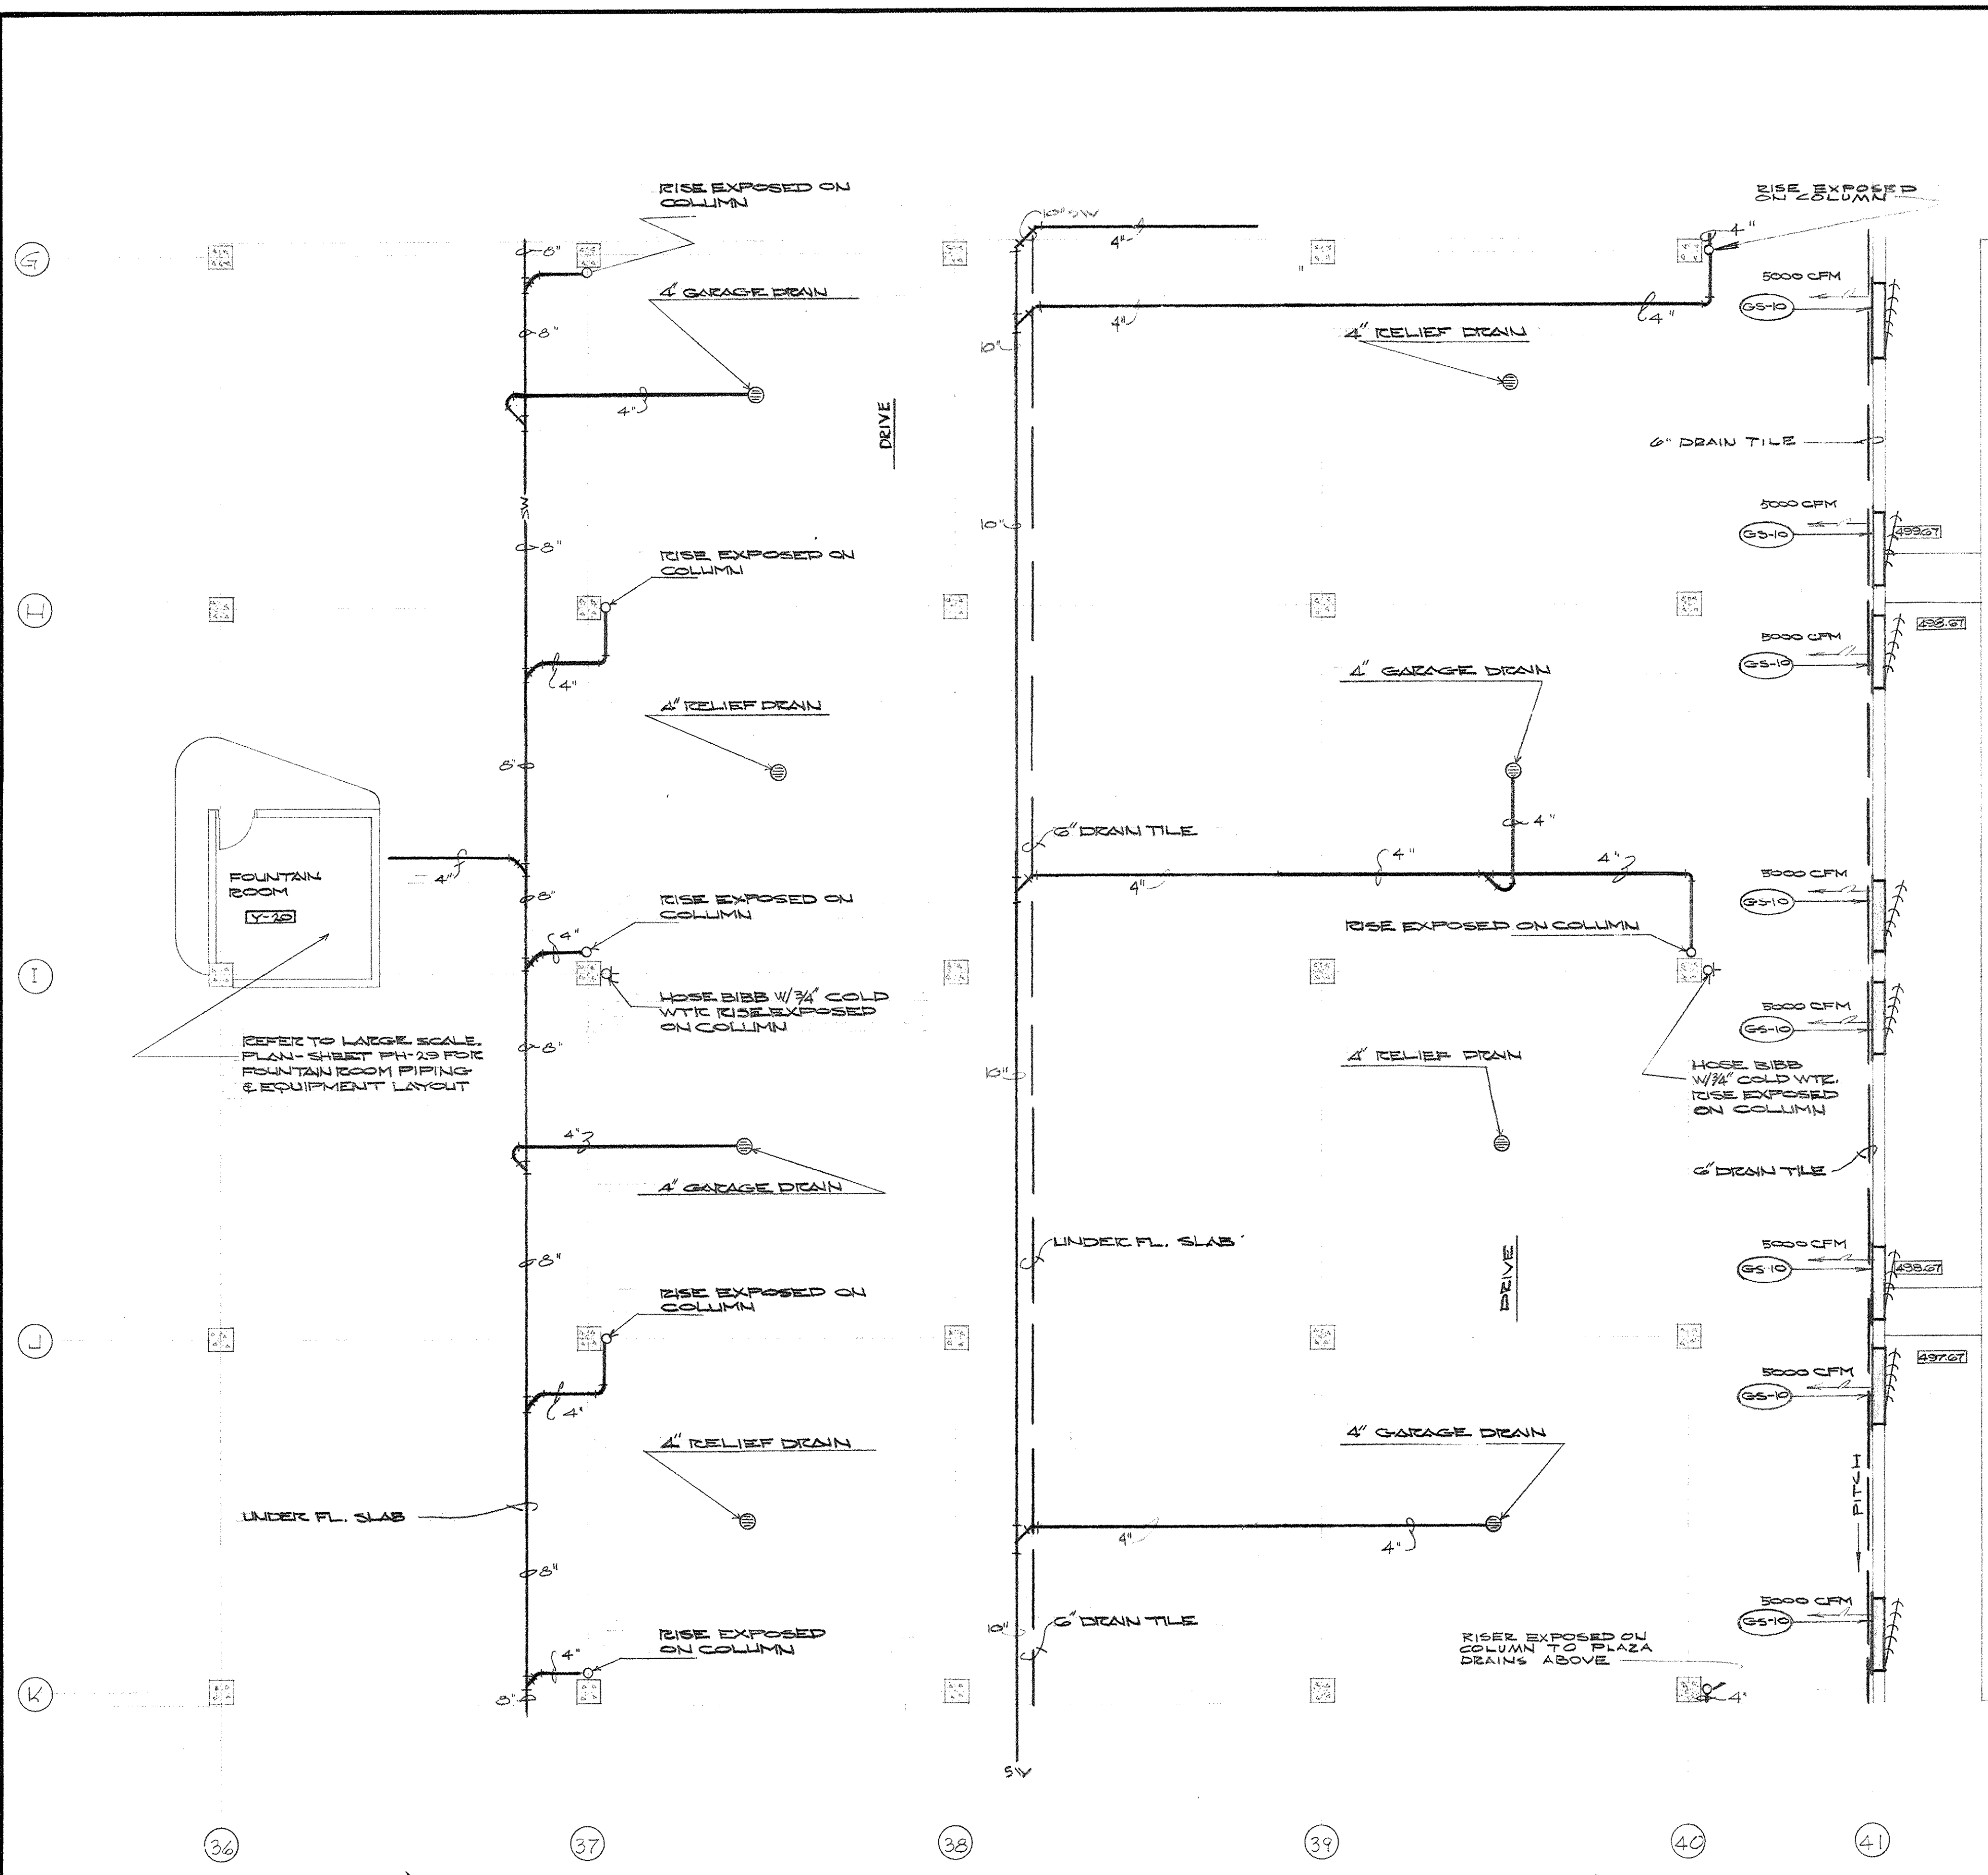


PLUMBING AND VENTILATING PLAN - MEZZANINE LEVEL - SECTOR E-2
SCALE - 1/8" = 1'-0"

SCHEDULE OF GRILLES AND DIFFUSERS

SYMBOL ROOM	MANUFACTURER	TYPE	DIFFUSER SIZE	CORE	NOMINAL INLET DIM	CFM	R.P. INCHES W.G.	THROW F.T.	SOUND LEVEL D.B. & NC.	DIRECTION OF THROW	MOUNTING	REMARKS
G5-1	BARBER - COLMAN	GER	120"x36"	RF	120"x36"	6100	.030		25		WALL SET @ 58" H. BY WALL SET @ 58" H. BY	WITH STRAIGHT FIN SET 45° DOWN
G5-2	BARBER - COLMAN	GER	120"x36"	RF	120"x36"	6100	.030		25		WALL SET @ 58" H. BY WALL SET @ 58" H. BY	WITH STRAIGHT FIN SET 45° DOWN
G5-3	BARBER - COLMAN	GER	72"x48"	RF	72"x48"	6100	.030		25		WALL SET @ 45" H. BY WALL SET @ 45" H. BY	WITH STRAIGHT FIN SET 45° DOWN
G5-4	BARBER - COLMAN	GER	72"x48"	RF	72"x48"	6200	.030		25		WALL SET @ 45" H. BY WALL SET @ 45" H. BY	WITH STRAIGHT FIN SET 45° DOWN
G5-5	BARBER - COLMAN	GER	72"x48"	RF	72"x48"	4500	.020		25		WALL SET @ 45" H. BY WALL SET @ 45" H. BY	WITH STRAIGHT FIN SET 45° DOWN
G5-6	BARBER - COLMAN	GER	30"x30"	RF	30"x30"	2000	.020		25		CEILING	WITH STRAIGHT FIN SET 45° DOWN
G5-7	BARBER - COLMAN	GER	30"x30"	RF	30"x30"	3000	.030		25		CEILING	WITH STRAIGHT FIN SET 45° DOWN
G5-8	BARBER - COLMAN	GER	18"x18"	RF	18"x18"	5000	.030		25		SIDE OF DUCT	WITH STRAIGHT FIN SET 45° DOWN
G5-9	BARBER - COLMAN	GER	72"x48"	RF	72"x48"	5000	.030		25		TOP AS HIGH AS POSSIBLE	WITH STRAIGHT FIN SET 45° DOWN
G5-10	BARBER - COLMAN	GER	72"x48"	RF	72"x48"	5000	.030		25		TOP AS HIGH AS POSSIBLE	WITH STRAIGHT FIN SET 45° DOWN




NOTES:
 1) GRADES TO BE SELECTED BY ARCHITECT.
 2) PROVIDE DAMPERS AND TAKE-OFF FOR EACH GRILLE.
 3) FRAME AND CORE TO BE HEAVY GAUGE STEEL.

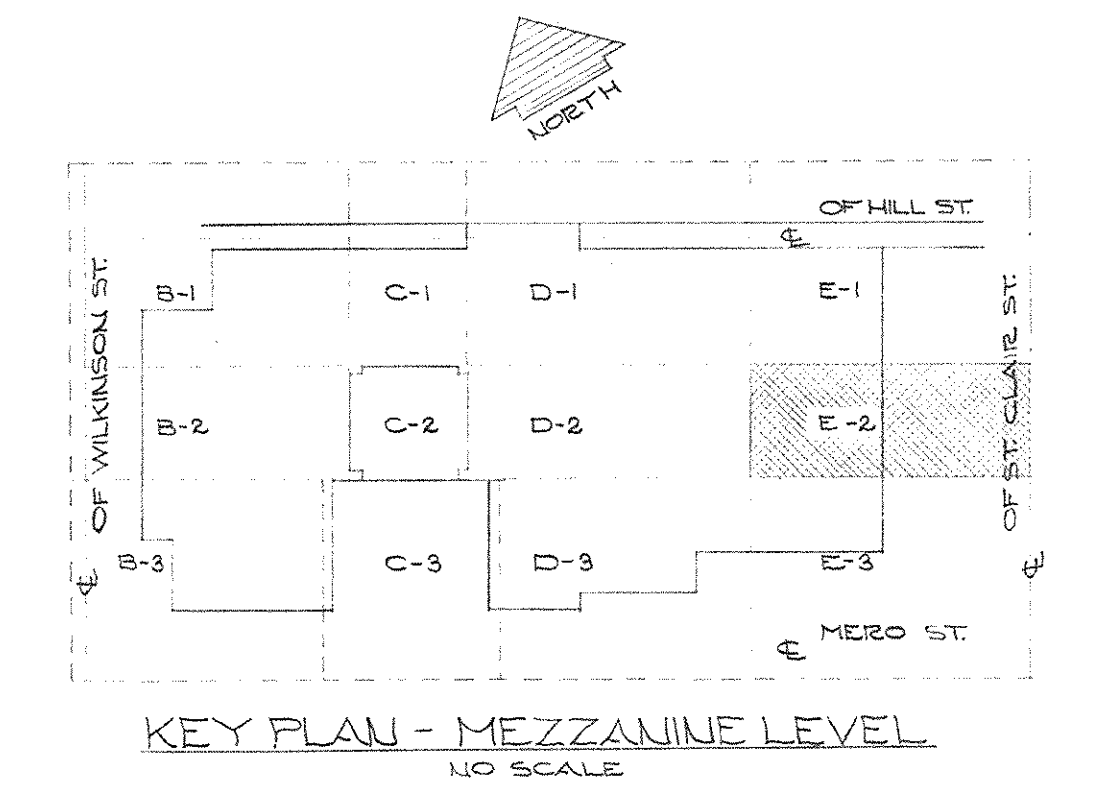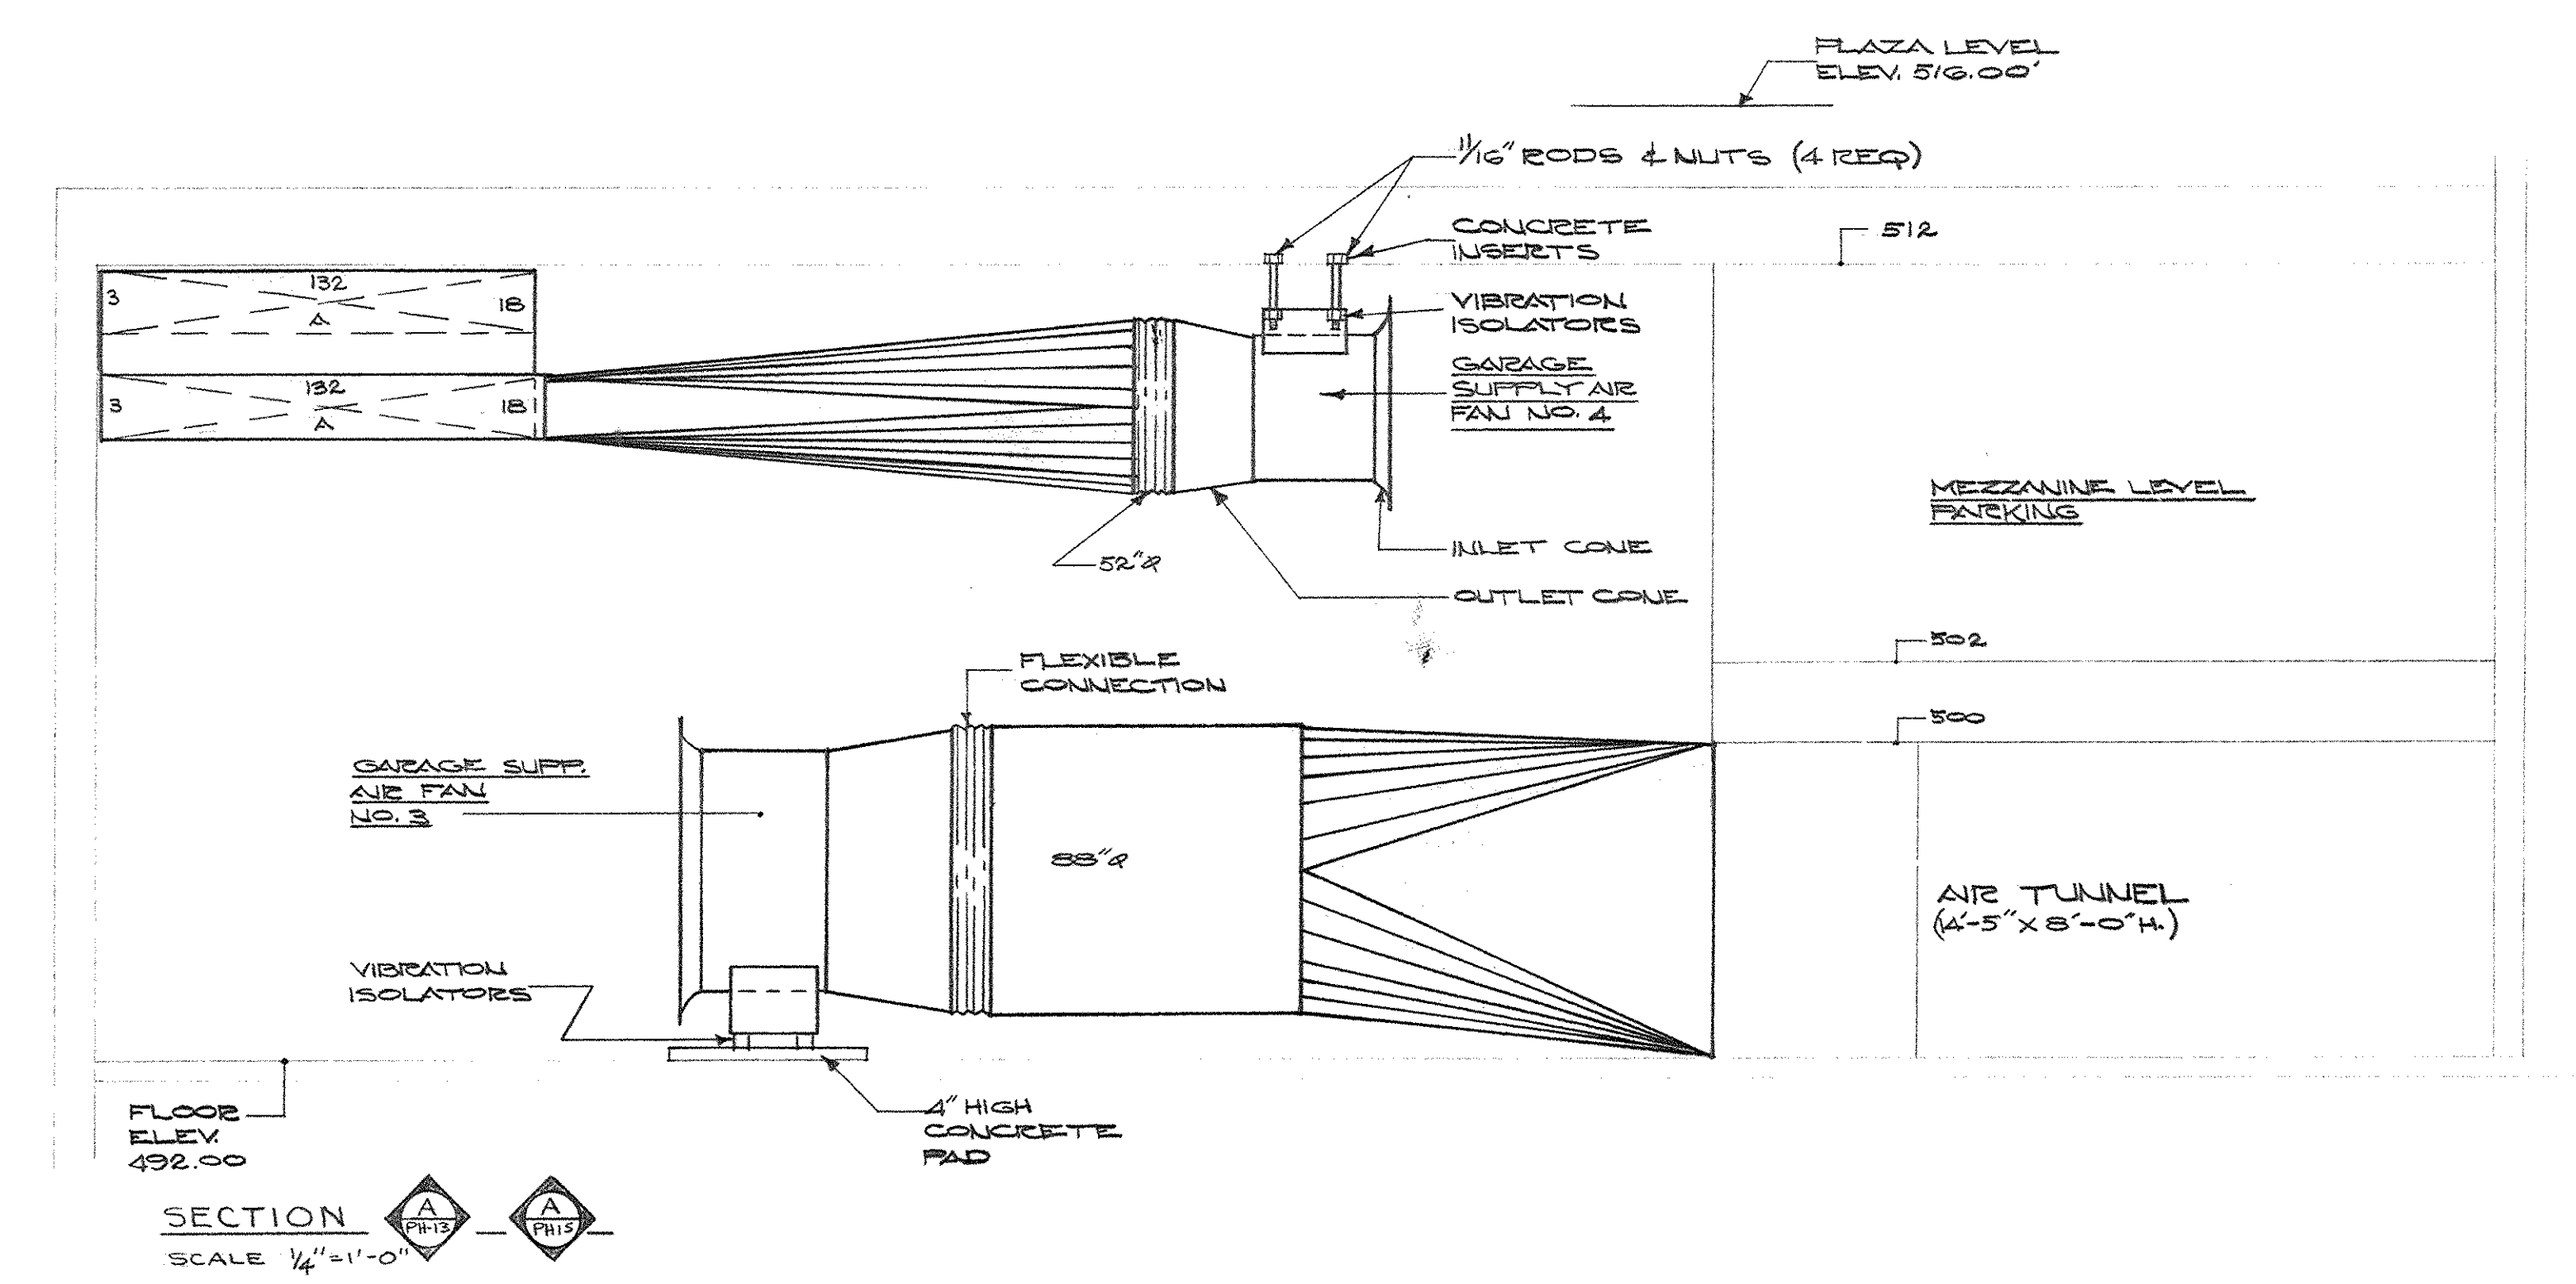

CAPITAL PLAZA OFFICE BUILDING
FRANKFORT, KENTUCKY

DRAWN BY O.S.C.P.S.	PLUMBING AND VENTILATING PLAN - MEZZANINE LEVEL - SECTOR E-2	DATE 15, MAY, 1967
TRACED BY B.W.	ARCHITECT EDWARD DURELL STONE	SCALE 1/8" = 1'-0"
CHECKED BY O.S.C.	7 EAST 67TH STREET NEW YORK, N.Y.	CDMA. NO. 502064
SECTOR NO. E 2	ASSOCIATE ARCHITECTS & ENGINEERS LEE POTTER SMITH & ASSOCIATES 314 WILKINSON FRANKFORT, KENTUCKY	DRAWING NO. PH 15
APPROVED BY	ARCHITECT	DATE
APPROVED BY	AGENCY HEAD	DATE
APPROVED BY	OWNER	DATE

DEPARTMENT OF FINANCE - ENGINEERING STAFF
FRANKFORT, KENTUCKY

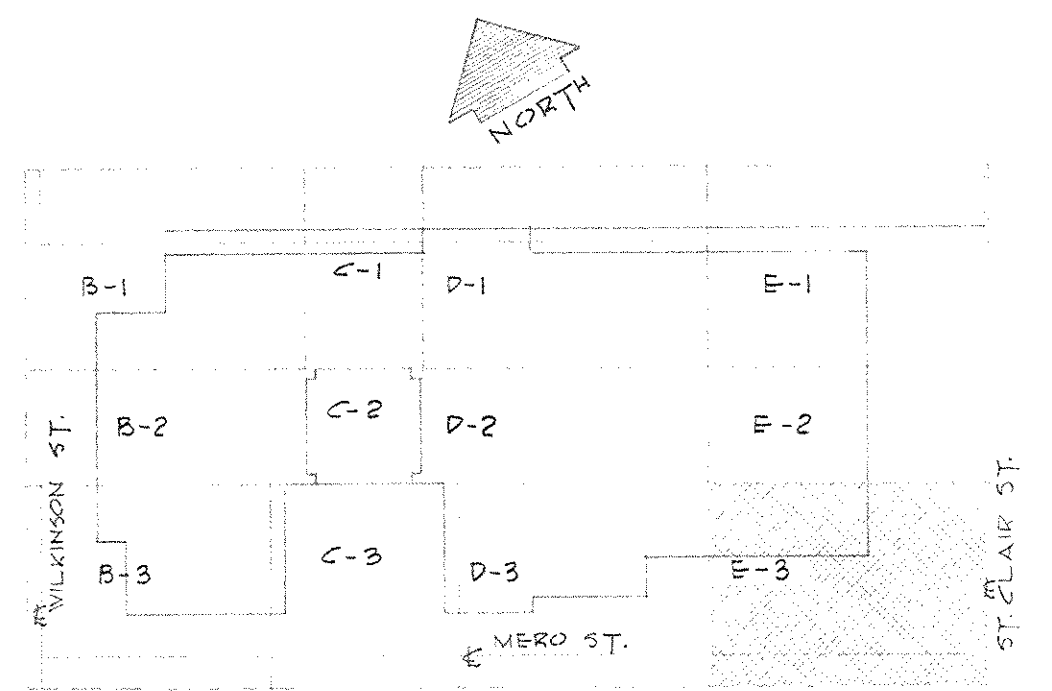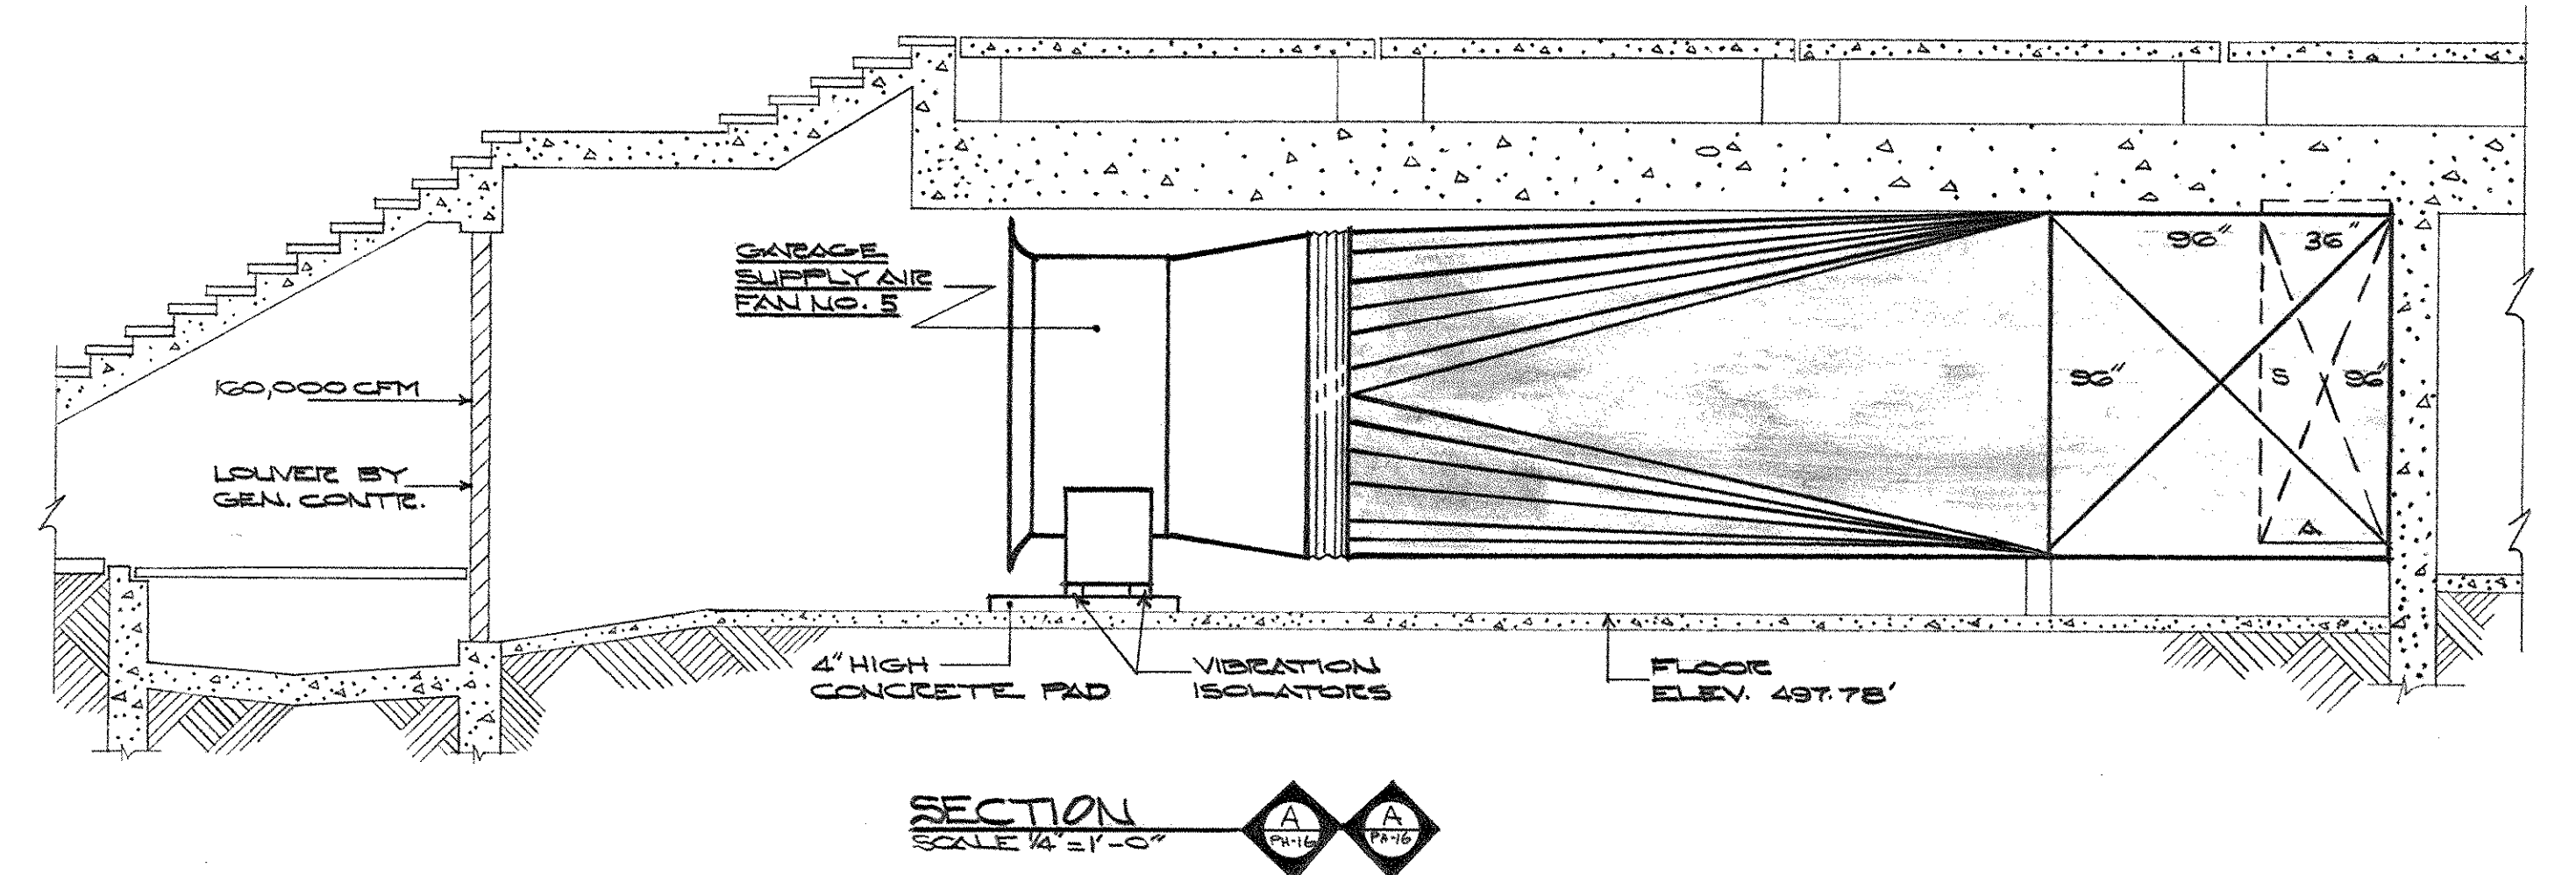
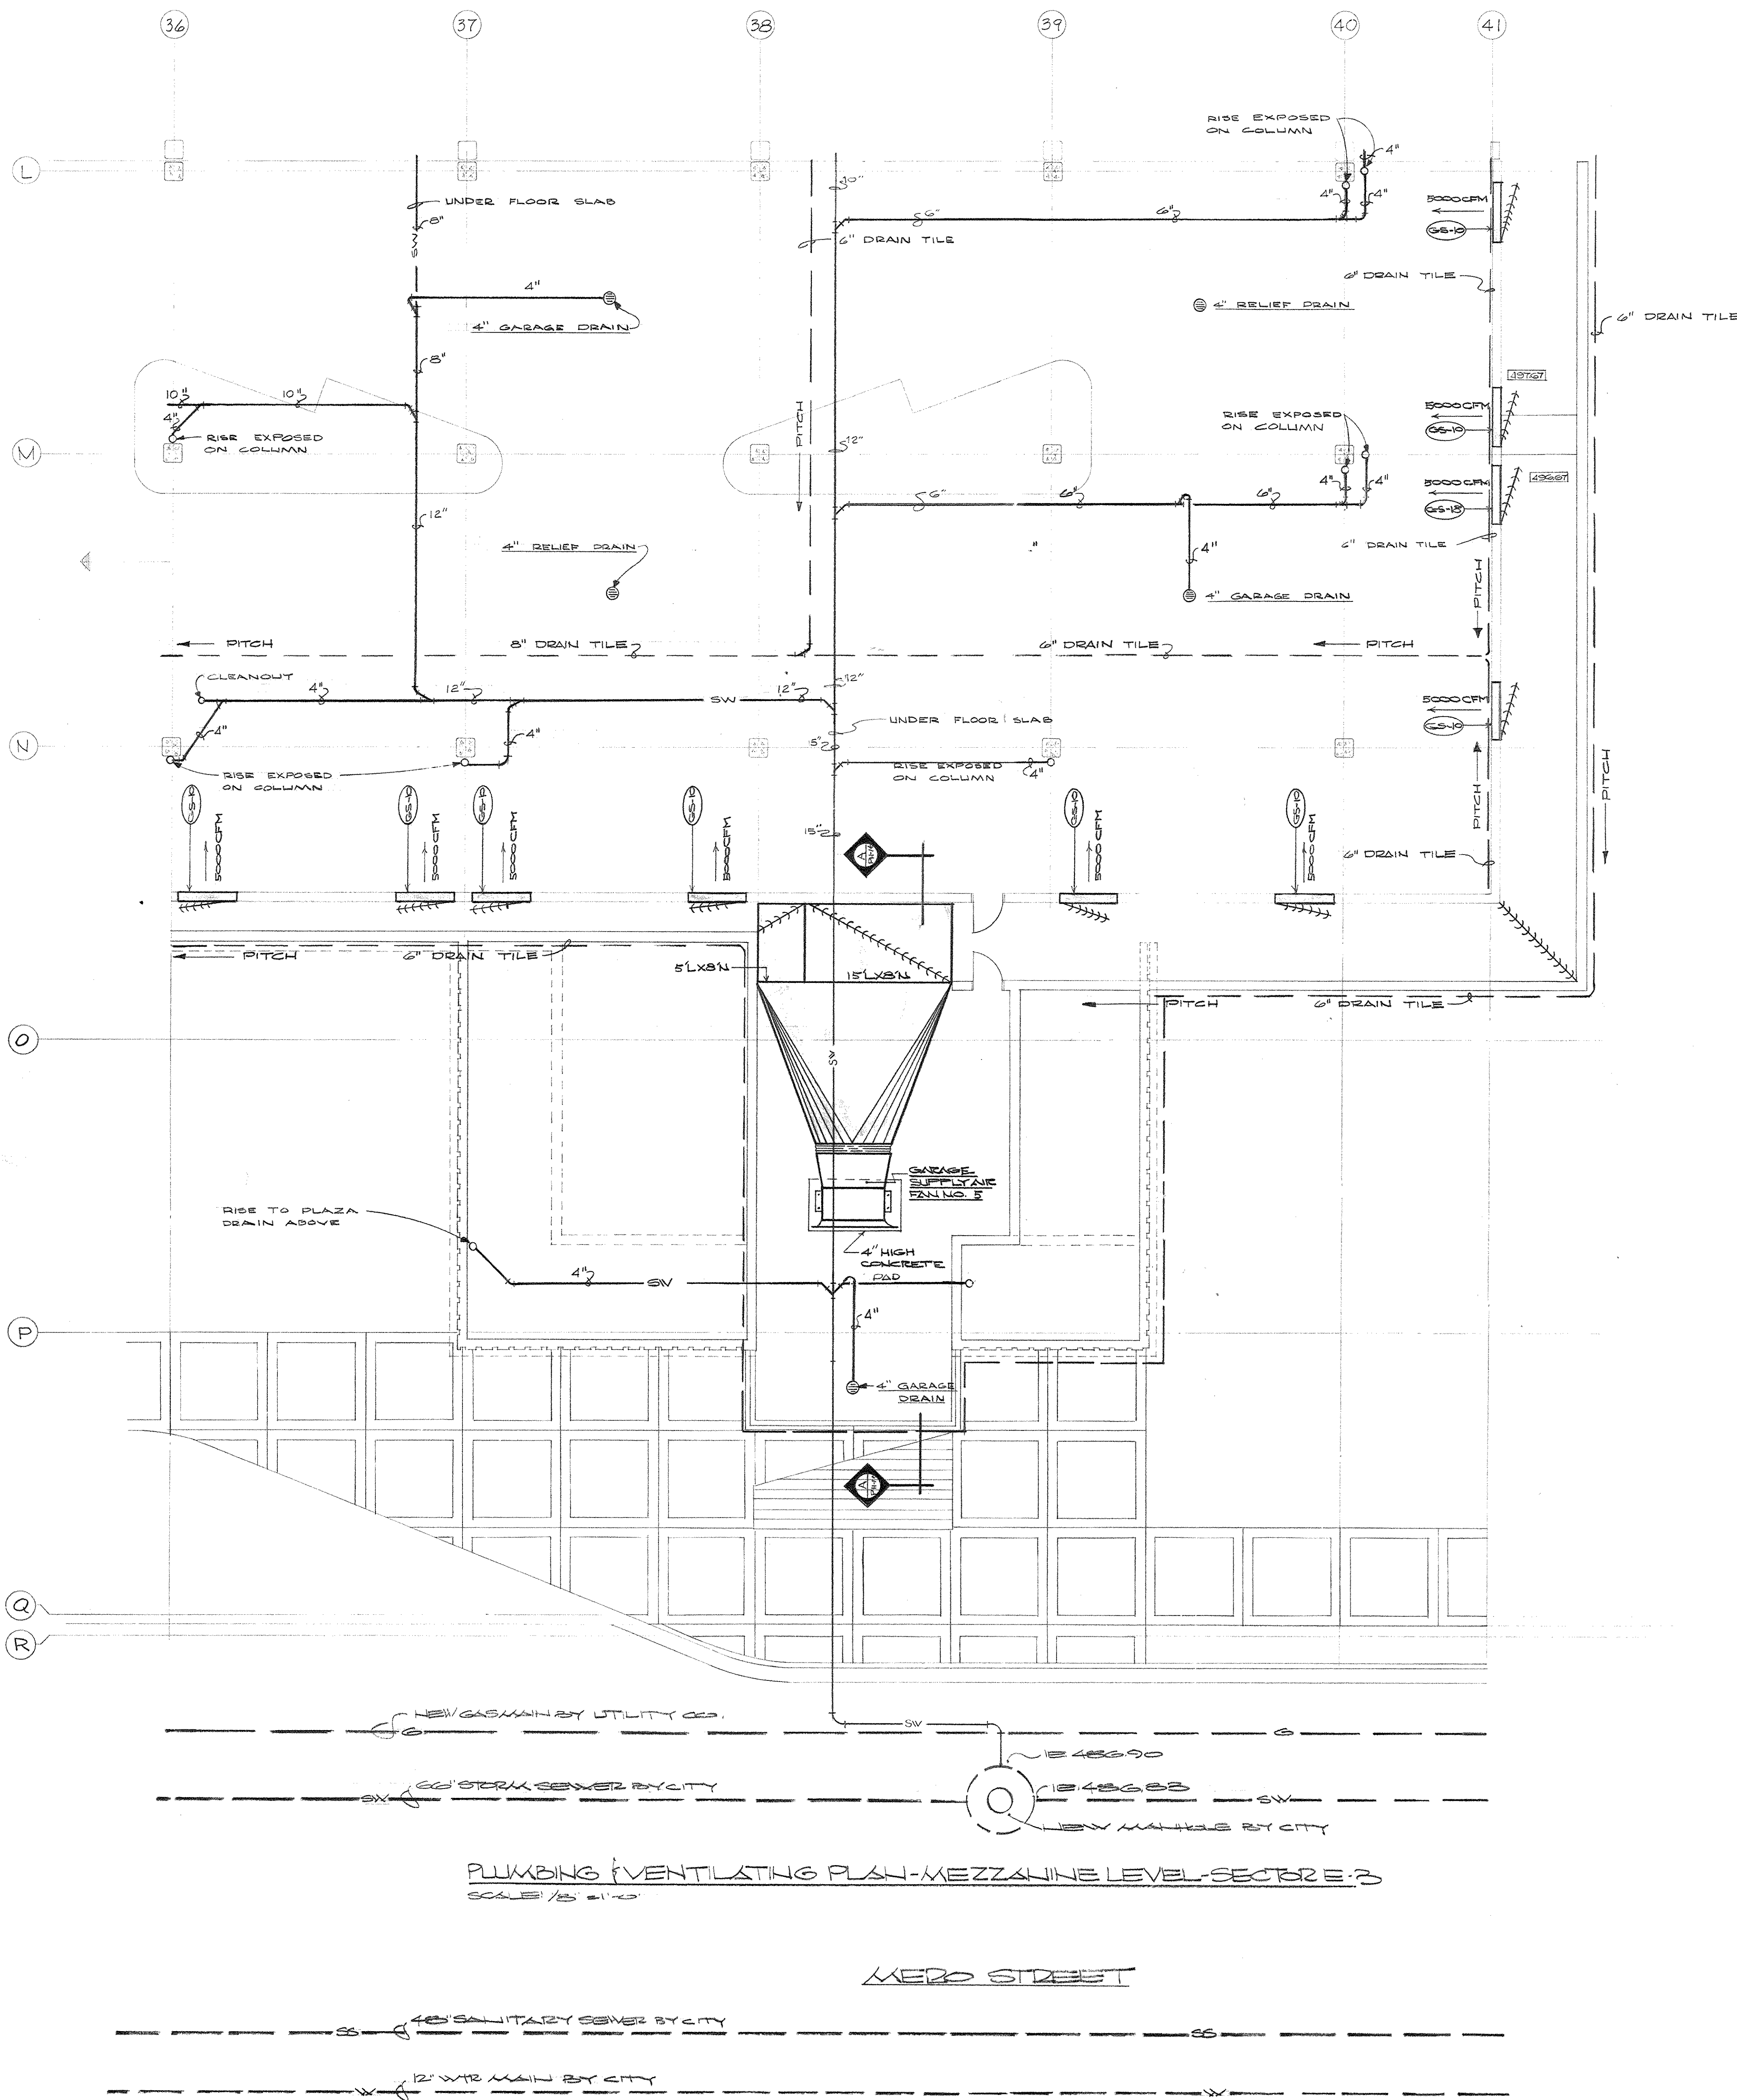



PLUMBING & VENTILATING PLAN - MEZZANINE LEVEL - SECTION E-3
SCALE 1/8" = 1'-0"

KEY PLAN - MEZZANINE LEVEL
NO SCALE


AS BUILT REVISION: AUGUST 1972

CAPITAL PLAZA OFFICE BUILDING		
FRANKFORT, KENTUCKY		
DRAWN BY	PLUMBING AND VENTILATING PLAN - MEZZANINE LEVEL - SECTION E-3	DATE 15 MAY 1967
TRACED BY	ARCHITECT	SCALE AS NOTED
CHECKED BY	EDWARD DURELL STONE	COMM. NO. 50556
SECTOR NO.	7 EAST 6TH STREET NEW YORK, N.Y.	DRAWING NO.
E 3	LEE POTTER SMITH & ASSOCIATES 314 WILKINSON FRANKFORT, KENTUCKY COMMONWEALTH OF KENTUCKY DEPARTMENT OF FINANCE - ENGINEERING STAFF FRANKFORT, KENTUCKY	PH 16 OF PH-31
APPROVED BY	ARCHITECT	DATE
APPROVED BY	AGENCY HEAD	DATE
APPROVED BY	OWNER	DATE MAY 24 1967

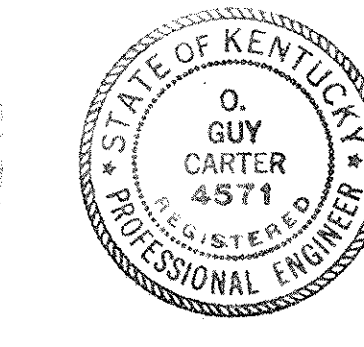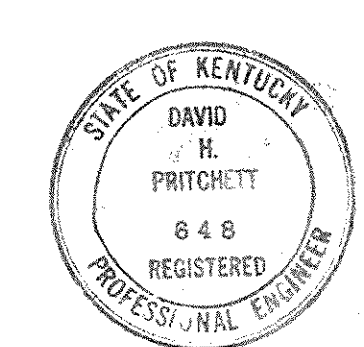


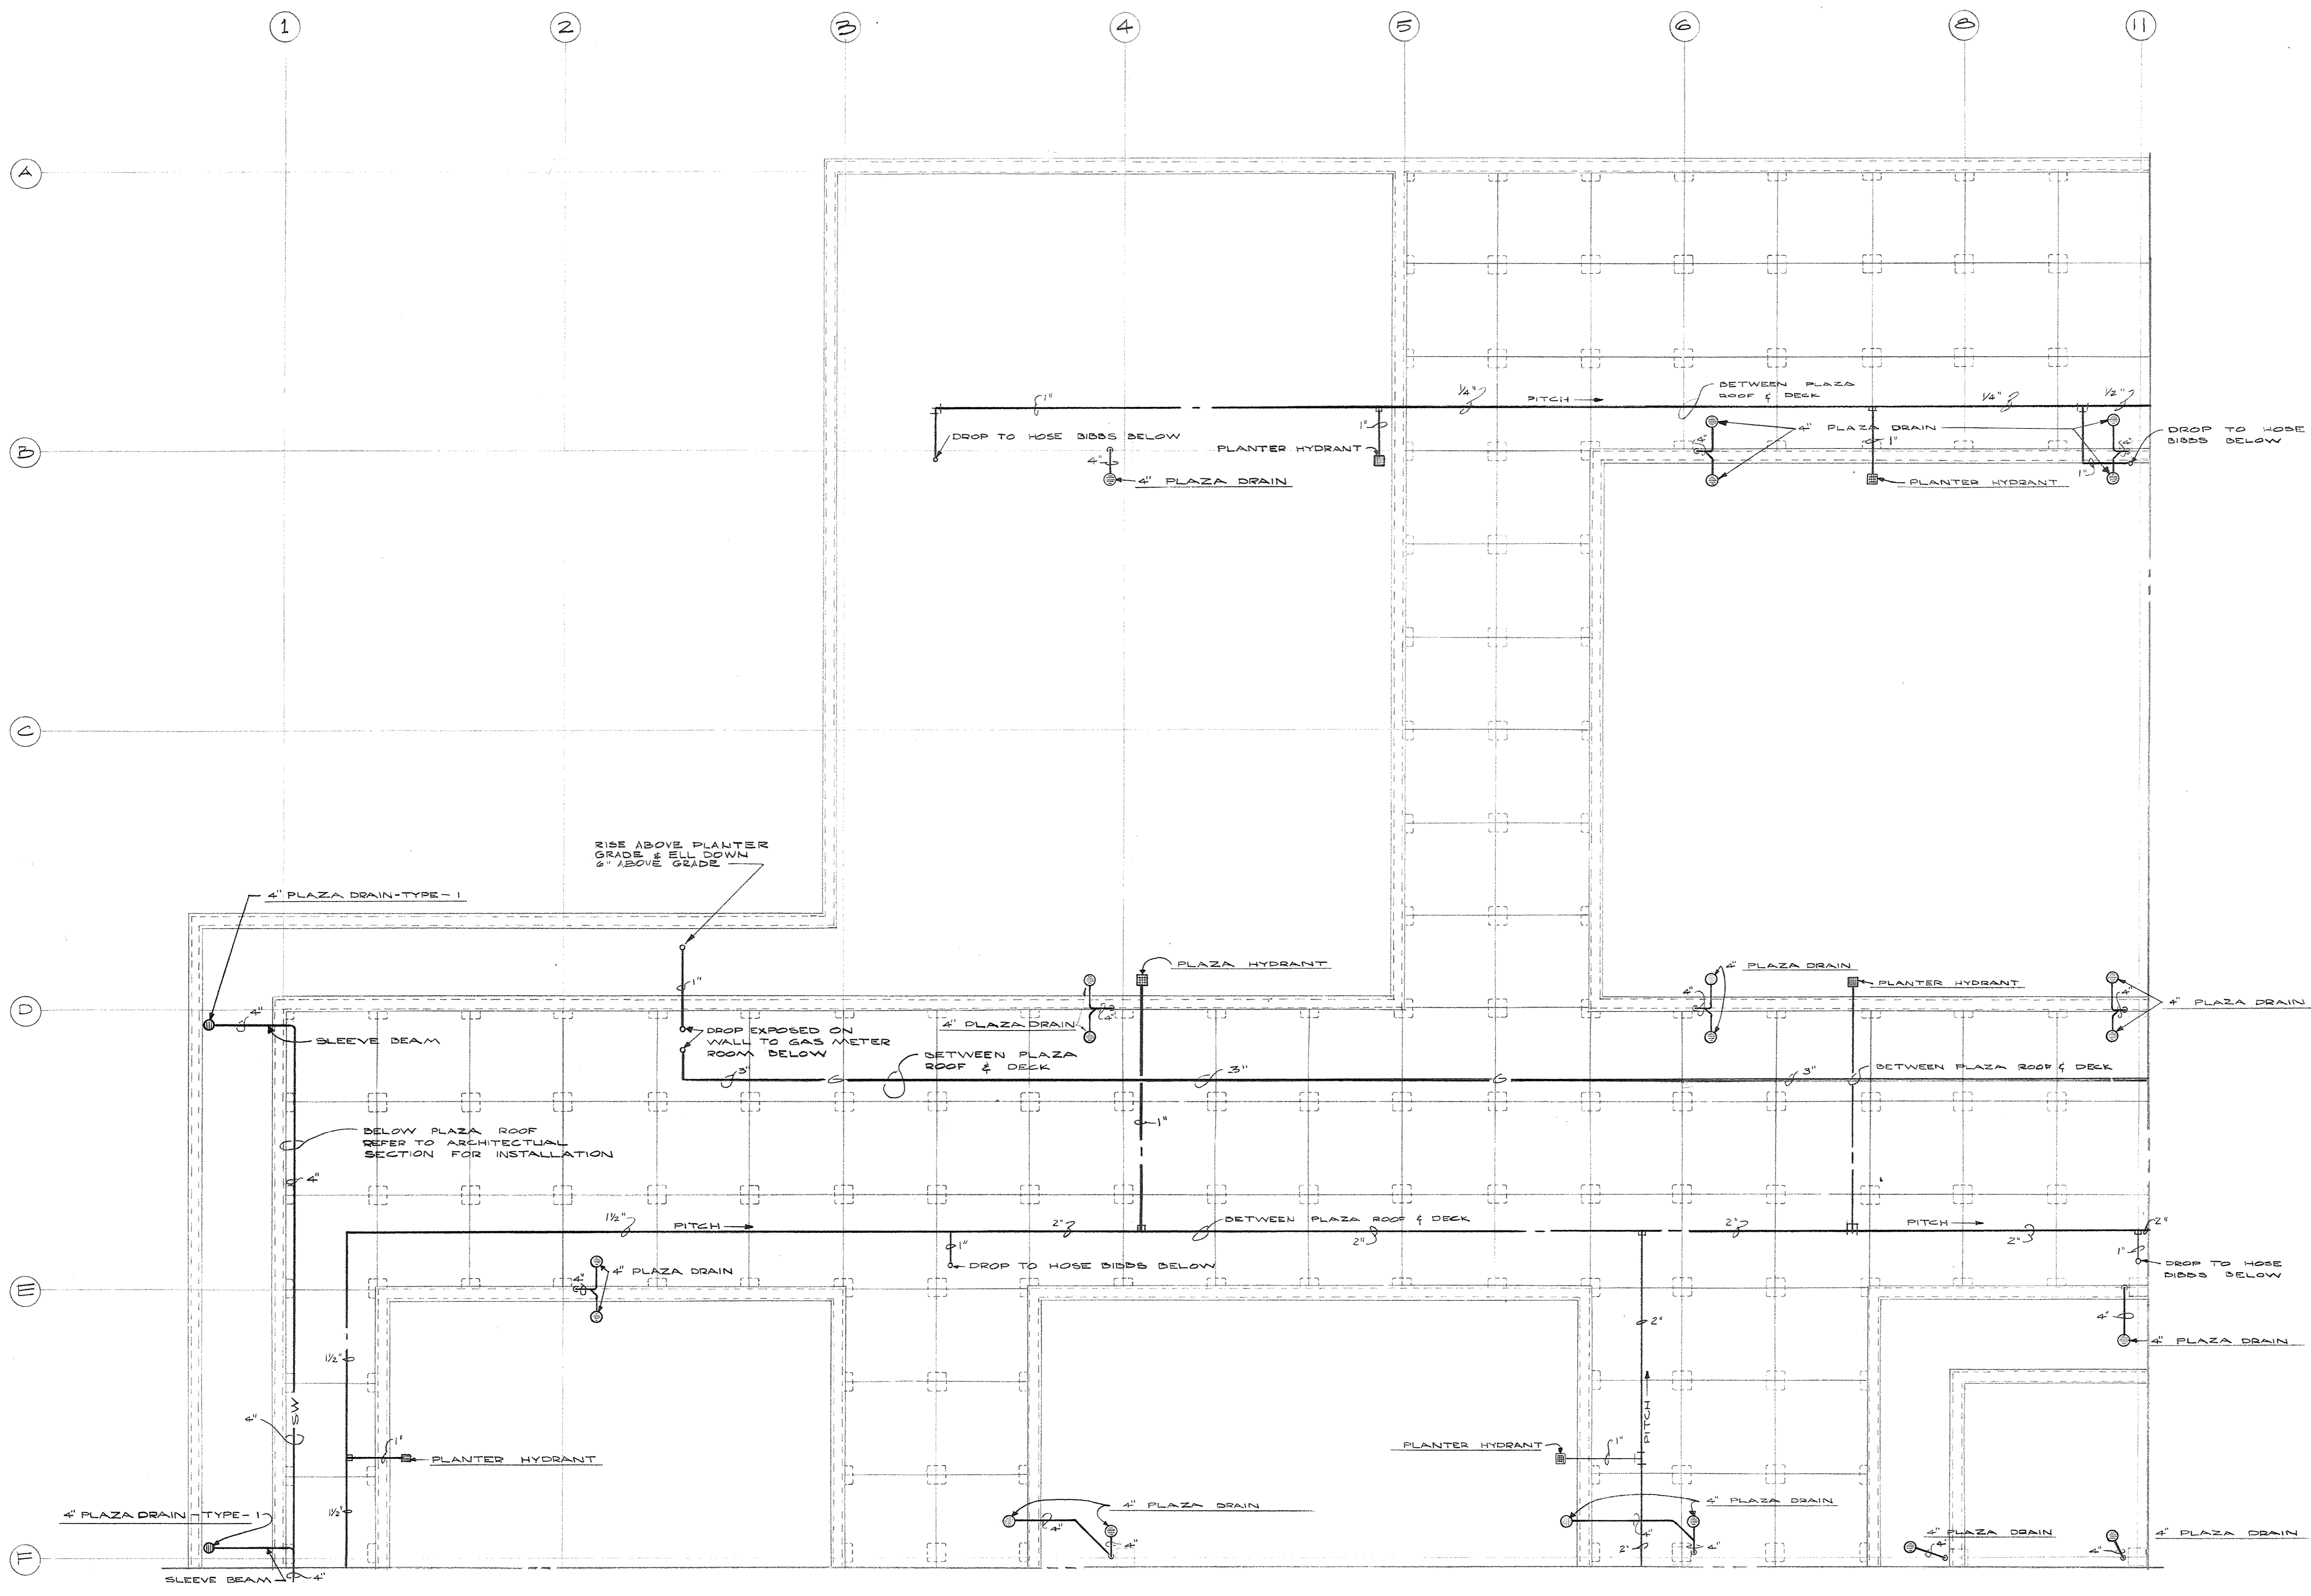


PLUMBING PLAN - PLAZA LEVEL - SECTOR B-1
SCALE 1/8" = 1'-0"

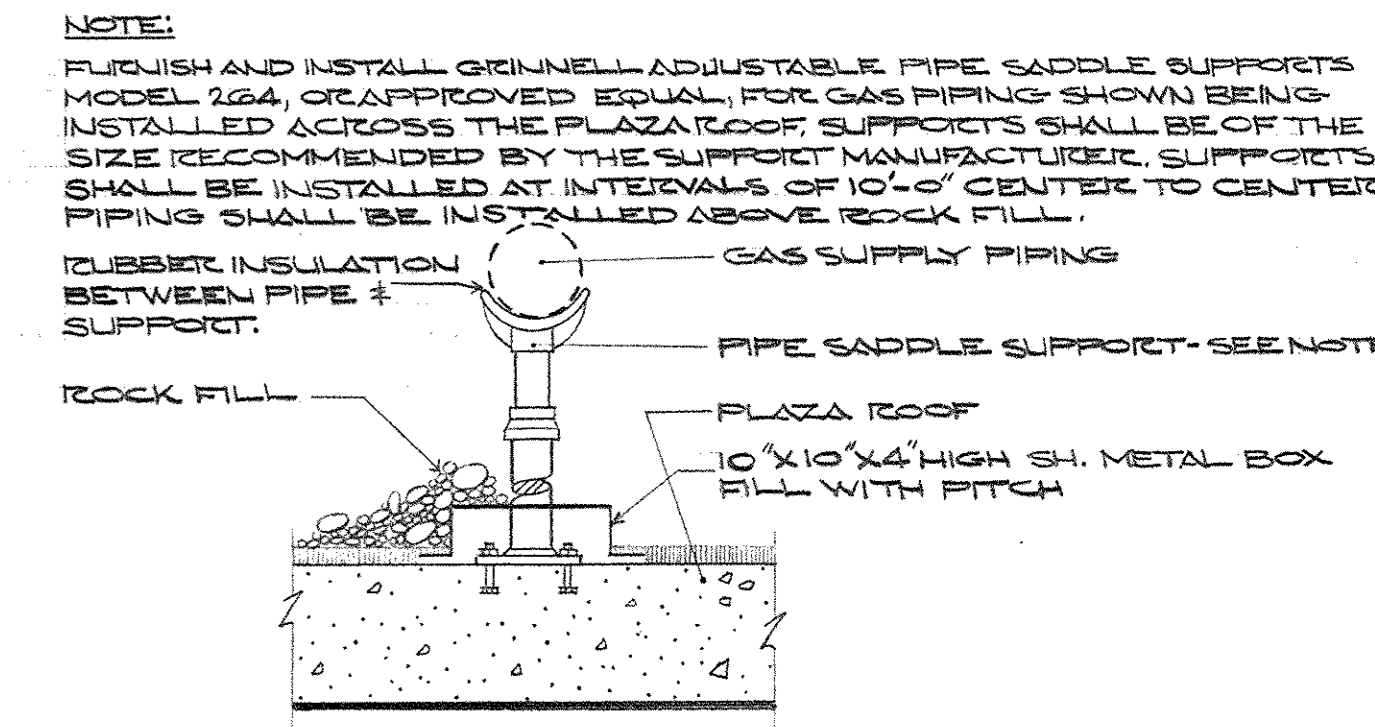


DETAIL OF GAS PIPING INSTALLATION BETWEEN PLAZA ROOF & DECK
NO SCALE

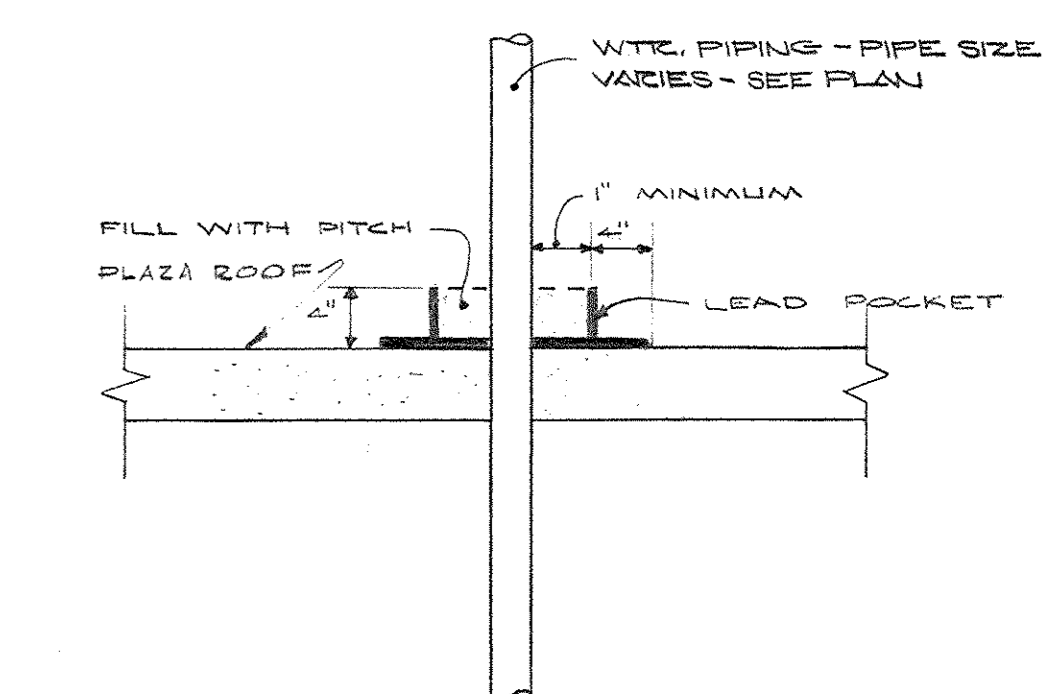

TYPICAL PIPING INSTALLATION THRU PLAZA ROOF
NO SCALE

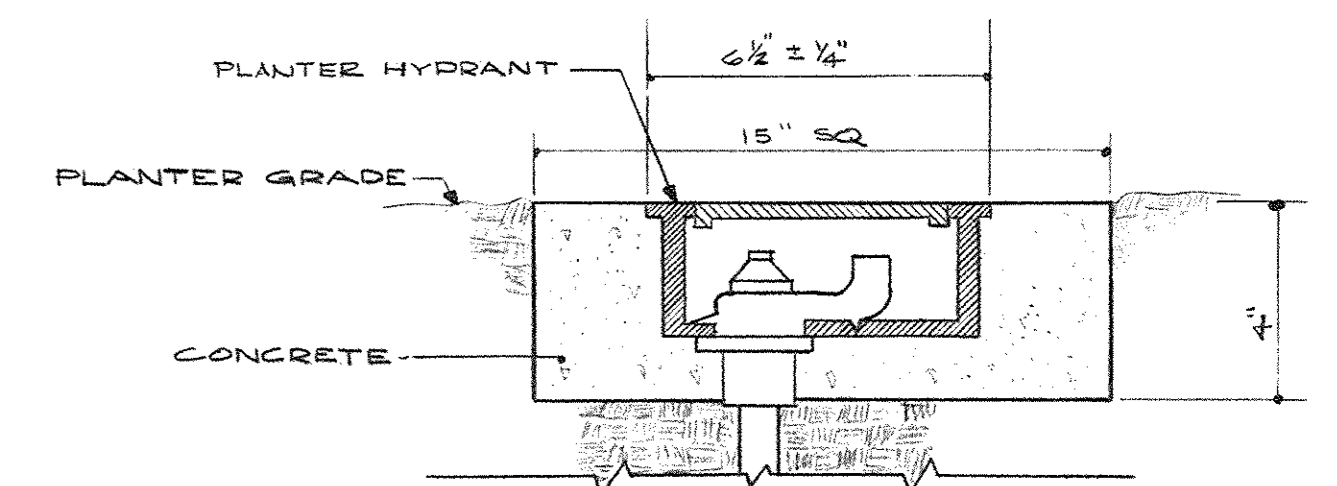



DETAIL OF PLANTER HYDRANT
NO SCALE

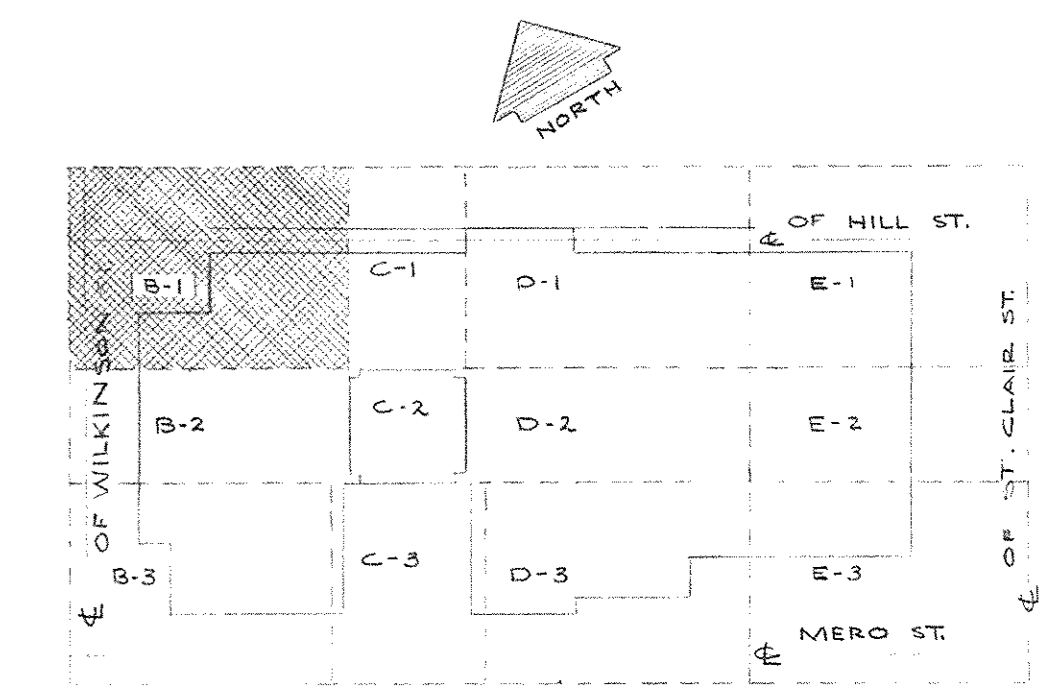


KEY PLAN - PLAZA LEVEL
NO SCALE

CAPITAL PLAZA OFFICE BUILDING		
FRANKFORT, KENTUCKY		
DRAWN BY SVP	PLUMBING PLAN - PLAZA LEVEL - SECTOR B-1	DATE 15 MAY, 1967
TRACED BY SVP	ARCHITECT	SCALE AS SHOWN
CHECKED BY SVP	EDWARD DURELL STONE 7 EAST 87TH STREET NEW YORK, N.Y.	COMM. NO. 20266
SECTOR NO. B 1	ASSOCIATE ARCHITECTS & ENGINEERS LEE POTTER SMITH & ASSOCIATES 314 WILKINSON FRANKFORT, KENTUCKY	DRAWING NO. PH 17 OF PH-31
APPROVED BY	ARCHITECT	DATE
APPROVED BY	AGENCY HEAD L. V. McCombs	DATE MAY 24 1967
APPROVED BY	OWNER	DATE

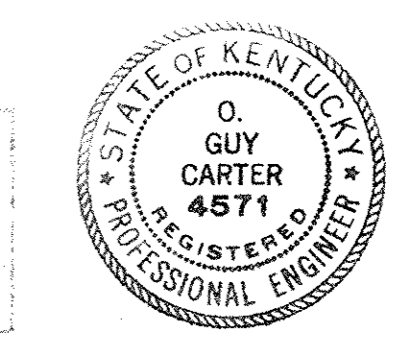


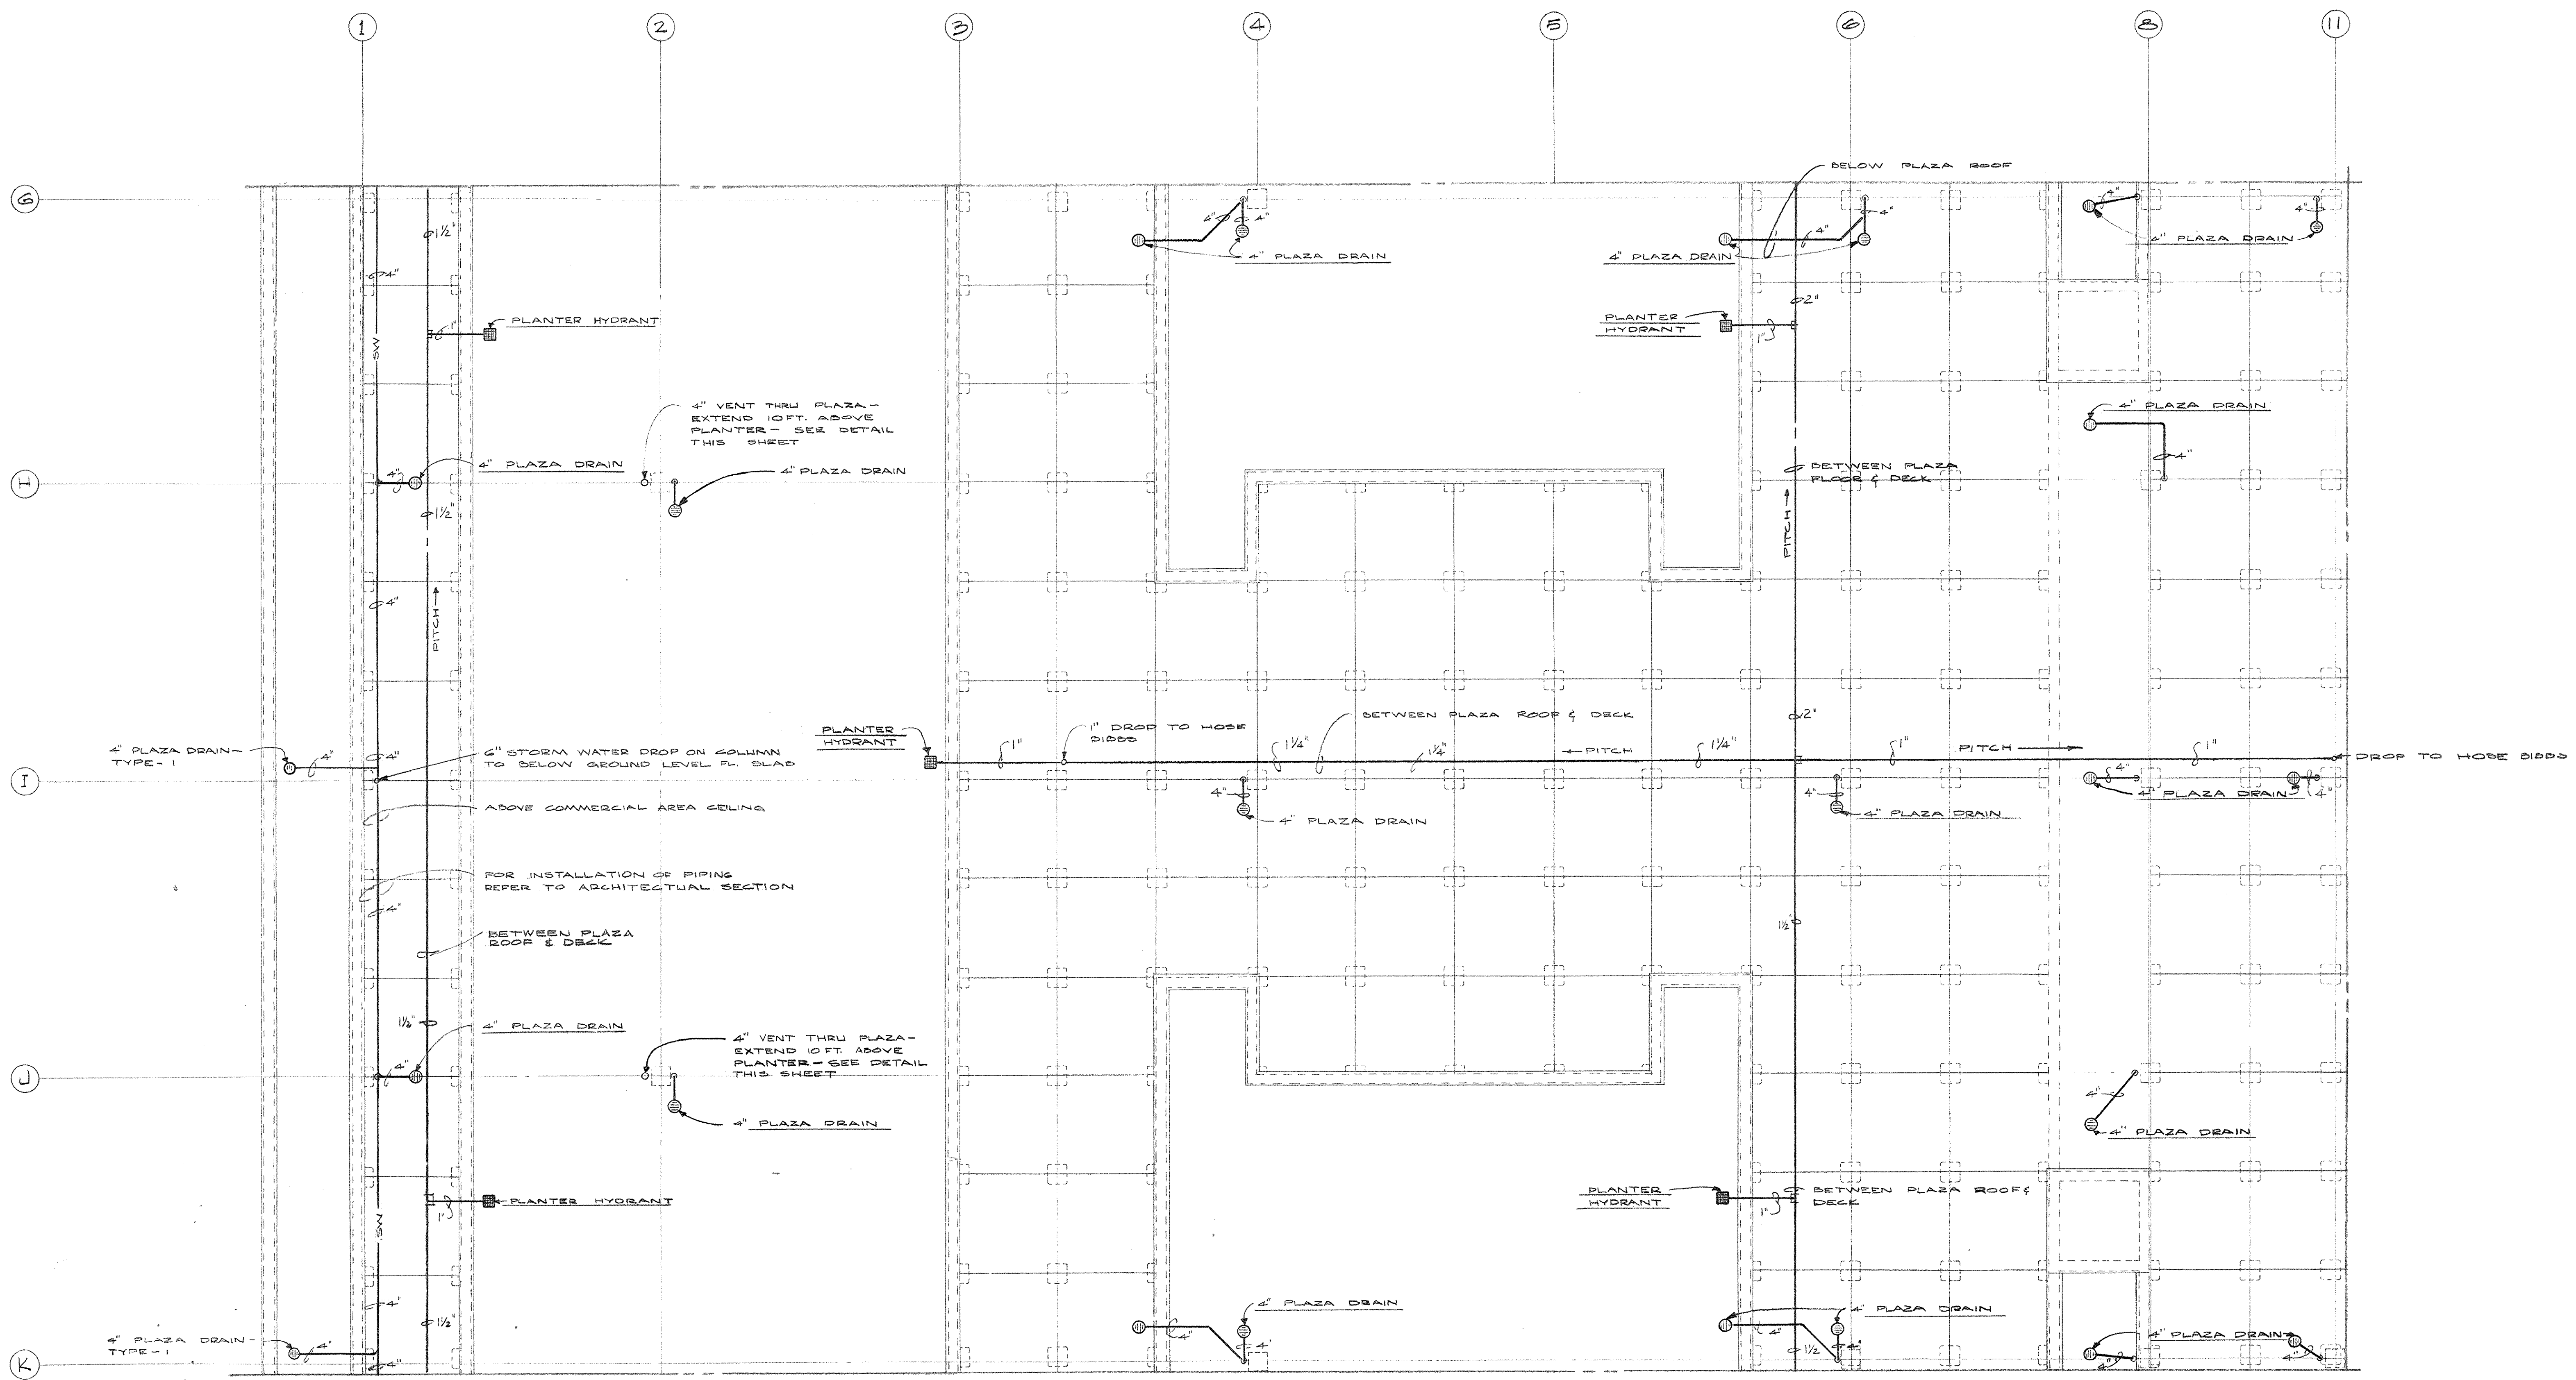

PLUMBING PLAN - PLAZA LEVEL - SECTOR B-2
SCALE: 1/2" = 1'-0"

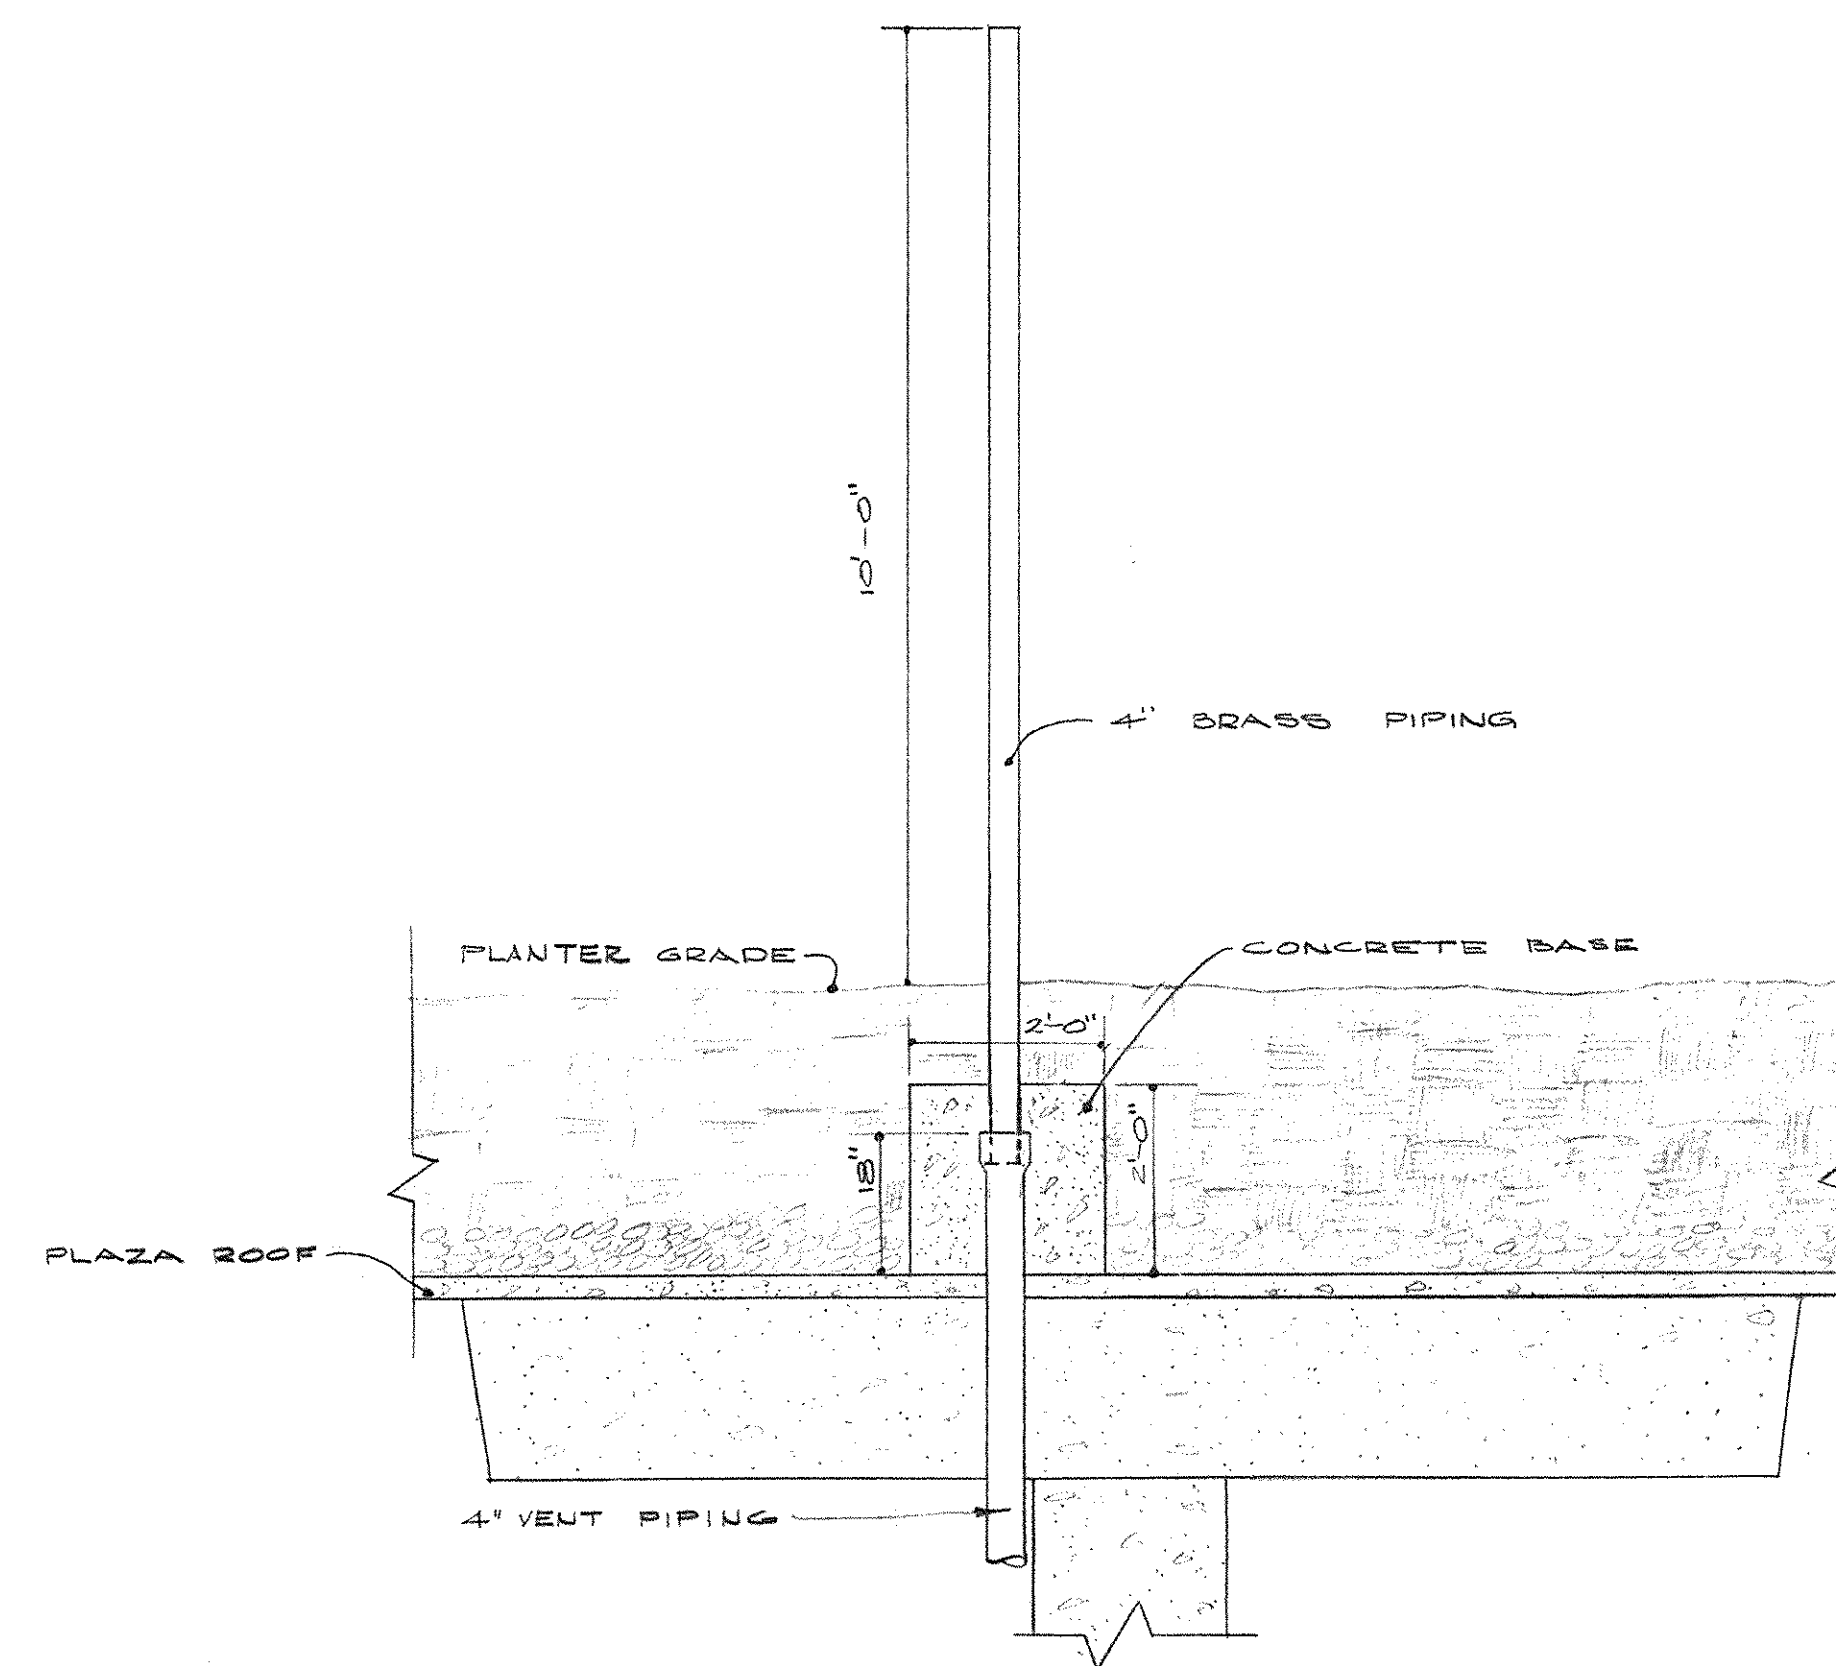

DETAIL OF VENT THRU PLAZA
SCALE: 1/2" = 1'-0"

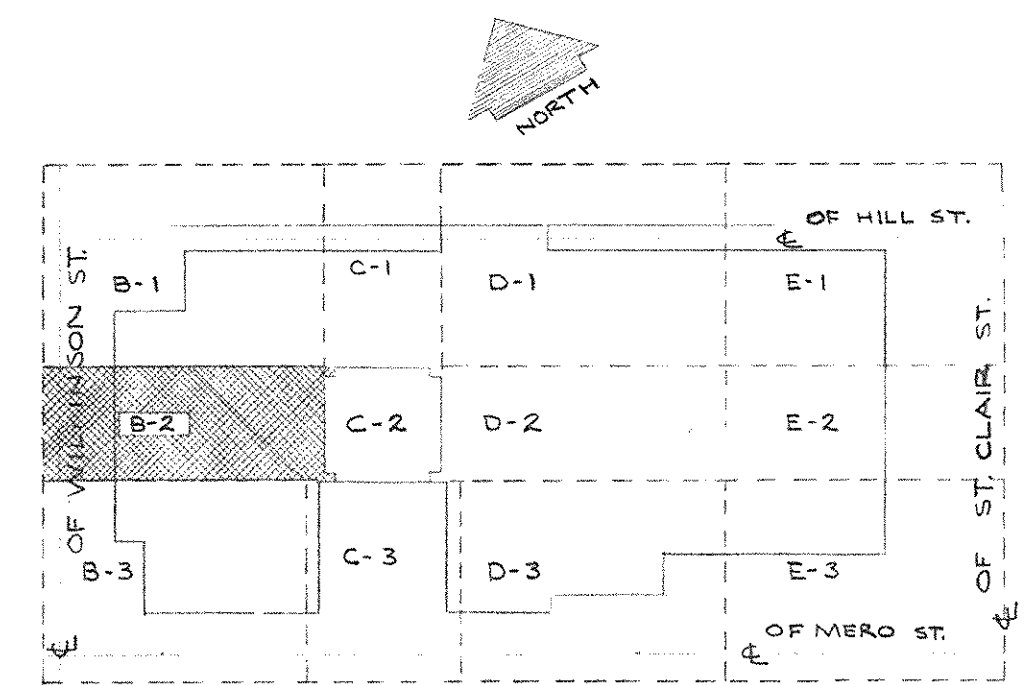


KEY PLAN - PLAZA LEVEL
NO SCALE


CAPITAL PLAZA OFFICE BUILDING
FRANKFORT, KENTUCKY

DRAWN BY SWIFT	PLUMBING PLAN - PLAZA LEVEL - SECTOR B-2	DATE 15, MAY, 1967
TRACED BY G.S.C.	ARCHITECT EDWARD DURELL STONE 7 EAST 67TH STREET NEW YORK, N. Y.	SCALE AS SHOWN
CHECKED BY G.S.C.	ASSOCIATE ARCHITECTS & ENGINEERS LEE POTTER SMITH & ASSOCIATES 314 WILKINSON FRANKFORT, KENTUCKY	COMM. NO. 20650
SECTOR NO. B 2	COMMONWEALTH OF KENTUCKY DEPARTMENT OF FINANCE - ENGINEERING STAFF FRANKFORT, KENTUCKY	DRAWING NO. PH 18 OF PH-31


APPROVED BY	ARCHITECT	DATE
APPROVED BY	AGENCY HEAD <i>W. M. ...</i>	DATE MAY 24 1967
APPROVED BY	OWNER	DATE

REGISTERED PROFESSIONAL ENGINEER
O. GUY CARTER
4571
FRANKFORT, KENTUCKY

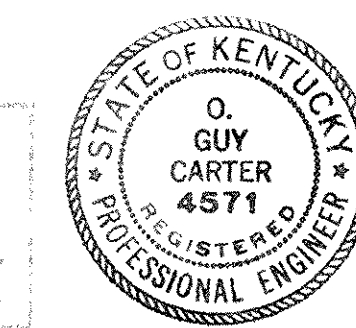

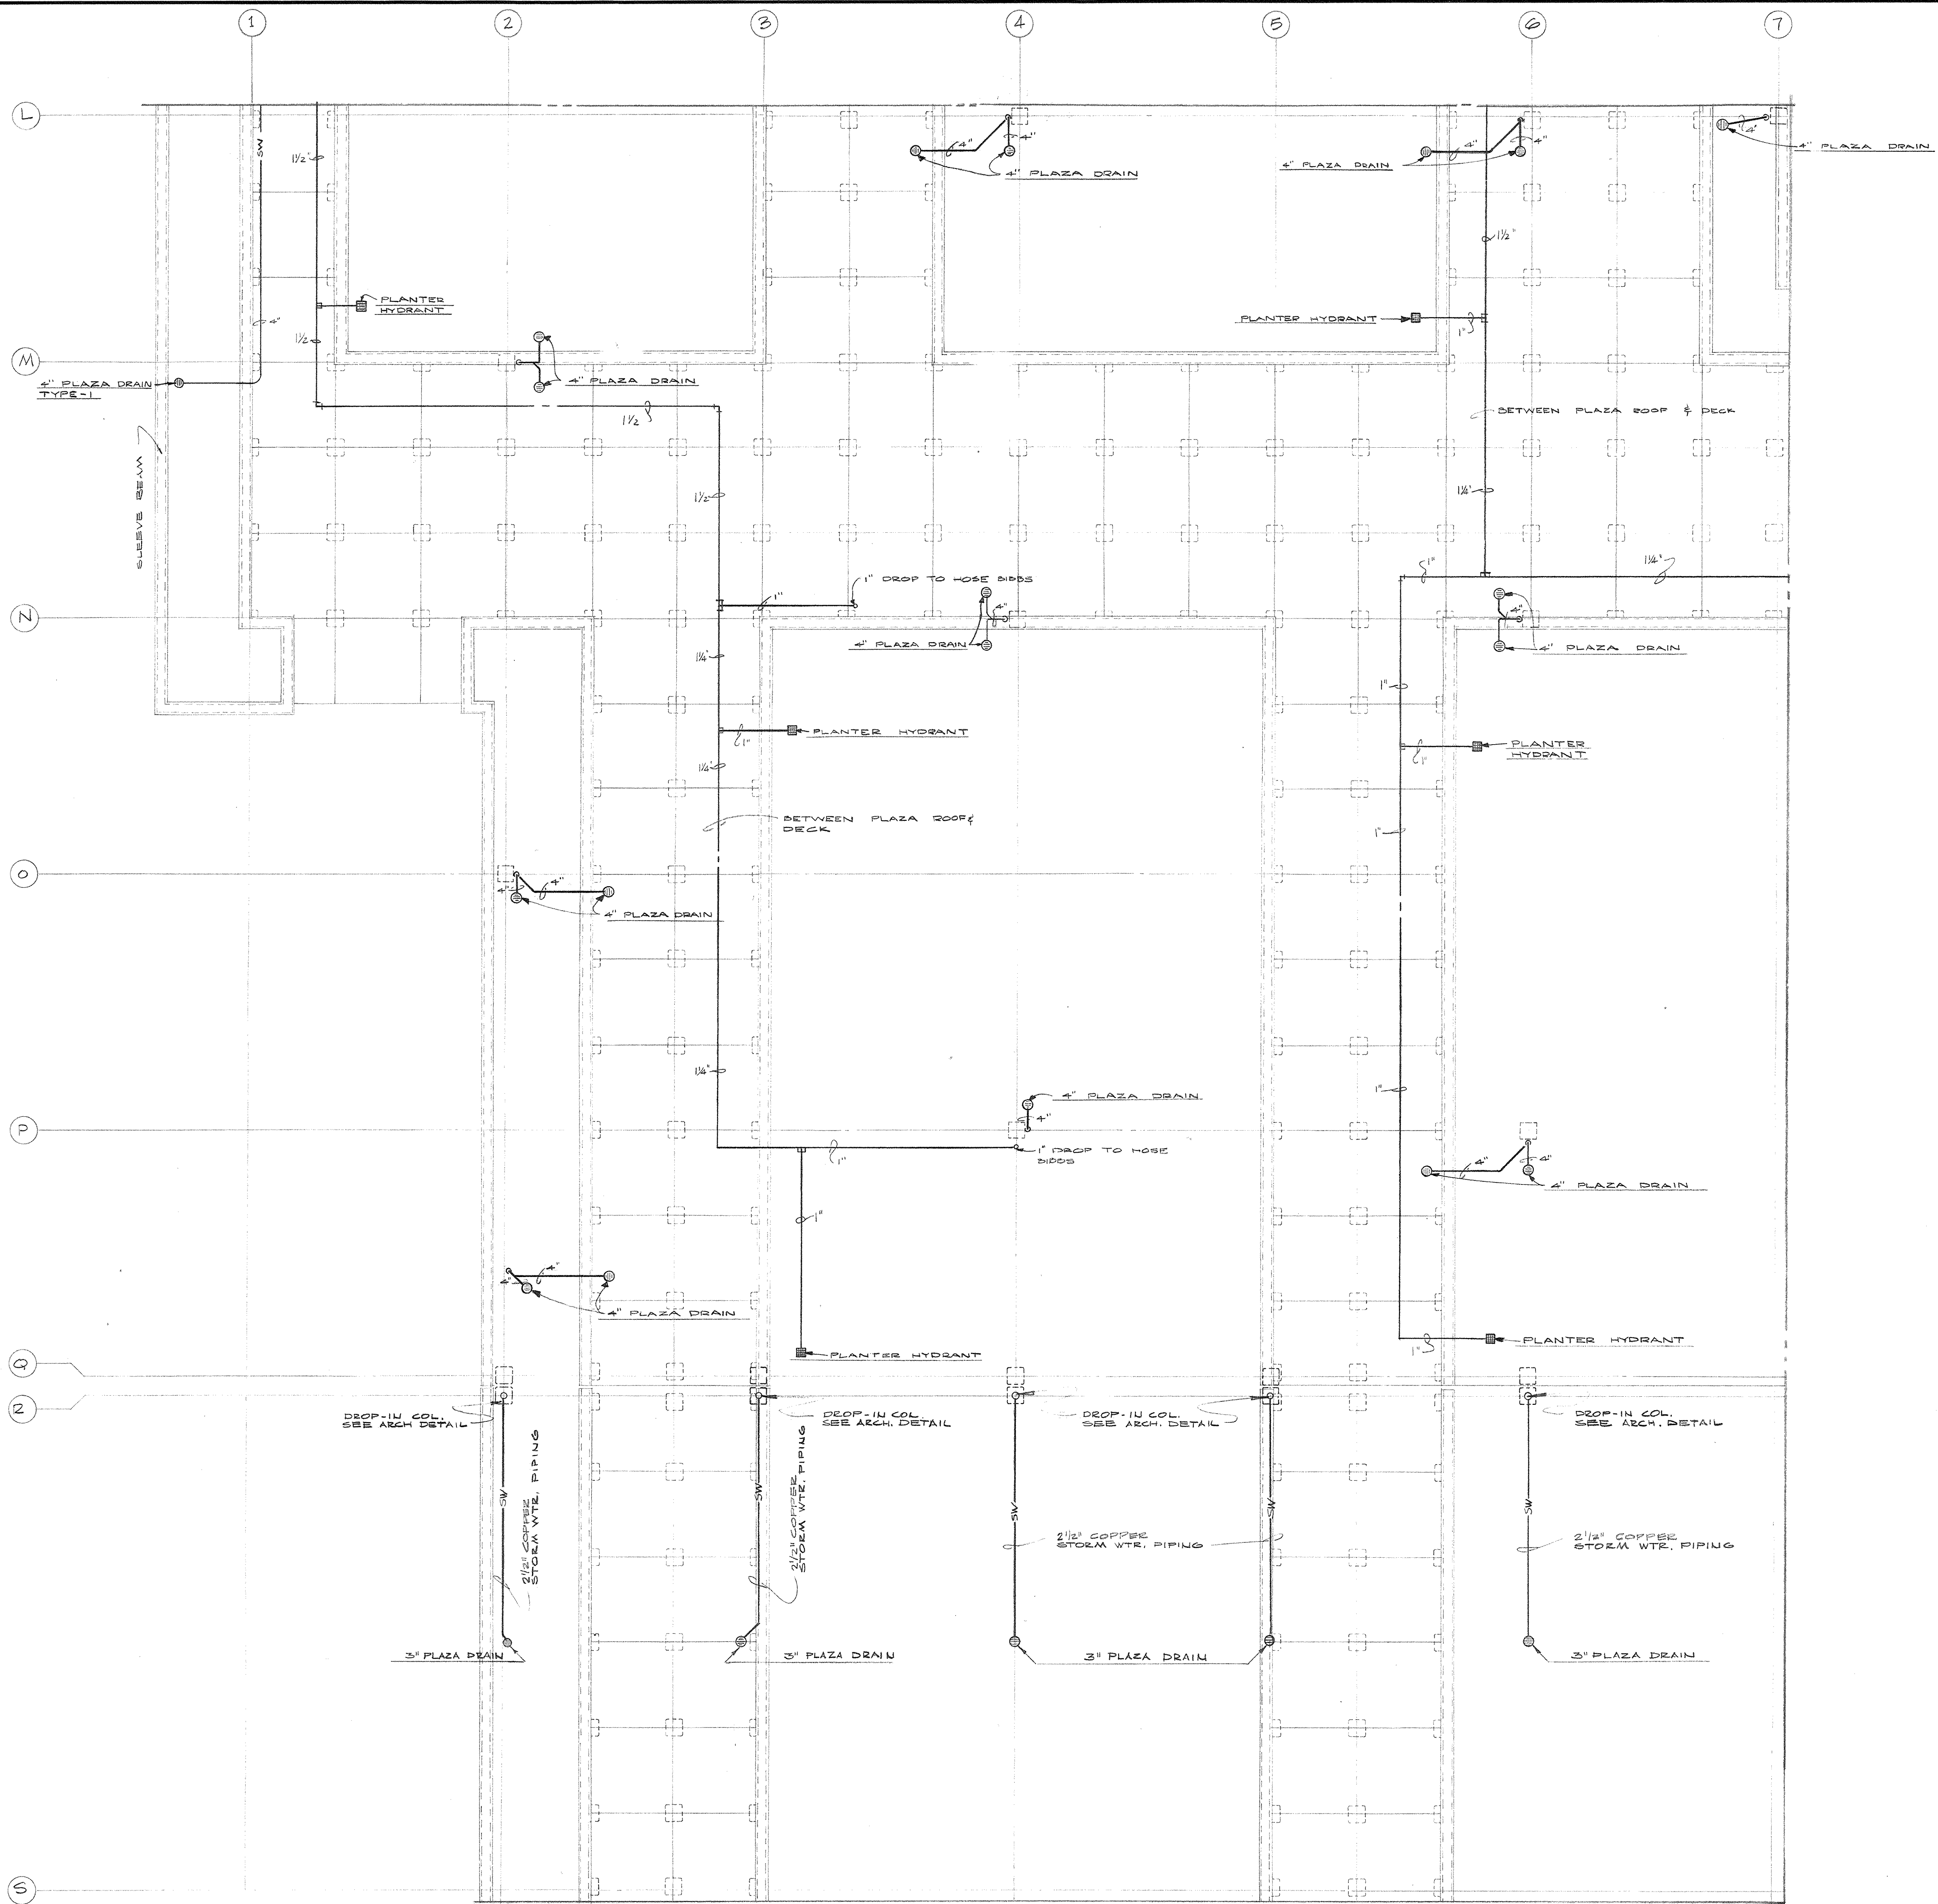



PLUMBING PLAN - PLAZA LEVEL - SECTOR B-3
SCALE: 1/8" = 1'-0"

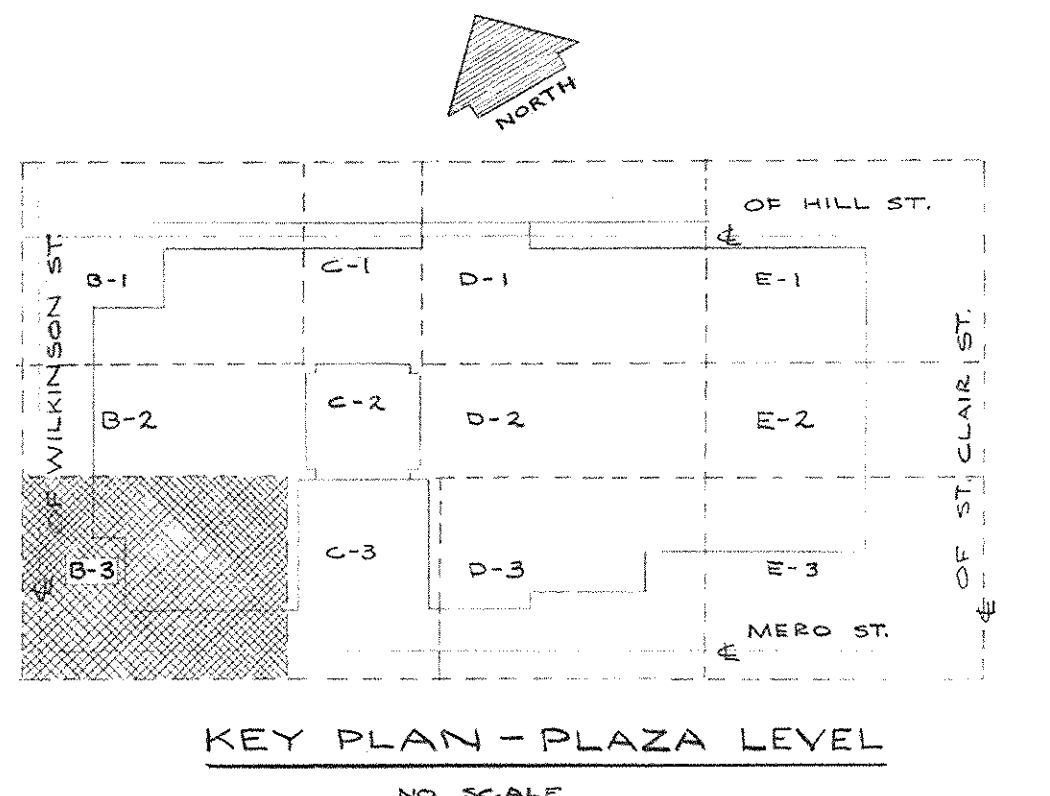


KEY PLAN - PLAZA LEVEL
NO SCALE

CAPITAL PLAZA OFFICE BUILDING FRANKFORT, KENTUCKY		
DRAWN BY SWIFT	PLUMBING PLAN - PLAZA LEVEL - SECTOR B-3	DATE 15, MAY, 1967
CHECKED BY OSC	ARCHITECT EDWARD DURELL STONE 7 EAST 67TH STREET NEW YORK, N.Y.	SCALE AS SHOWN COMM. NO. 5006
SECTOR NO. B 3	ASSOCIATE ARCHITECTS & ENGINEERS LEE POTTER SMITH & ASSOCIATES 314 WILKINSON FRANKFORT, KENTUCKY	DRAWING NO. PH 19 OF PH-31
APPROVED BY ARCHITECT	DATE	
APPROVED BY AGENCY HEAD <i>W. M. Lammell</i>	DATE MAY 24 1967	
APPROVED BY OWNER	DATE	

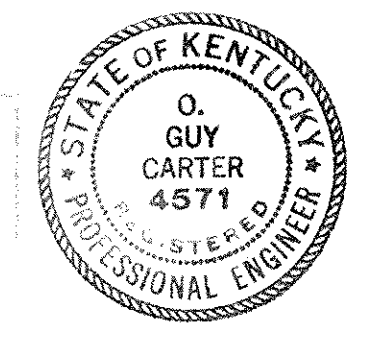


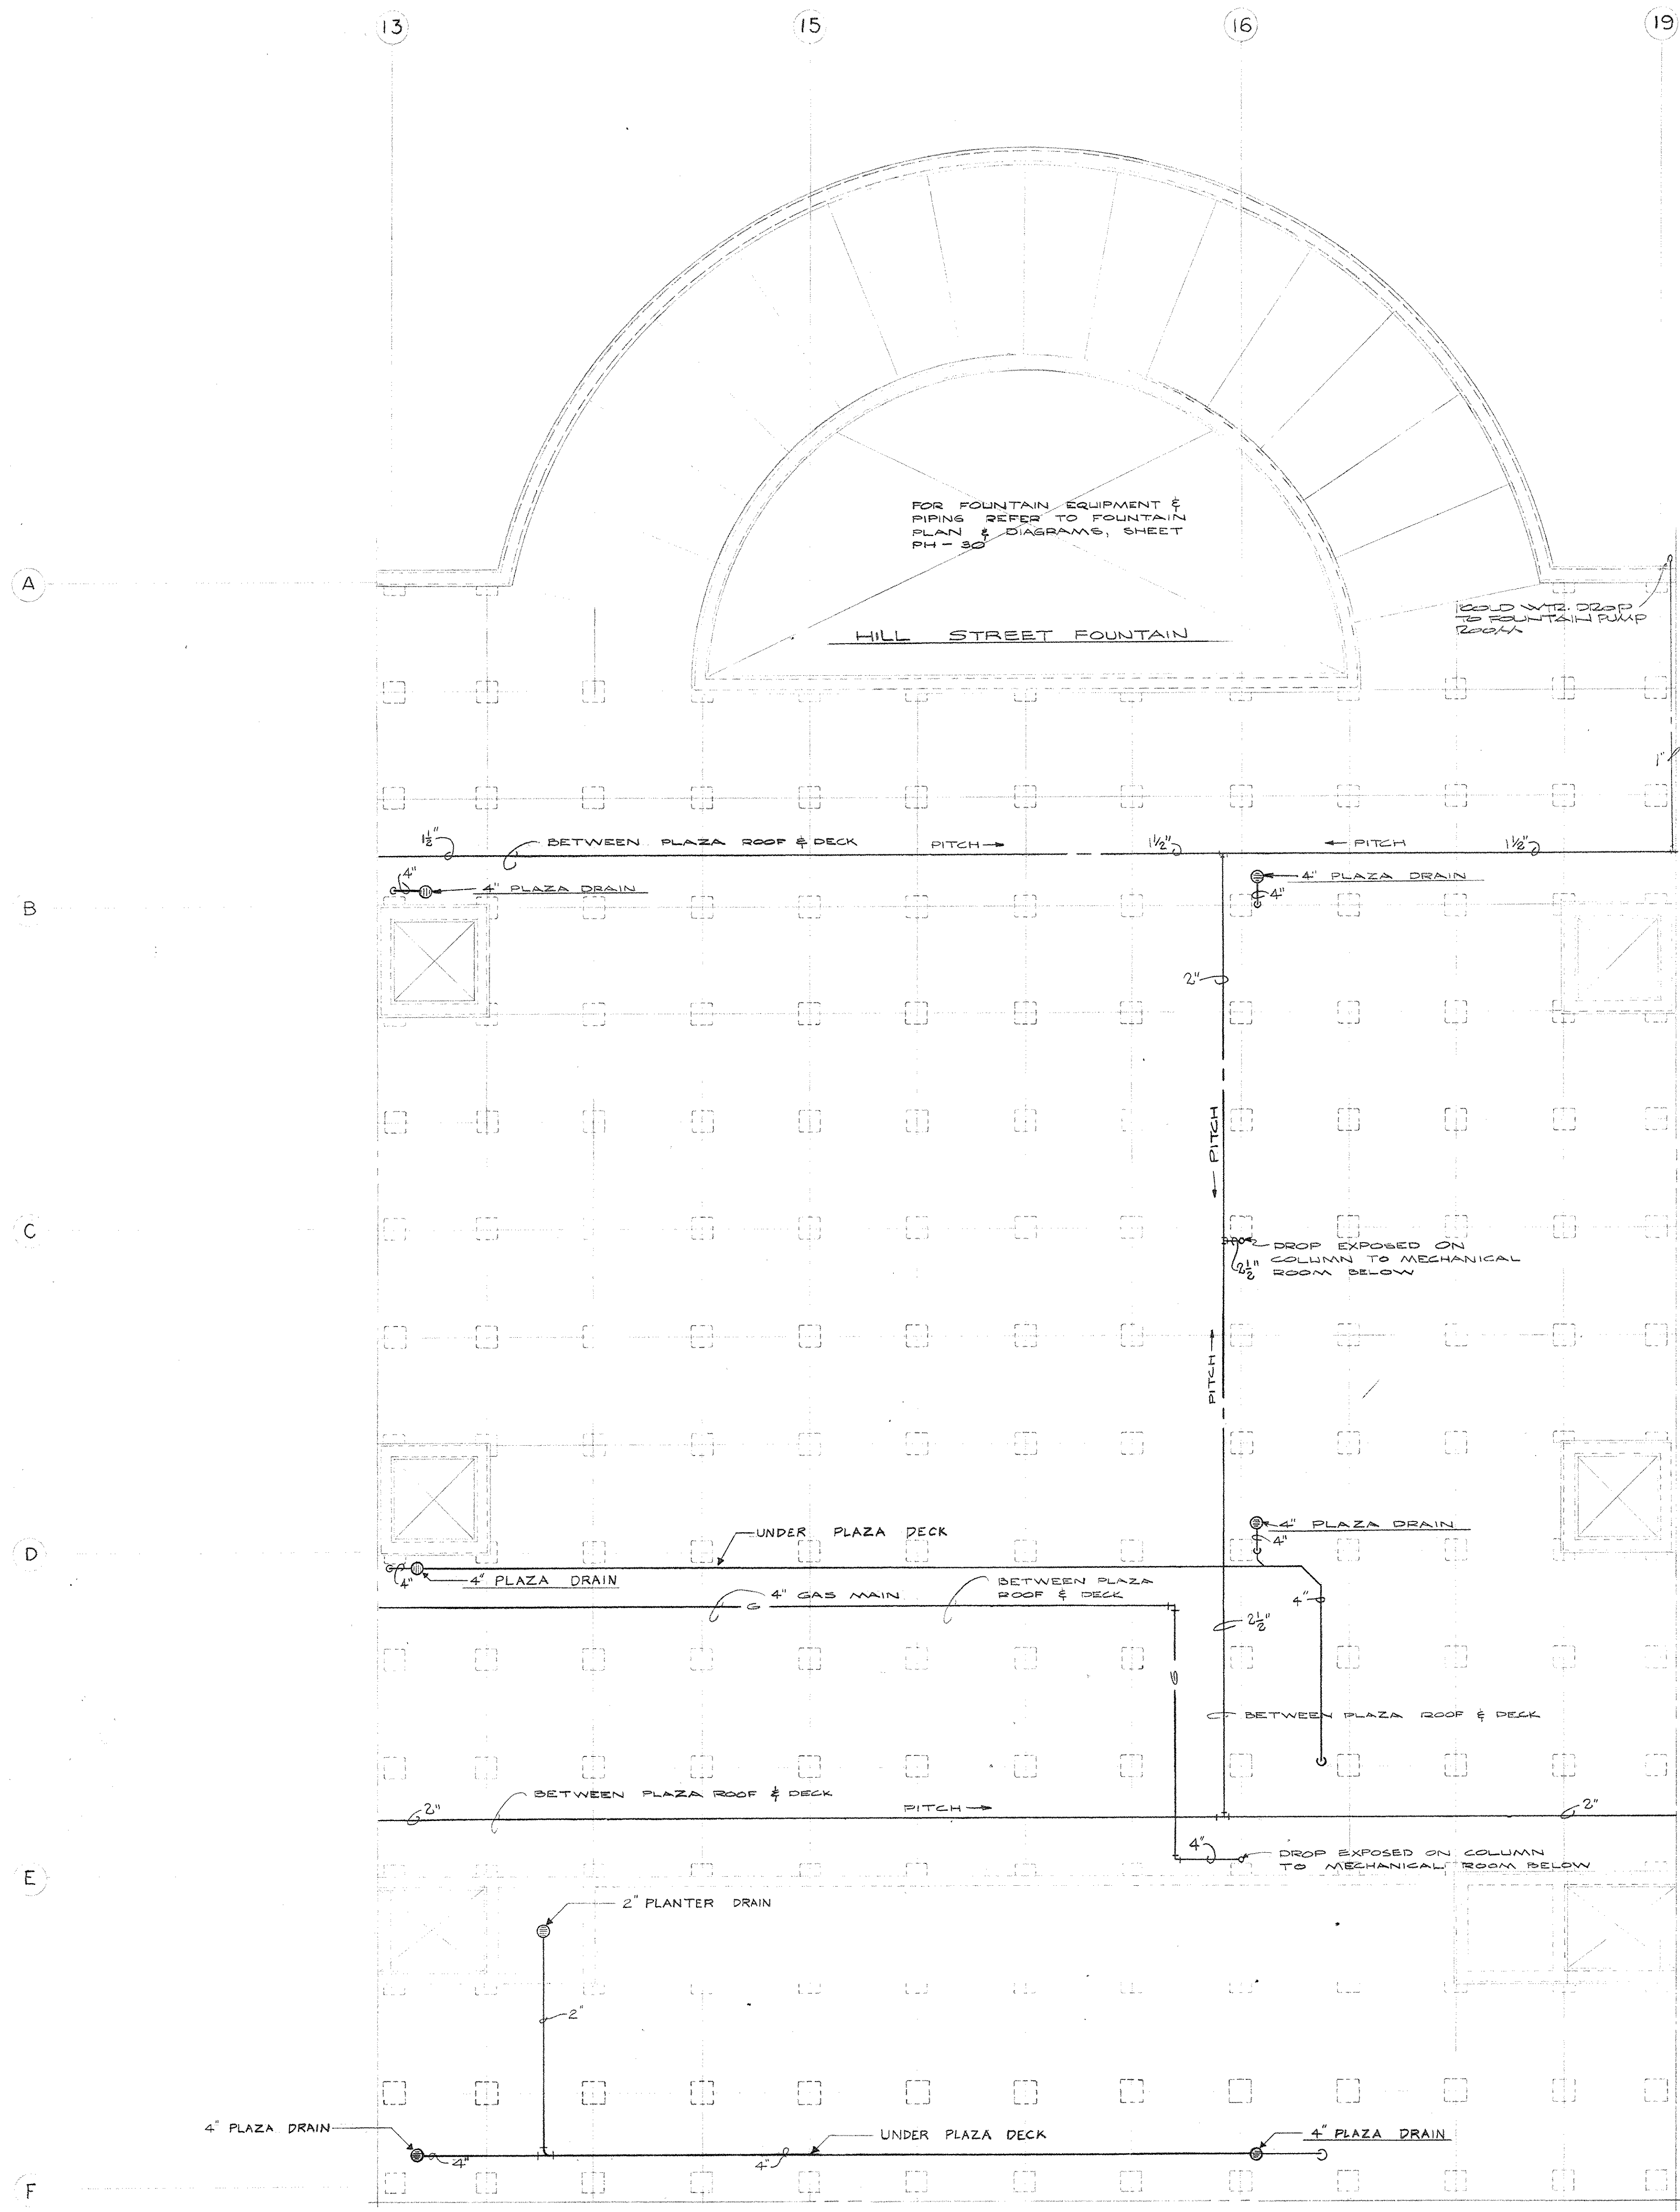



PLUMBING PLAN - PLAZA LEVEL - SECTOR C-1
SCALE: 1/8" = 1'-0"

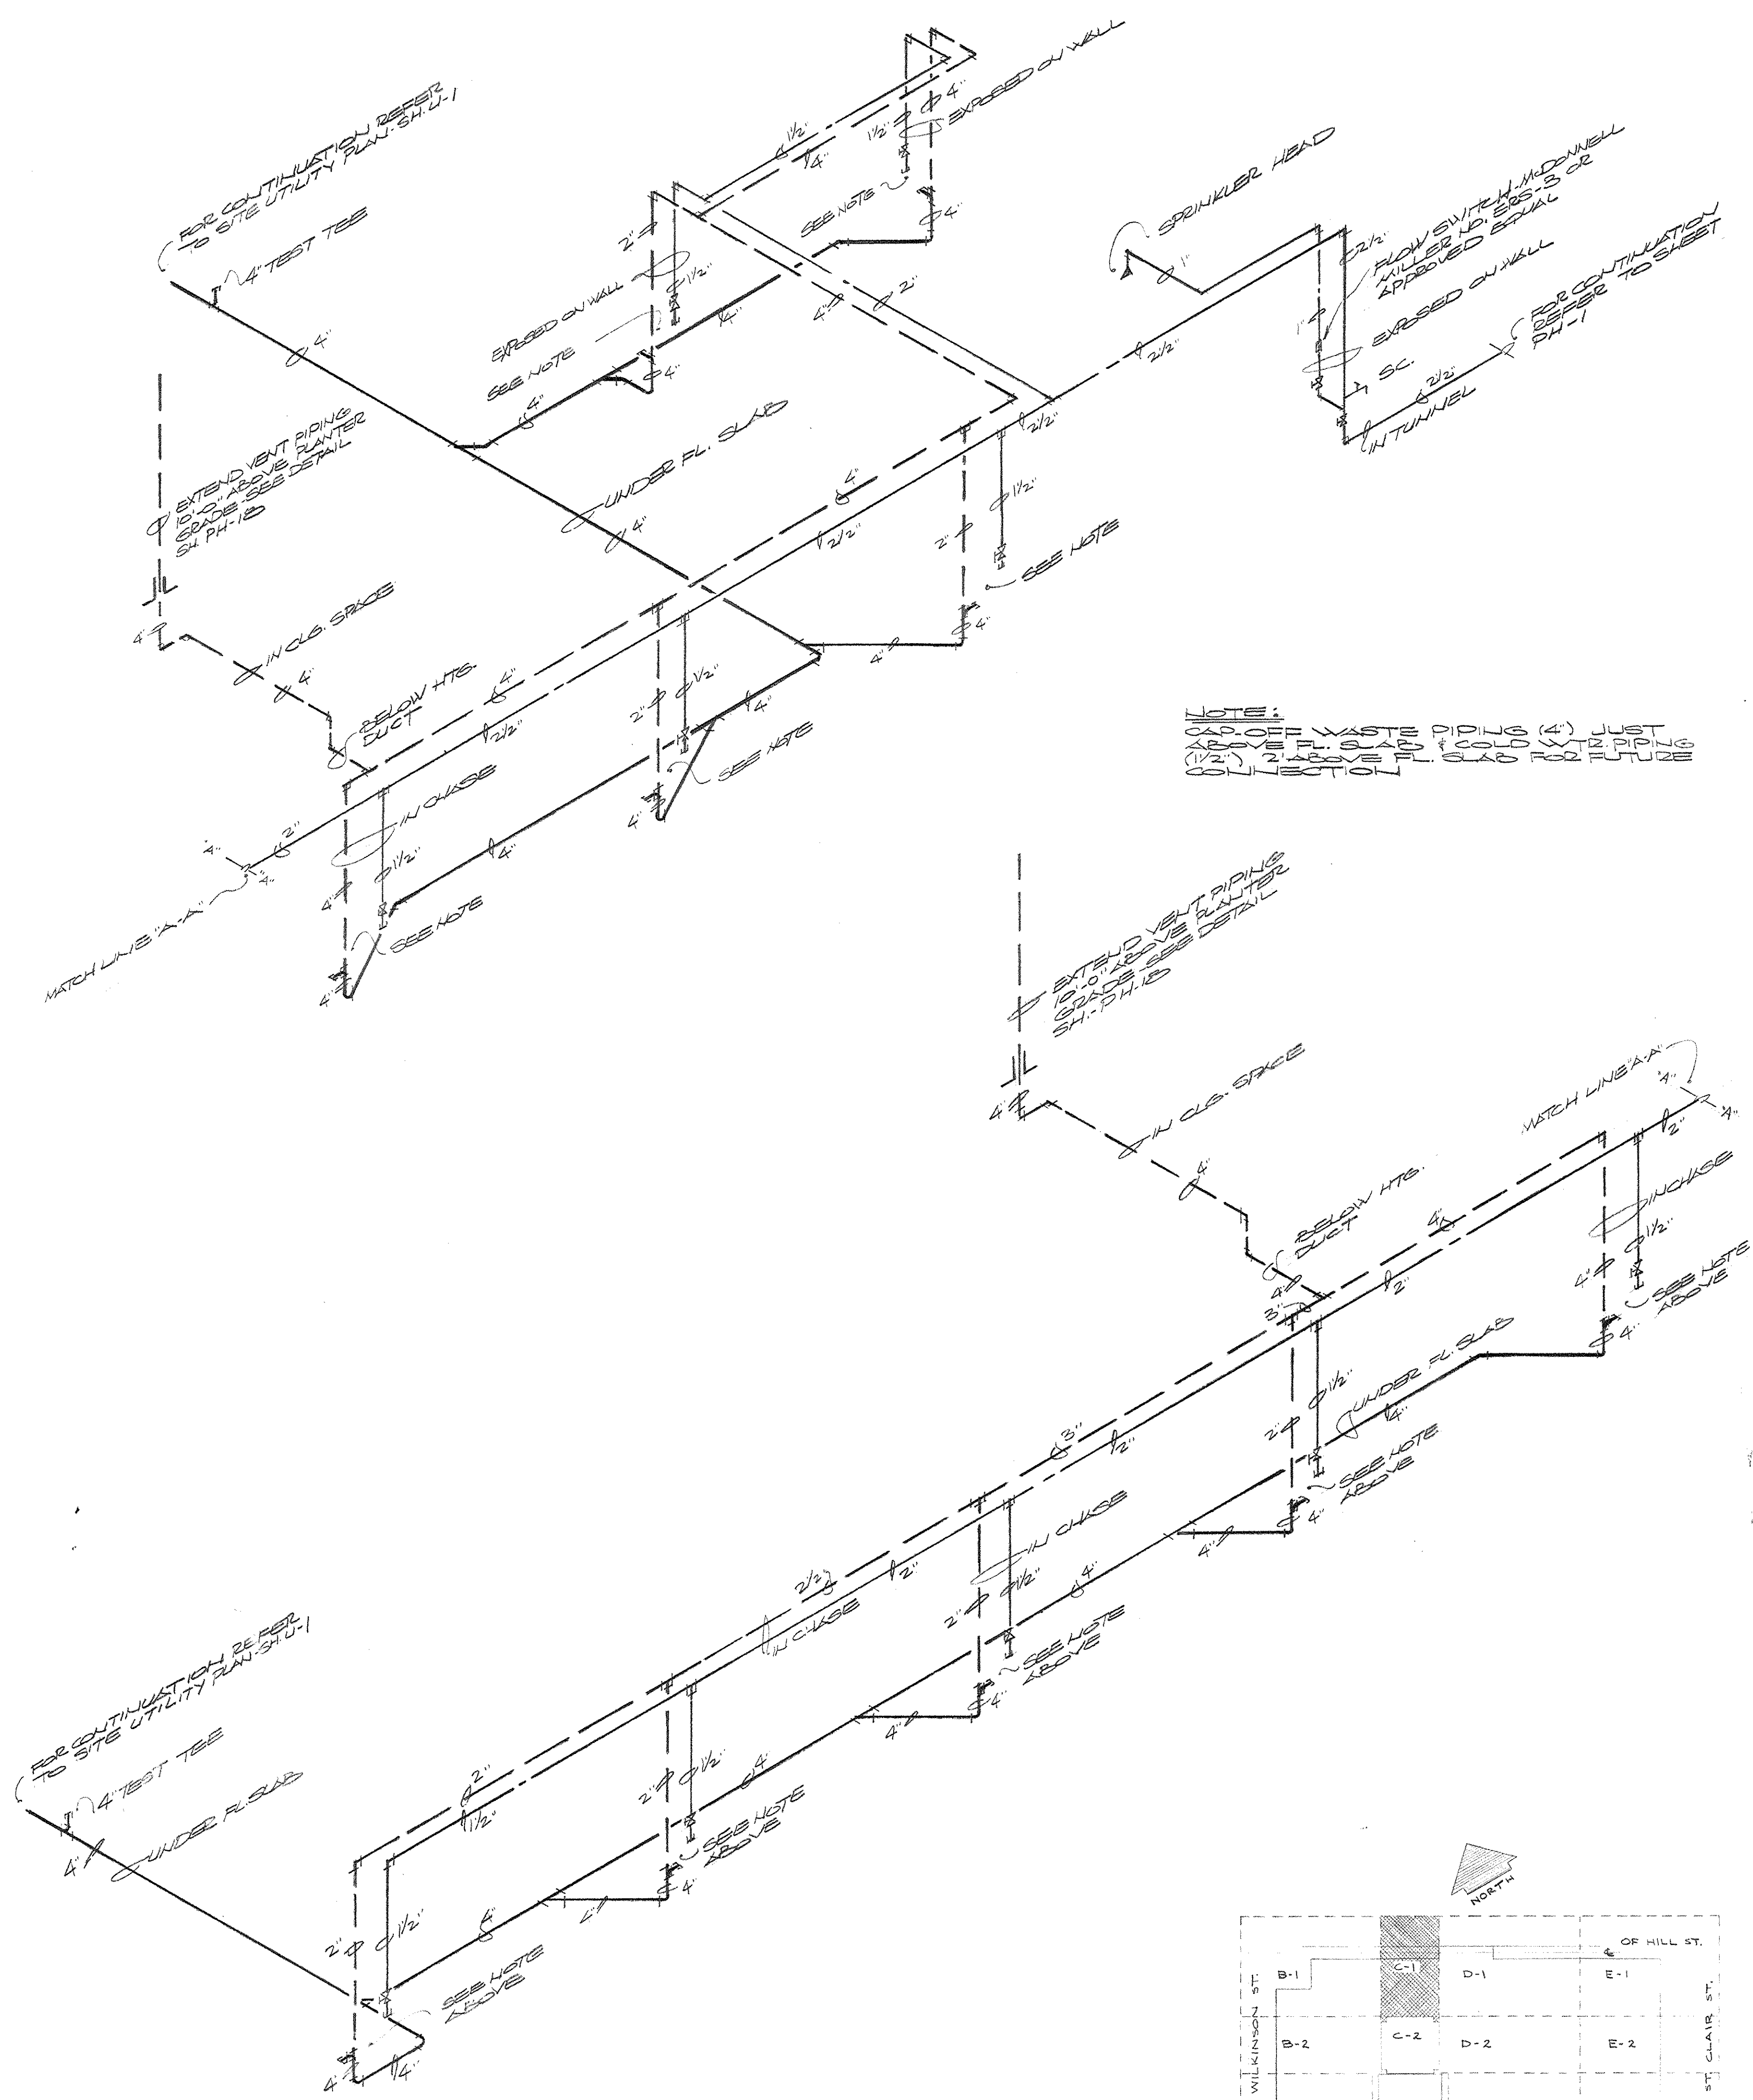


WASTE, VENT, & WATER PIPING DIAGRAMS -
COMMERCIAL AREA - SECTORS B-1, B-2, & B-3
NO SCALE

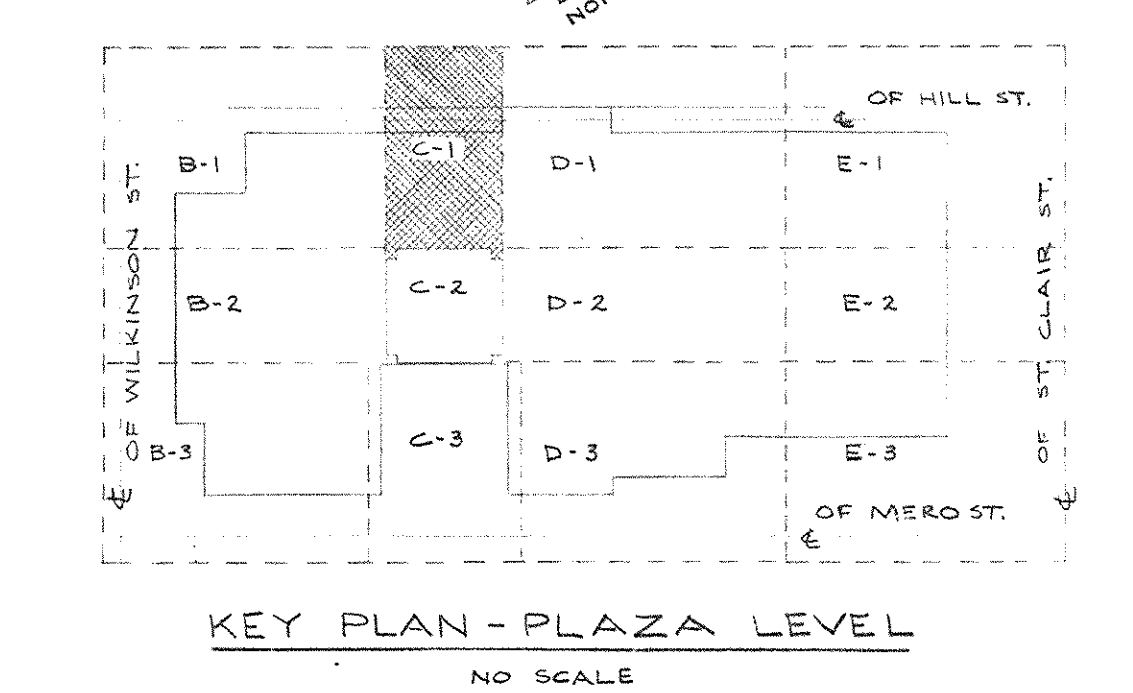


KEY PLAN - PLAZA LEVEL
NO SCALE

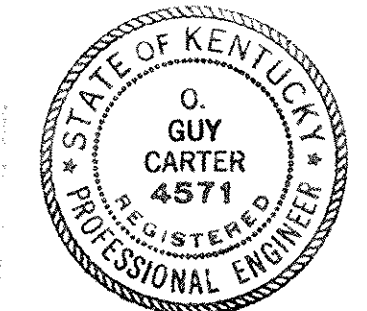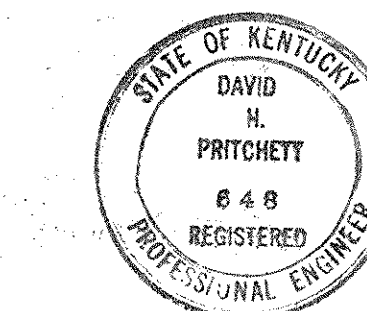

CAPITAL PLAZA OFFICE BUILDING		
FRANKFORT, KENTUCKY		
DRAWN BY DAVID H. PRITCHETT	PLUMBING PLAN - PLAZA LEVEL - SECTOR C-1	DATE 12, MAY, 1967
CHECKED BY D. G. C.	ARCHITECT EDWARD DURELL STONE	SCALE AS SHOWN
SECTOR NO. C-1	7 EAST 67TH STREET FRANKFORT, KENTUCKY	CONTRACT NO. SC022
	ASSOCIATE ARCHITECTS & ENGINEERS LEE POTTER SMITH & ASSOCIATES	DRAWING NO. PH 20
	COMMONWEALTH OF KENTUCKY DEPARTMENT OF FINANCE - ENGINEERING STAFF	OF PH-31
APPROVED BY	ARCHITECT	DATE
APPROVED BY	AGENCY HEAD	DATE
APPROVED BY	OWNER	DATE

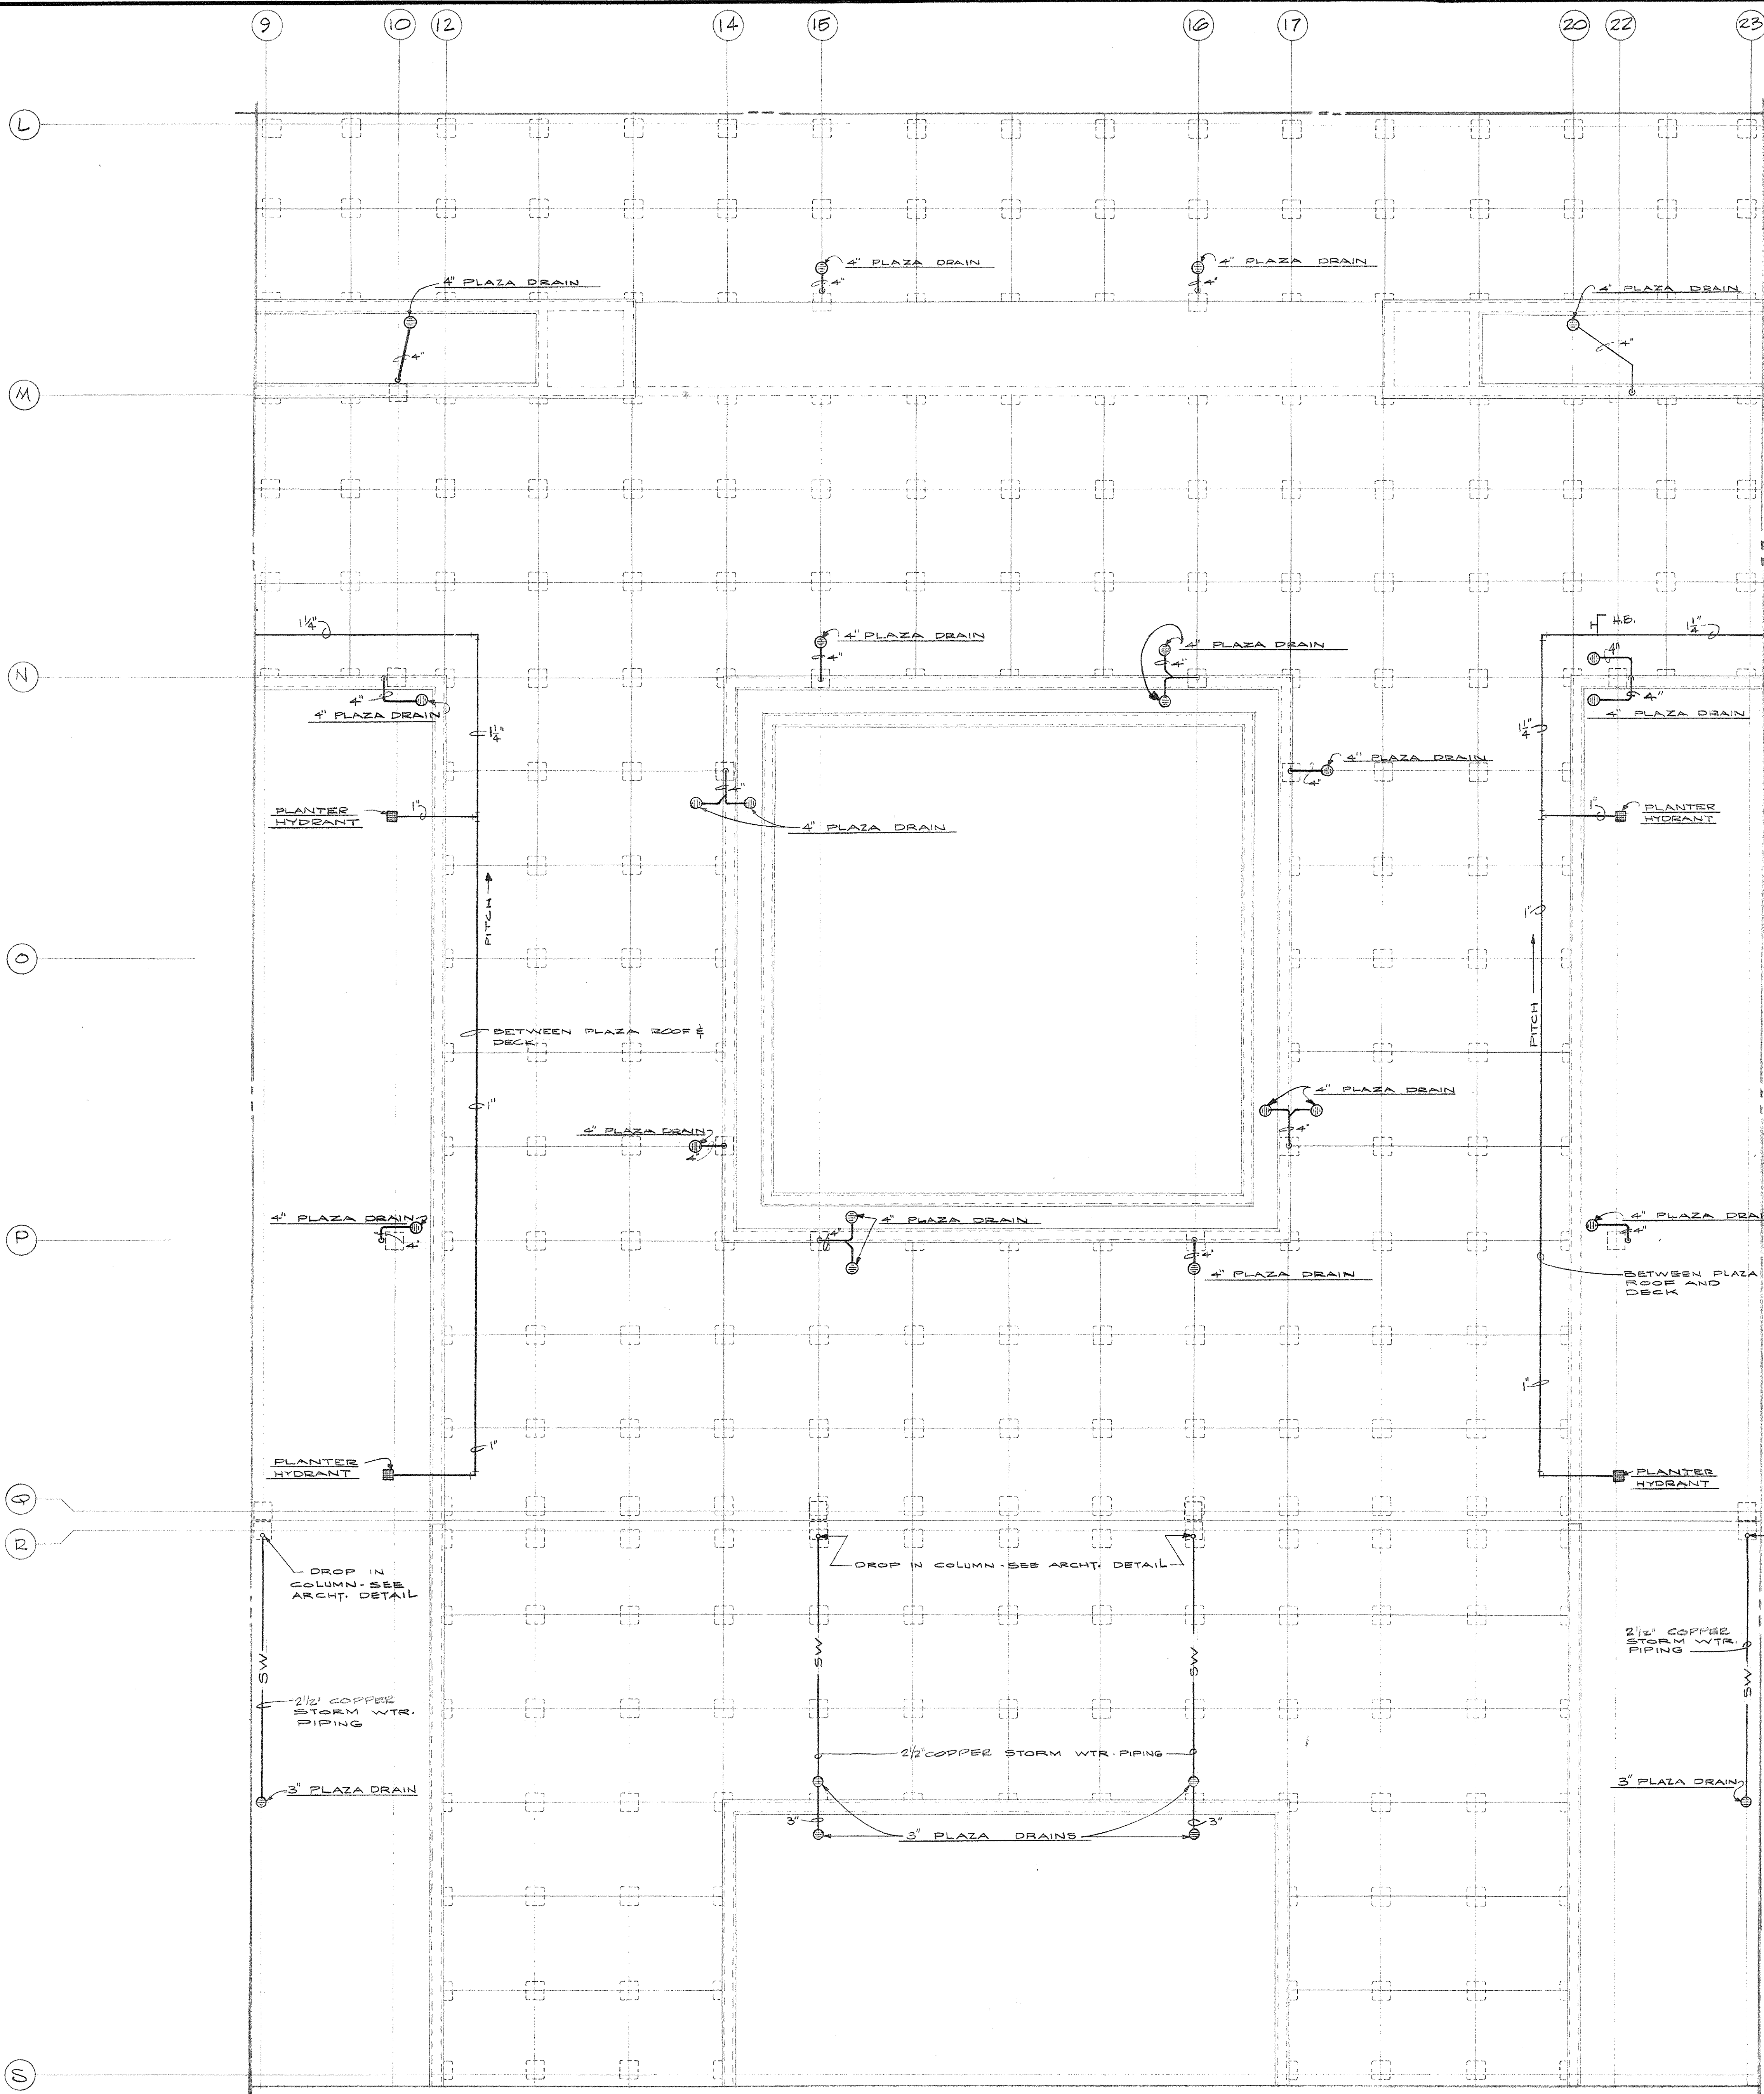



PLUMBING PLAN - PLAZA LEVEL - SECTOR C-3
SCALE: 1/8" = 1'-0"

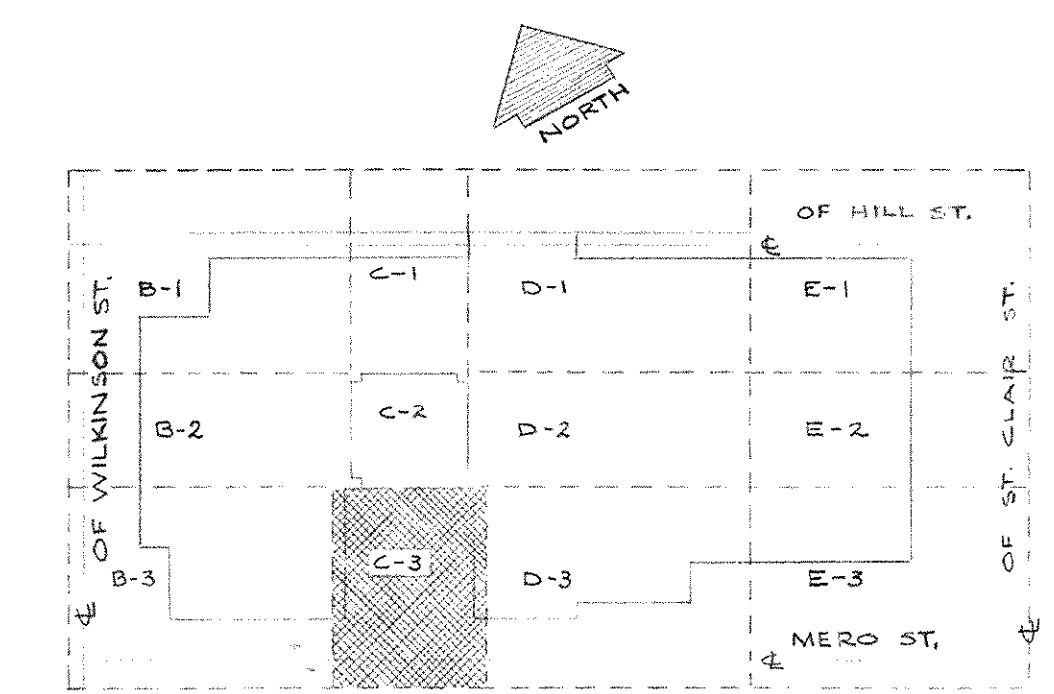


KEY PLAN - PLAZA LEVEL
NO SCALE

CAPITAL PLAZA OFFICE BUILDING
FRANKFORT, KENTUCKY


DRAWN BY SWIFT	PLUMBING PLAN - PLAZA LEVEL - SECTOR C-3	DATE 15, MAY, 1967
TRACED BY D.S. & M.S.	ARCHITECT EDWARD DURELL STONE 7 EAST 67TH STREET NEW YORK N. Y.	SCALE AS SHOWN
CHECKED BY D.S.C.	ASSOCIATE ARCHITECTS & ENGINEERS LEE POTTER SMITH & ASSOCIATES 314 WILKINSON FRANKFORT, KENTUCKY	COMM. NO. 20866
SECTOR NO. C 3	DEPARTMENT OF FINANCE - ENGINEERING STAFF FRANKFORT, KENTUCKY	DRAWING NO. PH 21
APPROVED BY ARCHITECT	DATE	of PH-31
APPROVED BY AGENCY HEAD	DATE MAY 24 1967	
APPROVED BY OWNER	DATE	

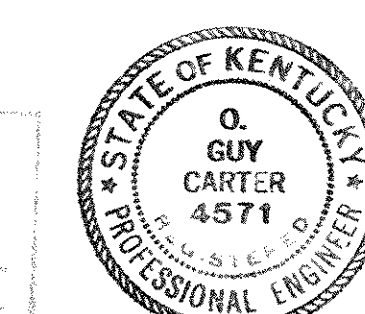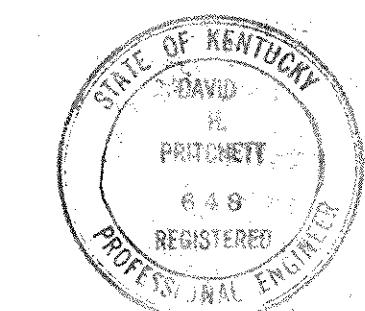


STATE OF KENTUCKY
DEPARTMENT OF FINANCE
FRANKFORT, KENTUCKY

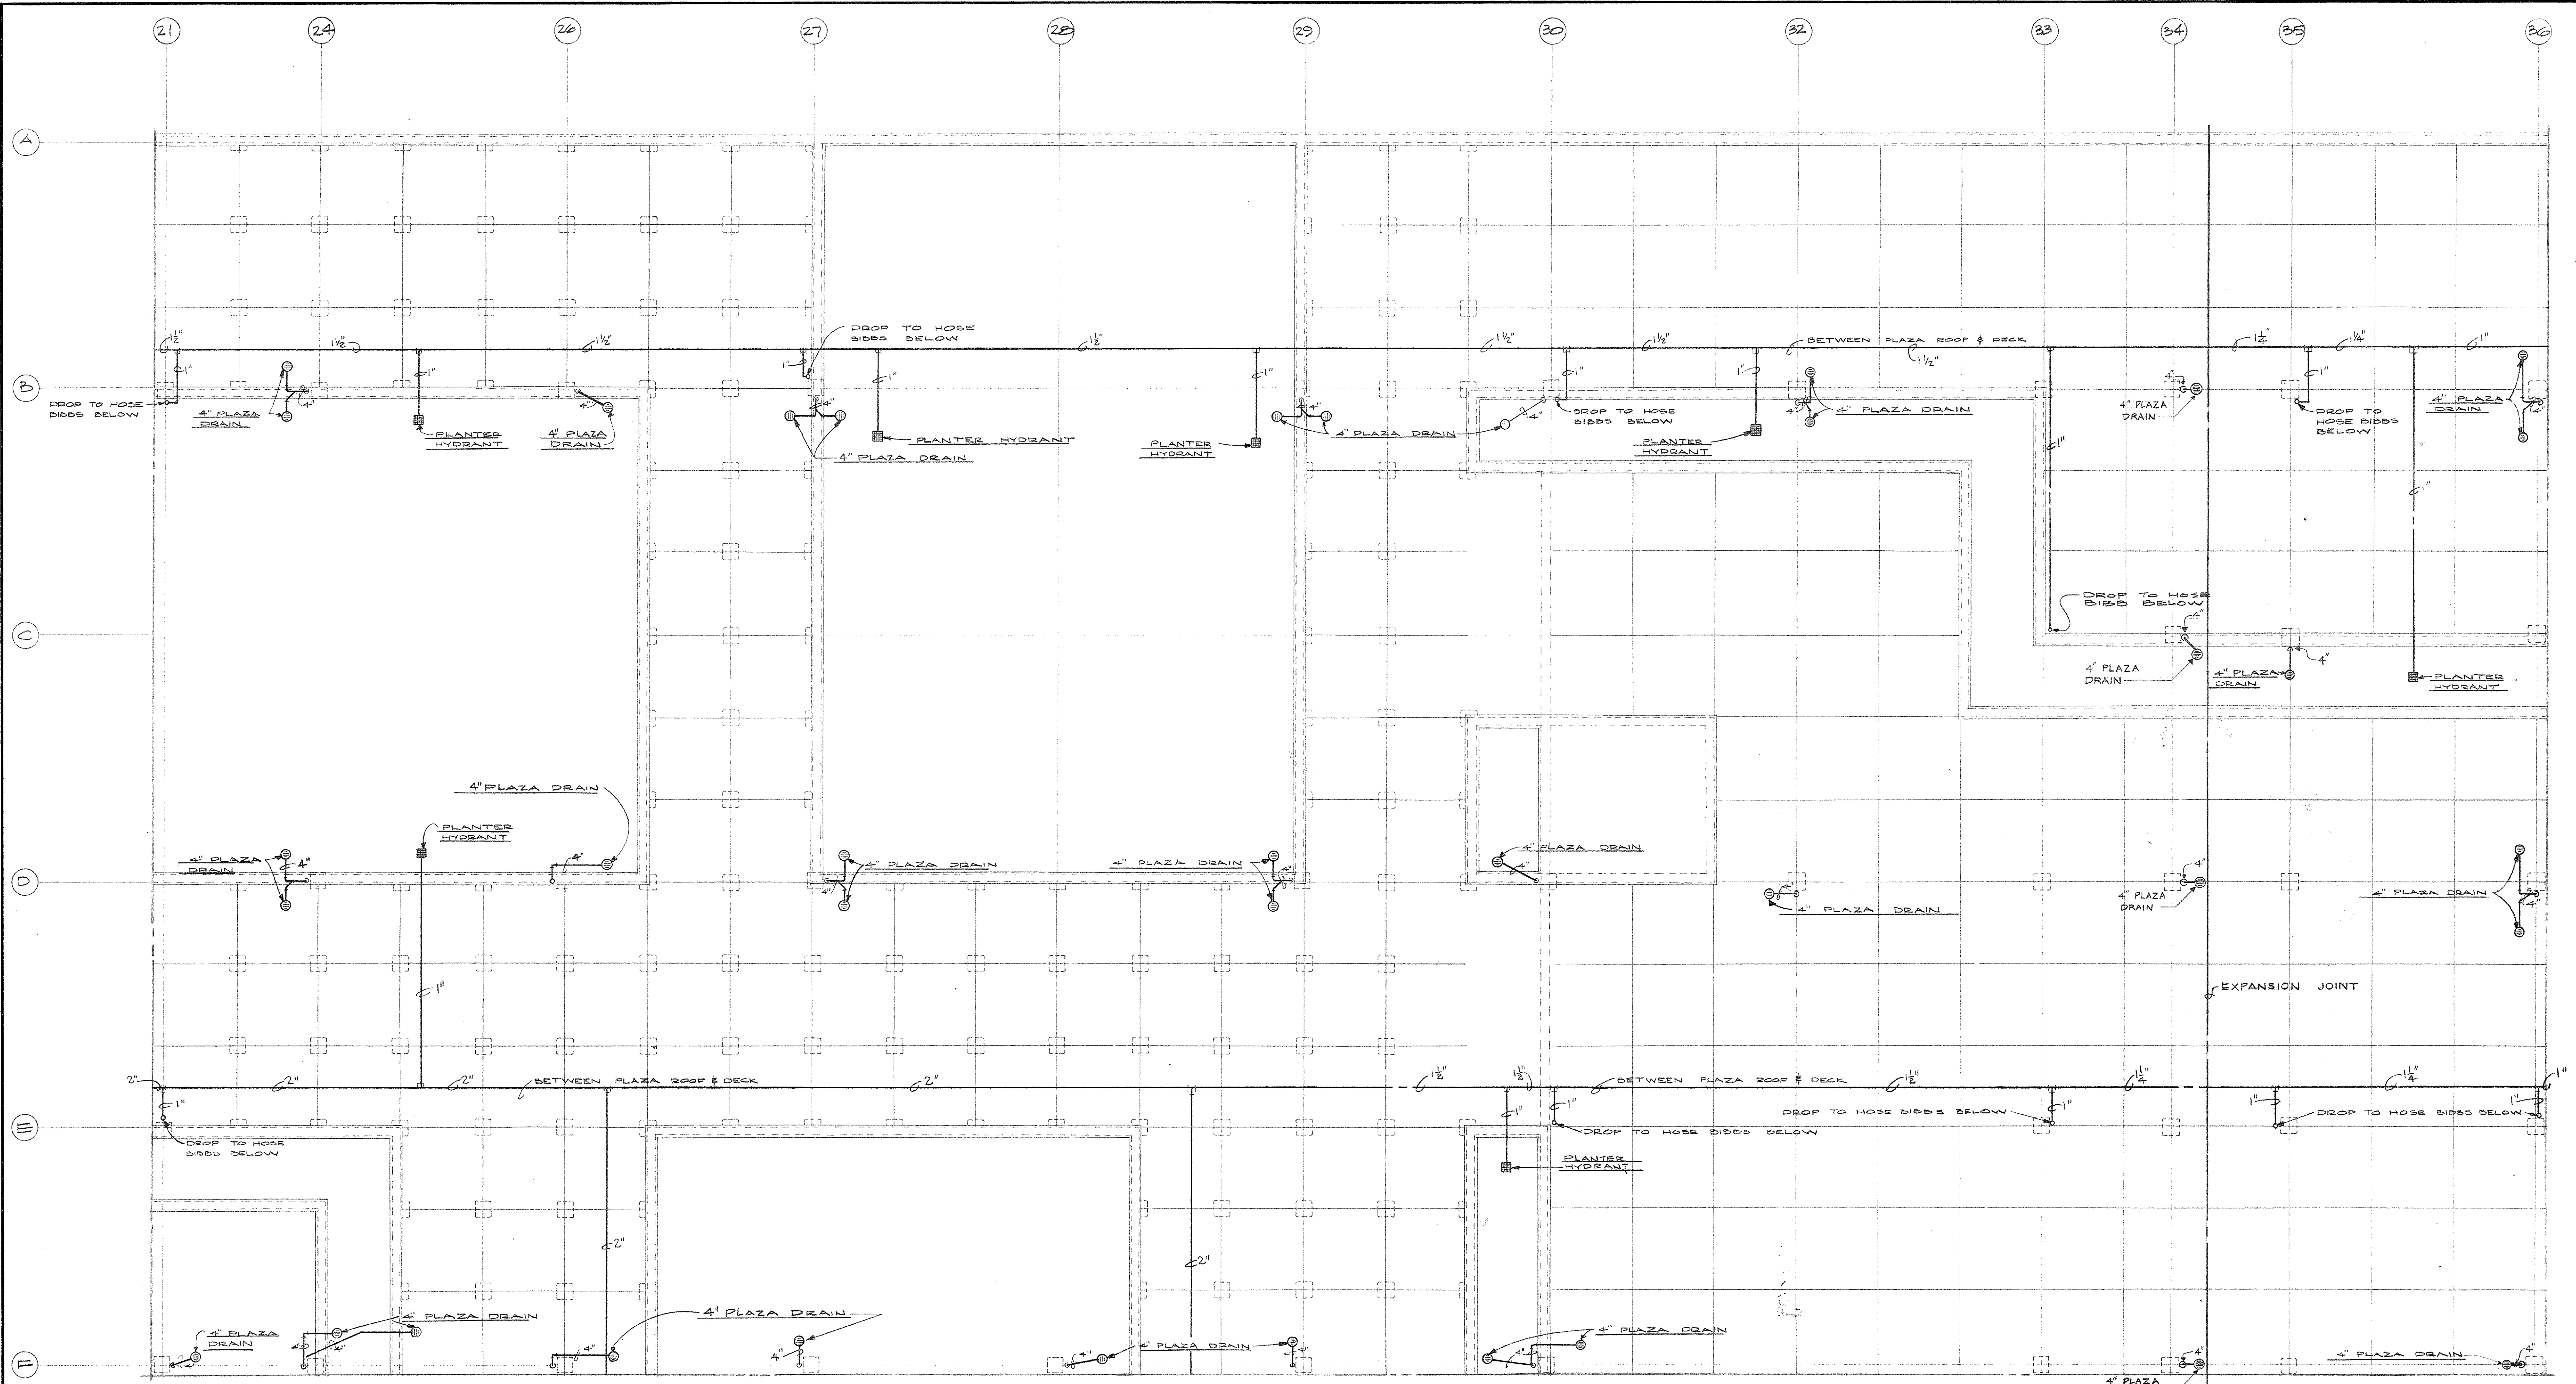

PLUMBING PLAN - PLAZA LEVEL - SECTOR D-1
SCALE: 1/8" = 1'-0"

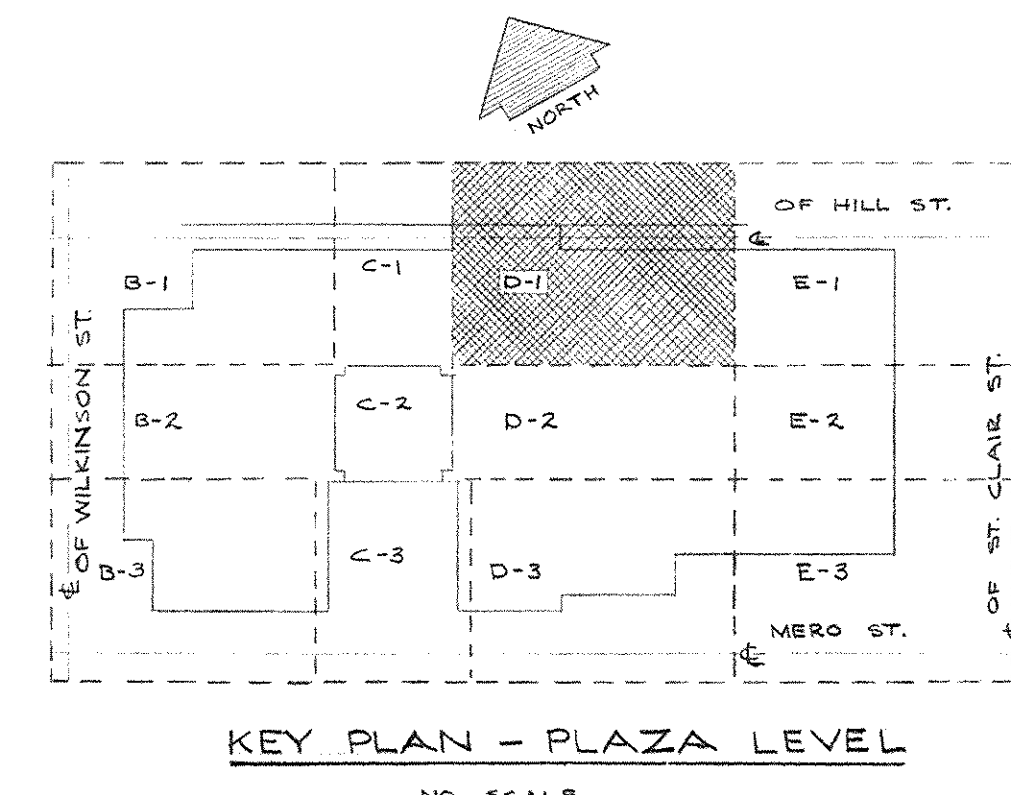


KEY PLAN - PLAZA LEVEL
NO SCALE

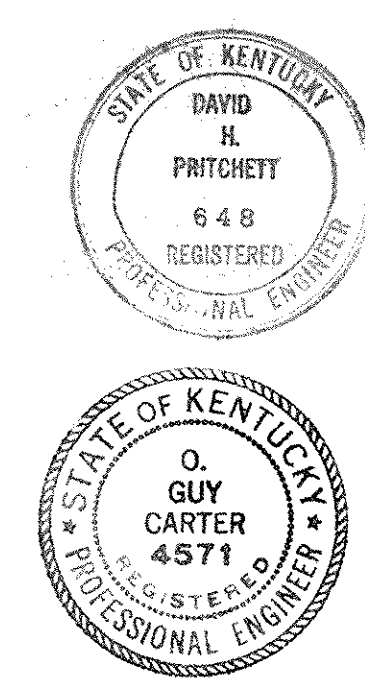


AS BUILT REVISIONS 21 AUGUST 1972

CAPITAL PLAZA OFFICE BUILDING FRANKFORT, KENTUCKY		
DRAWN BY SWIFT	PLUMBING PLAN - PLAZA LEVEL - SECTOR D-1	DATE 15, MAY, 1967
TRACED BY DS & MS	ARCHITECT	SCALE AS SHOWN
CHECKED BY D.S.C.	EDWARD DURELL STONE 7 EAST 87TH STREET NEW YORK, N. Y.	COMM. NO. 80056
SECTOR NO. D 1	ASSOCIATE ARCHITECTS & ENGINEERS LEE POTTER SMITH & ASSOCIATES 314 WILKINSON FRANKFORT, KENTUCKY	DRAWING NO. PH 22
APPROVED BY ARCHITECT	DATE	OF PH-31
APPROVED BY AGENCY HEAD <i>W. M. ...</i>	DATE MAY 24 1967	
APPROVED BY OWNER	DATE	

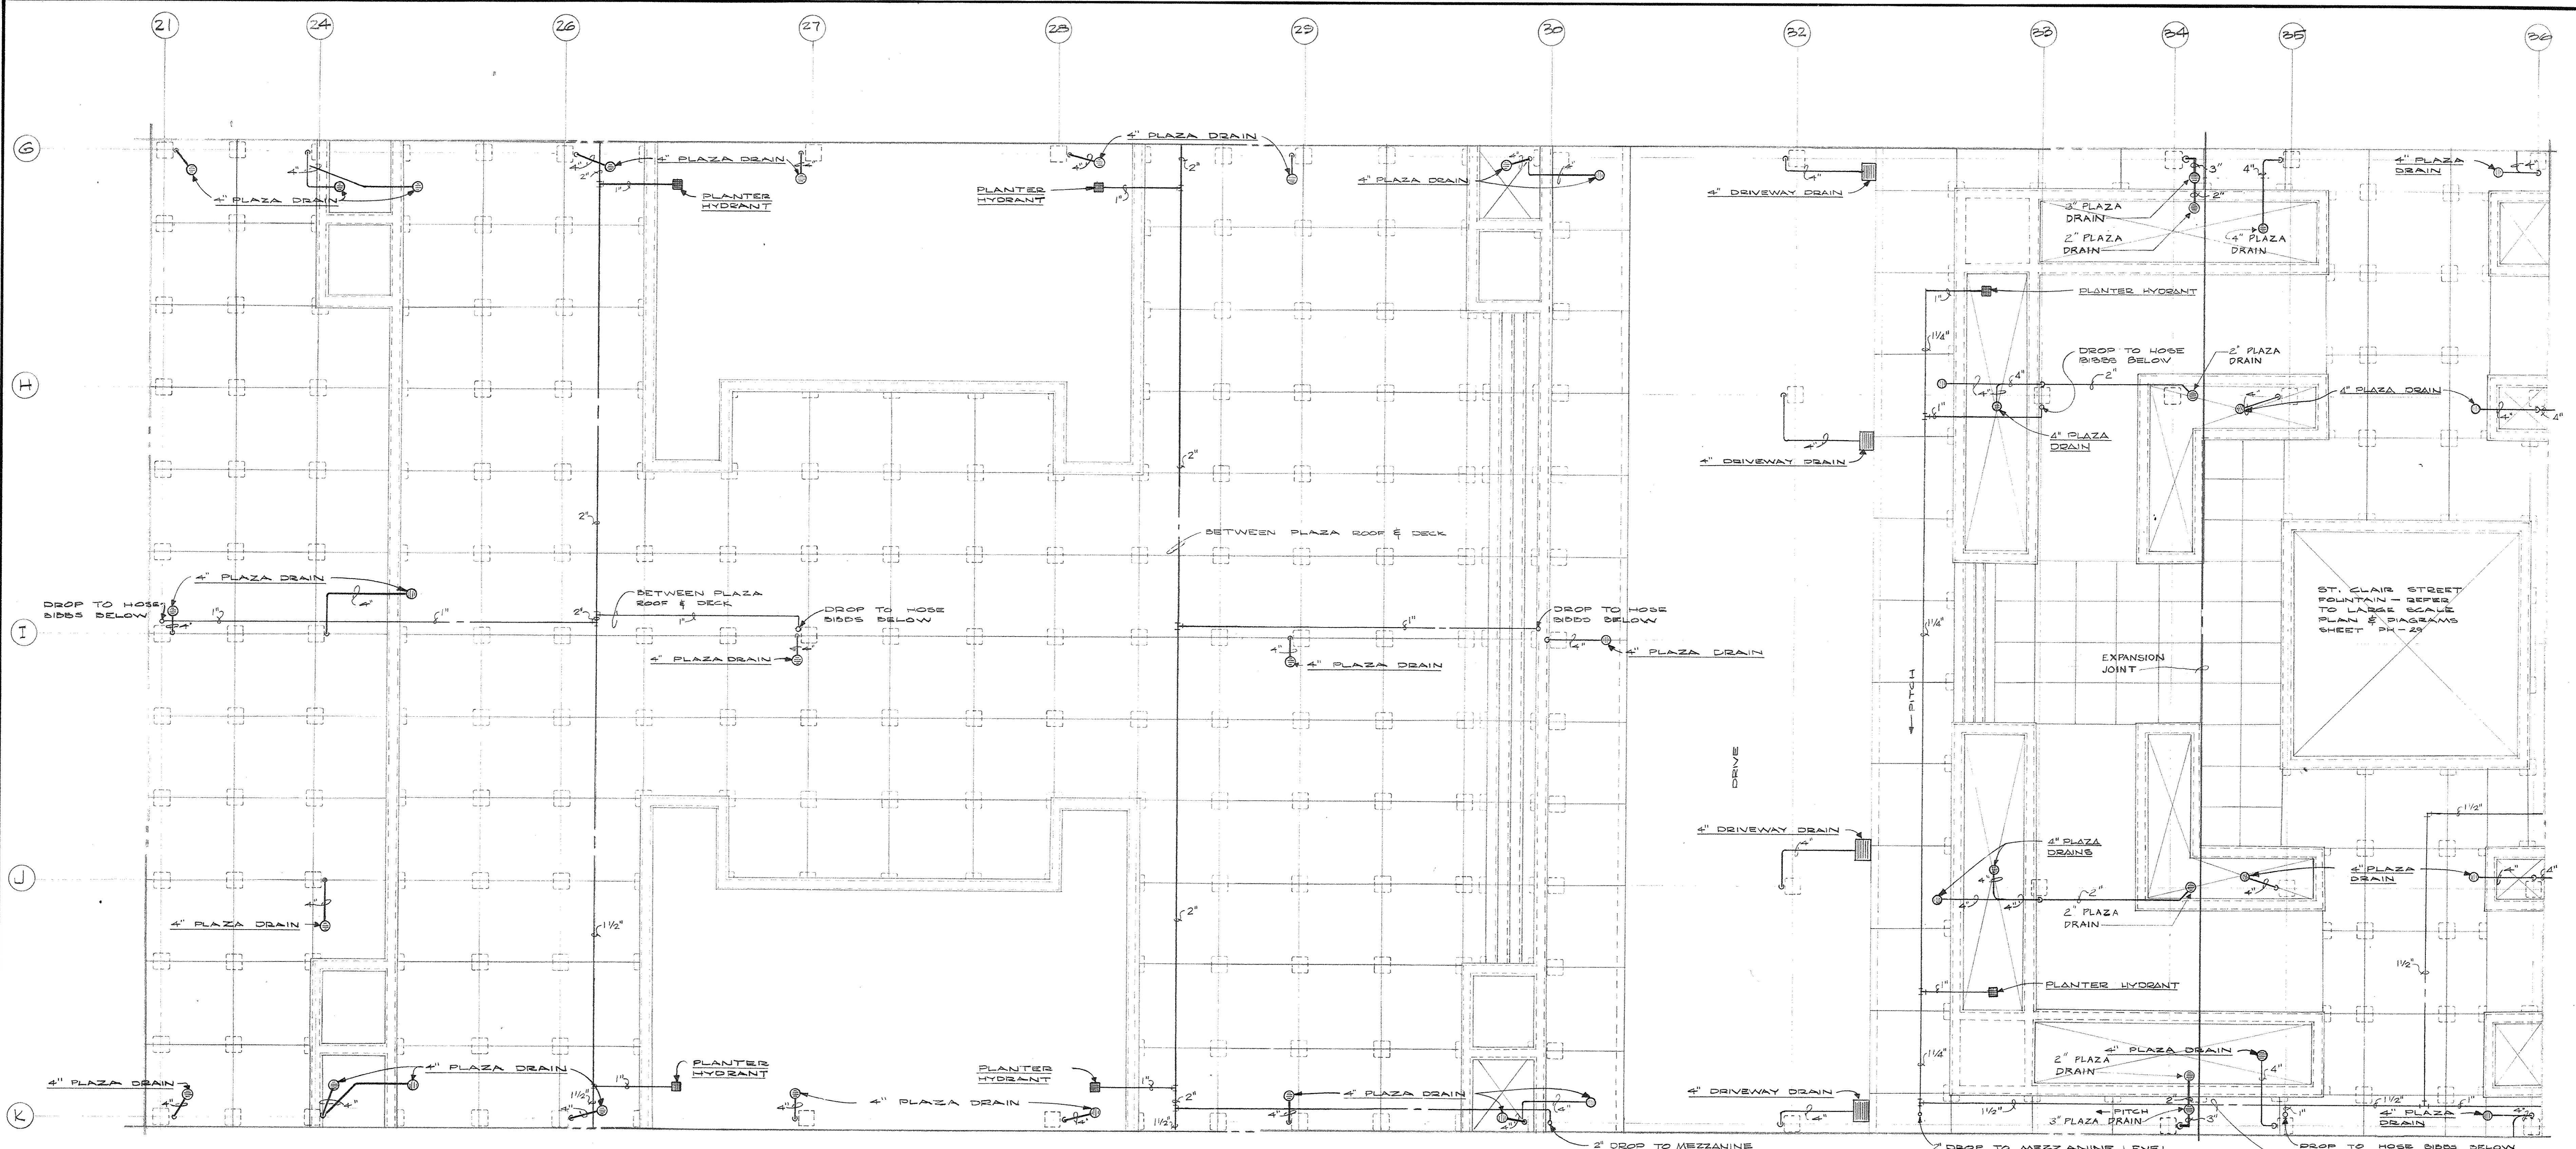

PLUMBING PLAN - PLAZA LEVEL - SECTOR D-2
SCALE: 1/8" = 1'-0"

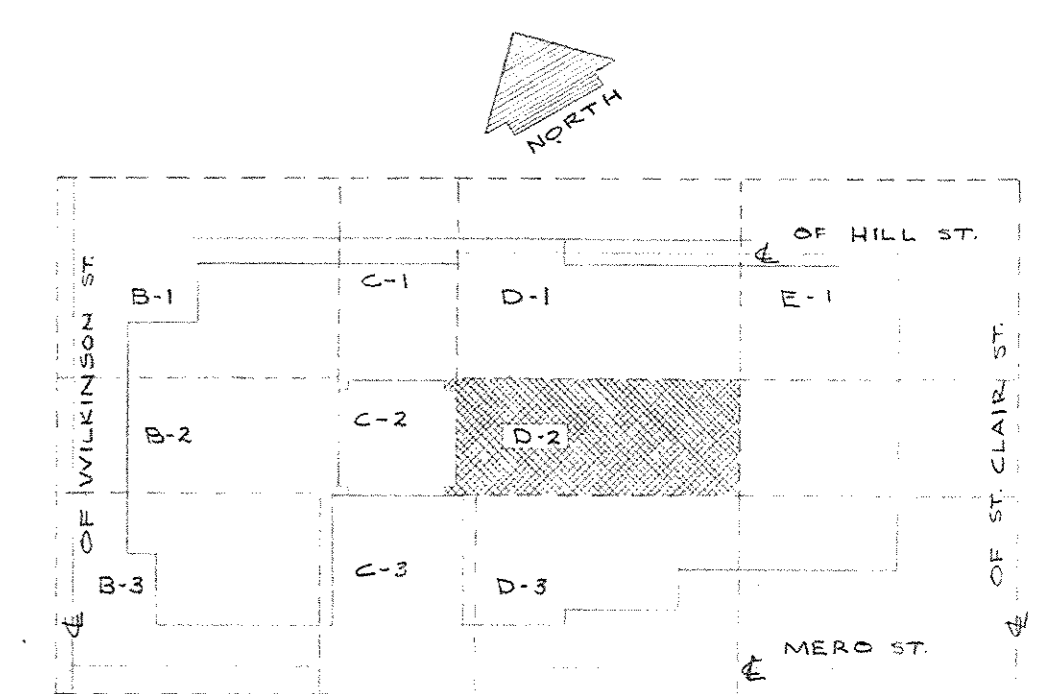




KEY PLAN - PLAZA LEVEL

NO SCALE
AS BUILT REVISION 21 AUGUST 1972

CAPITAL PLAZA OFFICE BUILDING
FRANKFORT, KENTUCKY

DRAWN BY SWIFT	PLUMBING PLAN - PLAZA LEVEL - SECTOR D-2	DATE 15 MAY 1967
TRACED BY DS & MS	ARCHITECT EDWARD DURELL STONE	SCALE AS SHOWN
CHECKED BY O. S. C.	7 EAST 6TH STREET NEW YORK, N. Y.	COMM. NO. 20066
SECTOR NO. D 2	ASSOCIATE ARCHITECTS & ENGINEERS LEE POTTER SMITH & ASSOCIATES 314 WILKINSON FRANKFORT, KENTUCKY	DRAWING NO. PH 23
APPROVED BY ARCHITECT	DATE	OF PH-31
APPROVED BY AGENCY HEAD <i>W. J. Mc... ..</i>	DATE	
APPROVED BY OWNER	DATE	

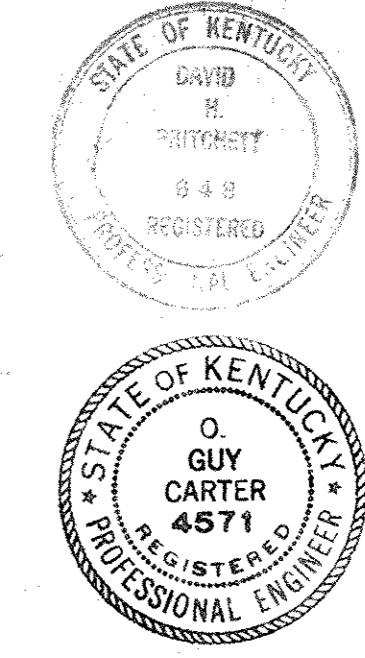

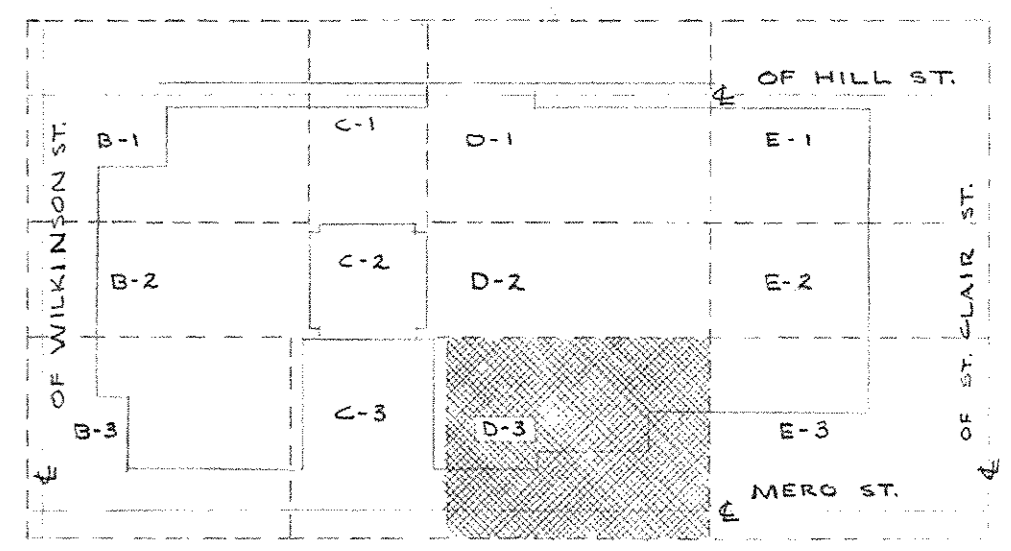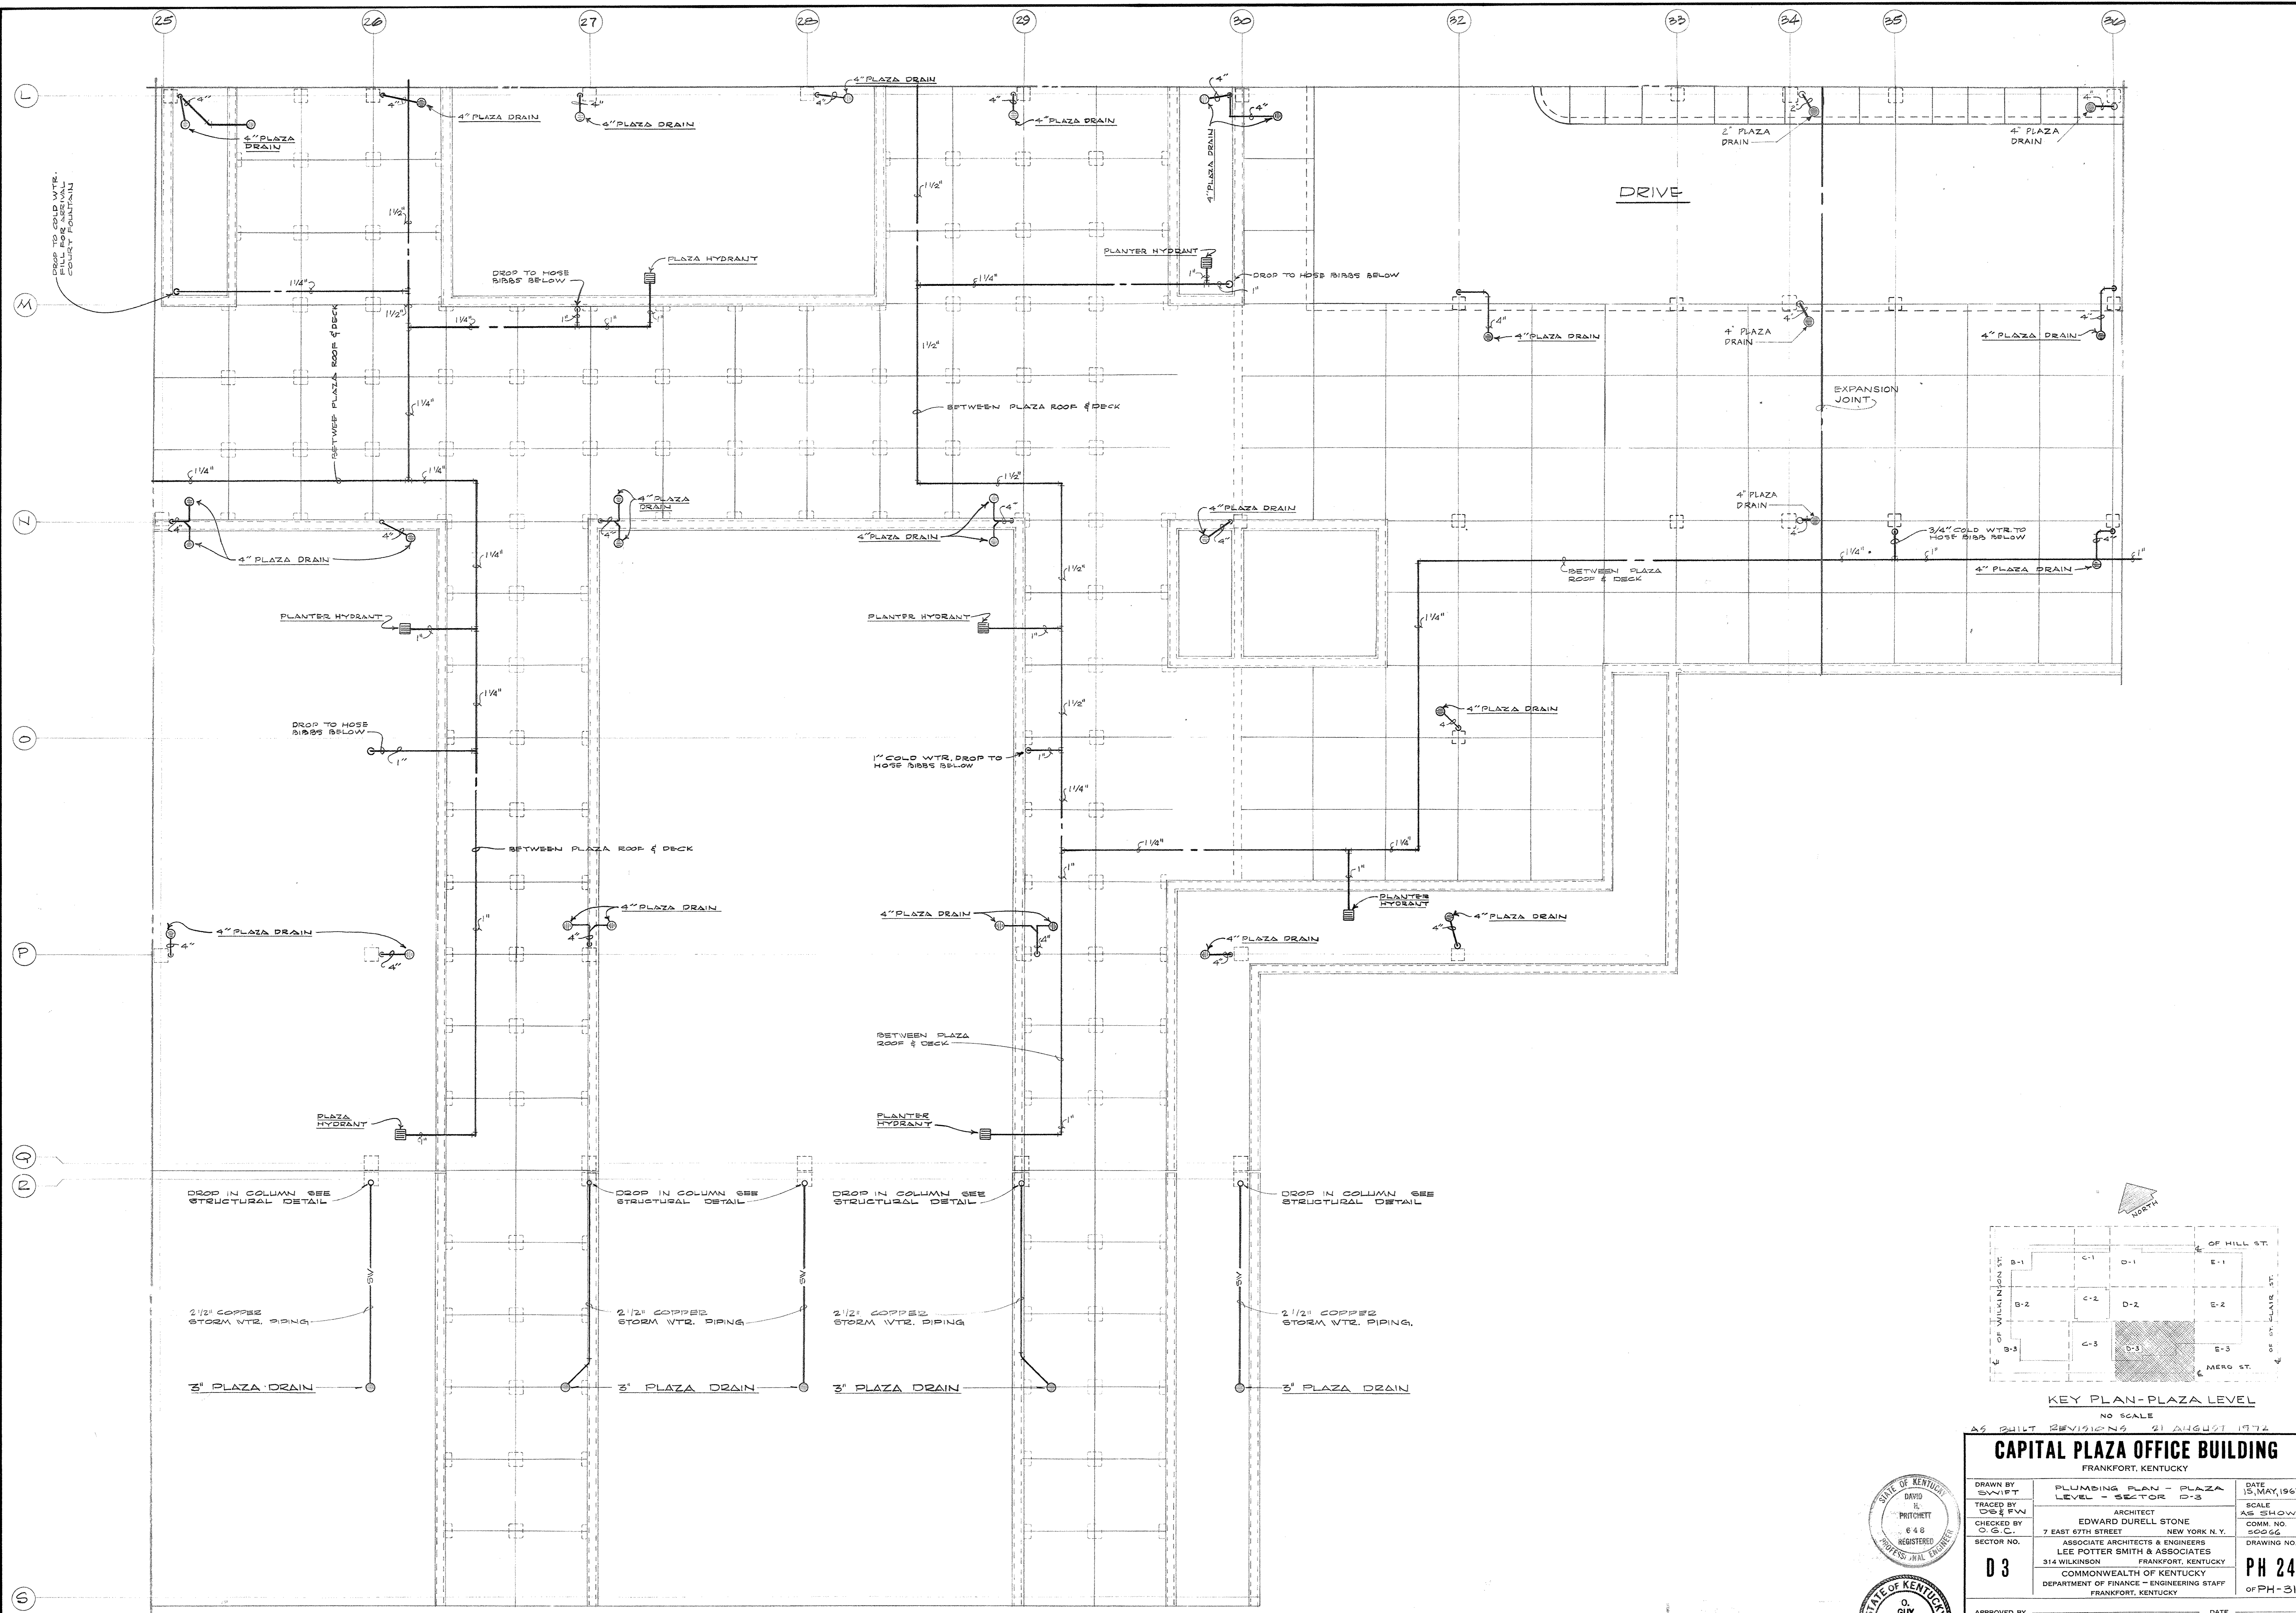


KEY PLAN - PLAZA LEVEL
NO SCALE


PLUMBING PLAN - PLAZA LEVEL - SECTOR D-3
SCALE: 1/8" = 1'-0"

AS BUILT REVISIONS 21 AUGUST 1972


CAPITAL PLAZA OFFICE BUILDING
FRANKFORT, KENTUCKY

DRAWN BY SWIFT TRACED BY DREFFEN CHECKED BY O.G.C.	PLUMBING PLAN - PLAZA LEVEL - SECTOR D-3 ARCHITECT EDWARD DURELL STONE 7 EAST 67TH STREET NEW YORK N.Y. ASSOCIATE ARCHITECTS & ENGINEERS LEE POTTER SMITH & ASSOCIATES 314 WILKINSON FRANKFORT, KENTUCKY COMMONWEALTH OF KENTUCKY DEPARTMENT OF FINANCE - ENGINEERING STAFF FRANKFORT, KENTUCKY	DATE 15 MAY 1967 SCALE AS SHOWN COMM. NO. 20066 DRAWING NO. PH 24 OF PH-31
APPROVED BY ARCHITECT APPROVED BY AGENCY HEAD APPROVED BY OWNER	DATE DATE MAY 24 1967	

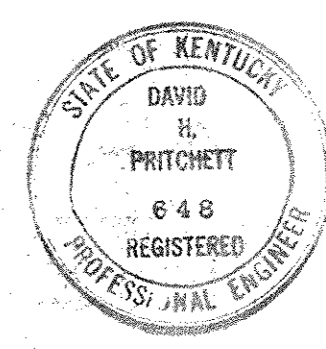


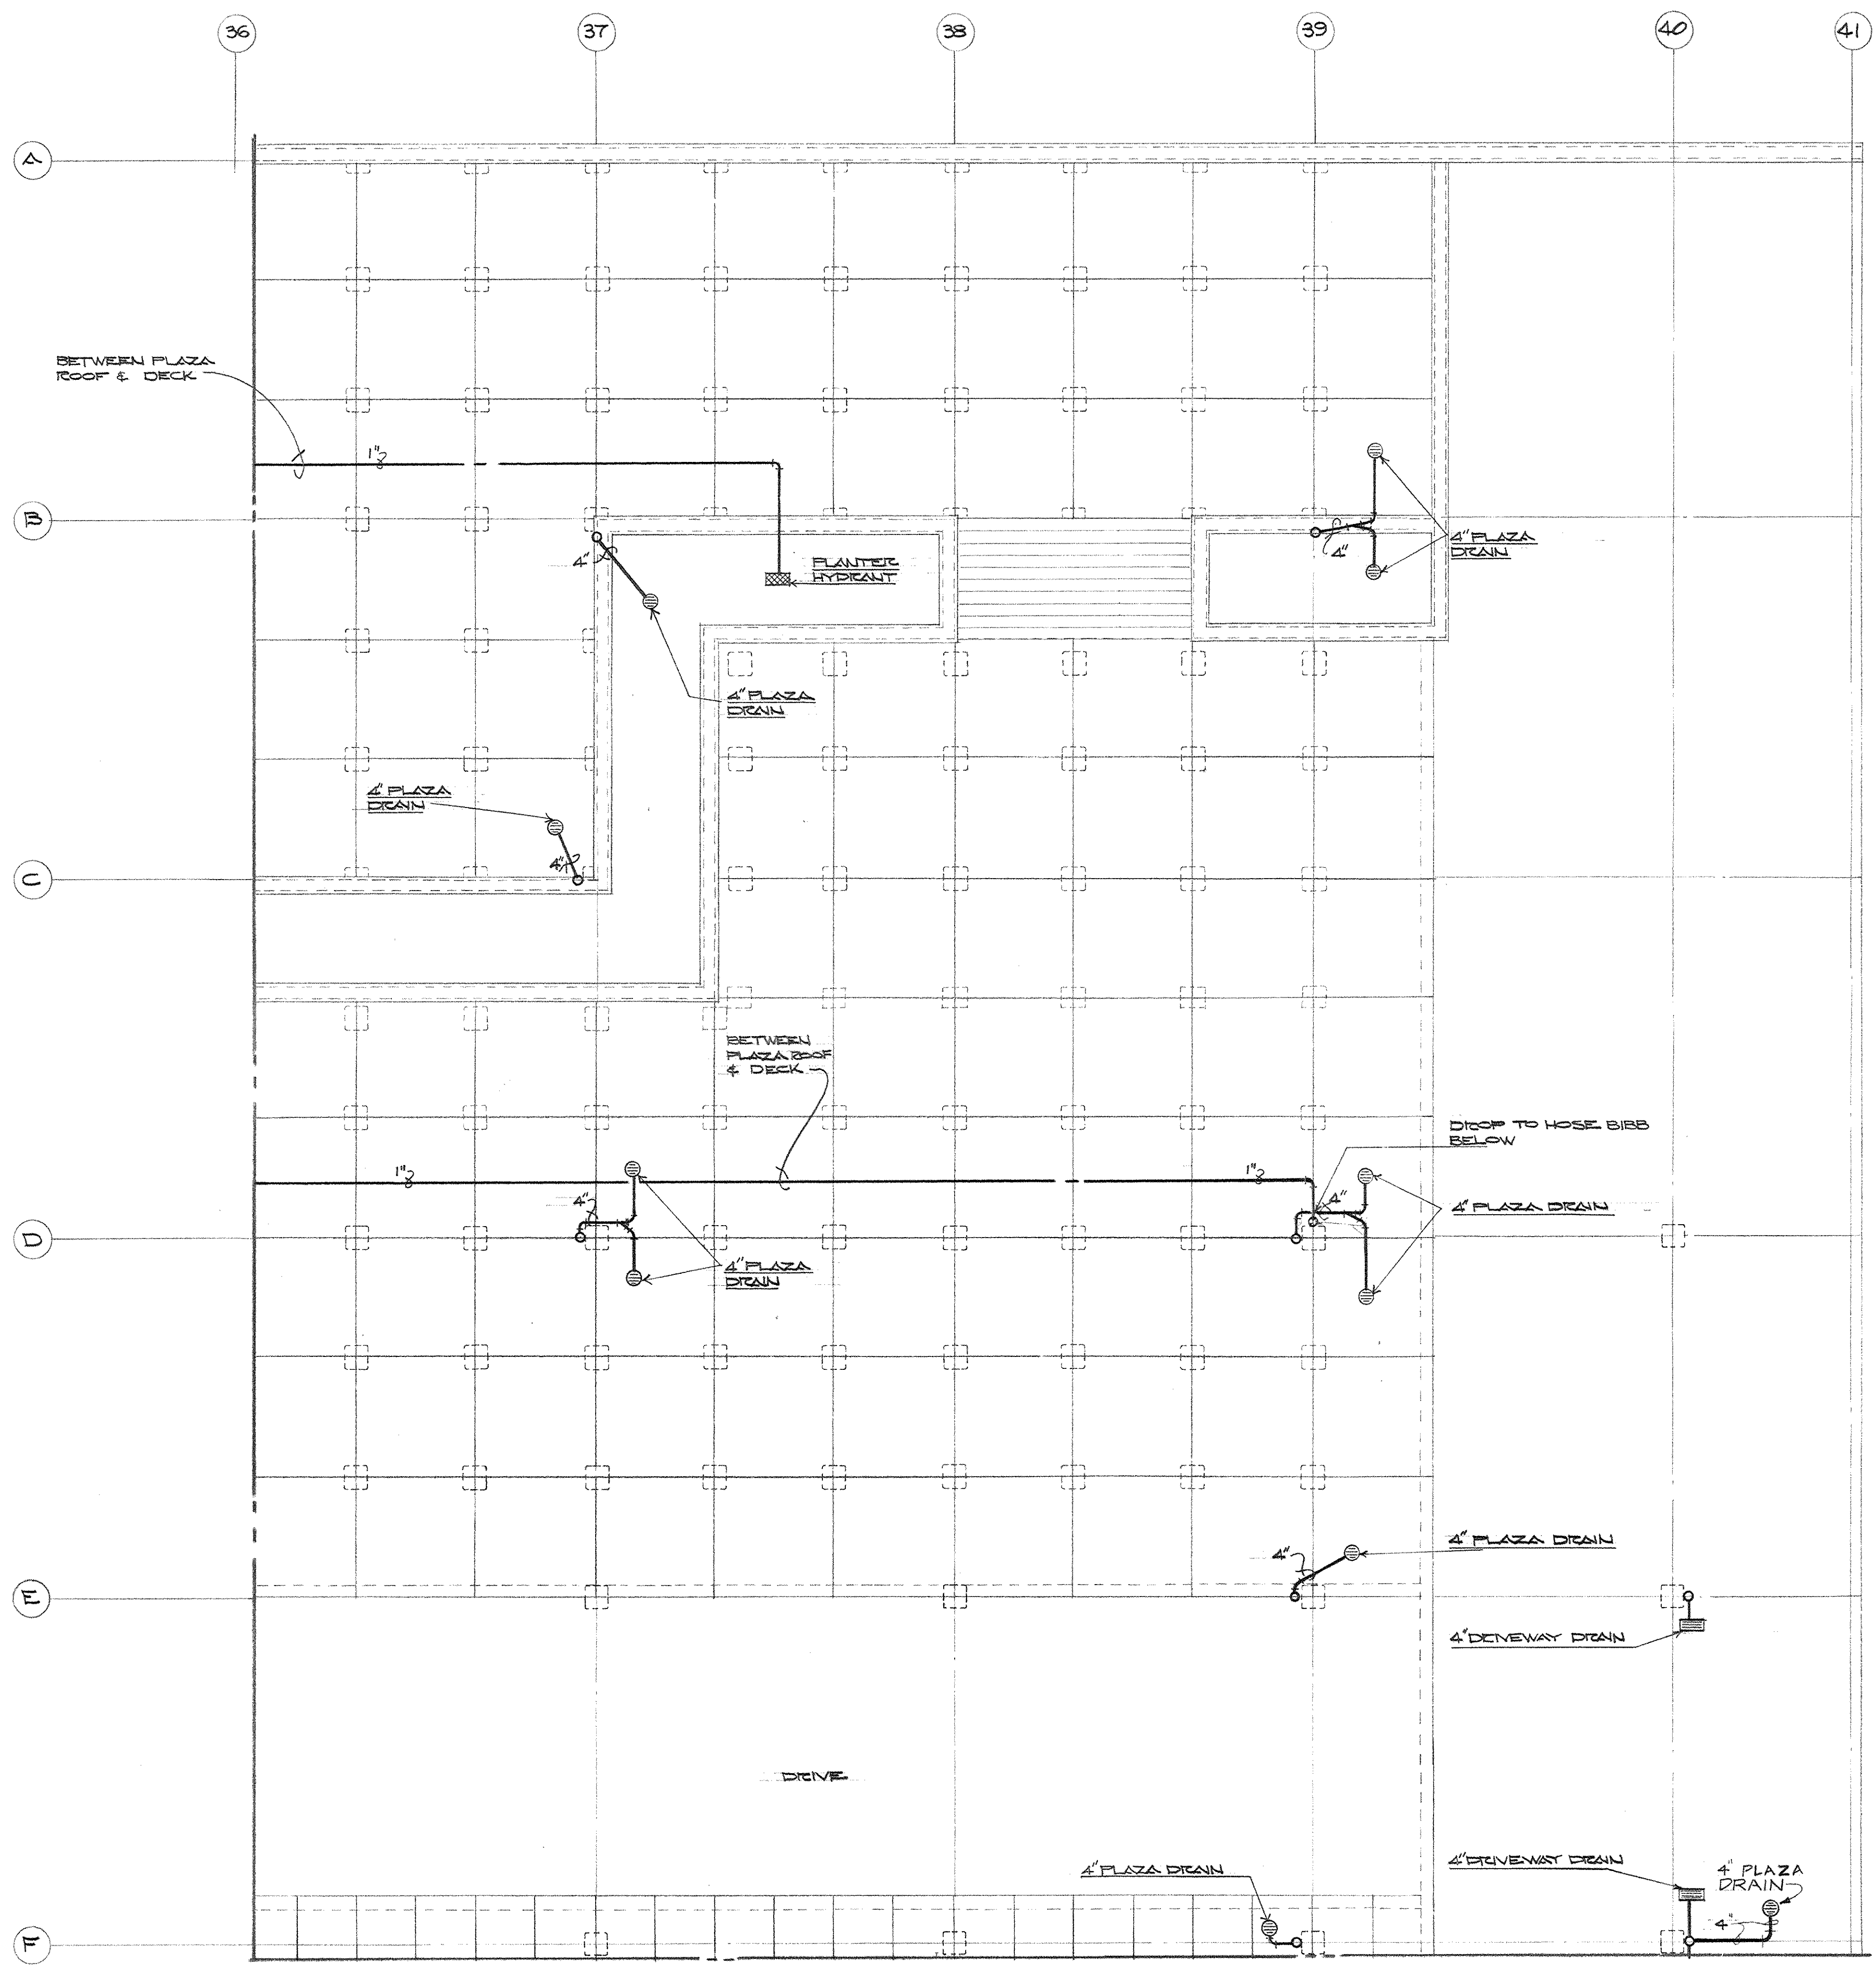


PLUMBING PLAN - PLAZA LEVEL - SECTOR E-1
SCALE: 1/8" = 1'-0"

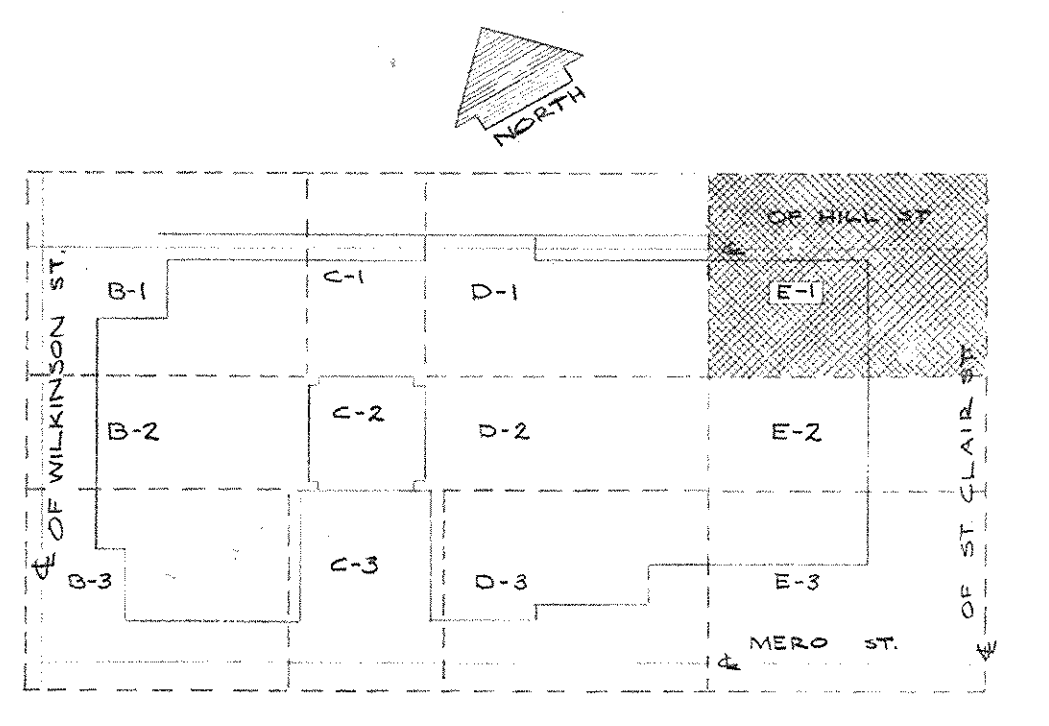


KEY PLAN - PLAZA LEVEL
NO SCALE

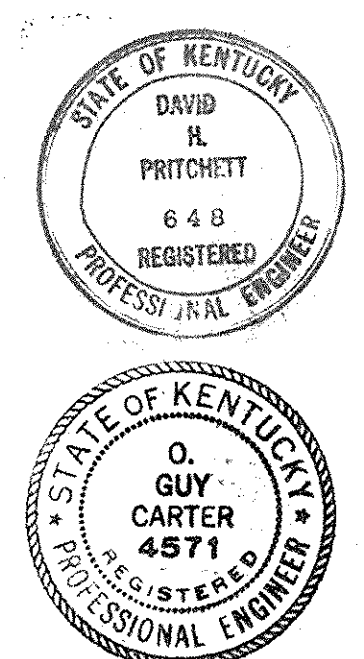


CAPITAL PLAZA OFFICE BUILDING FRANKFORT, KENTUCKY		
DRAWN BY D.H.	PLUMBING PLAN - PLAZA LEVEL - SECTOR - E-1	DATE 15, MAY, 1967
TRACED BY D.H.	ARCHITECT	SCALE 1/8" = 1'-0"
CHECKED BY S.S.	EDWARD DURELL STONE 7 EAST 67TH STREET NEW YORK, N.Y.	COMM. NO. 600660
SECTOR NO. E 1	ASSOCIATE ARCHITECTS & ENGINEERS LEE POTTER SMITH & ASSOCIATES 314 WILKINSON FRANKFORT, KENTUCKY	DRAWING NO. PH 25 OF PH-31
APPROVED BY	ARCHITECT	DATE
APPROVED BY	AGENCY HEAD	DATE
APPROVED BY	OWNER	DATE MAY 24 1967

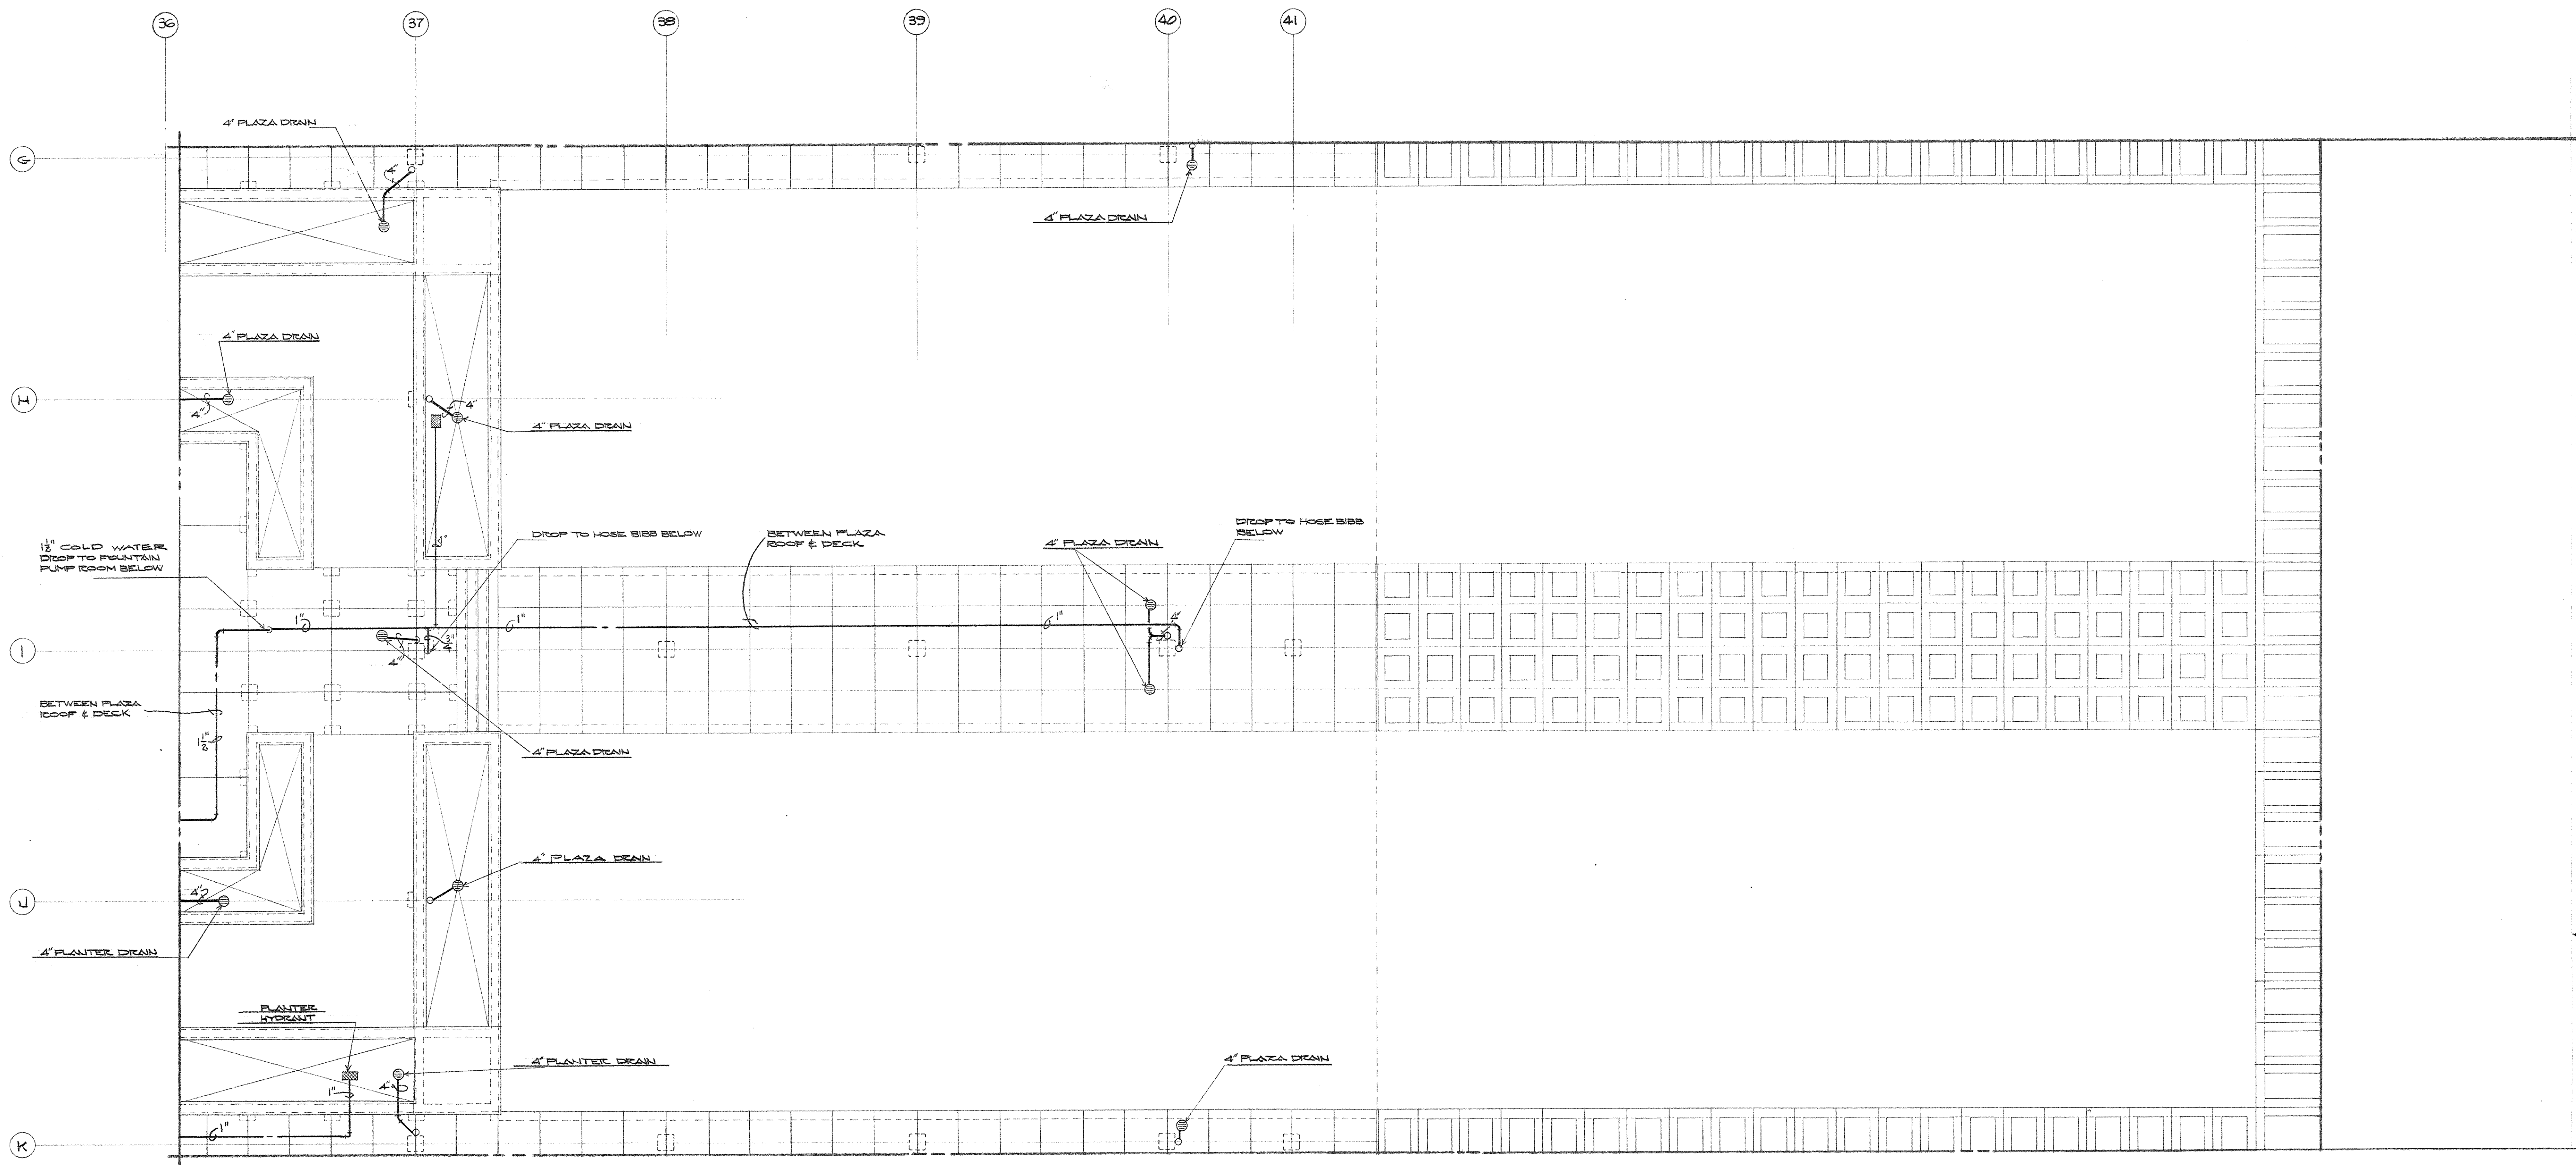


PLUMBING PLAN - PLAZA LEVEL - SECTOR E-2
SCALE: 1/8" = 1'-0"

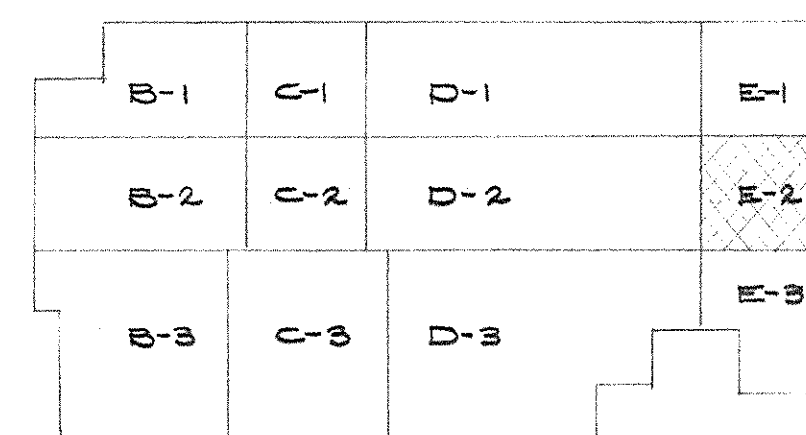


KEY PLAN
NO SCALE

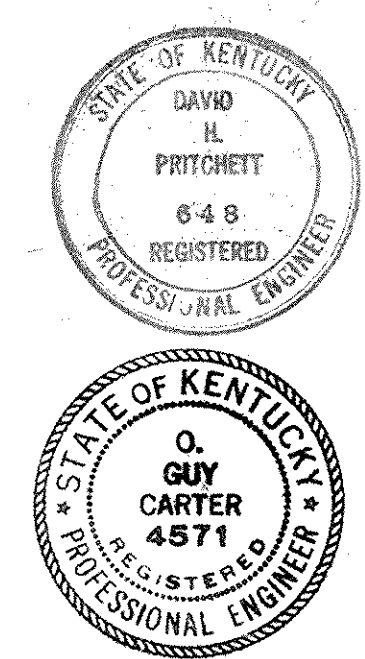



CAPITAL PLAZA OFFICE BUILDING			
FRANKFORT, KENTUCKY			
DRAWN BY SWIFT	PLUMBING PLAN - PLAZA LEVEL - SECTOR E-2	DATE 15 MAY 1967	
TRACED BY D.S. SW	ARCHITECT	SCALE 1/8" = 1'-0"	
CHECKED BY O.G.C.	EDWARD DURELL STONE 7 EAST 67TH STREET NEW YORK N.Y.	CONTR. NO. 50000	
SECTOR NO. E 2	ASSOCIATE ARCHITECTS & ENGINEERS LEE POTTER SMITH & ASSOCIATES 314 WILKINSON FRANKFORT, KENTUCKY	DRAWING NO. PH 26	
	COMMONWEALTH OF KENTUCKY DEPARTMENT OF FINANCE - ENGINEERING STAFF FRANKFORT, KENTUCKY	OF PH - 31	
APPROVED BY	ARCHITECT	DATE	
APPROVED BY	AGENCY HEAD	DATE	JULY 24 1967
APPROVED BY	OWNER	DATE	

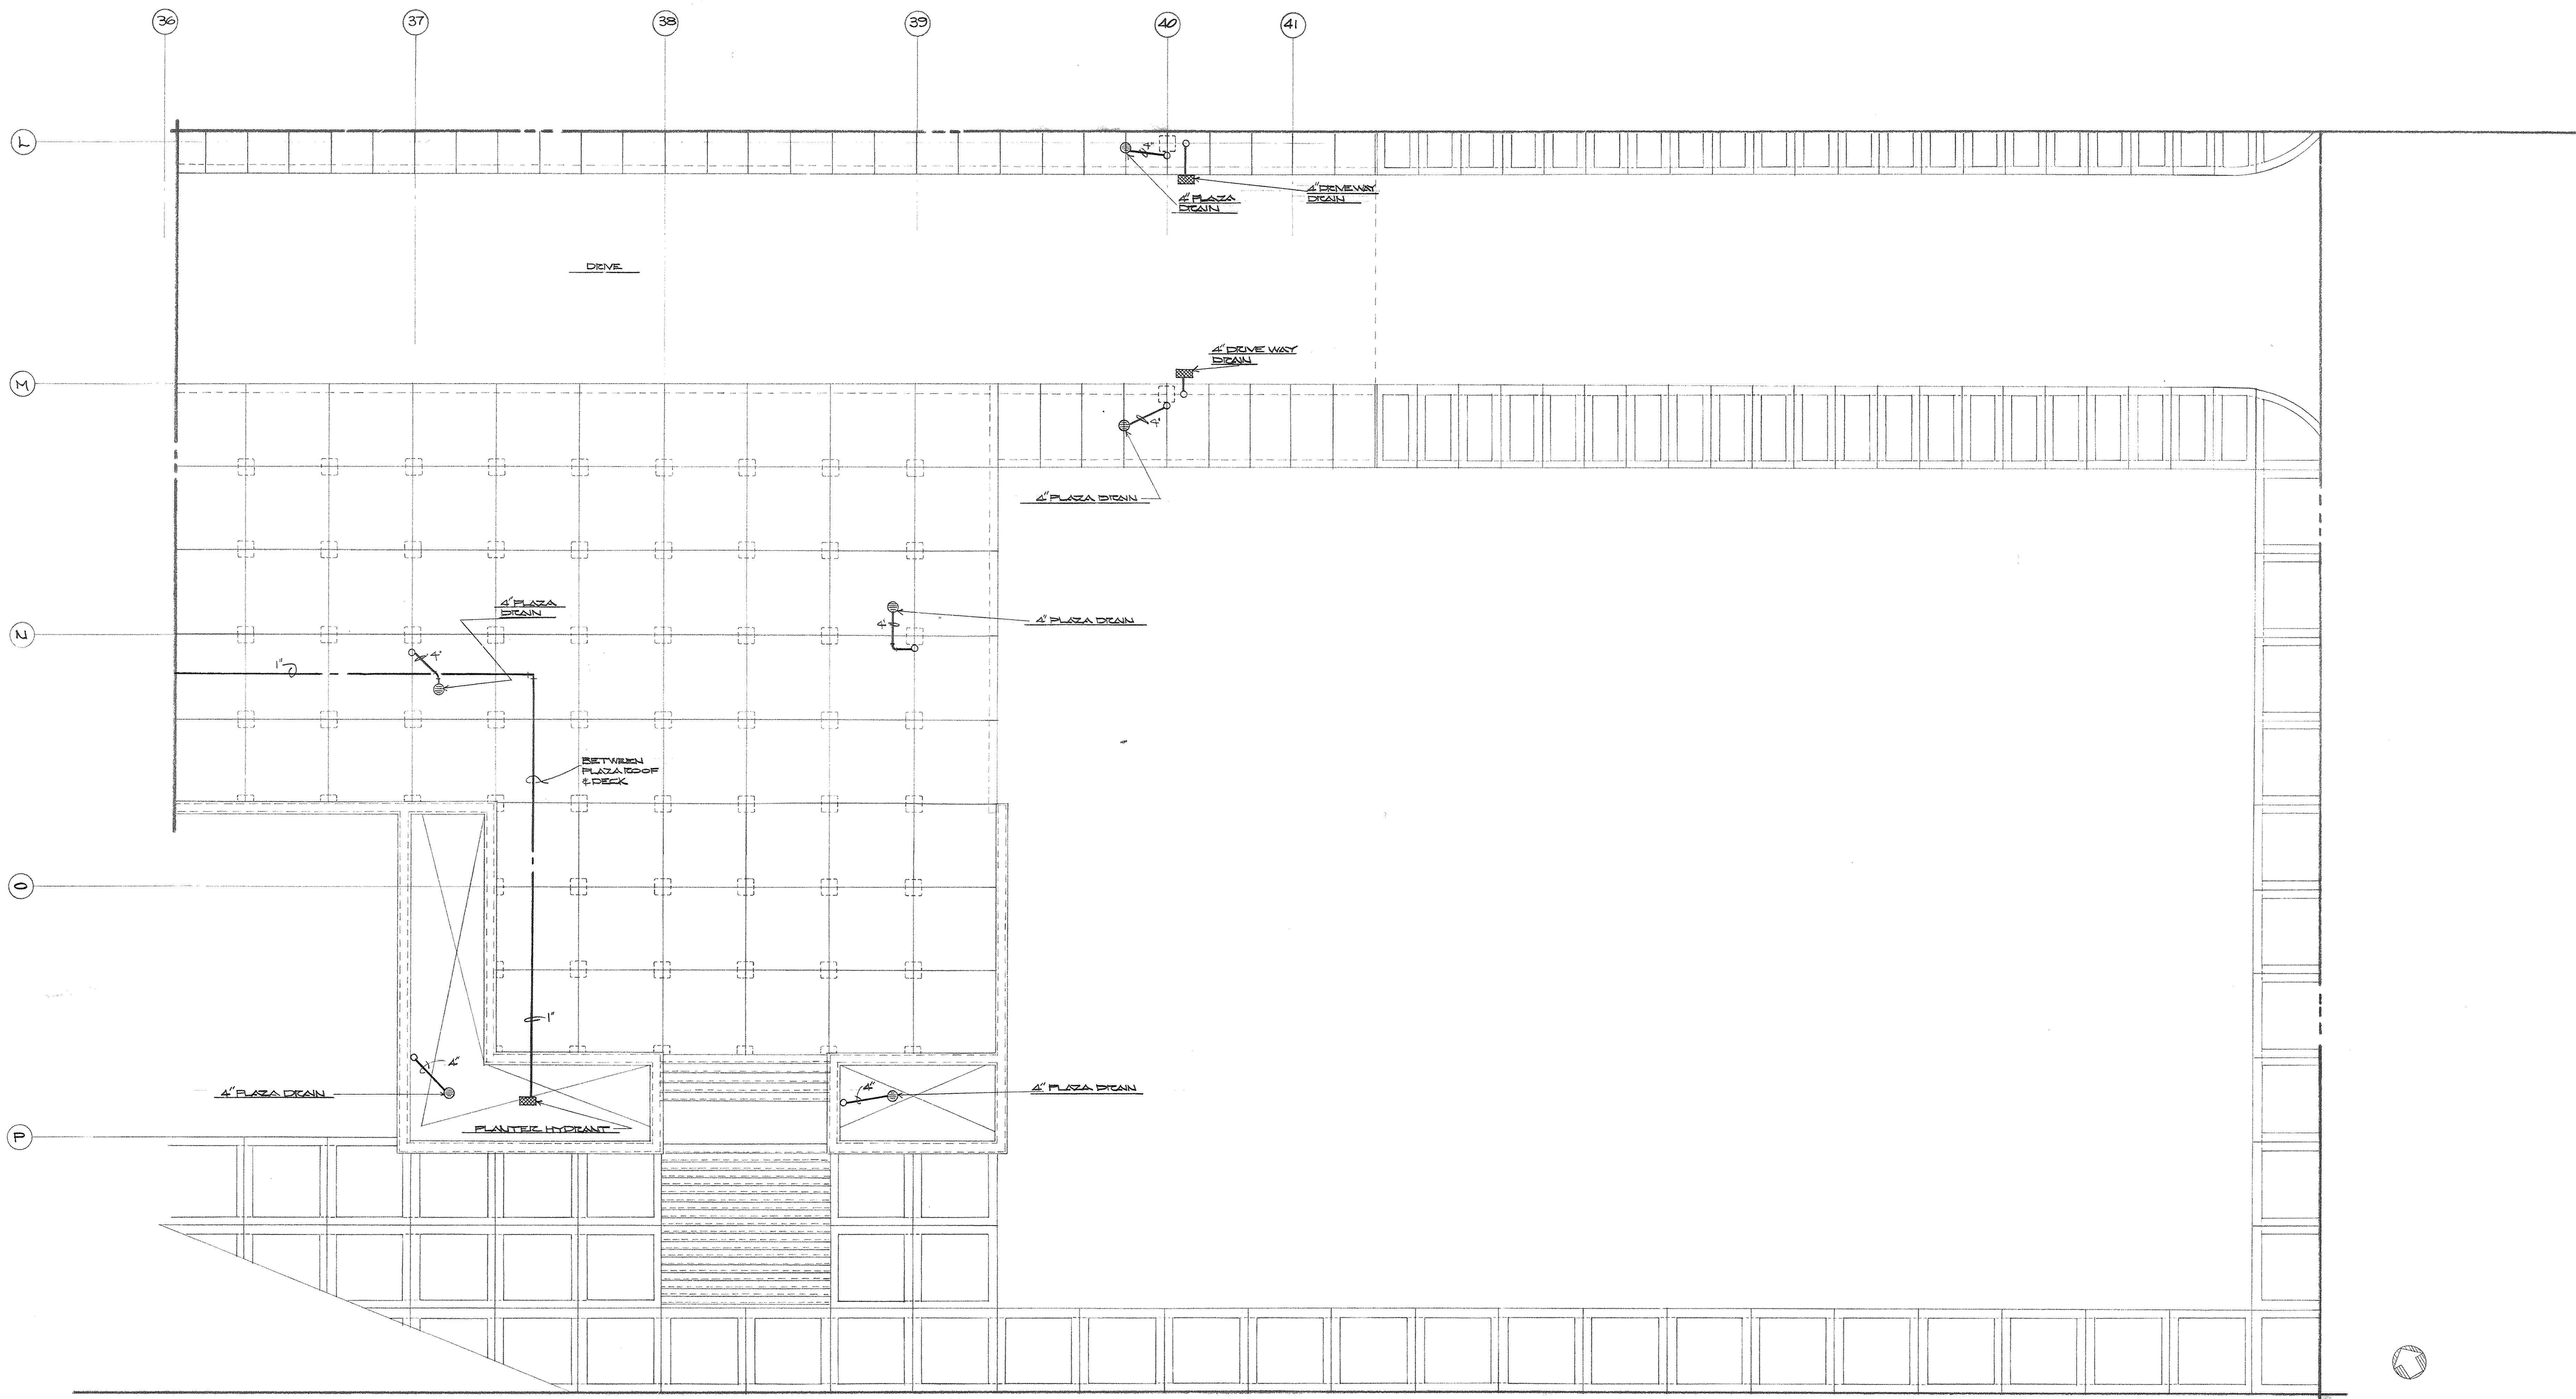

PLUMBING PLAN - PLAZA LEVEL - SECTOR E-3
SCALE 1/8" = 1'-0"

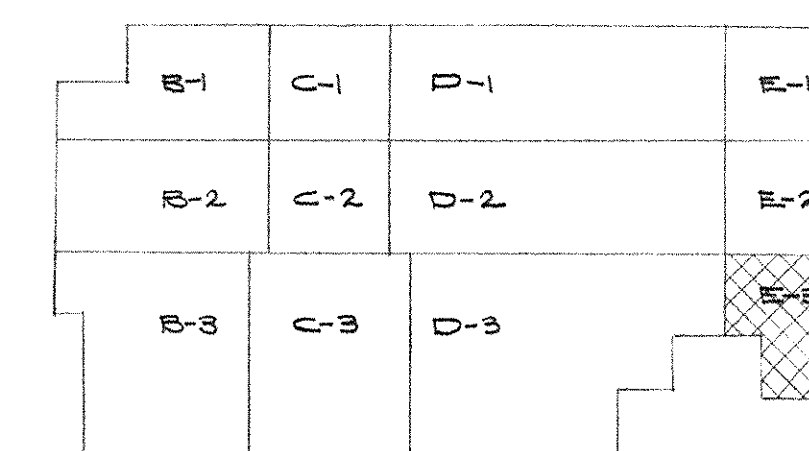


KEY PLAN
1/8" SCALE

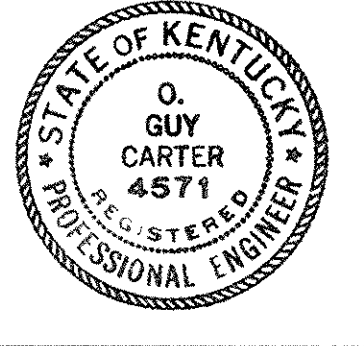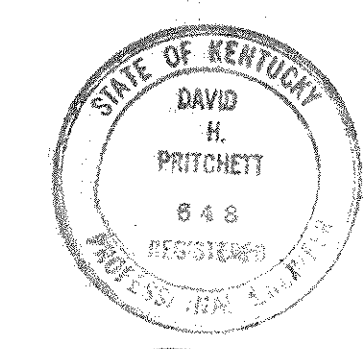

CAPITAL PLAZA OFFICE BUILDING FRANKFORT, KENTUCKY		
DRAWN BY SMIFT	PLUMBING PLAN - PLAZA LEVEL - SECTOR E-3	DATE 15, MAY, 1967
TRACED BY BOW	ARCHITECT EDWARD DURELL STONE	SCALE 1/8" = 1'-0"
CHECKED BY D & C	7 EAST 67TH STREET NEW YORK, N. Y.	COMM. NO. 50006
SECTOR NO. E 3	ASSOCIATE ARCHITECTS & ENGINEERS LEE POTTER SMITH & ASSOCIATES 314 WILKINSON FRANKFORT, KENTUCKY	DRAWING NO. PH 27
APPROVED BY ARCHITECT	DATE	of PH-31
APPROVED BY AGENCY HEAD	DATE	MAY 24 1967
APPROVED BY OWNER	DATE	

NOTES:
 1. FOR CONTINUATION OF PIPING REFER TO 1/8" SCALE PLAN SECTION C-3, SHEET PH-4

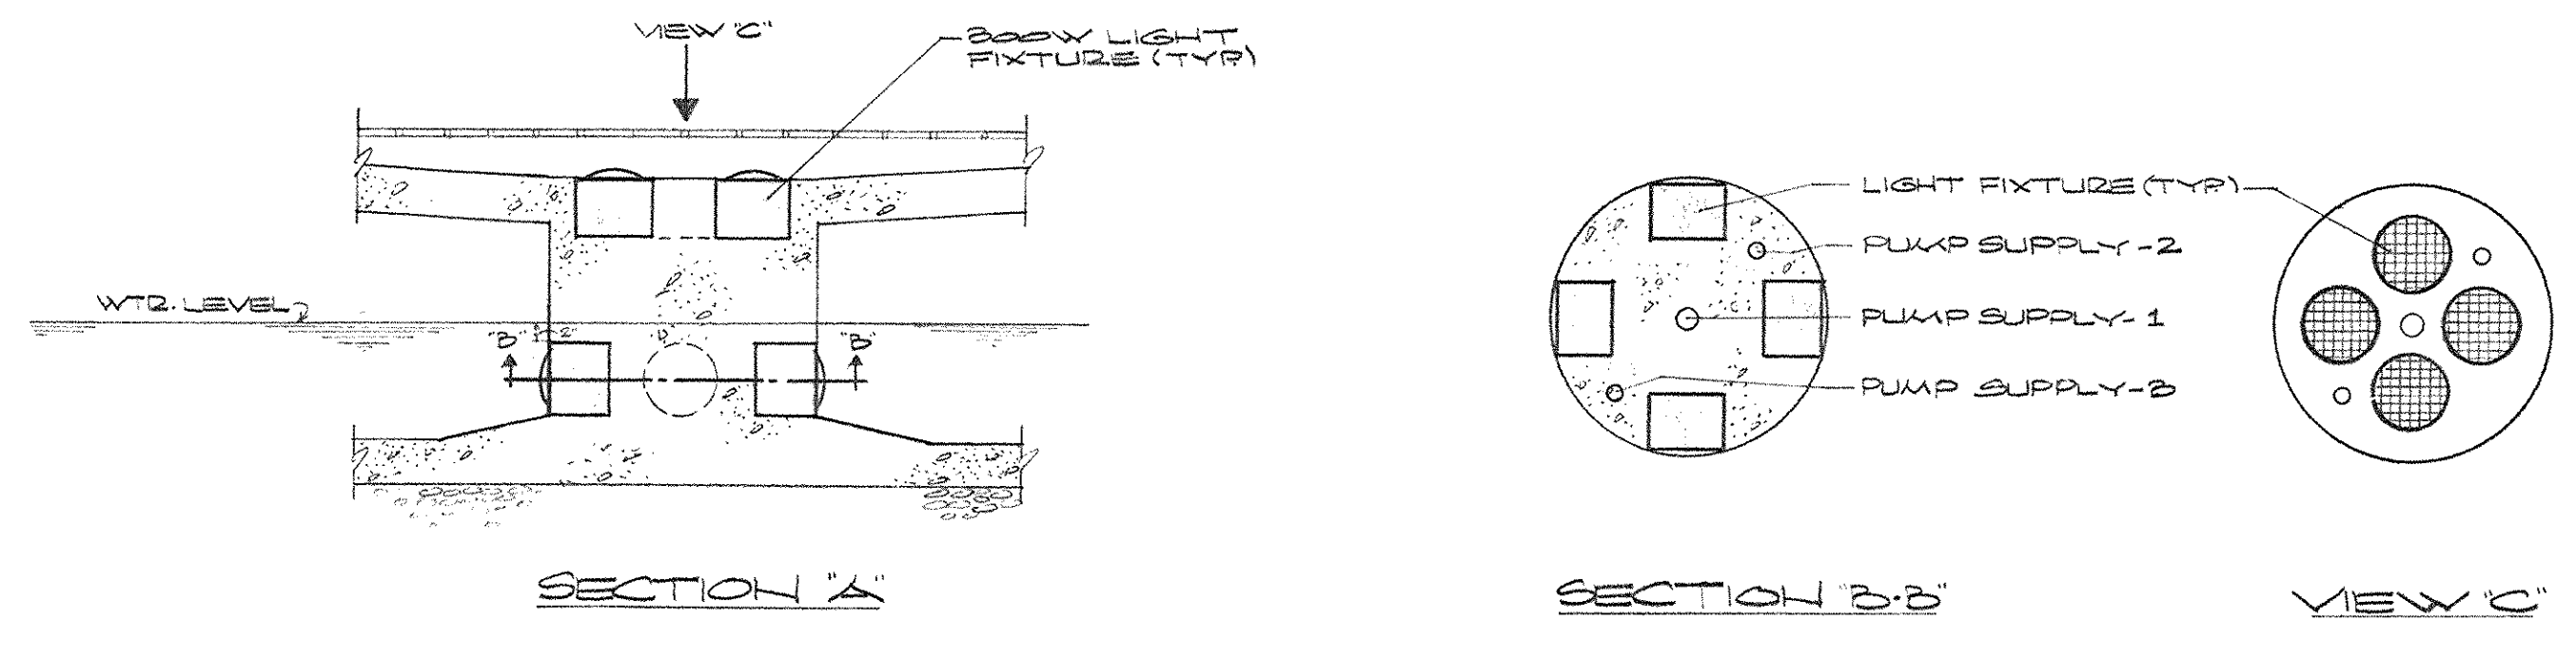


LIGHT FIXTURE INSTALLATION AT COLUMN
 SCALE: 1/2" = 1'-0"

FOUNTAIN PIPING LEGEND


- PS-1 PUMP SUPPLY-1 (TO 3" SMOOTH BORE NOZZLE)
- PS-2 PUMP SUPPLY-2 (TO 4" DIA SPRAY RING)
- PS-3 PUMP SUPPLY-3 (TO 2" DIA SPRAY RING)
- PS-4 PUMP SUPPLY-4 (TO AIRATED BUBBLERS)
- P2 PUMP RETURN
- F2 FILTERED SUPPLY
- F3 FILTERED RETURN
- VAC VACUUM PIPING
- CW COLD WATER FILL PIPING

GENERAL NOTES:



1. FILTERED SUPPLY SYSTEM OUTLETS SHALL BE REGULATED TO 3.4 SPIN EACH.
2. FILTERED SUPPLY OUTLETS, VACUUM FITTINGS & VTR FILL PIST SHALL BE AT 0' BELOW VTR LEVEL.
3. ALL PIPING (EXCEPT SPRAY RINGS) SHALL BE PITCHED TO DRAIN TOWARD PUMP ROOM.

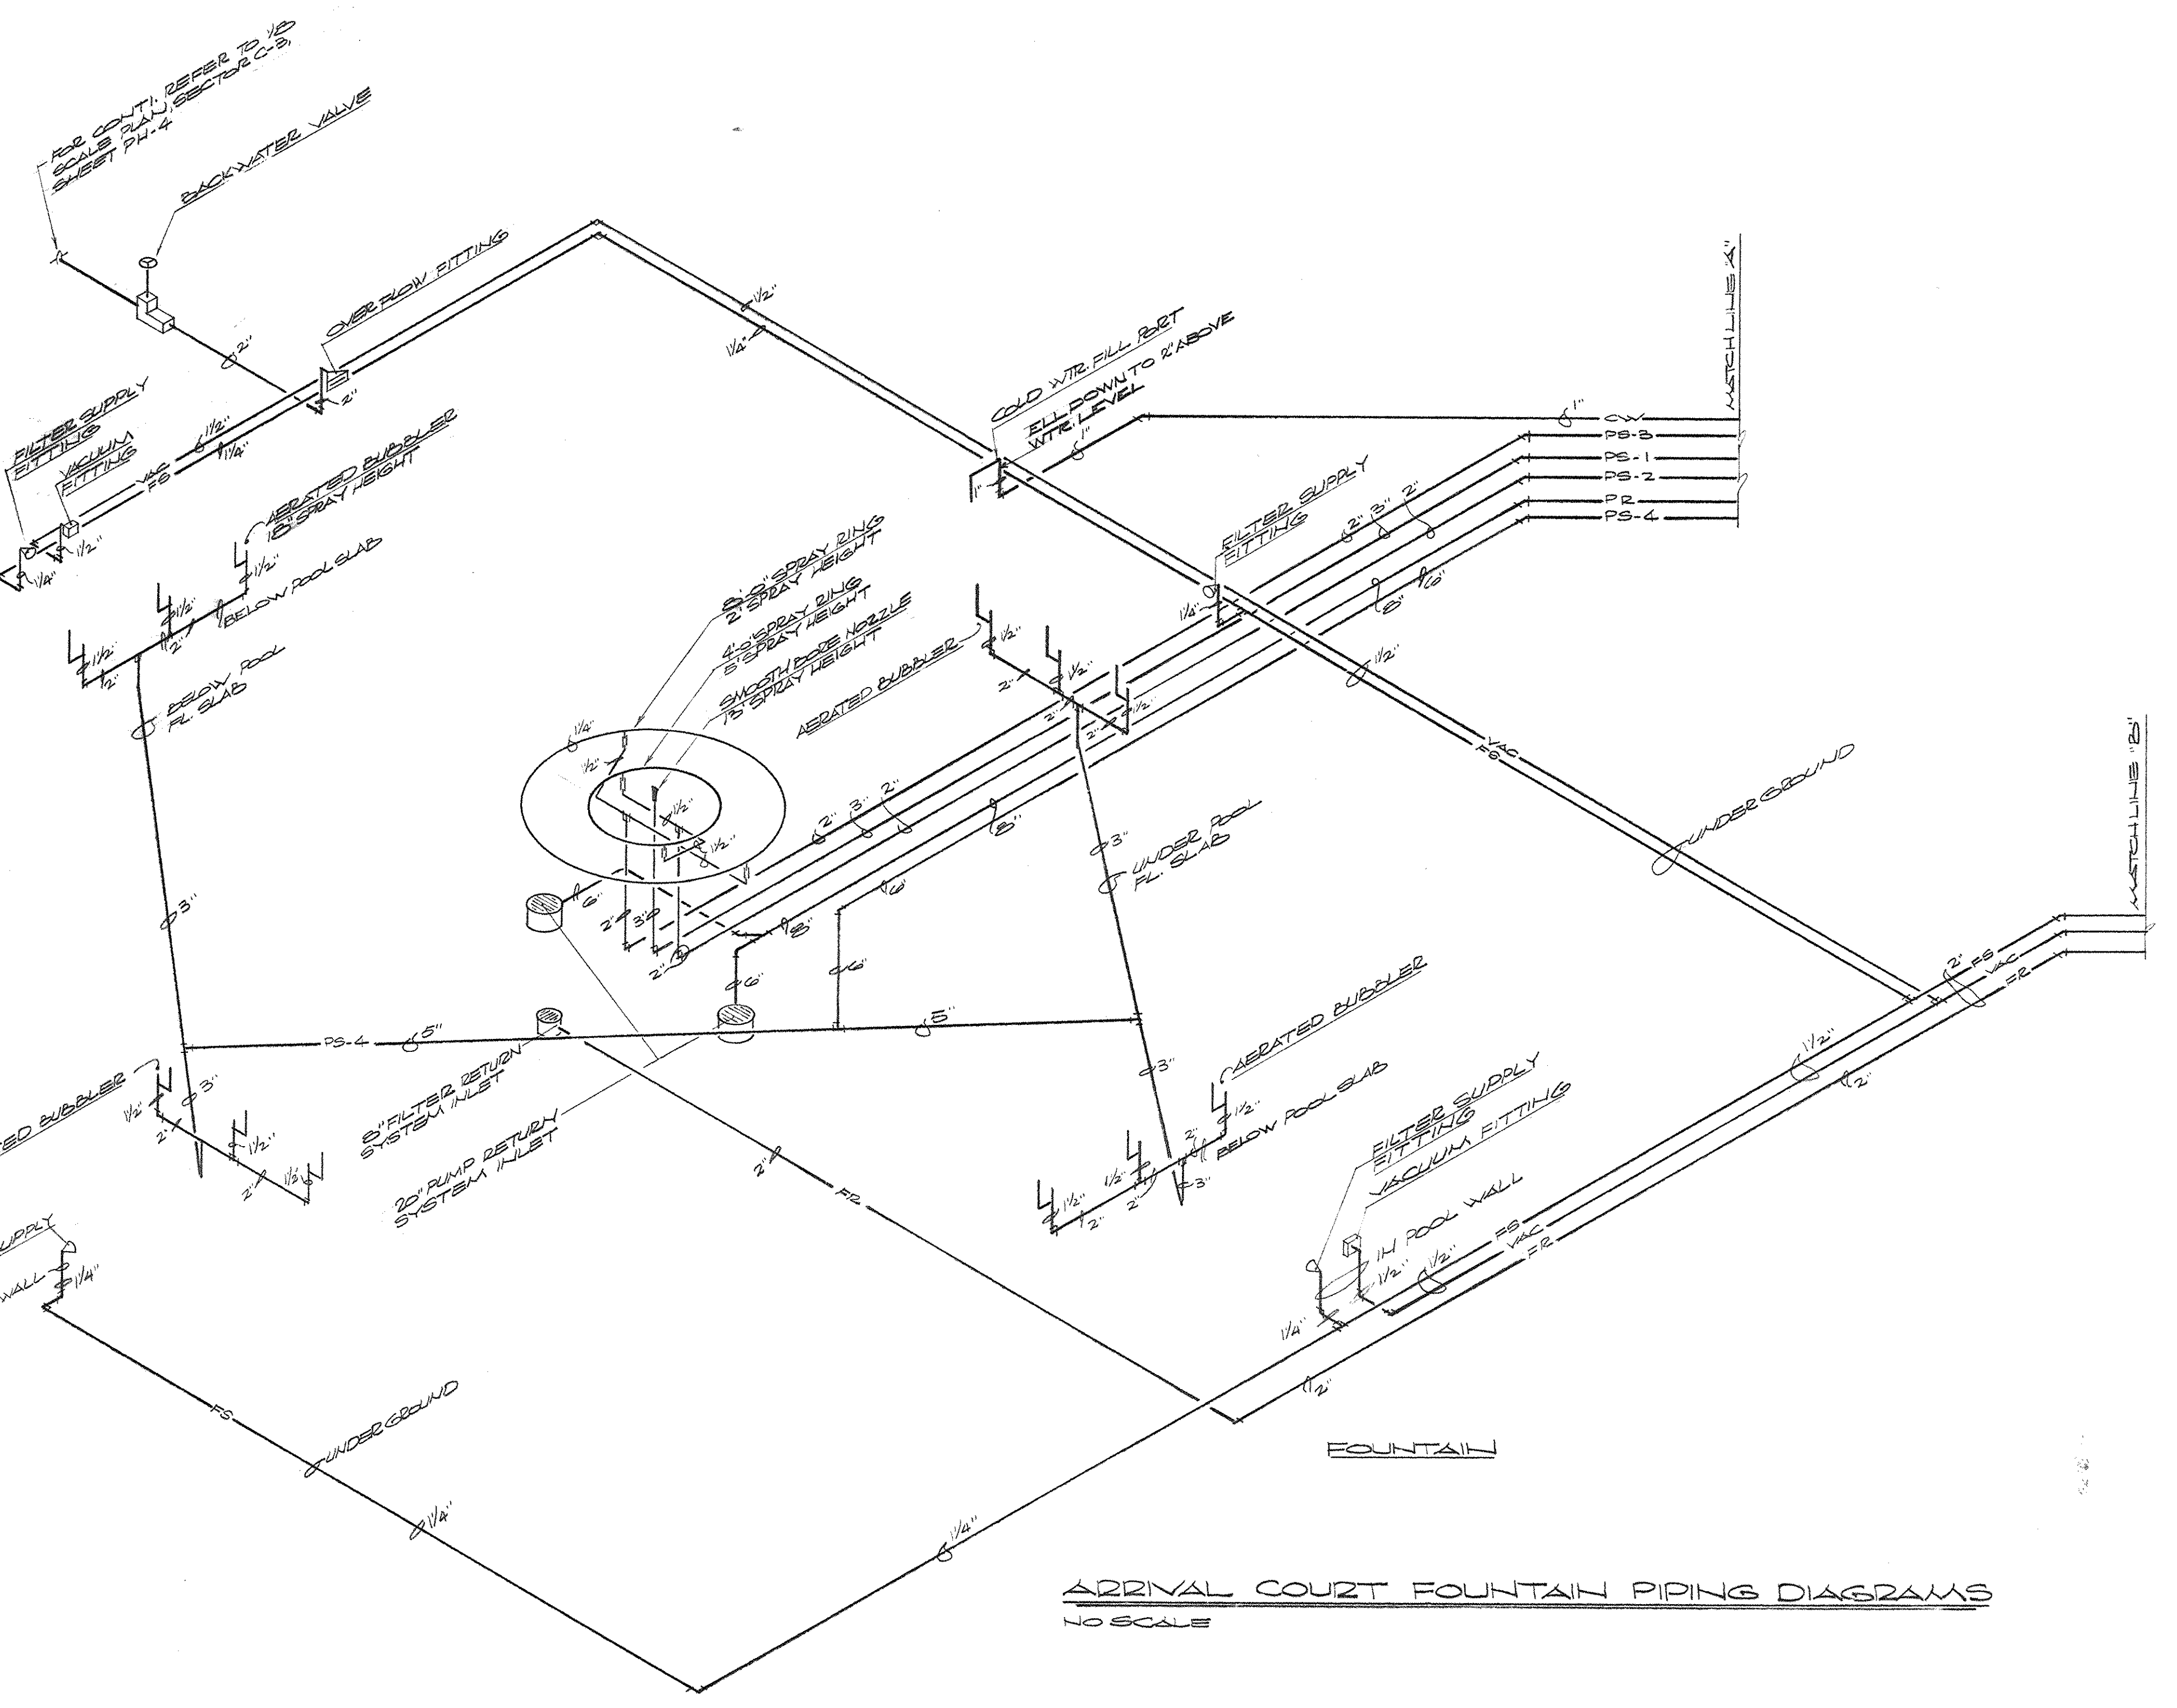

ARRIVAL COURT FOUNTAIN PIPING DIAGRAMS
 NO SCALE

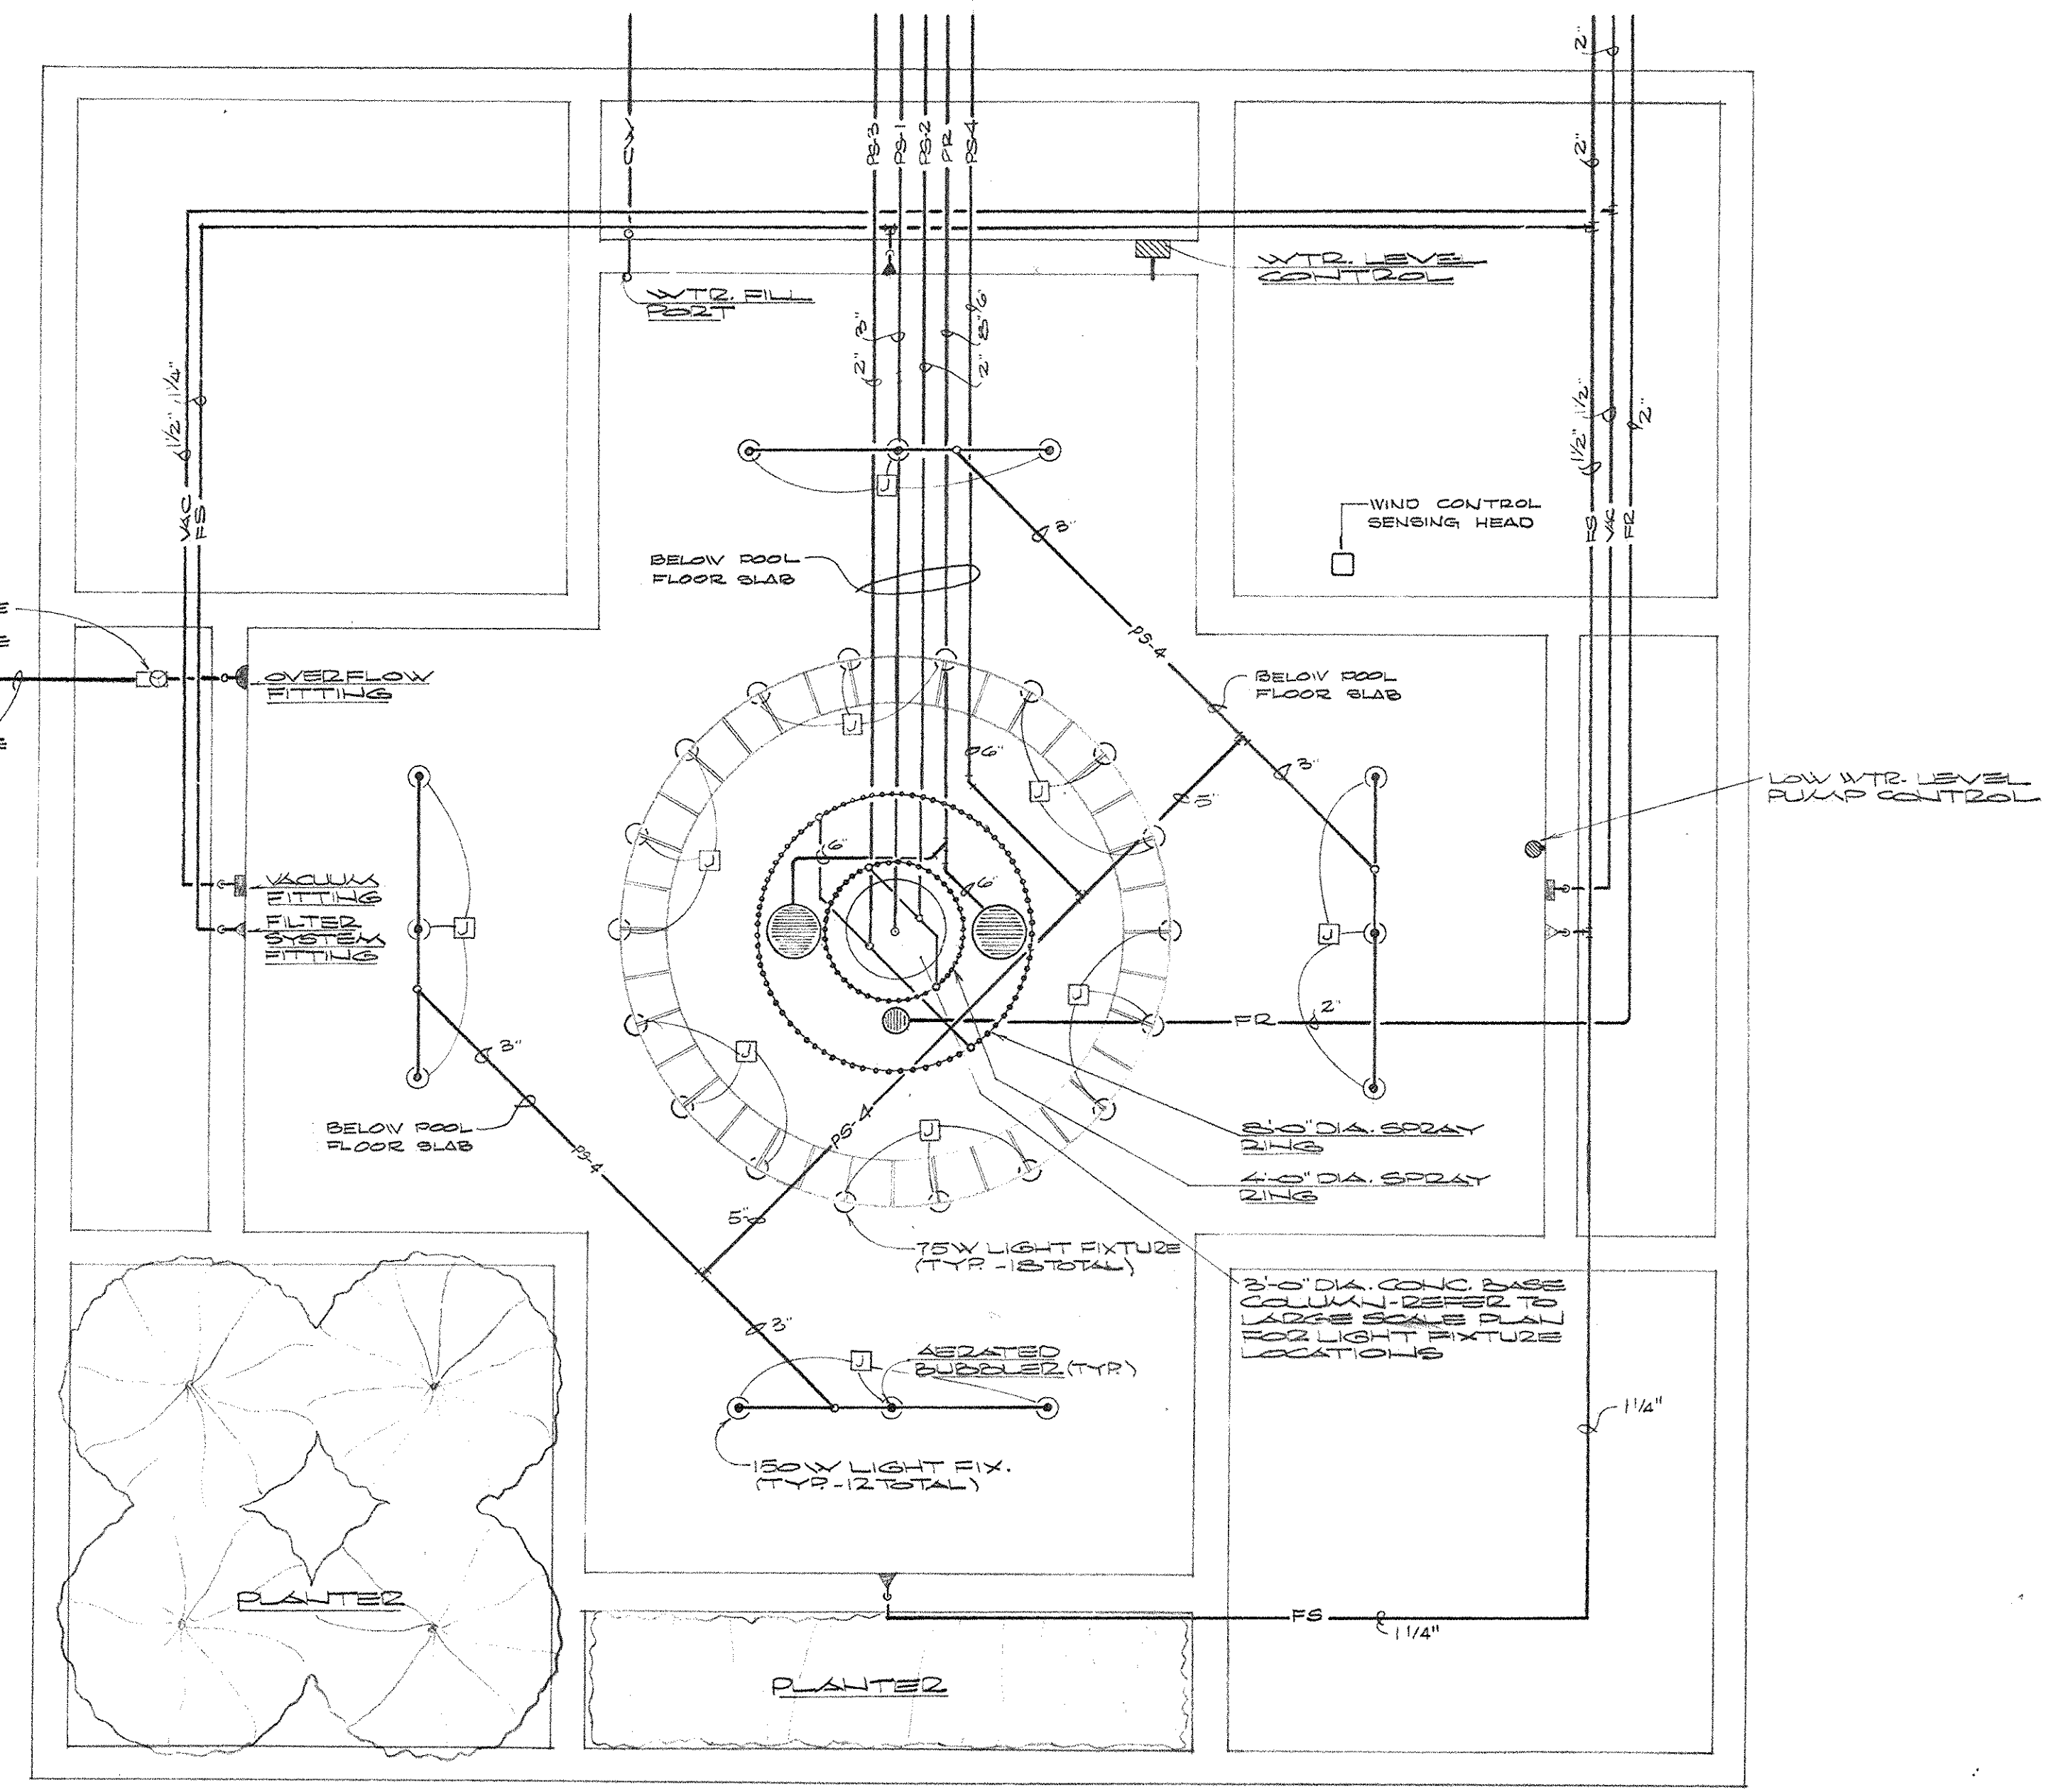

ARRIVAL COURT FOUNTAIN PLAN
 SCALE: 1/4" = 1'-0"

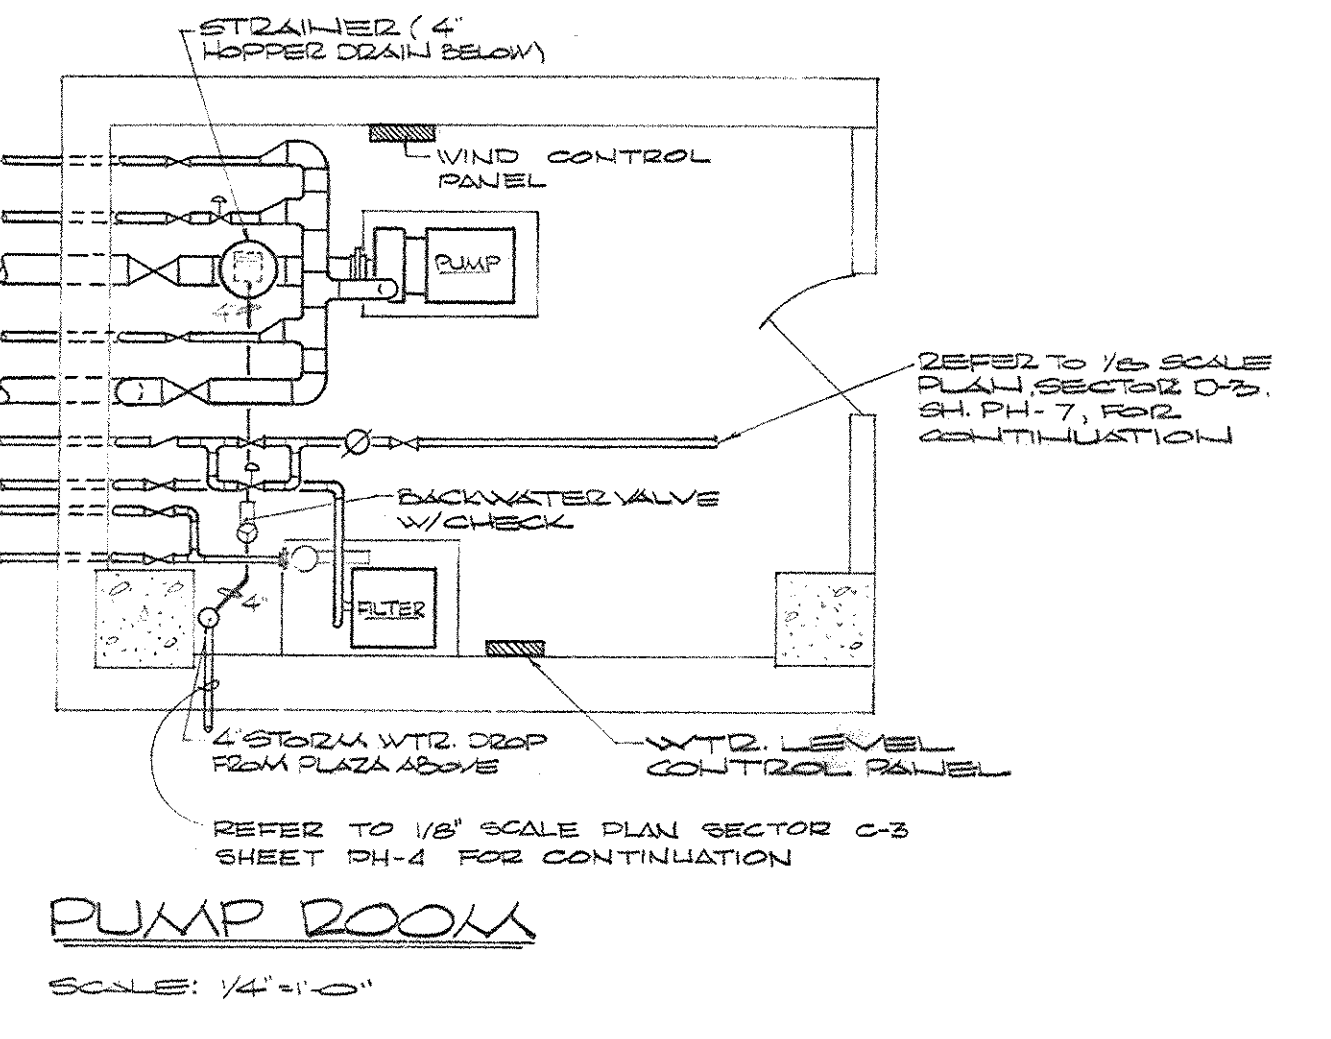
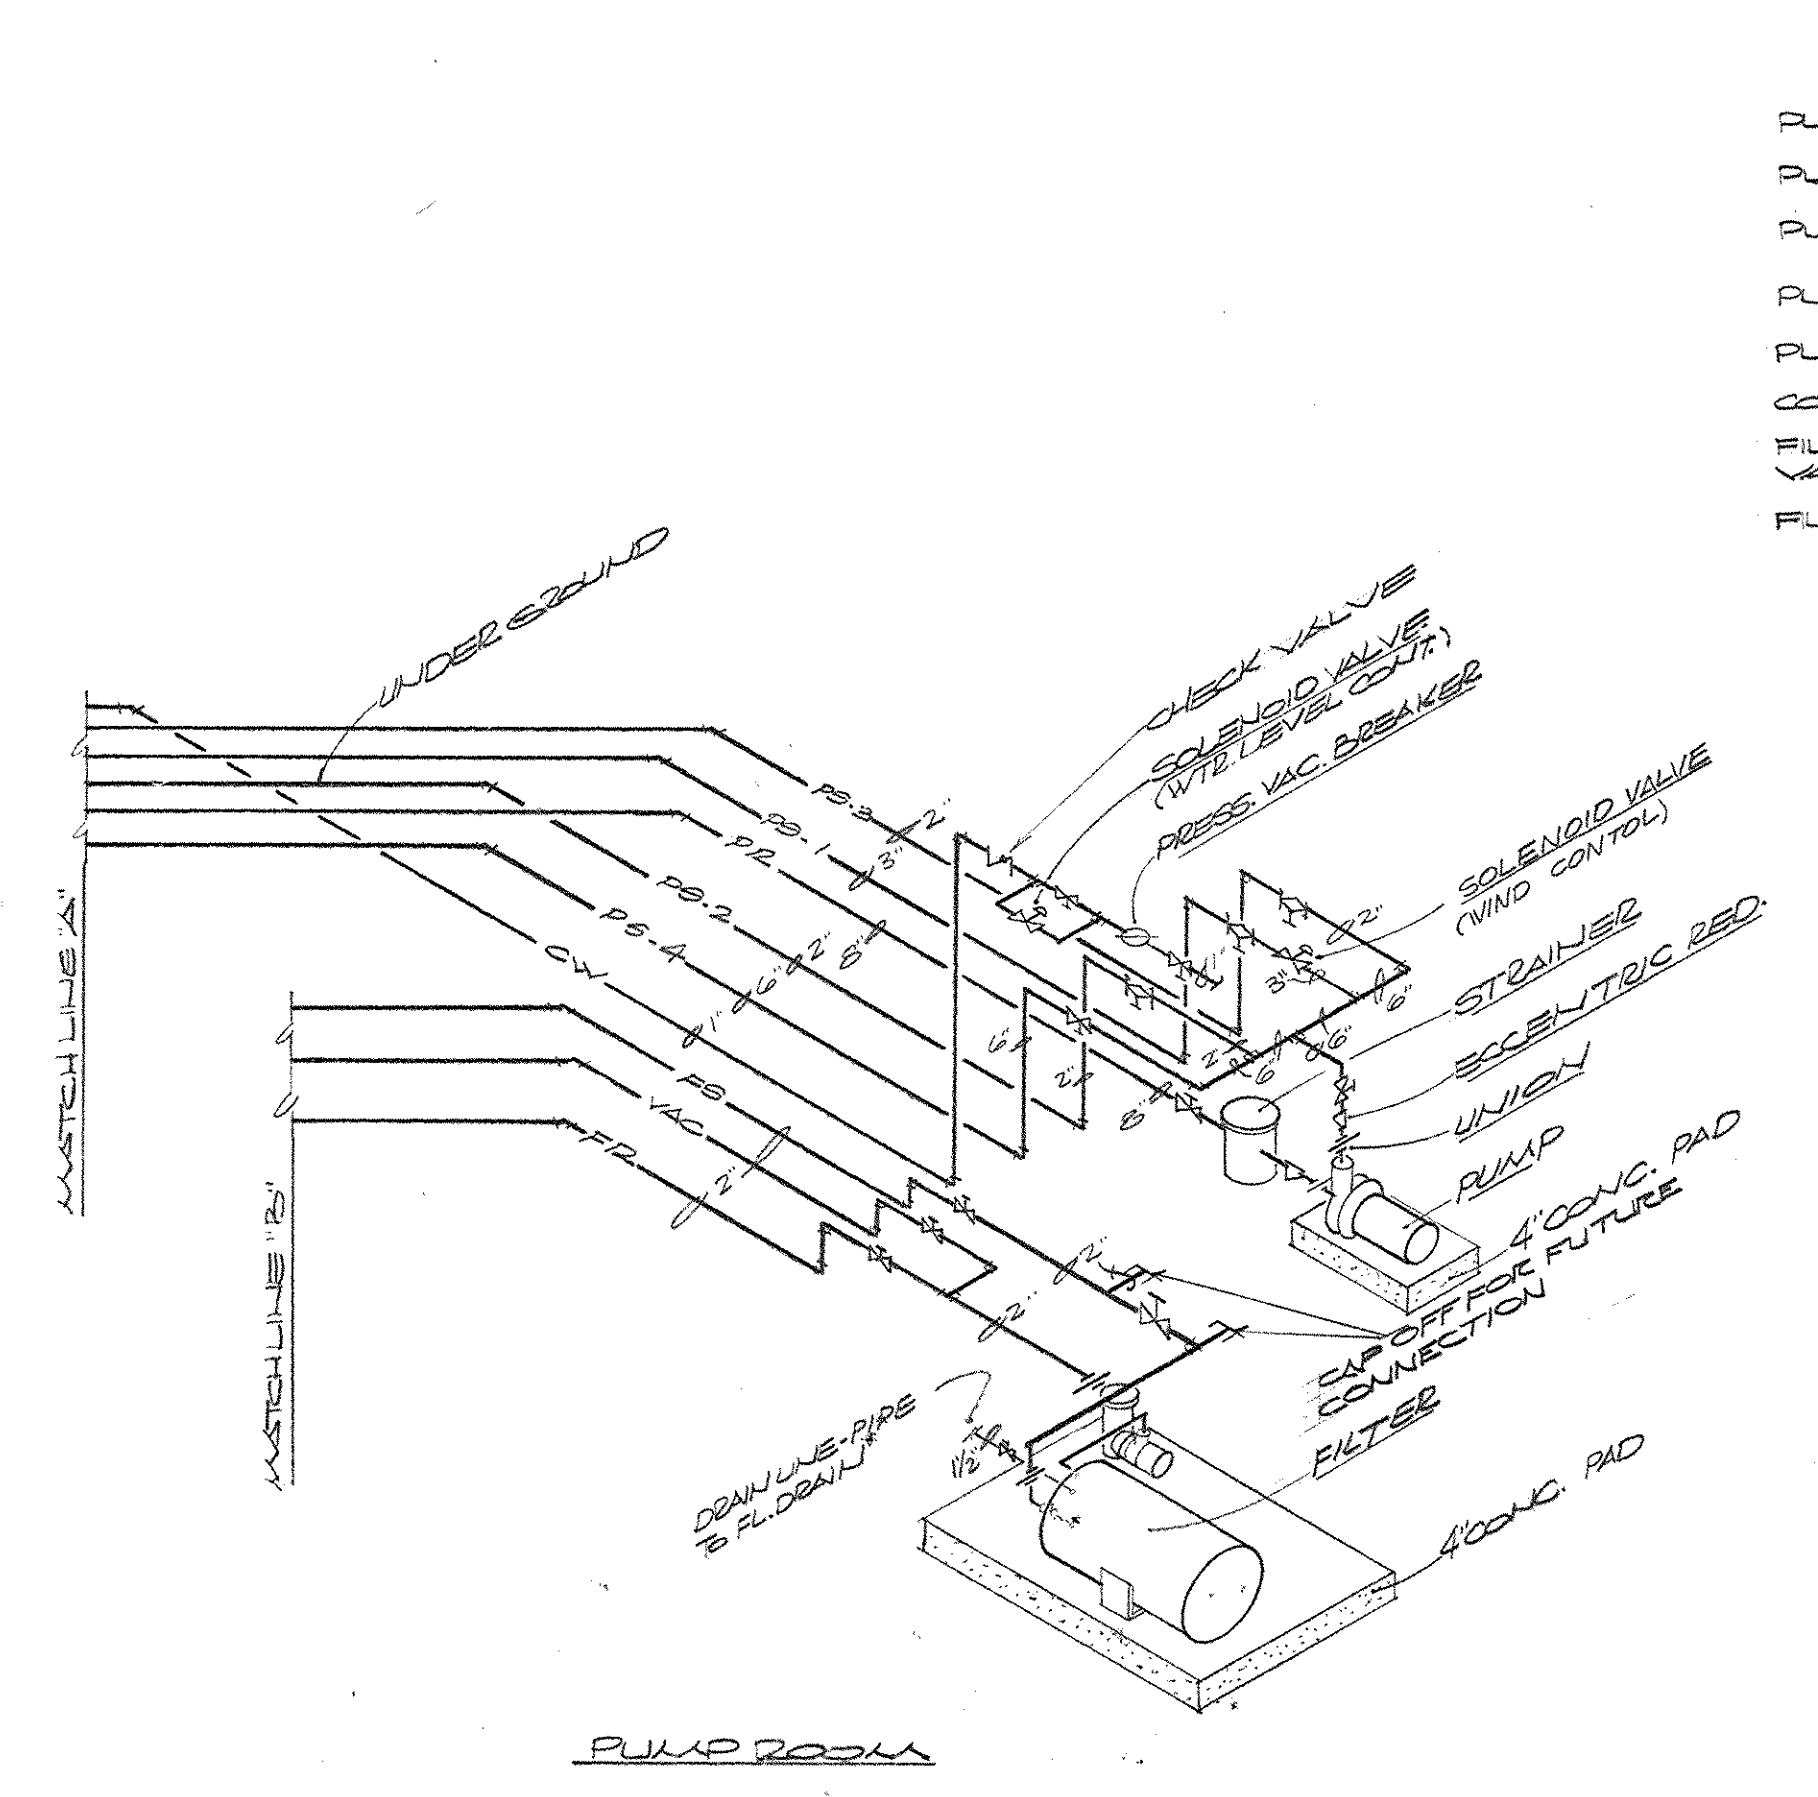



PUMP ROOM
 SCALE: 1/4" = 1'-0"

CAPITAL PLAZA OFFICE BUILDING
 FRANKFORT, KENTUCKY


DRAWN BY S. W. HUNT	DATE 15 MAY 1967
TRACED BY S. W. HUNT	SCALE AS SHOWN
CHECKED BY S. W. HUNT	ARCHITECT EDWARD DURELL STONE 7 EAST 67TH STREET NEW YORK N. Y.
SECTOR NO.	COMM. NO. 30000
ASSOCIATE ARCHITECTS & ENGINEERS LEE POTTER SMITH & ASSOCIATES 314 WILKINSON FRANKFORT, KENTUCKY	DRAWING NO. PH 28
COMMONWEALTH OF KENTUCKY DEPARTMENT OF FINANCE - ENGINEERING STAFF FRANKFORT, KENTUCKY	DATE MAY 24 1967

APPROVED BY: ARCHITECT DATE: _____
 APPROVED BY: AGENCY HEAD DATE: _____
 APPROVED BY: OWNER DATE: MAY 24 1967

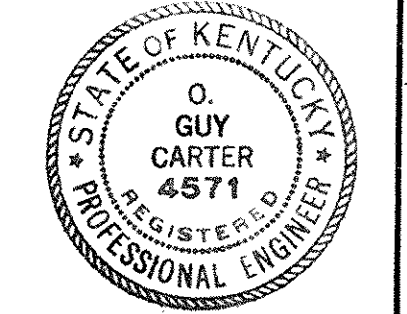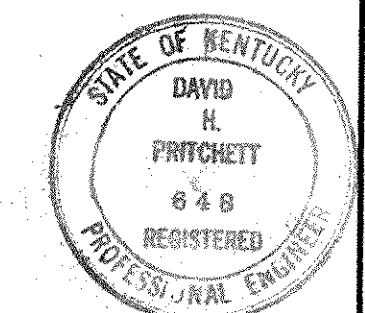

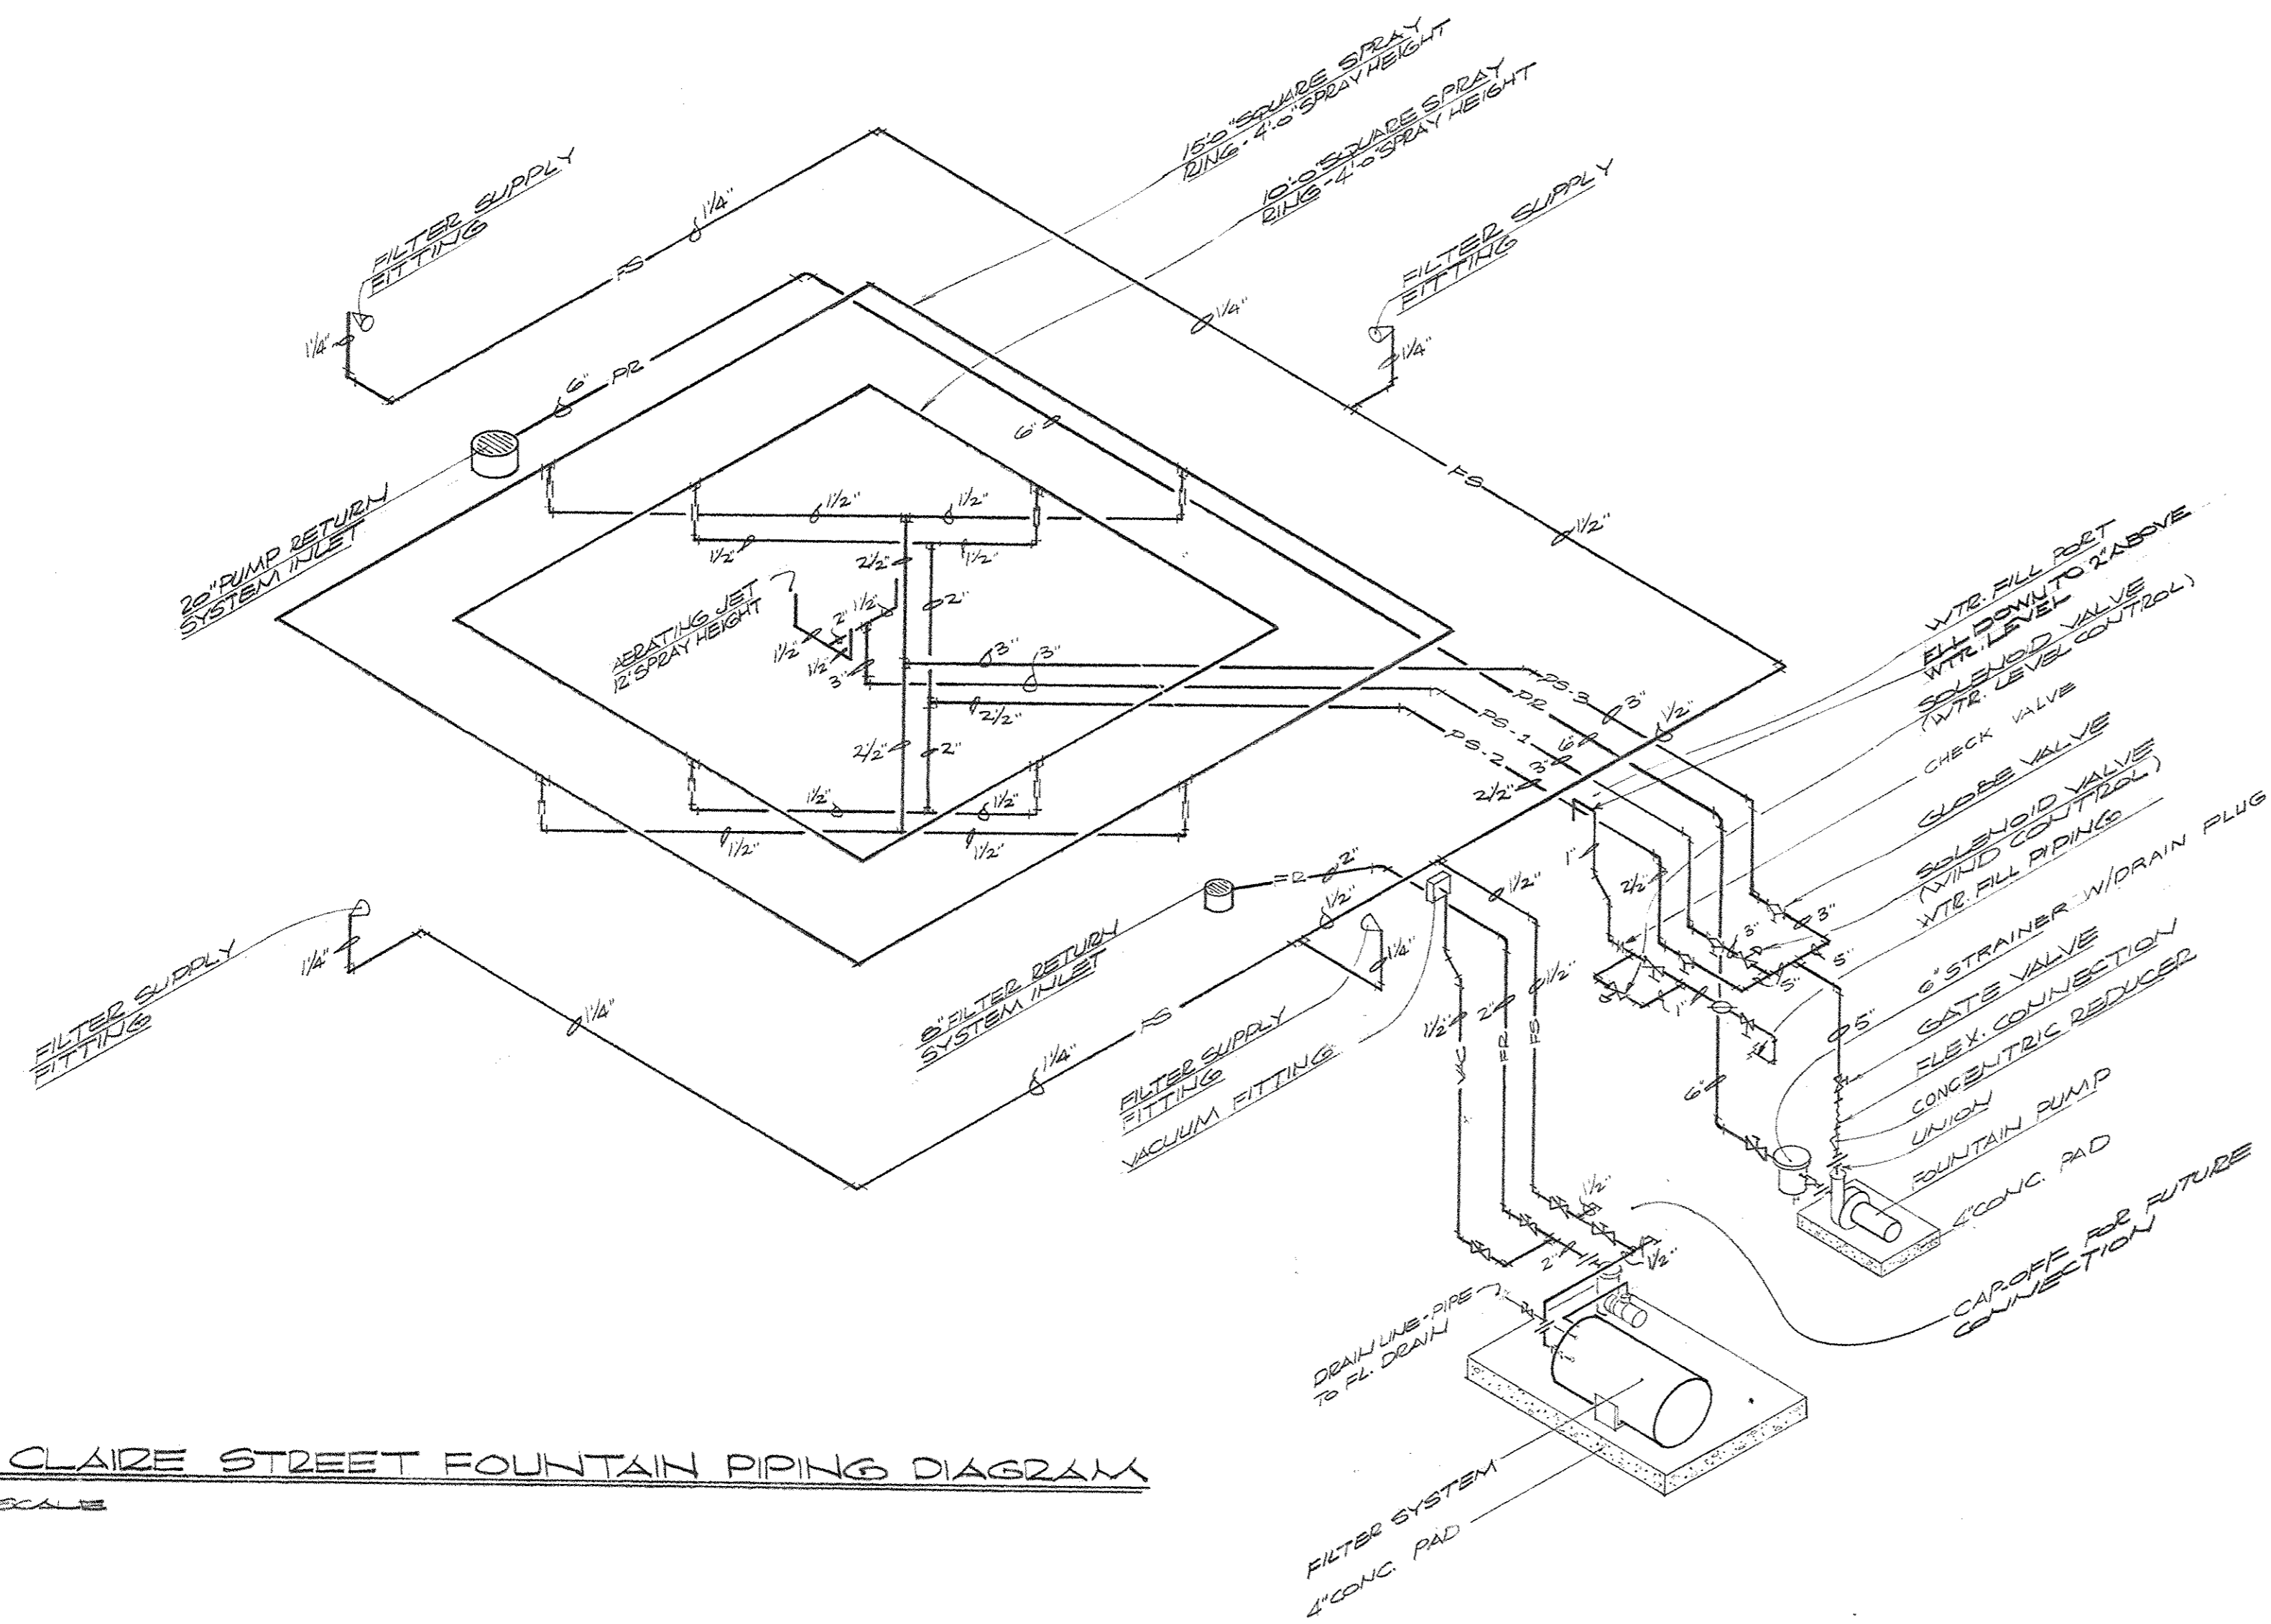

ST. CLARE STREET FOUNTAIN PIPING DIAGRAM
1/4" = 1'-0"

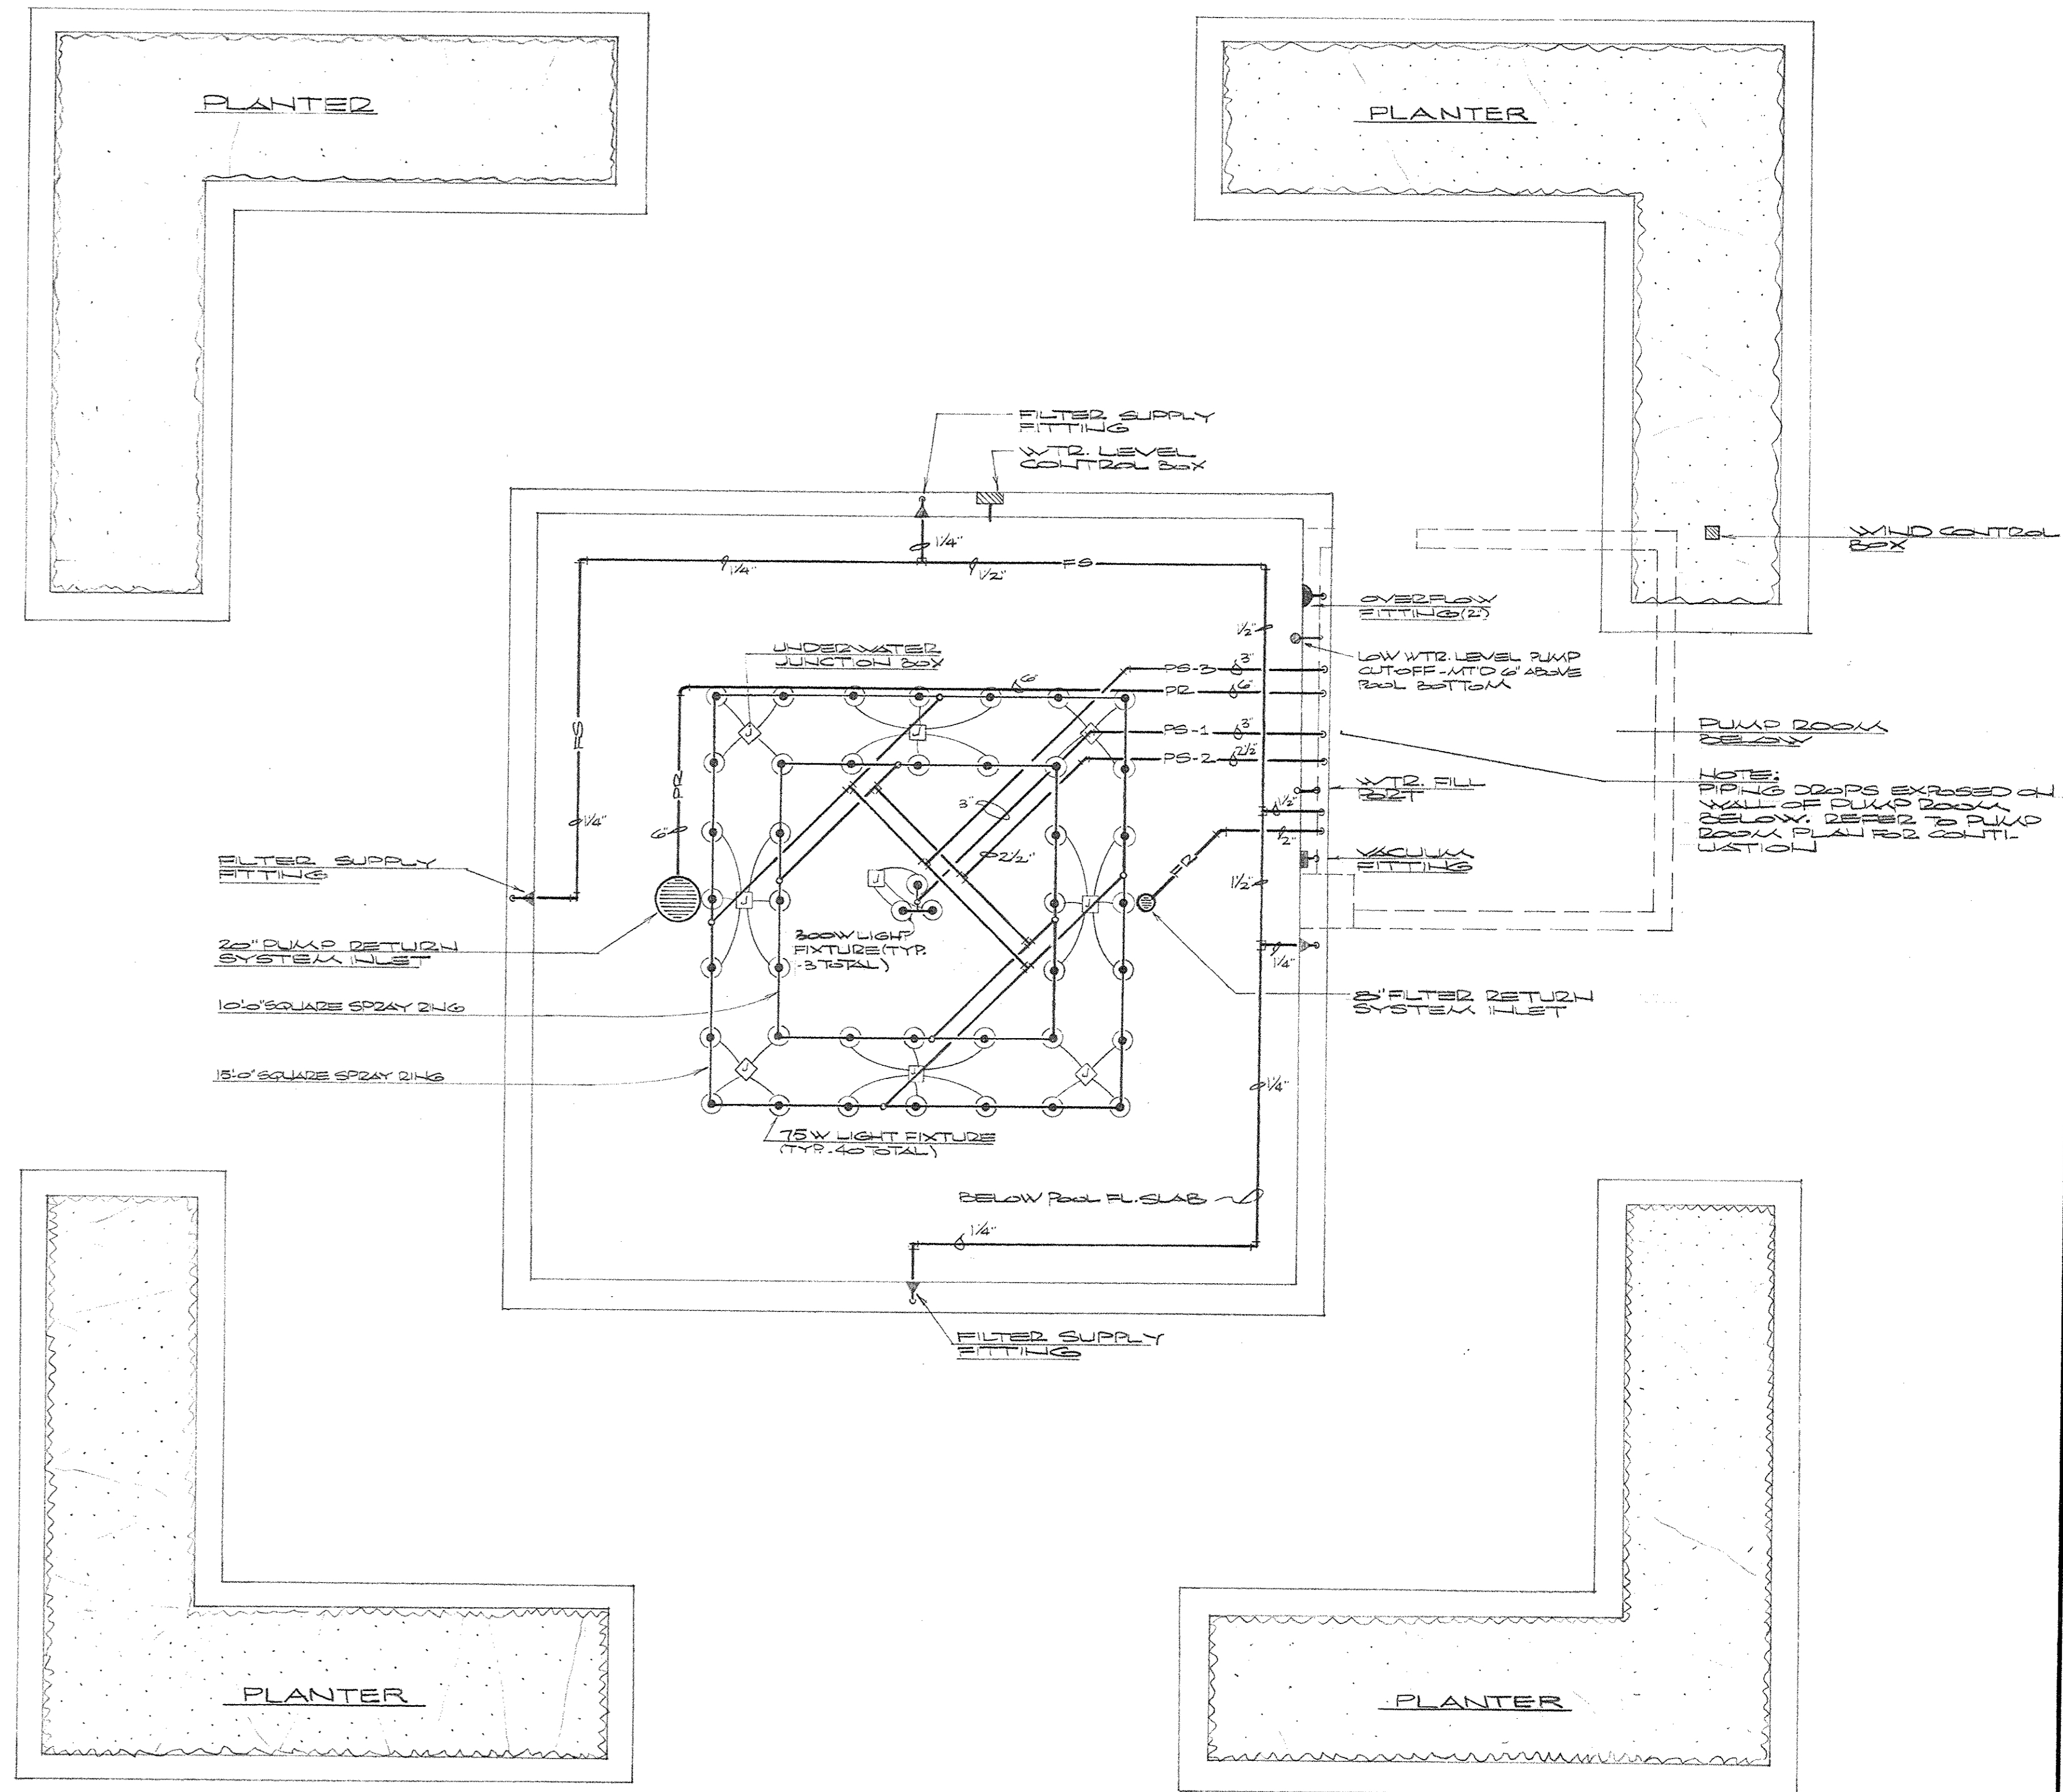


ST. CLARE STREET FOUNTAIN PLAN
SCALE: 1/4" = 1'-0"

FOUNTAIN PIPING LEGEND

- PS-1 PUMP SUPPLY - 1 (TO ABSTAINING JETS)
- PS-2 PUMP SUPPLY - 2 (TO SQUARE SPRAY DINGS)
- PS-3 PUMP SUPPLY - 3 (TO SQUARE SPRAY DINGS)
- PR-1 PUMP RETURN
- PR-2 PUMP RETURN
- PR-3 PUMP RETURN
- FS FILTERED SUPPLY
- FR FILTERED RETURN
- VAC VACUUM PIPING
- CV GOLD WTR. FULL PIPING

GENERAL NOTES

- 1 FILTERED SYSTEM OUTLETS SHALL BE DECELLATED TO 3/4" DIA. EACH
- 2 FILTERED SUPPLY FITTINGS (WTR. FILL) SHALL BE AT 0' BELOW WTR. LEVEL
- 3 ALL PIPING (EXCEPT SPRAY DINGS) SHALL BE PITCHED TO DRAIN TOWARD PUMP ROOM

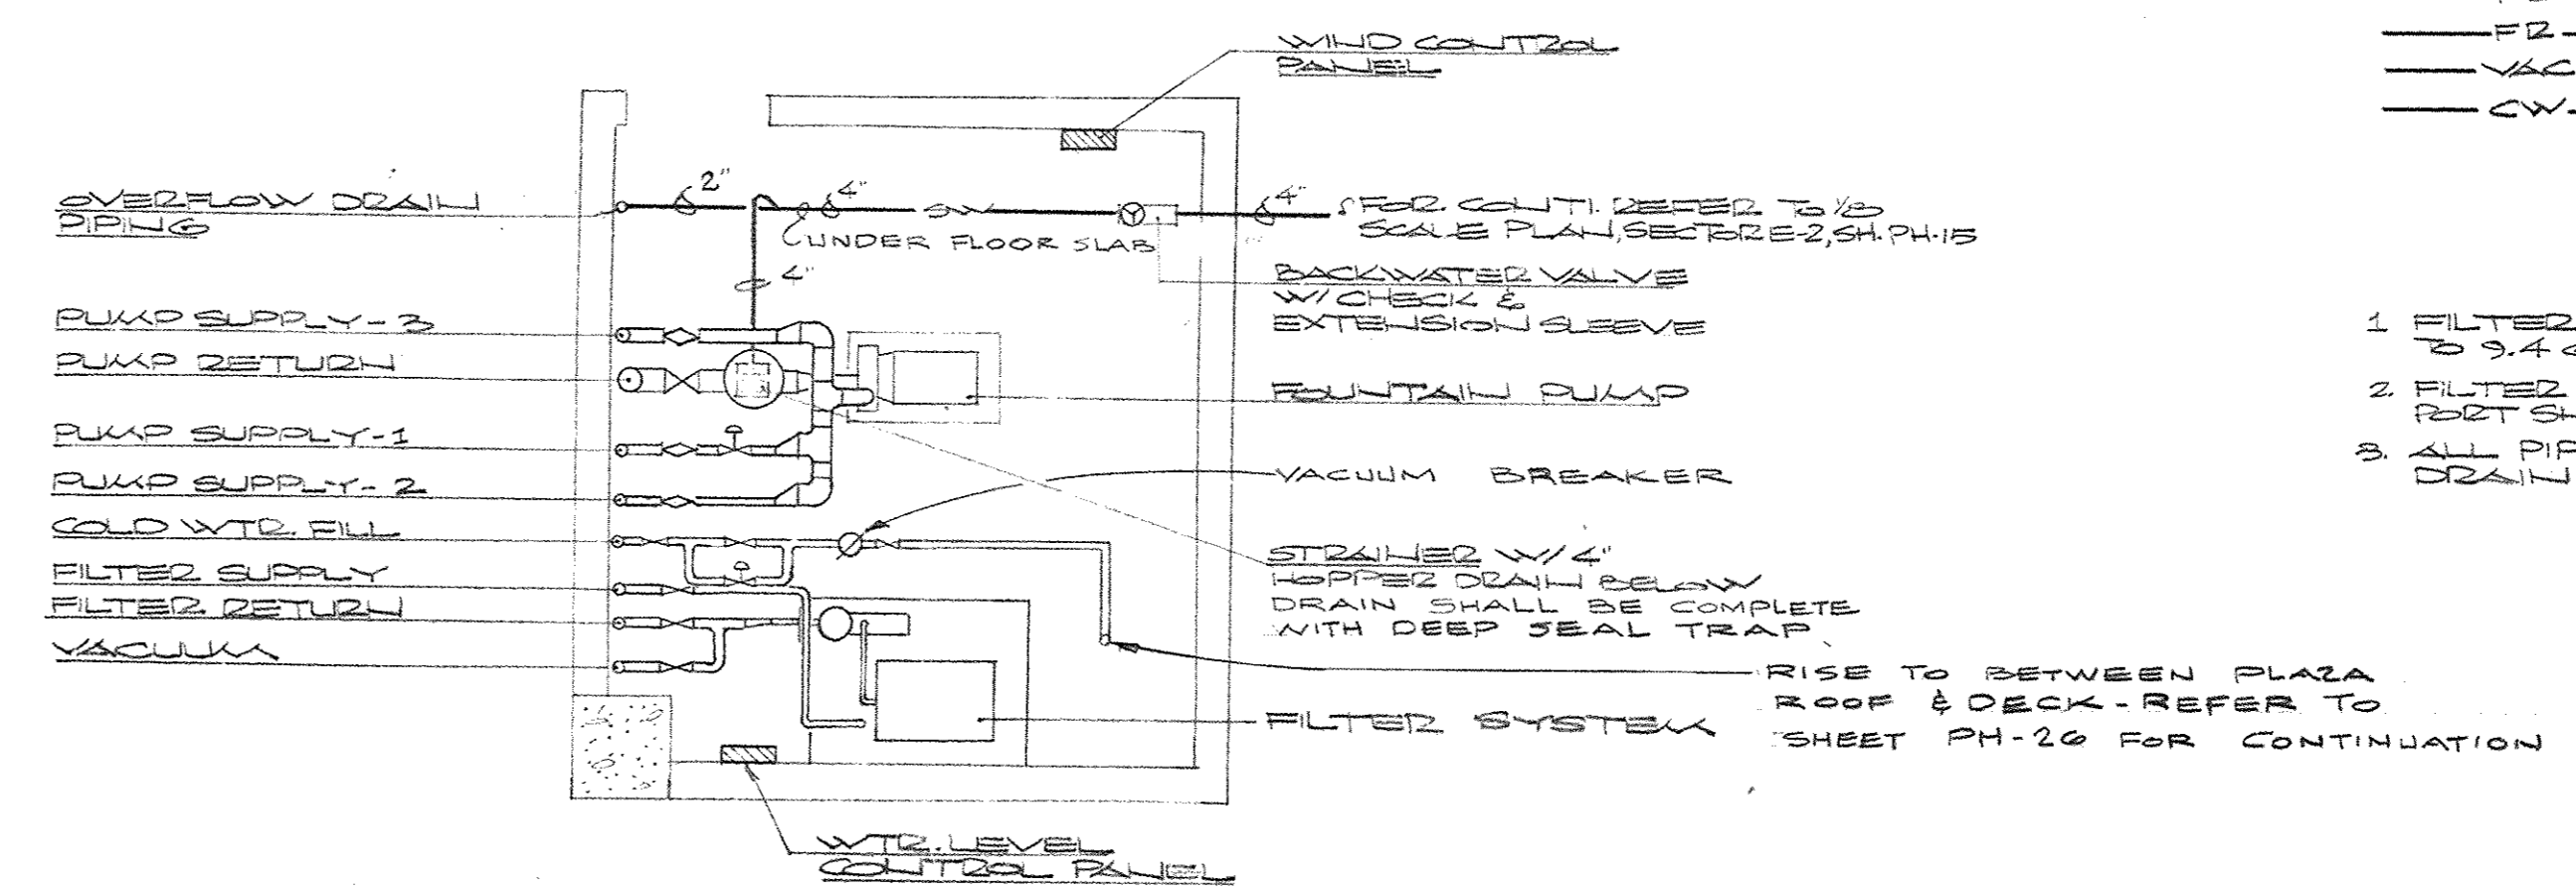

PUMP ROOM
SCALE: 1/4" = 1'-0"

CAPITAL PLAZA OFFICE BUILDING		
FRANKFORT, KENTUCKY		
DRAWN BY SMET	ST. CLARE STREET FOUNTAIN PLAN & DIAGRAM	DATE 15, MAY, 1967
TRACED BY SMET	ARCHITECT	SCALE AS SHOWN
CHECKED BY 648 REGISTERED	EDWARD DURELL STONE 7 EAST 6TH STREET NEW YORK N. Y.	COMM. NO. 5006
SECTION NO.	LEE POTTER SMITH & ASSOCIATES 314 WILKINSON FRANKFORT, KENTUCKY	DRAWING NO. PH 29 OF 31
APPROVED BY O. GUY CARTER 4571 REGISTERED PROFESSIONAL ENGINEER	DEPARTMENT OF FINANCE - ENGINEERING STAFF FRANKFORT, KENTUCKY	DATE MAY 24 1967
APPROVED BY	OWNER	DATE

