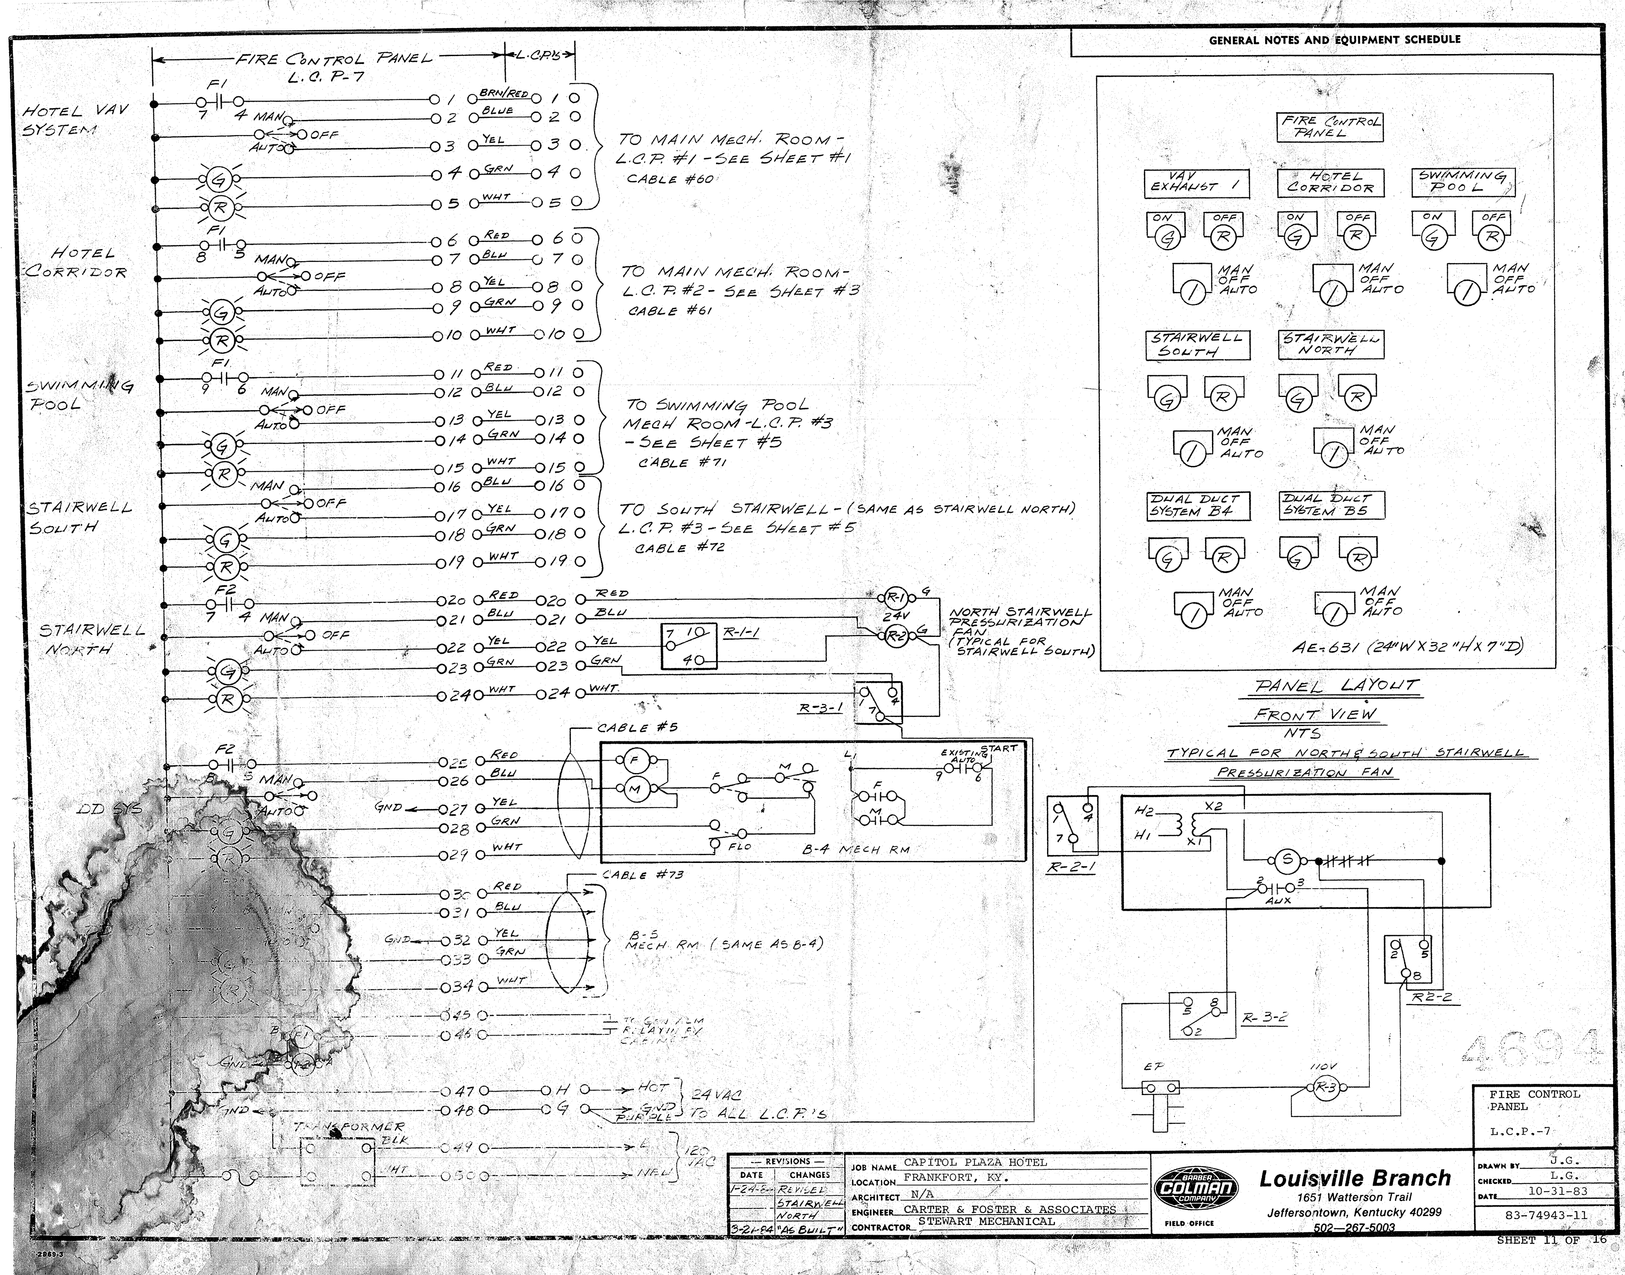
GENERAL NOTES AND EQUIPMENT SCHEDULE
FIRE CONTROL PANEL L.C.P-7
L.C.P.'S
HOTEL VAV SYSTEM
TO MAIN MECH. ROOM - L.C.P. #1 - SEE SHEET #1 CABLE #60
HOTEL CORRIDOR
TO MAIN MECH. ROOM - L.C.P. #2 - SEE SHEET #3 CABLE #61
SWIMMING POOL
TO SWIMMING POOL MECH ROOM - L.C.P. #3 - SEE SHEET #5 CABLE #71
STAIRWELL SOUTH
TO SOUTH STAIRWELL - (SAME AS STAIRWELL NORTH) L.C.P. #3 - SEE SHEET #5 CABLE #72
STAIRWELL NORTH
NORTH STAIRWELL PRESSURIZATION FAN (TYPICAL FOR STAIRWELL SOUTH)
R-1-1
R-3-1
CABLE #5
B-4 MECH RM
CABLE #73
B-5 MECH RM (SAME AS B-4)
24VAC TO ALL L.C.P.'S
TRANSFORMER
120 VAC
FIRE CONTROL PANEL
VAV EXHAUST 1
HOTEL CORRIDOR
SWIMMING POOL
STAIRWELL SOUTH
STAIRWELL NORTH
DUAL DUCT SYSTEM B4
DUAL DUCT SYSTEM B5
AE-631 (24"W X 32"H X 7"D)
PANEL LAYOUT
FRONT VIEW
NTS
TYPICAL FOR NORTH & SOUTH STAIRWELL PRESSURIZATION FAN
R-2-1
R-3-2
R2-2
4694
FIRE CONTROL PANEL
L.C.P.-7
REVISIONS
DATE CHANGES
1-24-84 REVISED STAIRWELL NORTH
3-21-84 "AS BUILT"
JOB NAME CAPITOL PLAZA HOTEL
LOCATION FRANKFORT, KY.
ARCHITECT N/A
ENGINEER CARTER & FOSTER & ASSOCIATES
CONTRACTOR STEWART MECHANICAL
BARBER COLMAN COMPANY
FIELD OFFICE
Louisville Branch
1651 Watterson Trail
Jeffersontown, Kentucky 40299
502—267-5003
DRAWN BY J.G.
CHECKED L.G.
DATE 10-31-83
83-74943-11
SHEET 11 OF 16

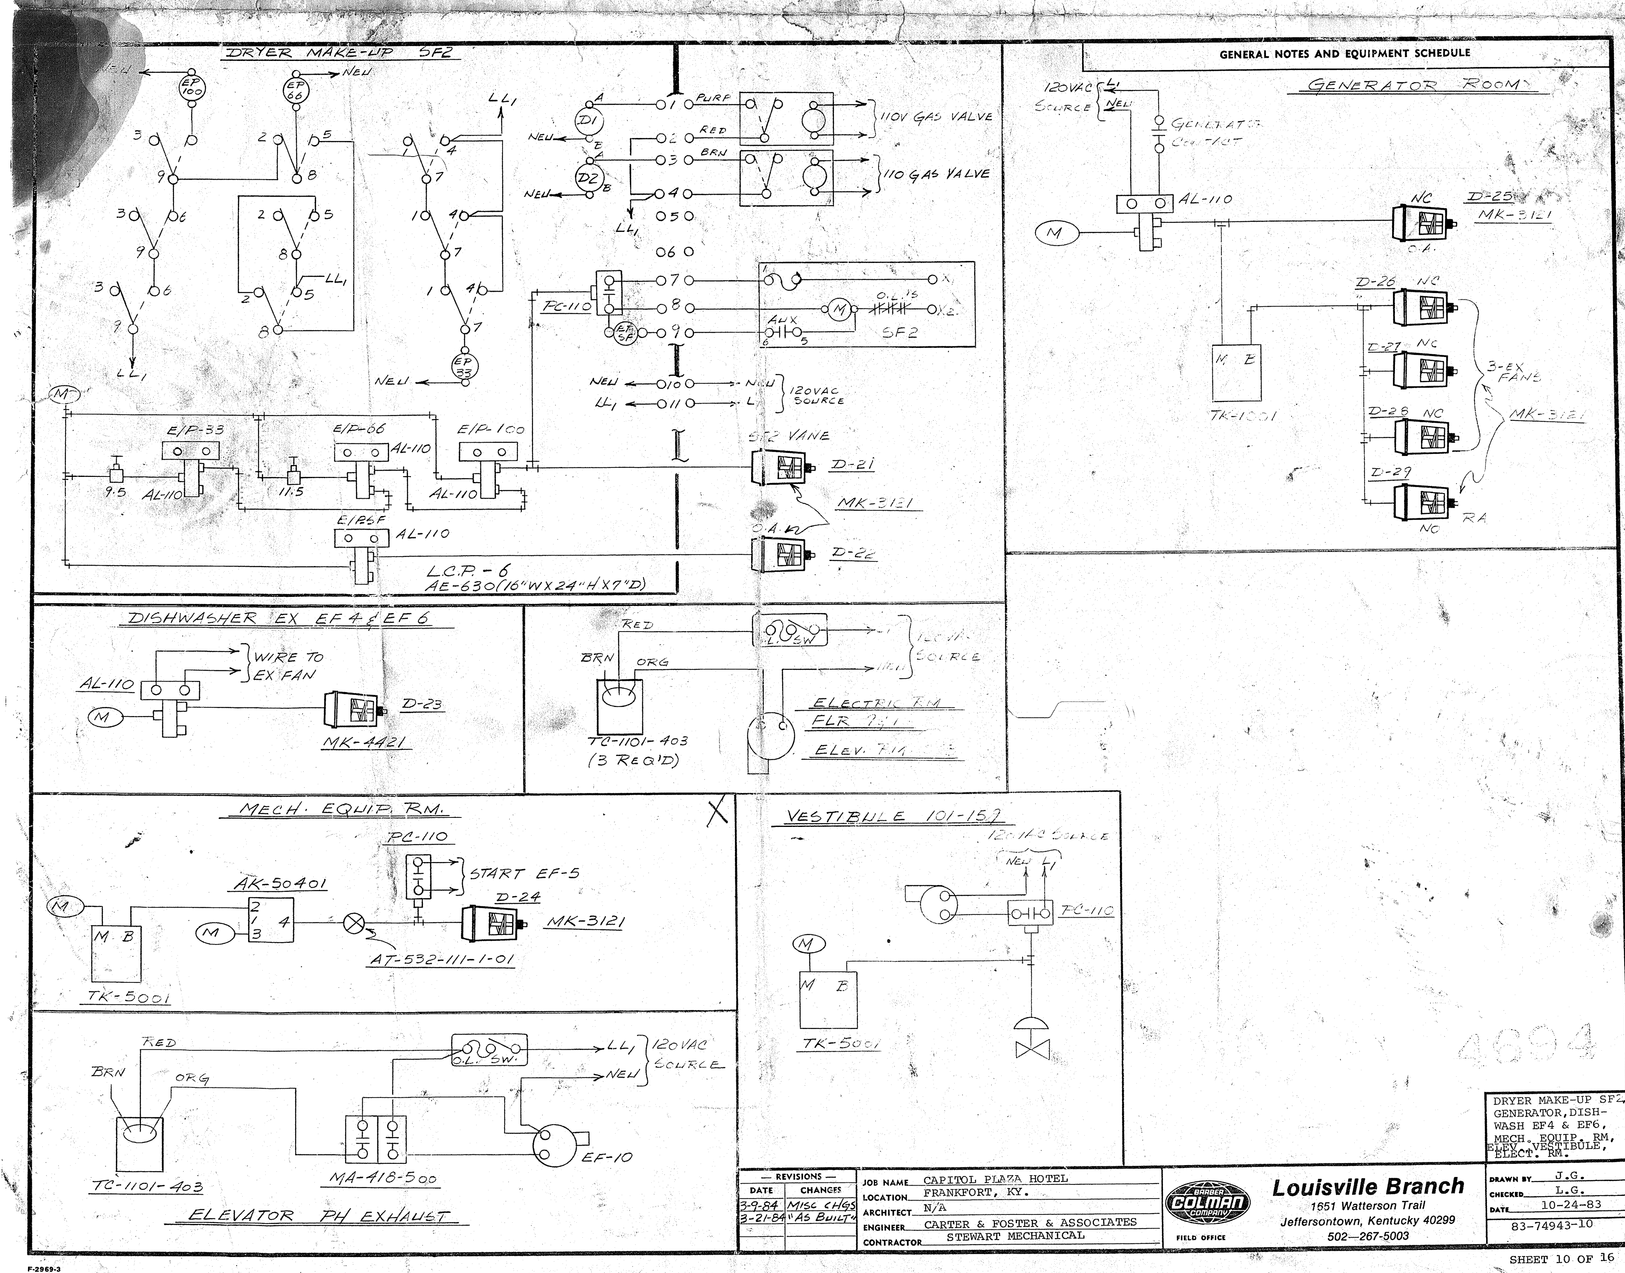
GENERAL NOTES AND EQUIPMENT SCHEDULE
DRYER MAKE-UP SF2
110V GAS VALVE
110 GAS VALVE
PC-110
SF2
120VAC SOURCE
SF2 VANE
D-21
MK-3121
D-22
L.C.P.-6
AE-630 (16"W X 24"H X 7"D)
GENERATOR ROOM
120VAC SOURCE
GENERATOR CONTACT
AL-110
D-25
MK-3121
D-26
D-27
D-28
D-29
3-EX FANS
TK-1001
DISHWASHER EX EF4 & EF6
WIRE TO EX FAN
D-23
MK-4421
TC-1101-403 (3 REQ'D)
ELECTRIC RM
MECH. EQUIP. RM.
PC-110
START EF-5
AK-50401
D-24
MK-3121
AT-532-111-1-01
TK-5001
VESTIBULE 101-159
120VAC SOURCE
PC-110
TK-5001
120VAC SOURCE
TC-1101-403
MA-418-500
EF-10
ELEVATOR PH EXHAUST
4694
DRYER MAKE-UP SF2, GENERATOR, DISHWASH EF4 & EF6, MECH. EQUIP. RM, ELEV. VESTIBULE, ELECT. RM.
REVISIONS
DATE CHANGES
3-9-84 MISC CHGS
3-21-84 "AS BUILT"
JOB NAME CAPITOL PLAZA HOTEL
LOCATION FRANKFORT, KY.
ARCHITECT N/A
ENGINEER CARTER & FOSTER & ASSOCIATES
CONTRACTOR STEWART MECHANICAL
BARBER COLMAN COMPANY
FIELD OFFICE
Louisville Branch
1651 Watterson Trail
Jeffersontown, Kentucky 40299
502—267-5003
DRAWN BY J.G.
CHECKED L.G.
DATE 10-24-83
83-74943-10
SHEET 10 OF 16